



POOL ROOM DETAIL - LIGHTING

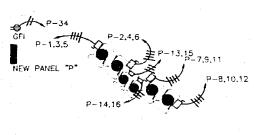

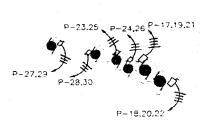

POOL ROOM DETAIL - POWER

PROJECT ARCHITECT

ALISON SPEAR, A.I.A. 180 NE 39th St., SUITE 222, MIAMI, FL 33137 305-438-1200 fax 305-438-1221

LIDO SPA HOTEL
SITE LIGHTING - RENOVATION
40 ISLAND AVENUE, MIAMI BEACH, FL 33139 PROJECT TITLE

POOL PUMPS ROOM AND PANEL SCHEDULE

DRAWN BY C.P.
CHECKED BY R.J.M.
ISSUES
INTERNATION ISSUE DATE

Leta 3/2/4



7723-1-04

141 141

1 milet

SHEET NO.

E-2SL


E	EXISTING	ELECTR	ICAL	PANEL	SCHEDULE	'EL'
TYPE : AO. G MOUNTING SURFA LOCATION - ELECT	ACE `		S CONTRA	(10) MAP BUS VOU	PATE LO AMP	AIN CIRCUIT BREAKER -3PHASE-4W
DESCRIPTION	WIFE & COND. SIZE	LOAD POLE,	ÇFT. No. A	S C No.	POLE : WIPE COND	& DESCRIPTION
LANDSCAPE LIGHTS+	#10 - 1/2"	510 100 20	100	++ 2	100 20 625 110 -	- 1/2" LANDSCAPE LIGHTS
LANDSCAPE LIGHTS.	#10 - 1/2"	550 120	3 +	1	100 625 10 -	- 1/2" LANDSCAPE LIGHTS
LANDSCAPE LIGHTS+	#10 - 1/2"		5	+ 6	20: 735 110 -	
LANDSCAPE LIGHTS.	#10 - 1/2"	730 110 20	7	8	20 550 10 -	- 1/2" LANDSCAPE LIGHTS
LANDSCAPE LIGHTS*	#10 - 1/2"	730 1 20	9	10	20 416 110 -	- 1/2" LANDSCAPE LICHTS
LANDSCAPE LIGHTS+	#10 - 1/2"	1.020 11.20	11		100 20 416 #10 -	- 1/2" LANDSCAPE LIGHTS
LANDSCAPE LIGHTS+	#10 - 1/2"	565 11: 20	13	1 11 "	20 540 110 -	
LANDSCAPE LIGHTS+	#10 - 1/2"	830 100 20	15_	1 1 1	20 1,380 110 -	- 1/2" LANDSCAPE LIGHTS
LANDSCAPE LIGHTS.	#10 - 1/2"	830 11. 20	17	18	20 735 110 -	- 1/2" LANDSCAPE LIGHTS
LANDSCAPE LIGHTS.	#10 - 1/2"	200 1100 20	19		100 1.020   10 -	- 1/2" LANDSCAPE LIGHTS
LANDSCAPE LIGHTS+	#10 - 1/2	1.080 1100 20	21		20 820 10 -	- 1/2" LANDSCAPE LIGHTS
LANDSCAPE LIGHTS+	#10 - 1/2"	540 100 20	23	24	20 735 10 -	- 1/2" LANDSCAPE LIGHTS
LANDSCAPE LIGHTS*	#10 - 1/2"	480 11.20	25	26	20. 735 110 -	- 1/2" LANDSCAPE LIGHTS.
LANDSCAPE LIGHTS.	#10 - 1/2"	416 100 20	27	28	20 735 #10 -	- 1/2" LANDSCAPE LIGHTS
IRRIG. CONTROLLER	#10 - 1/2"	416 100 20	29	30	7,500 #4 IN	FOUNTAIN
SPACE			31	32	50 7.500.14	CONTROLLER
SPACE		1	33	34		SPACE
SPACE		1	35	3€		SPACE
SPACE		1	37	33		SPACE
SPACE		1	39	40	1	SPACE
SPACE		1	41	42		SPACE
· CONTROLLED BY PH •• PROVIDE GFI CIT			TOR		SATG: SAM:	LOAD: 26,948 VA 75

E	XISTING	ELE	CTR	CA	L_	PAI	NEL	SC	HEDL		'WL	<u>.                                    </u>
TYPE . AQ. ( MOUNTING : SURF LOCATION : ELEC	ACE .	D IN P	REVIOUS	000 A	RAC	(T)	MAIN BUS VOLT	PATING.	M.L.O. 125 / 208Y		3PHAS	E-4W
DESCRIPTION	WRE & COND. SIZE	LOAD (V.A.)	POLF./ TRIP	CFT.	A	вс	CHT. No	POLE.	LOAD (V.A.)	WIRE COND.		BESCRIPTION
LANDSCAPE LIGHTS+	#10 - 1/2"	420			+	++		100 20	1,050			LANDSCAPE LIGHTS
LANDSCAPE LIGHTS.	#10 - 1/2"	420	100 20	3	+	+-+	- [ -4	20				LANDSCAPE LIGHTS
LANDSCAPE LIGHTS+	#10 - 1/2"	380	1:: 20	5	+	┽┵	- 6	20	1,060			LANDSCAPE LIGHTS
LANDSCAPE LIGHTS*	#10 1/2"	350	100 20	7.	+	++	- 3	1100 20	870	#10 -	1/2	LANDSCAPE LIGHTS
LANDSCAPE LIGHTS+	#10 - 1/2"	480	1:: 20	9	1	++	10	100 20	630	#10 -	1/2	LANDSCAPE LIGHTS
LANDSCAPE LIGHTS+	#10 - 1/2"	840	100 20	11	+	┵┵	- 12	1100 20	540	<b>≨</b> 10 −	1/2	LANDSCAPE LIGHTS
LANDSCAPE LIGHTS	#10 - 1/2"	840		13	-	+-1	- 14	100 20	640	#10 -	1/2-	LANDSCAPE LIGHTS
LANDSCAPE LIGHTS+	#10 - 1/2"	1,020			1	+	16	20	460	#10 -	1/2	LANDSCAPE LIGHTS
LANDSCAPE LICHTS+	#10 - 1/2	160	1:: 20	17	4		- 13	10:20	540	#10 -	1/2	LANDSCAPE LIGHTS
ANDSCAPE LIGHTS.	#10 - 1/2"	795			1	44	- 20	20	400	#10 -	1/2"	LANDSCAPE LIGHTS
LANDSCAPE LIGHTS+	#10 - 1/2"	795	100-20	21	ㅗ	+	- 22	10: 20	460	#10	1/2	LANDSCAPE LIGHTS
LANDSCAPE LIGHTS.	#10 - 1/2"	1,020			4		- 34	100000	460	#10 -	1/2"	LANDSCAPE LIGHTS
LANDSCAPE LIGHTS.	#10 - 1/2"	1,020			4		- 2ē	10 20	460	#10 -	1/2	LANDSCAPE LIGHTS
SPACE	-			27	1	44	- 23					SPACE
SPACE.				29	4	11	- 30					SPACE
SPACE	-			31	1	11	- 32					SPACE
SPACE	<del> </del> -			33	1	+	- 32					SPACE
SPACE.	<del> </del>			35	4	1 1	- 36					SPACE
SPACE.	<del>                                     </del>			37	$\perp$	$\perp$	- 35					SPACE
				39	4	44	- <del>  10</del>					SPACE
SPACE				41	1	1	- 43					SPACE
CONTROLLED B	Y PHOTOCELL	THROUG	SH TIGH		: :ON1	: : ACTO				TOTAL	LOAD:	15.810 VA

	NEW	ELEC	TRIC	AL	PANE						
THRE AQ, GE MODITARY SUPPACE LUCATION POOL PUMP POOM		14,000 AIC				938 84713 - <b>225</b> 32749E - <b>208</b> Y			AMP MAIN CIRCUIT BREAKER AMP (/120V-3PHASE-4W		
CESCP-Pich	WRE & CUNC. SIZE	LOAD (V.A.)	PSLE.	CHT. No.	A = 1	7.7. No	POLE /	LOAD /A./	MPE & COND. SIJE	CESCRIPTIC*I	
STREAM JET PUMP (5HP)	#10 ~ 1/2"	6.300	3 30	1 3 5			3 / 30	,	#10 - 1/2"	STREAM JET PUMP (SHP)	
BADU JET PUMP (7.5HP)	#8 - 3/4"	9,108	3 40	7 9		10	3 40	9,108	#8 - 3/4"	BADU JET PUNP (7.5HP)	
HYDROTHERAPY PUMP (1.5HP)	#12 - 1/2"	2,300	2 / 20	13 15		1.4	2 20	2,390	#12 - 1/2"	HYDROTHERAPY PUV (1.5HP)	
WATERFALL PUVP (5HP)	#10 - 1/2"	6,300	3 30	17 19		18 20 20	3 / 30		#10 - 1/2	WATERFALL PUMP (SHP)	
SPA JET PUVP (2HP)	#12 - 1/2°	2,760	2 20	23	+	24	2 20	2,760	#12 - 1/2"	SPA JET PUMP (2HP)	
FILTER PUMP (1HP)	#12 - 1/2"	1,840	2 20	27 29		25 30	2 20	1.840	#12 - 1/2"	FILTER PUMP (1HP)	
POOL LIGHTS*	#12 - 1/2"	1,200	100 20		4	32	20	600	#12 - 1/2	POOL RM. LIGHTS	
POOL LIGHTS+	#12 - 1/2"	1,200				34	20	500	1 11	POOL RM. REC.	
SPACE	<del></del>			35	<del> </del>	ΞE	20	528	#12 - 1/2"	EF-3	
SPACE	<del> </del>			37	i <del></del>	38				SPACE	
SPACE	i			39		4/3	-			SPACE	
SPACE	<del></del>	:		41	<del> </del>	42				SPACE	
. CONTROLLED B			эн шант	าพด	CONTACTOR				TOTAL LOAD:	61,244 VA 170	

LOAD DATA (208Y/120V -	3PH-4W 9	BERMCE) -	EAST WING	
EXIST. 600AMP LIGHTING MAIN			TOTAL BUILDING LOAD	
EXISTING PANEL "EN"		26,552 VA	A/C MAIN LOAD	
EXISTING PANEL "ES"		28,664 VA	EXIST. PANEL "CHP"	86,055 VA
EXISTING PANEL "EL"		26,948 VA	LIGHTING MAIN LOAD	(239A)
EXISTING PANEL "C"		31,952 VA	TOTAL, CONN. LIGHTING LOAD -	192,360 VA
NEW PANEL "P" (POOL EQUIPMENT)		61,244 VA	EXISTING OTHER LOAD	65,000 VA
NEW PANEL "EJ"		17,000 VA	TOTAL BLDG CONN. LOAD	343,415 VA (954 A)
TOTAL CONN. LOAD		192,360 VA		

LOAD DATA (208Y/120V - 3PH-4W SERVICE) - W	VEST WING
EXIST. PANEL "MDP" (MAIN 1 OF 5)	166,634 VA
EXIST. PANEL "CHP" (MAIN 2 OF 5)	92.412 VA
EXIST. PANEL "WC" (MAIN 3 OF 5)	51,200 VA
EXIST. PANEL "WD" (MAIN 4 OF 5)	11,000 VA
EXIST. POOL PUMPS MAIN (MAIN 5 OF 5)	12,500 VA
TOTAL. WEST WING CONN. LOAD	333,746 VA (927 A)

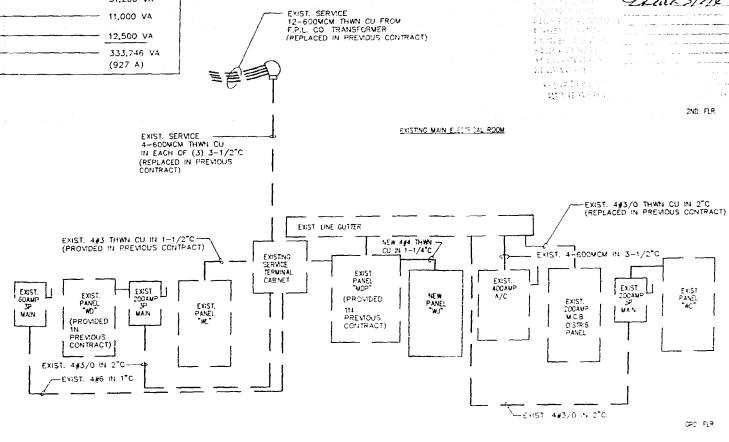

EXIST. SERVICE 12-600MCM THWN CU FROM F.P.L. CO TRANSFORMER (PEPLACED IN PREVIOUS CONTRACT)

EXISTING F.P.L. TRANSE, VAULT POOL PUMPS ROOM EXISTING MAIN ELECTRICAL ROOM - NEW 4#4 THWN CU IN 1-1/4"C EXISTING 4-600MCM IN 3-1/2"C EXIST LOAD GUTTER EXISTING FEEDER -(REPLACED IN
REMOUS CONTRACT)
EXISTING FEEDER
(REPLACED IN
REMOUS CONTRACT) EXIST. 60A-3P FUSED DISC. SWITCH NEW PANEL EJ EXIST. PANEL C EXIST. PANEL EL NEW PANEL EXIST. | 200A | (FUSED) | POOL | POOL | POOL | L MAIN | L (REPLACED IN PREVIOUS CONTRACT) (PROVIDED IN PREVIOUS CONTRACT) EXIST. 400A 3 POLE A/C MAIN (NEW 350A FUSES) EXIST. 600A (FUSED) 3 POLE LIGHTING MAIN EXIST. CT'S CABINET EXIST. ELECT. METER - EXISTING 1004-3P DISC. SWITCH EXISTING 4-350MCM IN-EXIST. 100A-39 DISC. SMTCH EXISTING 4-350MCM -IN EA. OF (2) 3°C (PEPLACED IN REMOUS CONTRACT) -NEW 4#4/0 THWN CU IN 2-1/2°C #4 CU IN 3/4"C
—CONNECT TO COLD WATER PIPE, TO
BUILDING FOUNDATION STEEL AND TO
(2) 5/8"x10"-0" DRIVEN GROUND RODS,
COPPERCIAD SEPARATED 6"-0"

ONE LINE RISER DIAGRAM - EAST WING

ONE LINE RISER DIAGRAM - WEST WING

PROJECT No: 0304-053

971 3 LOY

Ltura/2/V

# STATE LANGUAGE COMMON COMMON

SHEET NO.

ALISON SPEAR, A.I.A. 180 NE 38th St., SUITE 222, MIAMI, FL 33137 305-438-1200 fax 305-438-1221

SITE LIGHTING - RENOVATION 40 ISLAND AVENUE, MIAMI BEACH, FL 33139

PANEL SCHEDULES AND RISERS

DRAWN BY C.P. CHECKED BY R.J.M.

ISSUES
0879013 ISSUE DATE

LIDO SPA HOTEL

ROJECT ARCHITECT

E-3SL

### ELECTRICAL SYMBOLS

- DUPLEX RECEPTACLE, 20A, 120V. GROUND. TYPE, WALL MID., WITH GROUND FAULT INTERRUPT., 18" A.F.F. (OR 48" A.F.F. ABOVE SINKS)
- LICHTING SWITCH
- 1'X4' FLUGRESCENT LIGHTING FIXTURE, SURFACE MOUNTED
- DISCONNECT SWITCH
- ELECTRIC MOTOR
- HOME PUN TO PANEL
- CONDUIT RUNNING EXPOSED OR CONCEALED IN CEILING OR IN WALLS --- CONDUIT RUNNING UNDER GROUND

- ELECTRICAL GENERAL NOTES
- DRAVINGS ARE BIAGRAMMATIC. DO NOT SCALE DRAVINGS FOR EXACT LOCATION OF EQUIPMENT. THESE DRAVINGS ARE NOT INTENDED TO SHOW EVERY MINOP DETAIL. HOVEVER, THE CONTRACTOR SHALL FURNISH AND INSTALL ALL ITEMS REQUIRED FOR A COMPLETE AND ACCEPTABLE VOPENING INSTALLATION FER EDDE.
- 2. ALL WORK SHALL BE DONE IN ACCORDANCE WITH THE LATEST EDITION OF THE NEC AND SHALL COMPLY WITH ALL LOCAL RULES AND ORDINANCES.
- 3. ALL MATERIAL SHALL BE NEV AND SHALL BEAR UL LABEL WHERE APPLICABLE. THE CONTRACTOR SHALL FURNISH ALL LABOR. MATERIALS AND EDUTEMENT FOR A COMPLETE INSTALLATION. ALL MOUNTING HARDWARE AND WIRING HARDWARE SHALL BE FURNISHED BY THE CONTRACTOR.
- I. CIRCUITS SHOWN DI THESE PLANS ARE SYMBOLICALLY SHOWN TO DETERMINE LOAD DATA AND EQUIPMENT SIZES. THE CONTRACTOR SHALL PHYSICALLY PROVIDE CIRCUITS AND ROUTING DE CONDUITS TO SUIT JUD CONDITIONS. THE LOADS SHALL BE BALANCED THROUGHOUT. THE CONTRACTOR SHALL ENSURE THAT NEUTRAL WIRES AND EQUIPMENT GROUND WIPES ARE INSTALLED WHEPE EVER APPLICABLE.
- 5. THE CONTRACTOR SHALL BE RESPONSIBLE FOR COORDINATING WITH THE POWER UTILITY TO DETAIN TEMPORARY POWER DURING CONSTRUCTION. THE CONTRACTOR SHALL IMMEDIATELY CONTACT THE POWER UTILITY TO SCHEDULE INSTALLATION OF TEMPORARY POWER SO THAT CONSTRUCTION DELAYS APE AVOIDED.
- THAT CONSTRUCTION DELAYS APE AVOIDED.

  THE CUNTRACTOR SHALL COURDINATE WITH THE DRAWINGS.

  DITAIN PERHAMENT POWER IN ACCORDANCE WITH THESE BRAWINGS.

  THE CONTRACTOR SHALL INHEDIDED PERHAMENT POWER SO THAT

  TO SCHEDULE AVOIDED ALT IS THE CONTRACTOR'S RESPONSIBILITY

  TO CONTACT THE POWER WITLITY EARLY ON TO IDENTIFY ANY ISSUES

  AFFECTING PERHAMENT POWER SERVICE AND TO WORK TOWARDS

  RESOLVING ANY ISSUES REGARDING PERMANENT SERVICE.
- THE CONTRACTOR SHALL COORDINATE WITH THE TELEPHONE COMPANY TO DETAIN TELEPHONE SERVICE. THE CONTRACTOR SHALL IMMEDIATELY CONTACT THE TELEPHONE COMPANY TO SCHEDULE INSTALLATION OF TELEPHONE SERVICE. IT IS THE CONTRACTOR'S RESPONSIBILITY TO CONTACT THE TELEPHONE COMPANY EARLY ON TO TENTIFY ANY ISSUES AFFECTING TELEPHONE SERVICE AND TO WORK TOWARDS PESOLVING ANY ISSUES DELAYING INSTALLATION.
- 8. IF APPLICABLE, THE CONTRACTOR SHALL COORDINATE WITH THE CABLE TV COMPANY IN THE SAME MANUER AS DESCRIBED IN PARAGRAPHS 6 AND 7 FOR POWER AID TELEPHONE UTILITIES.
- PARAGRAPHS 6 AND 7 FOR POWER AND TELEPHONE UTILITIES.

  9. IF ANY DR ALL OF THE UTILITIES (ELECTRICAL, TELEPHONE, CATY)
  ARE EXISTIMS, IT IS THE RESPONSIBILITY OF THE CONTRACTOR TO
  BECOME FAMILIAR WITH THE EXISTIMS SYSTEMS PRIOR TO BID. THE
  CONTRACTOR SHALL TRACE DOWN ALL CIRCUITS AND VIRING AND
  SHALL VERIFY THAT CAPACITY IS AVAILABLE FOR THE SCOPE OF THE
  PROJECT. THE CONTRACTOR SHALL FIELD INSPECT ALL EXISTIMG
  EQUIPMENT AND SHALL ENSURE THAT ALL RATINGS, FUSES,
  ENCLOSURES, ETC. APP FORDER FOR THE SCOPE OF THE
  CONTRACTOR SHALL INSPECT ANY EQUIPMENT OF THE PROJECT.
  THE CONTRACTOR SHALL INSPECT ANY EQUIPMENT OF THE PROJECT
  EQUIPMENT FOR DNE YEAR. THE CONTRACTOR SHALL PROJECT
  EQUIPMENT FOR DNE YEAR. THE CONTRACTOR CONDITION. A LIST OF
  EQUIPMENT THAT IS DANGED BY REPRESENTATIVE) AND THE ENGINEER
  PRIOR TO PEPLACEMENT.
- 10. THE CONTPACTOR SHALL THOROUGHLY REVIEW THESE DRAWINGS AND SHALL VISIT AND BECOME FAMILIAR WITH THE JOB SITE AND ALL EXISTING CONDITIONS PRIDE TO BID. ANY OUESTIONS, COMMENTS, DISCEPPANCIES OF PERCEIVED AMBIGUITIES SHALL BE DISCUSSED WITH THE ENGINEER PRIDE TO BID.
- ELECTRICAL DESIGN IS BASED UPON THE BEST AVAILABLE INFORMATION. THE CONTRACTOR SHALL REVIEW NAMEPLATE DATA AND MANUFACTUPER SUPPLIED LITERATURE FOR ALL PIECES OF EQUIPMENT PRIDE TO ROUGH ELECTRICAL VIRING. THE CONTRACTOR SHALL CHECK ALL EQUIPMENT FOR PROPER VOLTAGE, PHASE AND AMP RATING PRIDE IN INSTALLATION. THE CONTRACTOR SHALL CONTACT ENGINEER PRIDE TOO ANY FIELD ADJUSTMENTS.

- 12. ALL CONDUCTORS SHALL BE COPPER WITH THWN INSULATION.
- 13. ALL PANELS SHALL BE CLEARLY LABELED ON THE DUTSIDE FOR OUICK AND EASY IDENTIFICATION ALL CIRCUITS IN ALL PANELS SHALL BE CLEARLY IDENTIFICATION ALL CIRCUITS IN ALL PANELS SHALL BE CLEARLY IDENTIFIED AND SHALL APPEAR WITH COMPLETE INTORMATION (DESCRIPTION OF CIRCUIT, BREAKER SIZE NUMBER OF POLES AND BREAKER POSITION MIMBERS) ON THE PANEL NUMBER OF THE PANEL SHALL CLEARLY BE IDENTIFIED ON THE INSIDE DOOP. THE PANEL SHALL CLEARLY BE IDENTIFIED ON THE INSIDE DOOP. BOARDS AND CIRCUITS.
- 14. PLANS SHOWING AS-BUILT CHANGES SHALL BE DELIVERED TO THE DWIERS REPRESENTATIVE UPON COMPLETION OF MORK.
- 15. IT IS THE RESPONSIBILITY OF THE CONTRACTOR TO MAKE THIS INSTALLATION IN COMPLIANCE WITH ALL FIRE PREVENTION CODES SUPERCEDING ALL DRAVINGS. SPECIFICATIONS AND MOTES. THE CONTRACTOR SHALL COMMUNICATE AND CODED NATURE WITH THE FIRE MARSHALL AND SHALL PROVIDE ALL NECESSARY INCOMPATION MEETED TO SATISFY THAT LIFE SAFETY SYSTEMS ARE TO LOCAL CODE ACCEPTANCE.
- ALLEPINICE.

  ALL SERVICE ENTRANCE EQUIPMENT IS TO BE RATED AT 100,000 AIC INLESS DIMERVISE NOTED. TO PROVIDE SERVICE ENTRANCE EQUIPMENT IN THE LOWER RATINGS THE CONTRACTOR SHALL PROVIDE IN WRITING INFORMATION FROM THE POWER UTILITY VERIFYING THAT CALCULATED FABLY CURPENTS ARE AT AN ACCEPTABLE LEVEL TO ACCOMMODATE THE LOWER RATED EQUIPMENT. IF SERVICE ENTRANCE EQUIPMENT IS SISTING. THE CONTRACTOR SHALL VERIFY THAT AIC RATINGS OF EXISTING EQUIPMENT APE PROPER. THE CONTRACTOR SHALL ODED INATE WITH THE POWER UTILITY AND THE ENGINEER PRIOR TO BE THE CONTRACTOR SHALL ODED INATE WITH THE POWER UTILITY AND THE ENGINEER PRIOR TO BID.
- 17. ALL BUTSIDE EQUIPMENT, BUTLETS, LIGHTING FIXTURES, ENCLOSUPES, ETC. SHALL BE WEATHERPROOF.
- 18 THE CONTPACTOR SHALL PROVIDE ALL REQUIRED CONNECTIONS FOR ALL OTHER TRADES.
- 19. THE CONTRACTOR SHALL DBTAIN ALL PERMITS FOR VORK UNDER THIS CONTRACT.
- THE NUMBER, EXACT LOCATION AND MOUNTING HEIGHTS OF ALL OUTLETS, LIGHTS AND ELECTRICAL FIXTURES SHALL BE DETERMINED BY THE DWINER AND ARCHITECT. THE CONTRACTOR SHALL VERIFY ALL NUMBERS AND LOCATIONS WITH ARCHITECT AND OWNER PRIOR TO BID AND TO INSTALLATION.
- 21. THE CONTRACTOR SHALL PROVIDE ROUTING FOR ALL FLOOR MOUNTED DUTLETS AND OTHER LOADS AND CONNECTIONS NOT READILY ACCESSIBLE VIA VALL OR CEILING. THE CONTRACTOR SHALL COORDINATE WITH APCHITECT AND OWNER TO DETERMINE THE METHOD TO SERVE SUCH AREAS (I.E. TRENCHING, COPE AND SOPING, POWER POLE, ETC.) FRIOR TO BID.
- 22. ALL RACEVAYS AND PIPES PLACED IN OR THROUGH ANY CONCRETE SLAB SHALL BE SPACED A MINIMUM OF THREE DIAMETERS OF THE LARGEST CONCUIT OR PIPE OF ANY OTHER SERVICE.
- 23. ALL RACEVA'S UNDERGROUND AND/OR LARGER THAN 2 INCHES IN DIAMETER SHALL BE GALVANIZED RIGID STEEL. PVC SCH 40 VILL BE ACCEPTABLE IF APPROVED BY LOCAL REGULATIONS CONTRACTOR TO VERIFY. ALL OTHER RACEVAYS 2' AND SMALLER IN DIAMETER MAY BE EMT.
- 24. DUTLET DOXES SHALL BE PRESSED STEEL IN DRY LOCATIONS AND CAST ALLOY WITH THREADED HUBS IN WET DR DAMP LOCATIONS.
- 25. DISCONNECT SWITCHES SHALL BE HORSEPOVER RATED, HEAVY DUTY, OUICK MAKE, OUICK BREAK, IN NEMA I OR NEMA 3R ENCLOSURES AS REQUIRED BY EXPOSURE.
- 26. THE ELECTRICAL SYSTEM CHALL BE COMPLETELY AND EFFECTIVELY GROUNDED PER NEC REQUIREMENTS AND STATE AND LOCAL CODE REQUIREMENTS.

- ALL WORK SHALL BE PERFORMED BY A LICENSED ELECTRICAL CONTRACTOR IN A FIRST CLASS WORMANLIKE MANUES. THE COMPLETE SYSTEM SHALL BE FULLY DEPARTUE. ACCEPTANCE BY ENGINEER/ARCHITECT MUST BE A CONDITION OF THE CONTRACT.
- IT IS NOT THE INTENTION OF THESE PRAVINGS TO ESTABLISH LIGHTING LEVELS OF ANY KIND. THE NUMBER STYLE AND LOCATION OF LIGHTING FIXTURES ARE DETERMINED BY THE APPHILET AND/OR THE DRAWINGS IS FOR INFORMATIONAL PURPOSES AND HAS BEEN DEVELOPED BY THE ARCHITECT AND/OR DEVELOPED BY THE ARCHITECT AND/OR DIVER FOR DETAILED OUESTIGHS REGARDING LIGHTING FITURES CONTACT THE ARCHITECT OF DWIRE.
- 29. EXISTING LIGHTING FIXTURES WHEN PEUSED APE TO BE RECIRCUITED AND RECONNECTED. THE ARCHITECT AND/OP OWNER SHALL BE INFORMED OF AND SHALL APPROVE THE REUSE OF ALL REUSED LIGHT FIXTURES. ALL REUSED LIGHTING FIXTURES SHALL BE PELAMPED. CLEANED AND PEPAIRED IF NECESSAFY. ANY EXISTING LIGHTING FIXTURE BEYOND REPAIR SHALL BE REPLACED. ALL LIGHTING FIXTURES SHALL BE GUARANTEED FOR A PERIOD OF DNE YEAR.
- 20. IT IS THE CONTRACTOR'S PESPONSIBILITY TO ENSURE THAT ALL ELECTRICAL SERVICES TO MECHANICAL EQUIPMENT IS ACCOUNTED FOR PRIOR TO BID. IN ADDITION, ALL WED-AMICAL EQUIPMENT SUBSTITUTIONS ARE TO BE ACCOUNTED FOR PRIOR TO BID AND SHALL BE COOPDINATED ELECTRICALLY.
- 31. FOR HVAC EQUIPMENT THE MECHANICAL SCUTRACTOR SHALL PROVIDE THE SMOKE DETECTOR, IF REQUIRED, AND THE ELECTRICAL CONTRACTOR SHALL INSTALL THE SMOKE DETECTOR.
- 32. THE ELECTRICAL CONTRACTOR SHALL COORDINATE WITH THE MECHANICAL CONTRACTOR FOR INSTALLATION OF ALL MECHANICAL CONTROLS.
- 33. IT IS THE RESPONSIBILITY OF THE CONTPACTOR TO FORWARD ANY SHOP DRAWINGS TO THE ARCHITECT DENER SHOP DRAWINGS ARE NOT SOLICITED BY THE ENGINEER.
- 34. IT IS THE CONTRACTOR'S RESPONSIBILITY TO ENSURE THAT FIRE STOPPING MEASURES ARE PROVIDED PER LOCAL BUILDING DEPT. REDUIPEMENTS. THE FIRE STOPPING MATERIAL AND ITS INSTALLATION SHALL BE UL APPROVED. ALL FIPE STOPPING MATERIAL SHALL BE NOW WATER SCLOBLE

Da 2 3-104

A.I.A 33137 I, FL (

SPEAR

ALISON

.. SUITE 222, MIAMI, 1200 fax 305-438-12

305-438-1

SITE LIGHTING - RENOVATION ISLAND AVENUE, MIAMI BEACH, FL 33139

40

SYMBOLS

AND

NOTES

DRAWN BY CHECKED BY R.J.M. ISSUES
NAZEOTE ESSUE DATE

ᇳ

SPA HOT

100

PROJECT TITLE

LL: Ca 3/2/0

MOUNTRIS FLI	I. GE USH RRIDOR EAST	WNG		AA 38 000 A		VOLT	RATING AGE			E-4W
DECORPTION	MRE & COND. SIZE	LOAD (V.A.)	/ TPIP	CFT. No	A B C	Cr.T	POLE	LOAD (V.A.)	WRE & COND TITE	CESCRIPTION
JACUZZI	110 - 1/2	1,000	100 20	100	1+++	- 2	100 20	1,000	110 - 1/2"	JACUZZI
JACUZZI	#10 - 1/2"	1,000	100 20	3	<del>Ĭ</del> ┪╅	4	0	1,000	#10 - 1/2°	JACUTZI
JACUZZI	#10 - 1/2"	1,000		5	<del>┤┤┤</del>	- 6	20	1,000	#10 - 1/2°	JACUZZI
JACUZZ:	#10 - 1/2°	1,000	20	7	<del>Ĭ┽╌┼╸╎</del>	8			#10 - 1/2"	JACUZZ3
JACUZZI	1/10 - 1/2"	1,000	100 20	9	┇┼╌┼╼┽	10	20	1.000	#10 - 1/2°	JACUZZI
JACUZZI	110 - 1/2	1,000	20	11	] <del>- - - </del>	12	اه يسنوزا	1,000	#10 - 1/2"	JACUZZI
JACUZZI	#10 - 1/2	1,000	20	13	[ <del></del>	14	100	1,000	#10 - 1/2"	JACUZZI
JACUZZI	#10 - 1/2 <sup>-</sup>	1,000	20	15	1+++	1€	20	1,000	#10 - 1/2°	JACUZZI
JACUZZI	#10 - 1/2"	1,000	20	17	<del>                                     </del>	18	اسمرا			SPACE
SPACE	1			19	<del>│</del> ┿ <del>╌┼╸╎</del>	20				SPACE
SPACE				21	<del>Ĭ</del> ┿┿╅	22	المسمرا			SPACE
SPACE				2.5	<del>┤╌┼╌</del> ┥	24				SPACE
SPACE	1			25	<del></del>	26	اسسرا			SPACE
SPACE				27	<del>                                     </del>	29				SPACE
SPACE				29	<del></del>	30				SPACE

DESCRIPTION	WIRE & COND. SIZE	LOAD (V.A.)	POLE	CKT.		вс	CKT.	POLE	LOAD (V.A.)	WPE & COND SIZE	CESCRIPTION
IACUZZI	#10 - 1/2"	1,000		100	1+	++	2			#10 - 1/2°	
IACUZZ:	1 10 - 1/2	1,000	20	3	1+	-{-}	-	20	1,000	#10 - 1/2°	JACUZZI
ACUZZI	110 - 1/2	1,000	100 20	5	1+	<del></del>	6	20	1,000	110 - 1/2"	JACUZZI
ACUZZI	110 - 1/2	1,000	100 ZC	7	]+	++	8	100 20		#10 - 1/2°	
ACUZZI	#10 - 1/2°	1,000	20	9	1+	<del>-}-                                   </del>	10			<b>1</b> 10 ~ 1/2°	
ACUZZI	10 - 1/2	1,000	100 20	11	1+	++	12	100 20	1,000	#10 - 1/2°	JACUZZI
IACUZZI	110 - 1/2"	1,000	100	13	1+	<del>  </del>	14	20	1,000	#10 - 1/2°	
IACUZZI	#10 - 1/2"	1,000		15	1+	++	16				SPACE
PACE				17	1+	<del></del>	15				SPACE
PACE				19	1+	++	20		1	·	SPACE
PACE				2:	i+	++	22		1		SPACE
PACE				23	i÷	++	24	1		Ī	SPACE
PACE				25	1+	++	26	1			SPACE
PACE	<del> </del>			27	14	++	28	1		T	SFACE
PACE	1			29	14		30	1			SPACE


AFTH ELECTRICAL BANES OCHEDILE W.F.

E	XISTING	ELE	CTRI	CAL	PAN	EL	SCH	(EDU	LE 'MD	P'
THEE COB. MOUNTING SURF	ACE	VIDED IN		DUS COL	NTRACT)	VOLT	RATING AGE	600	AMP M.C.B. AMP /120V~3PHAS	E-4W
DESCRIPTION	MPE AV			Grit. No	4 B 1	Çr T. No	POLE / TRI-		## <b>E #</b> 60/10 9/2E	CESCRIPTON
EXIST. PANEL "WA"	EXISTING	26,912	3• / 100	3 -		4 6	3.	21,028	EXISTING	EXIST. PANEL "WB"
EXIST. PANEL "WF"	EXISTING	35,900	3• / / 125	9 -		10	3.	37,226	EXISTING	EXIST, PANEL "WG"
EXIST. PANEL "WJ"	EXISTING	24,715	3• 	13 -		16 16	3• Ε:	17,193	EXISTING	EX:ST. PANEL "ML"
NEW PANEL "WJ"	NEW #4 IN 1-1/4"		3•• / 	21 - 21 - 23 -			/			SPACE
CENERAL LIGHTING A DEMAND LOAD FOR C 20,000 VA © 50% 80,000 VA © 40% 24,580 VA © 30%		and Rec Va Va		* EXIST	NG CIRCUI	T BREAM		(MAN	POTAU LI AD AMPS,	166,634 VA 463
TOTAL EGAD OTHER LOAD TOTAL CONN. LOAD	= 49,374 = 117,260 = 166,634	VA -		NEW	CIFCUIT B	YLAKER				


PROJECT No: 0304-053



SHEET NO E-4SL

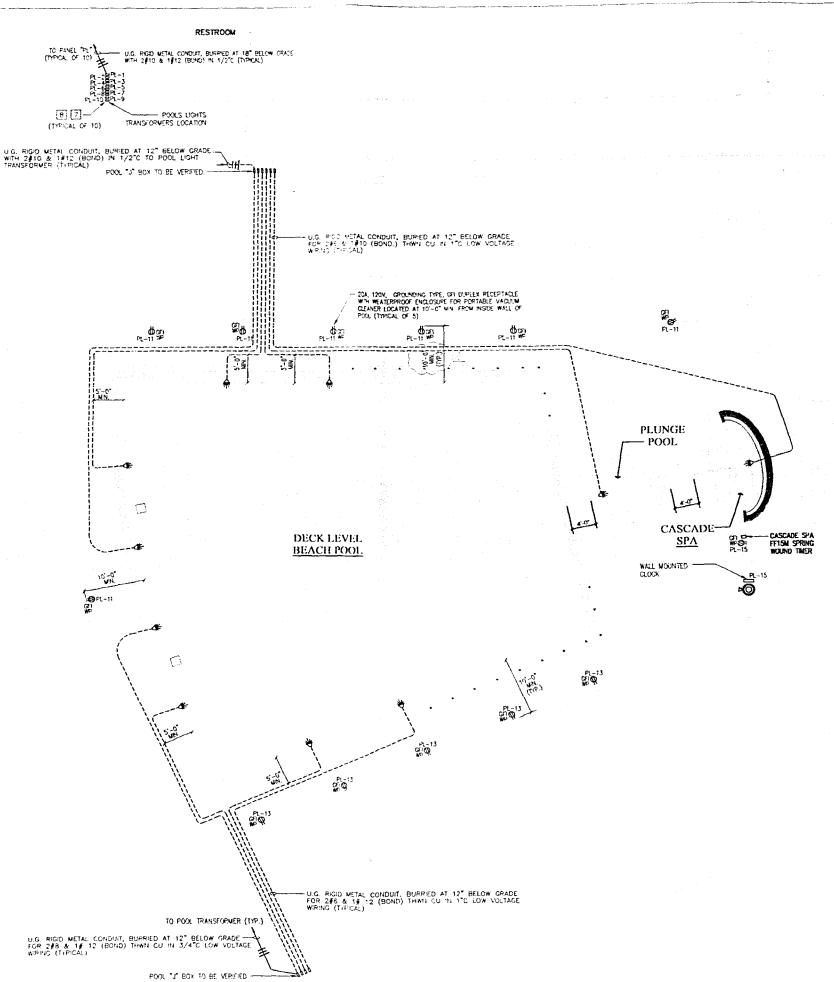


		<u>s</u>		EACH POLE OF E	OOL QUIPMENT
MARK	QTY.	ITEM	MFR	CAT. No.	DESCRIPTION
6	8	POOL LIGHTS	AMERICAN PRODUCTS	#78435100	POOL UNDERWATER LIGHT WITH STAINLESS STEE FACE RING, 300W, 12V, 100 FT COPD. INCLUDE AMERICAN PRODUCTS \$78210500 STAINLESS STEEL NICHE WITH 1" SIDE HUB OR EQUAL
7	8	TRANSFORMER BOX			TRANSFORMER BOX IN WEATHER PROOF ENCLOSURE, A.J. GIAMMANCO SAF-T-VOLT DUAL WHIDING TYPE.
8	8	JUNCTION BOX			JUNCTION BOX IN WEATHER PROOF NON-CORROSIVE ENCLOSURE REQUIRED.
Ю	6	ANCHOR SOCKET	S.R.SMITH	AS-100B	BRASS SOCKET WITH GROUNDING LUG. EACH SOCKET SHALL BE PROPERLY GROUNDED IN ACCORDANCE WITH NATIONAL ELECTRICAL CODE
18	1	FILTER PUMP	PENTAIR	COMMERCIAL BRASS PUMP CHK-75	STATURIOS. 7.5 HP, WITH HAR AND LINT POT, 292 GPW AT 60 TDH EACH, THREE FHASE, 220/440 VOLT.
28	2	HYDROTHERAPY JET PUMP	STA-RITE	P4E6FL MAX-E-GLASS II	1.5 HP, SELF PRIMING PUMP WITH A HAIR AND LINT STRAINER, 90 CPU AT 60 TCH EACH, SINGLE PHASE, 230 VOLT.
29	1	STREAM JET PUMP	PENTAIR	COMMERCIAL BRASS PUNP CHK-50	5.0 HP, SELF PRIMING PUNP, WITH 6" STRAINER 180 GPM AT 60 TDH. THREE PHASE, 220-440 VOLT.
30	2	BADU JET PUMP	PENTAIR	COMMERCIAL BRASS PUMP CHK-75	7.5 HP, WITH HAIR AND LINT POT, 400 CPM AT 60 TDH EACH, THREE PHASE, 220/440 VOLT.

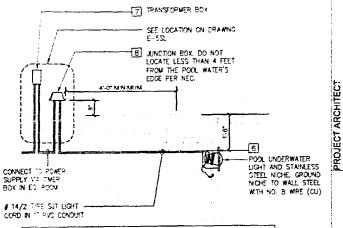


ALL ELECTRICAL WORK SHALL BE DONE BY LICENSED CONTRACTORS ON "ALL WORK SHALL BE DONE IN STRICT COMPLIANCE W: ARTICLE 580 N E C AND ALL LOCAL BUILDING DEPT. REQUIREMENTS THE CONTRACTOR IS RESPONSIBLE FOR MEETING THESE CRITERIA

## POOL LIGHT DETAIL

N.T.S.

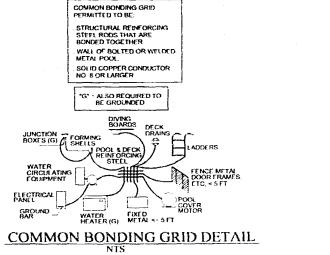

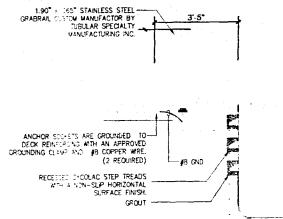

## **SECTION** BEACH POOL CUSTOM GRABRAIL GREOUNDING DETAIL

N.T.S.

NOTE ALL METAL PARTS IN THE POOL AREA SHALL BE BONDED TO THE POOL REINFORCING STEEL WITH A #8 COPPER WIRE AND AN APPROVED NEC CROUNDING CLAMP, ALL BONDING SHALL COMPLY WITH THE REQUIREMENTS SET FORTH IN THE NATIONAL ELECTRICAL CODE ARTICLE 680 AND ALL LOCAL ORDINANCES.

St 3-1-04. LIEG 3/2/4

PROJECT No: 0304-053



SHEET NO. E-5SL

ALISON SPEAR, A.I.A

LIDO SPA HOTEL SITE LIGHTING - RENOVATION 40 ISLAND AVENUE, MIAMI BEACH, FL 33139


SYMBOLS

NOTES AND

DRAWN BY C.P.
CHECKED BY R.J.M.
ISSUES
GATROTT
GOTTON
TOWNS
TOWNS
A CLEERA REV.


PROJECT TITLE


180 NE 39th St., SUITE 222, MIAMI, FL 33137 305-438-1200 fax 305-438-1221

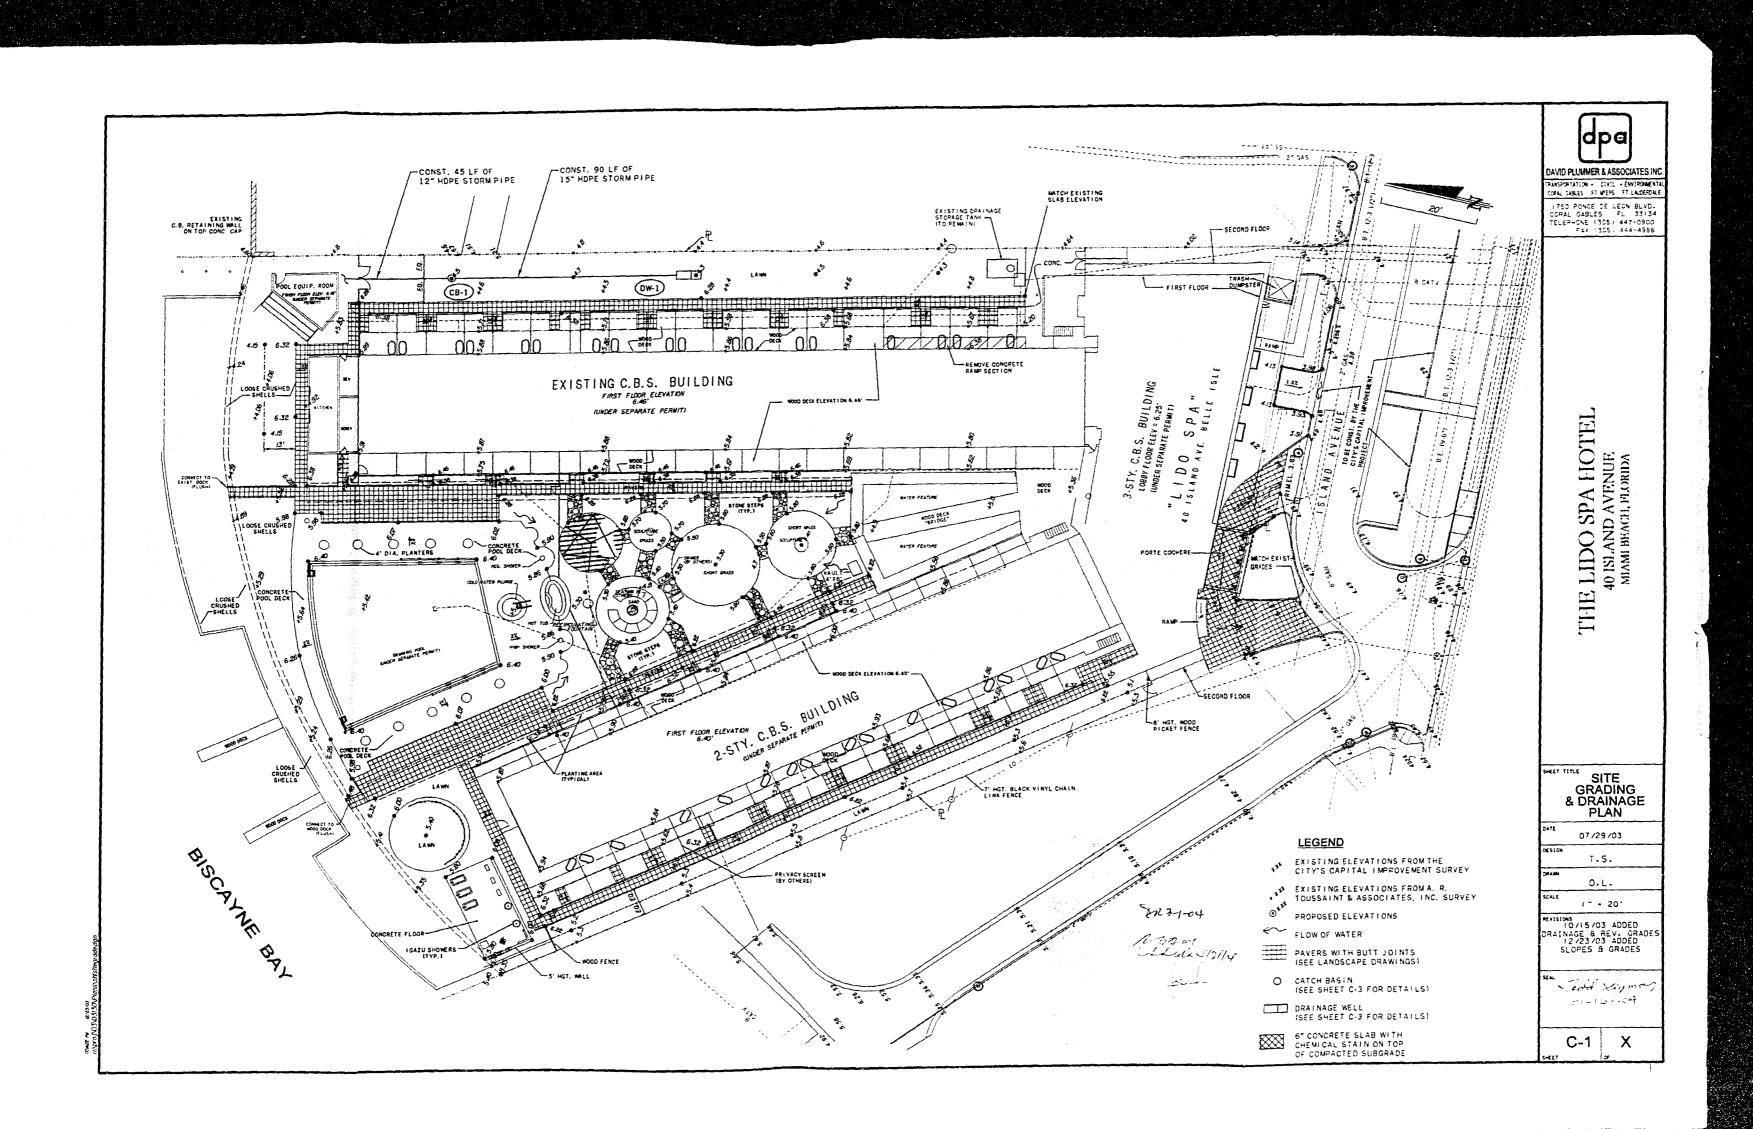


## CATCH BASIN AND DRAINAGE WELL NOTES:

- 1. CONCRETE SHALL BE 1'c 4000 PSI AT 28 DAYS. TYPE II CEMENT
- WALLS TO BE CONSTRUCTED OF REINFORCED CONCRETE. CONCRETE MAY BE EITHER CAST-IN-PLACE OR PRECAST.
- 3. ALL REINFORCING STEEL SHALL BE NEW BARS IN ACCORDANCE WITH ASTM A-615 GRADE 60.
- MANHOLE TOP SHALL BE SECURED TO STRUCTURE WITH A MINIMUM OF 6 NO. 5 BARS 12" LONG OR AS SHOWN IN THE SUPPLEMENTARY DETAILS FOR MANHOLES & INLETS.
- ALL STEEL BARS HAVE 3" MINIMUM COVER UNLESS OTHERWISE SHOWN AND SHALL BE HOOKED WHERE INDICATED. HORIZONTAL STEEL SHALL BE LAPPED A MINIMUM OF 24 BAR DIAMETERS AT CORNERS. FLOOR SLABS MAY BE SECURED TO STRUCTURE WALLS BY NO. 5 DOWEL BARS (A MINIMUM OF 6 DOWELS) PUSHED INTO THE WET CONCRETE AFTER THE FLOOR SLAB IS PLACED.
- FOR SUPPLEMENTARY DETAILS, SEE MANHOLES & INLETS DETAIL. FOOT INDEX 200. 201 & 214.
- CATCH BASINS SHALL HAVE A MINIMUM INSIDE DIAMETER OF 42" WITH 6" THICK WALLS,
- ALL EXISTING AND NEW INLETS AND MANHOLES SHALL BE CLEANED AND FREE OF ALL SAND, SILT AND CONSTRUCTION DEBRIS PRIOR TO PROJECT COMPLETION.
- A CERTIFIED WELL DRILLER SHALL DEVELOP THE WELL TO A DEPTH AT WHICH THE WATER CONTAINS A MINIMUM OF 10.000 PPM OF TOTAL DISSOLVED SOLIDS AND 1500 PPM OF CHLORIDES.

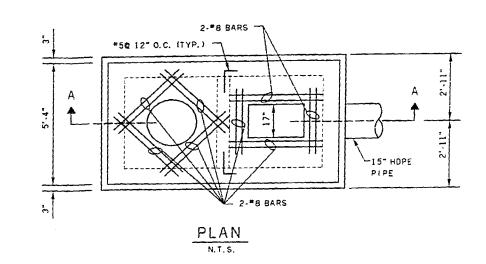

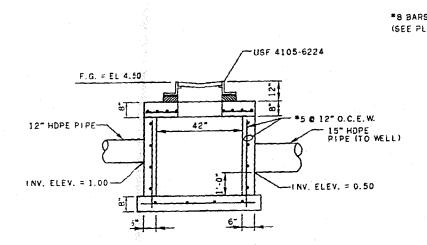

CATCH BASIN CB-1 DETAIL

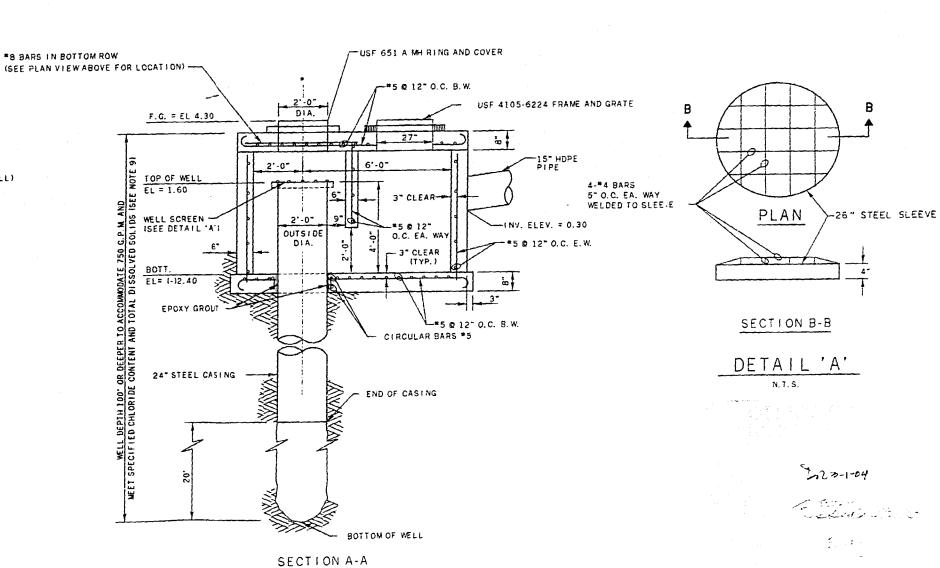

DRAINAGE WELL DW-1 DETAIL



DAVID PLUMMER & ASSOCIATES, I

1750 PONCE DE LEON BLVD. CORAL GABLES PL 33134 TELEPHONE (305) 447-0900 FAX (305) 444-4986

THE LIDO SPA HOTEL 40 ISLAND AVENUE MIAMI BEACH, PLORIDA

DRAINAGE DETAILS

10/13/03 T.S. N.T.S.

Told Lumon 01-16-04

C-3 X

2000000 ANE TERMIN WE

# **tyco** Fire & Building Products

Technical Services: Tel: (800) 381-9312 / Fax: (800) 791-5500

## Series TY-FRB — 5.6 K-factor Horizontal and Vertical Sidewall Sprinklers Quick Response, Standard Coverage

## General Description

The Series TY-FRB, 5.6 K-Factor, Horizontal and Vertical Sidewall Sprinklers described in this data sheet are quick response - standard coverage, decorative 3 mm glass bulb type spray sprinklers designed for use in light and ordinary hazard, commercial occupancies such as banks, hotels, shopping malls, etc. They are designed for installation along a wall or the side of a beam and just beneath a smooth ceiling. Sidewall sprinklers are commonly used instead of pendent or upright sprinklers due to aesthetics or building construction considerations, where piping across the ceiling is not desirable.

The recessed version of the Series TY-FRB Horizontal Sidewall Sprinkler is intended for use in areas with a finished wall. It uses a two-piece Style 10 Recessed Escutcheon with 1/2 inch (12,7 mm) of recessed adjustment or up to 3/4 inch (19,1 mm) of total adjustment from the flush sidewall position, or a two-piece Style 20 Recessed Escutcheon with 1/4 inch (6,4 mm) of recessed adjustment or up to 1/2 inch (12,7 mm) of total adjustment from the flush sidewall position. The adjust-

### **IMPORTANT**

Always rafer to Technical Data Sheet TFP700 for the "INSTALLER WARNING" that provides cautions with respect to handling and installation of sprinkler systems and components. Improper handling and installation can permanently damage a sprinkler system or its components and cause the sprinkler to fall to operate in a fire situation or cause it to operate prematurely.

ment provided by the Recessed Escutcheon reduces the accuracy to which the fixed pipe nipples to the sprinklers must be cut.

Corrosion resistant coatings, where applicable, are utilized to extend the life of copper alloy sprinklers beyond that which would otherwise be obtained when exposed to corrosive atmospheres. Although corrosion resistant coated sprinklers have passed the standard corrosion tests of the applicable approval agencies, the testing is not representative of all possible corrosive atmospheres. Consequently, it is recommended that the end user be consulted with respect to the suitability of these coatings for any given corrosive environment. The effects of ambient temperature, concentration of chemicals, and gas/chemical velocity, should be considered, as a minimum, along with the corrosive nature of the chemical to which the sprinklers will be exposed.


#### WARNINGS

The Series TY-FRB Sprinklers described herein must be installed and maintained in compliance with this document, as well as with the applicable standards of the National Fire Protection Association, in addition to the standards of any other authorities having jurisdiction. Failure to do so may impair the performance of these devices

The owner is responsible for maintaining their fire protection system and devices in proper operating condition. The installing contractor or sprinkler manufacturer should be contacted with any questions.

## Model/Sprinkler Identification Numbers

TY3331 - Horizontal TY3431 - Vertical

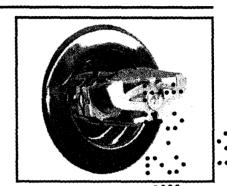



## Technical Data

Approvals
UL and C-UL Listed.
FM, LPCB, and NYC Approved.
(Refer to Table A for complete approval information including corrosion resistant status.)

Maximum Working Pressure Refer to Table B.

Discharge Coefficient K = 5.6 GPM/psi<sup>1/2</sup> (80,6 LPM/bar<sup>1/2</sup>)

Temperature Ratings Refer to Table A.

Finishes
Sprinkler: Refer to Table A.
Recessed Escutcheon: White Coated,
Chrome Plated, or Brass Plated.

į	_					SPRINKLER F	INISH (See Note 11)	
κ	TYPE	ТЕМР.	BULB	NATURAL BRASS	CHROME PLATED	WHITE*** POLYESTER	LEAD COATED	
		135°F/57°C	Orange					
	HORIZ.	155°F/68°C	Red	422	<i>4</i> 0 10	1 2 2 2 2	1, 2, 3, 9	
	(TY3331)	175°F/79°C	Yellow	1, 2, 3,	4, 9, 10	1, 2, 3, 9	1, 2, 3, 9	1
		200°F/93°C	Green					}
5.6 1/2"		286°F/141°C	Blue	}				
NPT	RECESSED	135°F/57°C	Orange					
	HORIZ.	155°F/68°C	Red	124	1, 9, 10	1, 2, 9	N/A	- (
	(TY3331)*	175°F/79°C	Yellow	,, 2, 7		1, 2, 3	NA	1
	Figure 3	200°F/93°C	Green					
}	RECESSED	135°F/57°C	Orange					
	HORIZ.	155°F/68°C	Red	]	1, 2, 3, 4, 9		N/A	
	(TY3331)**	175°F/79°C	Yellow		1, 2, 3, 4, 3		ŅA	1
	Figure 4	200°F/93°C	Green	1			••••	•
	VERTICAL	135°F/57°C	Orange				•• •	
	SIDEWALL (TY3431)	155°F/68°C	Red	1			5670	` [
5.6 1/2"	Installed	175°F/79°C	Yellow	1	5, 6, 7, 8, 9		5, 6, 7, 9	ſ
NPT	Pendent	200°F/93°C	Green	1				•
	or Upright	286°F/141°C	Blue	1			••••	

### NOTES:

- 1. Listed by Underwriters Laboratories, Inc. (UL) as Quick Response Sprinklers for use in Light and Ordinary Hazard Occupancies at a 4 to 12 inch (100 to 300 mm) top of deflector to ceiling distance.
- 2. Listed by Underwriters Laboratories Inc. for use in Canada (C-UL) as Quick Response Sprinklers for use in Light and Ordinary Hazard Occupancies at a 4 to 12 inch (100 to 300 mm) top of deflector to ceiling distance.
- 3. Approved by Factory Mutual Research Corporation (FM) as Quick Response Sprinklers for use in Light Hazard Occupancies at a
- 4 to 12 inch (100 to 300 mm) top of deflector to ceiling distance.

  4. Approved by the Loss Prevention Certification Board (LPCB Ref. No. 007a/04) at a 4 to 6 inch (100 to 150 mm) top of deflector to ceiling distance. The LPC does not rate the thermal sensitivity of horizontal sidewall sprinklers.
- 5. Listed by Underwriters Laboratories, Inc. as Quick Response Sprinklers for use in Light and Ordinary Hazard Occupancies.
- 6. Listed by Underwriters Laboratories for use in Canada (C-UL) as Quick Response Sprinklers for use in Light and Ordinary Hazard Occupancies.
- 7. Approved by Factory Mutual Research Corporation (FM) as Quick Response Sprinklers for use in Light Hazard Occupancies.
- 8. Approved by the Loss Prevention Certification Board (LPCB Ref. No. 094a/06 & 007a/04) as Quick Response Sprinklers.
- 9. Approved by the City of New York under MEA 354-01-E.
- 10. Approved by the Loss Prevention Certification Board (LPCB Ref. No. 094a/06) at a 4 to 6 inch (100 to 150 mm) top of deflector to ceiling distance. The LPC does not rate the thermal sensitivity of horizontal sidewall sprinklers.
- 11. Where Polyester Coated and Lead Coated Sprinklers are noted to be UL and C-UL Listed, the sprinklers are UL and C-UL Listed as Corrosion Resistant Sprinklers. Where Lead Coated Sprinklers are noted to be FM Approved, the sprinklers are FM Approved as Corrosion Resistant Sprinklers.
- \* Installed with Style 10 (1/2" NPT) 3/4" Total Adjustment Recessed Escutcheon.
  \*\* Installed with Style 20 (1/2" NPT) 1/2" Total Adjustment Recessed Escutcheon.
- \*\*\* Frame and deflector only. Listings and approvals apply to color (Special Order).

#### TABLE A LABORATORY LISTINGS AND APPROVALS

#### **Physical Characteristics** Frame . . . . . . . . . . Bronze Button . . . . . . Brass/Copper Sealing Assembly . . . . . . . . . . . . Beryllium Nickel w/Teflon† Bulb . . . . . . . . . . . . Glass Compression Screw . . . . Bronze HSW Deflector . . . . . . . Bronze VSW Deflector . . . . . . Copper **Patents** U.S.A. 5,810,263

## **Operation**


The glass Bulb contains a fluid which expands when exposed to heat. When the rated temperature is reached, the fluid expands sufficiently to shatter the glass Bulb, allowing the sprinkler to activate and water to flow.

				SPRINI	KLER FINISH
К	ТҮРЕ	NATURAL BRASS	CHROME PLATED	WHITE POLYESTER	LEAD COATED
~	HORIZONTAL SIDEWALL (TY3331)	j	0 PSI (17,2 B OR 5 PSI (12,1 B		175 PSI (12,1 BAR)
5.6 1/2"	RECESSED HORIZ. SIDEWALL (TY3331)		(SEE NOTE		N/A
NPT -	VERTICAL SIDEWALL (TY3431)			175 P	SI (12,1 BAR)

## TABLE B, MAXIMUM WORKING PRESSURE

# Design Criteria

The Series TY-FRB Horizontal and Vertical Sidewall Sprinklers are intended for fire protection systems designed in accordance with the standard installation rules recognized by the applicable Listing or Approval agency (e.g., UL Listing is based on the requirements of NFPA 13, and FM Approval is based on the requirements of FM's Loss Prevention Data Sheets). Only the Style 10 or 20 Recessed Escutcheon, as applicable, is to be used for recessed horizontal installations.

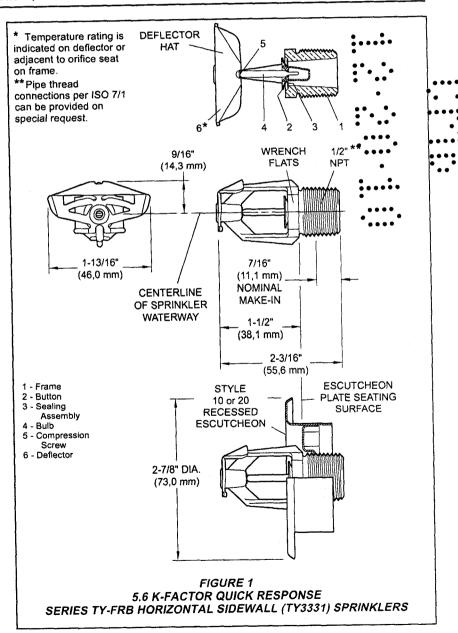

<sup>1.</sup> The maximum working pressure of 250 psi (17,2 bar) only applies to the Listing by Underwriters Laboratories, Inc. (UL); the Listing by Underwriters Laboratories, Inc. for use in Canada (C-UL); and, the Approval by the City of New York.

## Installation

The Series TY-FRB Sprinklers must be installed in accordance with the following instructions:

#### **NOTES**

Do not install any bulb type sprinkler if the bulb is cracked or there is a loss of liquid from the bulb. With the sprinkler held horizontally, a small air bubble should be present. The diameter of the air bubble is approximately 1/16 inch (1,6 mm) for the 135°F/57°C to 3/32 inch (2,4 mm) for the 286°F/141°C temperature ratings.

A leak tight 1/2 inch NPT sprinkler joint should be obtained with a torque of 7 to 14 ft.lbs. (9,5 to 19,0 Nm). A maximum of 21 ft. lbs. (28,5 Nm) of torque may be used to install sprinklers with 1/2 NPT connections. Higher levels of torque may distort the sprinkler and cause leakage or impairment of the sprinkler.

Do not attempt to make-up for insufficient adjustment in the escutcheon plate by under- or over-tightening the sprinkler. Readjust the position of the sprinkler fitting to suit.

The Series TY-FRB Horizontal and Vertical Sidewall Sprinklers must be installed in accordance with the following instructions.

Step 1. Horizontal sidewall sprinklers are to be installed in the horizontal position with their centerline of waterway perpendicular to the back wall and parallel to the ceiling. The word "TOP" on the Deflector is to face towards the ceiling.


Vertical sidewall sprinklers are to be installed in the pendent or upright position with the arrow on the Deflector pointing away from the wall.

Step 2. With pipe thread sealant applied to the pipe threads, hand tighten the sprinkler into the sprinkler fitting.

Step 3. Tighten the sprinkler into the sprinkler fitting using only the W-Type 6 Sprinkler Wrench (Ref. Figure 5), With reference to Figure 1 or 2, the W-Type 6 Sprinkler Wrench is to be applied to the wrench flats.

The Series TY-FRB Recessed Horizontal Sidewall Sprinklers must be installed in accordance with the following instructions.

Step A. Recessed horizontal sidewall sprinklers are to be installed in the horizontal position with their centerline of waterway perpendicular to the back wall and parallel to the ceiling. The word "TOP" on the Deflector is to face towards the ceiling.

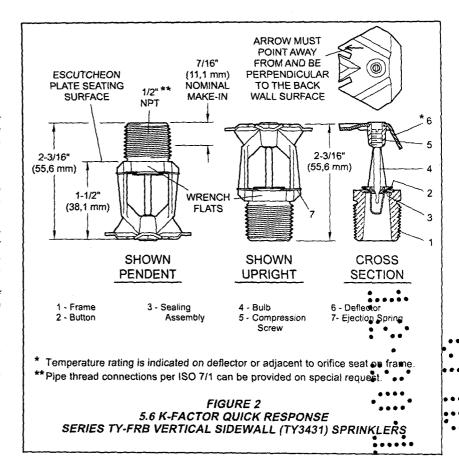

**Step B.** After installing the Style 10 or 20 Mounting Plate over the sprinkler threads, hand tighten the sprinkler into the sprinkler fitting.

Step C. Tighten the sprinkler into the sprinkler fitting using only the W-Type 7 Recessed Sprinkler Wrench (Ref. Figure 6). With reference to Figure 1, the W-Type 7 Recessed Sprinkler Wrench is to be applied to the sprinkler wrench flats.

**Step D.** After the ceiling has been installed or the finish coat has been applied, slide on the Style 10 or 20 Closure over the Series TY-FRB Sprinkler and push the Closure over the Mounting Plate until its flange comes in contact with the ceiling

## Care and Maintenance

The Series TY-BFR Sprinklers must be maintained and serviced in accordance with the following instructions:


#### **NOTES**


Before closing a fire protection system main control valve for maintenance work on the fire protection system that it controls, permission to shut down the affected fire protection system must be obtained from the proper authorities and all personnel who may be affected by this action must be notified


The owner must assure that the sprinklers are not used for hanging of any objects; otherwise, non-operation in the event of a fire or inadvertent operation may result.


Absence of an escutcheon, which is used to cover a clearance hole, may delay the time to sprinkler operation in a fire situation.

Sprinklers that are found to be leaking or exhibiting visible signs of corrosion

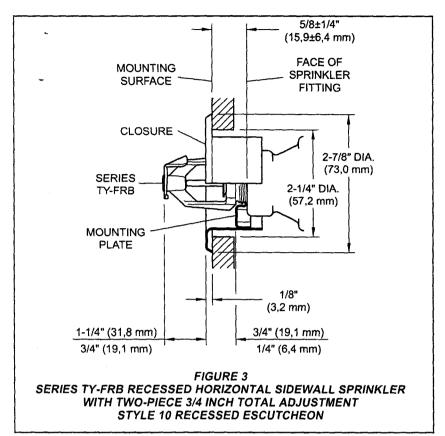

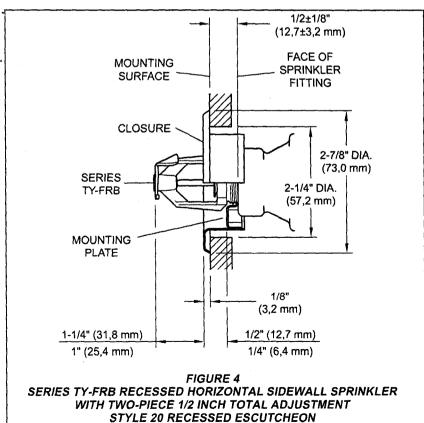

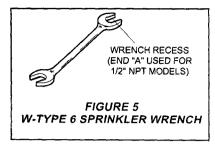

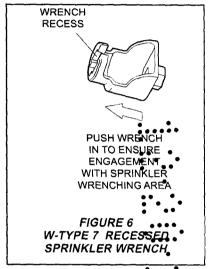

must be replaced.

Automatic sprinklers must never be painted, plated, coated or otherwise altered after leaving the factory. Modified sprinklers must be replaced. Sprinklers that have been exposed to corrosive products of combustion, but have not operated, should be replaced if they cannot be completely cleaned by wiping the sprinkler with a cloth or by brushing it with a soft bristle brush.

Care must be exercised to avoid damage to the sprinklers - before, during, and after installation. Sprinklers damaged by dropping, striking, wrench twist/slippage, or the like, must be replaced. Also, replace any sprinkler that has a cracked bulb or that has lost liquid from its bulb. (Ref. Installation Section).

Frequent visual inspections are recommended to be initially performed for corrosion resistant coated sprinklers, after the installation has been completed, to verify the integrity of the corrosion resistant coating. Thereafter, annual inspections per NFPA 25 should suffice; however, instead of inspecting from the floor level, a random sampling of close-up visual inspections should be made, so as to better determine the exact sprinkler condition and the long term integrity of the

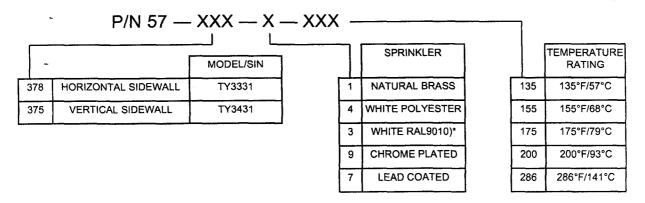


TABLE C \* Eastern Hemisphere sales only.

PART NUMBER SELECTION

SERIES TY-FRB HORIZONTAL AND VERTICAL SIDEWALL SPRINKLERS

corrosion resistant coating, as it may be affected by the corrosive conditions present.

The owner is responsible for the inspection, testing, and maintenance of their fire protection system and devices in compliance with this document, as well as with the applicable standards of the National Fire Protection Association (e.g., NFPA 25), in addition to the standards of any other authorities having jurisdiction. The installing contractor or sprinkler manufacturer should be contacted relative to any questions.

It is recommended that automatic sprinkler systems be inspected, tested, and maintained by a qualified Inspection Service in accordance with local requirements and/or national codes.

## Limited Warranty

Products manufactured by Tyco Fire & Building Products (TFBP) are warranted solely to the original Buyer for ten (10) years against defects in material and workmanship when paid for and properly installed and maintained under normal use and service. This warranty will expire ten (10) years from date of shipment by TFBP. No warranty is given for products or components manufactured by companies not affiliated by ownership with TFBP or for products and components which have been subject to misuse, improper installation, corrosion, or which have not been installed, maintained, modified or repaired in accordance with applicable Standards of the National Fire Protection Association, and/or the standards of any other Authorities Having Jurisdiction. Materials found by TFBP to be defective shall be either repaired or replaced, at TFBP's sole option. TFBP neither assumes, nor authorizes any person to assume for it, any other obligation in connection with the sale of products or parts of products. TFBP shall not be responsible for sprinkler system design errors or inaccurate or incomplete information supplied by Buyer or Buyer's representatives.

In no event shall TFBP be liable, in contract, tort, strict liability or under any other legal theory, for incidental, indirect, special or consequential damages, including but not limited to labor charges, regardless of whether TFBP was informed about the possibility of such damages, and in no event shall TFBP's liability exceed an amount equal to the sales price.

The foregoing warranty is made in lieu of any and all other warranties, express or implied, including warranties of merchantability and fitness for a particular purpose.

This limited warranty sets forth the exclusive remedy for claims based on failure of or defect in products, materials or components, whether the claim is made in contract, tort, strict liability or any other legal theory.

This warranty will apply to the full extent permitted by law. The invalidity, in whole or part, of any portion of this warranty will not affect the remainder.

## Ordering Procedure

When placing an order, indicate the full product name. Refer to the Price List for complete listing of Part Numbers.

Contact your local distributor for availability.

## Sprinkler Assemblies with NPT Thread Connections:

Specify: (Specify Model/SIN), Quick Response, (specify K-factor), (specify temperature rating), Series TY-FRB (specify Horizontal Sidewall or Vertical Sidewall) Sprinkler with (specify type of finish or coating), P/N (specify from Table C).

#### Recessed Escutcheon:

Specify: Style (10 or 20) Recessed Escutcheon with (specify\*) finish, P/N (specify\*).

\* Refer to Technical Data Sheet TFP770.

### Sprinkler Wrench:

Specify: W-Type 6 Sprinkler Wrench, P/N 56-000-6-387.

Specify: W-Type 7 Sprinkler Wrench, P/N 56-850-4-001.

# **THEO** Fire Suppression & Building Products

Technical Services 800-381-9312 | +1-401-781-8220 www.tyco-fire.com

## Series TY-FRB — 2.8, 4.2, 5.6, and 8.0 K-Factor Upright, Pendent, and Recessed Pendent Sprinklers Quick Response, Standard Coverage

## General Description

The TYCO Series TY-FRB, 2.8, 4.2, 5.6, and 8.0 K-factor, Upright and Pendent Sprinklers described in this data sheet are quick response, standard coverage, decorative 3 mm glass bulb-type spray sprinklers designed for use in light or ordinary hazard, commercial occupancies such as banks, hotels, and shopping malls.

The recessed version of the Series TY-FRB Pendent Sprinkler, where applicable, is intended for use in areas with a finished ceiling. This recessed pendent sprinkler uses one of the following,

- A two-piece Style 10 (1/2 inch NPT) or Style 40 (3/4 inch NPT) Recessed Escutcheon with 1/2 inch (12,7 mm) of recessed adjustment or up to 3/4 inch (19,1 mm) of total adjustment from the flush pendent position, or a
- A two-piece Style 20 (1/2 inch NPT) or Style 30 (3/4 inch NPT) Recessed Escutcheon with 1/4 inch (6,4 mm) of recessed adjustment or up to 1/2 inch (12,7 mm) of total adjustment from the flush pendent position.

The adjustment provided by the Recessed Escutcheon reduces the accuracy to which the fixed pipe drops to the sprinklers must be cut.

#### **IMPORTANT**

Always refer to Technical Data Sheet TFP700 for the "INSTALLER WARNING" that provides cautions with respect to handling and installation of sprinkler systems and components. Improper handling and installation can permanently damage a sprinkler system or its components and cause the sprinkler to fail to operate in a fire situation or cause it to operate prematurely.


Corrosion-resistant coatings, where applicable, are utilized to extend the life of copper alloy sprinklers beyond that which would otherwise be obtained when exposed to corrosive atmospheres. Although corrosion-resistant coated sprinklers have passed the standard corrosion tests of the applicable approval agencies, the testing is not representative of all possible corrosive atmospheres. Consequently, it is recommended that the end user be consulted with respect to the suitability of these coatings for any given corrosive environment. The effects of ambient temperature, concentration of chemicals, and gas/chemical velocity, should be considered, as a minimum, along with the corrosive nature of the chemical to which the sprinklers will be exposed.


An intermediate level of the Series TY-FRB Pendent Sprinklers is detailed in Technical Data Sheet TFP356, and Sprinkler Guards are detailed in Technical Data Sheet TFP780.

### NOTICE

The Series TY-FRB Concealed Pendent Sprinklers described herein must be installed and maintained in compliance with this document and with the applicable standards of the National Fire Protection Association, in addition to the standards of any authorities having jurisdiction. Failure to do so may impair the performance of these devices.


Owners are responsible for maintaining their fire protection system and devices in proper operating condition. The installing contractor or sprinkler manufacturer should be contacted with any questions.

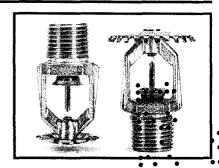


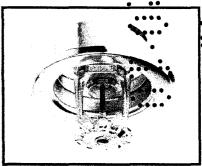



## Model/Sprinkler Identification Number (SIN)


	•	-
TY1131:	Upright	2.8K, 1/2" NPT
TY1231:	Pendent	2.8K, 1/2" NPT
TY2131:	Upright	4.2K, 1/2" NPT
TY2231:	Pendent	4.2K, 1/2" NPT
TY3131:	Upright	5.6K, 1/2" NPT
TY3231:	Pendent	5.6K, 1/2" NPT
TY4131:	Upright	8.0K, 3/4" NPT
TY4231:	Pendent	8.0K, 3/4" NPT
TY4831:	Upright	8.0K, 1/2" NPT
TY4931:	Pendent	8.0K, 1/2" NPT

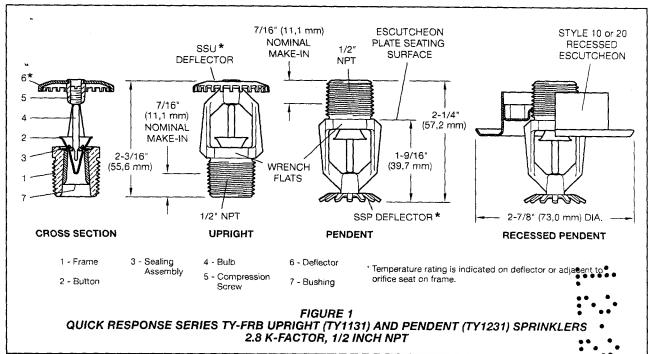

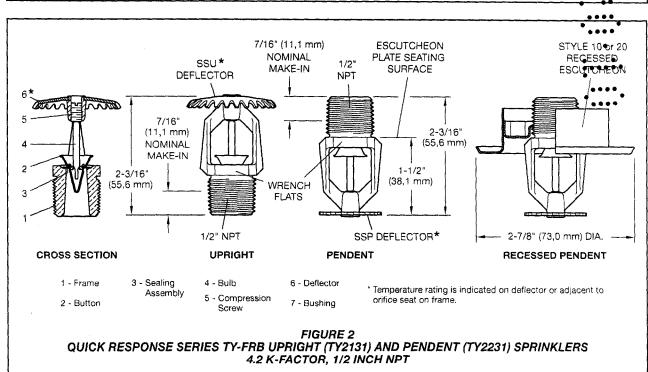

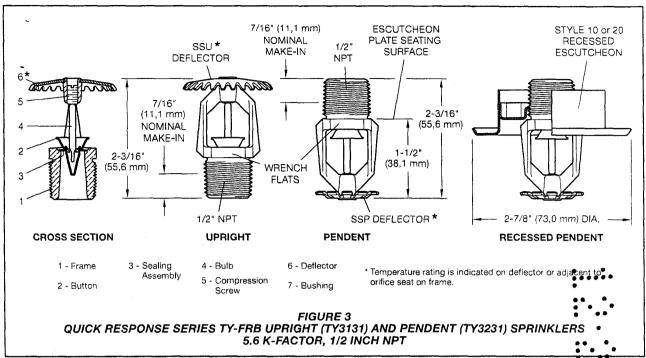

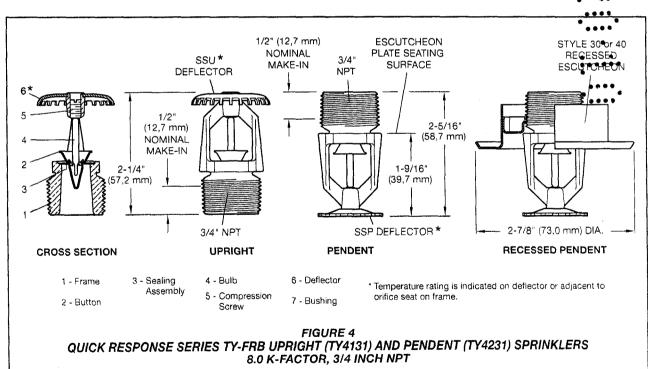

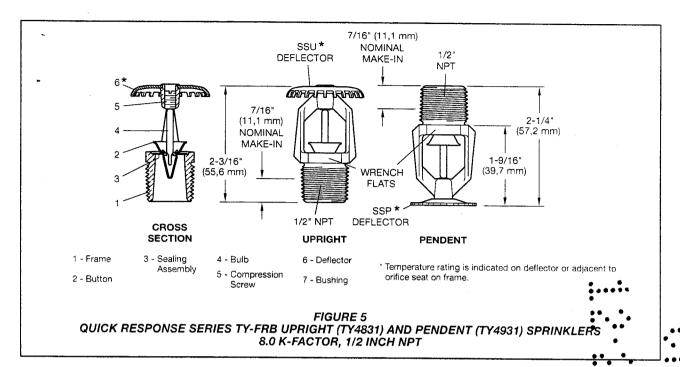

## Technical Data

#### Approvals

UL and C-UL Listed FM, LPCB, and NYC Approved Refer to Table A and B for complete approval information including corrosion-resistant status.

#### Maximum Working Pressure Refer to Table C.

#### **Discharge Coefficient**

K=2.8 GPM/psi<sup>1/2</sup> (40,3 LPM/bar<sup>1/2</sup>) K=4.2 GPM/psi<sup>1/2</sup> (60,5 LPM/bar<sup>1/2</sup>) K=5.6 GPM/psi<sup>1/2</sup> (80,6 LPM/bar<sup>1/2</sup>) K=8.0 GPM/psi<sup>1/2</sup> (115,2 LPM/bar<sup>1/2</sup>)

#### Temperature Rating Refer to Table A and B.

#### **Finishes**

Sprinkler: Refer to Table A and B. Recessed Escutcheon: White Coated, Chrome Plated, or Brass Plated.

#### **Physical Characteristics**

Frame	Bronze
Button	
Sealing Assembly	
9	Nickel w/Teflont
Bulb	
Compression Screw.	Bronze
Deflector	. Copper/Bronze
Bushing (K=2.8)	

## **Operation**

The glass Bulb contains a fluid that expands when exposed to heat. When the rated temperature is reached, the fluid expands sufficiently to shatter the glass Bulb, allowing the sprinkler to activate and water to flow.

## Design Criteria

The TYCO Series TY-FRB Pendent and Upright Sprinklers are intended for fire protection systems designed in accordance with the standard installation rules recognized by the applicable Listing or Approval agency (such as, UL Listing is based on the requirements of NFPA 13, and FM Approval is based on the requirements of FM's Loss Prevention Data Sheets). Only the Style 10, 20, 30, or 40 Recessed Escutcheon, as applicable, is to be used for recessed pendent installations.

## Installation

The TYCO Series TY-FRB Sprinklers must be installed in accordance with the following instructions.

### NOTICE

Do not install any bulb-type sprinkler if the bulb is cracked or there is a loss of liquid from the bulb. With the sprinkler held horizontally, a small air bubble should be present. The diameter of the air bubble is approximately 1/16 inch (1,6 mm) for the 135°F/57°C and 3/32 inch (2,4 mm) for the 286°F/141°C temperature ratings.

Obtain a leak-tight 1/2 inch NPT sprinkler joint by applying a minimum to maximum torque of 7 to 14 ft.lbs. (9,5 to 19,0 Nm). Higher levels of torque can distort the sprinkler Inles with consequent leakage or impairment of the sprinkler.

Do not attempt to compensate for insufficient adjustment in the Escutcheon Plate by under- or over-tightening the sprinkler. Re-adjust the position of the sprinkler fitting to suit.

The Series TY-FRB Pendent and Upright Sprinklers must be installed in accordance with the following instructions.

- Install Pendent sprinklers in the pendent position. Install upright sprinklers in the upright position.
- 2. With pipe-thread sealant applied to the pipe threads, hand-tighten the sprinkler into the sprinkler fitting.
- Tighten the sprinkler into the sprinkler fitting using only the W-Type 6
   Sprinkler Wrench (Figure 14). With reference to Figures 1 through 5, apply the W-Type 6 Sprinkler Wrench to the sprinkler wrench flats

	T	-	SPRINKLER FINISH (See Note 5)					
FACTOR	TYPE	TEMPERATURE	BULB LIQUID COLOR	NATURAL BRASS	CHROME PLATED	WHITE*** POLYESTER		
		135°F/57°C	Orange		<u> </u>			
	PENDENT (TY1231)	155°F/68°C	Red					
	and UPRIGHT	175°F/79°C	Yellow	1, 2, 3, 4				
	(TY1131)	200°F/93°C	Green					
		286°F/141°C	Blue					
2.8	RECESSED	135°F/57°C	Orange					
1/2" NPT	PENDENT	155°F/68°C	Red					
	(TY1231)* Figure 6	175°F/79°C	Yellow					
		200°F/93°C	Green					
	RECESSED PENDENT (TY1231)** Figure 7	135°F/57°C	Orange		1, 2, 4			
		155°F/68°C	Red					
i		175°F/79°C	Yellow			:		
		200°F/93°C	Green			•		
	PENDENT (TY2231) and UPRIGHT (TY2131)	135°F/57°C	Orange					
		155°F/68°C	Red			•		
		175°F/79°C	Yellow			••.		
		200°F/93°C	Green			• • •		
		286°F/141°C	Blue			.***.		
	RECESSED PENDENT (TY2231)* Figure 8	135°F/57°C	Orange			••••		
4.2 1/2" NPT		155°F/68°C	Red		•			
		175°F/79°C	Yellow		1, 2	• • • •		
		200°F/93°C	Green			••••		
	RECESSED PENDENT (TY2231)**	135°F/57°C	Orange			•••••		
		155°F/68°C	Red					
		175°F/79°C	Yellow					
ļ	Figure 9	200°F/93°C	Green					



- NOTES:
  1. Listed by Underwriters Laboratories, Inc., (UL) as Quick Response Sprinklers.
  2. Listed by Underwriters Laboratories, Inc., for use in Canada (C-UL) as Quick Response Sprinklers.
- 3. Approved by Factory Mutual Research Corporation (FM) as Quick Response Sprinklers.
- 4. Approved by the City of New York under MEA 354-01-E.
- Where Polyester Coated Sprinklers are noted to be UL and C-UL Listed, the sprinklers are UL and C-UL Listed as Corrosion-Resistant Sprinklers.
- \* Installed with Style 10 (1/2" NPT) or Style 40 (3/4" NPT) 3/4" Total Adjustment Recessed Escutcheon, as applicable.
- \*\* Installed with Style 20 (1/2" NPT) or Style 30 (3/4" NPT) 1/2" Total Adjustment Recessed Escutcheon, as applicable.
- \*\*\* Frame and Deflector only. Listings and approvals apply to color (Special Order).

N/A: Not Available

TABLE A LABORATORY LISTINGS AND APPROVALS FOR 2.8 AND 4.2 K-FACTOR SPRINKLERS

	<u> </u>		SPRINKLER FINISH (See Note 8)					
K FACTOR	TYPE	TEMPERATURE	BULB LIQUID COLOR	NATURAL BRASS	CHROME PLATED	WHITE*** POLYESTER	LEAD COATED	
		135°F/57°C	Orange			<u></u>		
	PENDENT (TY3231)	155°F/68°C	Red					
	and	175°F/79°C	Yellow		1, 2, 3, 4, 5, 6,	7	1, 2, 3, 5	
	UPRIGHT (TY3131)	200°F/93°C	Green					
	(	286°F/141°C	Blue					
		135°F/57°C	Orange					
	RECESSED	155°F/68°C	Red					
5.6 1/2" NPT	PENDENT (TY3231)*	175°F/79°C	Yellow		1, 2, 4, 5		N/A	
.,	Figure 10	200°F/93°C	Green					
	L	286°F/141°C	Blue				<u> </u>	
		135°F/57°C	Orange					
	RECESSED	155°F/68°C	Red					
	PENDENT (TY3231)**	175°F/79°C	Yellow		1, 2, 3, 4, 5		N/A	
	Figure 11	200°F/93°C	Green					
		286°F/141°C	Blue					
		135°F/57°C	Orange	1, 2, 3, 4, 5, 6, 7				
	PENDENT (TY4231)	155°F/68°C	Red					
	and	175°F/79°C	Yellow			1, 2, 5		
	UPRIGHT (TY4131)	200°F/93°C	Green			••		
		286°F/141°C	Blue				:	
	RECESSED PENDENT (TY4231)* Figure 12	135°F/57°C	Orange	1, 2, 5		•		
		155°F/68°C	Red			•• •		
8.0 3/4" NPT		175°F/79°C	Yellow			N/A		
U/# INF I		200°F/93°C	Green			••••		
		286°F/141°C	Blue				*****	
		135°F/57°C	Orange	1, 2, 3, 5		•		
	RECESSED PENDENT (TY4231)** Figure 13	155°F/68°C	Red					
		175°F/79°C	Yellow			N/A		
8.0 1/2" NPT		200°F/93°C	Green			••••		
		286°F/141°C	Blue			•••••		
		135°F/57°C	Orange	1, 2, 4, 5, 6				
	PENDENT (TY4931)	155°F/68°C	Red					
	and UPRIGHT (TY4831)	175°F/79°C	Yellow			1, 2, 5		
		200°F/93°C	Green					
		286°F/141°C	Blue					

- Listed by Underwriters Laboratories, Inc., (UL) as Quick Response Sprinklers.
   Listed by Underwriters Laboratories, Inc., for use in Canada (C-UL) as Quick Response Sprinklers.
   Approved by Factory Mutual Research Corporation (FM) as Quick Response Sprinklers.
   Approved by the Loss Prevention Certification Board (LPCB Ref. No. 007k/04) as Quick Response Sprinklers. However, LPCB does not rate the thermal sensitivity of recessed sprinklers.
   Approved by the City of New York under MEA 354-01-E.
- VdS Approved (For details, contact Tyco Fire Suppression & Building Products, Enschede, Netherlands, Tel. 31-53-428-4444/Fax 31-53-428-3377.)
- Approved by the Loss Prevention Certification Board (LPCB Ref. No. 094a/06) as Quick Response Sprinklers.
- Where Polyester Coated and Lead-Coated Sprinklers are noted to be UL and C-UL Listed, the sprinklers are UL and C-UL Listed as Corrosion-Resistant Sprinklers. Where Lead-Coated Sprinklers are noted to be FM Approved, the sprinklers are FM Approved as a Corrosion-Resistant Sprinklers.
- \* Installed with Style 10 (1/2" NPT) or Style 40 (3/4" NPT) 3/4" Total Adjustment Recessed Escutcheon, as applicable.
  \*\* Installed with Style 20 (1/2" NPT) or Style 30 (3/4" NPT) 1/2" Total Adjustment Recessed Escutcheon, as applicable.
- \*\*\* Frame and Deflector only. Listings and approvals apply to color (Special Order).

N/A: Not Available

TABLE B LABORATORY LISTINGS AND APPROVALS FOR 5.6 AND 8.0 K-FACTOR SPRINKLERS

		SPRINKLER FINISH				
K FACTOR	TYPE	NATURAL BRASS	CHROME PLATED	WHITE POLYESTER	LEAD COATED	
2.8	PENDENT (TY1231) and UPRIGHT (TY1131)		N/A			
1/2" NPT	RECESSED PENDENT (TY1231)	٠	N/A			
4.2	PENDENT (TY2231) and UPRIGHT (TY2131)		175 PSI (12,1 BAR)			
1/2" NPT	RECESSED PENDENT (TY2231)		N/A			
5.6	PENDENT (TY3231) and UPRIGHT (TY3131)	250 PSI (17,2 BAR) OR 175 PSI (12,1 BAR) (SEE NOTE 1)			175 PSI (12,1 BAR)	
1/2" NPT	RECESSED PENDENT (TY3231)				N/A	
8.0	PENDENT (TY4231) and UPRIGHT (TY4131)  175 PSI (12,1 BAR)		3)	175 PSI (12,1 BAR)		
3/4" NPT	RECESSED PENDENT (TY4231)	113 1 31 (12,1 5A1)		N/A		
8.0 1/2" NPT	PENDENT (TY4931) and UPRIGHT (TY4831)	175 PSI (12,1 BAR)		175 PSI (12,1 BAR)		

#### NOTES:

1. The maximum working pressure of 250 psi (17,2 bar) only applies to the Listing by Underwriters Laboratories Inc. (UL); th Listing by Underwriters Laboratories, Inc. for use in Canada (C-UL); and, the Approval by the City of New York.

#### TABLE C MAXIMUM WORKING PRESSURE

The Series TY-FRB Recessed Pendent Sprinklers must be installed in accordance with the following instructions.

- After installing the Style 10, 20, 30, or 40 Mounting Plate, as applicable, over the sprinkler threads and with pipe-thread sealant applied to the pipe threads, hand-tighten the sprinkler into the sprinkler fitting.
- Tighten the sprinkler into the sprinkler fitting using only the W-Type 7
  Recessed Sprinkler Wrench (Figure 15). With reference to Figures 1
  to 4, apply the W-Type 7 Recessed Sprinkler Wrench to the sprinkler wrench flats.
- After ceiling installation and finishing, slide on the Style 10, 20, 30, or 40 Closure over the Series TY-FRB Sprinkler and push the Closure over the Mounting Plate until its flange comes in contact with the ceiling.

## Care and Maintenance

The TYCO Series TY-FRB must be maintained and serviced in accordance with the following instructions.

### NOTICE


Before closing a fire protection system main control valve for maintenance work on the fire protection system that it controls, obtain permission to shut down the affected fire protection systems from the proper authorities and notify all personnel who may be affected by this action.


Absence of the outer piece of an escutcheon, which is used to cover a clearance hole, can delay sprinkler operation in a fire situation.


Exercise care to avoid damage to sprinklers before, during, and after installation. Never paint, plate, coat, or otherwise after automatic sprinklers after they leave the factory.


Replace sprinklers that:

- · were modified or over-heated.
- were damaged by dropping, striking, wrench twisting, wrench slippage, or the like.
- are leaking or exhibiting visible signs of corrosion.
- were exposed to corrosive products of combustion but have not operated, if you cannot easily remove combustion by-products with a cloth.
- have a cracked bulb or have lost liquid from the bulb. Refer to the Installation section in this data sheet.

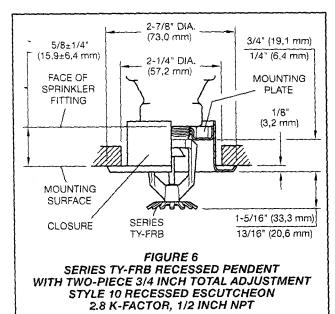

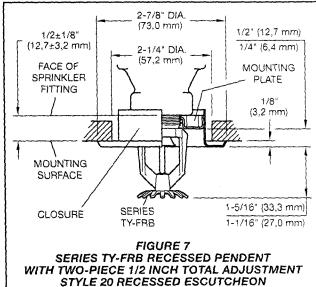

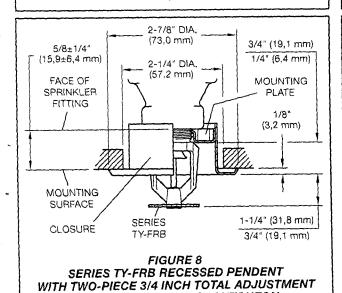

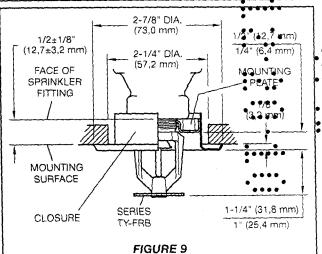

SERIES TY-FRB RECESSED PENDENT

WITH TWO-PIECE 1/2 INCH TOTAL ADJUSTMENT

STYLE 20 RECESSED ESCUTCHEON

4.2 K-FACTOR, 1/2 INCH NPT

2.8 K-FACTOR, 1/2 INCH NPT

Initial and frequent visual inspections of random samples are recommended for corresion-resistant sprinklers to verify nance of the inspections.

random samples are recommended for corrosion-resistant sprinklers to verify the integrity of the corrosion-resistant material of construction. Thereafter, annual inspections per NFPA 25 should suffice.


Inspections of corrosion-resistant sprinklers are recommended at close range, instead of from the floor level per NFPA. Inspection at close range can better determine the exact sprinkler condition and the long-term integrity of the corrosion-resistant material, which can be affected by the corrosive conditions present.

Responsibility lies with the owner for the inspection, testing, and maintenance of their fire protection system and devices in compliance with this document, as well as with the applicable standards of the National Fire Protection Association (for example, NFPA 25), in addition to the standards of any other authorities having jurisdiction. Contact the installing contractor or sprinkler manufacturer regarding any questions.

Automatic sprinkler systems are recommended to be inspected, tested, and maintained by a qualified Inspection Service in accordance with local requirements and/or national codes.

Care must be exercised to avoid damage to the sprinklers -before, during, and after installation. Sprinklers damaged by dropping, striking, wrench twist/slippage, or the like, must be replaced. Also, replace any sprinkler that has a cracked bulb or that has lost liquid from its bulb. (Ref. Installation Section).

Initial and frequent visual inspections of random samples are recommended for corrosion-resistant sprinklers to verify the integrity of the corrosion-resistant material of construction. Thereafter, annual inspections per NFPA 25 should suffice.

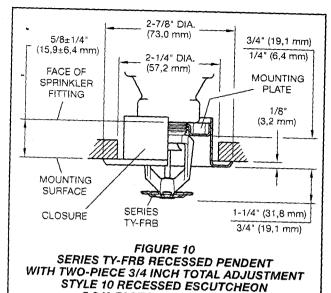


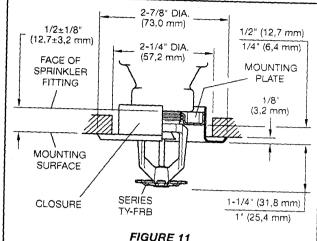


FIGURE 11
SERIES TY-FRB RECESSED PENDENT
WITH TWO-PIECE 1/2 INCH TOTAL ADJUSTMENT
STYLE 20 RECESSED ESCUTCHEON
5.6 K-FACTOR, 1/2 INCH NPT

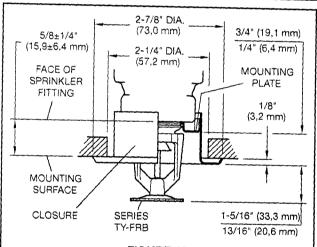

5.6 K-FACTOR, 1/2 INCH NPT

FIGURE 12 SERIES TY-FRB RECESSED PENDENT WITH TWO-PIECE 3/4 INCH TOTAL ADJUSTMENT STYLE 40 RECESSED ESCUTCHEON 8.0 K-FACTOR, 3/4 INCH NPT



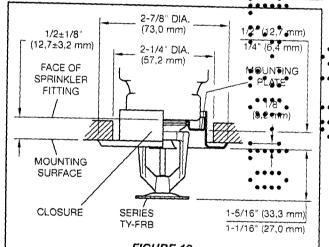


FIGURE 13 SERIES TY-FRB RECESSED PENDENT WITH TWO-PIECE 1/2 INCH TOTAL ADJUSTMENT STYLE 30 RECESSED ESCUTCHEON 8.0 K-FACTOR, 3/4 INCH NPT

Inspections of corrosion-resistant sprinklers are recommended at close range, instead of from the floor level per NFPA. Inspection at close range can better determine the exact sprinkler condition and the long-term integrity of the corrosion-resistant material, which can be affected by the corrosive conditions present.

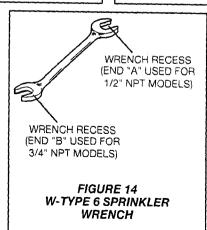

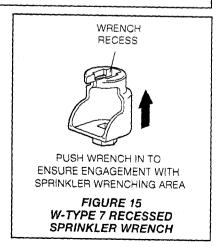

<b></b>	P/N 57 - X	XX - X	- XXX				
		MODEL/SIN		SPRINKLER FINISH			TEMPERATURE RATINGS
330	2.8K UPRIGHT (1/2"NPT)	TY1131	1	NATURAL BRASS		135	135°F (57°C)
331	2.8K PENDENT (1/2"NPT)	TY1231	4	WHITE POLYESTER		155	155°F (68°C)
340	4.2K UPRIGHT (1/2"NPT)	TY2131	3	WHITE (RAL9010)*		175	175°F (79°C)
341	4.2K PENDENT (1/2"NPT)	TY2231	9	CHROME PLATED		200	200°F (93°C)
370	5.6K UPRIGHT (1/2"NPT)	TY3131	7	LEAD COATED		286	286°F (141°C)
371	5.6K PENDENT (1/2"NPT)	TY3231	L	<del> </del>	\$		
390	8.0K UPRIGHT (3/4"NPT)	TY4131					
391	8.0K PENDENT (3/4"NPT)	TY4231					
360	8.0K UPRIGHT (1/2"NPT)	TY4831'	* East	ern Hemisphere sale	s only.		•••••
361	8.0K PENDENT (1/2"NPT)	TY4931*					

## TABLE D PART NUMBER SELECTION SERIES TY-FRB PENDENT AND UPRIGHT SPRINKLERS

## Limited Warranty

Products manufactured by Tyco Fire Suppression & Building Products (TFSBP) are warranted solely to the original Buyer for ten (10) years against defects in material and workmanship when paid for and properly installed and maintained under normal use and service. This warranty will expire ten (10) years from date of shipment by TFSBP. No warranty is given for products or components manufactured by companies not affiliated by ownership with TFSBP or for products and components which have been subject to misuse, improper installation, corrosion, or which have not been installed, maintained, modified or repaired in accordance with applicable Standards of the National Fire Protection Association, and/or the standards of any other Authorities Having Jurisdiction. Materials found by TFSBP to be defective shall be either repaired or replaced, at TFSBP's sole option. TFSBP neither assumes, nor authorizes any person to assume for it, any other obligation in connection with the sale of products or parts of products. TFSBP shall not be responsible for sprinkler system design errors or inaccurate or incomplete information supplied by Buyer or Buyer's representatives.

In no event shall TFSBP be liable, in contract, tort, strict liability or under any other legal theory, for incidental, indirect, special or consequential damages, including but not limited to labor charges, regardless of whether TFSBP was informed about the possibility of such damages, and in no event shall TFSBP's liability exceed an amount equal to the sales price.

The foregoing warranty is made in lieu of any and all other warranties, express or implied, including warranties of merchantability and fitness for a particular purpose.

This limited warranty sets forth the exclusive remedy for claims based on failure of or defect in products, materials or components, whether the claim is made in contract, tort, strict liability or any other legal theory.

This warranty will apply to the full extent permitted by law. The invalidity, in whole or part, of any portion of this warranty will not affect the remainder.

## Ordering Procedure

Contact your local distributor for availability. When placing an order, indicate the full product name and Part Number (P/N).

### Sprinkler Assemblies with NPT Thread Connections

Specify: (Specify Model/SIN), Quick Response, (specify K-factor), (specify temperature rating), Series TY-FRB (specify Pendent or Upright) Sprinkler with (specify type of finish or coating), P/N (specify from Table D).

#### Recessed Escutcheon:

Specify: Style (10, 20, 30, or 40) Recessed Escutcheon with (specify\*) finish, P/N (specify\*).

#### Sprinkler Wrench

Specify: W-Type 6 Sprinkler Wrench, P/N 56-000-6-387.

Specify: W-Type 7 Sprinkler Wrench, P/N 56-850-4-001.

\* Refer to Technical Data Sheet TFP770.



Technical Services: Tel: (800) 381-9312 / Fax: (800) 791-5500

Email: techserv@tycofp.com

## Series RFII — 5.6 K-factor "Royal Flush II" Concealed Pendent Sprinklers Quick & Standard Response, Standard Coverage

## General Description

The Tyco® Series RFII Quick Response (3-mm bulb) and Standard Response (5-mm bulb), 5.6 K-Factor, "Royal Flush II" Concealed Pendent Sprinklers are decorative sprinklers featuring a flat cover plate designed to conceal the sprinkler. These sprinklers are optimal for architecturally sensitive areas such as hotel lobbies, office buildings, churches, and restaurants.

Each sprinkler includes a Cover Plate/ Retainer Assembly and a Sprinkler/ Support Cup Assembly. The separable, two-piece assembly design provides the following benefits:

- · Allows installation of the sprinklers and pressure testing of the fire protection system prior to installation of a suspended ceiling or application of the finish coating to a fixed ceiling.
- · Permits the removal of suspended ceiling panels for access to building service equipment without having to first shut down the fire protection system and remove sprinklers.
- · Provides for 1/2 inch (12,7 mm) of vertical adjustment to allow a measure of flexibility in determining the length of fixed piping to cut for the sprinkler drops.

### **IMPORTANT**

Always refer to Technical Data Sheet TFP700 for the "INSTALLER WARNING" that provides cautions with respect to handling and installation of sprinkler systems and components. Improper handling and installation can permanently damage a sprinkler system or its components and cause the sprinkler to fail to operate in a fire situation or cause it to operate prematurely.


The Series RFII Sprinklers are shipped with a Disposable Protective Cap. The Protective Cap is temporarily removed during installation and replaced to help protect the sprinkler during ceiling in-stallation or finish. The tip of the Protective Cap can be used to mark the center of the ceiling hole into plaster board or ceiling tiles by gently pushing the ceiling product against the Protective Cap. When ceiling installation is complete, the Protective Cap is removed and the Cover Plate/Retainer Assembly is installed.

As an option, the Series RFII Standard Response (5-mm bulb) "Royal Flush II" Concealed Pendent Sprinklers can be fitted with a silicone Air and Dust Seal. (Refer to Figure 5.) The Air and Dust Seal is intended for sensitive areas where it is desirable to prevent air and dust from the area above the ceiling to pass through the cover plate.

### NOTICE

The Series RFII Concealed Pendent Sprinklers described herein must be installed and maintained in compliance with this document and with the applicable standards of the National Fire Protection Association, in addition to the standards of any authorities having jurisdiction. Failure to do so may impair the performance of these devices.

The owner is responsible for maintaining their fire protection system and devices in proper operating condition. The installing contractor or sprinkler manufacturer should be contacted with any questions.

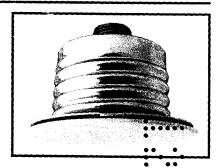

## Sprinkler Identification Number (SIN):

TY3531 - 3 mm bulb TY3551 - 5 mm bulb



## Technical Data

### **Sprinkler Approvals**

Approvals apply only to the service conditions indicated in the Design Criteria section.

- TY3531 (3-mm Bulb) is UL Listed, C-UL Listed, LPCB Approved (Ref. No. 094a/10), VdS Approved (Certificate No. G 4090007), and NYC Approved (MEA 353-01-E) as Quick Response.
- TY3531 (3-mm Bulb) is FM Approved as Standard Response.
  - Factory Mutual does not approve any concealed sprinklers for quick response.
- TY3551 (5-mm Bulb) is UL Listed, C-UL Listed, FM Approved, LPCB Approved (Ref. No. 094a/9), and NYC Approved (MEA 353-01-E) as Standard Response.

Approvals for Air and Dust Seal

UL and C-UL Listed for use with the RFII Standard Response Concealed Sprinkler (TY3551).

**Maximum Working Pressure** 

Maximum 250 psi (17,3 bar) by UL, C-UL, and NYC

Maximum 175 psi (12,1 bar) by FM, VdS, and LPCB

- Temperature Rating

155°F/68°C Sprinkler with 139°F/59°C Plate

200°F/93°C Sprinkler with 165°F/74°C Plate

**Discharge Coefficient** 

K= 5.6 GPM/psi<sup>1/2</sup> (80.6 LPM/bar<sup>1/2</sup>)

Adjustment


1/2 inch (12,7 mm)

#### **Finishes**

See the Ordering Procedure section.

Physical Characteristics

Physical Characteristics
Frame Bronze
Support Cup Chrome Plated Steel
Guide Pins Stainless Steel
Deflector Bronze
Compression Screw Brass
Bulb
Cap Bronze or Copper
Sealing AssemblyBeryllium
Nickel w/ Teflont
Cover Plate Brass
Retainer Brass
Ejection Spring Stainless Steel

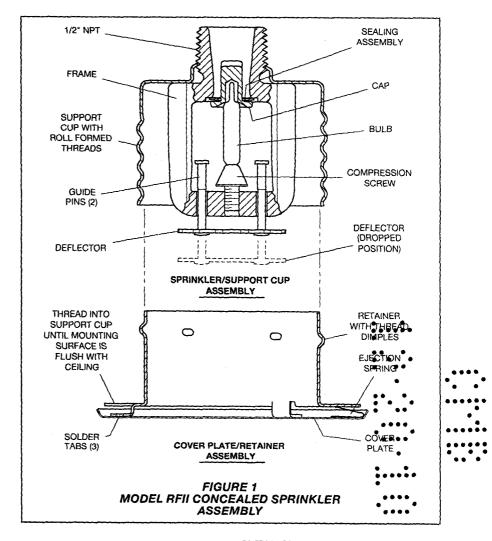

## Design Criteria

The Tyco® Series RFII Concealed Pendent Sprinklers are intended for fire protection systems designed in accordance with the standard installation rules recognized by the applicable Listing or Approval agency; for example, UL Listing is based on NFPA 13 and VdS Approval is based on the CEA 4001.


For more information on LPCB and VdS Approvals, contact Tyco Fire Suppression & Building Products at the following office:


Enschede, Netherlands Telephone: 31-53-428-4444 Fax: 31-53-428-3377

The Series RFII Concealed Pendent Sprinklers are only listed and approved with the Series RFII Concealed Cover Plates having a factory applied finish.

#### NOTICE

Do not use the Series RFII in applications where the air pressure above the ceiling is greater than that below. Down drafts through the Sprinkler/Support Cup Assembly can delay sprinkler operation in a fire situation.

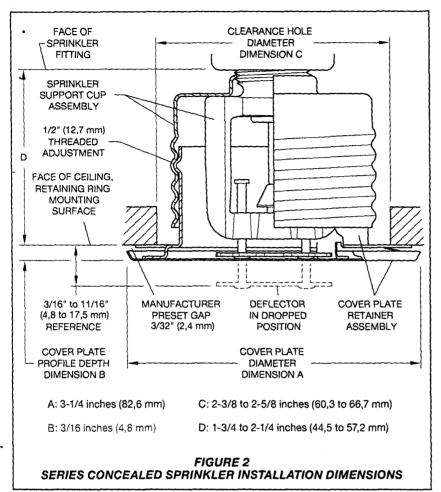

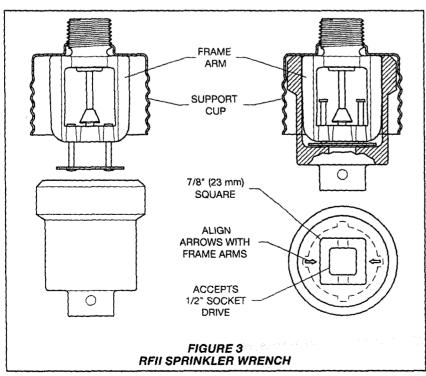


## **Operation**

When exposed to heat from a fire, the Cover Plate, normally soldered to the Retainer at three points, falls away to expose the Sprinkler/Support Cup Assembly.

The Deflector—supported by the Guide Pins—then drops down to its operational position.

The glass Bulb contains a fluid that expands when exposed to heat. When the rated temperature is reached, the fluid expands sufficiently to shatter the glass Bulb, activating the sprinkler and allowing water to flow.

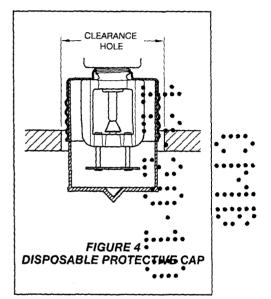

## Installation

The Tyco® Series RFII must be installed in accordance with the following instructions.

### NOTICE

Do not install any bulb-type sprinkler if the bulb is cracked or there is a loss of liquid from the bulb. With the sprinkler held horizontally, a small air bubble should be present. The diameter of the air bubble is approximately 1/16 inch (1,6 mm) for the 155°F/68°C and 3/32 inch (2,4 mm) for the 200°F/93°C temperature ratings.

Obtain a 1/2 inch NPT sprinkler joint by applying a minimum to maximum torque of 7 to 14 ft.-lbs. (9,5 to 19,0 Nm). Higher levels of torque can distort the sprinkler Inlet with consequent leakage or impairment of the sprinkler.

Do not attempt to compensate for insufficient adjustment in the Sprinkler by under- or over-tightening the Sprinkler/Support Cup Assembly. Re-adjust the position of the sprinkler fitting to suit.

Step 1. Install the sprinkler only in the pendent position with the center-line of the sprinkler perpendicular to the mounting surface.

Step 2. Remove the Protective Cap.

**Step 3.** With pipe thread sealant applied to the pipe threads, hand-tighten the sprinkler into the sprinkler fitting.

**Step 4.** Wrench-tighten the sprinkler using only the RFII Sprinkler Wrench. (Refer to Figure 3.) Apply the RFII Sprinkler Wrench to the Sprinkler as shown in Figure 3.

Step 5. Replace the Protective Cap by pushing it upwards until it bottoms out against the Support Cup. (Refer to Figure 4.) The Protective Cap helps prevent damage to the Deflector and Arms during ceiling installation and/or finish. You can also use the Protective Cap to locate the center of the clearance hole by gently pushing the ceiling material up against the center point of the Protective Cap.

#### NOTICE

As long as the Protective Cap remains in place, the system is considered "Out of Service".

Step 6. After the ceiling has been completed with the 2-1/2 inch (63,5 mm) diameter clearance hole and in preparation for installing the Cover Plate/Retainer Assembly, remove and discard the Protective Cap. Verify that the Deflector moves up and down freely.

If the Sprinkler is damaged and the Deflector does not move up and down freely, replace the entire Sprinkler. Do not attempt to modify or repair a damaged sprinkler.

Step 7. When installing an Air and Dust Seal, refer to Figure 5; otherwise, proceed to Step 8. To attach the Air and Dust Seal, verify the angle of the outside edge of the seal is oriented according to Figure 5. Start the edge of the Retainer in the grooved slot of the Air and Dust Seal and continue around the retainer until the entire Air and Dust Seal is engaged.

Step 8. Screw on the Cover Plate/Retainer Assembly until the Retainer (shown in Figure 2) or the Air and Dust Seal (shown in Figure 5) contacts the ceiling. Do not continue to screw on the Cover Plate/Retainer Assembly so that it lifts a ceiling panel out of its normal position. If you cannot engage the Cover Plate/Retainer Assembly with the Support Cup or you cannot engage the Cover Plate/Retainer Assembly sufficiently to contact the ceiling, you must reposition the Sprinkler Fitting.

## Care and Maintenance

The Tyco® Series RFII must be maintained and serviced in accordance with the following instructions.

### NOTICE

Before closing a fire protection system main control valve for maintenance work on the fire protection system that it controls, obtain permission to shut down the affected fire protection system from the proper authorities and notify all personnel who may be affected by this action.

Absence of the Cover Plate/Retainer Assembly can delay sprinkler operation in a fire situation.

When properly installed, there is a nominal 3/32 inch (2,4 mm) air gap between the lip of the Cover Plate and the ceiling, as shown in Figure 2.

This air gap is necessary for proper operation of the sprinkler. If the ceiling requires repainting after sprinkler installation, ensure that the new paint does not seal off any of the air gap.

Do not pull the Cover Plate relative to the Enclosure. Separation may result.

Replace sprinklers that:

- are leaking or exhibiting visible signs of corrosion.
- were modified or over-heated.


Never paint, plate, coat, or otherwise alter automatic sprinklers after they leave the factory. Never repaint factory-painted Cover Plates. If necessary, replace them with factory-painted units. Non-factory applied paint can adversely delay or prevent sprinkler operation in the event of a fire.

Exercise care to avoid damage to sprinklers before, during, and after installation. Replace sprinklers damaged by dropping, striking, wrench twisting, wrench slipping, or the like. Also, replace any sprinkler that has a cracked bulb or that has lost liquid from its bulb. (Refer to the Installation section.)

If you must remove a sprinkler, do not reinstall it or a replacement without reinstalling the Cover Plate/Retainer Assembly. If a Cover Plate/Retainer Assembly becomes disloged during service, replace it immediately.

Responsibility lies with sprinkler owners for the inspection, testing, and maintenance of their fire protection system and devices in compliance with this document, as well as with the applicable standards of the National Fire Protection Association (for example, NFPA 25), in addition to the standards of any other authorities having jurisdiction. Contact the installing contractor or sprinkler manufacturer regarding any questions.

Automatic sprinkler systems should be inspected, tested, and maintained by a qualified Inspection Service in accordance with local requirements and/or national code.

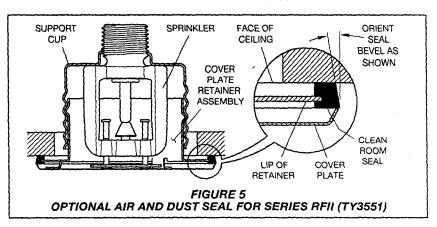



## Limited Warranty

Products manufactured by Tyco Fire Suppression & Building Products (TFSBP) are warranted solely to the original Buyer for ten (10) years against defects in material and workmanship when paid for and properly installed and maintained under normal use and service. This warranty will expire ten (10) years from date of shipment by TFSBP. No warranty is given for products or components manufactured by companies not affiliated by ownership with TFSBP or for products and components which have been subject to misuse, improper installation, corrosion, or which have not been installed, maintained, modified or repaired in accordance with applicable Standards of the National Fire Protection Association, and/or the standards of any other Authorities Having Jurisdiction. Materials found by TFSBP to be defective shall be either repaired or replaced, at TFSBP's sole option. TFSBP neither assumes, nor authorizes any person to assume for it, any other obligation in connection with the sale of products or parts of products. TFSBP shall not be responsible for sprinkler system design errors or inaccurate or incomplete information supplied by Buyer or Buyer's representatives.

In no event shall TFSBP be liable, in contract, tort, strict liability or under any other legal theory, for incidental, indirect, special or consequential damages, including but not limited to labor charges, regardless of whether TFSBP was informed about the possibility of such damages, and in no event shall TFSBP's liability exceed an amount equal to the sales price.

The foregoing warranty is made in lieu of any and all other warranties, express or implied, including warranties of merchantability and fitness for a particular purpose.

This limited warranty sets forth the exclusive remedy for claims based on failure of or defect in products, materials or components, whether the claim is made in contract, tort, strict liability or any other legal theory.

This warranty will apply to the full extent permitted by law. The invalidity, in whole or part, of any portion of this warranty will not affect the remainder.

## Ordering Procedure

Contact your local distributor for availability. When placing an order, indicate the full product name.

Sprinkler/Support Cup Assembly Specify: (SIN), (temperature rating from below) Series RFII Concealed Pendent Sprinkler, P/N (specify).

 TY3531
 55°F/68°C
 200°F/93°C

 51-792-1-155
 51-792-1-200

 TY3551
 51-790-1-155
 51-790-1-200

#### Separately Ordered Cover Plate/ Retainer Assembly:

Specify: (temperature rating from below) Series RFII Concealed Cover Plate with (finish), P/N (specify).


	139°F/59°C(a)	165°F/74°C(b
Brass	. 56-792-1-135	56-792-1-165
Chrome	. 56-792-9-135	56-792-9-165
Signal White (RAL 9003)	. 56-792-4 <b>-</b> 135	56-792-4-165
Grey White (RAL 9002)	. 56-792-0-135	56-792-0-165
Pure White (c) (RAL 9010)	. 56-792-3-135	56-792-3-165
Custom	. 56-792-X-135	56-792-X-165


- (a) For use with 155°F/68°C sprinklers.
- (b) For use with 200°F/93°C sprinklers.
- (c) Eastern Hemisphere sales only.


### Sprinkler Wrench Specify: RFII Sprinkler Wrench,

Air and Dust Seal Specify: Air and Dust Seal, P/N 56-908-1-001.

P/N 56-000-1-075.

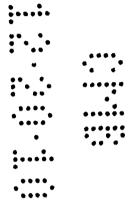

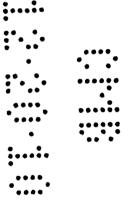

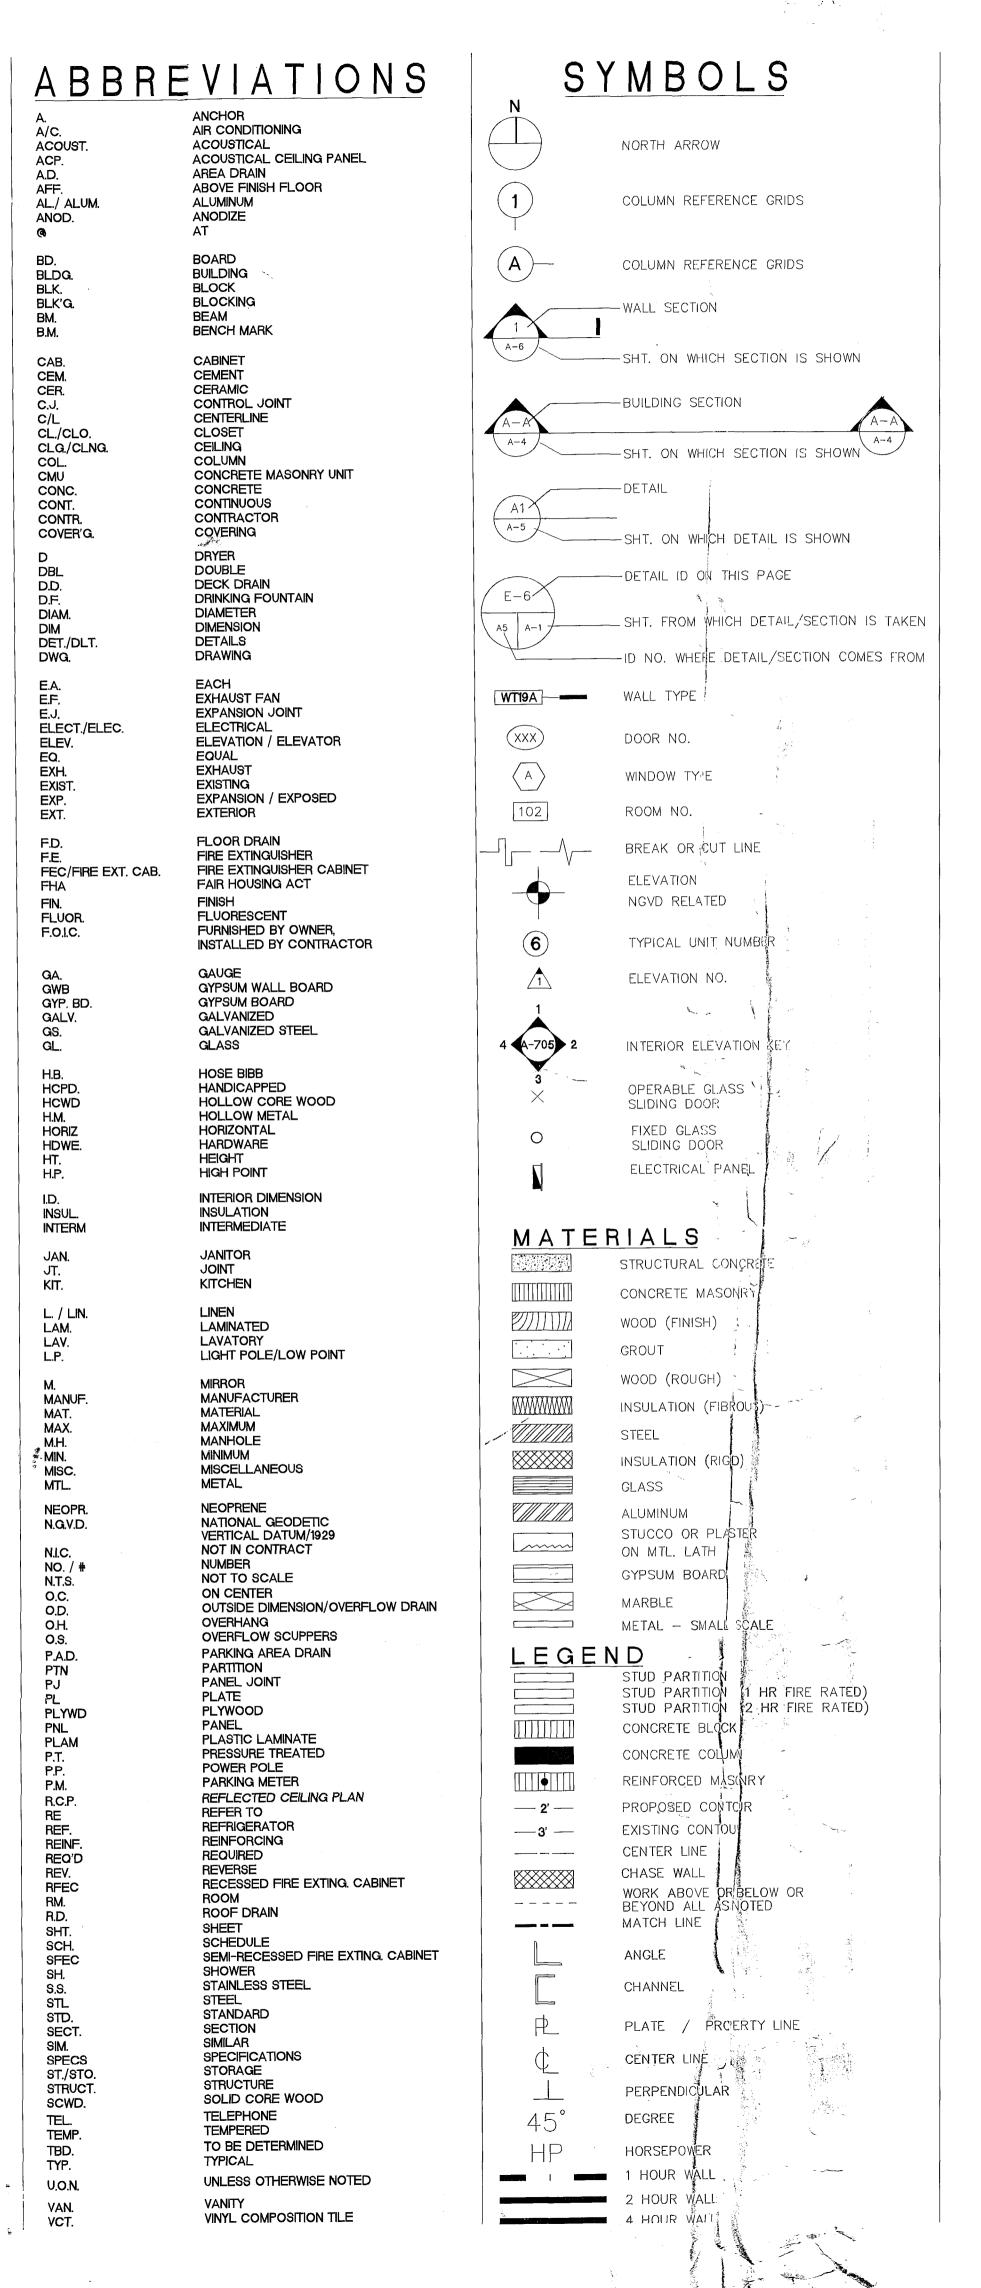

## DEMOLITION NOTES

1. IT IS NOT THE INTENT OF THESE PLANS TO SHOW EVERY DETAIL OF DEMOLITION AND CONSTRUCTION. CONTRACTOR SHALL VISIT JOB LOCATION TO BECOME THOROUGHLY FAMILIAR WITH THE WORK AND SHALL VERIFY ALL EXISTING CONDITIONS APPLICABLE TO THE DEMOLITION WORK PRIOR TO SUBMITTING A BID FOR THE WORK. IF ANY ITEMS AND/OR SYSTEMS ARE OTHER THAN AS DESCRIBED ON THESE DRAWINGS, THE CONTRACTOR SHALL SUBMIT A BID ON THE BASIS OF THE WORK. ACTUALLY REQUIRED TO DEMOLISH, PROVIDE, OR INSTALL ANY ITEMS OR SYSTEMS EQUAL TO THE DESIGN AS DRAWN AND QUALIFY THE BID ACCORDINGLY.

2. ALL EXISTING SURFACES AND EQUIPMENT TO REMAIN SHALL BE FULLY PROTECTED FROM DAMAGE. THE CONTRACTOR SHALL ASSUME FULL RESPONSIBILITY FOR DAMAGE AND SHALL MAKE REPAIRS REQUIRED WITHOUT ADDITIONAL COST TO THE OWNER.

3. NO DEBRIS SHALL BE ALLOWED TO ACCUMULATE ON THE JOB SITE. DEBRIS SHALL BE REMOVED BY THE CONTRACTOR AS THE JOB PROCEEDS, FROM THE SITE TO THE DUMPSTER OR OFF SITE ON A DAILY BASIS. DEBRIS IS NOT TO ACCUMULATE.

4. THE SITE SHALL BE LEFT BROOM CLEAN AT THE COMPLETION OF DEMOLITION. NO STRUCTURAL ELEMENTS SHALL BE REMOVED UNLESS THE PORTIONS AFFECTED ARE ADEQUATELY SUPPORTED BY EITHER TEMPORARY SHORING OR NEW STRUCTURAL ELEMENTS AS REQUIRED TO PROTECT THE STABILITY AND INTEGRITY OF THE EXISTING STRUCTURE.

5. DEMOLITION TO OCCUR IN SUCH A MANNER SO THAT ALL BUILDING STANDARD COMPONENTS SUCH AS LIGHTS, SWITCHES, ALL DIFFUSERS AND RETURN AIR GRILLES, POWER DEVICES, DOORS, FRAMES, HARDWARE, ETC. ARE CAREFULLY REMOVED AND SALVAGED FOR RE-USE.

6. REMOVE OR RELOCATE ALL WIRING, PLUMBING, AND MECHANICAL EQUIPMENT AFFECTED BY THE REMOVAL OF PARTITIONS. REMOVED PIPES AND/OR LINES SHALL BE CUT TO A POINT OF CONCEALMENT BEHIND OR BELOW FINISH SURFACE AND SHALL BE PROPERLY CAPPED OR PLUGGED. ALL WIRING, PLUMBING AND MECHANICAL EQUIPMENT SHALL BE CUT BEHIND THE WALL TO POINT OF CONCEALMENT AND BACK TO THE MAIN RISER, BRANCH LINE, PANEL BOARD, ETC... NO WIRING, PIPING, EQUIPM. IS TO BE ABANDONED ABOVE THE CEILING OR BEHIND THE WALLS. ALL WIRING, PIPING AND EQUIPMENT TO BE: REMOVED SHALL BE CLEARLY SHOWN IN THE CONSTRUCTION DOCUMENTS.

7. REMOVE ABANDONED DUCTWORK, WIRES, PIPES, ETC. SERVING THIS TENANT SPACE FROM PLENUM ABOVE AND BELOW THE CEILING AND FLOOR SLAB. INSTALL VALVES AND CAPS AS REQUIRED. ALL ABANDONED OPENINGS THROUGH THE SLAB (PLUMBING, ELECTRICAL, ETC.) TO BE REPOURED TO MAINTAIN FIRE RATING. THE BASE BUILDING SPECIFICATIONS SHALL APPLY. REPLACE FIREPROOFING.

8. THE CONTRACTOR SHALL PROVIDE ADEQUATE WEATHER PROTECTION FOR THE BUILDING AND ITS CONTENTS DURING COURSE OF WORK.

9. THE CONTRACTOR SHALL FILE ALL NECESSARY CERTIFICATES OF INSURANCE WITH THE DEPARTMENT OF BUILDINGS, PAY ALL FEES, OBTAIN ALL PERMITS AND PROVIDE ANY AND ALL BONDS REQUIRED BY ANY CITY AGENCY IN ORDER TO DO THE WORK DESCRIBED HEREIN. CERTIFICATES OF INSURANCE ARE ALSO PROVIDED IN CONFORMANCE W/ LANDLORD REQUIREMENTS WHICH SHALL BE INCLUDED AS PART OF THE BID PACKAGE.

10. CONTRACTOR SHALL PERFORM ALL OPERATIONS OF DEMOLITION AND REMOVAL INDICATED ON DRAWINGS AND AS MAY BE REQUIRED BY THE WORK.
ALL WORK SHALL BE DONE CAREFULLY NEATLY AND IN A SYSTEMATIC MANNER.

11. ALL ADJOINING PROPERTY AFFECTED BY ANY OPERATIONS OF DEMOLITION SHALL BE PROTECTED PER THE REQUIREMENTS OF APPLICABLE CODES.

12. THE CONTRACTOR SHALL PROVIDE, ERECT AND MAINTAIN ALL TEMPORARY BARRIERS AND GUARDS AND ALL TEMPORARY SHORING AND BRACING AS REQUIRED BY THE DEPARTMENT OF BUILDING RULES AND REGULATIONS.

13. EXISTING WINDOW TREATMENT TO BE REMOVED AS REQUIRED AND REINSTALLED BY CONTRACTOR.

14. CAREFULLY REMOVE EXISTING LIGHT FIXTURES + STORE FOR TENANT REUSE AS REQUIRED.

15. G.C. TO PATCH/ REPAIR/ CAP ALL POKETHROUGHS, CONDUIT, + PLUMBING PENETRATIONS THAT ARE NOT PERTINENT TO THE DESIGN FUNCTIONALITY OF THE NEW SPACE. ALL PATCHING, ETC. TO MATCH OR EXCEED EXISTING SLAB FIRE RATING.


16. REMOVE DRYWALL/ A.C.T. AND GRID CEILING AS REQUIRED.

17. FIRE EXTINGUISHER CABINETS TO BE CAREFULLY REMOVED + RETAINED FOR LANDLORD'S REUSE.


18. ALL WORK IS TO BE COORDINATED W/ BUILDING MANAGEMENT.

19. G.C. TO MAINTAIN INTEGRITY OF FIRE ENVELOPE DURING DEMO, RENOVATION AND CONSTRUCTION.

# I. SITE LOCATION PLAN

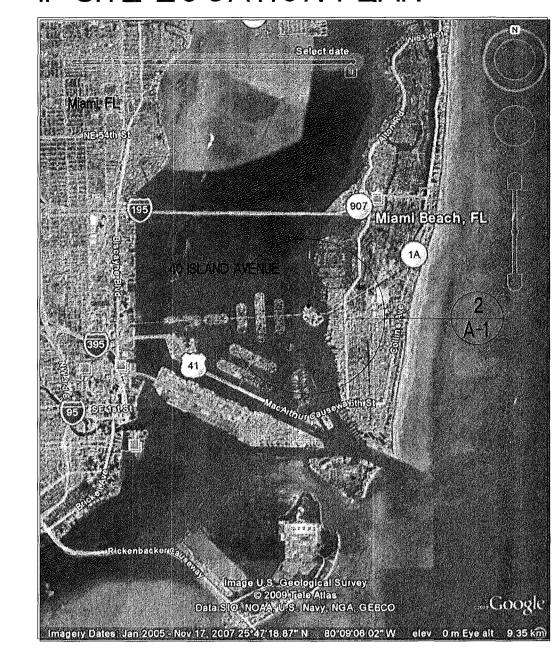


#### 2. KEY SITE PLAN

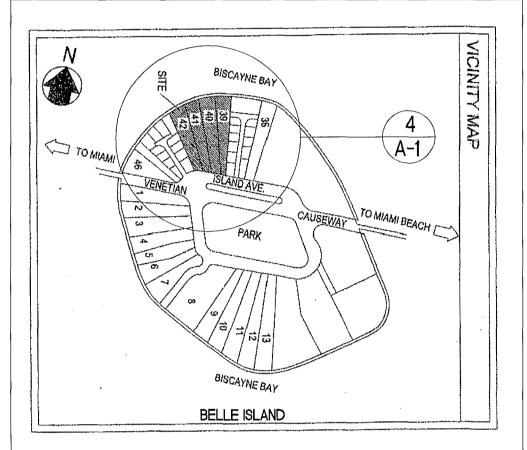

# 3. LEGAL DESCRIPTION

LOTS 39, 40, 41 AND 42 OF 'AMENDED PLAT OF BELLE ISLAND' ACCORDING TO THE PLAT THEREOF RECOVERED IN PLAT BOOK 5 AT PAGE 11 OF THE PUBLIC RECORDS OF MIAMI-DADE COUNTY, FLORIDA AND BEING SITUATED ON BELLE EISLAND, ON VENETIAN CAUSEWAY, WITHIN THE CITY LIMITS OF MIAMI BEACH, FLORIDA.

#### 4. KEY LOCATION PLAN

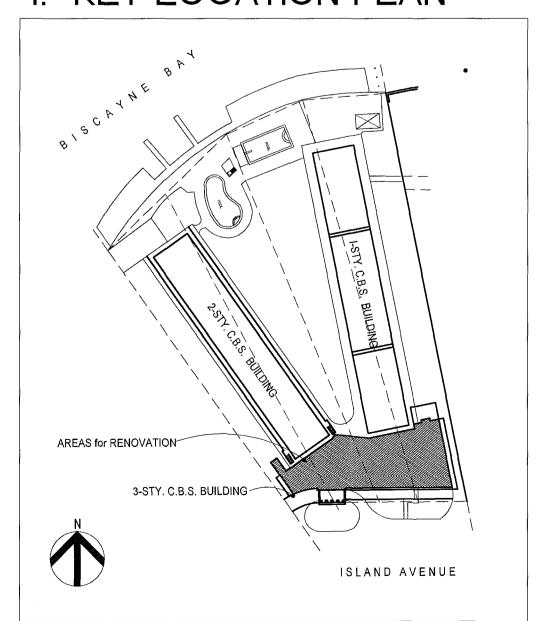

### INDEX of DRAWINGS ARCHITECTURE: COVER + CONTENTS FIRE EGRESS PLAN A-3 DEMOLITION PLAN STANDARD / MIAMI 40 ISLAND WAY A-4 CONSTRUCTION PLAN MIAMI BEACH, FL 33139 tele: 305-673-1717 REFLECTED CEILING PLAN Architect: A-5.1 EMERGENCY LIGHTING ARTHUR J. MARCUS ARCHITECT F MIAMI REACH EL 33130 TELE + ELECTRIC PLANT PLAN REVIEW NOTICE SCHEDULES Phone 305-673-7080 Engineering 673-7020 INTERIOR ELEVATIONS A-9 DETAILS A-10 DETAILS UL DETAIL A-11 GENERAL NOTES GENERAL NOTES PENETRATION DETAILS A-15 PENETRATION DETAILS MECHANICAL ENGINEERING M-0 NOTES + LEGEND PLAN DETAILS ELECTRICAL ENGINEERING NOTES + LEGEND ELEC FLOOR PLAN E-1D ELEC DEMO PLAN ELEC. REF. CLG PLAN E-3 ELEC SCHEDULES PLUMBING ENGINEERING P-0 NOTES + LEGEND FLOOR PLAN P-1D DEMO PLAN P-2 SCHEDULE + DETAILS

FIRE SAFETY ENGINEERING

FP-0 NOTES + LEGENDFFICE COPY Project:
FP-1 REF. CLG PLANY OF AMANA DE ACINTER

FP-1 REF. CLG. PLANY OF MIAMI BEACHIOR RENOVATIONS
FP-2 DETAILS

APPROVED FOR PERMIT BY STANDARD

FA-1 FIRE ALARM FLOOR PLAN 12/09/1090 MIAMI

	ZONING:	؞ڔٛڿٙڋ؞ ؙٵ	012/14/VO	
TERÁTION - LE				
IENATION - LE	y Eura	Y:	11 12/13/1	J
IS AN ALȚERATION - LEVEL 2 W	HIHOUNCLUDE	S THE	12-12/19/0	9
	4 To The 1-1-1 on 1 1 on 10		The state of the s	

PUBLIC WORKS:

STRUCTURAL:

NIA Les 12/14/10

RECONFIGURATION OF SPACE, THE ADDITION OR ELIMINATION OF ANY DOOR OR WINDOW, THE RECONFIGURATION OF ANY SYSTEM ORITHE INSTALLATION OR AND INSTALLATION OR AND

GC NOTES

1. ALL WORK LISTED ON THE CONSTRUCTION DOCUMENTS TO NOTES AS SHOWN OR IMPLIED ON DRAWINGS SHALL BE SUPPLIED AND INSTALLED BY THE GENERAL CONTRACTOR, UNLESS OTHERWISE NOTED ON DRAWINGS. IT IS EXPECTED THAT THE GENERAL CONTRACTOR WILL COORDINATE WORK WITH THE SUB-CONTRACTORS TO ASSURE COONSTRUCTION SCHEDULES ARE MET.

HOTEL

40 ISLAND AVENUE
MIAMI BEACH, FL 33139

Drawing Title

20/10


12.20.16

2
Drawn By
AJM

Scale
AJM

AS NOTED

Drawing

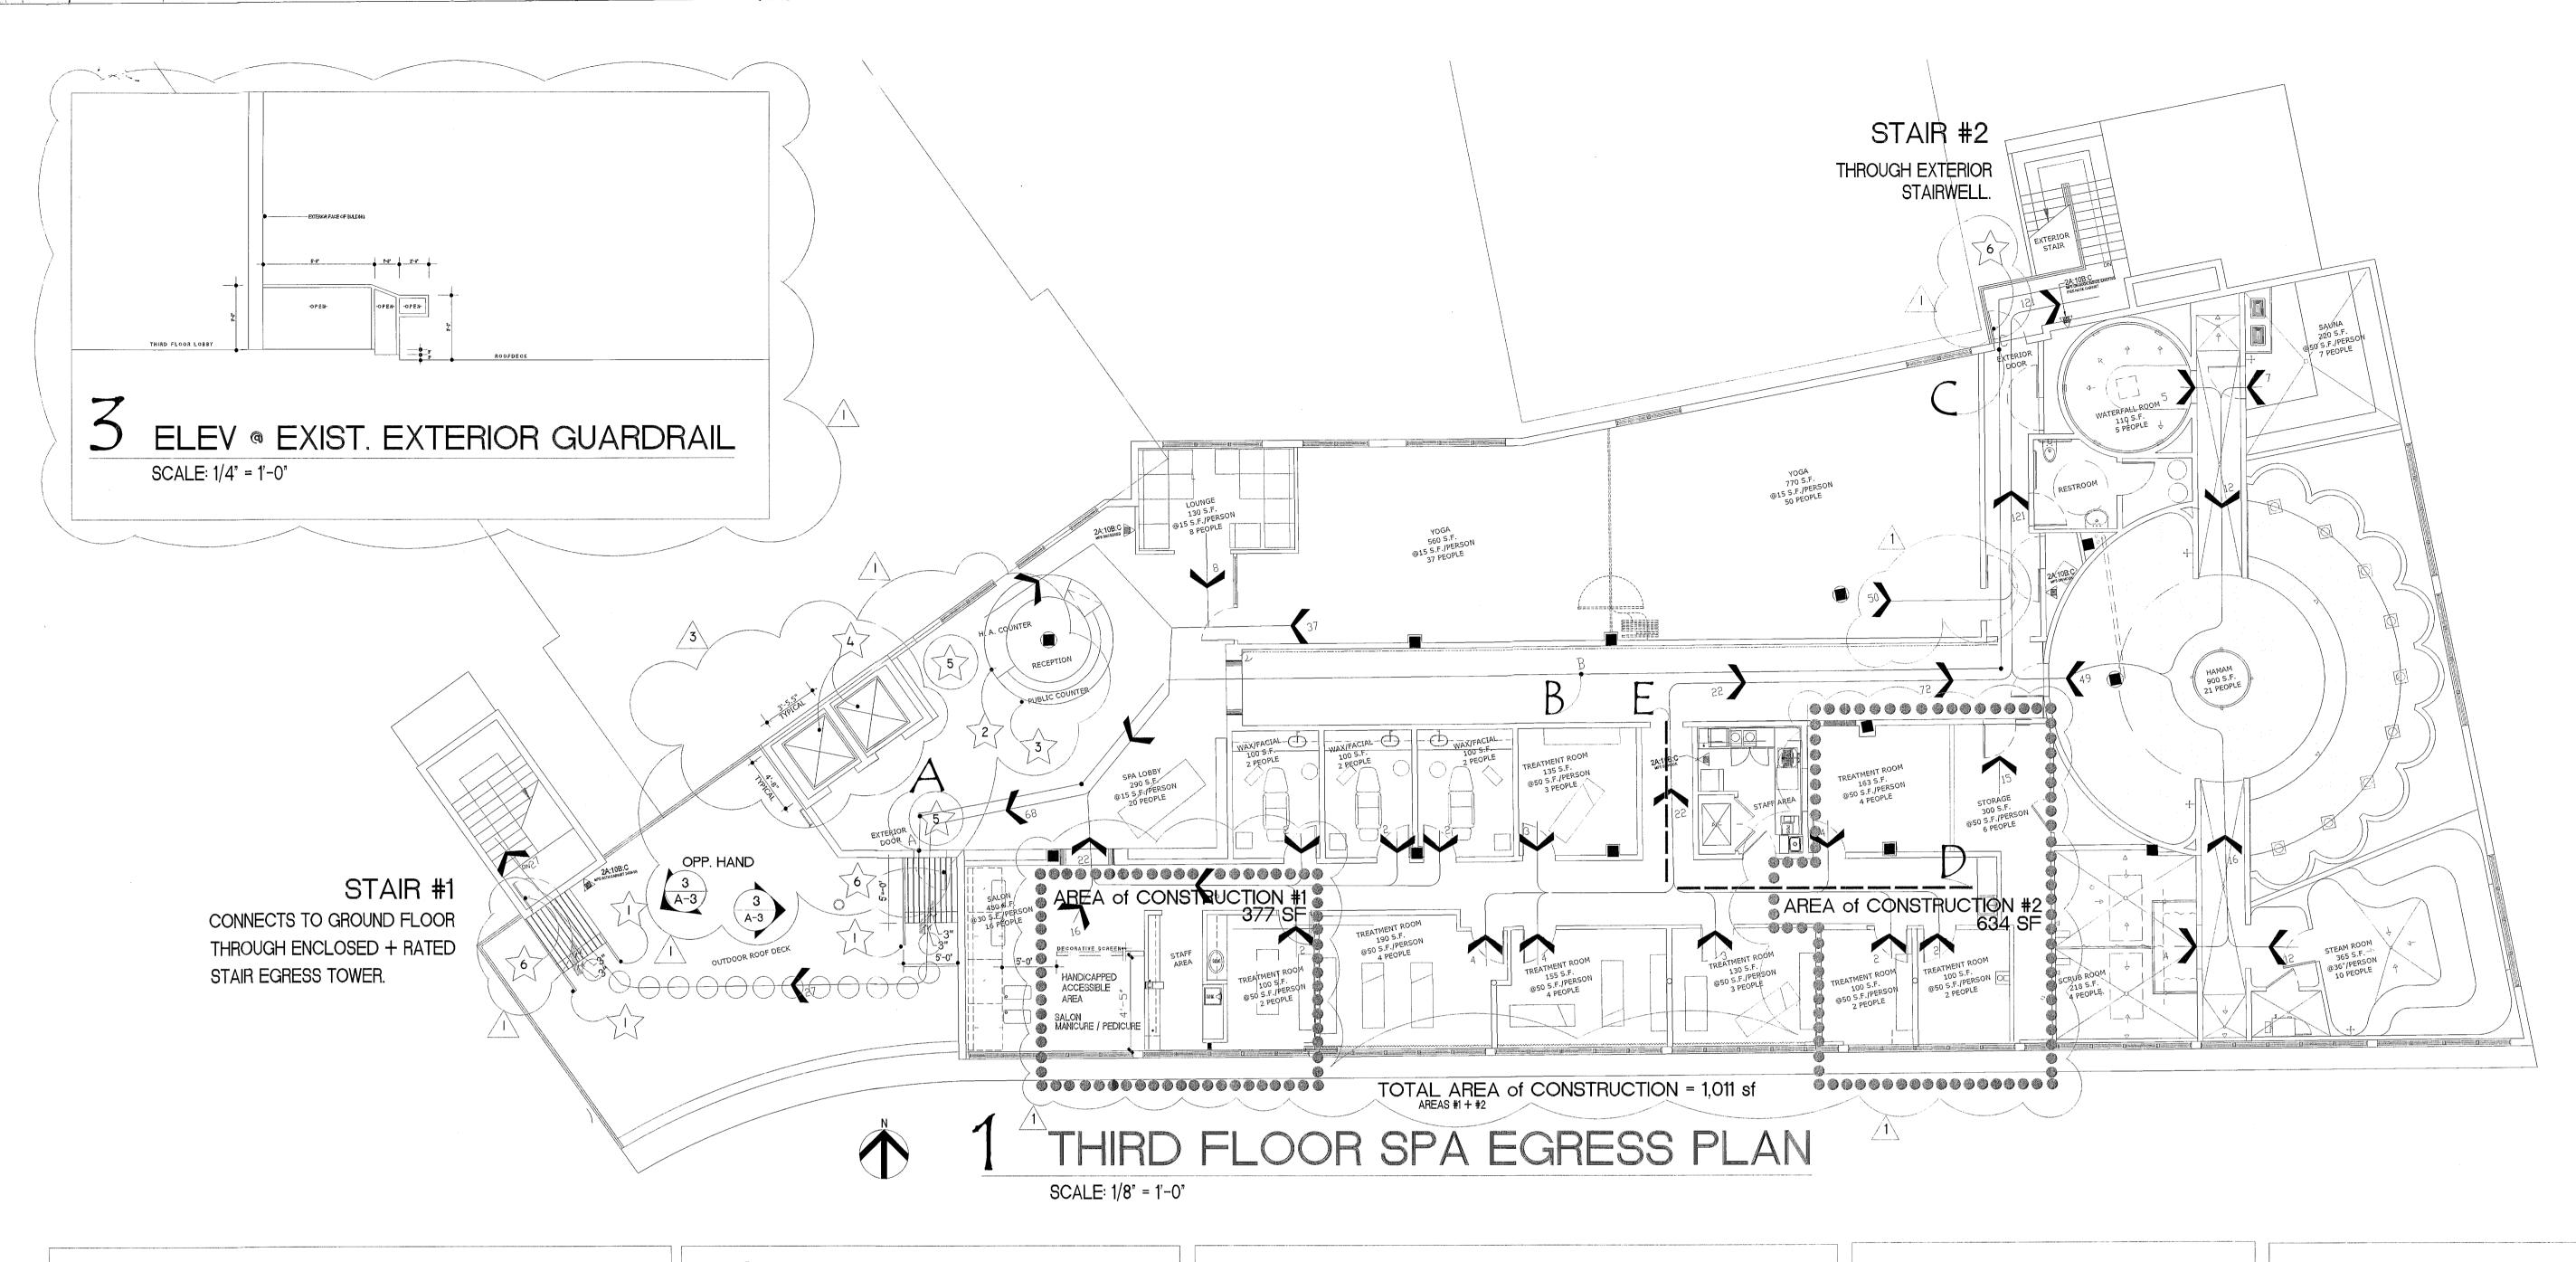

#### EGRESS NOTES

TOTAL TRAVEL DISTANCE: A - C = 131'-0" TOTAL TRAVEL DISTANCE: A - B = 56'-6" (A-C / 2) TOTAL TRAVEL DISTANCE: D - E = 43'-8"

(DEAD END CORRIDORS NOT TO EXCEED 50'-0") AS PER EXCEPTION 3 TO NFPA 101-7.2.2.6.3: SEPARATION + PROTECTION

OF EXISTING OUTSIDE STAIRS NOT REQUIRED. AS PER EXCEPTION 1 TO NFPA 101-13.2.6: TRAVEL DISTANCE TO EXITS

SHALL NOT EXCEED 200'-0". EXISTING EXTERIOR STAIR IS PART OF EXIT ACCESS AND IS NOT AN EXIT COMPONENT.

AS PER EXCEPTION 3 TO NFPA 101-7.2.2.4.6: EXISTING GUARD RAILS ON EXISTING STAIRS SHALL BE PERMITTED TO BE NOT LESS THAN 30"HIGH.

# ADDITIONAL NOTES

- A. FIRE PROTECTION SYSTEM SHOP DRAWINGS ARE TO BE SUBMITTED BY GC TO INDICATE CONFORMANCE WITH THE CODE AND SHALL BE APPROVED PRIOR TO SYSTEM INSTALLATION.
- B. ALTERED AREAS ARE SAME BUSINESS OCCUPANCY AS EXISTING AREAS. ALL AREAS ARE PART OF RESIDENTIAL GROUP R-1: HOTELS (TRANSIENT) PER FBC CH.3.
- C. PER FBC 105,3.5 THE MINIMUM TYPE OF CONSTRUCTION IS TYPE 'I I I A'
- D. PER FBC TABLE 508.3.3 THE FIRE RATING FOR OCCUPANCY AND TENANT SEPARATION, A ONE HOUR FIRE SEPARATION IS REQUIRED BETWEEN THE HOTEL OCCUPANCY AND THE SPA / BUSINESS OCCUPANCY.
- È. ALL EXIT DOORS HAVE THE REQUIRED PANIC HARDWARE DEVICES.

#### LEGEND

OCCUPANCY COUNT



and the second of the second o

- DIRECTION OF TRAVEL

DIRECTION OF TRAVEL

#### NOTES

- EXISTING CODE COMPLIANT RAILINGS AND STEPS. SEE DETAIL 3 THIS SHEET.
- HANDICAPPED ACCESSIBLE COUNTER AT 2'-10.5" H
- 3'-10.5" HIGH SERVICE COUNTER-
- THE EXISTING INSIDE CAB DIMENSIONS OF 3'-5.5" x 4'-8" WILL MEET THE EQUIVALENCY AS STATED IN FBC SECTION 11-4.1.6(3)(C)(iii)
- 5'-0" DIAMETER MANEUVERING CLEARANCE
- EXISTING PUSH-BAR EGRESS HARDWARE AT EXISTING EGRESS DOOR.

# SCOPE of WORK

THE SCOPE OF WORK INCLUDES 1,011 SF OF INTERIOR RENOVATIONS, AT TWO SEPARATE AREAS OF THE SPA ON THE THIRD FLOOR.

#### CODES

2007 FLORIDA BUILDING CODE

ZONING CLASSIFICATION:

CODES in EFFECT: (1)

R-1 HOTEL/MOTEL

ZONING CLASSIFICATION:

R-1 HOTEL/MOTEL

TOTAL NUMBER OF STORIES:

**CONSTRUCTION TYPE:** 

STAIRS

SPLINKLERED:

DISCHARGE OF EXITS:

PORTABLE FIRE EXTINGUISHERS:

PER N.F.P.A. 10

3

YES

150'-0"

INTERIOR WALL / CEILING FINISH

CLASS A or B PER N.F.P.A. 101

INTERIOR WALL + CEILING FINISH MAT'LS CLASS 'A' or CLASS 'B' FOR ALL EXIT ENCLOSURES, LOBBIES +

CORRIDORS THAT ARE PART OF AN EXIT ACCESS.

OCCUPANCY + TENANT SEPARATION

PER FBC TABLE 508.3.3

NO SEPARATION REQUIREMENT BUILDING IS EQUIPED THROUGHOUT W/AUTOMATIC SPRINKLER SYSTEM

(1) WORK TO MEET ALL REQUIREMENTS OF THE FLORIDA FIRE PREVENTION CODE 2007

#### PLUMBING FIXTURE COUNT SECOND + THIRD FLOORS COMBINED

TOTAL NUMBER OF PERSONS - 391

PUBLIC	PROVIDED
MALE	
WATER CLOSETS	5
URINALS	3
LAVATORIES	3

FEMALE WATER CLOSETS LAVATORIES

SERVICE SINK

\ A-10 / AREAS for RENOVATION 3-STY, C.B.S. BUILDING ISLAND AVENUE

∠ KEY LOCATION PLAN

9.13.10 PERIMIT COMMENTS 11.11.10 PERMIT COMMENTS

MIAMI BEACH, FL 33139 tele: 305-673-1717

Architect:
ARTHUR J. MARCUS ARCHITECT P.A. 1450 LINCOLN ROAD MIAMI BEACH, FL 33139 tele: 305-674-8945


MEP Engineering: UCI ENGINEERING INC. 4247 S.W. 71st AVENUE MIAMI, FL 33155 tele: 305-661-0800

INTERIOR RENOVATIONS FOR THE STANDARD MIAMI HOTEL 40 ISLAND AVENUE MIAMI BEACH, FL 33139

Drawing Title FIRE **EGRESS** PLAN

Issue Date 9.09.09 AJM

Checked By AJM

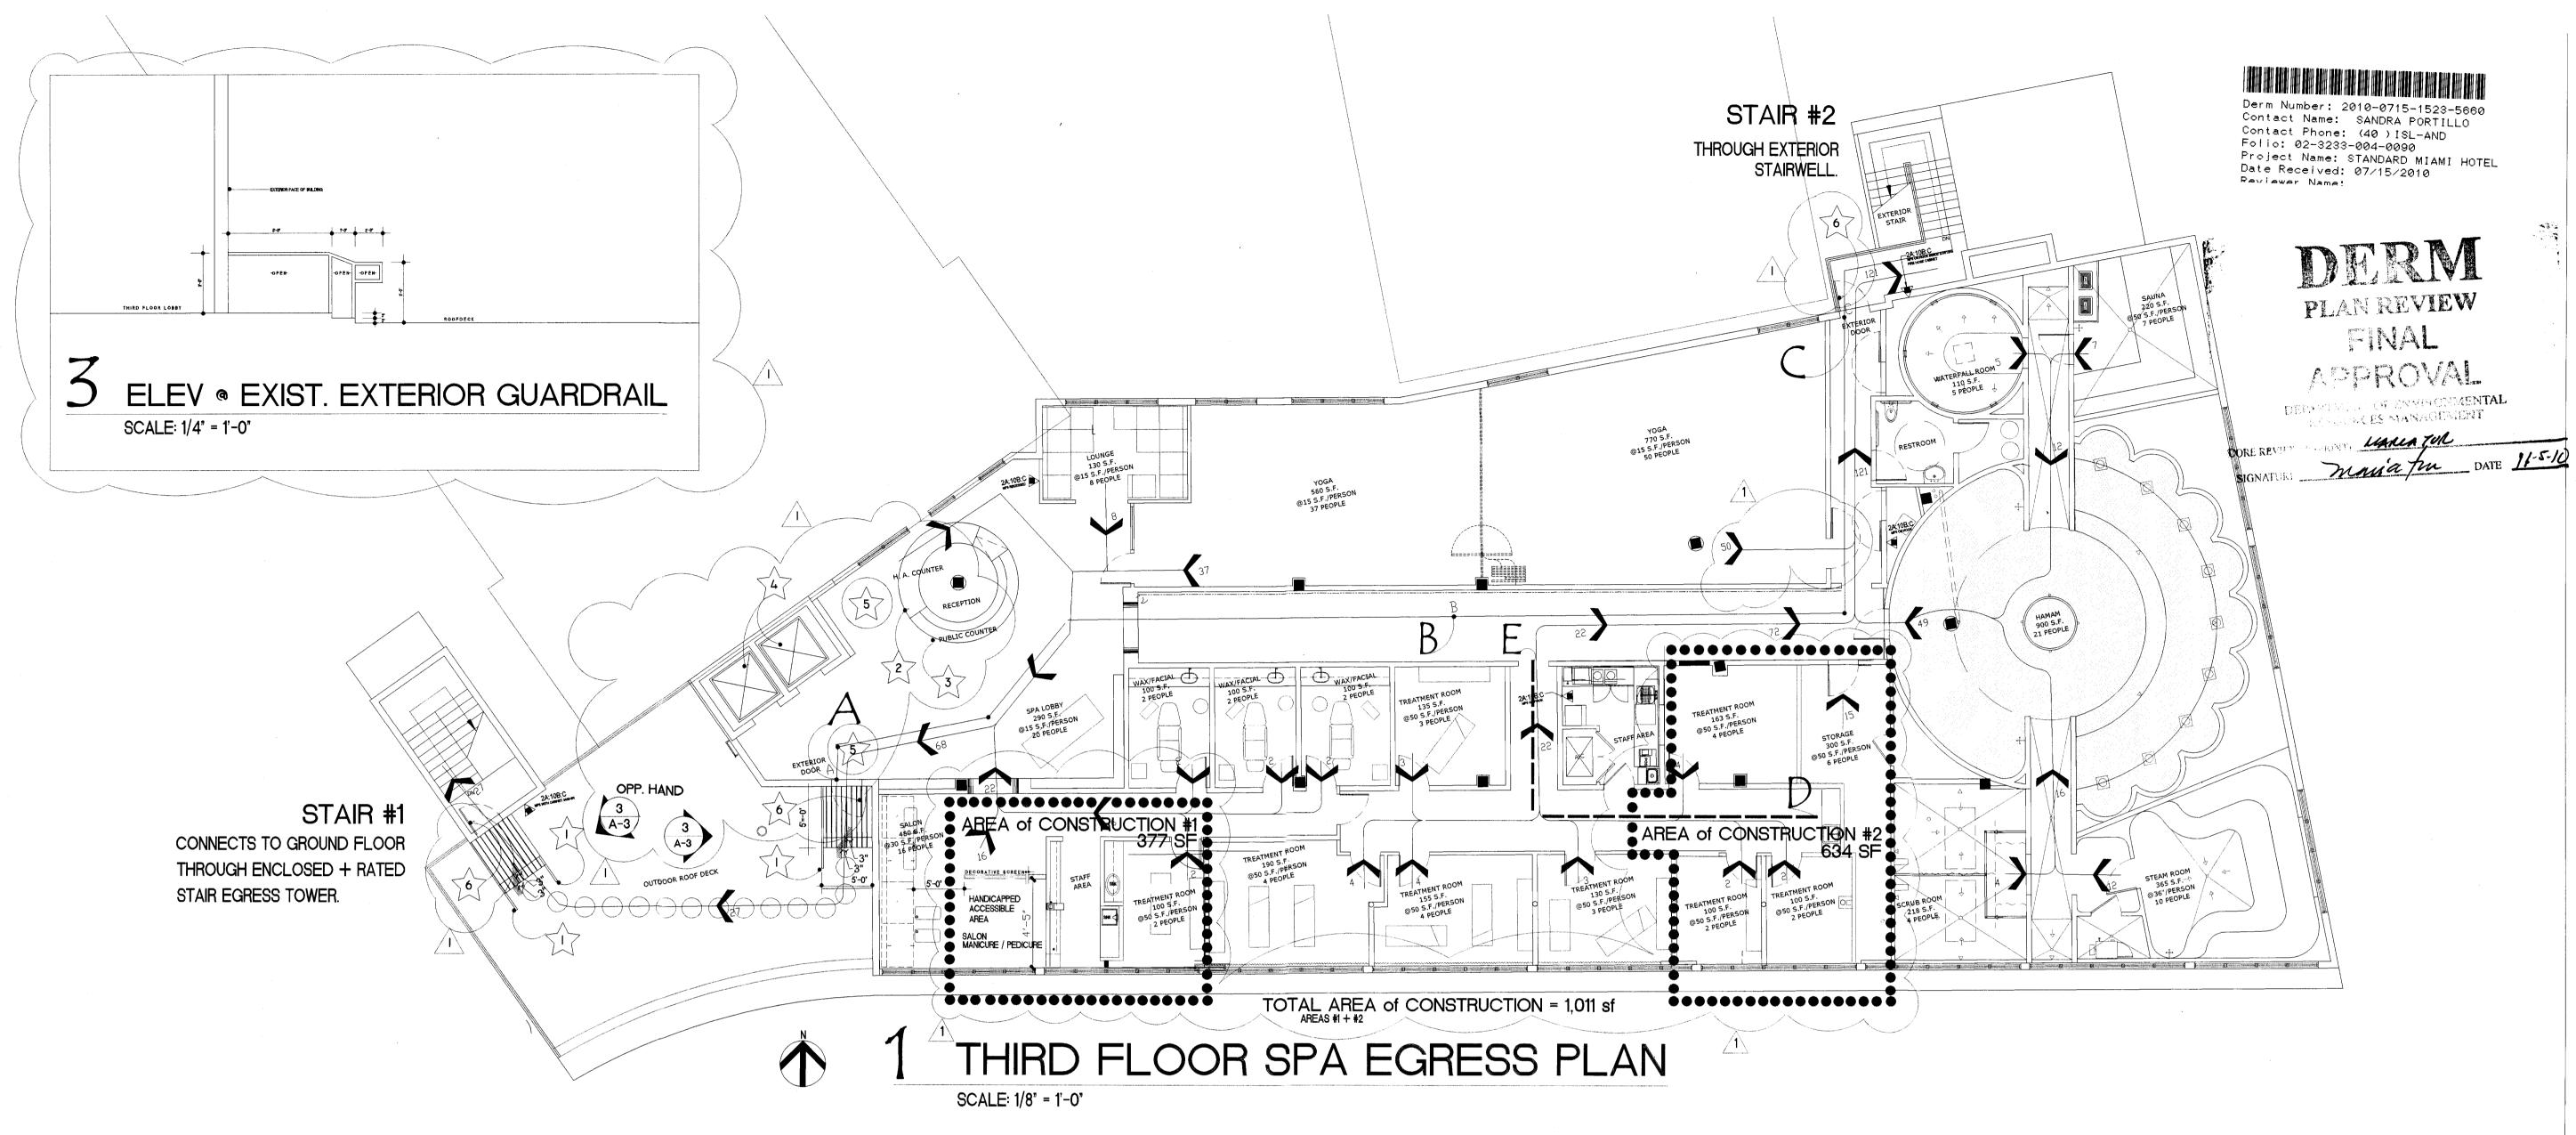

#### EGRESS NOTES

TOTAL TRAVEL DISTANCE: A - C = 131'-0" TOTAL TRAVEL DISTANCE: A - B = 56'-6" (A-C / 2) TOTAL TRAVEL DISTANCE: D - E = 43'-8" (DEAD END CORRIDORS NOT TO EXCEED 50'-0")

AS PER EXCEPTION 3 TO NFPA 101-7.2.2.6.3: SEPARATION + PROTECTION OF EXISTING OUTSIDE STAIRS NOT REQUIRED.

AS PER EXCEPTION 1 TO NFPA 101-13.2.6: TRAVEL DISTANCE TO EXITS SHALL NOT EXCEED 200'-0". EXISTING EXTERIOR STAIR IS PART OF EXIT ACCESS AND IS NOT AN EXIT COMPONENT.

AS PER EXCEPTION 3 TO NFPA 101-7.2.2.4.6: EXISTING GUARD RAILS ON EXISTING STAIRS SHALL BE PERMITTED TO BE NOT LESS THAN 30"HIGH.

#### ADDITIONAL NOTES

- A. FIRE PROTECTION SYSTEM SHOP DRAWINGS ARE TO BE SUBMITTED BY GC TO INDICATE CONFORMANCE WITH THE CODE AND SHALL BE APPROVED PRIOR TO SYSTEM INSTALLATION.
- B. ALTERED AREAS ARE SAME BUSINESS OCCUPANCY AS EXISTING AREAS. ALL AREAS ARE PART OF RESIDENTIAL GROUP R-2: HOTELS (TRANSIENT) PER FBC CH.3.
- C. PER FBC 105.3.5 THE MINIMUM TYPE OF CONSTRUCTION IS TYPE 'I I I A'
- D. PER FBC TABLE 508.3.3 THE FIRE RATING FOR OCCUPANCY AND TENANT SEPARATION, A ONE HOUR FIRE SEPARATION IS REQUIRED BETWEEN THE HOTEL OCCUPANCY AND THE SPA / BUSINESS OCCUPANCY.
- E. ALL EXIT DOORS HAVE THE REQUIRED PANIC HARDWARE DEVICES.

#### LEGEND

OCCUPANCY COUNT

DIRECTION OF TRAVEL DIRECTION OF TRAVEL

#### NOTES

- EXISTING CODE COMPLIANT RAILINGS AND STEPS. SEE DETAIL 3 THIS SHEET.
- HANDICAPPED ACCESSIBLE COUNTER AT 2'-10.5" H
  - 3'-10.5" HIGH SERVICE COUNTER
- INTERIOR ELEVATOR CAB DIMENSIONS:
- 3'-5.5" x 4'-8"
- 5'-0" DIAMETER MANEUVERING CLEARANCE
- EXISTING PUSH-BAR EGRESS HARDWARE AT EXISTING EGRESS DOOR.

# SCOPE of WORK

THE SCOPE OF WORK INCLUDES 1,011 SF OF INTERIOR RENOVATIONS, AT TWO SEPARATE AREAS OF THE SPA ON THE THIRD FLOOR.

#### CODES

2007 FLORIDA BUILDING CODE

ZONING CLASSIFICATION: R-1 HOTEL/MOTEL

ZONING CLASSIFICATION: R-1 HOTEL/MOTEL

TOTAL NUMBER OF STORIES:

CONSTRUCTION TYPE:

SPLINKLERED:

DISCHARGE OF EXITS: 150'-0"

PORTABLE FIRE EXTINGUISHERS: PER N.F.P.A. 10

INTERIOR WALL / CEILING FINISH CLASS A or B STAIRS PER N.F.P.A. 101

INTERIOR WALL + CEILING FINISH MAT'LS CLASS 'A' or CLASS 'B'

FOR ALL EXIT ENCLOSURES, LOBBIES + CORRIDORS THAT ARE PART OF AN

EXIT ACCESS.

CODES in EFFECT: (1)

(1) WORK TO MEET ALL REQUIREMENTS OF THE

FLORIDA FIRE PREVENTION CODE 2007

#### PLUMBING FIXTURE COUNT SECOND + THIRD FLOORS COMBINED

TOTAL NUMBER OF PERSONS - 391

PUBLIC	PROVIDED
MALE	
WATER CLOSETS	5
URINALS	3
LAVATORIES	3

FEMALE	The state of the s
WATER CLOSETS	5
LAVATORIES	3
SERVICE SINK	2

A-10 AREAS for RENOVATION 3-STY. C.B.S. BUILDING ISLAND AVENUE

KEY LOCATION PLAN

1 9.13.10 PERMIT COMMENTS

FERRADO LIDO, LLC STANDARD / MIAMI 40 ISLAND WAY tele: 305-673-1717

> ARTHUR J. MARCUS ARCHITECT P.A 1450 LINCOLN ROAD MIAMI BEACH, FL 33139 tele: 305-674-8945

MEP Engineering: UCI ENGINEERING INC. 4247 S.W. 71st AVENUE MIAMI, FL 33155


INTERIOR RENOVATIONS FOR THE STANDARD **MAMI** HOTEL

Drawing Title **EGRESS** PLAN

**40 ISLAND AVENUE** 

MIAMI BEACH, FL 33139

Issue Date 9.09.09

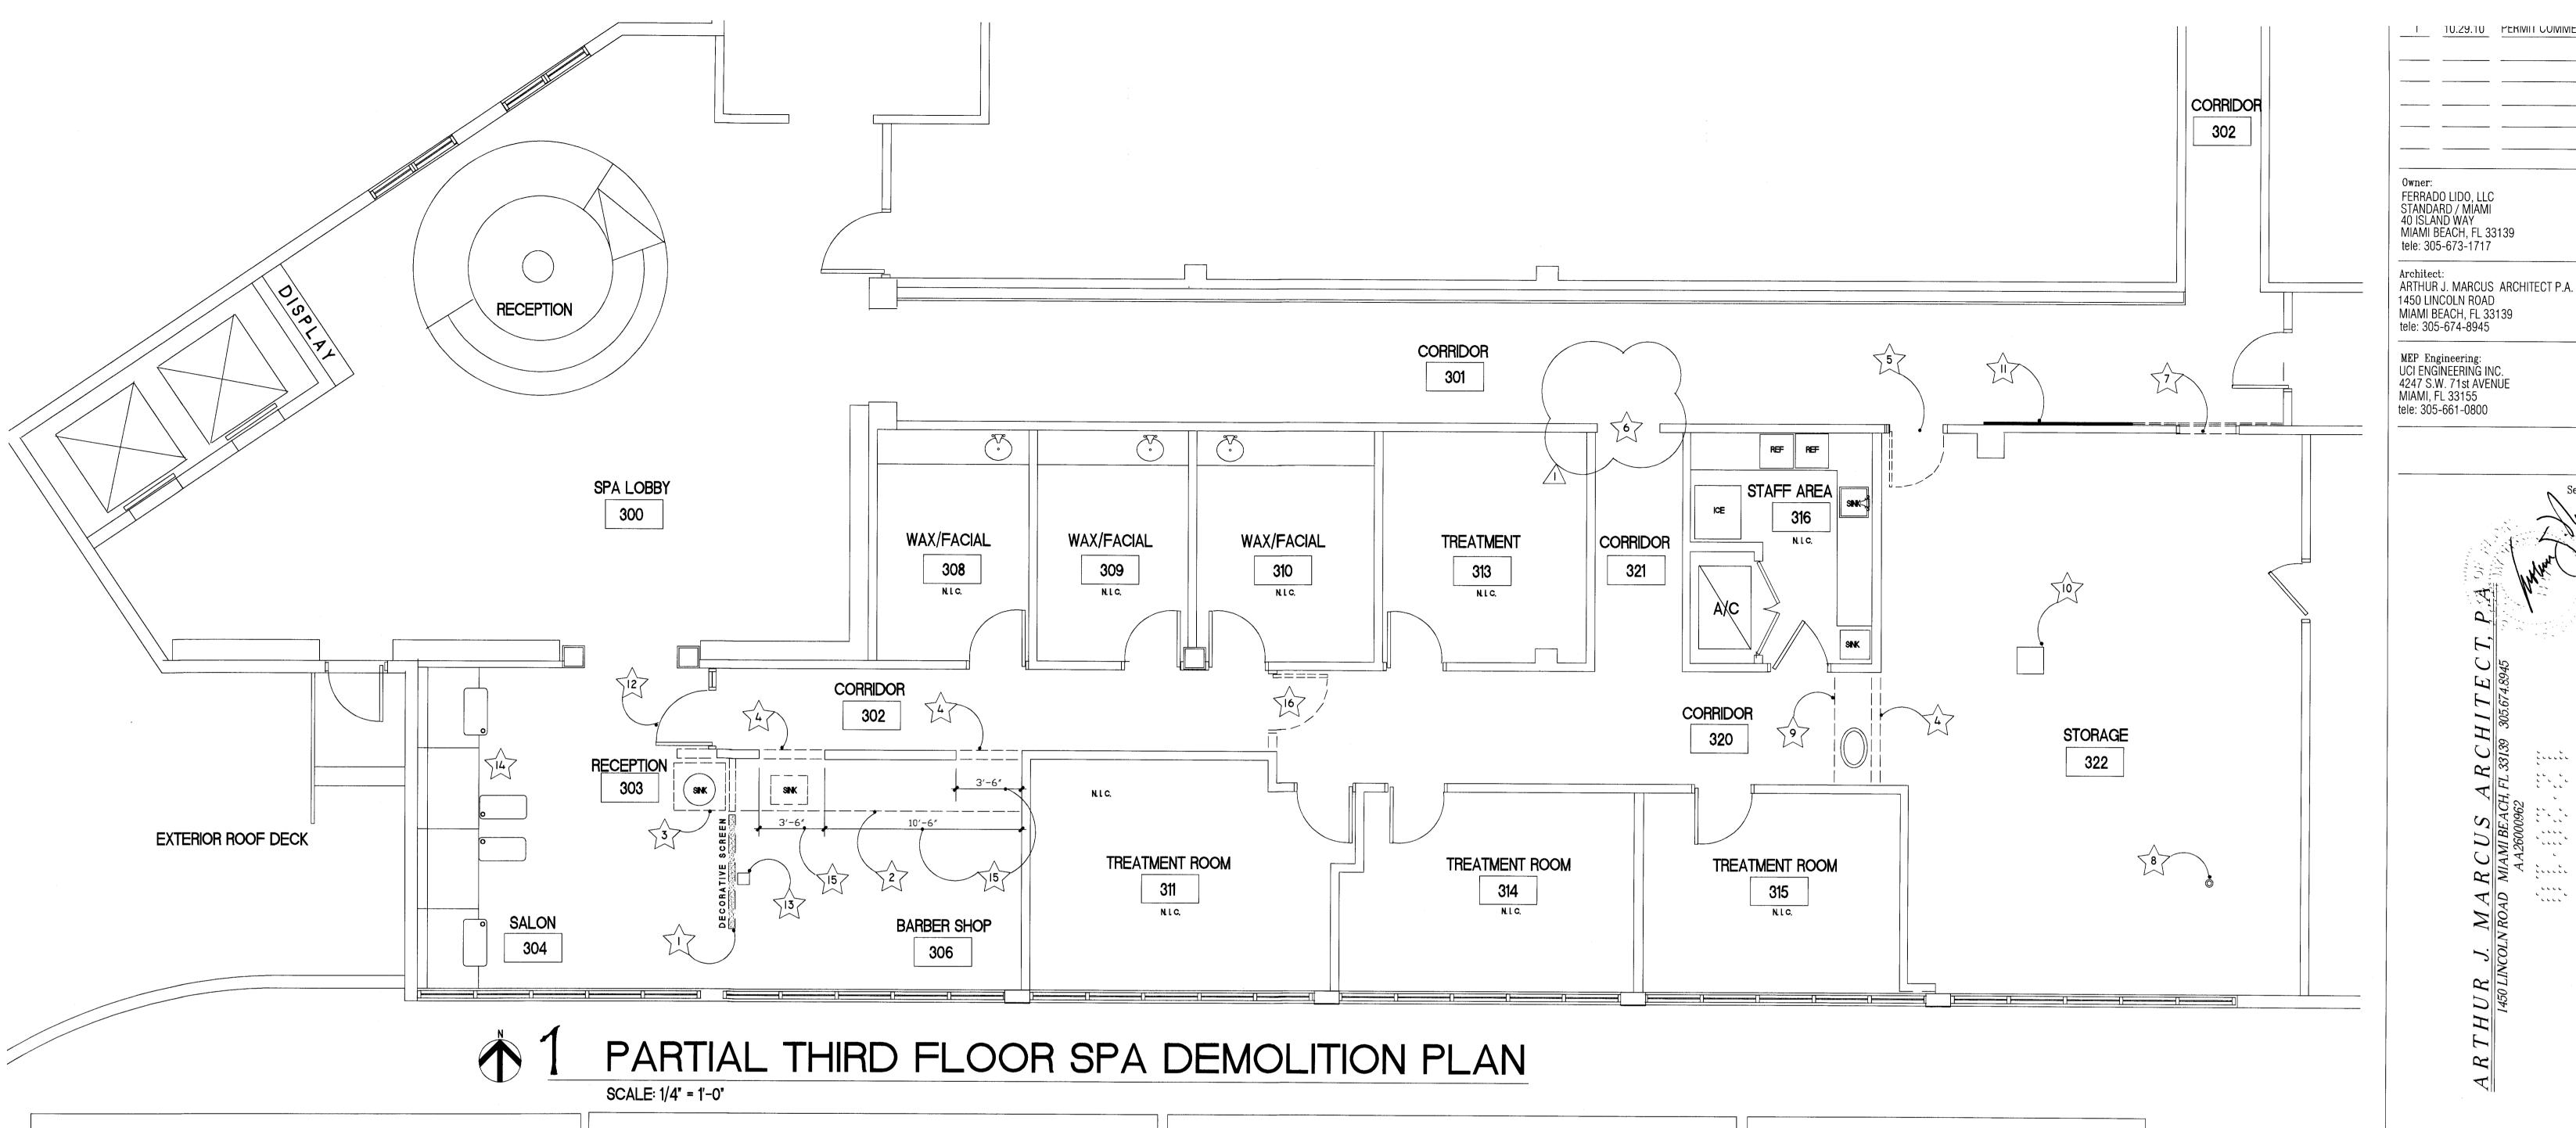

10.29.10 PERIVITI CUIVIIVIENTS

INTERIOR RENOVATIONS

STANDARD

40 ISLAND AVENUE MIAMI BEACH, FL 33139

**DEMOLITION** 

1ssue Date 9.09.09


FOR THE


MIAMI


HOTEL


Drawing Title

PLAN

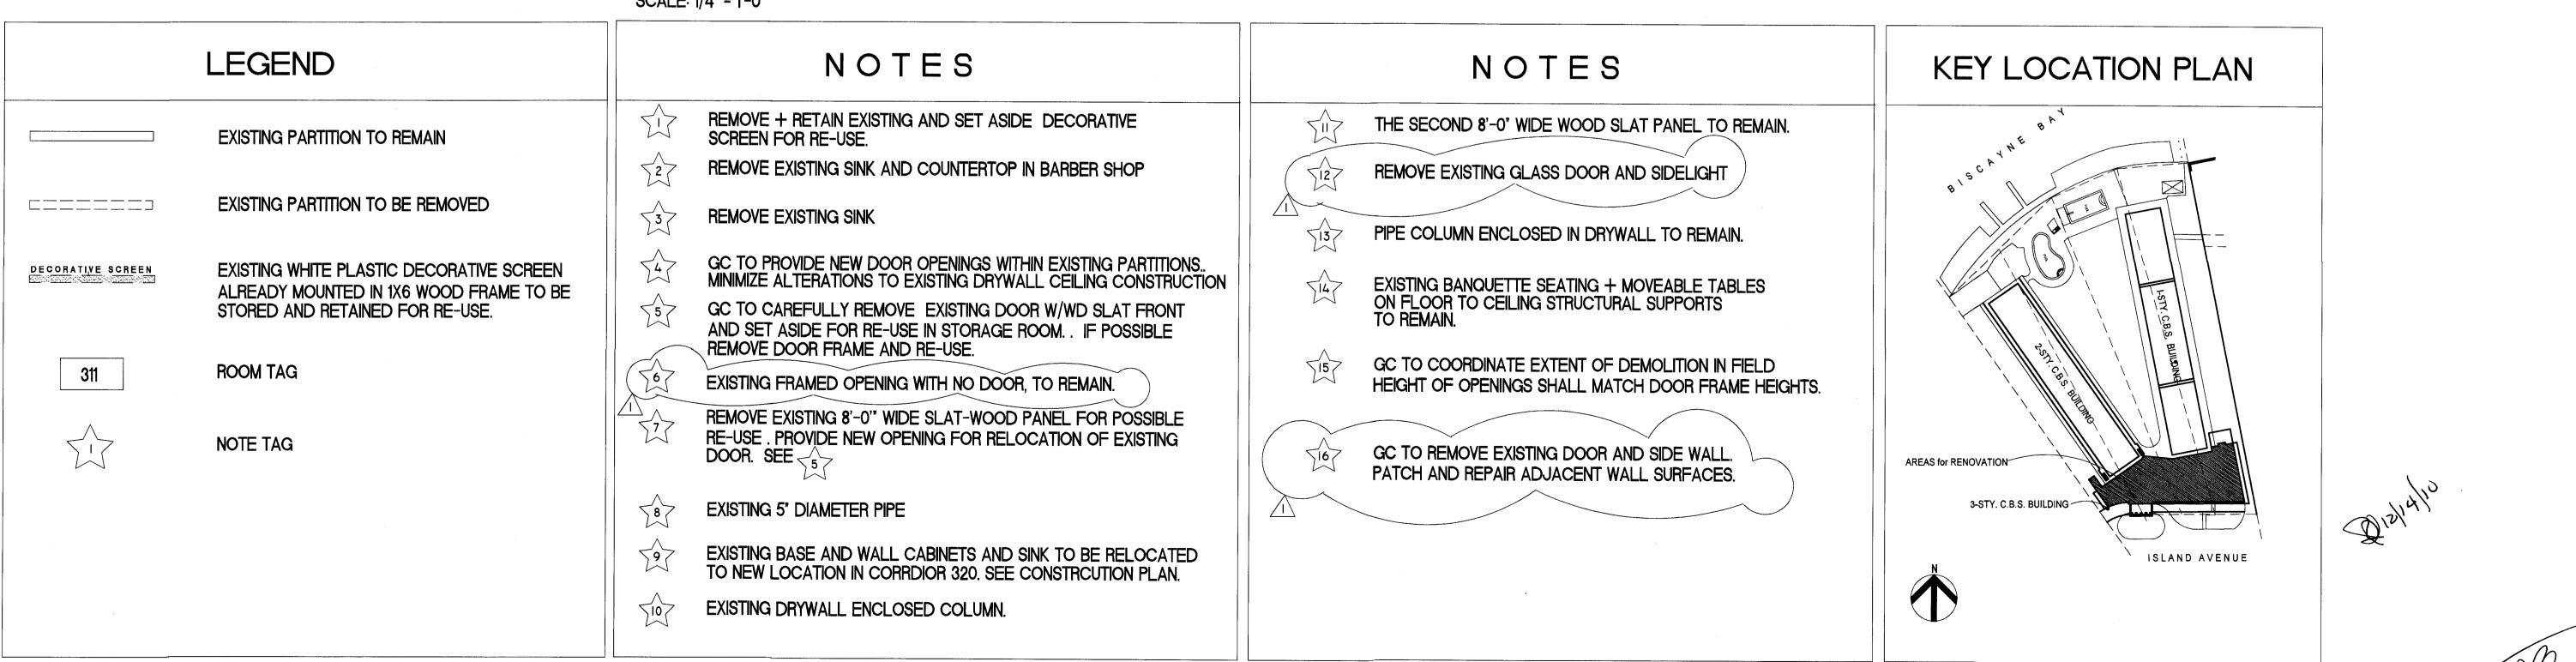


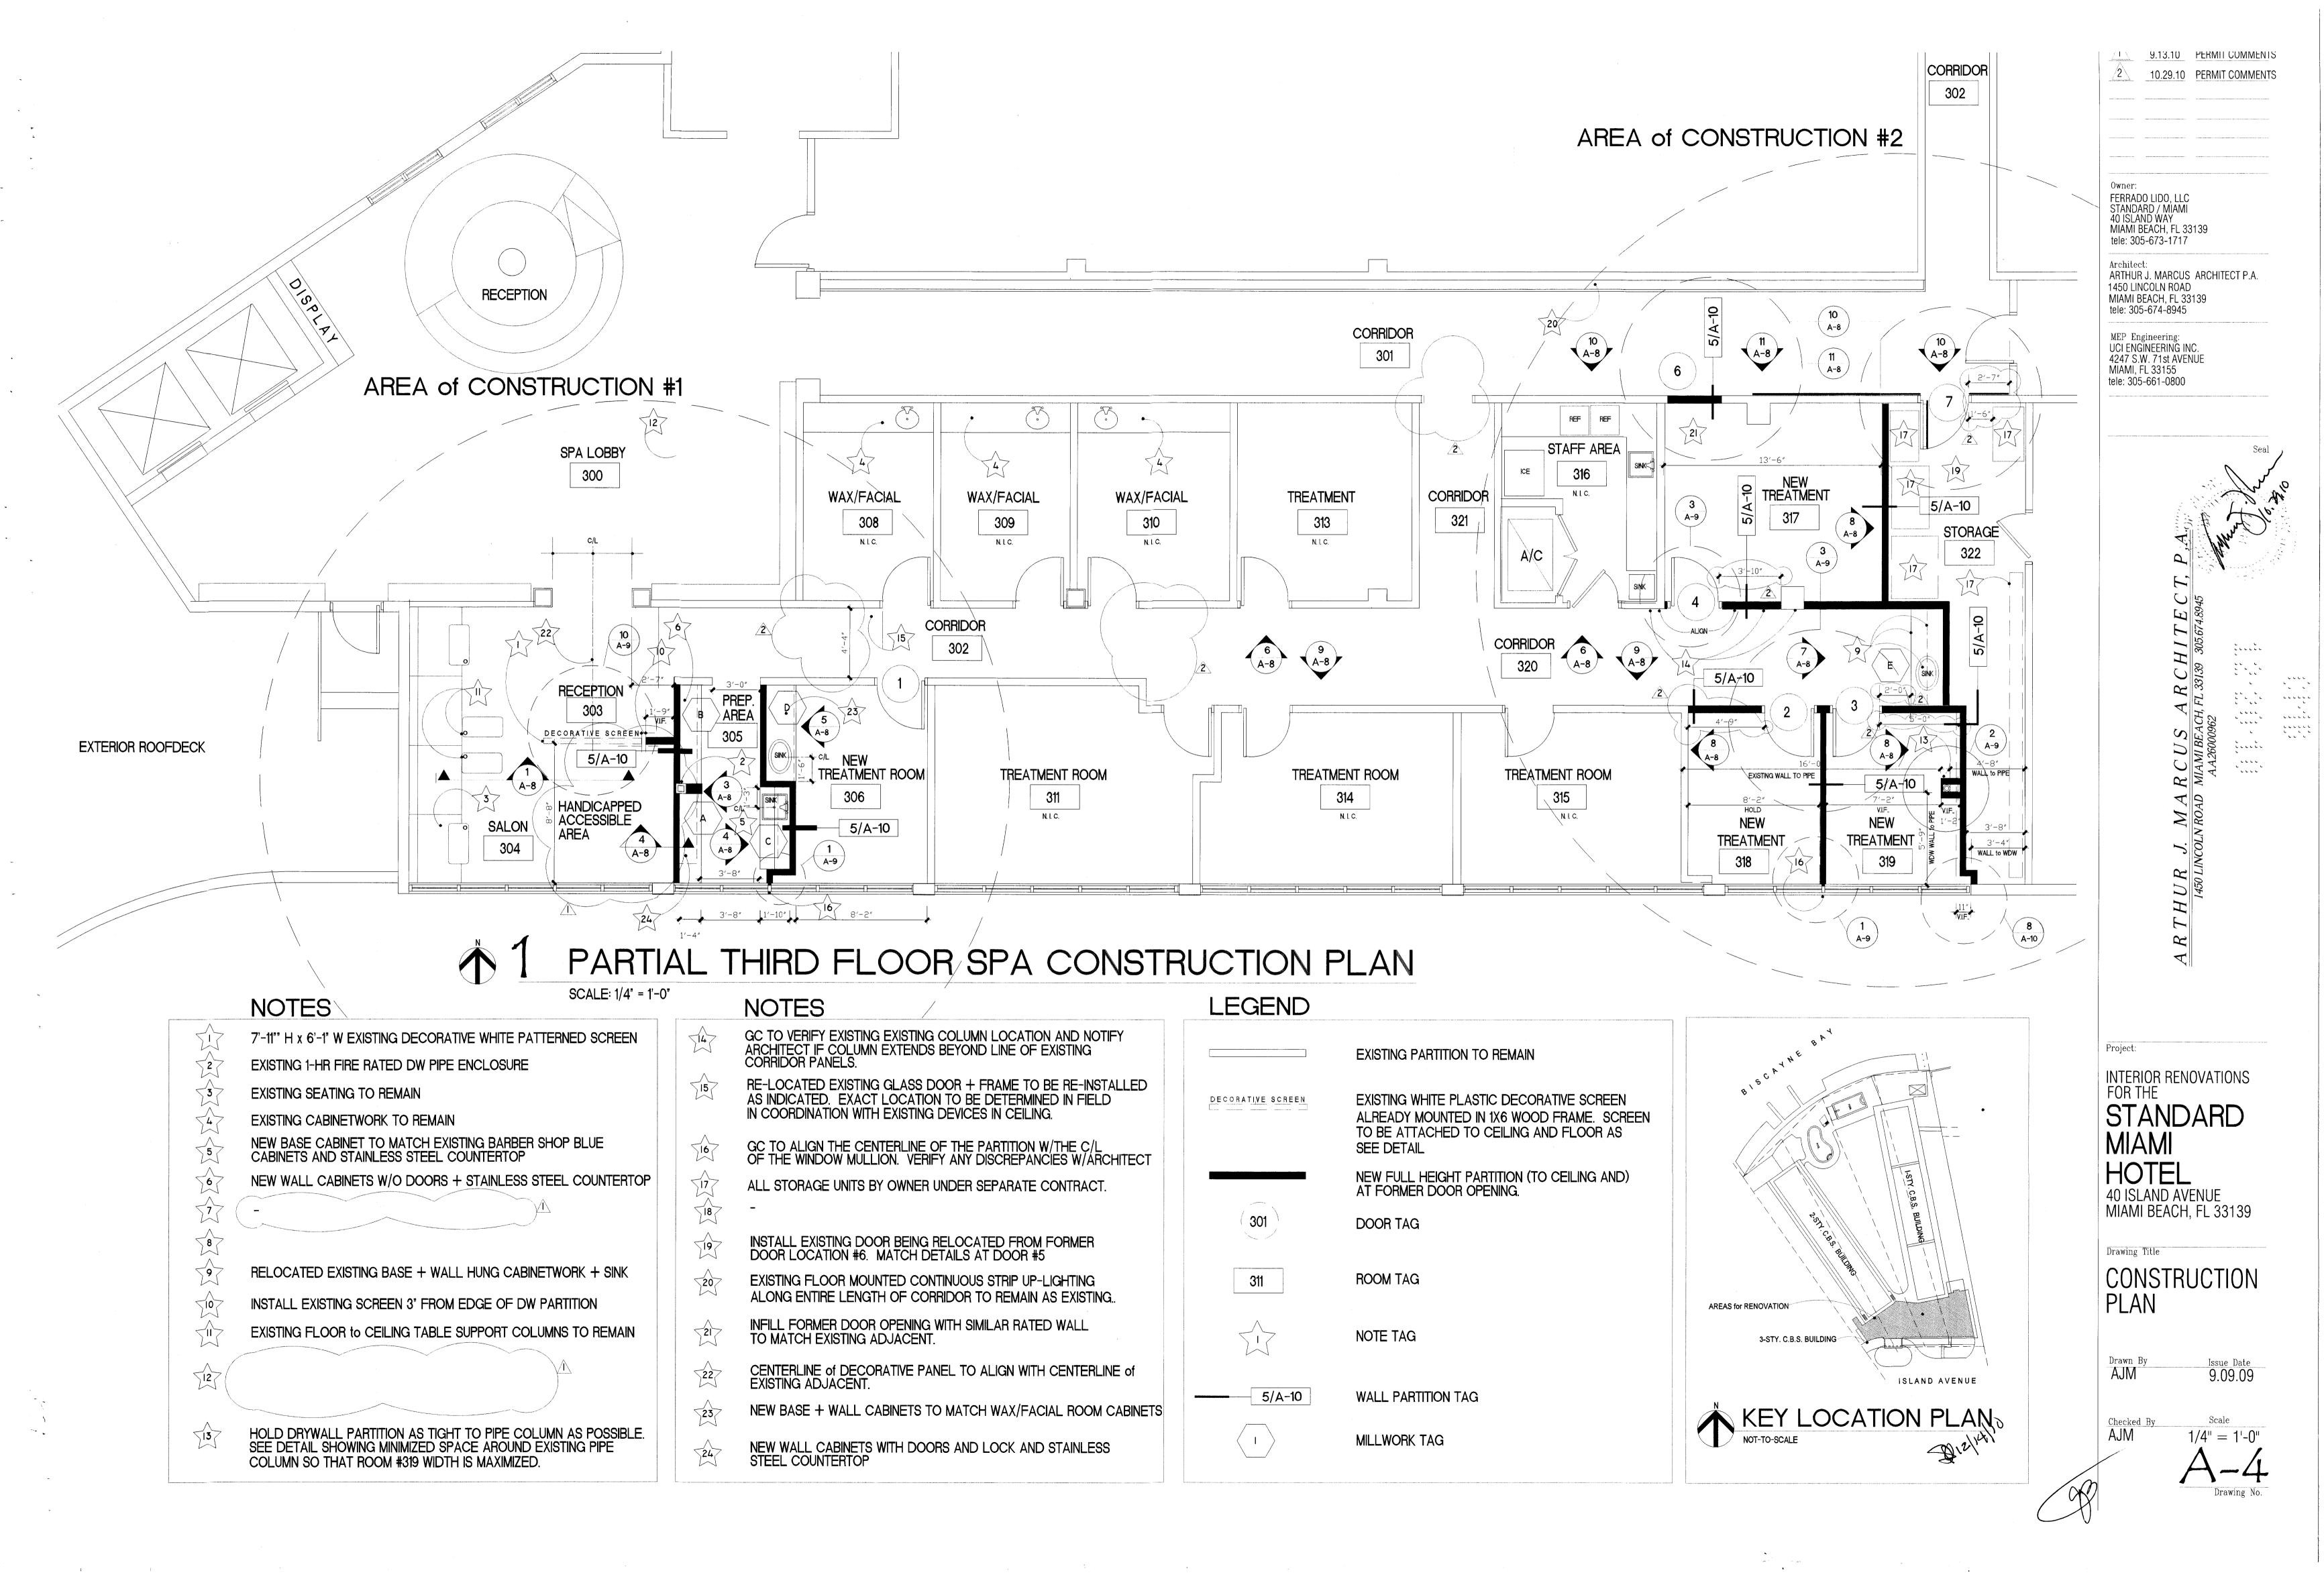

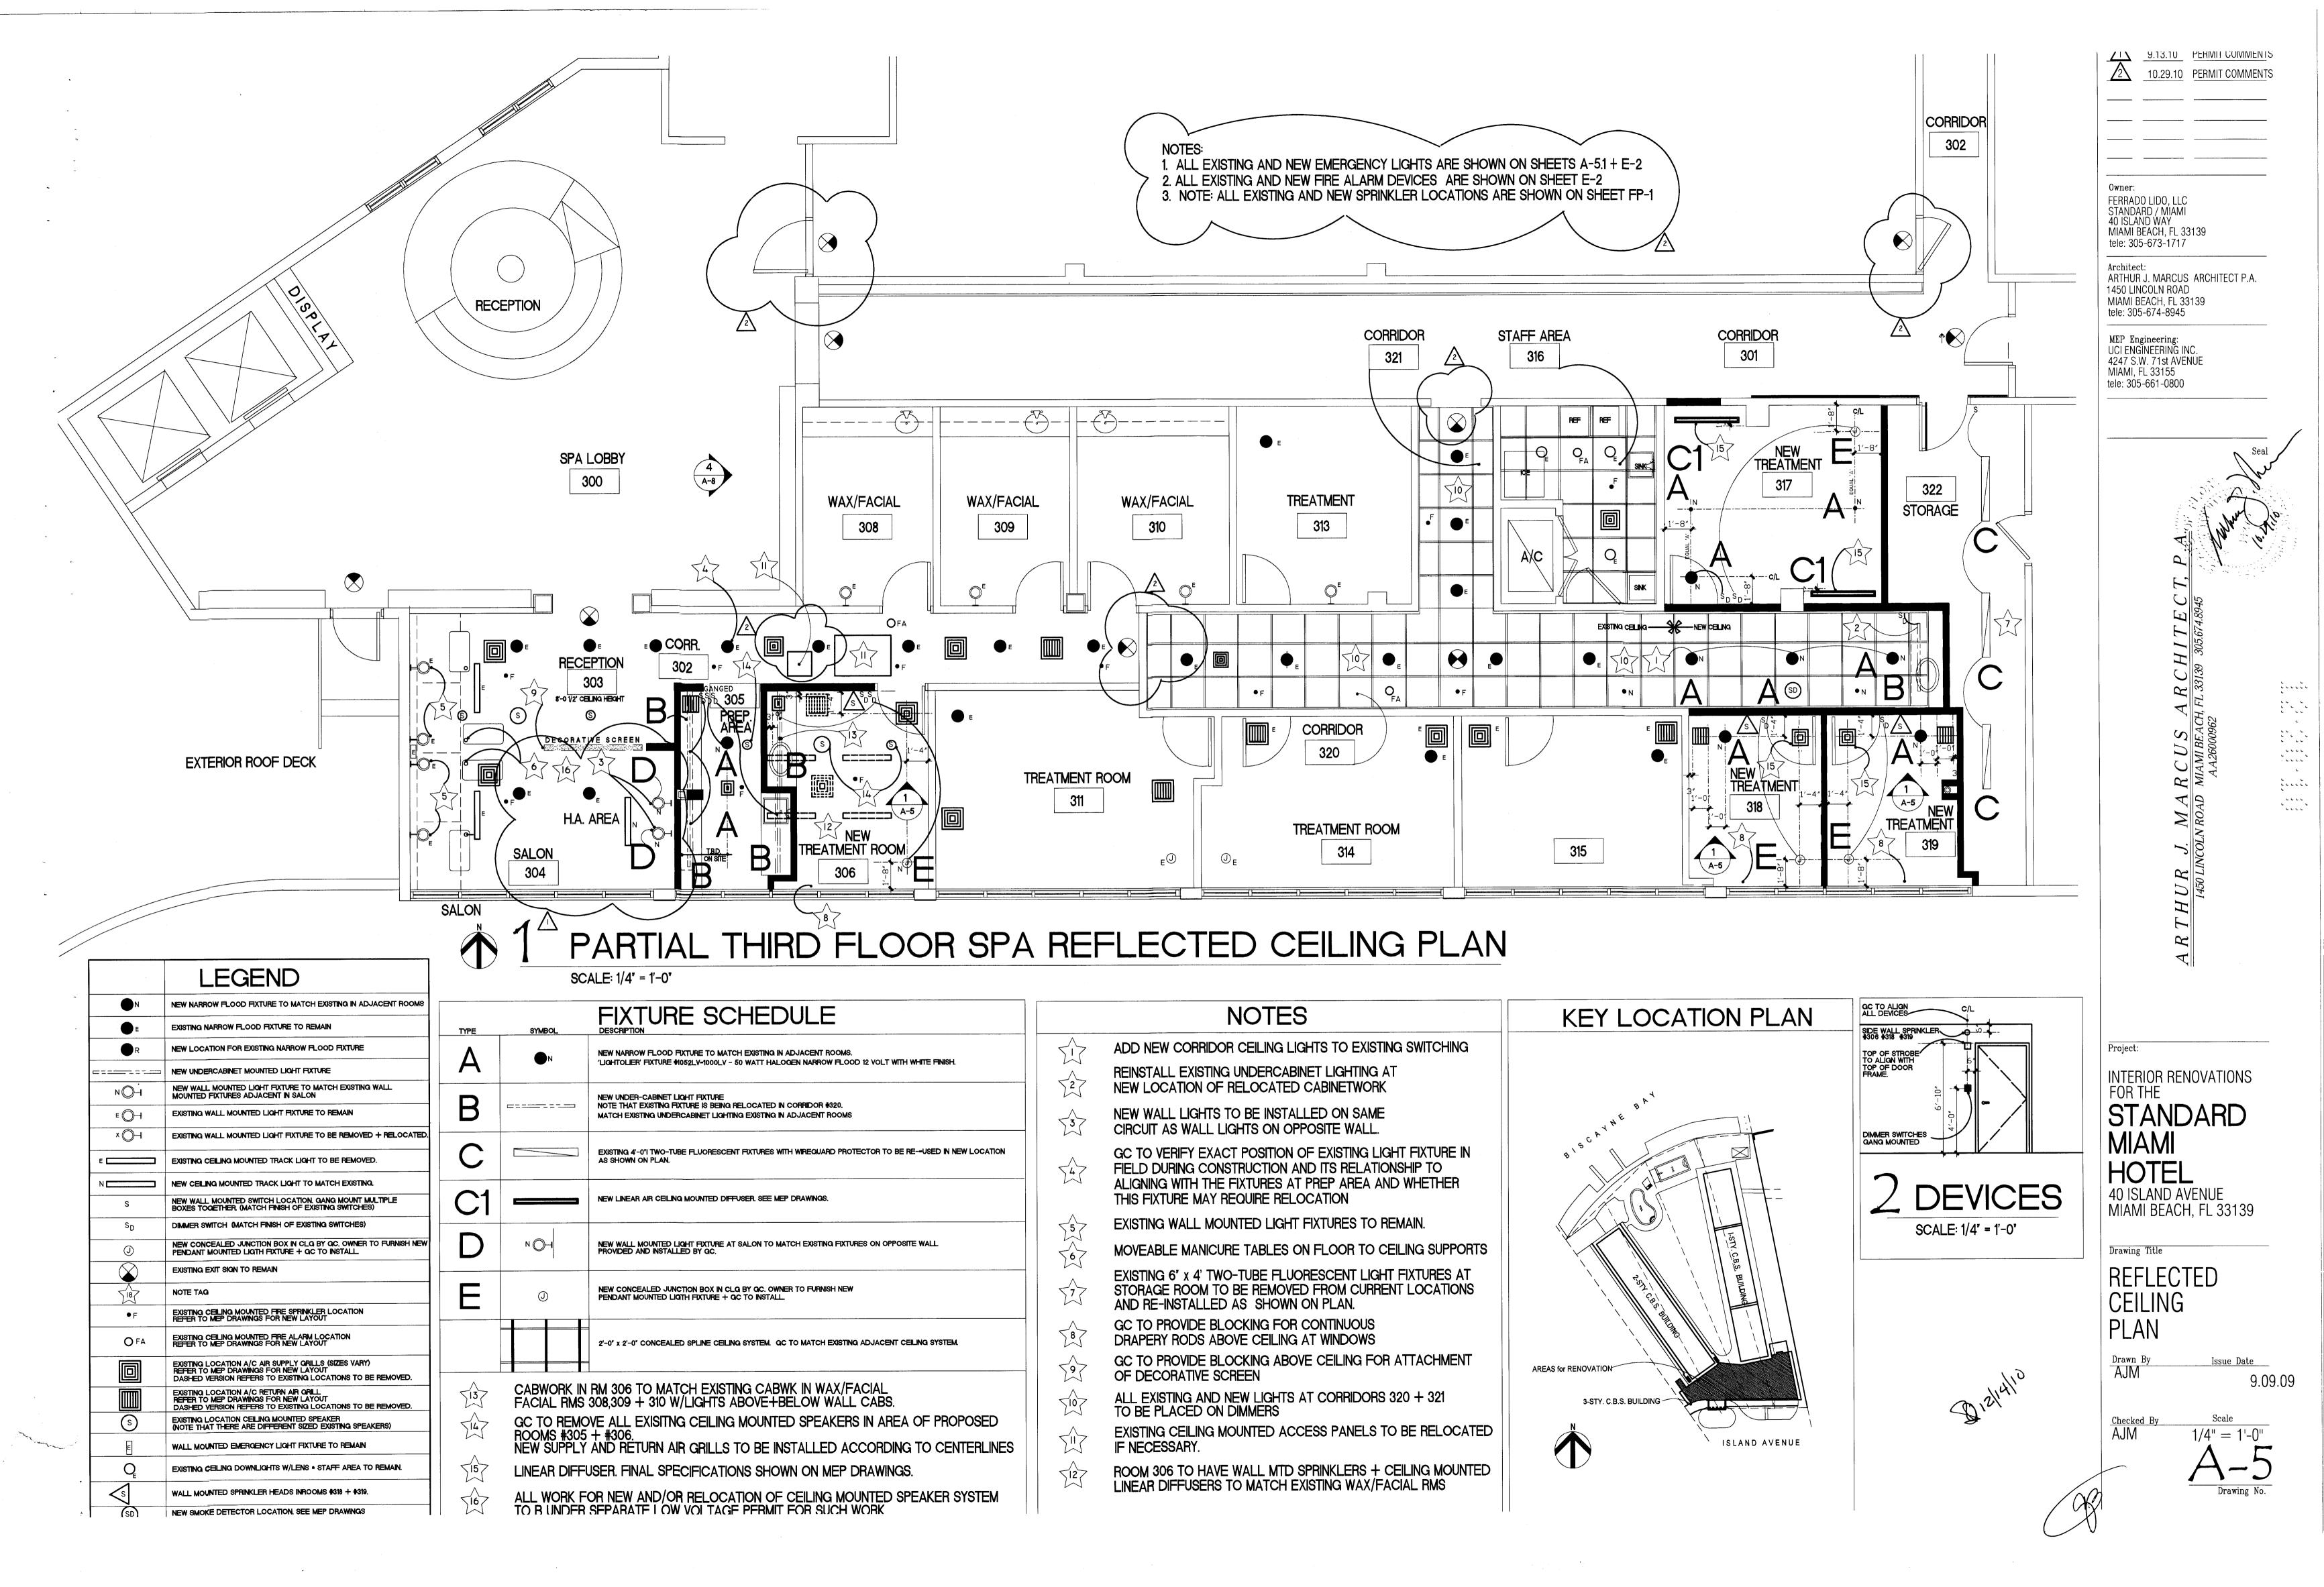

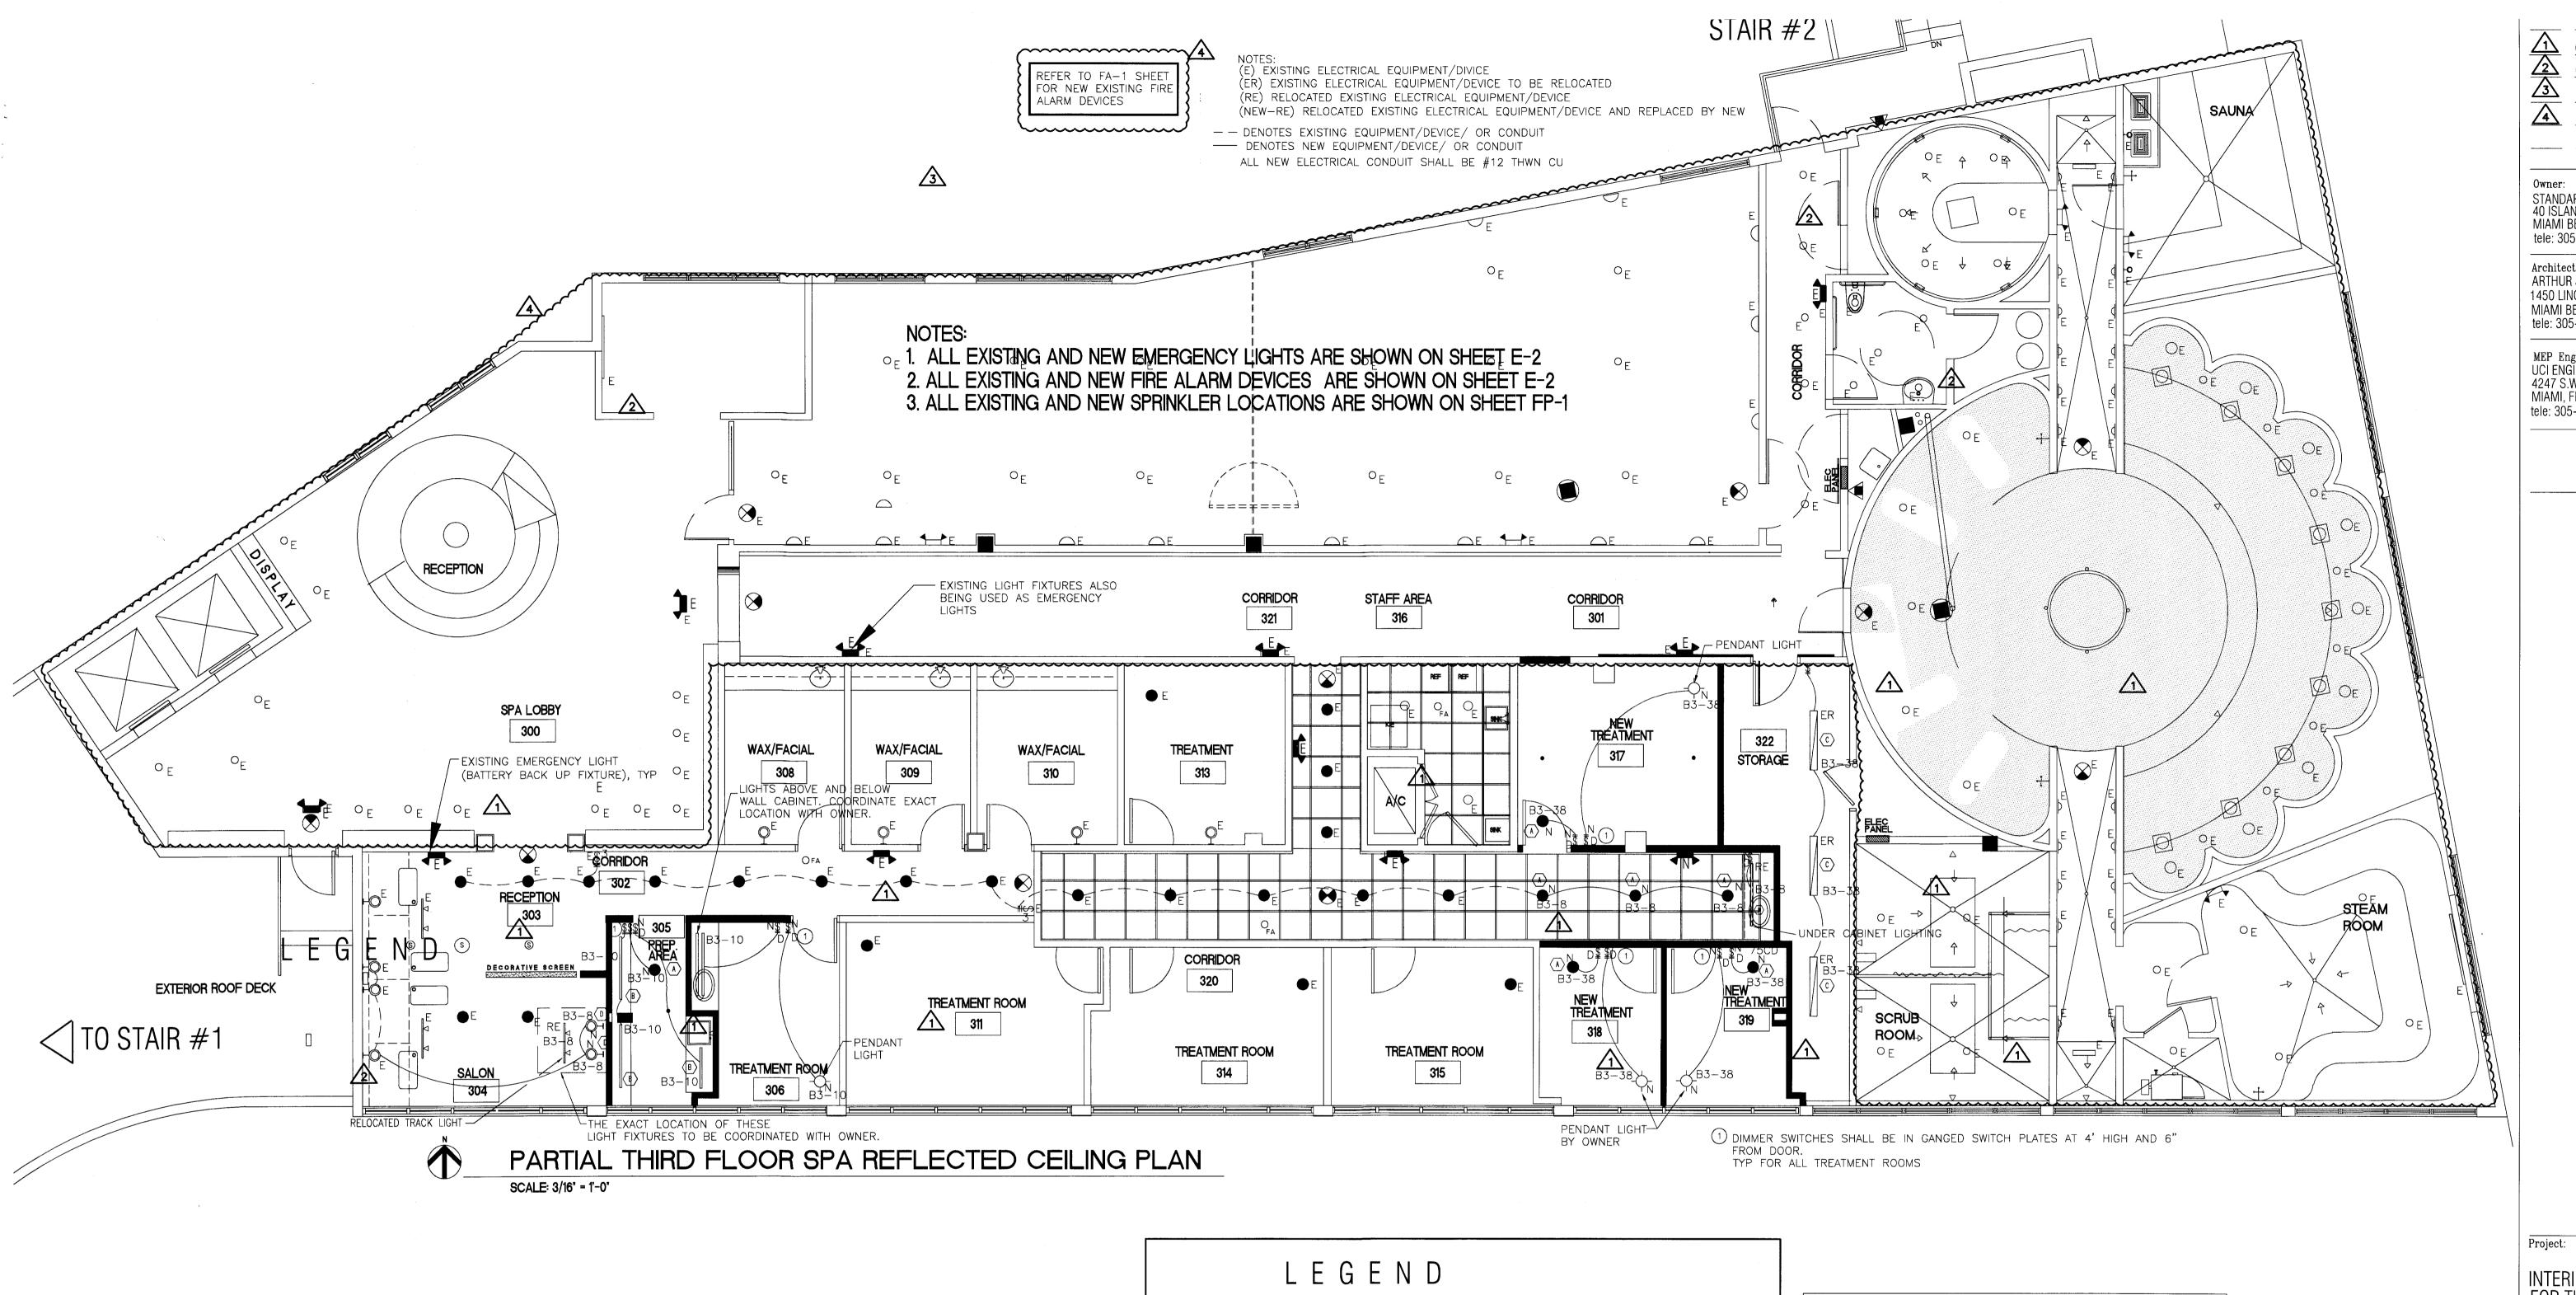

	LEGEND
<b>←</b> E	EXISTING EMERGENCY LIGHTING FIXTURE TO REMAIN. (BATTERY BACKUP FIXTURE)
<b>→</b> N	NEW EMERGENCY LIGHTING FIXTURE TO REMAIN. (BATTERY BACKUP FIXTURE)
	EXISTING CONSTRUCTION TO REMAIN
	NEW CONSTRUCTION

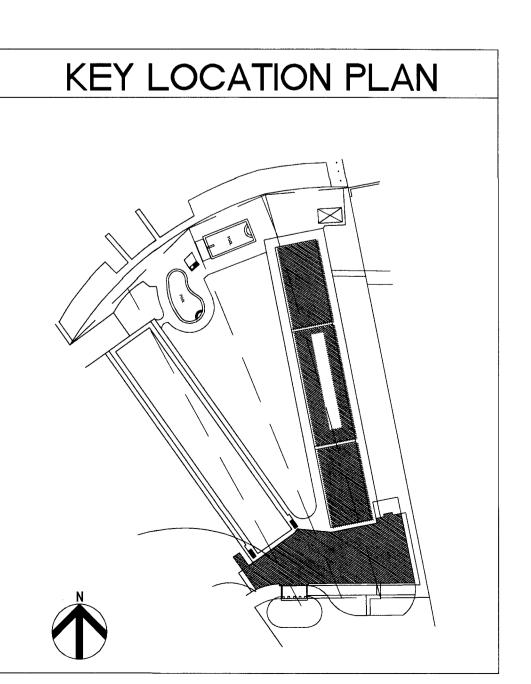




<u>1</u> 09/07/10 B.D.C 09/24/10 B.D.C 10/07/10 B.D.C 10/26/10 B.D.C

STANDARD / MIAMI 40 ISLAND WAY MIAMI BEACH, FL 33139 tele: 305-673-1717

Architect:
ARTHUR J. MARCUS ARCHITECT P.A.
1450 LINCOLN ROAD
MIAMI BEACH, FL 33139
tele: 305-674-8945

MEP Engineering: UCI ENGINEERING INC. 4247 S.W. 71st AVENUE MIAMI, FL 33155 tele: 305-661-0800

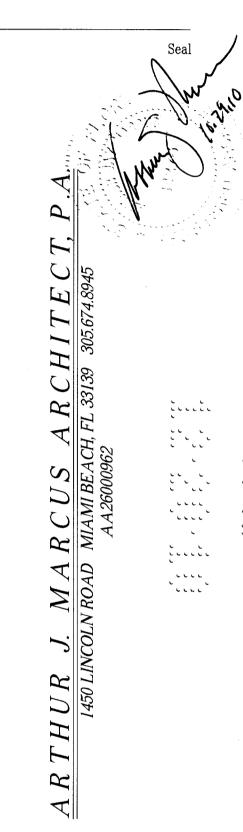

INTERIOR RENOVATIONS FOR THE STANDARD

# MIAMI HOTEL


FERRADO LIDO LTD 40 ISLAND AVENUE MIAMI BEACH, FL 33139

Drawing Title
EMERGENCY
LIGHTING
PLAN

Drawn By

10.29.10

Checked By

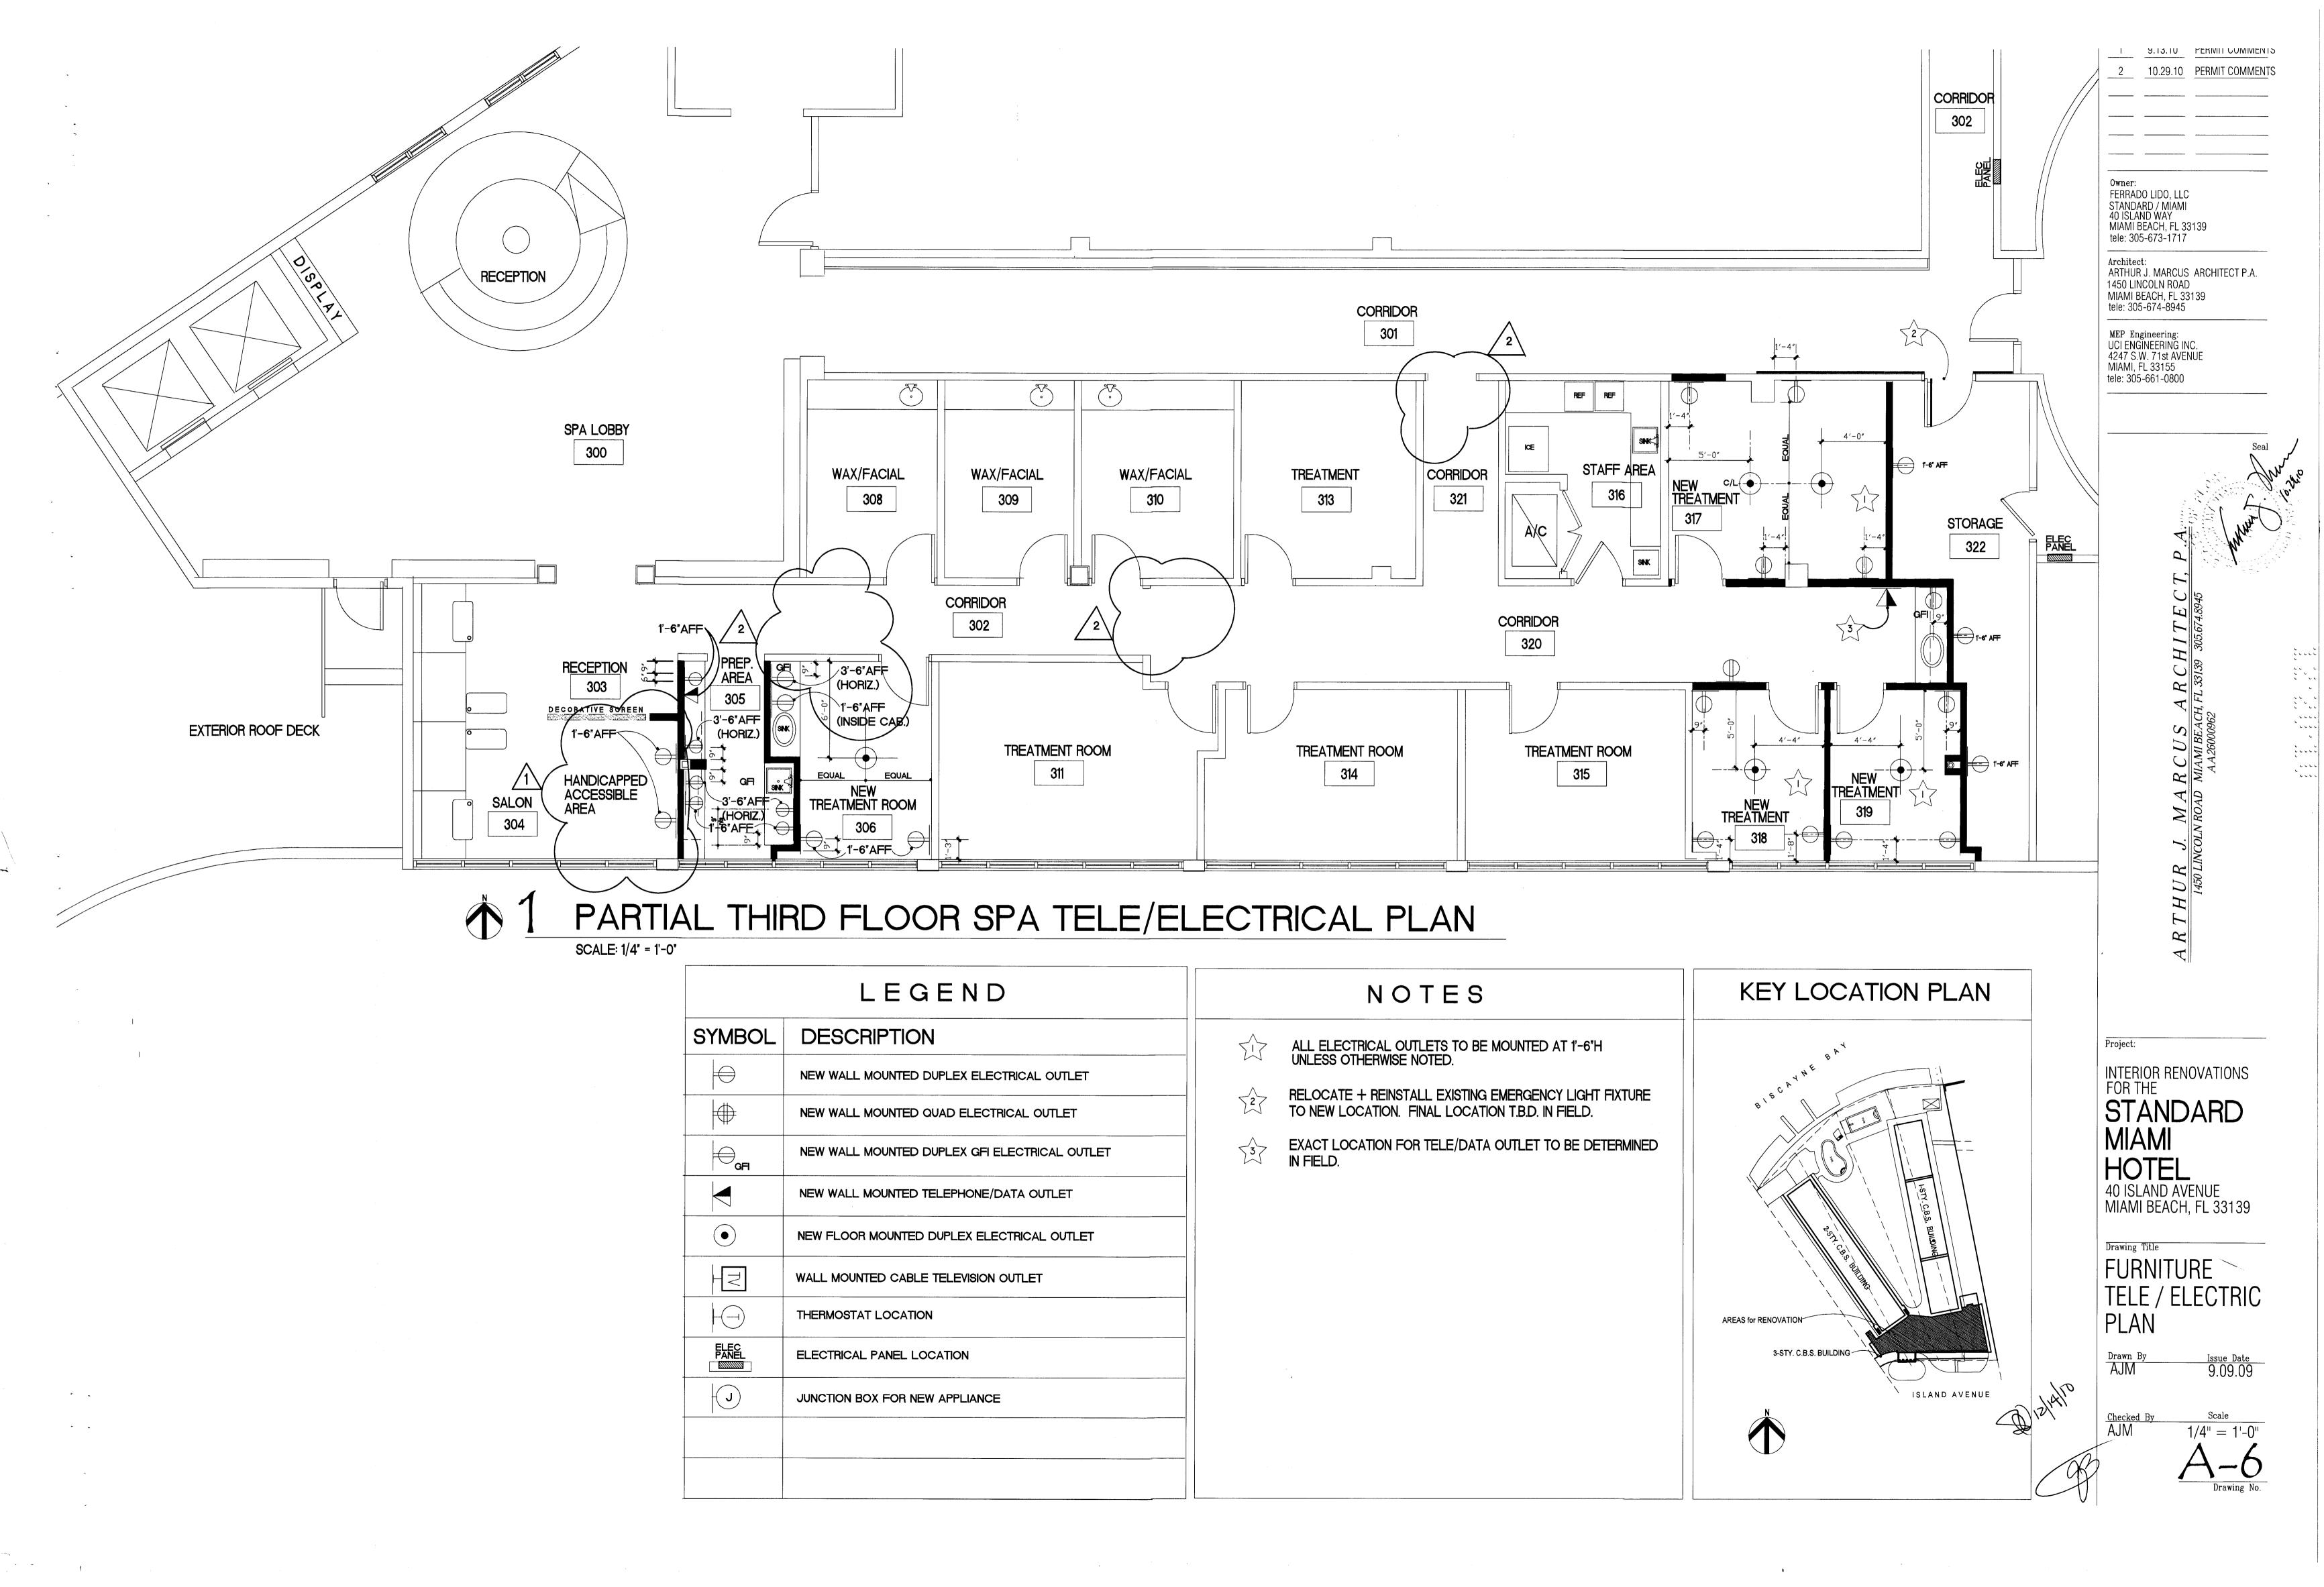


	·		MI	L	L W	0	RK	S	С	Н	E	D	U		E		
	MILLWORK NUMBER	ROOM NAME	ROOM #	CNTRTOP MATERIAL	CABINET MATERIAL	HARDWARE		TYPE				FINISH	1			REMARKS	
	A-I	PREP AREA	305	-	P. LAM.	1	WALL CA	BINET		PIONIT	E' FRENCH E	BLUE #SB005	5L PLASTIC LA	AMINATE	GC TO SUBMI	T SAMPLE FOR APPROVA	AL.
Æ X	A-2	PREP AREA	305	ST. STEEL	<u>-</u>	-	ST. STEEL	COUNTERTOP					W. 4	:	1		
N	B-I	PREP AREA	305	_	P. LAM.	-	WALL MO	UNTED OPEN SHELVING	<b>3</b>	PIONIT	E' FRENCH E	BLUE #SB005	5L PLASTIC LA	AMINATE	GC TO SUBMI	T SAMPLE FOR APPROVA	AL.
M	B-2	PREP AREA	305	ST. STEEL	P. LAM.	-	ST. STEEL	COUNTERTOP									
	C-I	PREP AREA	305	_	P. LAM.	-	WALL MO	UNTED OPEN SHELVING	3	PIONIT	E' FRENCH E	BLUE #SB005	5L PLASTIC LA	AMINATE	GC TO SUBMI	T SAMPLE FOR APPROVA	AL.
	C-2	PREP AREA	305	ST. STEEL	P. LAM.	_	ST. STEEL	COUNTERTOP OVER	BASE CABINET								
	D-I	NEW TREATMENT RI	м 306	P. LAM.	P. LAM.	2	'IKEA' AB	STRAKT SERIES CABINE	TS	COLO	R: WHITE				CABWK TO M ADJACENT	ATCH EXISTING WAX/FA	CIAL RMS
	D-2	NEW TREATMENT R	M 321			-											
	E																
	E	CORRIDOR #321	321	RELOCATE	EXISTING BAS	SE AND WALL	MOUNTED CABI	NET W/ BACKSPLASH	TO NEW LOCAT	ION AT CORR	IDOR.						

	NUMBER	ROOM NAME	ROOM #	EQUIPMENT NAME	CHEDULE
	Δ	PREP AREA	305	UTILITY SINK	ELKAY #ESSB2319C W/#14 GAUGE, TYPE 304 STAINLESSS STEEL SERVICE SINK WITH 1-3/4" RADIUS VERTICAL AND HORIZONTAL COVED CORNERS; WITH FULL LENGTH 1"-0" HIGH BACK-SPLASH.
	В	PREP AREA	318	FAUCET • UTILITY SINK	ELKAY #LK907BR03T4H COMMERCIAL WALL MOUNTED FAUCET. FINISH: CHROME, W/ TWO- 4" WRISTBLADE HANDLES,
	С	NEW TREATMENT ROOM	306	SINK	SINK TO MATCH SINKS AT EXISTING WAX/FACIAL ROOMS WHITE PORCELAIN SINK MFR: SIMAS ACQUA fI-13 15.5 cm x 31 cm
⊢ Z	D	NEW TREATMENT ROOM	306	FAUCET	FAUCET TO MATCH EXISTING CHROME FAUCETS AT WAX / FACIAL ROOMS.
PME	E	SALON	304	MANICURE POLE-MOUNT TABLE	HAFELE: SUPPORT POLE: GC TO PROVIDE BLOCKING AT CEILING 50 mm DIA POLES (2625mm) CAT. NO. 815.00.226 STEEL W/ CHROME PLATING www.hafele.com
EQU	F	SALON	304	MANICURE POLE-MOUNT TABLE	HAFELE: TABLE BRACKET FOR POLE SYSTEM: www.hafele.com SWIVEL- ARM MOUNT (10-1/8"W x 11=1/2"D x 2"H) CAT. #815.03.210 STEEL W/ CHROME PLATING HAFELE: 310-5252205
	G	SALON	304	MANICURE POLE-MOUNT TABLE	HAFELE: GLASS BOTTOM SHELF W/ SWIVEL ARM (10 1/4" DIA.) CAT. #815.08.210 STEEL W/CHROME PLATING www.hafele.com
	Н	SALON	304	MANICURE POLE-MOUNT TABLE	HAFELE: TABLE LEG WITH CASTER SYSTEM www.hafele.com 60mm BRUSHED STEEL CAT. #635.60.460


FINISH


SPECIFICATIONS

DOOR 7	TYPES
--------	-------

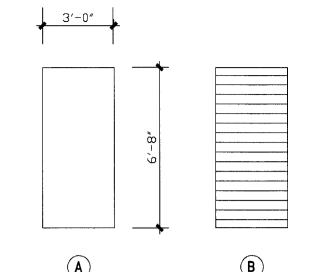

**NEW TREATMENT** ROOM DOOR TO MATCH EXISTING ADJACENT

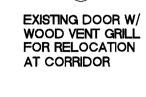

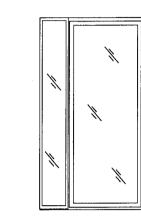

**c** EXISTING METAL FRAME AND GLASS DOOR TO BE RELOCATED TO NEW LOCATION AT CORR 302.

# INTERIOR FLAME-SPREAD FINISH CLASSIFICAT'N

PER NFPA 101 - LIFE SAFETY CODE 2006 SECTION 29.3.3.2 INTERIOR WALL & CEILING FINISHES for EXISTING HOTELS WITH AN APPROVED AUTOMATIC SPRINKLER SYSTEM

EXIT ENCLOSURES CLASS 'A, B or C' INTERIOR WALL & CLG FIN FLAME SPREAD 0-200, (NEW APPLICATIONS) SMOKE DEVEL<del>OPE</del>R 0-450. LOBBIES & CORRIDORS CLASS 'A or B' INTERIOR WALL & CLG FIN FLAME SPREAD 0-200, (NEW APPLICATIONS) SMOKE DEVELOPED 0-450.

OTHER SPACES

CLASS 'A OR B' INTERIOR WALL & CLG FIN FLAME SPREAD 0-200, (NEW APPLICATIONS)

SMOKE DEVELOPED 0-450. INTERIOR FLOOR FINISHES CLASS I or CLASS II INTERIOR FLOOR FINISH WITH CRITICAL RADIANT FLUX OF

NOT LESS THAN 0.22 W/cm<sup>2</sup>
BUT LESS THAN 0.45 W/cm<sup>2</sup>
SMOKE DEVELOPED 0-450.

				5		0	(	<u> </u>	F	3	·		S	(	2		H		E		D	)	U				E	-	
				Ę			5	SIZE							D	ES	CF	IPT	101		F	RAN	ME	THRE	ESH	<del>l</del> OL	D	눓	
FLOOR	DOOR NUMBER	ROOM NAME	ROOM #	IMPACT-RESISTANT	DOOR TYPE	HARDWARE SET	PAIR	HEIGHT	THICKNESS	UNDERCUT	MATERIAL	HSINEH	LABEL	BI-FOLD	LOWERED	FLUSH	GLASS	SLID MIRROR	POCKET BYPASS	ASTRAGAL	ROLL-UP	MATERIAL	FINISH		STONE	MARBLE	ALUMINUM	CLOSER GLAZED SIDELIGHT	
					1																								
	1	NEW TREATMENT ROOM	306		(A)	2 \	3'-0	<b>"</b> 6'-8"	1-5/8	1/2"	SC WD	PTD				•					,	STL	PTD.						MATCH INSTALLATION OF TREATROOM DOORS ADJACENT.
THREE	2	NEW TREATMENT ROOM	318		A	2	3'-0	6'-8"	1-5/8*	1/2"	SC WD	PTD				•					ű	STL.	PTD.						MATCH INSTALLATION OF TREATROOM DOORS ADJACENT.
Ĕ.	3	NEW TREATMENT ROOM	319		A	2	3'-0	6'-8"	1-5/8"	1/2"	SC WD	PTD				•					ű	STL	PTD.						MATCH INSTALLATION OF TREATROOM DOORS ADJACENT.
LEVEL	4	NEW TREATMENT ROOM	317		(A)	2 <	3'-0	<b>"</b> 6'-8"	1-5/8	1/2"	SC WD	PTD				•					ű	STL	PTD.						MATCH INSTALLATION OF TREATROOM DOORS ADJACENT.
	5	CORRIDOR #321	321		_	\ <u>\</u> -	EXIS	STING E	OOR 1	O REM	<b>NAN</b>																		
	6	NEW TREATMENT ROOM	317		_	2	SEA	L EXIS	TING O	PENIN	G AND F	ELOCA	TE DOC	PR.															
	7	STORAGE ROOM	322		B	\\ - <u>/</u>	RE-	USE EX	STING	DOOI	R + REL	OCATE										STL	PTD.		•		•	•	NEW LOCATION FOR EXISTING DOOR
		CORRIDOR	302		C	(-)	REM	OVE T	WO EX	STING	CORRID	OR DO	OR)+ FF	RAME +	SIDE	LIGH	•											• •	NEW LOCATION FOR EXISTING DOOR

C - REMOVE TWO EXISTING CORRIDOR DOOR + FRAME + SIDELIGHT • 1 HARDWARE SETS FOR ALL DOORS TO BE PASSAGE LATCHSET, TO MATCH EXISTING HARDWARE ON NEARBY SIMILAR DOORS

2 DOOR HARDWARE TO BE 'HAFELE' TUBULAR PRIVACY LATCH TO MATCH EXISTING SIMILAR DOOR HARDWARE ADJACENT,


HARDWARE NOTE #1: RE-USE EXISTING HARDWARE FROMBARBER SHOP TO BE DEMOLISHED

HARDWARE NOTE #2: CABINET DOOR + DRAWER HANDLES TO BE 'HEWI' NYLON PULL CAT. #158.73.0.52 - CONFIRM COLOR WITH EXISTING IN ADJACENT ROOMS

			F	ΙN	I S	Н	SC	H	E D U	L E		
				W	A L L	S	FLOOR	BASE	CEILING HEIGHT	CEILING	REMARKS	
R	OOM NAME	ROOM #	NORTH	EAST	SOUTH	WEST						
CORRID	OR	301	EXIST. TO REMAIN	(3)	EXIST. WD. SLAT CEILING TO REMAIN	EXIST. WD. SLAT. CEILING SYSTEM TO REMAIN	TOUCH-UP EXISTING WOOD SLATS WHERE NEEDED-MATCH EXIST. FINISH					
CORRIDO	OR	302	_	-	-	-	EXIST. TO REMAIN	(3)	EXISTING TO REMAIN	EXISTING TO REMAIN	TOUCH-UP PAINT AS NEEDED	
RECEPT	ION	303	PTD DW (W-1)	PTD DW (W-1)	PTD DW (W-1)	PTD DW (W-1)	EXIST. TO REMAIN	(3)	8'-0 1/2"	C-1	PATCH, FILL + REPAIR EXISTING EPOXY FLOOR AND PAINT ENTIRE AREA.	
SALON		304	PTD DW (W-1)	PTD DW (W-1)	PTD DW (W-1)	PTD DW (W-1)	F-2	(3)	8'-0 1/2"	C-1	PATCH, FILL + REPAIR EXISTING EPOXY FLOOR AND PAINT ENTIRE AREA.	
PREPAR	ATION AREA	305	PTD DW (W-1)	PTD DW (W-1)	PTD DW (W-1)	PTD DW (W-1)	F-2	(3) 8'-0 1/2"		C-1	PATCH, FILL + REPAIR EXISTING EPOXY FLOOR AND PAINT ENTIRE AREA.	
NEW TRE	EATMENT ROOM	306	PTD DW (W-2)	PTD DW (W-2)	PTD DW (W-2)	PTD DW (W-2)	F-2	(3)	8'-0 1/2°	C-1	PATCH, FILL + REPAIR EXISTING EPOXY FLOOR AND PAINT ENTIRE AREA.	
NEW TRE	EATMENT ROOM	317	PTD DW (W-2)	W-4	PTD DW (W-2)	PTD DW (W-2)	F-1	(3)	8'-3' C-1			
NEW TRE	EATMENT ROOM	318	PTD DW (W-2)	PTD DW (W-2)	PTD DW (W-2)	W-4	F-1	(3)	8'-3"	C-1		
NEW TRE	EATMENT ROOM	319	PTD DW (W-2)	W-4	PTD DW (W-2)	PTD DW (W-2)	F-1	(3)	8'-3"	C-1		
CORRIDO	OR	320	W-3	CABINETS	WD PANELS	2) EXISTING DOOR	F-1	(3)	8'-0" (ALIGN W/EXIST. ADJ. DW CEILING)	C-1	SEE ELEVATIONS 6/A-8 + 9/A-8 FOR EXTENT OF NEW WOOD PANELS	
STORAG	BE ROOM	322	PTD DW (W-2)	PTD DW (W-2)	PTD DW (W-2)	PTD DW (W-2)	EXIST. TO REMAIN	NONE	8'-3"	C-1		
			•									

- (1) The wood in the treatment rooms is to be sand-blasted in order to make the grain stand out. GC and sub-contractors to verify the wood species and to match existing.
- (2) The wood in the Corridors is to match the existing wood grain adjacent.. GC and sub-contractors to verify the wood species and to match existing.
- (3) Match existing 2-1/2" high wood base adjacent

the same and the s

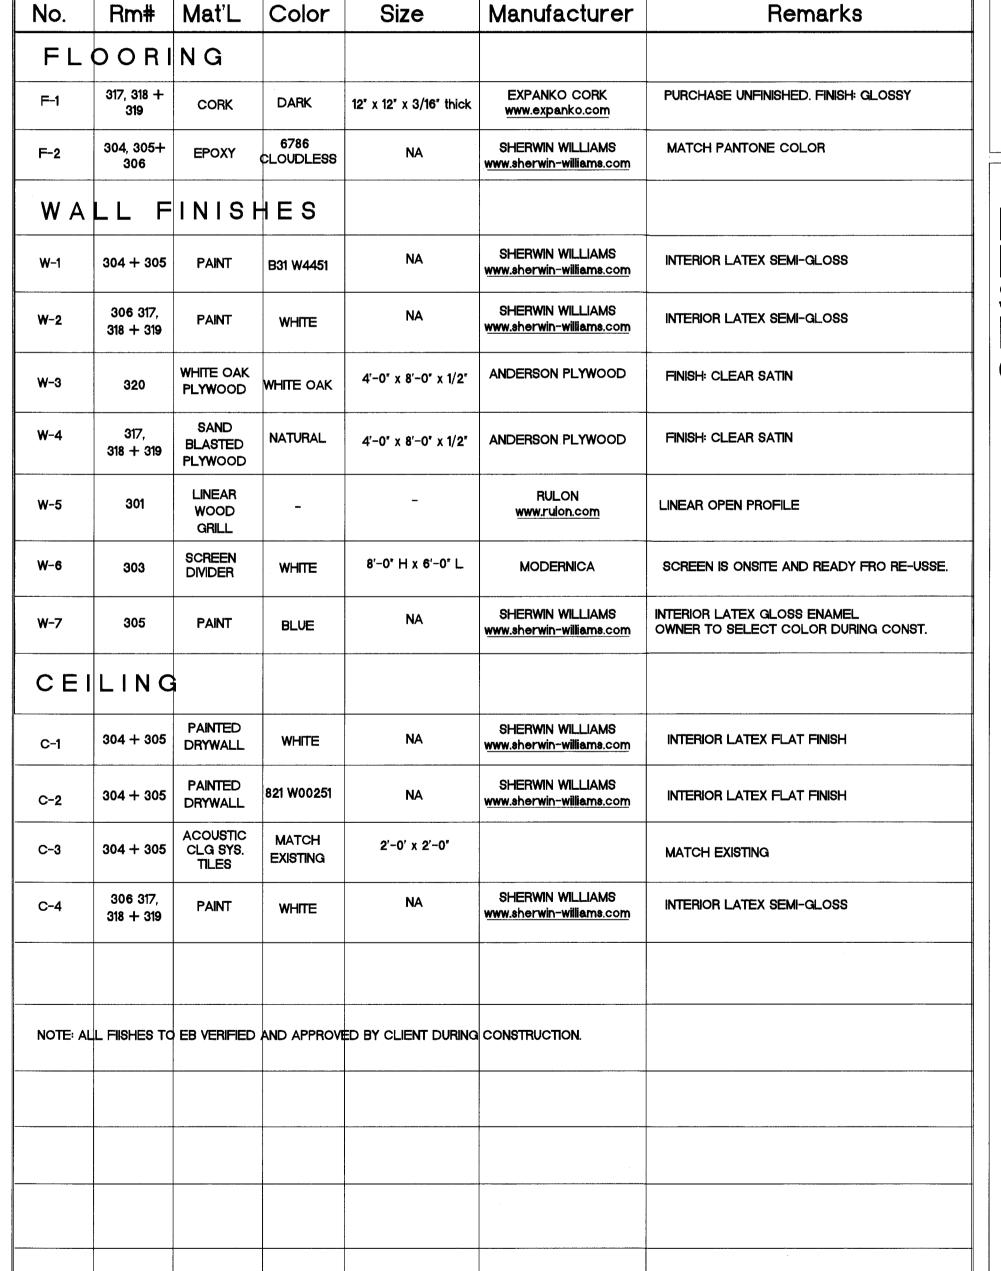

Project: INTERIOR RENOVATIONS FOR THE

TU.29.TU TENIVITI GOIVIIVILINTO

FERRADO LIDO, LLC STANDARD / MIAMI 40 ISLAND WAY

Architect:

MIAMI BEACH, FL 33139 tele: 305-673-1717

1450 LINCOLN ROAD MIAMI BEACH, FL 33139

4247 S.W. 71st AVENUE

tele: 305-674-8945

MEP Engineering: UCI ENGINEERING INC.

MIAMI, FL 33155

tele: 305-661-0800

ARTHUR J. MARCUS ARCHITECT P.A.

HOTEL 40 ISLAND AVENUE


MIAMI BEACH, FL 33139 Drawing Title

**SCHEDULES** 

Drawn By AJM

Checked By

Drawing No.

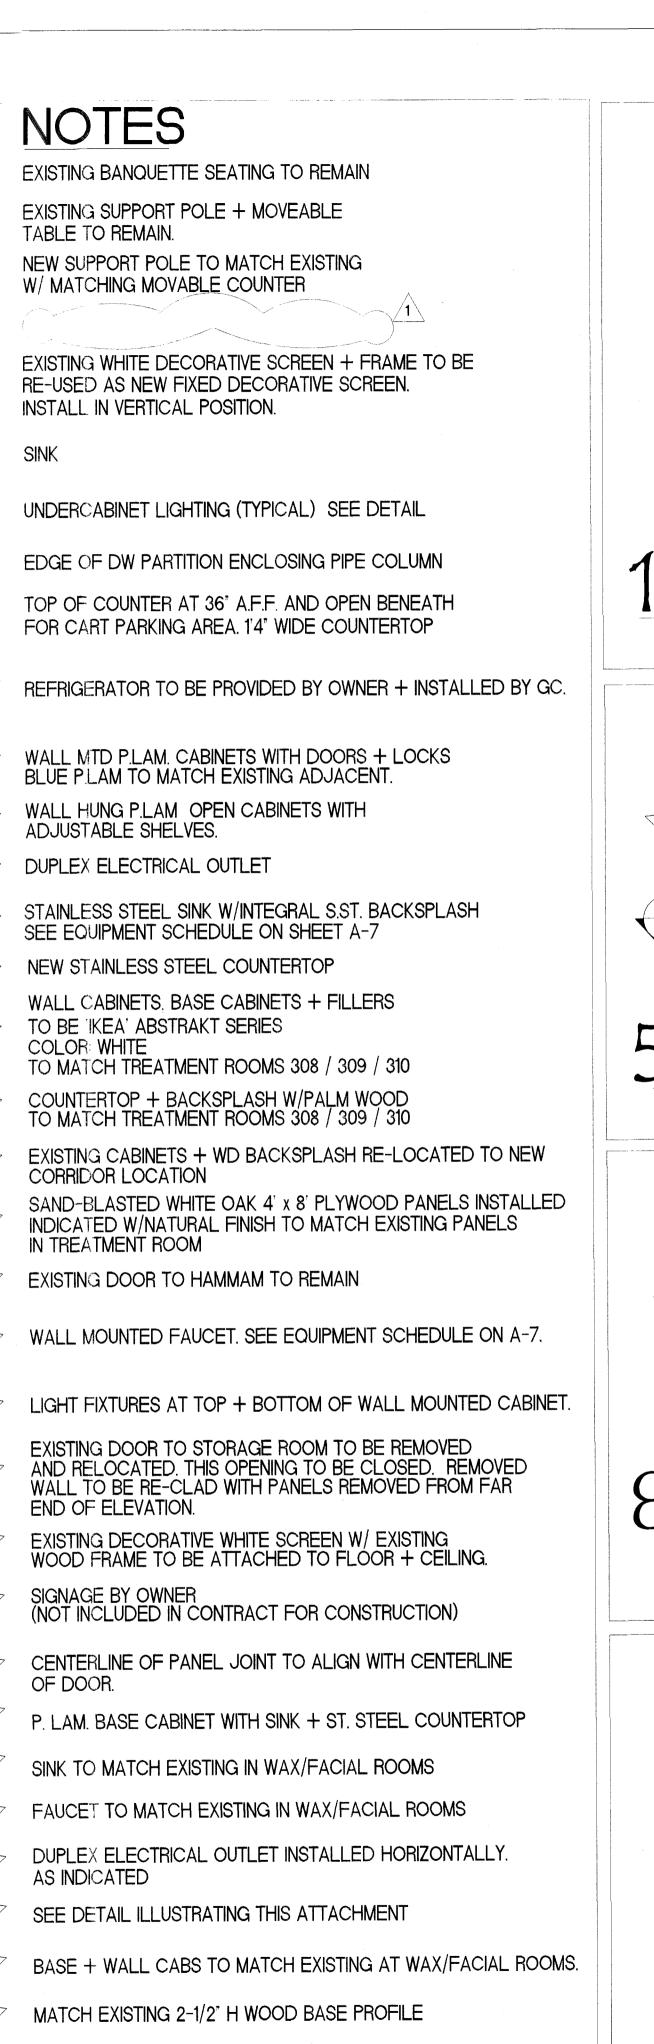


ONE PANEL - NO JOINT

1/2" DIA. HALF-ROUND WOOD MOULDING AT ALL WD. PANEL JOINTS

MATCH DETAIL IN EXISTING ROOMS #311 + #314.

EXIST. ELEVATION

SCALE: 3/8" = 1'-0"

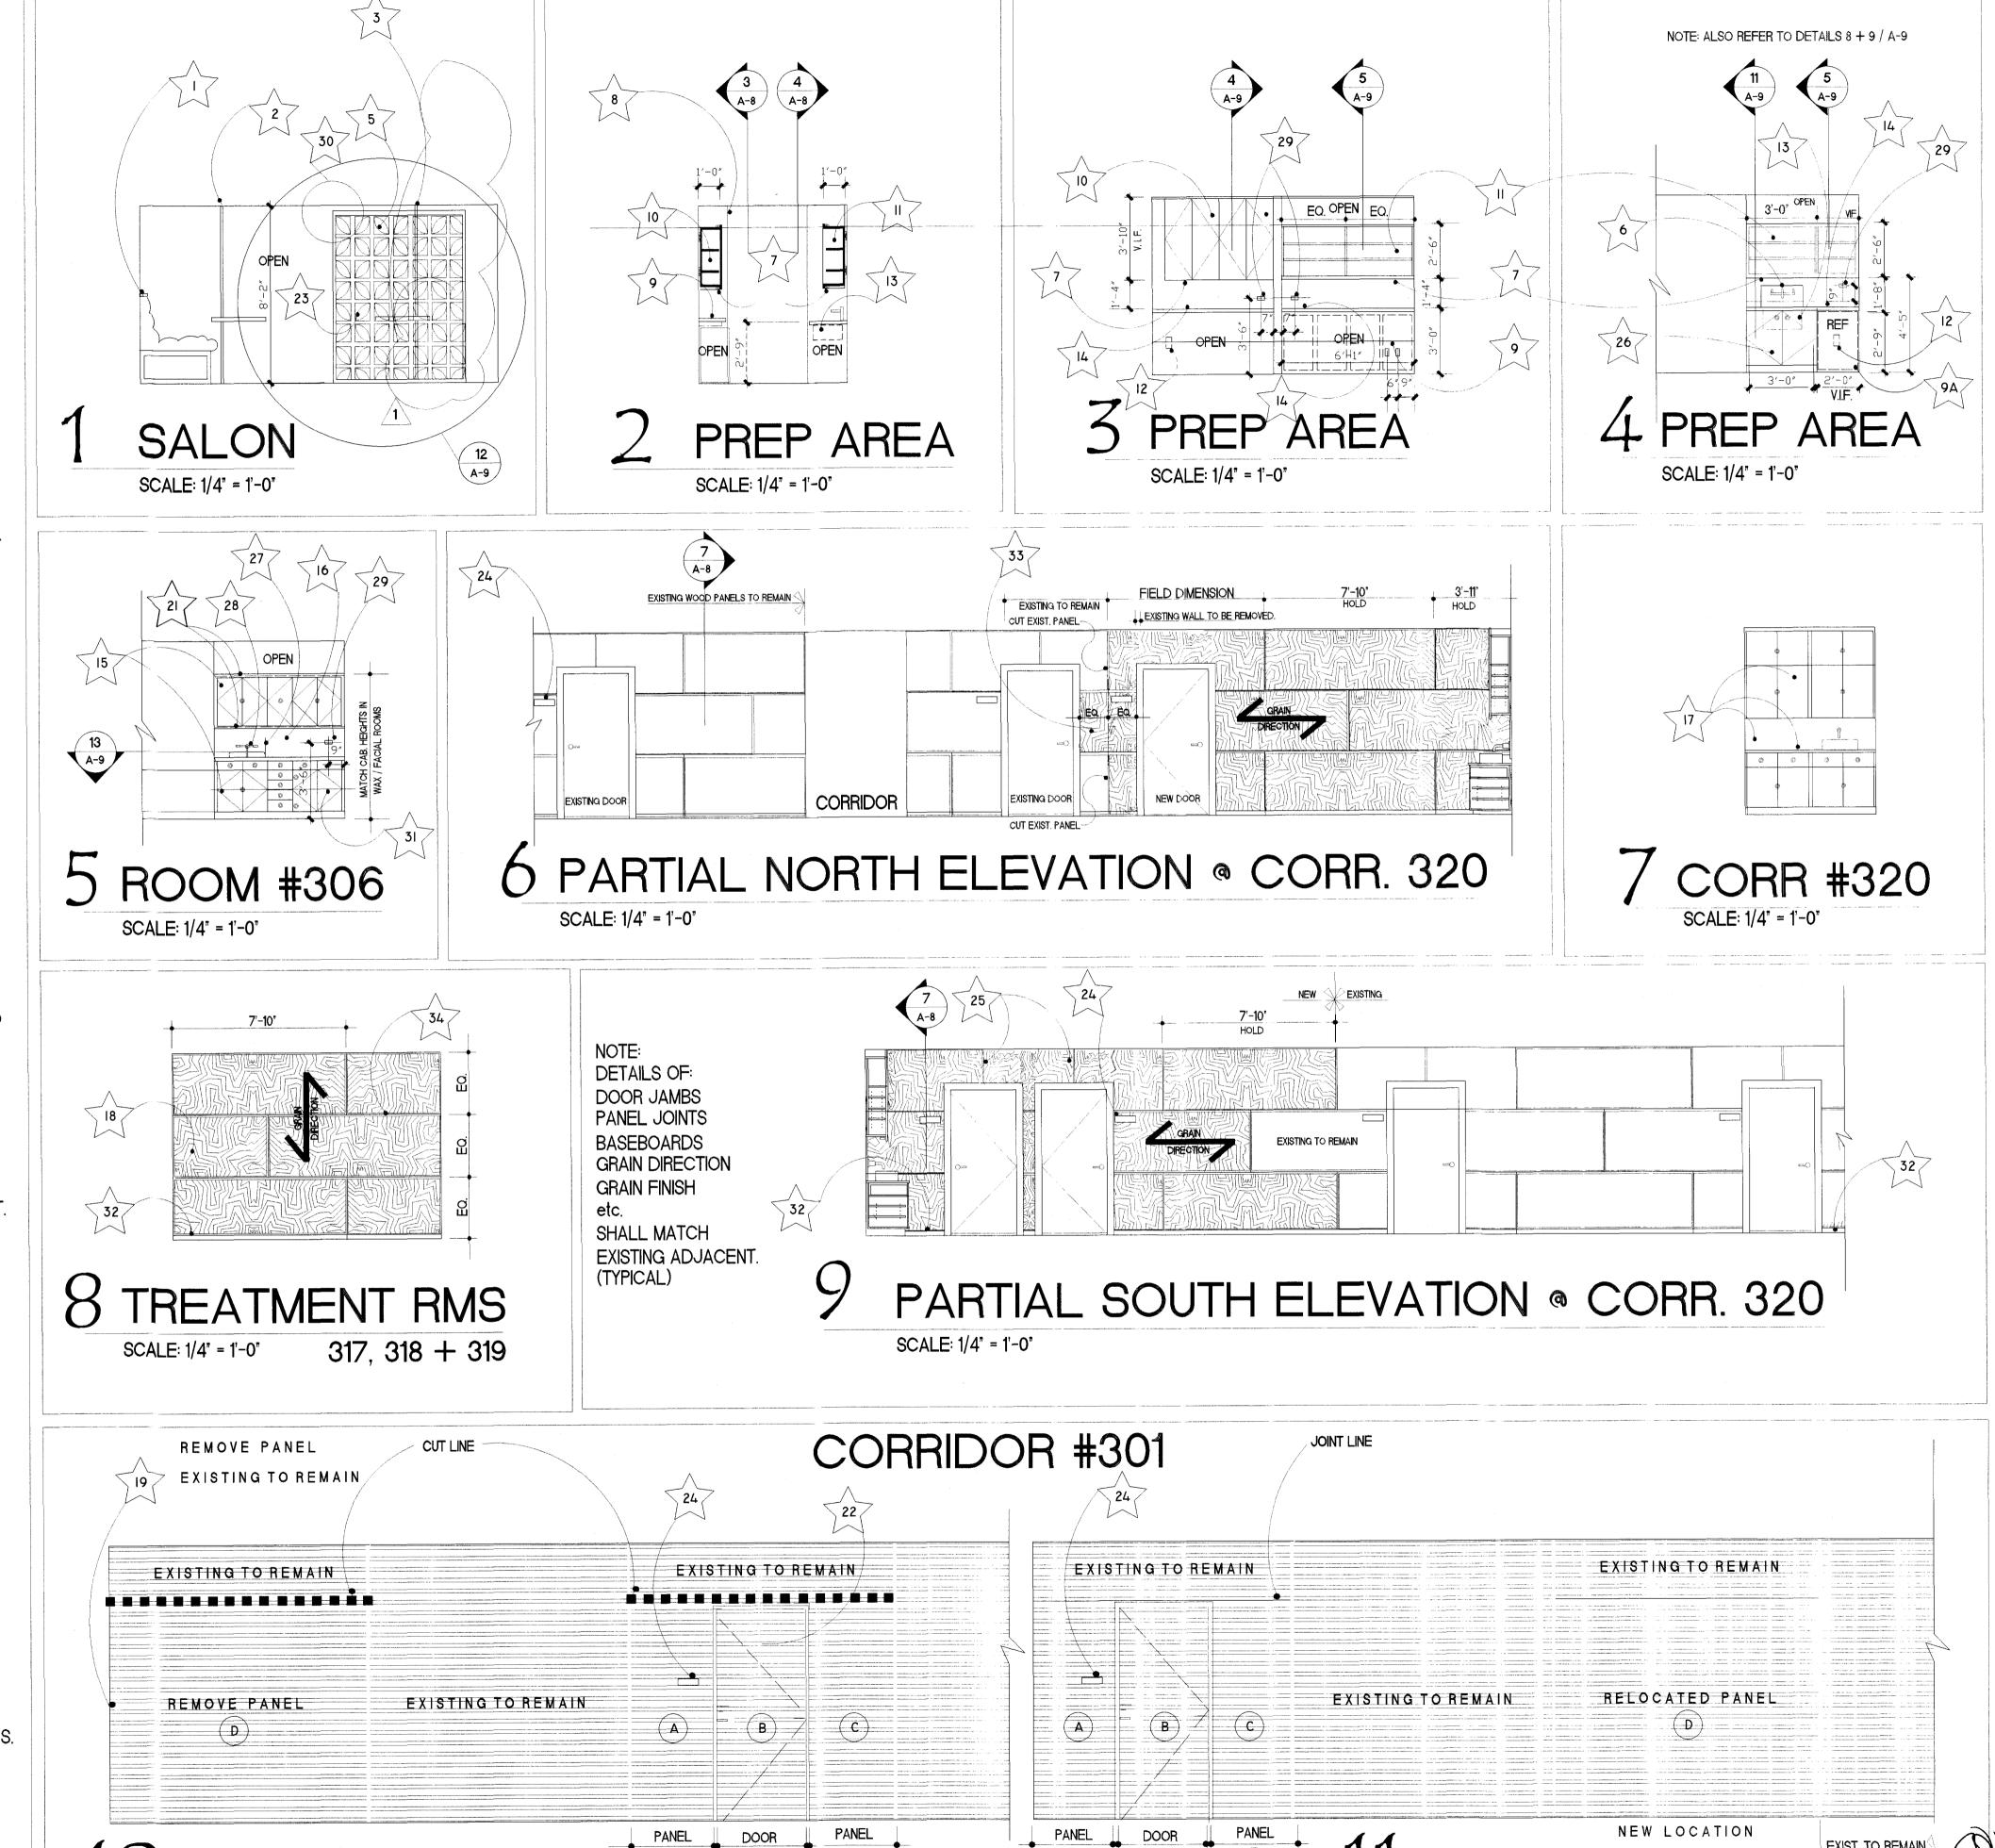

9.13.10 PERMIT COMMENTS FERRADO LIDO, LLC STANDARD / MIAMI 40 ISLAND WAY MIAMI BEACH, FL 33139 tele: 305-673-1717 1450 LINCOLN ROAD MIAMI BEACH, FL 33139 tele: 305-674-8945 MEP Engineering: UCI ENGINEERING INC. 4247 S.W. 71st AVENUE MIAMI, FL 33155 tele: 305-661-0800

INTERIOR RENOVATIONS
FOR THE

STANDARD

MIAMI

HOTEL

40 ISLAND AVENUE

MIAMI BEACH, FL 33139


INTERIOR
FLEVATIONS

n By M

9.09.09

AJM

1/4" = 1'-0" A - 8Drawing No.

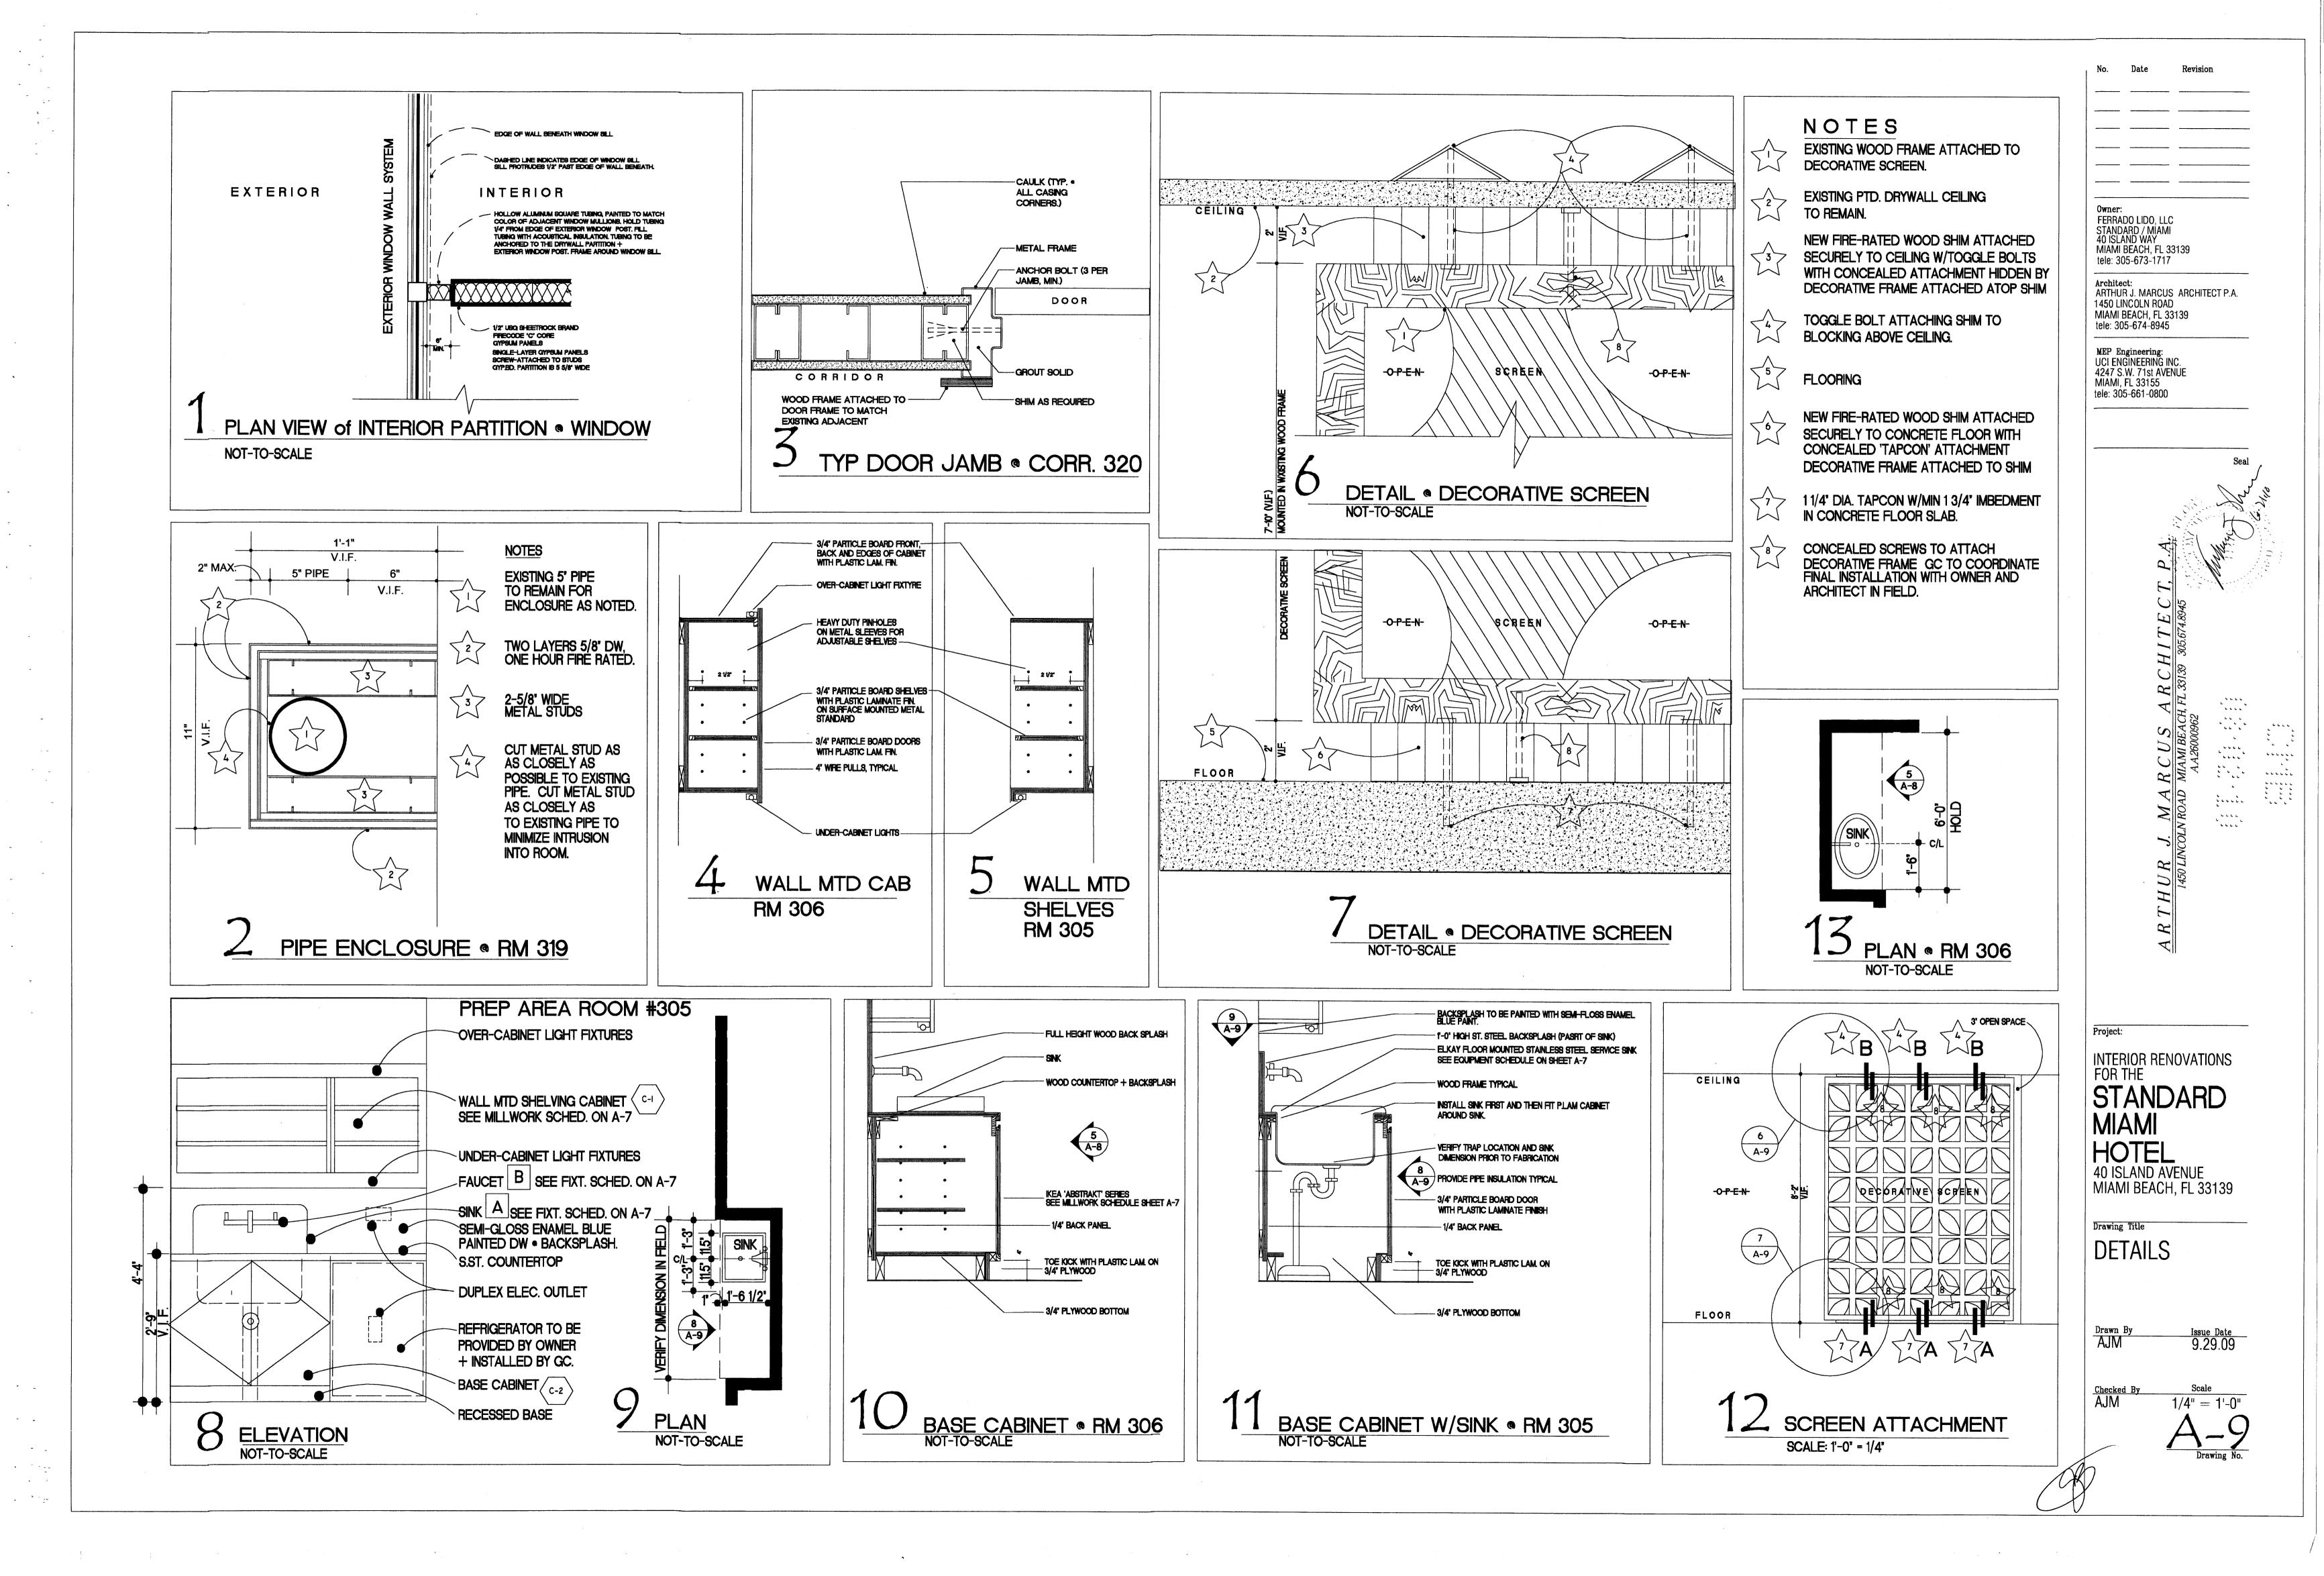

#### PARTITION NOTES

1. APPLY GYPSUM BOARD PANELS PARALLEL TO STUD. POSITION ALL EDGES OVER STUDS FOR PARALLEL APPLICATION. USE MAXIMUM PRACTICAL LENGTH TO MINIMIZE END JOINTS. STAGGER JOINTS ON OPPOSITE SIDES OF PARTITION, A MINIMUM OF 1/16". 3/8" MAXIMUM GAP AT FLOOR CONDITIONS.

2. ELECTRIC BOXES TO BE OFFSET IN ALL SOUND RATED PARTITIONS AT A MINIMUM OF 24" OC. PROVIDE ONE STUD (MINIMUM) BETWEEN OFFSET BOXES, INSTALL ACCUSTIC SEALANT AROUND OPPENINGS AND FIRE PROOFING PUTTY AROUND JUNCTION BOXES AT FIRE—RATED ASSEMBLIES.

3. THE PARTITON WITH THE HIGHEST FIRE RATING WILL RUN CONTINUOUS THROUGH INTERSECTING AND PERPENDICULAR PARTITIONS.


4. ALL VOIDS BETWEEN METAL DECKING AND TOP PLATE OF RATED PARTITION TO BE PACKED TIGHT WITH THERMAFIBER BLANKETS.


5. FIBER BLANKET INSULATION TO BE THERMAFIBER "SAFB'S" OR APPROVED EQUAL.

6. STUD GAUGE TO BE A MINIMUM OF 25 IN ACCORDANCE WITH ASTM REQUIREMENTS C 645.

7. HEIGHT LIMIT OF STUDS TO BE IN ACCORDANCE WITH ANSI REQUIREMENTS AND GYPSUM ASSOCIATION RECOMENDATIONS.

8. IN-WALL BLOCKING AND BACKING SHALL BE INSTALLED IN ALL ASSEMBLIES AS REQUIRED TO MAINTAIN SPECIFIED FIRE RATINGS; TO COMPLY WITH EFFECTIVE FAIR HOUSING ACT REQUIREMENTS; AND TO COMPLY WITH EFFECTIVE FLORIDA ACCESSIBILITY CODE REQUIREMENTS.

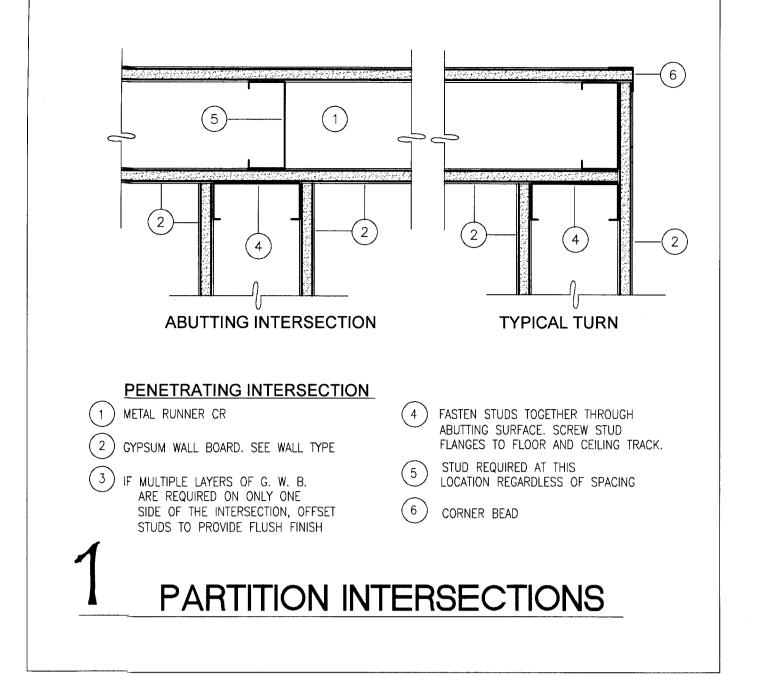

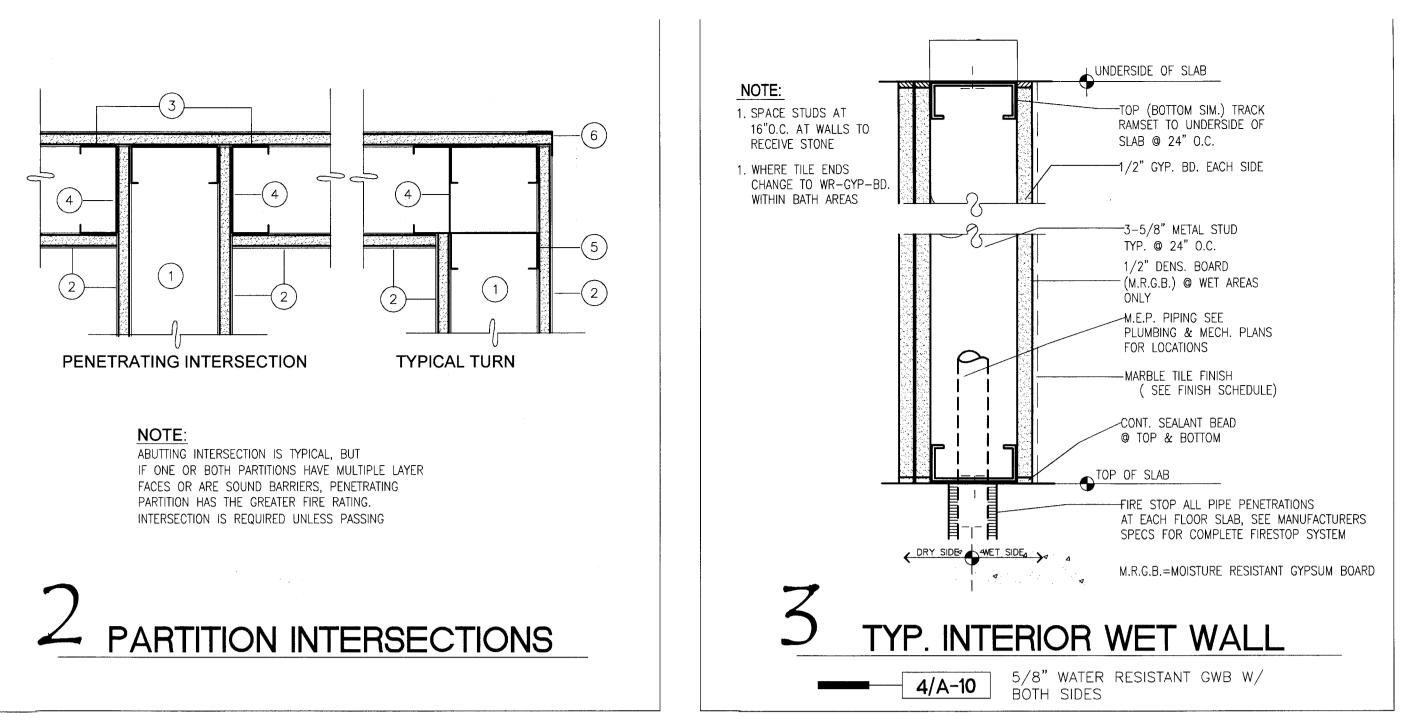

#### INTERIOR PARTITION TYPICAL NOTES:


- 1. GENERAL CONTRACTOR SHALL BE SOLELY RESPONSIBLE FOR THE APPROPRIATE CONSTRUCTION OF ALL PARTITION TYPES ACCORDING TO INDICATIONS ON THE DRAWINGS, AND WITH THE COORDINATION OF ALL MECHANICAL, ELECTRICAL AND PLUMBING SYSTEMS. GENERAL CONTRACTOR SHALL SUPERVISE AND INSPECT CONSTRUCTION OF ALL PARTITIONS TO VERIFY THAT CONSTRUCTION IS PERFORMED ACCORDING TO SPECIFICATIONS, CODE REQUIREMENTS AND INDUSTRY STANDARDS. ANY DISCREPANCIES SHALL BE BROUGHT TO THE ARCHITECT'S ATTENTION.
- 2. ALL DIMENSIONS SHOWN ON FLOOR PLANS ARE ROUGH TO ROUGH (STUD TO STUD OR MASONRY TO MASONRY OR MASONRY TO STUD) UNLESS CLEAR, "CLR", "FIN" OR FINISHED DIMENSION IS SPECIFICALLY STATED.
- 3. ALL WALLS ARE DIMENSIONED AT THE NOMINAL ROUGH DIMENSION. 4-INCH DIMENSIONS INDICATE A 3-5/8 INCH ACTUAL STUD SIZE. 8-INCH NOMINAL MASONRY SHALL HAVE ACTUAL DIMENSION OF 7-5/8 INCH. IT IS INTENDED THAT 3/8 FOR STUD AND MASONRY WALLS BE USED TO ADJUST FOR FIELD CONDITIONS.
- 4. ALL PARTITIONS SHALL BE 4' NOMINAL DIMENSION (UNLESS OTHERWISE NOTED ON PLANS. INTERIOR WALLS AND PARTITIONS (RATED OR NOT) SHALL SUPPORT A MINIMUM OF FIVE POUNDS PER SQUARE FOOT APPLIED PERPENDICULAR TO THE WALL.
- 5. PROVIDE BACKING SUPPORT AT ALL PARTITIONS WHERE EQUIPMENT, ACCESSORIES OR CASEWORK ARE INDICATED TO BE MOUNTED. PROVIDE 20 GAGE GALVANIZED SHEET METAL BACKING AND/OR 2-INCH NOMINAL PRESSURE TREATED BLOCKING DEPENDING ON SIZE AND WEIGHT OF ITEM TO BE MOUNTED.
- 6. SOFFIT SUPPORTS ON RATED PARTITIONS SHALL BE PERMITTED, ONLY IF THEY ARE ATTACHED DIRECTLY TO METAL STUDS AND/OR STRUCTURAL BACKING. ATTACHMENT TO GYPSUM WALLBOARD SHALL NOT BE PERMITTED.
- 7. PROVIDE CONTINUOUS ( R-5 MIN.) INSULATION BOARD AT ALL EXTERIOR BLOCK/CONCRETE WALLS FACING AIR CONDITIONED SPACES. INSTALL FROM FLOOR SLAB STRUCTURAL DECK. GYPSUM WALLBOARD SHALL BE INSTALLED TO CONCEAL/PROTECT FLAMMABLE INSULATION ABOVE CEILING, IF ANY.
- 8. RATED PARTITIONS SHALL BE BUILT FIRST IN COMPLIANCE WITH THE U.L. ASSEMBLY INDICATED. ALL OTHER PARTITIONS ABUTTING RATED PARTITIONS SHALL BE CONSTRUCTED AFTER THE RATED PARTITIONS ARE COMPLETED.
- 9. ALL PIPE, CONDUIT AND DUCT PENETRATIONS THROUGH RATED PARTITIONS SHALL BE DONE AT 90 DEGREES (BOTH SIDES).
- 10. ANY RECESSED ITEM OVER 4"x4" IN SIZE INSTALLED IN A RATED PARTITION SHALL BE ENCASED IN A FIVE SIDED 5/8" TYPE "X" GYPSUM WALLBOARD ENCLOSURE (SEE TYP. DETAIL) FIVE SIDED BACK BOXES SHALL BE CONSTRUCTED AS TO COMPLY WITH RATING REQUIREMENTS OF THE PARTITION. (I.E. ELECTRICAL JUNCTION BOXES ACCESSORIES).
- 11. PROVIDE WATER RESISTANT GYPSUM BACKING BOARD AT INTERIOR AREAS WHICH COULD BE SUBJECT TO INTERMITTENT WETTING.
- 12. ALL INTERIOR METAL STUDS, RUNNERS, TRACKS, AND ACCESSORIES TO BE GALVANIZED STEEL.
- 13. APPROPRIATE FIRESTOPPING/FIRE CAULKING SHALL BE PROVIDED AT ALL PENETRATIONS THROUGH FIRE-RATED CONSTRUCTION. SEE DIVISION 7 SPECIFICATIONS.
- 14. GENERAL CONTRACTOR SHALL IDENTIFY ALL FIRE-RATED AND SMOKE TIGHT PARTITIONS BY PAINTING 3-INCH HIGH SIGNS IN RED PAINT USING STENCILS. SIGNAGE SHALL BE LOCATED ABOVE DECORATIVE CEILING AND IN CONCEALED SPACES, OR IN THE CASE OF RATED MECHANICAL AND ELECTRICAL ROOMS, AT 8 FEET ABOVE THE FLOOR. SIGNS SHALL BE LOCATED NO FURTHER THAN 20 FEET APART. TEXT SHALL BE 'FIRE AND SMOKE BARRIER PROTECT ALL OPENINGS'.


#### DRYWALL FINISH NOTES


- 1. ALL DRYWALL CONSTRUCTION, FURRING + SHEATHING SHALL CONFROM TO STANDARD DETAILS AS NOTED ON DRAWINGS.
- 2. DRYWALL JOINTS SHALL BE TAPED, SPACKLED, POLISHED + FINISHED TO SMOOTH + LEVEL FINISH FLUSH W/ FACE OF BOARD SURFACE.
- 3. EXTERIOR CORNERS RECEIVE METAL CORNER BEADS AND BE FINISHED AS IN NOTE #2.


\* ...


- 4. FULL HEIGHT GYPSUM BOARD SHEETS SHALL BE USED THROUGHOUT FOR FULL HEIGHT CONSTRUCTION.
- 5. EXISTING TAPED JOINTS, CORNERS, DIMPLES OR SCREW HEADS SHALL BE FINISHED SMOOTH + LEVEL W/ ADJACENT BOARD SURFACE.
- 6. WHERE NEW DRYWALL CONSTRUCTION MEETS EXISTING DRYWALL CORNER CONDITION, G.C. SHALL REMOVE EXISTING CORNER BEAD AND INSTALL NEW DRYWALL FLUSH WITH EXISTING DRYWALL.
- 7. GENERAL CONTRACTOR IS RESPONSIBLE FOR THE PAINTING OF ALL DRYWALL SURFACES.

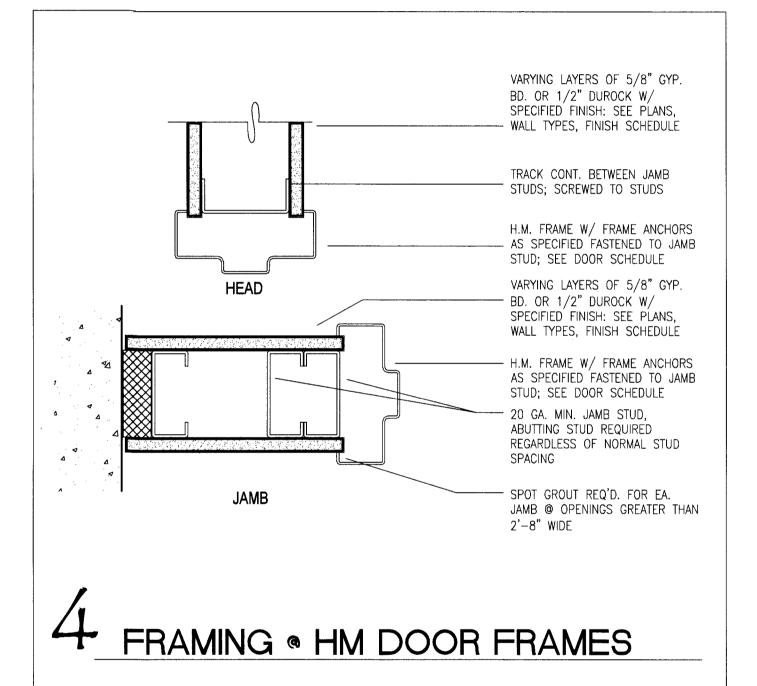

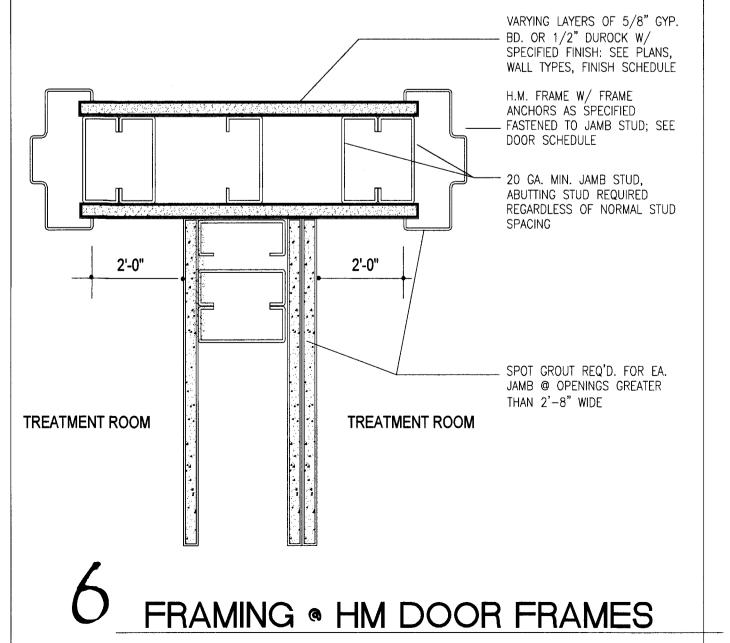

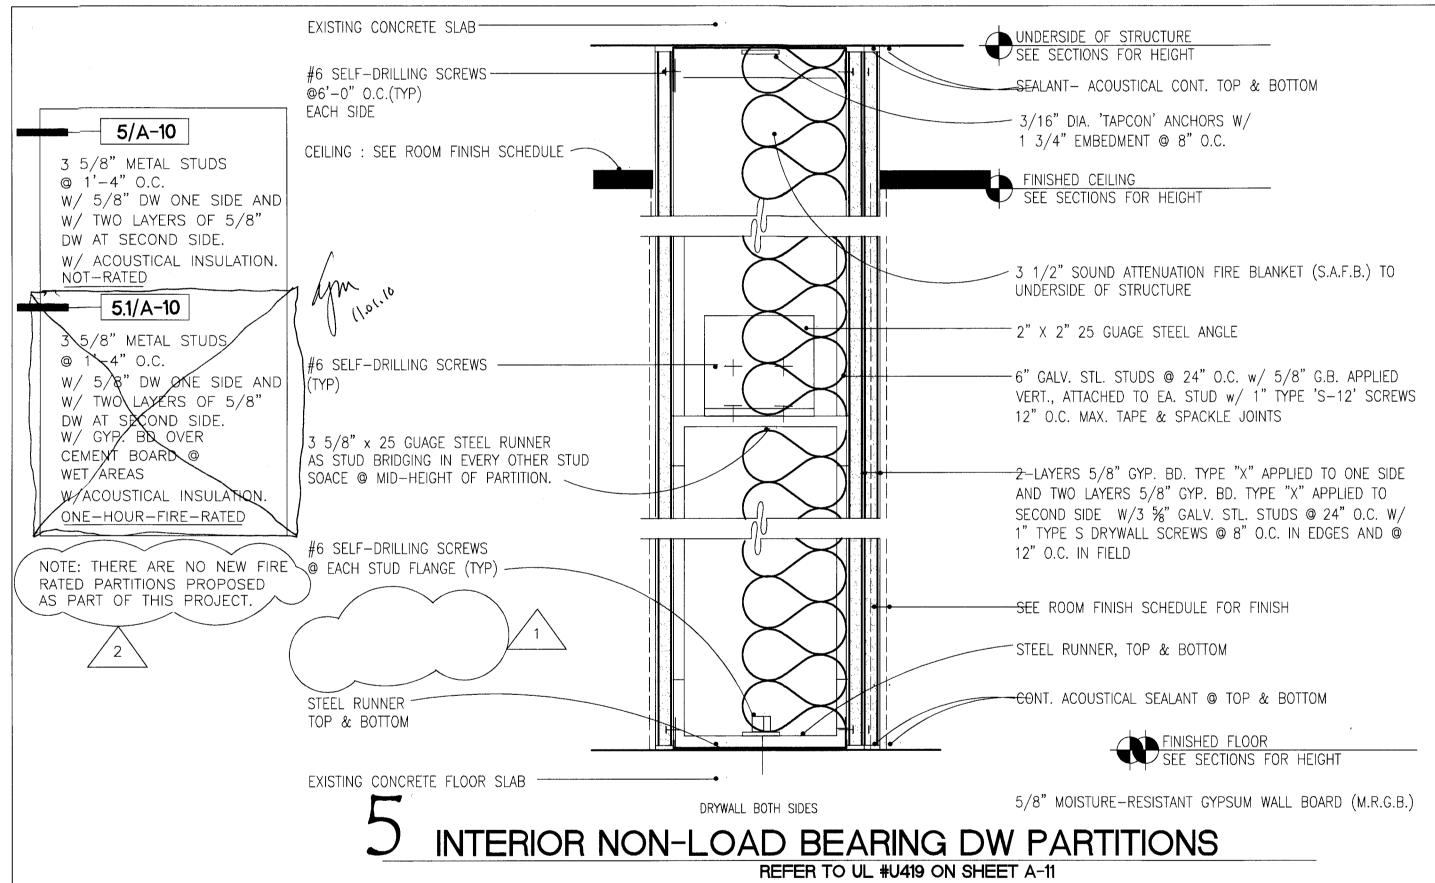

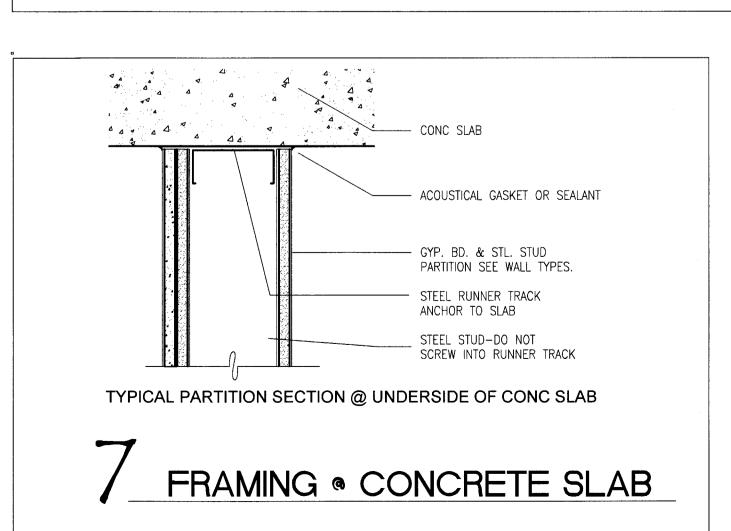

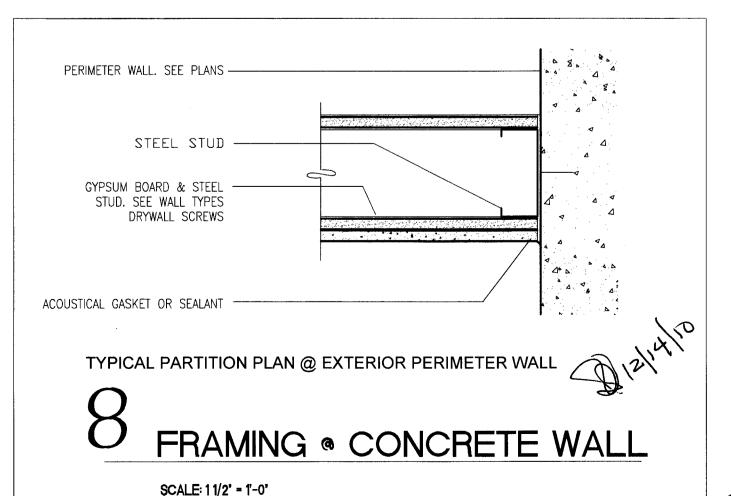

Architect:
ARTHUR J. MARCUS ARCHITECT P.A.
1450 LINCOLN ROAD
MIAMI BEACH, FL 33139
tele: 305-674-8945

MEP Engineering:
UCI ENGINEERING INC.
4247 S.W. 71st AVENUE
MIAMI, FL 33155
tele: 305-661-0800

9.13.10 NOTES

10.26.10 NOTES

FERRADO LIDO, LLC

STANDARD / MIAMI

tele: 305-673-1717

MIAMI BEACH, FL 33139

40 ISLAND WAY

Project:

INTERIOR RENOVATIONS FOR THE STANDARD MIAMI

HOTEL 40 ISLAND AVENUE MIAMI BEACH, FL 33139

Drawing Title

PARTITION DETAILS

Drawn By Issue Date 9.09.09

 $\begin{array}{c|cccc} \underline{\text{Checked By}} & \underline{\text{Scale}} \\ \hline \text{AJM} & 1/4^{\shortparallel} = 1^{\shortmid} - 1^{\prime} \\ \hline \end{array}$ 

 $\underbrace{A-1}_{\text{Drawing No.}}$