
SKETCH OF BOUNDARY SURVEY

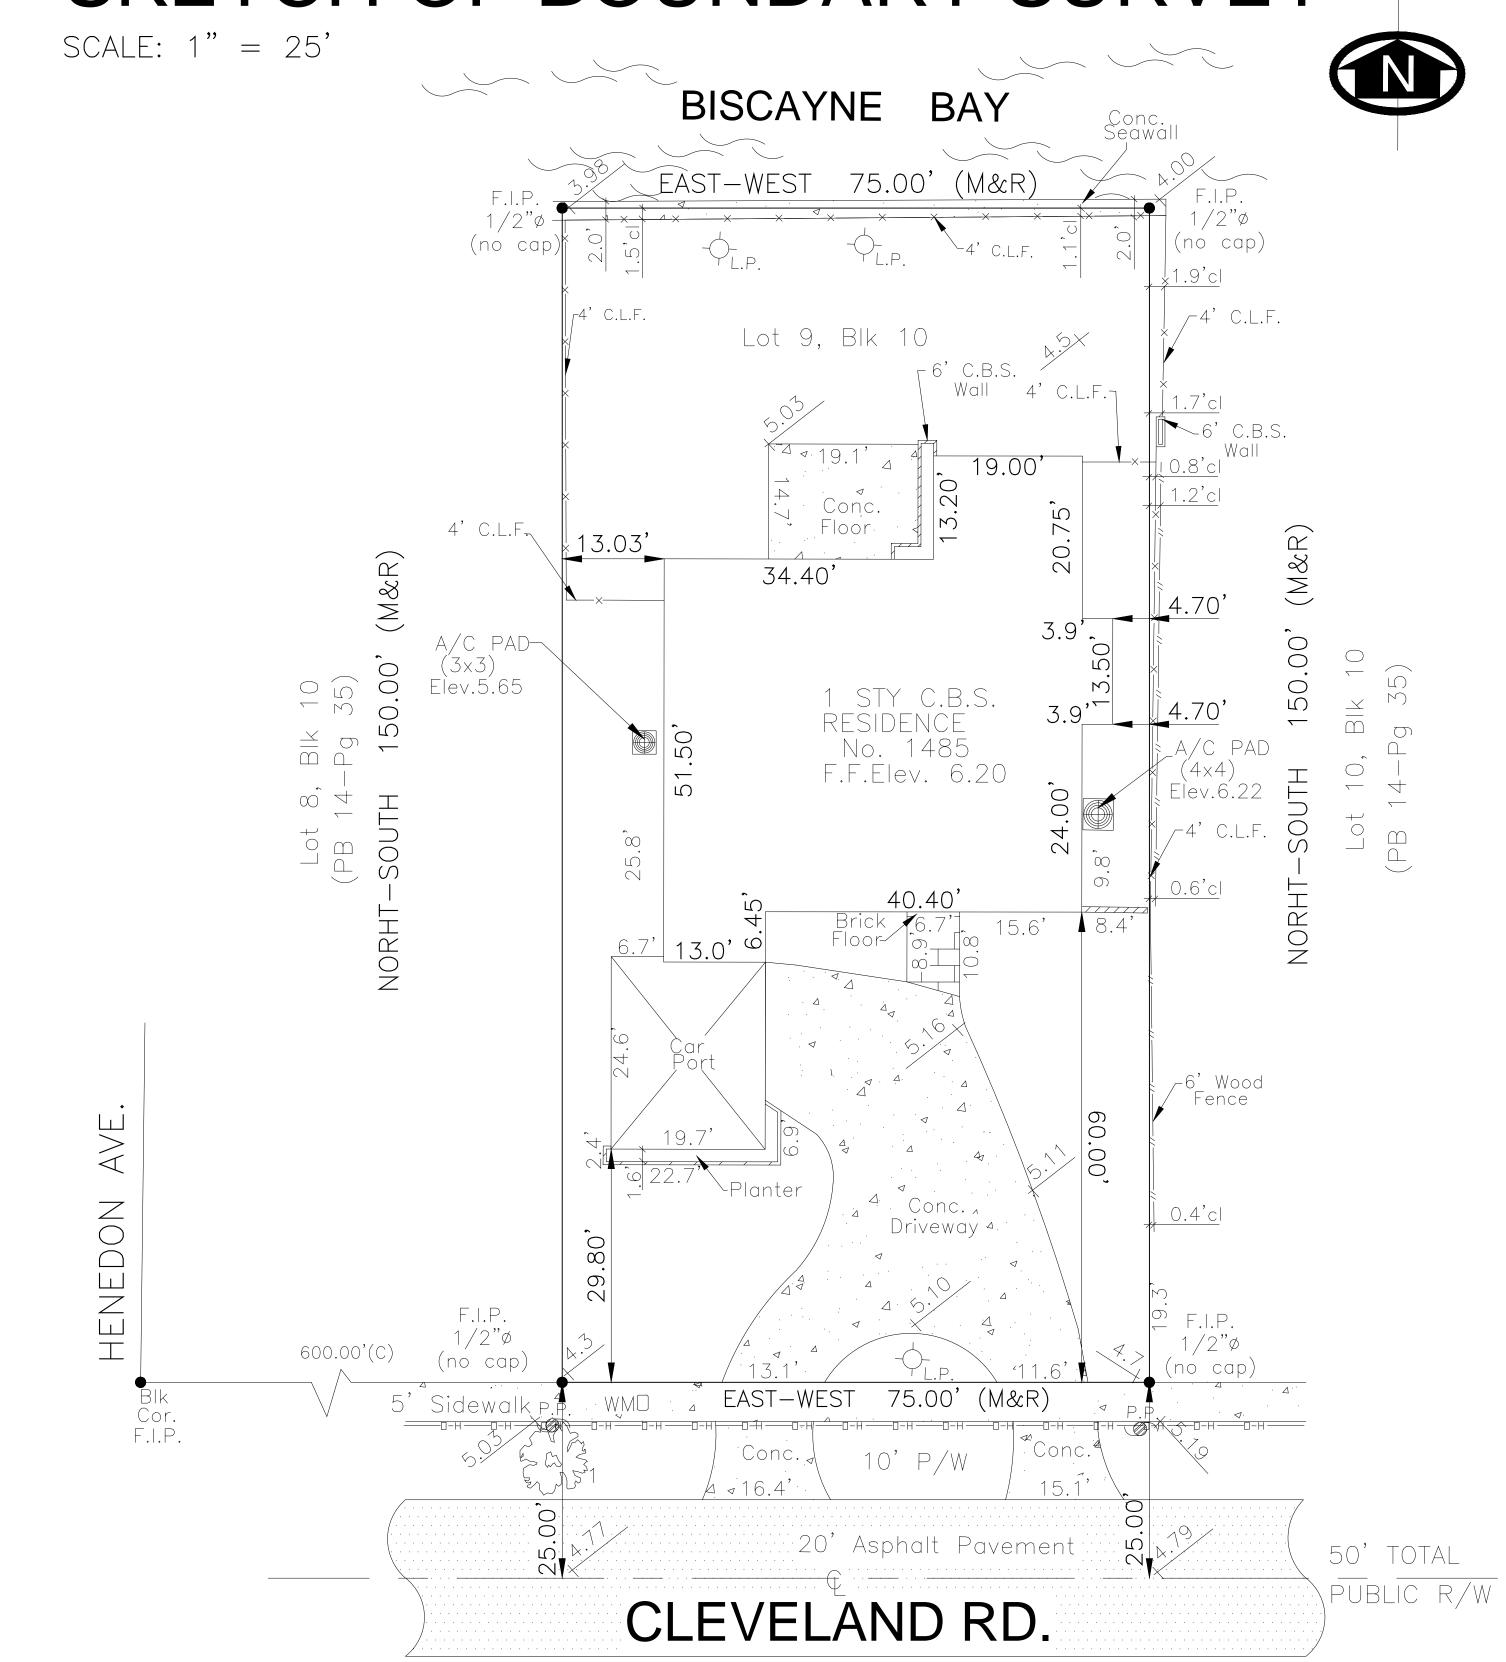


HEIGHT

40'

SPREAD

TREE LIST			
No.	TREE NAME	BOTANICAL NAME	D.B.H.
1	BAY LAUREL	LAURUS NOBILIS	1.6

LOCATION MAP SCALE: NTS

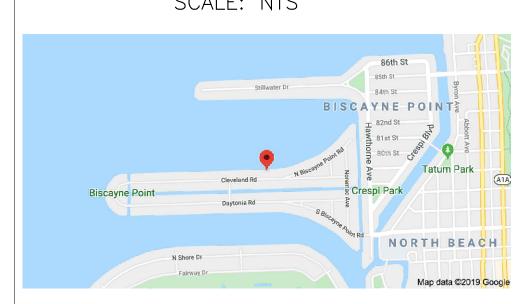

SITE PICTURE

.\..\..\aMERICAN\PHOTOS FOR ELEVATIONS\BART REINES\1485 CLEVELAND\19-1040 FRONT.jp;

ABREVIATION (IF ANY APPLIED)

A/C = AIR CONDITIONING UNITP.O.B. = POINT OF BEGINNING B.M. = BENCH MARK P.C. = POINT OF CURVATUREBlk/Corn.= BLOCK CORNER P.I. = POINT OF INTERSECTION CALC(C) = CALCULATEICB = CATCH BASINP.P. = POWER POLE CONC. = CONCRETE P.T. = POINT OF TANGENCY D.M.E. = DRAINAGE MAINT. EASEMENT Ø = DIAMETER $EASMT. = EASEMEN^{T}$ RES. = RESIDENCE ELEV. = ELEVATIONR/W = RIGHT OF WAYENC. = ENCROACHMENT S.D/H = SET DRILL HOLEF.H. = FIRE HYDRANTF.N/D = FOUND NAIL AND DISF.I.P. = FOUND IRON PIPES.R.B. = SET REBAR F.S. = FOUND SPIKEL.P. = LIGHT POLE SWK. = SIDEWALK MEAS.(M) = MEASUREDT.O.P. = TOP OF BANKU.E. = UTIL. EASEMENT W.P. = WOODEN POLE M = MONUMENT€ = SECTION LINE M = MONUMENT LINENTS = NOT TO SCALE

SURVEYOR'S LEGEND (IF ANY APPLIED)

	BOUNDARY LINE		CATCH BASIN
	STRUCTURE (BLDG.)	\bigcirc	MANHOLE
	CONCRETE BLOCK WALL	O.E.	OVERHEAD ELECT.
	METAL FENCE		POWER POLE
-11111111	WOODEN FENCE	-	LIGHT POLE
_ *_*	CHAIN LINK FENCE	£	HANDICAP SPACE
	WOOD DECK/DOCK		TIME TOTAL STREET
	ASPHALTED AREAS	\mathcal{C}	FIRE HYDRANT
Α Δ	CONCRETE -		EASEMENT LINE
	BRICKS OR PAVERS	M	WATER VALVE
	ROOFED AREAS	tv	TV-CABLE BOX
	WATER (EDGE OF WATER)	WM	WATER METER
			CONC. LIGHT POLE

JOB SPECIFIC SURVEYOR NOTES:

DATE OF SURVEY: OCTOBER 27, 2019

ANKONINA INVESTMENTS GROUP, LLC

BART REINES LUXURY HOMEBUILDER, INC

19-1040

02-3203-001-2230

CERTIFIED TO

JOB NUMBER:

FOLIO NUMBER:

- FLOOD ZONE "AE" OF THE FLOOD INSURANCE RATE MAP IDENTIFIED AS COMMUNITY PANEL No. 120651-0307L, WITH AN EFFECTIVE DATE OF SEPTEMBER 11, 2009. BASE FLOOD ELEVATION OF 8.00 FEET (NGVD)
- 2 LAND AREA OF SUBJECT PROPERTY: 11,250 SF (+/-)
- AT PAGE 35 OF THE PUBLIC RECORD OF MIAMI DADE COUNTY, FLORIDA

GENERAL SURVEYOR NOTES:

THE SHOWN LEGAL DESCRIPTION USED TO PERFORM THIS BOUNDARY SURVEY WAS PROVIDED BY THE CLIENT

1485 CLEVELAND DR, MIAMI BEACH, FL. 33141

SURVEY IS BASED ON RECORDED INFORMATION PROVIDED BY CLIENT. NO SPECIFIC SEARCH OF THE PUBLIC RECORD HAS BEEN MADE BY OUR OFFICE.

UNLESS OTHERWISE NOTED, AN EXAMINATION OF THE ABSTRACT OF TITLE WAS NOT DONE BY THE SIGNING SURVEYOR TO DETERMINE WHICH INSTRUMENTS, IF ANY ARE AFFECTING THE SUBJECT PROPERTY

THIS SURVEY IS EXCLUSIVELY FOR THE USE OF THE PARTIES TO WHOM IT WAS CERTIFIED.

PURSUANT TO RULE 5J-17 OF THE FLORIDA ADMINISTRATIVE CODE THE EXPECTED USE OF LAND IS SUBURBAN, THE MINIMUM RELATIVE DISTANCE ACCURACY FOR THIS TYPE OF SURVEY IS 1 FOOT IN 7,500 FEET. THE ACCURACY OBTAINED BY MEASUREMENT AND CALCULATIONS OF CLOSED GEOMETRIC FIGURES WAS FOUND TO EXCEED THIS REQUIREMENT.

ADJOINING PROPERTIES, STREETS OR ALLEYS UPON THE SUBJECT PROPERTY OTHER THAN THOSE SHOWN ON THIS BOUNDARY SURVEY

THERE ARE NO VISIBLE EASEMENTS OR RIGHT-OF-WAY OF WHICH THE UNDERSIGNED HAS BEEN ADVISED OTHER THAN THOSE SHOWN ON THIS SURVEY.

THE MAP OF SURVEY IS INTENDED TO BE DISPLAYED AT THE SHOWN GRAPHIC SCALE IN ENGLISH UNITS OF MEASUREMENT. IN SOME CASES GRAPHIC REPRESENTATION HAVE BEEN EXAGERATED TO MORE CLEARLY ILLUSTRATE A PARTICULAR AREA WHERE DIMENSIONS SHALL HAVE PREFERENCE OVER GRAPHIC LOCATION.

THE ELEVATIONS (IF ANY) OF WELL-IDENTIFIED FEATURES AS DEPICTED ON THIS SURVEY AND MAP WERE MEASURED TO AN ESTIMATED VERTICAL POSITIONAL ACCURACY OF $\frac{1}{10}$ FOOT FOR NATURAL GROUND SURFACES AND $\frac{1}{100}$ FOOT FOR HARDSCAPE SURFACES, INCLUDING PAVEMENT, CURBS, SIDEWALKS AND OTHER MANMADE STRUCTURES.

THE SURVEYOR MAKES NO REPRESENTATION AS TO OWNERSHIP, POSSESSION OR OCCUPATION OF THE SUBJECT PROPERTY BY ANY ENTITY OR INDIVIDUAL

ANY FEMA FLOOD ZONE INFORMATION PROVIDED ON THIS SURVEY IS FOR INFORMATIONAL PURPOSE ONLY AND IT WAS OBTAINED AT WWW.FEMA.COM

IF YOU ARE READING THIS BOUNDARY SURVEY IN AN ELECTRONIC FORMAT, THE INFORMATION CONTAINED ON THIS DOCUMENT IS ONLY VALID IF THIS DOCUMENT IS ELECTRONICALLY SIGNED AS SPECIFIED IN CHAPTER CHAPTER 5J-17.062 (3) OF THE FLORIDA ADMINISTRATIVE CODE. IF THIS DOCUMENT IS IN PAPER FORMAT, IT IS NOT VALID WITHOUT THE SIGNATURE AND ORIGINAL RAISED SEAL OF THE PROFESSIONAL LAND SURVEYOR AND MAPPER OF RECORD.


LEGAL DESCRIPTION:

LOT 9, BLOCK 10, OF BISCAYNE POINT, ACCORDING TO THE PLAT THEREOF AS RECORDED IN PLAT BOOK 14 AT PAGE 35, OF THE PUBLIC RECORDS OF MIAMI-DADE COUNTY, FLORIDA.

ENCROACHMENTS AND OTHER POINTS OF INTEREST: THERE ARE NO VISIBLE ENCROACHMENT OF THE SUBJECT PROPERTY -THE SUBJECT PROPERTY IS WITHIN A FLOOD ZONE AE (SEE NOTE 1) -THERE NO PLATTED UTIL. EASEMENT ON THE SUBJECT PROPERTY

WE HEREBY CERTIFY THAT THIS BOUNDARY AND TOPOGRAPHICAL SURVEY AND THE SURVEY MAP RESULTING THEREFROM WAS PERFORMED UNDER MY SUPERVISION AND/OR DIRECTION AND TRUE AND CORRECT TO THE BEST OF MY KNOWLEDGE AND BELIEF AND FURTHER, THAT SAID "BOUNDARY AND TOPOGRAPHICAL SURVEY" MEETS THE INTENT OF THE APPLICABLE PROVISIONS THE "STANDARDS OF PRACTICE FOR LAND SURVEYING IN THE STATE OF FLORIDA", PURSUANT TO RULE 5J-17 OF THE FLORIDA ADMINISTRATIVE CODE AND ITS IMPLEMENTING LAW, CHAPTER 472.027 FOR THE FLORIDA STATUTES.

American Services of Miami, Corp.

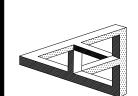

LB 6683

Consulting Engineers . Planners . Surveyors 3195 PONCE DE LEON BLVD, SUITE 200

CORAL GABLES, FL 33134 PHONE: (305)598-5101 FAX: (305)598-8627

Ed Pino PROFESSIONAL LAND SURVEYOR AND MAPPER No. 6771 STATE OF FLORIDA

ASOMIAMI.COM

DATE: OCTOBER 30, 2019