

**1. GENERAL PROJECT INFORMATION**

PROJECT TEAM		
OWNER		ARCHITECT
Company	Crescent Heights	Perkins + Will
Contact	Victor Nieves	Jose Gelebert-Navia
Title	Construction and Design Manager	Principal, Architect of Record
Address	2200 Biscayne Blvd., Miami, Florida 33137	806 Douglas Rd., Suite 300 Coral Gables, FL 33143
Phone	305.374.5700 ext. 7355	305.569.1385
Fax	-	305.569.1334

AUTHORITY HAVING JURISDICTION	
BUILDING OFFICIAL FIRE PROTECTION PLANNING AND ZONING	
Jurisdiction	City of Miami Beach
Contact	-
Address	1700 Convention Center Drive, Miami Beach FL 33139
Phone	305.673.7000
Fax	-

APPLICABLE CODES			
CODE	YEAR	AUTHORITY HAVING JURISDICTION	
Accessibility	Florida Building Code Accessibility ADA/Amendments w/ Disabilities Act 2010 2010	City of Miami Beach Building Department City of Miami Beach Building Department	
Life Safety	NFPA 101 Life Safety Code Florida Edition NFPA 101 2009 2010	City of Miami Beach Building Department City of Miami Beach Fire Department	
Building	Florida Building Code - Existing Building 2010	City of Miami Beach Building Department	
Fire Prevention	Florida Building Code 2010	City of Miami Beach Fire Department	
Energy	Florida Building Code 2010	City of Miami Beach Building Department	
Electrical	Florida Building Code 2010	City of Miami Beach Building Department	
Mechanical	Florida Building Code 2010	City of Miami Beach Building Department	
Plumbing	Florida Building Code 2010	City of Miami Beach Building Department	
Gas	Florida Building Code 2010	City of Miami Beach Building Department	
Zoning	City of Miami Beach Code of Ordinances 2014	City of Miami Beach Planning and Zoning Department	

LAND DESCRIPTION
SURVEY OF LOT 1-8, BLOCK 45, OF COMMERCIAL SUBDIVISION ACCORDING TO THE PLAT THEREOF AS RECORDED IN THE PLAT BOOK 6, PAGE 5, OF THE PUBLIC RECORDS OF MIAMI-DADE COUNTY FLORIDA.

PROJECT DESCRIPTION
THE PROJECT CONSISTS OF SHELL SPACE FOR RETAIL SHOPS, BUSINESS, AND A CAR PARKING GARAGE. THE PROJECT TOTALS 236,042 OF GSF OF NEW CONSTRUCTION. THE GROUND FLOOR OF 1600 ALTON IS TO REMAIN. THE SECOND FLOOR WILL BE DEMOLISHED AND THE EXISTING STRUCTURE BELOW WILL RECEIVE A NEW ROOF AND MECHANICAL SYSTEMS. THIS PROJECT UTILIZES ONLY A PORTION OF THE SITE IN ANTICIPATION OF A SECOND PHASE AT THE NORTH END (1634 ALTON ROAD SITE) BY SEPARATE PERMIT.

ZONING DATA SUMMARY		
SITE AREA:	1.62 ACRES 70,666 SF	
ZONING DESIGNATION:	CD2 COMMERCIAL MEDIUM INTENSITY	
142-396 DEVELOPMENT REGULATIONS		
REGULATIONS	REQUIREMENT	PROPOSED
MAXIMUM FAR	2.0 (MIXED USE)	2.0
MAXIMUM BUILDABLE AREA (FAR)	2.0 X 70,666 = 141,332 SF MAX 141,215 SF APPROVED AS PER DRB	60,426 SF (55,789 NEW + 4,638 EXISTING) *REMAINING ALLOWABLE FAR: (80,789 SF) TO BE UTILIZED BY FUTURE PH. 2 CONSTRUCTION UNDER SEPARATE PERMIT.
MINIMUM LOT AREA	7,000 SF	70,666 SF
MINIMUM LOT WIDTH	50 FT	471'-0"
MAXIMUM BUILDING HEIGHT	60 FT	60 FT
142-307 SETBACK REGULATIONS (CD2 applicable to COMMERCIAL MED. INTENSITY)		
REGULATION (PEDESTAL & TOWER)	REQUIREMENT	PROPOSED
FRONT	0 FT	VARIABLE: 0 FT TO 14'-0"
SIDE, INTERIOR	NA	NA
SIDE, FACING STREET	0 FT; 10 FT IF ABUTTING RESIDENTIAL	VARIABLE: 0 TO 58'-0" ON SOUTH, 0 TO 4'-0" ON NORTH.
REAR	5 FT	10 FT AT GRADE AND 2ND FLOOR, 0 ALL LEVELS ABOVE. (VARIANCE GRANTED)
133-33(c) OFF STREET PARKING REQUIREMENTS FOR PARKING DISTRICTS 2,3,4,5 AND 6		
REGULATIONS	REQUIREMENT	PROPOSED
RETAIL, SHELL SPACE	71 SPACES + 35,410 SF/500 (1 SPACE PER 500 SF)	137 SPACES FOR PHASE 1 215 ADDITIONAL ESTIMATED SPACES FOR FUTURE PHASE 2
FINANCIAL INSTITUTION	15 SPACES + 4,486 SF/200 (1 SPACE PER 300 SF)	
EXCESS/ROOF PARKING	0	20
TOTAL PARKING	332	372 (INCLUDES 9 H.C. SPACES)
133-33(7) SHORT TERM AND LONG TERM BICYCLE PARKING		
BICYCLE FOR RETAIL	10 SHORT TERM (1 PER 10,000 SF OF RETAIL) + 10 LONG TERM	13 SHORT TERM / 10 LONG TERM (SEE LONG TERM BIKE STORAGE ON IST FL)
133-101 OFF STREET LOADING		
REGULATIONS	REQUIREMENT	PROPOSED
RETAIL	5 SPACES; 14 SPACES FOR 60,000 SF + 1 SPACE FOR THE NEXT 50,000 SF	6

**2. OCCUPANCY CLASSIFICATION**

	BUILDING CODE	LIFE SAFETY CODE
Occupancy Classification(s)	Assembly Group A-2, Business Group B, Mercantile Group M, Residential Group R-1, Storage Group S-2	New Assembly New Business New Mercantile New Hotel New Storage
Code Reference	Florida Building Code Section 303, 304, 309, 310, 311	NFPA 101, Life Safety Code Florida Edition Assembly Occupancy 6.1.2 Business Occupancy 6.1.11 Mercantile Occupancy 6.1.10 Hotel Occupancy 6.1.3, 1.3 Storage Occupancy 6.1.13

NOTES: \* Non-Separated Building Occupancy

**3. CONSTRUCTION TYPE**

	BUILDING CODE
Construction Type	Type I-B
Code Reference	Florida Building Code
Section Reference(s)	Table 601

NOTES: Florida Fire Prevention Code (8.2.1.2) The Florida Building Code, shall be used to determine the requirements for the Construction Classification.

**4. FIRE PROTECTION SYSTEMS**

Requirements	BUILDING CODE	LIFE SAFETY CODE
	SECTION 903.3.1.1 NFPA 13 SPRINKLER SYSTEMS, WHERE THE PROVISIONS OF THIS CODE REQUIRE THAT A BUILDING OR PORTION THEREOF BE EQUIPPED THROUGHOUT WITH AN AUTOMATIC SPRINKLER SYSTEM IN ACCORDANCE WITH THIS SECTION SPRINKLERS SHALL BE INSTALLED THROUGHOUT IN ACCORDANCE WITH NFPA 13	NFPA 101, SECTION 9.7.1.1 EACH AUTOMATIC SPRINKLER SYSTEM SHALL BE IN ACCORDANCE WITH NFPA 13, STANDARD OF THE INSTALLATION OF SPRINKLER SYSTEMS, NFPA 500, SECTION 7.4.1 FOR SPRINKLERED BUILDINGS APPLY TO BUILDINGS PROTECTED THROUGHOUT WITH AN APPROVED ELECTRICALLY SUPERVISED AUTOMATIC SPRINKLER SYSTEM IN ACCORDANCE WITH NFPA 13.
	SECTION 903.2.1.3 - ANY BUILDING WHICH IS OF THREE STORIES OR MORE IN HEIGHT SHALL BE EQUIPPED WITH AN APPROVED AUTOMATIC SPRINKLER SYSTEM INSTALLED IN ACCORDANCE WITH SECTION 903.1	
	SECTION 905.2 - STANDPIPE SYSTEMS SHALL BE INSTALLED IN ACCORDANCE WITH THIS SECTION AND NFPA 14	
Code Reference	FLORIDA BUILDING CODE	FLORIDA FIRE PREVENTION CODE, NFPA 101
Section Reference(s)	903.3.1.1; 903.2.1.1.3; 905.2	NFPA 101, SECTION 9.7.1.1

NOTES:

**5. FIRE-RESISTANCE RATING REQUIREMENTS FOR BUILDING ELEMENTS (HOURS)**

BUILDING ELEMENTS	FIRE-RESISTANCE RATING REQUIREMENTS (HOURS)
STRUCTURAL FRAME	2 HOUR <sup>a</sup>
EXTERIOR BEARING WALL	2 HOUR
INTERIOR BEARING WALL	2 HOUR
FLOOR CONSTRUCTION (INC. SUPPORTS)	2 HOUR
ROOF (INC. SUPPORTS)	1 HOUR <sup>b</sup>
NONBEARING WALLS EXTERIOR	SEE NOTES
NONBEARING WALLS INTERIOR	0 HOUR
SHAFT ENCLOSURES - 4 STORIES OR MORE	2 HR (Section 713.4)
EXIT STAIR ENCLOSURES - 4 STORIES OR MORE	2 HR (Section 1022.1)
CORRIDORS	SEE NOTES
SMOKE BARRIER	1 HR (Section 709.3)

NOTES:

- Roof Supports: Fire-resistance ratings of primary structural frame and bearing walls are permitted to be reduced by 1 hour where supporting a roof only.
- Except in Group F-1, H, M and S-1 occupancies, fire protection of structural members shall not be required, including protection of roof framing and decking where every part of the roof construction is 20 feet or more above any floor immediately below. Fire-retardant-treated wood members shall be allowed to be used for such unprotected members.

Nonbearing Exterior walls:  
Per Table 602, Nonbearing Exterior walls shall have the following fire-resistance rating requirements:  
X < 5' = 2 Hours for Group M, 1 Hour for Groups B, S-2  
5' < X < 10' = 1 Hour for all Groups.  
10' < X < 30' = 1 Hour for all Groups.  
X > 30' = No Rating Required.

- Any wood finish in the project will be inherently fire retardant.
- Interior walls will comply with FPFC 101 6th Edition 10.2.2.

PARKING SPACES	
LEVEL	COUNT
LEVEL 03	99
LEVEL 04	101
LEVEL 05	102
LEVEL 06	70
	372

**6. ALLOWABLE HEIGHT AND BUILDING AREAS**

	BUILDING CODE	MUNICIPAL
Code Reference	Florida Building Code	City of Miami Beach Code Ordinances
Section Reference(s)	Table 503	Chapter 142 Zoning District Regulations

HEIGHT LIMITATION ABOVE GRADE PLANE		
	BUILDING CODE	MUNICIPAL
Height (Ft)	160	60'
Height (Stories)	11	5

ALLOWABLE BUILDING AREA BY LEVEL	
Storage Group S-2	79,000 SF
All Other Groups	Unlimited

NOTES: \* Per Section 114-1, freeboard elevation is set at 11'4" NGVD, therefore, maximum allowable T.O.S. is 71'4".

**7. BUILDING OCCUPANCY**

	BUILDING CODE	LIFE SAFETY CODE
Code Reference	Florida Building Code	NFPA 101, Life Safety Code Florida Edition
Section Reference(s)	Section 1004.1 and Table 1004.1.1	Table 7.3.1.2

BUILDING OCCUPANT LOAD BY LEVEL				
LEVEL	OCCUPANCY TYPE	AREA	OCCUPANCY LOAD FACTOR (SF / OCCUPANT)	OCCUPANT LOAD
LEVEL 01	BUSINESS	4,475 SF	100 SF	45
LEVEL 01	MERCANTILE & GRADE	15,962 SF	30 SF	532
LEVEL 01	MECH/EQUIP/STOR.	4,402 SF	300 SF	15
LEVEL 01	MECH/EQUIP/STOR.	2,656 SF	300 SF	9
LEVEL 01	MECH/EQUIP/STOR.	236 SF	300 SF	1
LEVEL 01.5		24,733 SF		591
LEVEL 02	MERCANTILE - OTHER	25,329 SF	160 SF	339
LEVEL 02	BUSINESS	660 SF	100 SF	7
LEVEL 02	BUSINESS	416 SF	100 SF	4
LEVEL 02	MECH/EQUIP/STOR.	237 SF	300 SF	1
LEVEL 02	MECH/EQUIP/STOR.	615 SF	300 SF	2
LEVEL 02.5		22,259 SF		352
LEVEL 03	PARKING GARAGE	40,770 SF	200 SF	204
LEVEL 03	MECH/EQUIP/STOR.	192 SF	300 SF	1
LEVEL 03.2		40,932 SF		204
LEVEL 04	PARKING GARAGE	40,757 SF	200 SF	204
LEVEL 04	MECH/EQUIP/STOR.	192 SF	300 SF	1
LEVEL 04.2		40,919 SF		204
LEVEL 05	PARKING GARAGE	40,811 SF	200 SF	204
LEVEL 05	MECH/EQUIP/STOR.	192 SF	300 SF	1
LEVEL 05.2		40,973 SF		205
LEVEL 06	PARKING GARAGE	38,504 SF	200 SF	193
LEVEL 06	MECH/EQUIP/STOR.	192 SF	300 SF	1
LEVEL 06	MECH/EQUIP/STOR.	2,231 SF	300 SF	7
LEVEL 06.3		40,897 SF		200

NOTES: OCCUPANCIES PROVIDED ARE FOR ANTICIPATED OCCUPANCY OF TENANT SPACES (TO BE SUBMITTED UNDER SEPARATE PERMIT). THIS PERMIT SUBMITTAL IS FOR SHELL SPACE ONLY.

**8. EGRESS REQUIREMENTS- EGRESS WIDTH / NUMBER OF EXITS**

	BUILDING CODE	LIFE SAFETY CODE
Code Reference	Florida Building Code	NFPA 101, Life Safety Code Florida Edition
Section Reference(s)	Table 1021.1, Sections 1005.1, 1009.1, 1018.2, 1019.1	Table 7.3.3.1, Sections 7.2.2.2.1, 12.2.2.1, 38.2.4.1

LEVEL	SQ. FTG.	OCC. LOAD FACTOR	OCC. LOAD	RECO. EGRESS WIDTH - STAIRS (2" PER OCCUPANT)	RECO. EGRESS WIDTH - OTHER (2" PER OCCUPANT)	Provided Egress Width (Stairways)	Provided Egress Width (Other)
LEVEL 01	24,733 SF	591	177	118	N/A	528	
LEVEL 02	22,259 SF	352	106	70	668	964	
LEVEL 03	40,932 SF	204	61	41	156	144	
LEVEL 04	40,919 SF	204	61	41	168	144	
LEVEL 05	40,973 SF	205	61	41	156	144	
LEVEL 06	40,897 SF	200	60	40	168	144	

NOTES:

**9. EGRESS REQUIREMENTS - TRAVEL DIST./ COMMON PATH / DEAD-END**

	TRAVEL DISTANCE	COMMON PATH	DEAD-END
	FBC Table 1016.2	Life Safety Code Table A.7.6	FBC Table 1014.3
Assembly Group A-2	250 feet	250 feet	75 feet
Business Group B	300 feet	300 feet	100 feet
Mercantile Group M	250 feet	250 feet	75 feet
Storage Group S-2	400 feet	200 feet	100 feet

NOTES: \* For common path serving > 50 persons, 20 feet; for common path serving < 50 persons, 75 feet.

**10. MINIMUM PLUMBING FIXTURE COUNT REQUIREMENTS**

	BUILDING CODE
Code Reference	Florida Building Code
Section Reference(s)	Plumbing Section 403.1 and Section 419.2

PERMIT SUBMITTAL IS FOR SHELL ONLY (NO OCCUPANCY). REQUIRED PLUMBING FIXTURES TO BE PROVIDED BY FUTURE TENANTS UNDER SEPARATE PERMITS. BY OWNER REQUEST RESTROOMS ARE PROVIDED ON LEVELS 01, 02 & 06.

**PERKINS + WILL**

806 DOUGLAS ROAD  
SUITE 300  
CORAL GABLES, FLORIDA  
33134

1212 LINCOLN ROAD  
1600 - 1634 ALTON RD.  
MIAMI BEACH, FL 33139



2200 BISCAYNE BLVD.  
MIAMI, FLORIDA 33137

LANDSCAPE ARCHITECT

URBAN ROBOT LLC

420 LINCOLN ROAD  
SUITE 600  
MIAMI BEACH, FLORIDA  
URBANROBOT.NET  
LA 6666853

MEP

BR+A

2600 S. DOUGLAS ROAD  
SUITE 1100  
CORAL GABLES, FLORIDA

STRUCTURAL

YHCE ENGINEERING  
12151 SW 128TH CT  
SUITE 104  
MIAMI, FLORIDA

CIVIL

MILLER LEGG  
7743 NW 48TH STREET,  
SUITE 140 MIAMI, FL  
33166



KEYPLAN

ISSUE CHART

PERMIT SET

13	PERMIT COMMENTS	06-11-2019
12	PERMIT COMMENTS	12-14-2018
8	REVISION & OWNER CHANGES	08-13-2018
6	PERMIT REVIEW COMMENTS	06-15-2018
5	ISSUE	05-17-2018
Permit Application Date 06-26-2015.		
Sheet Issue Date 12/15/16		
Job Number 810414.000		
Drawn	Checker	
Checked	Author	
Approved	Approver	
TITLE		

CODE COMPLIANCE DATA

SHEET NUMBER

A00-10



**PERMIT SET**


10	OWNER CHANGES	01-21-2020
11	ASB/DA OWNER CHANGES	06-27-2019
12	PERMIT COMMENTS	06-28-2019
13	PERMIT COMMENTS	05-17-2019
12	COORDINATION AND PERMIT COMMENTS	03-29-2019
10	PERMIT COMMENTS	12-14-2018
8	REVISION & OWNER CHANGES	06-10-2018
6	PERMIT REVIEW COMMENTS	06-15-2018
5	ISSUE CHART	

Permit Application Date 06-26-2015.  
Sheet Issue Date 12/15/16  
Job Number 810414.000  
Drawn Author  
Checked Checker  
Approved Approver


**FAR DIAGRAMS**

**A01-02**


FAR	
Level	POST-DRB
LEVEL 01	40,138 SF
LEVEL 02	32,851 SF
LEVEL 03	3,117 SF
LEVEL 04	2,794 SF
LEVEL 05	2,749 SF
LEVEL 06	13,070 SF
84,978 SF	

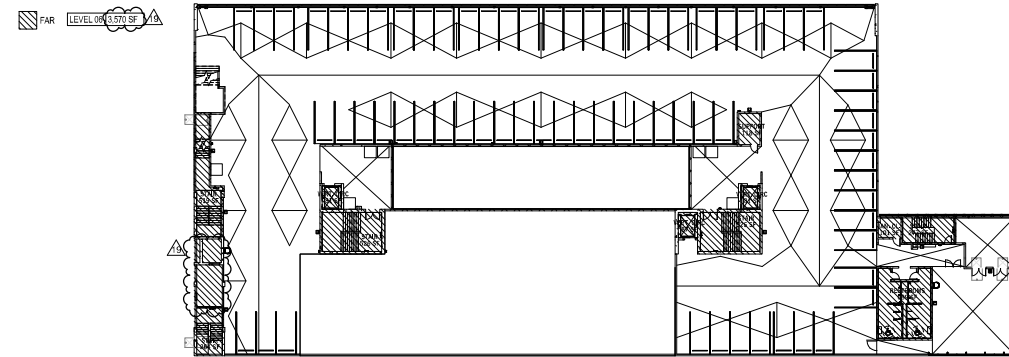

6 LEVEL 06  
1" = 30'-0"

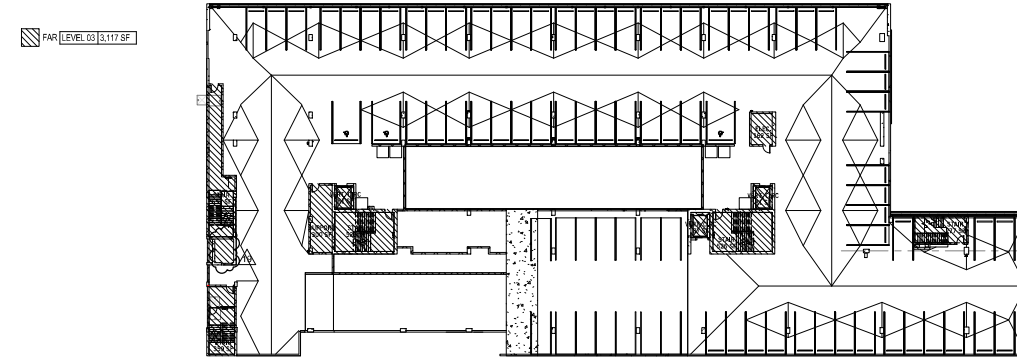


3 LEVEL 03  
1" = 30'-0"


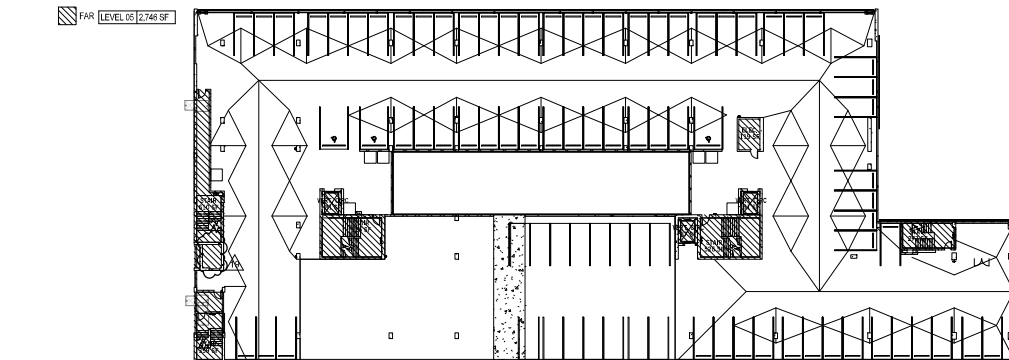


5 LEVEL 05  
1" = 30'-0"

FAR LEVEL 02 32,851 SF

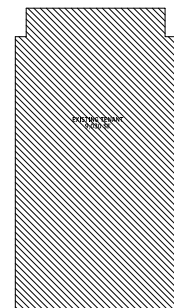


2 LEVEL 02  
1" = 30'-0"

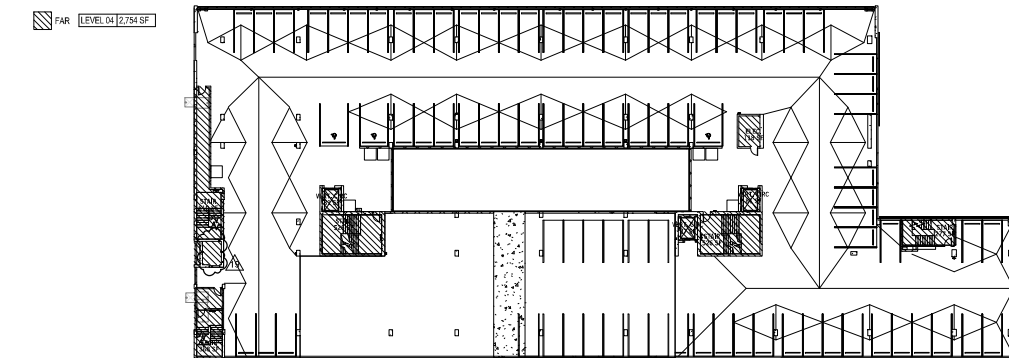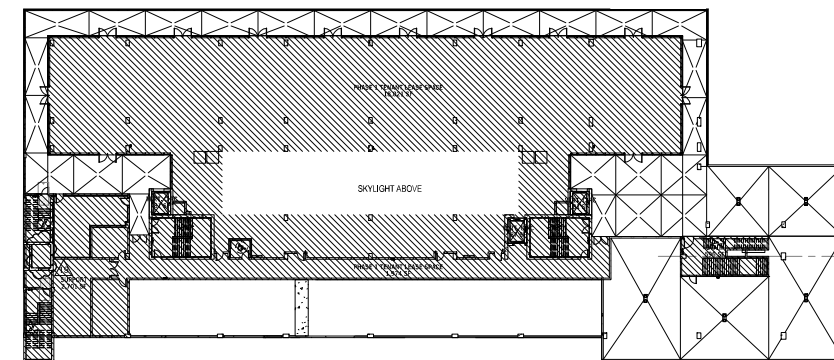

4 LEVEL 04  
1" = 30'-0"

FAR LEVEL 01 40,138 SF

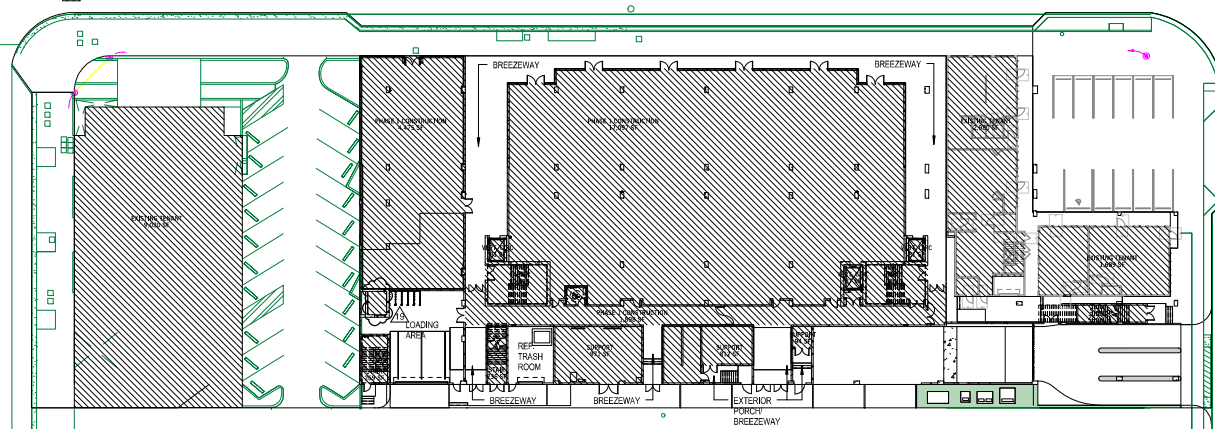

1 LEVEL 01  
1" = 30'-0"

NOTES:  
 DASHED WALL PARTITIONS REPRESENTS WORK THAT IS N.I.C.  
 INTERIOR PARTITIONS FOR PHASE 2 ARE N.I.C.

**PERKINS  
 + WILL**

806 DOUGLAS ROAD  
 SUITE 300  
 CORAL GABLES, FLORIDA  
 33134

**1212 LINCOLN ROAD**  
 1600 - 1634 ALTON RD.  
 MIAMI BEACH, FL 33139

**CRESCENT HEIGHTS\***  
 INSPIRATIONAL LIVING

2200 BISCAYNE BLVD.  
 MIAMI, FLORIDA 33137

LANDSCAPE ARCHITECT

**URBAN ROBOT  
 LLC**

420 LINCOLN ROAD  
 SUITE 600  
 MIAMI BEACH, FLORIDA  
 URBANROBOT.NET  
 LA 6668853

MEP

**BR+A**

2600 S. DOUGLAS ROAD  
 SUITE 1100  
 CORAL GABLES, FLORIDA

STRUCTURAL

**YHCE ENGINEERING**

12151 SW 128TH CT  
 SUITE 104  
 MIAMI, FLORIDA

CIVIL

**MILLER LEGG**

7743 NW 48TH STREET,  
 SUITE 140 MIAMI, FL  
 33166



KEYPLAN

ISSUE CHART

**PERMIT SET**

NO.	OWNER CHANGES	DATE
13	OWNER CHANGES	01-21-2020
17	OWNER CHANGES	08-26-2019
16	ASH 004 OWNER CHANGES	06-27-2019
13	PERMIT COMMENTS	02-21-2019
12	COORDINATION AND PERMIT COMMENTS	03-29-2019
11	ASH 002 AND ASH 003 OWNER CHANGES	01-31-2019
10	PERMIT COMMENTS	12-14-2018
9	ASH 001 OWNER COORDINATION	10-31-2018
8	REVISION 8 OWNER CHANGES	08-10-2018
6	PERMIT REVIEW COMMENTS	06-15-2018
5	ISSUE	06-15-2018


Permit Application Date 06-26-2015  
 Sheet Issue Date 12/15/16  
 Job Number 810414.000  
 Drawn Author  
 Checked Checker  
 Approved Approver

**LEVEL 01 AND 02  
 OVERALL FLOOR PLAN**


SHEET NUMBER

**A03-01**

Copyright © 2014 Perkins+WILL

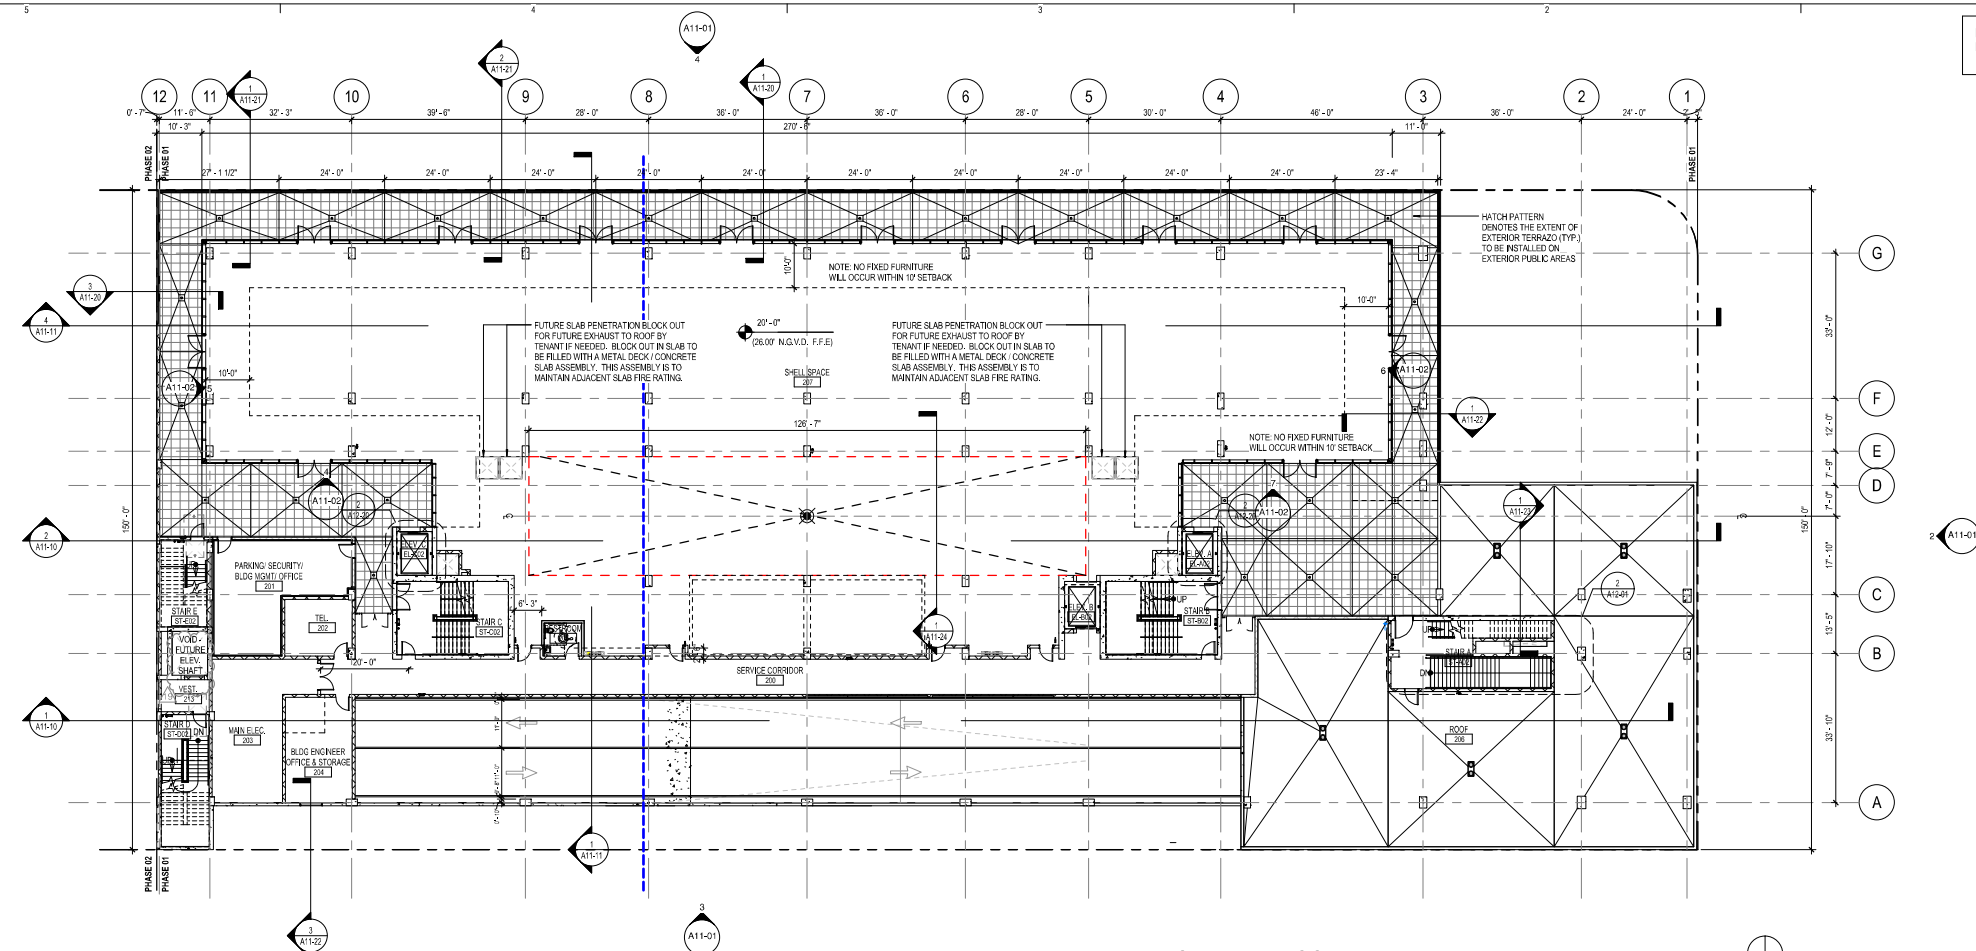

**2 LEVEL 02 OVERALL FLOOR PLAN**  
 1/16" = 1'-0"

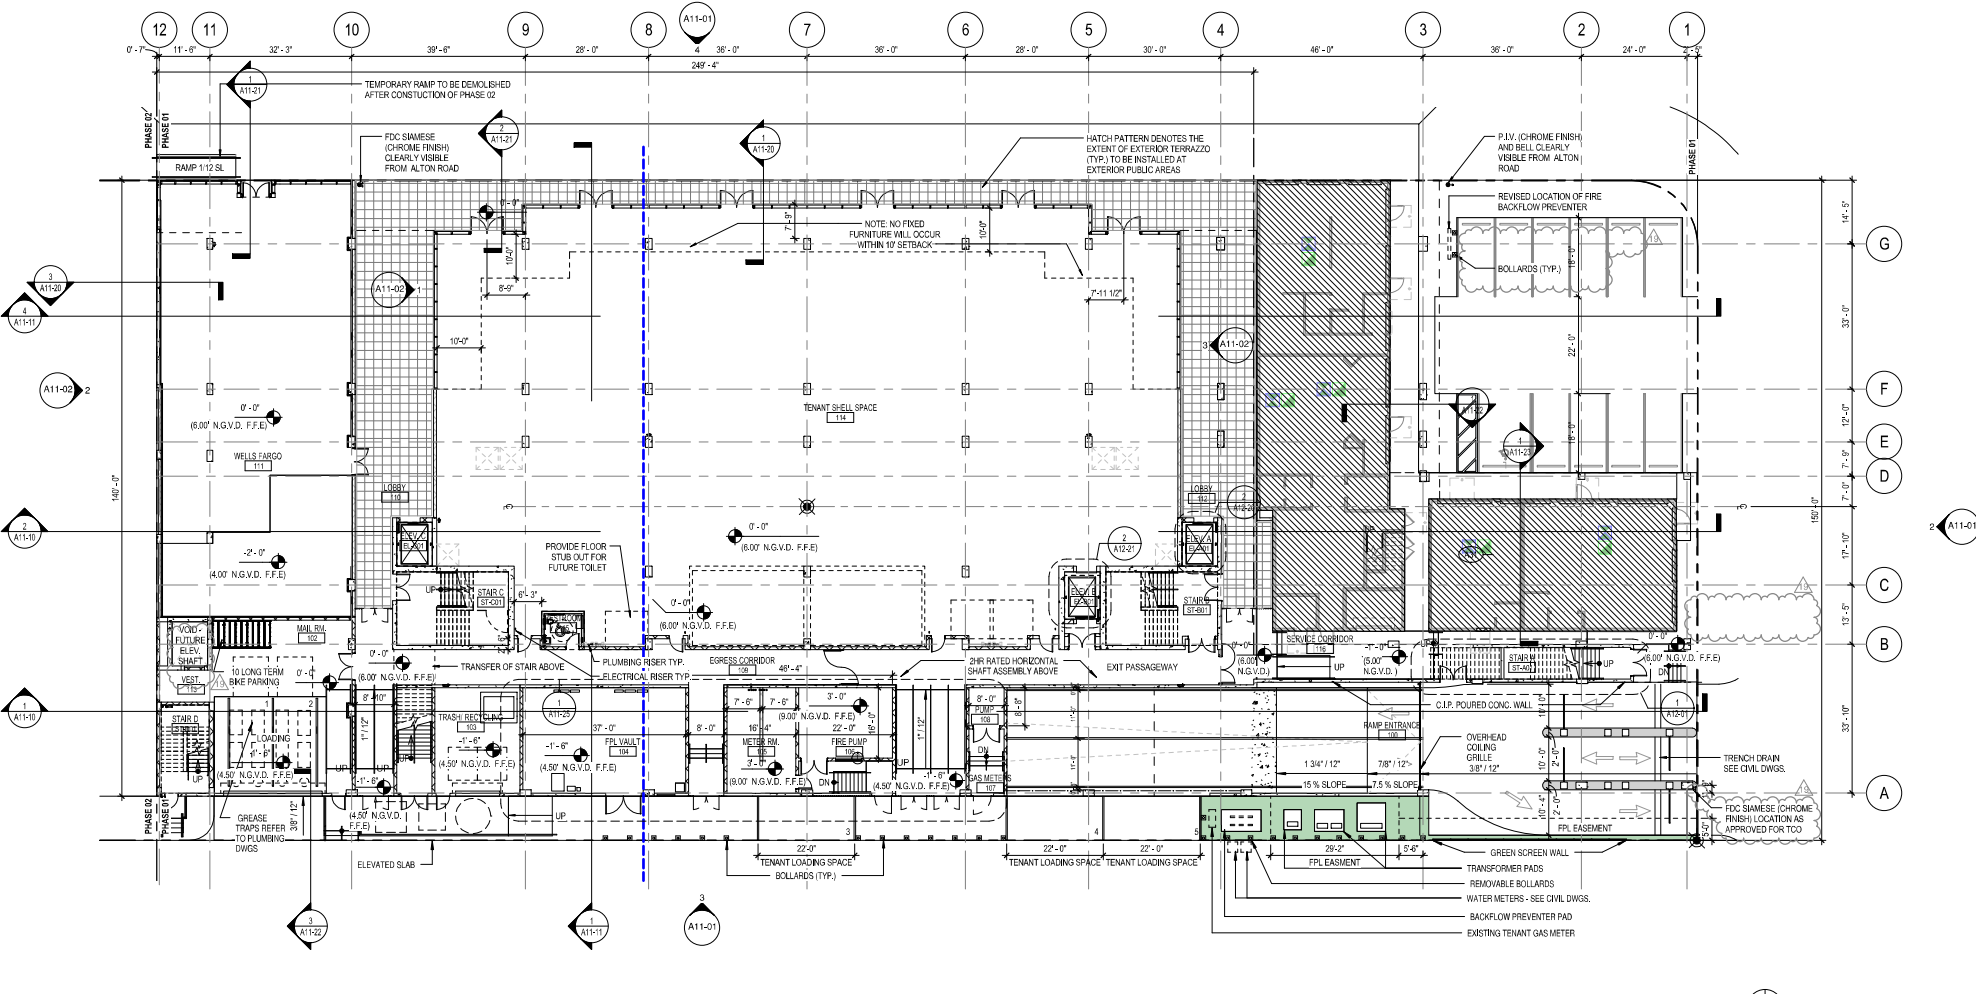

**1 LEVEL 01 OVERALL FLOOR PLAN**  
 1/16" = 1'-0"


1/20/2020 10:18:27 AM c:\temp\1212 LINCOLN\_PHASED PERMIT\_cad\m...






13	OWNER CHANGES	01-21-2020
17	OWNER CHANGES	06-26-2015
18	ASB 004 OWNER CHANGES	06-21-2015
11	ASB 002 AND ASB 003 OWNER CHANGES	01-31-2015
10	PERMIT COMMENTS	12-14-2014
9	ASB 001 OWNER COORDINATION	10-31-2014
8	REVISION 1 OWNER CHANGES	06-10-2014
6	PERMIT REVIEW COMMENTS	06-15-2014
5	ISSUE	06-15-2014

Permit Application Date 06-26-2015  
Sheet Issue Date 12/15/16  
Job Number 810414.000  
Drawn Author  
Checked Checker  
Approved Approver

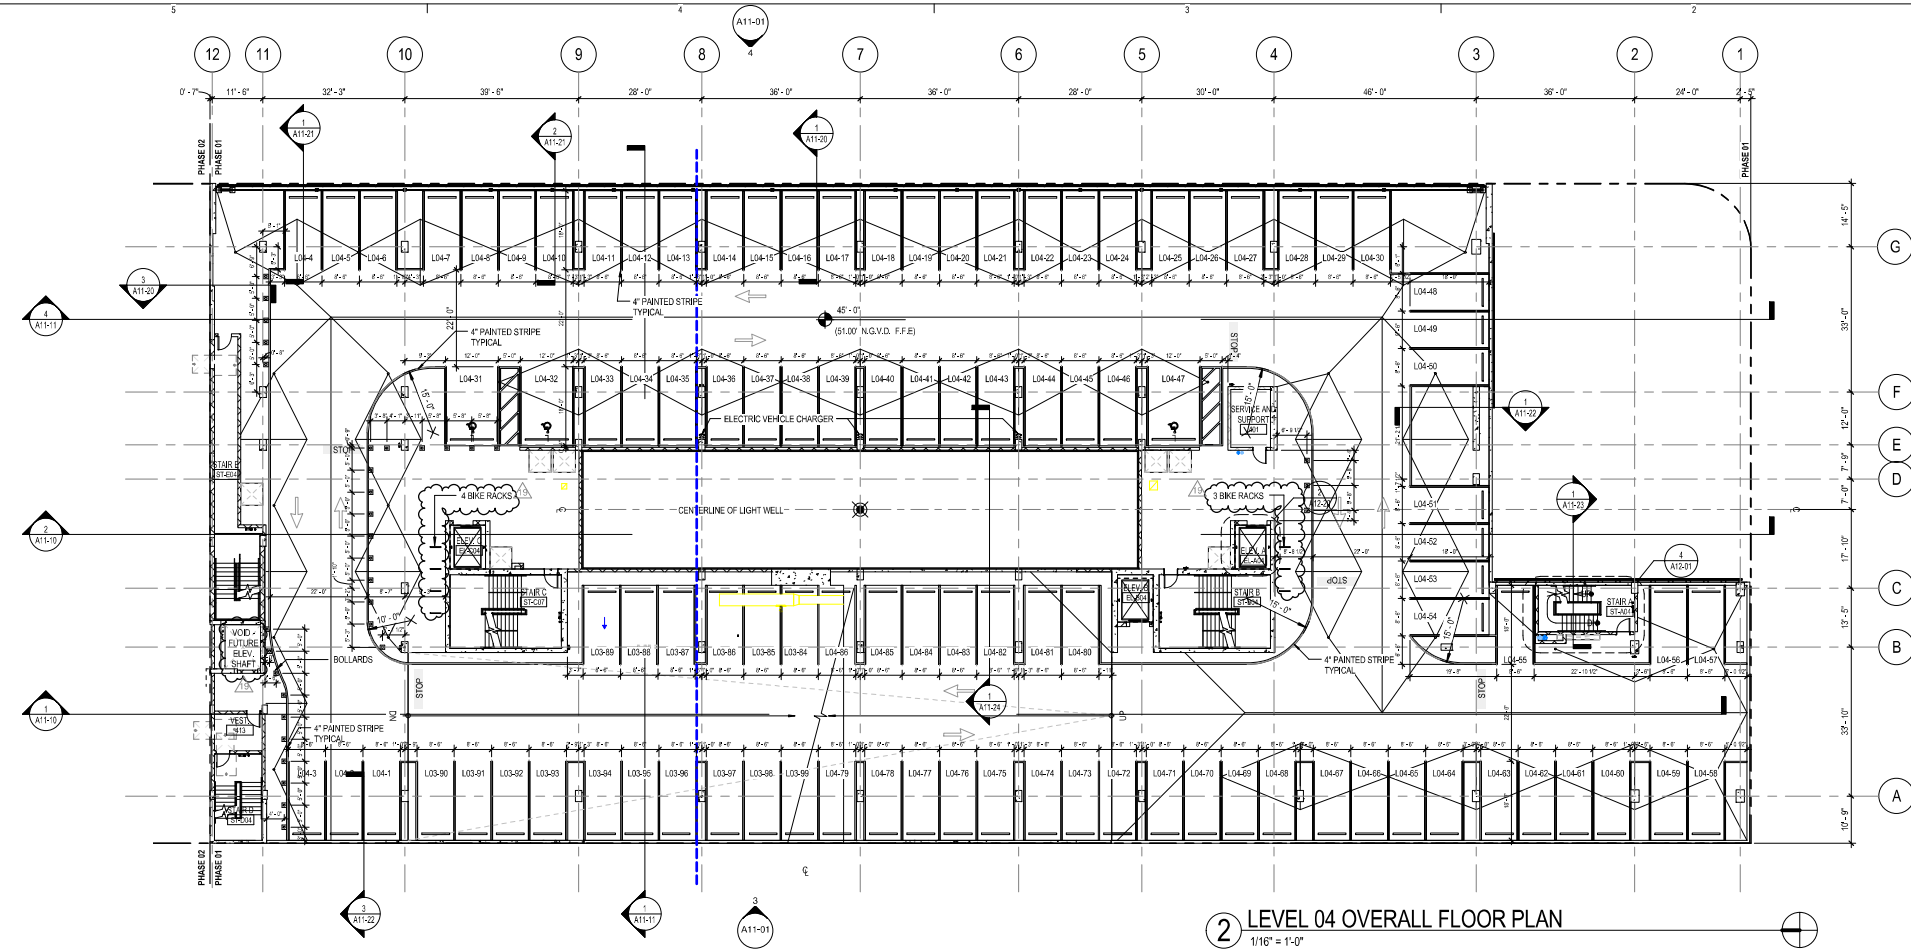

**2 LEVEL 04 OVERALL FLOOR PLAN**  
1/16" = 1'-0"

PARKING SCHEDULE LEVEL 4	
TYPE	COUNT
ADA LARGE STALL	3
LARGE STALL	98
	101

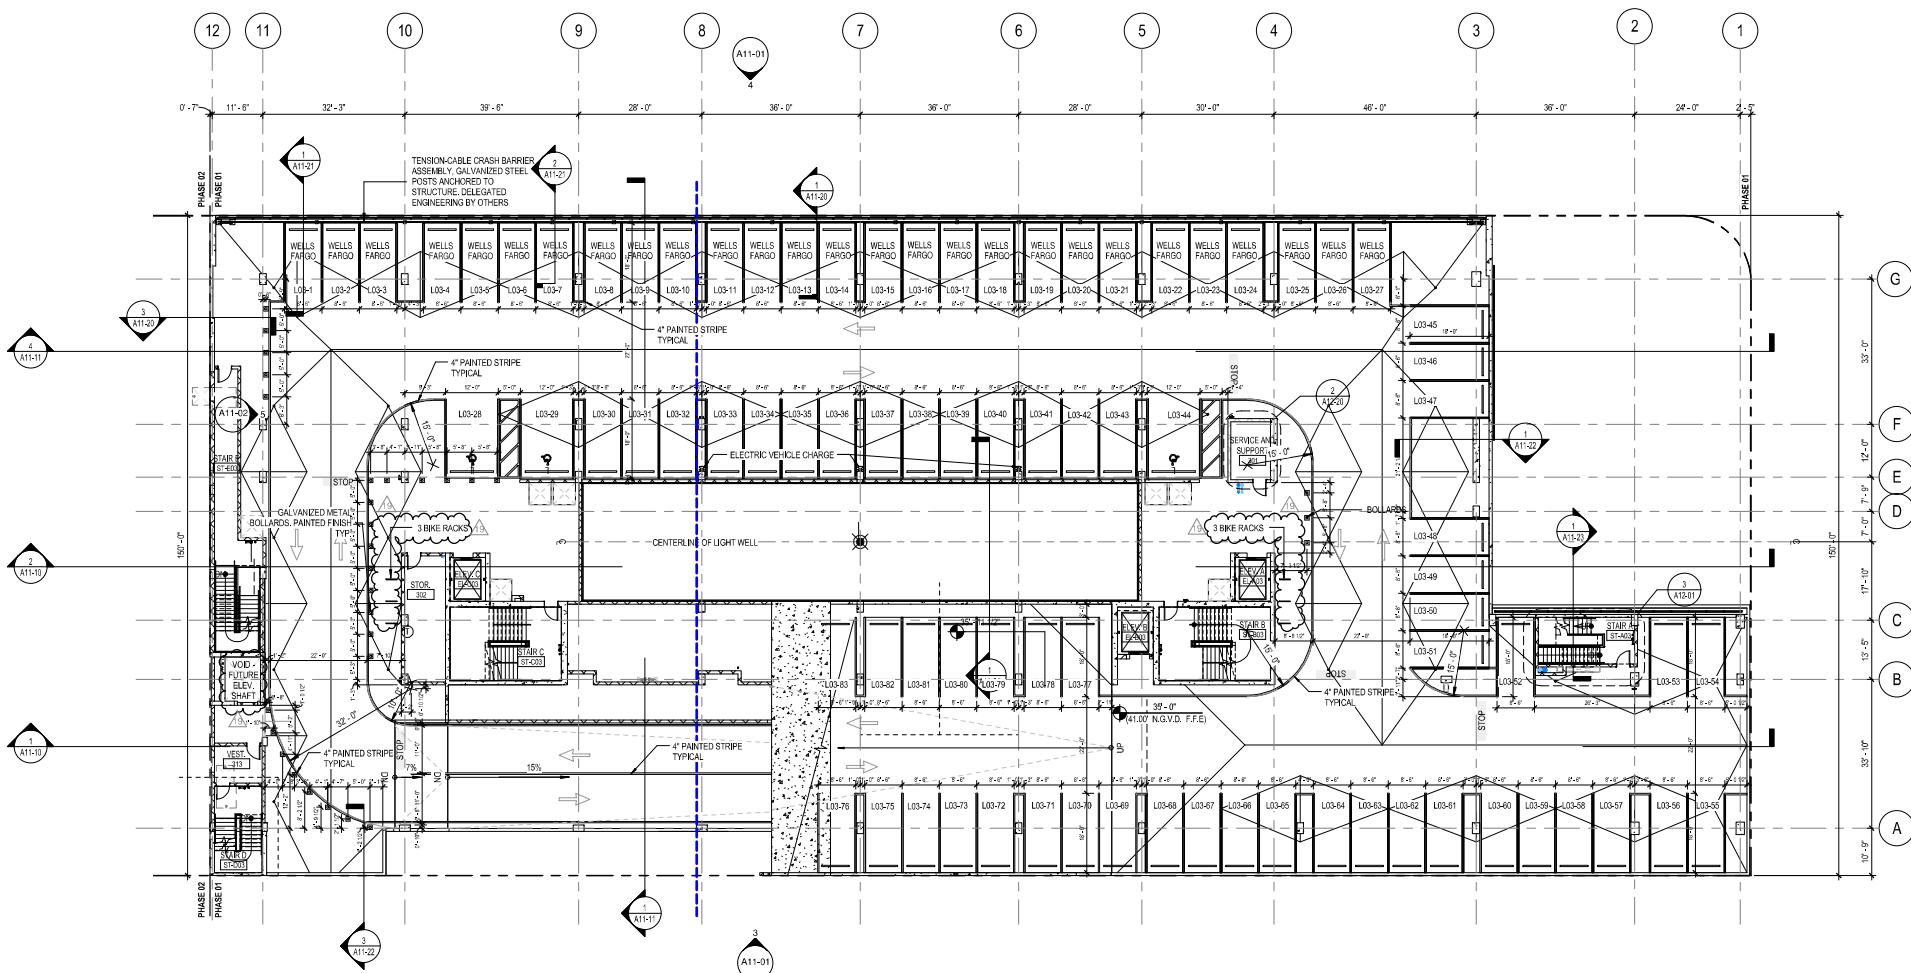

**1 LEVEL 03 OVERALL FLOOR PLAN**  
1/16" = 1'-0"

130-437) SHORT TERM AND LONG TERM BICYCLE PARKING FOR RETAIL.  
REQUIREMENT  
10 SHORT TERM (1 PER 10,000 SF OF RETAIL)  
10 LONG TERM  
PROPOSED  
13 SHORT TERM / 10 LONG TERM  
(SEE LONG TERM PARKING BIKE STORAGE ON 1ST FLOOR)

NOTES:  
DASHED WALL PARTITIONS REPRESENTS WORK THAT IS N.L.C.  
INTERIOR PARTITIONS FOR PHASE 2 ARE N.L.C.


PARKING SCHEDULE LEVEL 3	
TYPE	COUNT
ADA LARGE STALL	3
LARGE STALL	96
	99

1/20/2020 10:08:14 AM c:\temp\1212 LINCOLN PHASED PERMIT\_c0304a.ar0304.rvt




13	OWNER CHANGES	01-21-2020
17	OWNER CHANGES	06-26-2015
18	ASB 004 OWNER CHANGES	06-21-2019
11	ASB 002 AND ASB 003 OWNER CHANGES	01-31-2019
10	PERMIT COMMENTS	12-14-2018
9	ASB 001 OWNER COORDINATION	10-31-2018
8	REVISION 3 OWNER CHANGES	06-10-2018
7	PERMIT REVIEW COMMENTS	06-15-2018

Permit Application Date	06-26-2015
Sheet Issue Date	12/15/16
Job Number	810414.000
Drawn	Author
Checked	Checker
Approved	Approver

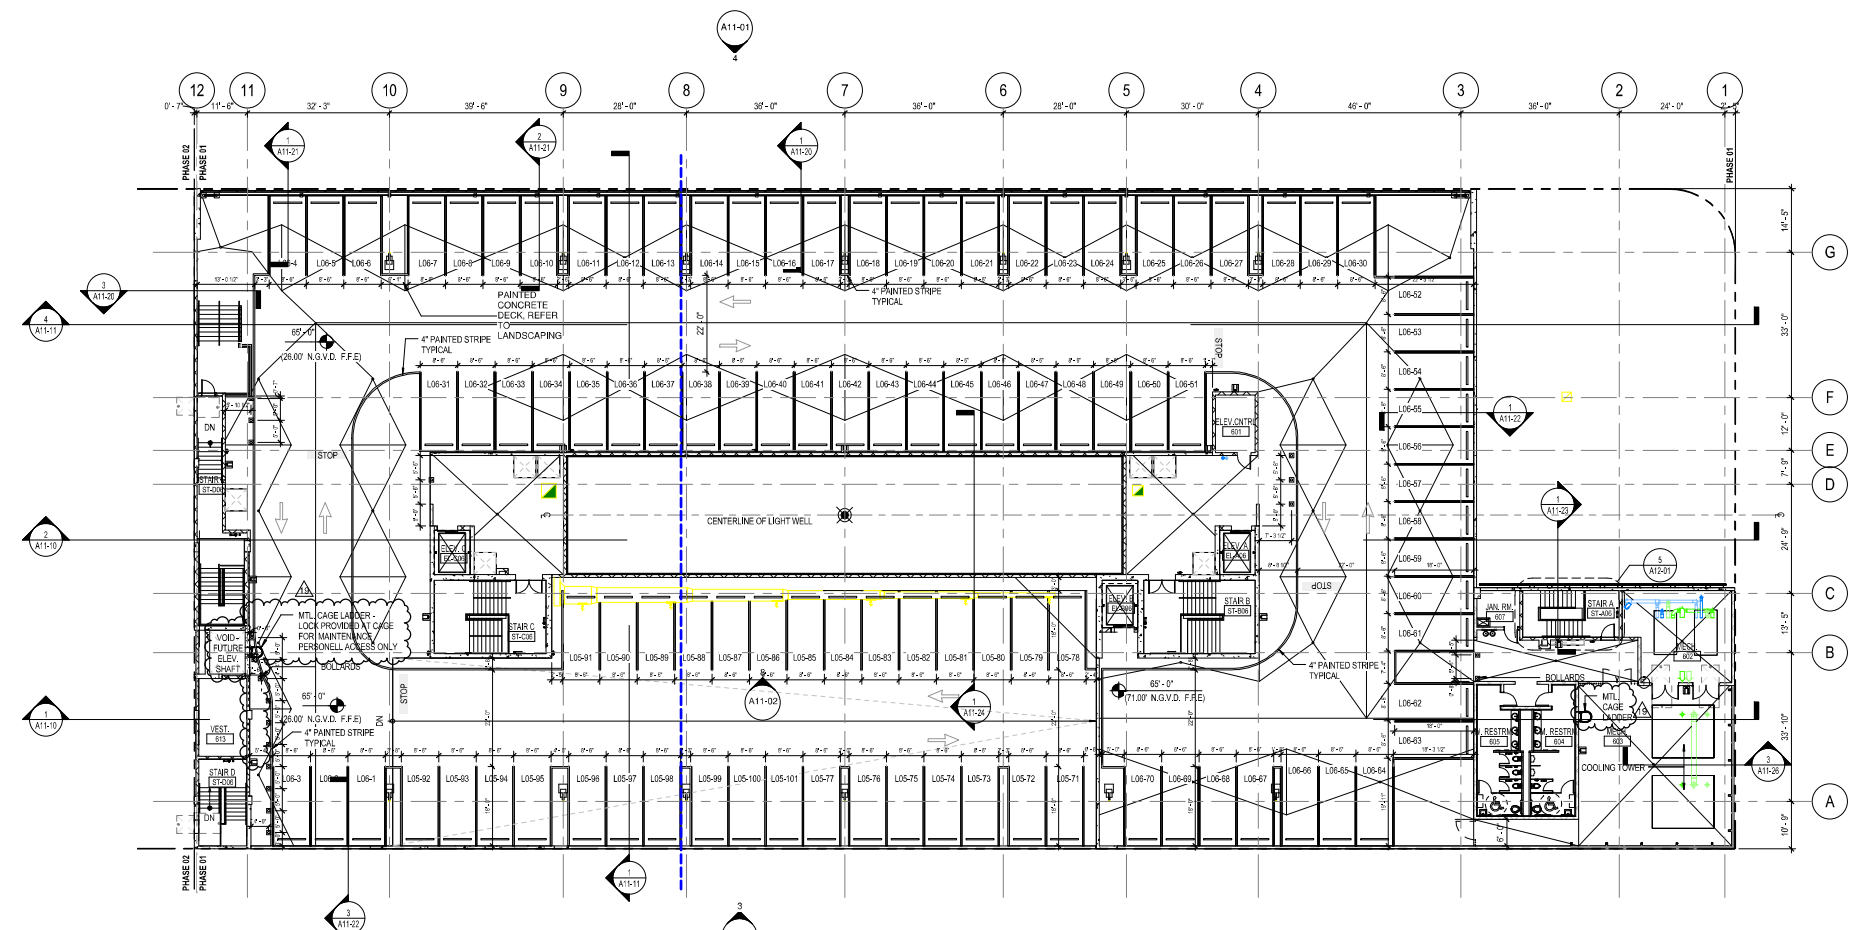

**2 ROOF LEVEL OVERALL FLOOR PLAN**  
1/16" = 1'-0"

PARKING SCHEDULE LEVEL 6	
TYPE	COUNT
LARGE STALL	70
	70

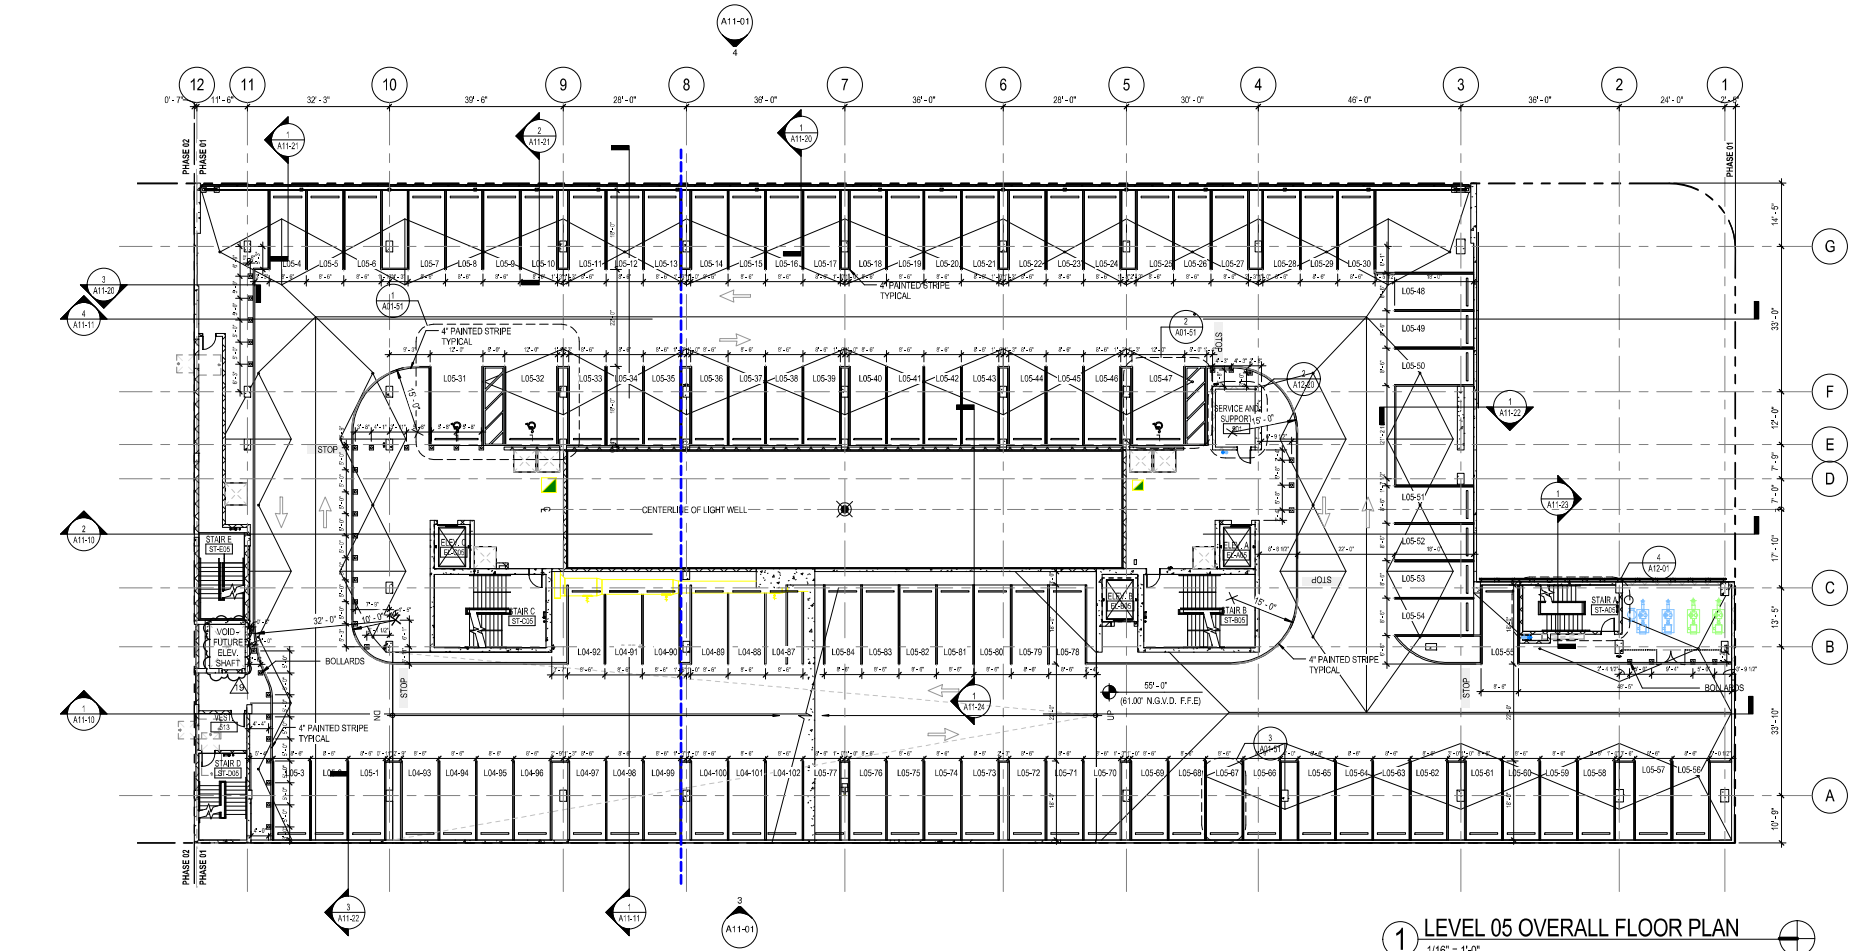

**1 LEVEL 05 OVERALL FLOOR PLAN**  
1/16" = 1'-0"

PARKING SCHEDULE LEVEL 5	
TYPE	COUNT
ADA LARGE STALL	3
LARGE STALL	89
	102

NOTES:  
DASHED WALL PARTITIONS REPRESENTS WORK THAT IS N.L.C.  
INTERIOR PARTITIONS FOR PHASE 2 ARE N.L.C.

**PERKINS  
+ WILL**

806 DOUGLAS ROAD  
SUITE 300  
CORAL GABLES, FLORIDA  
33134

**1212 LINCOLN ROAD**  
1600 - 1634 ALTON RD.  
MIAMI BEACH, FL 33139

**CRESCENT HEIGHTS**  
INSPIRATIONAL LIVING

2200 BISCAYNE BLVD.  
MIAMI, FLORIDA 33137

LANDSCAPE ARCHITECT

**URBAN ROBOT  
LLC**

420 LINCOLN ROAD  
SUITE 600  
MIAMI BEACH, FLORIDA  
URBANROBOT.NET  
LA 6666853

MEP

**BR+A**

2600 S. DOUGLAS ROAD  
SUITE 1100  
CORAL GABLES, FLORIDA

STRUCTURAL


**YHCE ENGINEERING**

12151 SW 128TH CT  
SUITE 104  
MIAMI, FLORIDA

CIVIL

**MILLER LEGG**

7743 NW 48TH STREET,  
SUITE 140 MIAMI, FL  
33166

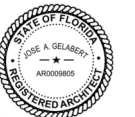

KEYPLAN

ISSUE CHART

**PERMIT SET**


17	OWNER CHANGES	08-09-2019
15	AS/04 OWNER CHANGES	02-21-2019
14	PERMIT COMMENTS	06-26-2019
13	SEVENSON OWNER CHANGES	06-15-2018
12	ISSUE	06-15-2018
Permit Application Date 06-26-2015.		
Sheet Issue Date 12/15/16		
Job Number 810414.000		
Drawn	Author	
Checked	Checker	
Approved	Approver	
TITLE		

**UPPER ROOF  
OVERALL FLOOR PLAN**

SHEET NUMBER

**A03-04**

Copyright © 2014 Perkins+Will

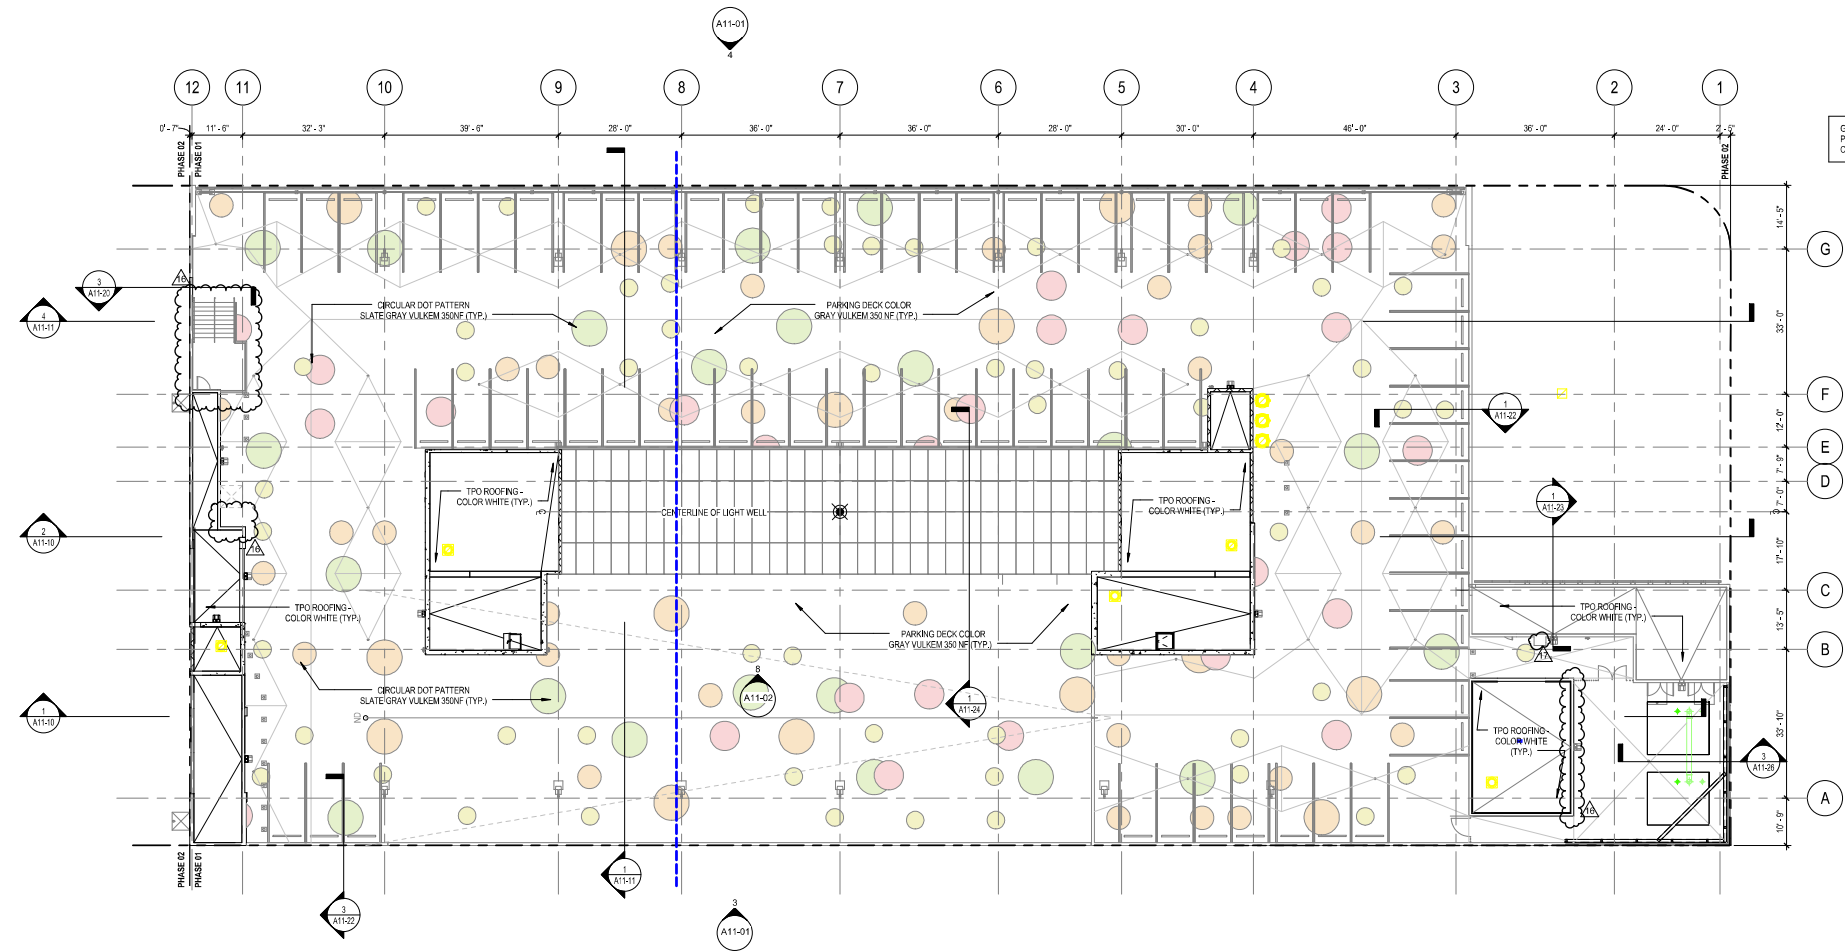

GENERAL NOTE:  
PARKING DECK COLOR - GRAY VULKEM 350 / TREMCO VEHICULAR DECK COATING  
CIRCULAR DOT PATTERN COLOR - SLATE GRAY VULKEM 350 / TREMCO VEHICULAR DECK COATING

1 UPPER ROOF LEVEL OVERALL FLOOR PLAN  
1/16" = 1'-0"



806 DOUGLAS ROAD  
SUITE 300  
CORAL GABLES, FLORIDA  
33134

**1212 LINCOLN ROAD**  
1600 - 1634 ALTON RD.  
MIAMI BEACH, FL 33139

2200 BISCAYNE BLVD.  
MIAMI, FLORIDA 33137

LANDSCAPE ARCHITECT

**URBAN ROBOT LLC**  
420 LINCOLN ROAD  
SUITE 600  
MIAMI BEACH, FLORIDA  
URBANROBOT.NET  
LA 6666853

MEP

**BR+A**  
2600 S. DOUGLAS ROAD  
SUITE 1100  
CORAL GABLES, FLORIDA

STRUCTURAL

**YHCE ENGINEERING**  
12151 SW 128TH CT  
SUITE 104  
MIAMI, FLORIDA

CIVIL

**MILLER LEGG**  
7743 NW 48TH STREET,  
SUITE 140 MIAMI, FL  
33166



KEYPLAN

ISSUE CHART

PERMIT SET





17	OWNER CHANGES	08/09/2019
13	PERMIT COMMENTS	05/12/2019
12	COORDINATION AND PERMIT COMMENTS	03/29/2019
11	ASB 002 AND ASB 003 OWNER CHANGES	01/31/2019
10	PERMIT COMMENTS	12/14/2018
9	ASB 001 OWNER COORDINATION	10/31/2018
8	REVISION 1 OWNER CHANGES	08/10/2018
6	PERMIT RENEWAL COMMENTS	06/15/2018
5	PERMIT RENEWAL COMMENTS	06/15/2018
Permit Application Date		06-26-2015.
Sheet Issue Date		12/15/16
Job Number		810414.000
Drawn	Author	
Checked	Checker	
Approved	Approver	
TITLE		

**EXTERIOR BUILDING ELEVATIONS**

SHEET NUMBER

**A11-01**

Copyright © 2014 Perkins+Will

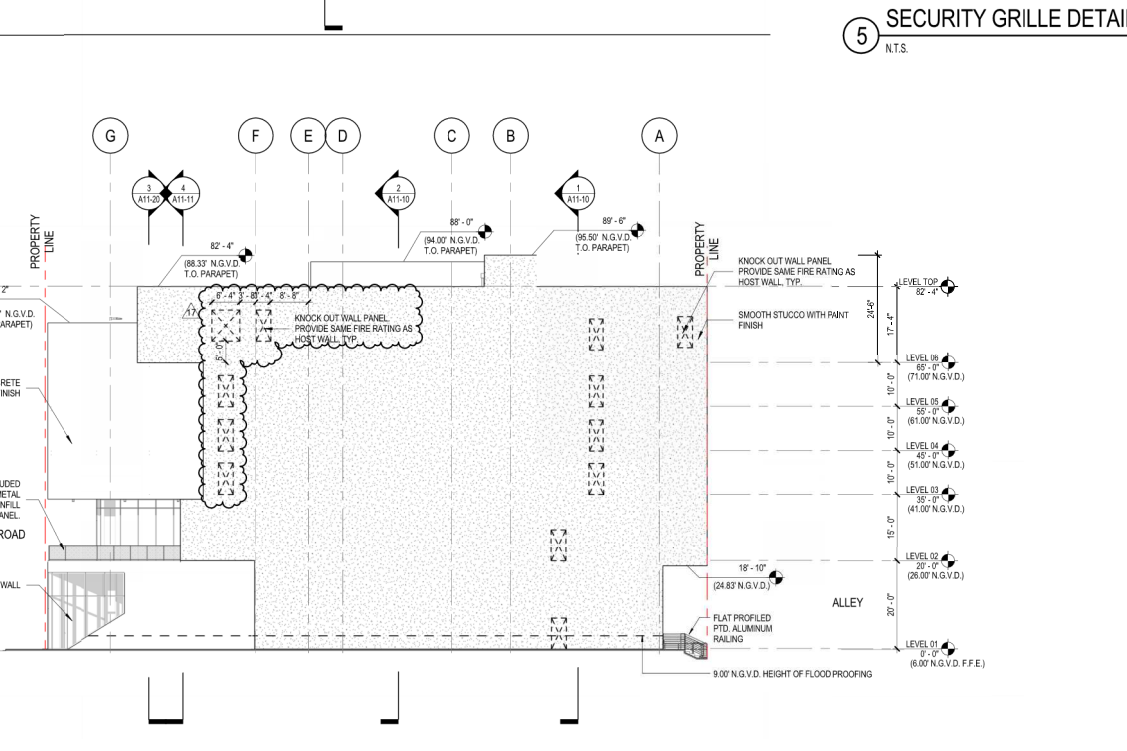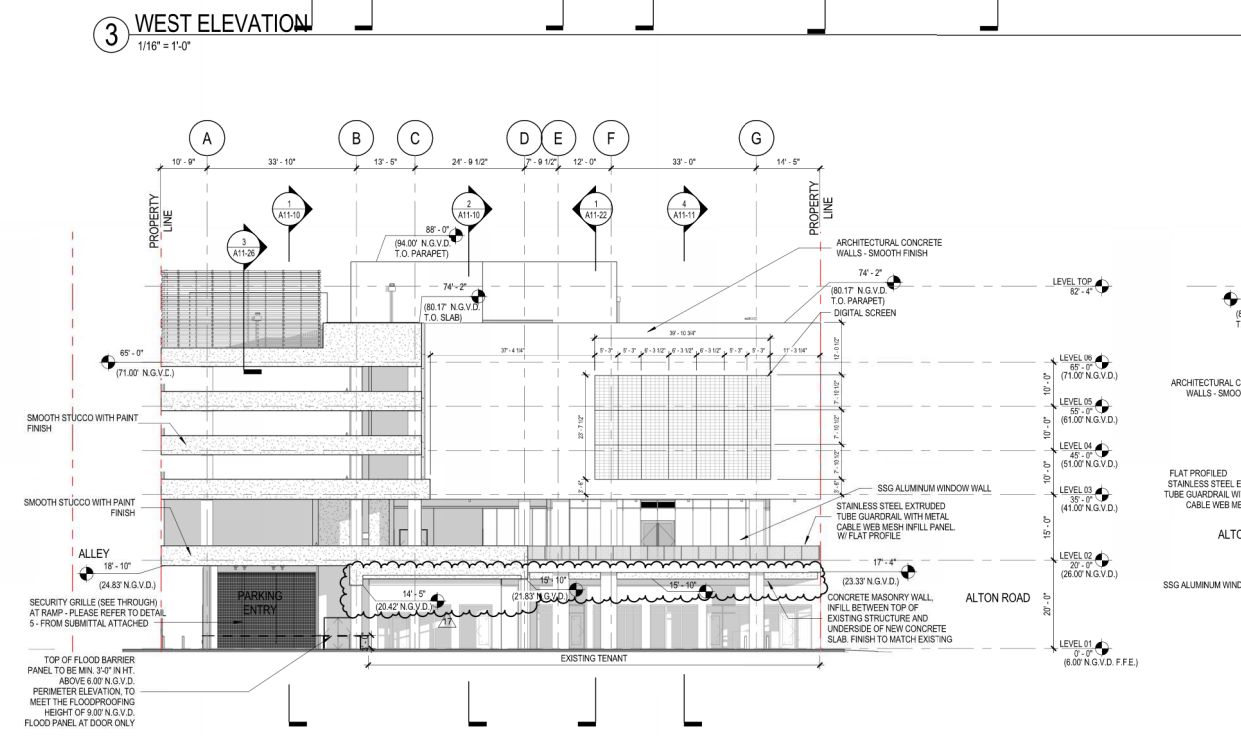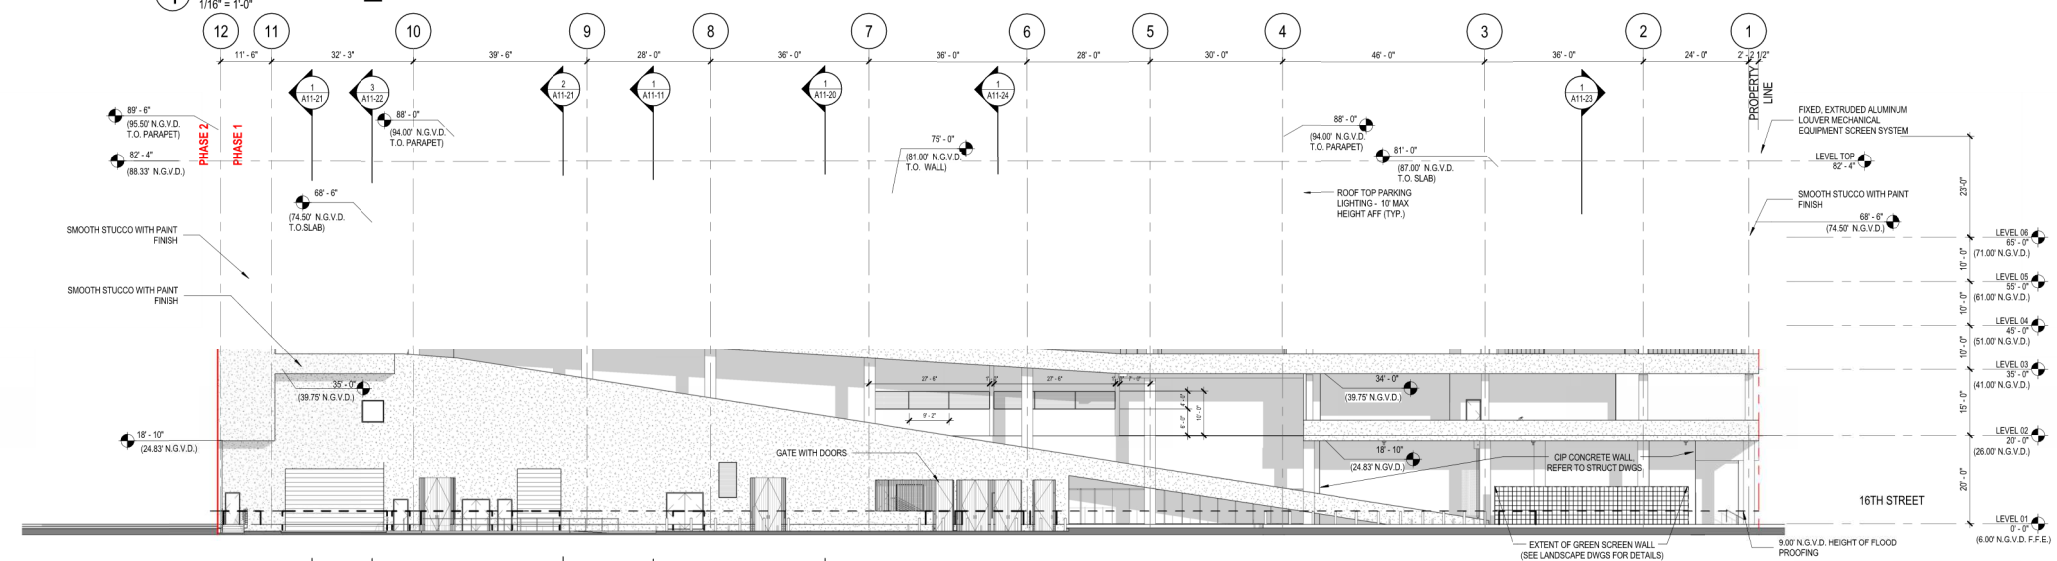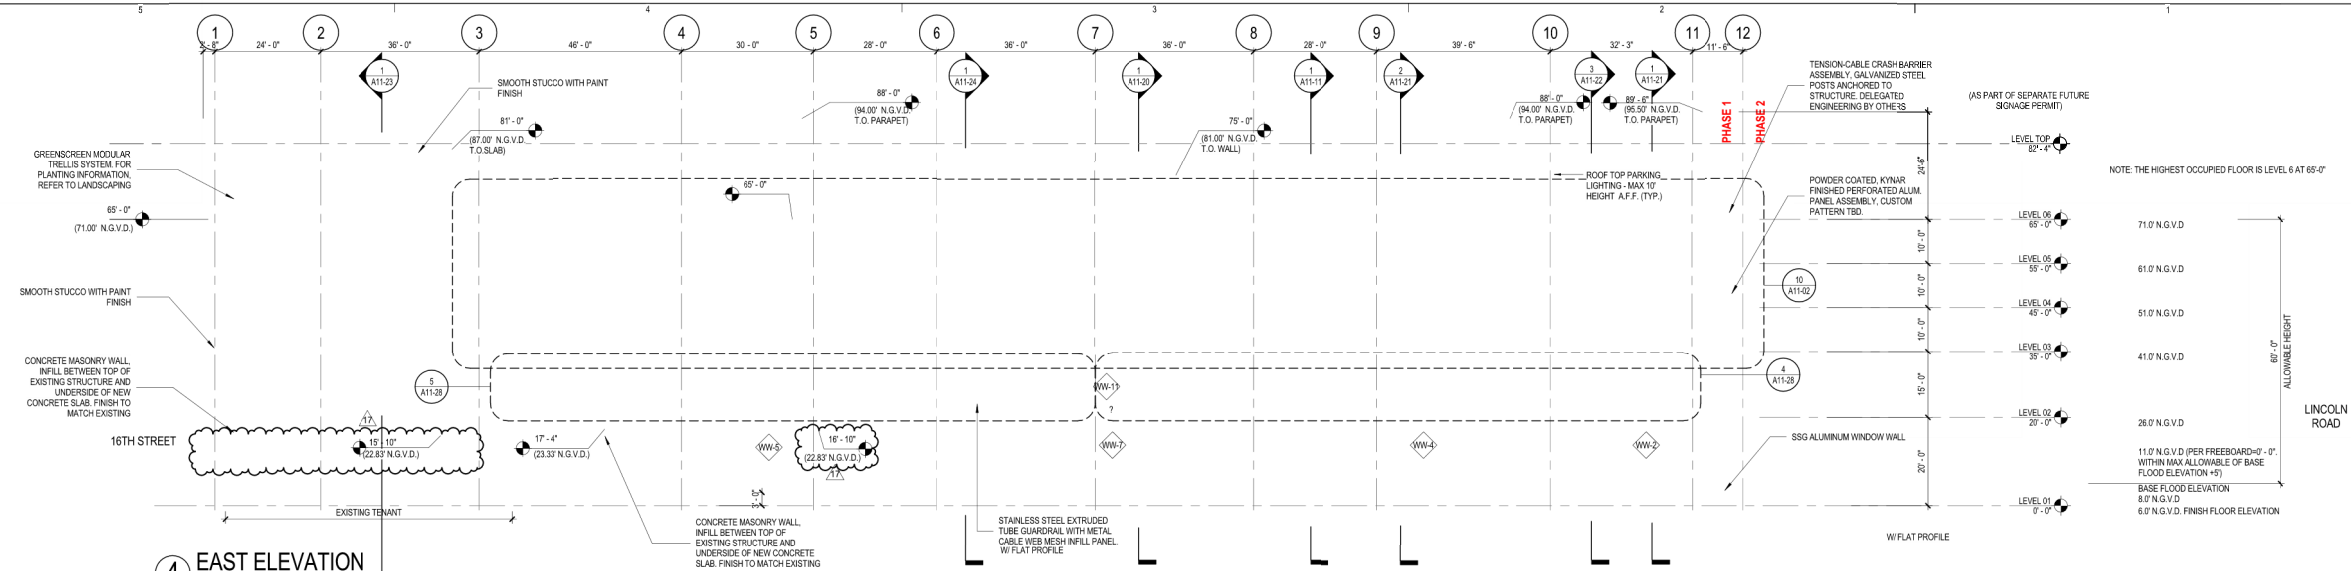


D:\2019\3\16\41 PM c:\temp\1212 LINCOLN\_PHASED PERMIT\_milboc.cvt




13	OWNER CHANGES	01-21-2020
11	ASB 002 AND ASB 003 OWNER CHANGES	01-31-2019
10	PERMIT COMMENTS	12-14-2018
8	REVISION 5 OWNER CHANGES	06-10-2018
6	PERMIT REVIEW COMMENTS	06-15-2018
5	REVISION 4 OWNER CHANGES	06-15-2018
4	PERMIT REVIEW COMMENTS	06-15-2018
3	REVISION 3 OWNER CHANGES	06-15-2018
2	PERMIT REVIEW COMMENTS	06-15-2018
1	PERMIT REVIEW COMMENTS	06-15-2018


Permit Application Date 06-26-2015.  
Sheet Issue Date 12/15/16  
Job Number 810414.000  
Drawn Author  
Checked Checker  
Approved Approver

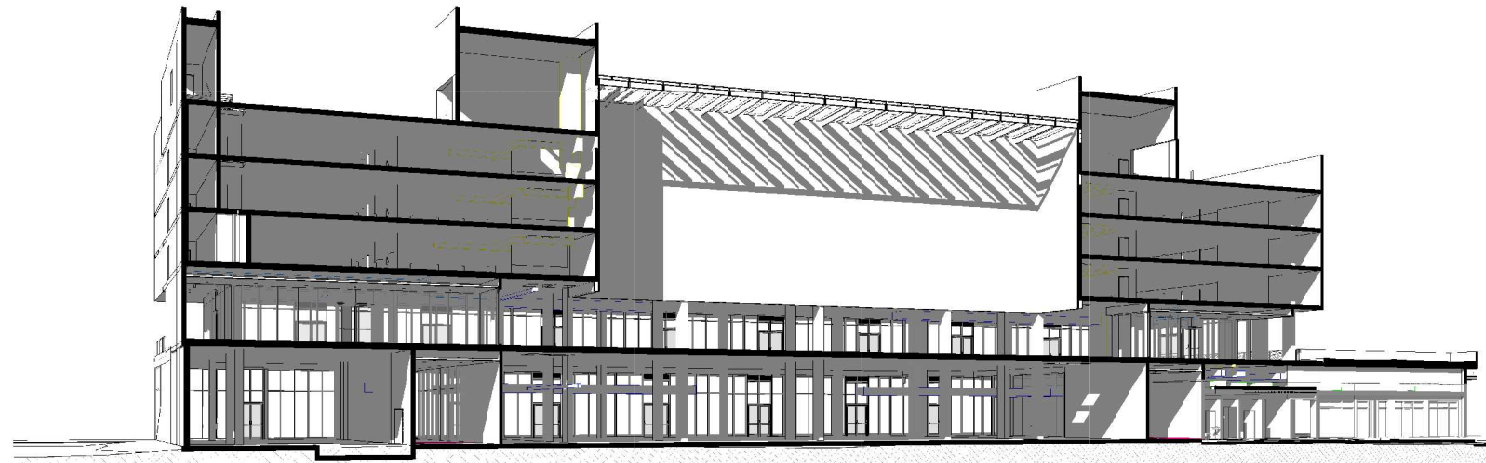

3 SECTION PERSPECTIVE

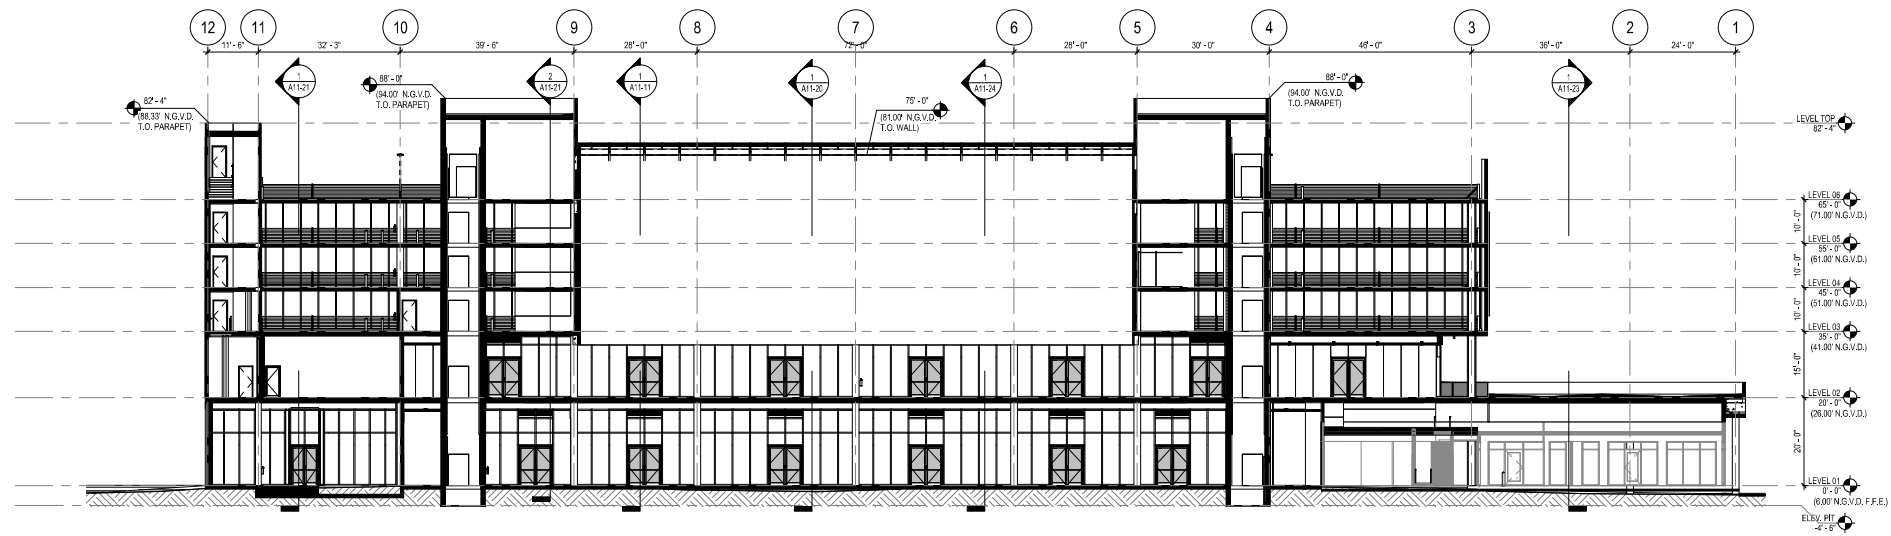

2 BUILDING SECTION  
1/16" = 1'-0"

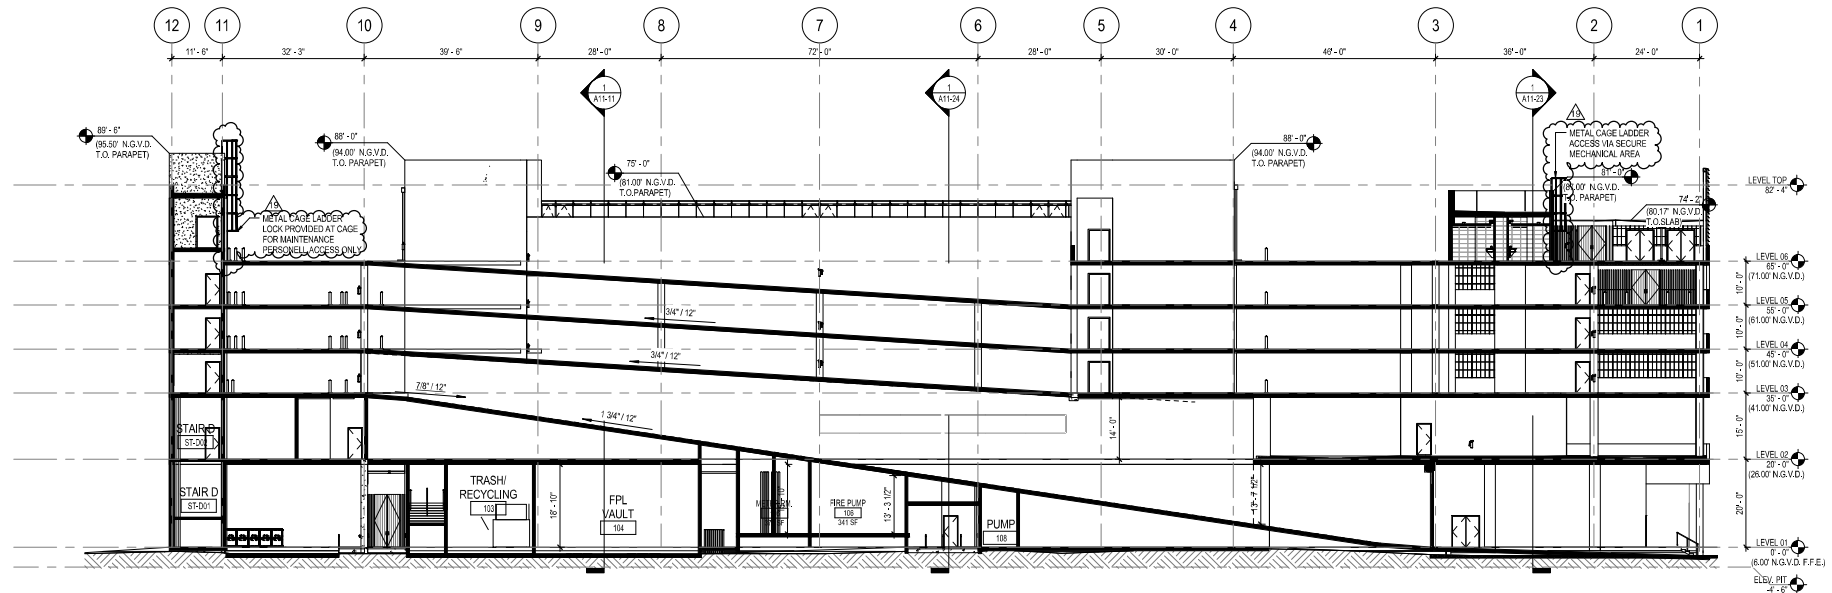

1 BUILDING SECTION  
1/16" = 1'-0"

1/20/2020 11:15:38 AM c:\temp\1212 LINCOLN\_PHASED PERMIT\_cad\brb\brb.rvt






NO.	PERMIT COMMENTS	DATE
13	PERMIT COMMENTS	05-17-2019
12	COORDINATION AND PERMIT COMMENTS	03-28-2019
10	PERMIT COMMENTS	12-14-2018
8	REVISION TO OWNER CHANGES	08-10-2018
7	ISSUE	06-28-2018


Permit Application Date 06-28-2015  
 Sheet Issue Date 12/15/16  
 Job Number 810414.000  
 Drawn Author  
 Checked Checker  
 Approved Approver




5 SECTION PERSPECTIVE

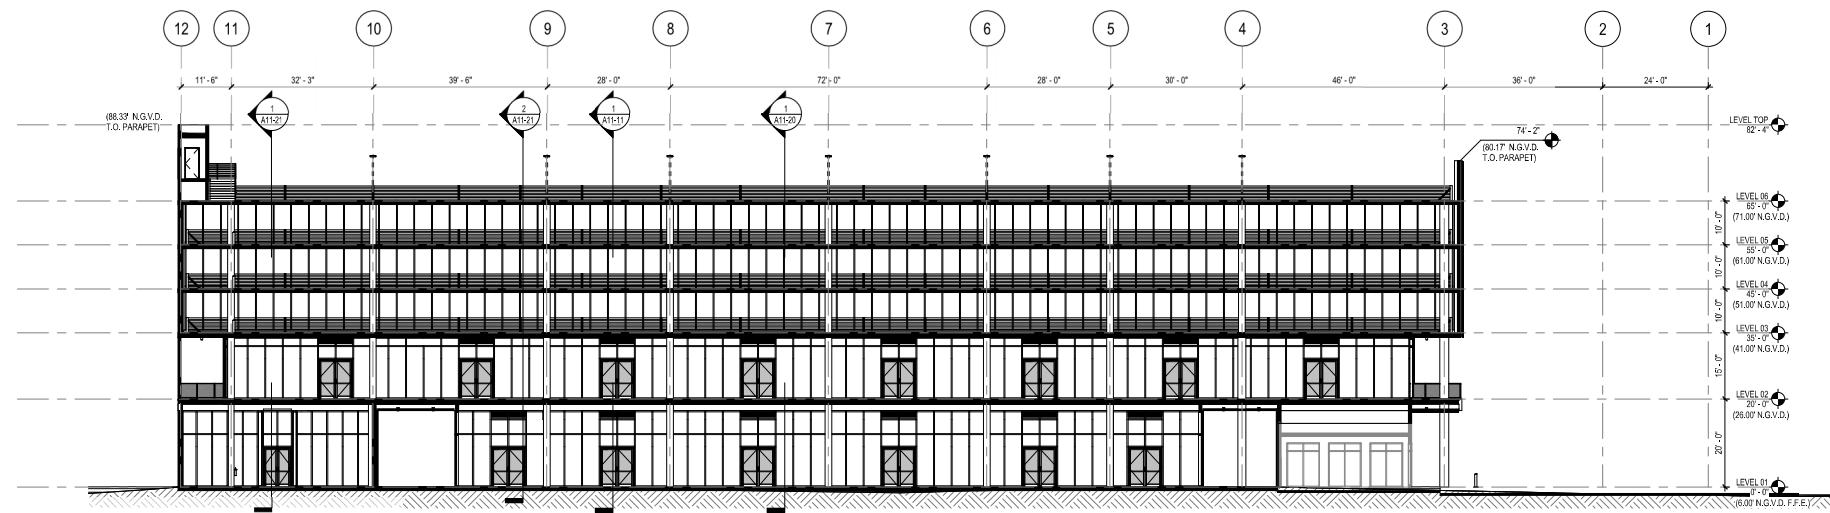

4 BUILDING SECTION  
1/16" = 1'-0"

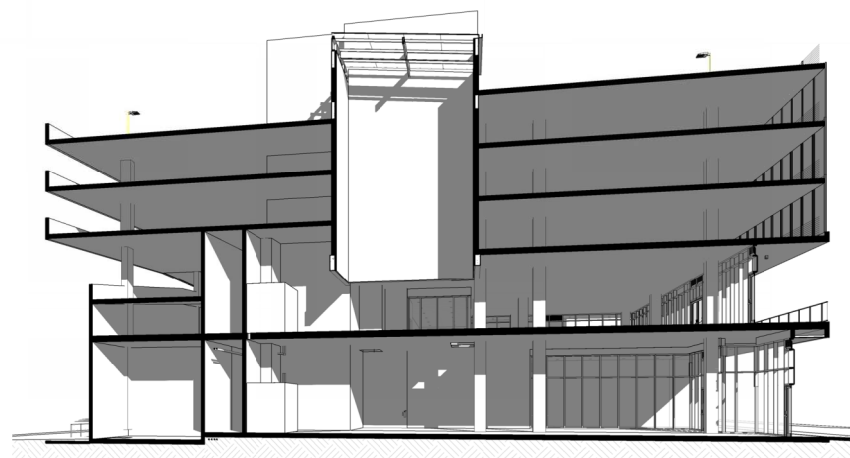

2 SECTION PERSPECTIVE

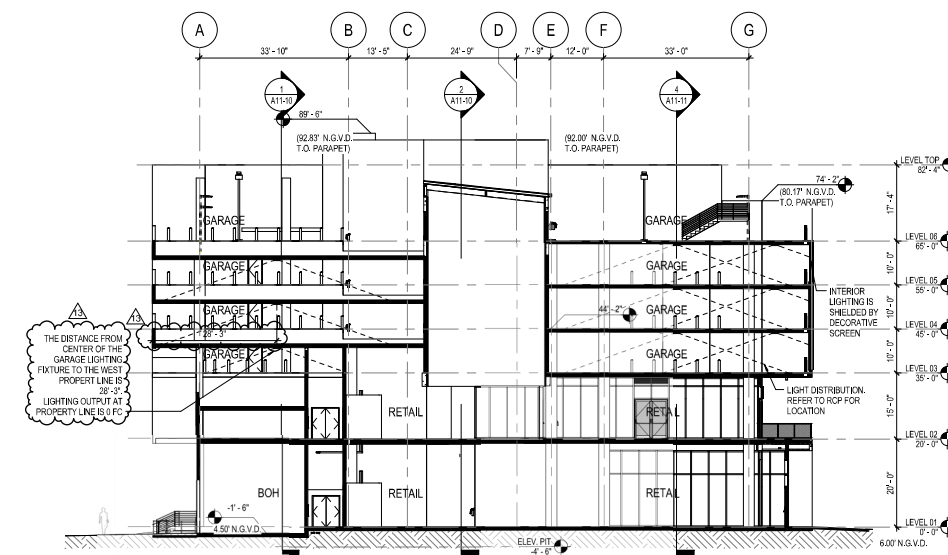

1 BUILDING SECTION  
1/16" = 1'-0"