

# BOUNDA

SCALE:

#### BISCAYNE BAY

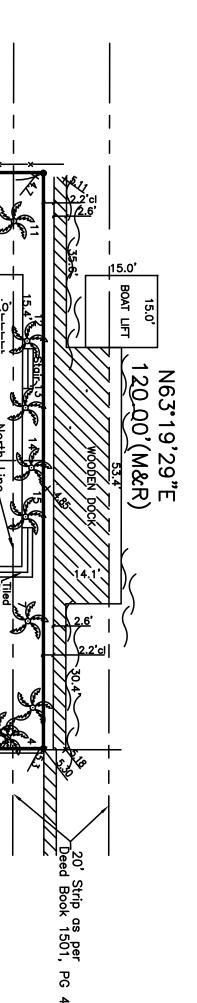

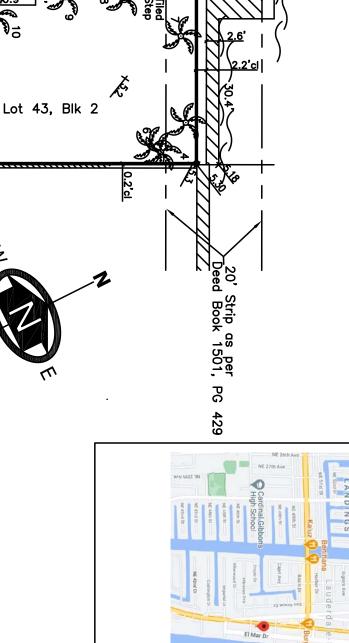

## LOCATION MAP

#### SITE **PICTURE**

ABREVIATION (IF ANY APPLIED)

A = CURVE

A/C = AR CONDITIONING UNIT

B.M. = BENCH MARK

BL/Com. = BLOCK CORNER

CLAC.(6) = CAUCHLATED

C.B.S. = CONCRETE BLOCK STRUCTURE

C.B.S. = CONCRETE BLOCK STRUCTURE

C.B.S. = CONCRETE

CONC. = CONCRETE

CONC. = CONCRETE

CONC. = CONCRETE

CONC. = CONCRETE

IC. = DRAN,
I.E. = DRAN,
DRAMETER
SMT. = ELEVATION
LEV. = ELEVATION
J.C. = BROROACHMENT
J.D/M = FOUND DRUL HOLE
F.M. = FRE HYDRANT
F.M.D = FOUND DRUL HOLE
F.M.D = FOUND DRU HOLE
F.M.D = FOUND NUL AND DISC
F.M.D = FOUND NON PRE
F.M.D = FOUND SPIKE
= UIGHT POLE
= UIGHT POLE
= LICASURED

P/W = PARKWAY
P.O.B. = POINT OF COMMENCE
P.C. = POINT OF MEPSECTION
P = PROPERTY LINE
P.T. = POINT OF TANGENCY
P.T. = POINT OF WAY
SEC. = RECORDED
RES. = RECORDED
RES. = RESIDENCE
R/W = RECORDED
SEC. = SECTION
SEC. = SECTION
SEC. = SECTION POINT
SEC. = SECTION POINT
SEC. = SECTION LINE
SECTION
SECTION LINE
SECTION
SECTION LINE
SECTION





	١
844	

BOUNDARY LINE
STRUCTURE (BLDG.)
CONCRETE BLOCK WALL
METAL FENCE

 $O\square$ 

CATCH BASIN
MANHOLE
OVERHEAD ELECT.

WOOD DECK/DOCK
ASPHALTED AREAS

HANDICAP SPACE

FIRE HYDRANT

WOODEN FENCE

LIGHT POLE POWER POLE

ROOFED AREAS
WATER (EDGE OF WATER)

RICKS OR PAVERS

EASEMENT LINE

WATER VALVE

TV-CABLE BOX

WM WATER METER

CONC. LIGHT POLE

SURVEYOR'S LEGEND (IF ANY APPLIED)

MONUMENT LINE

NOT TO SCALE

FOLIO NUMBER:	DATE OF SURVEY	JOB NUMBER:
FOLIO NUMBER: 02-3232-006-0540	DATE OF SURVEY: NOVEMBER 14,2020	20-1046
-THERE	-THE SU	ENCR

SITE ADDRESS:

121 N HIBISCUS DR , MIAMI BEACH, FL. 33139

ENCROACHMENTS AND OTHER POINTS OF INTEREST:
-THERE ARE NO VISIBLE ENCROACHMENT OF THE SUBJECT PROPERTY
-THE SUBJECT PROPERTY IS WITHIN A FLOOD ZONE AE (SEE NOTE 1)
-THERE NO PLATTED UTIL. EASEMENT ON THE SUBJECT PROPERTY

### JOB SPECIFIC SURVEYOR NOTES:

- THE PROPERTY DESCRIBED ON THIS SURVEY <u>DOES LIE</u> WITHIN A SPECIAL HAZARD AREA AS DEFINED BY THE FEDERAL EMERGENCY MANAGEMENT AGENCY; THE PROPERTY LIES

  WITHIN A FLOOD ZONE "AE" OF THE FLOOD INSURANCE RATE MAP IDENTIFIED AS COMMUNITY PANEL NO. 120651-316L, WITH AN EFFECTIVE DATE OF SEPTEMBER 11, 2009. BASE

  FLOOD ELEVATION OF 10.00 FEET (NGVD)
- ② LAND AREA OF SUBJECT PROPERTY: 21,000 SF (+/-) AS PER PUBLIC RECORDS/ 21,157 SF (+/-) (CALCULATED)

Lot 41, Blk 2 (PB 8-Pg 75)

N26'40'31"W 190.23'(C) To Strip of Land

12.50

21.20

170.00'(R)

31.00

ထ္ Lot

39.65

49.0'

**42.70**<sup>1</sup>

2 STY C.B.S. RESIDENCE No. 121 F.F.Elev. 8.00

S26°40'31"E 176.37'(M) N26°40'31"W 190.00'(C) To Strip of Land

Lot 44, Blk 2 (PB 8-Pg 75) 42,

Blk 2

N26'40'31"W 176.23'(M)

170.00'(R)

- (3) ELEVATIONS ARE BASED ON THE NATIONAL GEODETIC VERTICAL DATUM (NGVD) OF 1929, AS PER MIAMI DADE COUNTY BENCH MARK No. D-175, WITH AN ELEVATION OF 7.69 FEET.
- (4) BEARINGS SHOWN HEREON ARE BASED ON AN ASSUME MERIDIAN OF N.00°07'12"W., BEING THE RECORDED BEARING FOR THE CENTERLINE OF WEST PALM MIDWAY., AS SHOWN ON PLAT BOOK 8 AT PAGE 75 OF THE PUBLIC RECORD OF MIAMI DADE COUNTY FLORIDA.

- GENERAL SURVEYOR NOTES:

  NOT VALID WITHOUT THE SIGNATURE AND RAISED SEAL OF A FLORIDA LICENSED SURVEYOR AND MAPPER THE SHOWN LEGAL DESCRIPTION USED TO PERFORM THIS BOUNDARY SURVEY WAS PROVIDED BY THE CLIENT.
- UNLESS OTHERWISE NOTED, AN EXAMINATION OF THE ABSTRACT OF TITLE WAS NOT DONE BY THE SIGNING SURVEYOR TO DETERMINE WHICH INSTRUMENTS, IF ANY ARE AFFECTING THE SUBJECT PROPERTY.

SURVEY IS BASED ON RECORDED INFORMATION PROVIDED BY CLIENT. NO SPECIFIC SEARCH OF THE PUBLIC RECORD HAS BEEN MADE BY OUR OFFICE.

- THIS SURVEY IS EXCLUSIVELY FOR THE USE OF THE PARTIES TO WHOM IT WAS CERTIFIED.
- PURSUANT TO RULE 5J-17 OF THE FLORIDA ADMINISTRATIVE CODE THE EXPECTED USE OF LAND IS SUBURBAN, THE MINIMUM RELATIVE DISTANCE ACCURACY FOR THIS TYPE OF SURVEY IS 1 FOOT IN 7,500 FEET. THE ACCURACY OBTAINED BY MEASUREMENT AND CALCULATIONS OF CLOSED GEOMETRIC FIGURES WAS FOUND TO EXCEED THIS REQUIREMENT.
- THERE ARE NO VISIBLE, ABOVE GROUND ENCROACHMENTS (a) BY THE IMPROVEMENTS OF THE SUBJECT PROPERTY UPON ADJOINING PROPERTIES, STREETS OR ALLEYS, OR (b) BY THE IMPROVEMENTS OF THE ADJOINING PROPERTIES, STREETS OR ALLEYS UPON THE SUBJECT PROPERTY OTHER THAN THOSE SHOWN ON THIS BOUNDARY SURVEY.
- THERE ARE NO VISIBLE EASEMENTS OR RIGHT-OF-WAY OF WHICH THE UNDERSIGNED HAS BEEN ADVISED OTHER THAN THOSE SHOWN ON THIS SURVEY.
- THE ELEVATIONS (IF ANY) OF WELL-IDENTIFIED FEATURES AS DEPICTED ON THIS SURVEY AND MAP WERE MEASURED TO AN ESTIMATED VERTICAL POSITIONAL ACCURACY OF  $\frac{1}{2}$ 0 FOOT FOR NATURAL GROUND SURFACES AND  $\frac{1}{2}$ 00 FOOT FOR HARDSCAPE SURFACES, INCLUDING PAVEMENT, CURBS, SIDEWALKS AND OTHER MANMADE STRUCTURES.

THE MAP OF SURVEY IS INTENDED TO BE DISPLAYED AT THE SHOWN GRAPHIC SCALE IN ENGLISH UNITS OF MEASUREMENT. IN SOME CASES GRAPHIC REPRESENTATION HAVE BEEN EXAGERATED TO MORE CLEARLY ILLUSTRATE A PARTICULAR AREA WHERE DIMENSIONS SHALL HAVE PREFERENCE OVER GRAPHIC LOCATION.

- THE SURVEYOR MAKES NO REPRESENTATION AS TO OWNERSHIP, POSSESSION OR OCCUPATION OF THE SUBJECT PROPERTY BY ANY ENTITY OR INDIVIDUAL. ANY FEMA FLOOD ZONE INFORMATION PROVIDED ON THIS SURVEY IS FOR INFORMATIONAL PURPOSE ONLY AND IT WAS OBTAINED AT WWW.FEMA.COM.
- IF YOU ARE READING THIS BOUNDARY SURVEY IN AN ELECTRONIC FORMAT, THE INFORMATION CONTAINED ON THIS DOCUMENT IS ONLY VALID IF THIS DOCUMENT IS ELECTRONICALLY SIGNED AS SPECIFIED IN CHAPTER 5J-17.062 (3) OF THE FLORIDA ADMINISTRATIVE CODE. IF THIS DOCUMENT IS IN PAPER FORMAT, IT IS NOT VALID WITHOUT THE SIGNATURE AND ORIGINAL RAISED SEAL OF THE PROFESSIONAL LAND SURVEYOR AND MAPPER OF RECORD.

#### LOT 42 AND 43, BLOCK 2, HIBI

PUBLIC

TOTAL R/W

HIBISCUS DR

30.00'

F.P.L.

J'(M&R)

18.30'

Grassed

30.00'

TREE NAME ROYAL PALM

ROYSTONIA ELATA
ROYSTONIA ELATA

1.7 2.0 1.5 0.5

8, 20

50'

1.0

ر 18.50'

Brick Walk

Garage Elev. 6.44

23.90'

Garage Elev. 6.44

23.85

61.90'

26.3'

32.75

32.80

LOT 42 AND 43, BLOCK 2, HIBISCUS ISLAND, ACCORDING TO THE MAP OR PINT THEREOF AS RECORDED IN PLAT BOOK 8, PAGE 75, PUBLIC RECORDS OF MIAMI-DADE COUNTY, FLORIDA; ALSO ALL THAT PART OF 20 FT. STRIP OF LAND CONVEYED BY THE TRUSTEES OF THE INTERNAL IMPROVEMENT FUND TO THE BISCAYNE BAY ISLAND COMPANY BY DEED DATED SEPTEMBER 14, 1932, AND RECORDED IN DEED BOOK 1501, PAGE 479, OF THE PUBLIC RECORDS OF DADE COUNTY, FLORIDA, WHICH LIES NORTHEASTERLY AND CONTIGUOUS TO THE NORTHEASTERLY BOUNDARY LINES OF LOTS 42 AND 43 OF BLOCK 2, OF HIBISCUS ISLAND, ACCORDING TO THE PLAT THEREOF RECORDED IN PLOT BOOK 8, PAGE 75, OF THE PUBLIC RECORDS OF DADE COUNTY, FLORIDA, AND BETWEEN THE NORTHWESTERLY LINE OF LOT 42 OF BLOCK 2 OF THE AFORESAID SUBDIVISION EXTENDED NORTHEASTERLY INTO BISCAYNE BAY AND THE SOUTHEASTERLY LINE OF LOT 43, BLOCK 2, OF THE AFORESAID SUBDIVISION EXTENDED NORTHEASTERLY WITH RIPARIAN AND/OR LITTORAL RIGHTS.

WE HEREBY CERTIFY THAT THIS BOUNDARY AND TOPOGRAPHICAL SURVEY AND THE SURVEY MAP RESULTING THEREFROM WAS PERFORMED UNDER MY SUPERVISION AND/OR DIRECTION AND IS TRUE AND CORRECT TO THE BEST OF MY KNOWLEDGE AND BELIEF AND FURTHER, THAT SAID "BOUNDARY AND TOPOGRAPHICAL SURVEY" MEETS THE INTENT OF THE APPLICABLE PROVISIONS OF THE "STANDARDS OF PRACTICE FOR LAND SURVEYING IN THE STATE OF FLORIDA", PURSUANT TO RULE 5J-17 OF THE FLORIDA ADMINSTRATIVE CODE AND ITS IMPLEMENTING LAW, CHAPTER 472.027 FO THE FLORIDA STATUTES.



American Consulting Engineers Planners Surveyors

3195 PONCE DE LEON BLVD, SUITE 200 CORAL GABLES, FL 33134 PHONE: (305)598-5101 FAX: (305)598-8627 ASOMIAMI.COM



Services of SIGNATURE AND RAISED Miami, SEAL OF A FLORIDA