
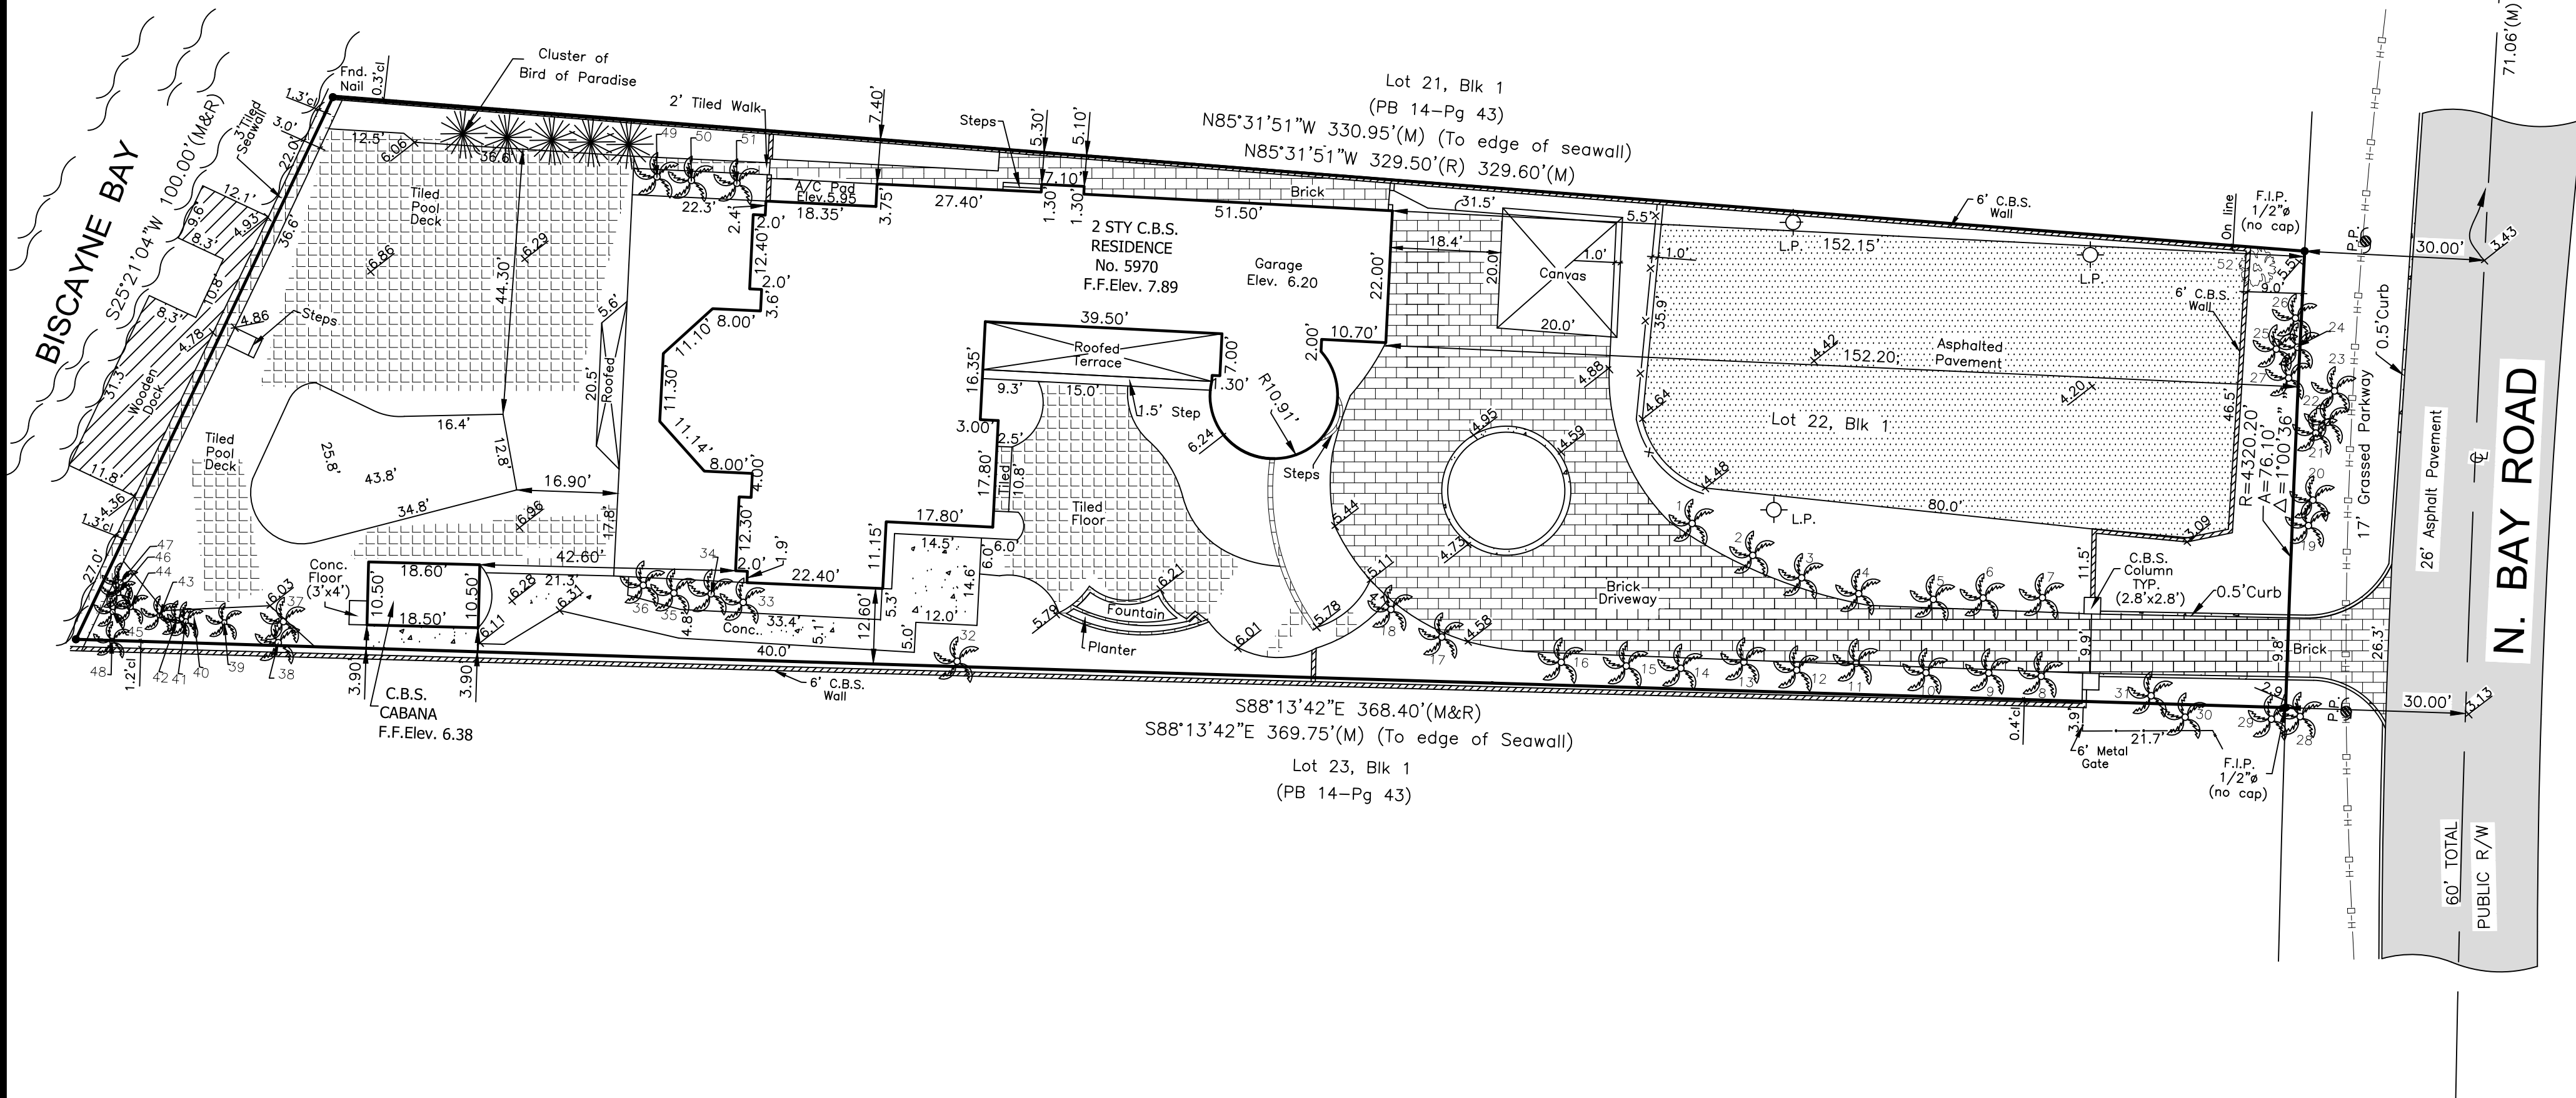


SKETCH OF BOUNDARY SURVEY

SCALE: 1" = 20'

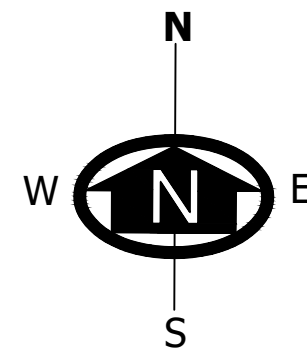

CERTIFIED TO :
TODD GLASER

SITE ADDRESS: 5970 N BAY ROAD, MIAMI BEACH, FL. 33140
JOB NUMBER: 21-401
DATE OF SURVEY: APRIL 6, 2021
FOLIO NUMBER: 02-3215-003-0200

JOB SPECIFIC SURVEYOR NOTES:

- THE PROPERTY DESCRIBED ON THIS SURVEY DOES LIE WITHIN A SPECIAL HAZARD AREA AS DEFINED BY THE FEDERAL EMERGENCY MANAGEMENT AGENCY; THE PROPERTY LIES WITHIN A FLOOD ZONE "AE" OF THE FLOOD INSURANCE RATE MAP IDENTIFIED AS COMMUNITY PANEL No. 120651-0309L, WITH AN EFFECTIVE DATE OF SEPTEMBER 11, 2009. **BASE FLOOD ELEVATION OF 8.00 FEET** (NGVD)
- LAND AREA OF SUBJECT PROPERTY: **30,800 SF (+/-)**(As per property appraiser)
29,413 SF (+/-)(Calculated to edge of seawall)
- ELEVATIONS ARE BASED ON THE NATIONAL GEODETIC VERTICAL DATUM (NGVD) OF 1929, AS PER MIAMI DADE COUNTY **BENCH MARK No. A-33**, WITH AN ELEVATION OF **8.23 FEET**.
- BEARINGS SHOWN HEREON ARE BASED ON AN ASSUME MERIDIAN OF N.20°10'05"W., BEING THE RECORDED BEARING FOR THE CENTERLINE OF W. 59TH ST, AS SHOWN ON PLAT BOOK 14 AT PAGE 43 OF THE PUBLIC RECORD OF MIAMI-DADE COUNTY FLORIDA.

TREE LIST

No.	TREE NAME	BOTANICAL NAME	D.B.H.	HEIGHT	SPREAD
1-7	ROYAL PALM	ROYSTONIA ELATA	1.5'	60'	50'
8-18	ROYAL PALM	ROYSTONIA ELATA	2.0'	60'	50'
19-23	COCONUT	COCOS NUCIFERA	1.0'	35'	25'
24-25	MACARTHUR PALM	PTYCHOSPERMA MACARTHUR	0.4'	18'	6'
26	MACARTHUR PALM	PTYCHOSPERMA MACARTHUR	0.4'	18'	6'
27	MACARTHUR PALM	PTYCHOSPERMA MACARTHUR	0.4'	18'	6'
28	MACARTHUR PALM	PTYCHOSPERMA MACARTHUR	0.4'	18'	8'
29	ALEXANDER PALM	PTYCHOSPERMA ELEGANS	0.3'	12'	5'
30	ROYAL PALM	ROYSTONIA ELATA	1.5'	60'	50'
31	ROYAL PALM	ROYSTONIA ELATA	2.0'	60'	60'
32	FISHTAIL PALM	CARYOTA	0.4'	25'	8'
33-36	MACARTHUR PALM	PTYCHOSPERMA MACARTHUR	0.3'	12'	6'
37	COCONUT	COCOS NUCIFERA	1.3'	50'	50'
38	COCONUT	COCOS NUCIFERA	1.0'	15'	20'
39	COCONUT	COCOS NUCIFERA	1.0'	30'	25'
40-48	COCONUT	COCOS NUCIFERA	1.0'	30'	25'
49	MACARTHUR PALM	PTYCHOSPERMA MACARTHUR	0.5'	20'	8'
50	MACARTHUR PALM	PTYCHOSPERMA MACARTHUR	0.4'	18'	6'
51	MACARTHUR PALM	PTYCHOSPERMA MACARTHUR	0.4'	18'	6'
52	WEeping FIG	FICUS BENJAMINA	6.0'	50'	50'

SITE PICTURE




ABBREVIATION (IF ANY APPLIED)

A = CURVE
A/C = AIR CONDITIONING UNIT
ASPH. = ASPHALT
B.M. = BENCH MARK
BK/COM = BLOCK CORNER
CALC(C) = CALCULATED
CB = CATCH BASIN
C.B.S. = CONCRETE BLOCK STRUCTURE
CL = CLEAR
CONC. = CONCRETE
D.M.E. = DRAINAGE MAINT. EASEMENT
EASEMT. = EASEMENT
ELEV. = ELEVATION
ENC. = ENCROACHMENT
F.D./H. = FOUND DRILL HOLE
F.H. = FIRE HYDRANT
F.N/D. = FOUND NAIL AND DISC
F.I.P. = FOUND IRON PIPE
F.S. = FOUND SPIKE
L.P. = LIGHT POLE
MEAS(M) = MEASURED
MH = MANHOLE
M = MONUMENT
N = NOT TO SCALE
P/W = PARKWAY
P.O.B. = POINT OF BEGINNING
P.O.C. = POINT OF COMMENCEMENT
P.C. = POINT OF CURVATURE
P.I. = POINT OF INTERSECTION
P.L. = PROPERTY LINE
P.P. = POWER POLE
P.R.M. = PERMANENT REFERENCE MONUMENT
P.T. = POINT OF TANGENCY
RAD. = RADIAL
REC. (R) = RECORDED
RES. = RESIDENCE
R/W = RIGHT OF WAY
SEC. = SECTION
S.D/H. = SET DRILL HOLE
S.D/M. = SET NAIL AND DISC
S.I.P. = SET IRON PIPE
S.R.B. = SET REBAR
STY. = STORY
SW. = SIDEWALK
T.O.P. = TOP OF BANK
U.E. = UTIL. EASEMENT
W.P. = WOODEN POLE
E = SECTION LINE

SURVEYOR'S LEGEND (IF ANY APPLIED)

BOUNDARY LINE
STRUCTURE (BLDG.)
CONCRETE BLOCK WALL
METAL FENCE
WOODEN FENCE
CHAIN LINK FENCE
WOOD DECK/DOCK
ASPHALTED AREAS
CONCRETE
BRICKS OR PAVERS
ROOFED AREAS
WATER (EDGE OF WATER)
CATCH BASIN
MANHOLE
OVERHEAD ELECT.
POWER POLE
LIGHT POLE
HANDICAP SPACE
FIRE HYDRANT
EASEMENT LINE
WATER VALVE
TV-CABLE BOX
WM WATER METER
CONC. LIGHT POLE

LOCATION MAP

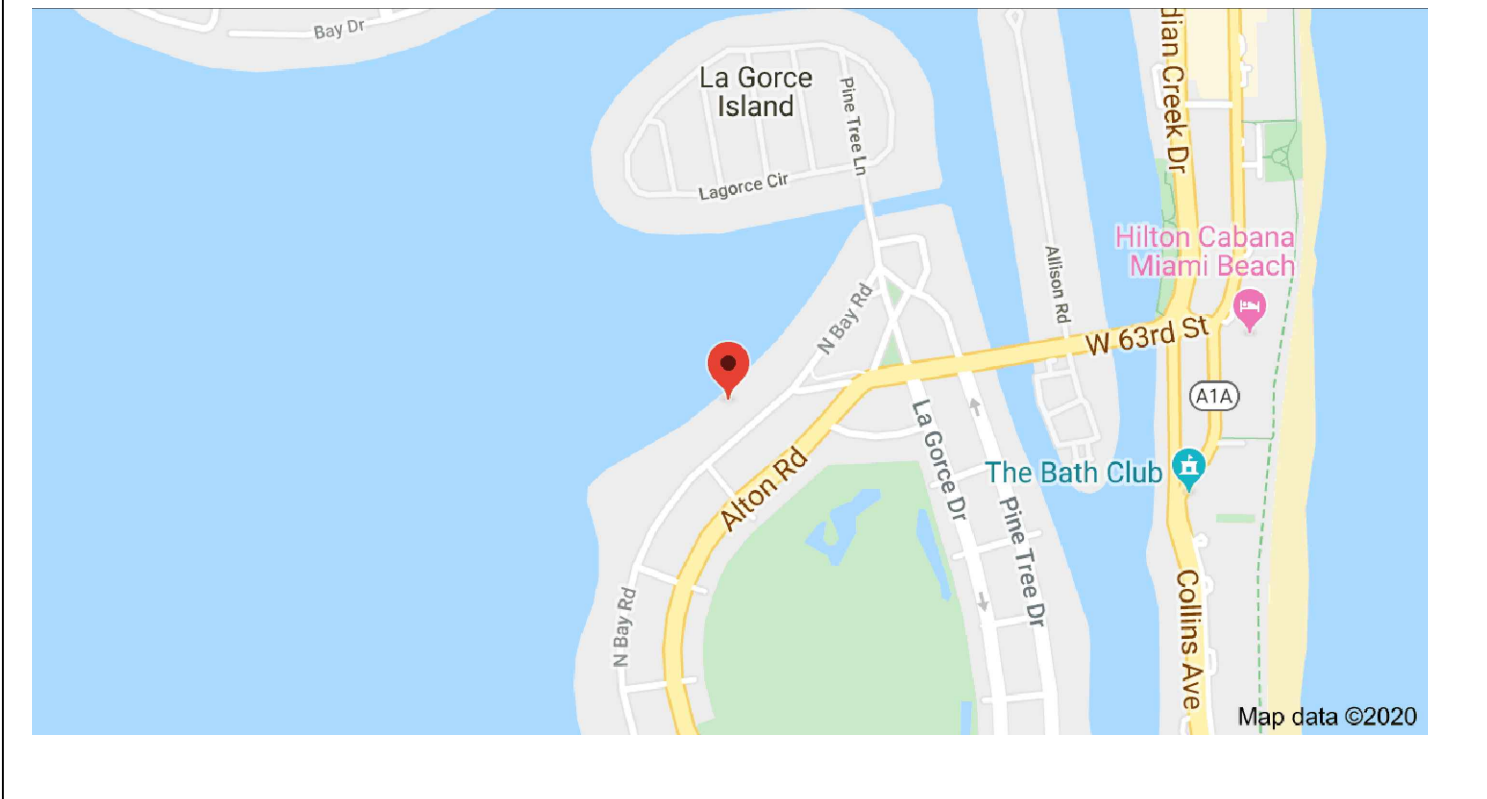

GENERAL SURVEYOR NOTES:

THE SHOWN LEGAL DESCRIPTION USED TO PERFORM THIS BOUNDARY SURVEY WAS PROVIDED BY THE CLIENT.

SURVEY IS BASED ON RECORDED INFORMATION PROVIDED BY CLIENT. NO SPECIFIC SEARCH OF THE PUBLIC RECORD HAS BEEN MADE BY OUR OFFICE.

UNLESS OTHERWISE NOTED, AN EXAMINATION OF THE ABSTRACT OF TITLE WAS NOT DONE BY THE SIGNING SURVEYOR TO DETERMINE WHICH INSTRUMENTS, IF ANY ARE AFFECTING THE SUBJECT PROPERTY.

THIS SURVEY IS EXCLUSIVELY FOR THE USE OF THE PARTIES TO WHOM IT WAS CERTIFIED.

PURSUANT TO RULE 53-17 OF THE FLORIDA ADMINISTRATIVE CODE THE EXPECTED USE OF LAND IS SUBURBAN, THE MINIMUM RELATIVE DISTANCE ACCURACY FOR THIS TYPE OF SURVEY IS 1 FOOT IN 7,500 FEET. THE ACCURACY OBTAINED BY MEASUREMENT AND CALCULATIONS OF CLOSED GEOMETRIC FIGURES WAS FOUND TO EXCEED THIS REQUIREMENT.

THERE ARE NO VISIBLE, ABOVE GROUND ENCROACHMENTS (a) BY THE IMPROVEMENTS OF THE SUBJECT PROPERTY UPON ADJOINING PROPERTIES, STREETS OR ALLEYS, OR (b) BY THE IMPROVEMENTS OF THE ADJOINING PROPERTIES, STREETS OR ALLEYS UPON THE SUBJECT PROPERTY OTHER THAN THOSE SHOWN ON THIS BOUNDARY SURVEY.

THERE ARE NO VISIBLE EASEMENTS OR RIGHT-OF-WAY OF WHICH THE UNDERSIGNED HAS BEEN ADVISED OTHER THAN THOSE SHOWN ON THIS SURVEY.

THE MAP OF SURVEY IS INTENDED TO BE DISPLAYED AT THE SHOWN GRAPHIC SCALE IN ENGLISH UNITS OF MEASUREMENT. IN SOME CASES GRAPHIC REPRESENTATION HAVE BEEN EXAGGERATED TO MORE CLEARLY ILLUSTRATE A PARTICULAR AREA WHERE DIMENSIONS SHALL HAVE PREFERENCE OVER GRAPHIC LOCATION.

THE ELEVATIONS (IF ANY) OF WELL-IDENTIFIED FEATURES AS DEPICTED ON THIS SURVEY AND MAP WERE MEASURED TO AN ESTIMATED VERTICAL POSITIONAL ACCURACY OF 1/10 FOOT FOR NATURAL GROUND SURFACES AND 1/16 FOOT FOR HARDSCAPE SURFACES, INCLUDING PAVEMENT, CURBS, SIDEWALKS AND OTHER MANMADE STRUCTURES.

THE SURVEYOR MAKES NO REPRESENTATION AS TO OWNERSHIP, POSSESSION OR OCCUPATION OF THE SUBJECT PROPERTY BY ANY ENTITY OR INDIVIDUAL.

ANY FEMA FLOOD ZONE INFORMATION PROVIDED ON THIS SURVEY IS FOR INFORMATIONAL PURPOSE ONLY AND IT WAS OBTAINED AT WWW.FEMA.COM.

IF YOU ARE READING THIS BOUNDARY SURVEY IN AN ELECTRONIC FORMAT, THE INFORMATION CONTAINED ON THIS DOCUMENT IS ONLY VALID IF THIS DOCUMENT IS ELECTRONICALLY SIGNED AS SPECIFIED IN CHAPTER 53-17.062 (3) OF THE FLORIDA ADMINISTRATIVE CODE. IF THIS DOCUMENT IS IN PAPER FORMAT, IT IS NOT VALID WITHOUT THE SIGNATURE AND ORIGINAL RAISED SEAL OF THE PROFESSIONAL LAND SURVEYOR AND MAPPER OF RECORD.

LEGAL DESCRIPTION:

LOT 15, BLOCK 1, OF LA GORCE GOLF SUBDIVISION, ACCORDING TO THE PLAT THEREOF AS RECORDED IN PLAT BOOK 14 AT PAGE 43, OF THE PUBLIC RECORDS OF MIAMI-DADE COUNTY, FLORIDA.

ENCROACHMENTS AND OTHER POINTS OF INTEREST:


-THERE ARE NO VISIBLE ENCROACHMENT OF THE SUBJECT PROPERTY
-THE SUBJECT PROPERTY IS WITHIN A FLOOD ZONE AE (SEE NOTE 1)
-THERE NO PLATTED UTIL. EASEMENT ON THE SUBJECT PROPERTY

THIS DRAWING IS THE PROPERTY OF AMERICAN SERVICES OF MIAMI, CORP. AND SHALL NOT BE USED OR REPRODUCED, IN WHOLE, OR IN PART, WITHOUT PERMISSION OF AMERICAN SERVICES OF MIAMI, CORP.

NOTHING HEREON SHALL BE CONSTRUED TO GIVE ANY RIGHTS OR BENEFITS TO ANYONE OTHER THAN THOSE CERTIFIED.

WE HEREBY CERTIFY THAT THIS BOUNDARY AND TOPOGRAPHICAL SURVEY AND THE SURVEY MAP RESULTING THEREFROM WAS PERFORMED UNDER MY SUPERVISION AND/OR DIRECTION AND IS TRUE AND CORRECT TO THE BEST OF MY KNOWLEDGE AND BELIEF AND FURTHER, THAT SAID "BOUNDARY AND TOPOGRAPHICAL SURVEY" MEETS THE INTENT OF THE APPLICABLE PROVISIONS OF THE "STANDARDS OF PRACTICE FOR LAND SURVEYING IN THE STATE OF FLORIDA", PURSUANT TO RULE 53-17 OF THE FLORIDA ADMINISTRATIVE CODE AND ITS IMPLEMENTING LAW, CHAPTER 472.027 FOR THE FLORIDA STATUTES.

American Services of Miami, Corp.

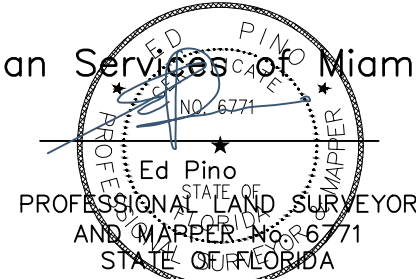

DATE: APRIL 23, 2021

AMERICAN SERVICES OF MIAMI, CORP.
Consulting Engineers . Planners . Surveyors

3195 PONCE DE LEON BLVD, SUITE 200
CORAL GABLES, FL 33134
PHONE: (305) 598-8627
ASOMIAMI.COM

FOR: TODD GLASER

SCALE: 1"=20'
DATE: 4/23/21

CHECKED BY: E.P.
PAGE No. 1

DRAWN BY: D.G.
FIELD BOOK No.

ORDER No.
21-401

SHEET No.
1