



LOCATION MAP
NOT TO SCALE

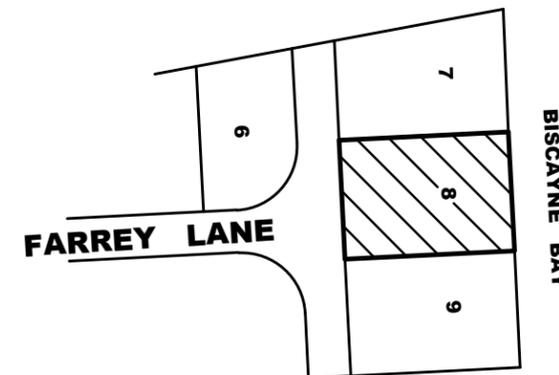

LOT AREA
4,590 sq. ft.
0.11 acres

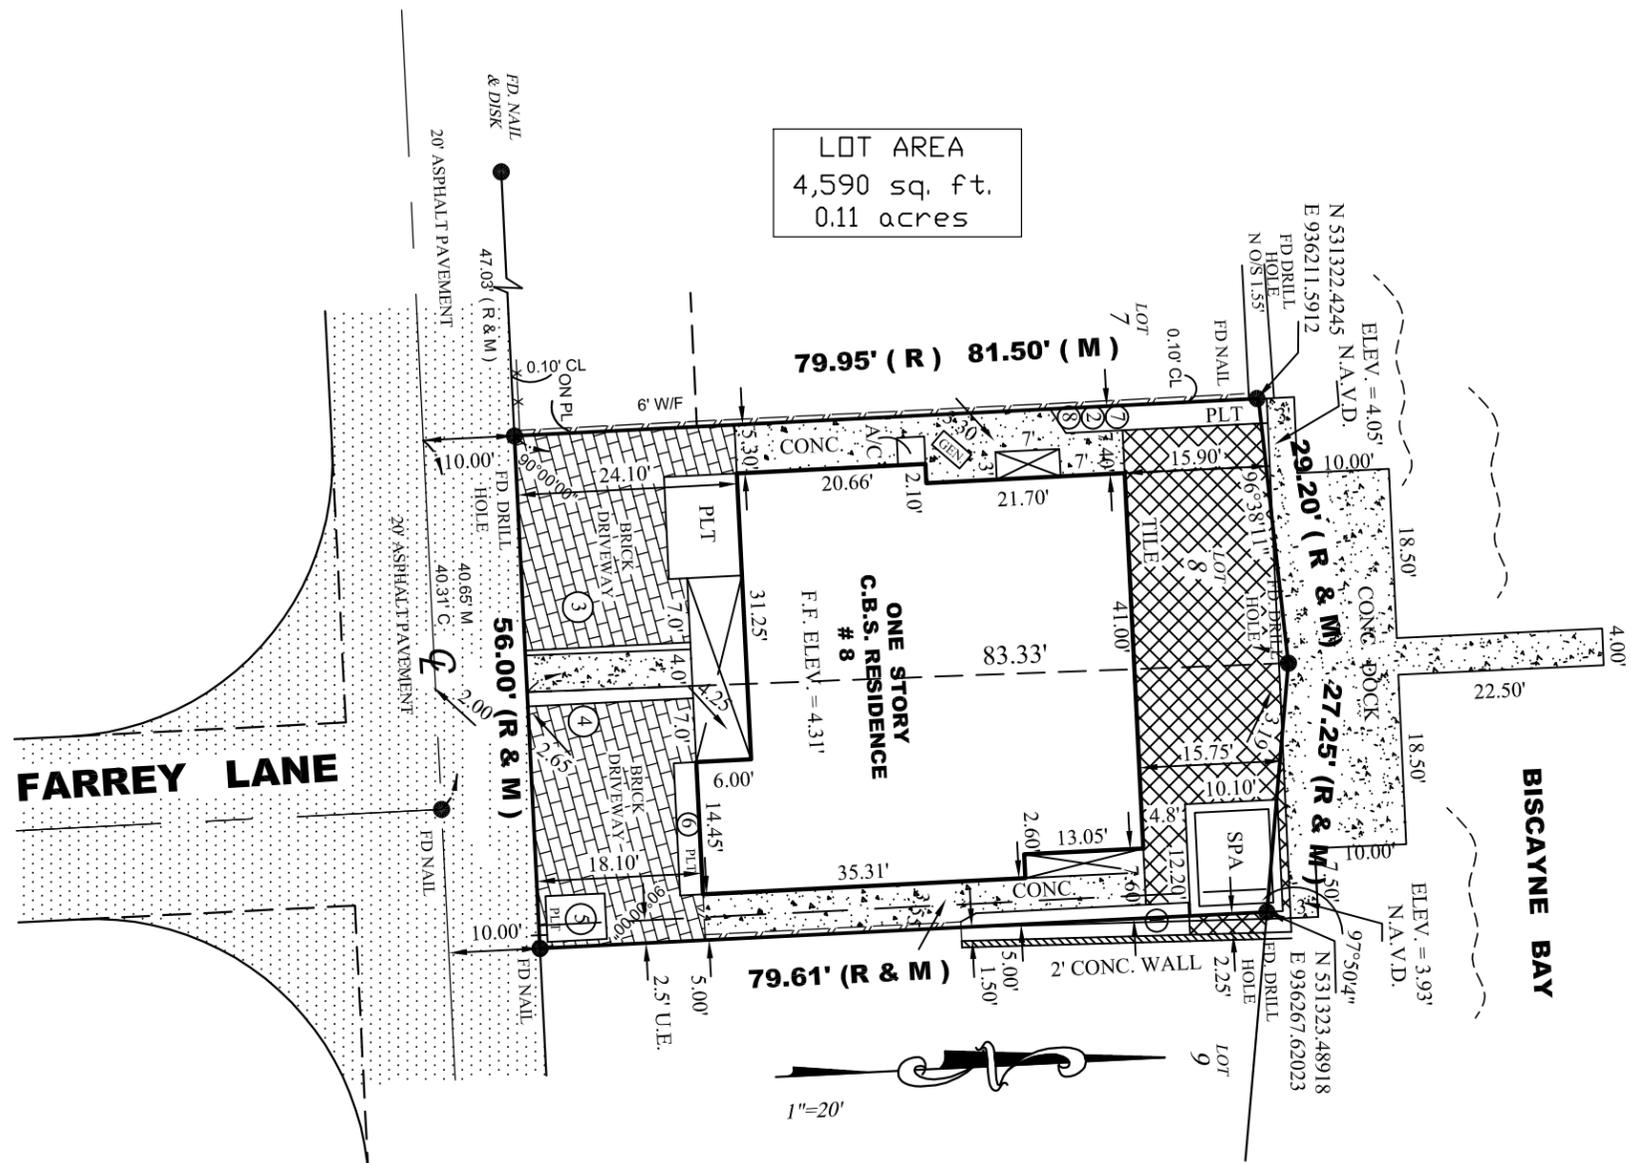

No.	NAME	DIAMETER	SPAN	HEIGHT
1	COCONUT PALM	0.8'	7'	27'
2	COCONUT PALM	0.8'	7'	27'
3	COCONUT PALM	0.8'	7'	27'
4	COCONUT PALM	0.8'	7'	27'
5	BLACK OLIVE TREE	3'	50'	35'
6	BIRD OF PARADISE	0.9'	10'	12'
7	CHRISTMAS PALM	0.45'	10'	17'
8	CHRISTMAS PALM	0.45'	10'	17'

PROPERTY ADDRESS: 8 FARREY LANE, MIAMI BEACH, FL. 33139

LEGAL DESCRIPTION: LOT 8, OF SECOND SECTION BELLE ISLE VILLAS, ACCORDING TO THE PLAT THEREOF, AS RECORDED IN PLAT BOOK 42, PAGE 100, OF THE PUBLIC RECORDS OF MIAMI-DADE COUNTY, FLORIDA.

SURVEYOR'S NOTES:

- 1) OWNERSHIP SUBJECT TO OPINION OF TITLE.
- 2) NOT VALID WITHOUT THE SIGNATURE AND RAISED SEAL OF A FLORIDA LICENSED SURVEYOR AND MAPPER.
- 3) THE SURVEY DEPICTED HERE IS NOT COVERED BY PROFESSIONAL LIABILITY INSURANCE.
- 4) LEGAL DESCRIPTION PROVIDED BY CLIENT.
- 5) UNDERGROUND ENCROACHMENTS NOT LOCATED.
- 6) ELEVATIONS ARE BASED ON NORTH AMERICAN VERTICAL DATUM OF 1988
- 7) OWNERSHIP OF FENCES ARE UNKNOWN.
- 8) THERE MAY BE ADDITIONAL RESTRICTIONS NOT SHOWN ON THIS SURVEY THAT MAY BE FOUND IN THE PUBLIC RECORDS OF THIS COUNTY.
- 9) CONTACT THE APPROPRIATE AUTHORITY PRIOR TO ANY DESIGN WORK FOR BUILDING AND ZONING INFORMATION.
- 10) EXAMINATION OF THE ABSTRACT OF TITLE WILL HAVE TO BE MADE TO DETERMINE RECORDED INSTRUMENTS, IF ANY, AFFECTING THIS PROPERTY.
- 11) ELEVATIONS BASED OFF OF BM# D-169 LOC# 3245 SE ELEV. 7.86' NGVD

ADDITIONS OR DELETIONS TO SURVEY MAPS OR REPORTS BY OTHER THAN THE SIGNING PARTY OR PARTIES IS PROHIBITED WITHOUT WRITTEN CONSENT OF THE SIGNING PARTY OR PARTIES
BEARINGS WHEN SHOWN ARE REFERRED TO AN ASSUMED VALUE OF SAID PB: 42 PG: 100

NOTE: GPS COORDINATES OBTAINED USING A GARMIN DEVICE.

AS-BUILT SURVEY

LEGEND & ABBREVIATIONS:

<p>CONC. BLOCK WALL WOOD DECK COVERED AREA ASPHALT CHAIN LINK FENCE (CLF) WOOD FENCE (WF) IRON FENCE (IF) ARC DISTANCE CENTRAL ANGLE / DELTA RADIUS TANGENT POINT OF TANGENCY POINT OF CURVATURE POINT OF COMPOUND CURVE CATCH BASIN CABLE UTILITY BOX</p>	<p>B.C. = BLOCK CORNER P = PROPERTY LINE C = CENTER LINE M = MONUMENT LINE CALC. = CALCULATED M. = FIELD MEASURED P. = PER PLAT TYP. = TYPICAL P.R.M. = PERMANENT REFERENCE MONUMENT P.C.P. = PERMANENT CONTROL POINT FD. NAIL = FOUND NAIL FD. D/H = FOUND DRILL HOLE FD. 1/2" I.P. = FOUND IRON PIPE 1/2" DIAMETER C.M. = CONCRETE MONUMENT W.M. = WATER METER R/W = RIGHT OF WAY</p>	<p>U.E. = UTILITY EASEMENT A.E. = ANCHOR EASEMENT D.E. = DRAINAGE EASEMENT ENCR. = ENCROACHMENT F.F. ELEV. = FINISHED FLOOR ELEVATION N.T.S. = NOT TO SCALE P.B. = PLAT BOOK O.R.B. = OFFICIAL RECORD BOOK M.H. = MAN HOLE C.B.S. = CONCRETE BLOCK STRUCTURE BLDG = BUILDING O.H.L. = OVERHEAD UTILITY LINES TEL. = TELEPHONE FACILITIES</p>	<p>P.R.C. = POINT OF REVERSE CURVE CH = CHORD CH. BRG. = CHORD BEARING B.M. = BENCH MARK B.R. = BEARING REFERENCE P.O.C. = POINT OF COMMENCEMENT P.O.B. = POINT OF BEGINNING T.B.M. = TEMPORARY BENCH MARK P.O.B. = POINT OF BEGINNING T.B.M. = TEMPORARY BENCH MARK FD. I.R. = FOUND IRON REBAR FD. P.K.NAIL = FOUND PARKER-KALON NAIL P.S.M. = PROFESSIONAL SURVEYOR AND MAPPER A/C = AIR CONDITIONER PAD TX = TRANSFORMER P.P. = POWER POLE D.M.E. = DRAINAGE & MAINTENANCE EASEMENT + 0.0' = EXISTING ELEVATION</p>	<p>ELEV. = ELEVATION SEC. = SECTION TWS. = TOWNSHIP RG. = RANGE SWK = SIDEWALK</p>
--	---	--	---	--

I HEREBY CERTIFY THAT THE SURVEY REPRESENTED THEREON MEETS THE MINIMUM TECHNICAL REQUIREMENTS ADOPTED BY THE STATE OF FLORIDA BOARD OF LAND SURVEYORS PURSUANT TO SECTION 472.027 FLORIDA STATUTES. THERE ARE NO ENCROACHMENTS, OVERLAPS, EASEMENTS APPEARING ON THE PLAT OR VISIBLE EASEMENTS OTHER THAN AS SHOWN HEREON.

ADIS N. NUNEZ
REGISTERED LAND SURVEYOR
STATE OF FLORIDA #5924

SINCE 1987

BLANCO SURVEYORS INC.

Engineers • Land Surveyors • Planners • LB # 0007059
555 NORTH SHORE DRIVE
MIAMI BEACH, FL 33141
Email: blancosurveyorsinc@yahoo.com Fax: (305) 865-7810

FLOOD ZONE: AE		SUFFIX: L FEMA DATE: 09/11/09 BASE: 9'	
PANEL: 0317		COMMUNITY #	
DATE: 7/8/21	SCALE: 1" = 20'	120651 DWN. BY: R.BELLO	JOB No. 21-436

