



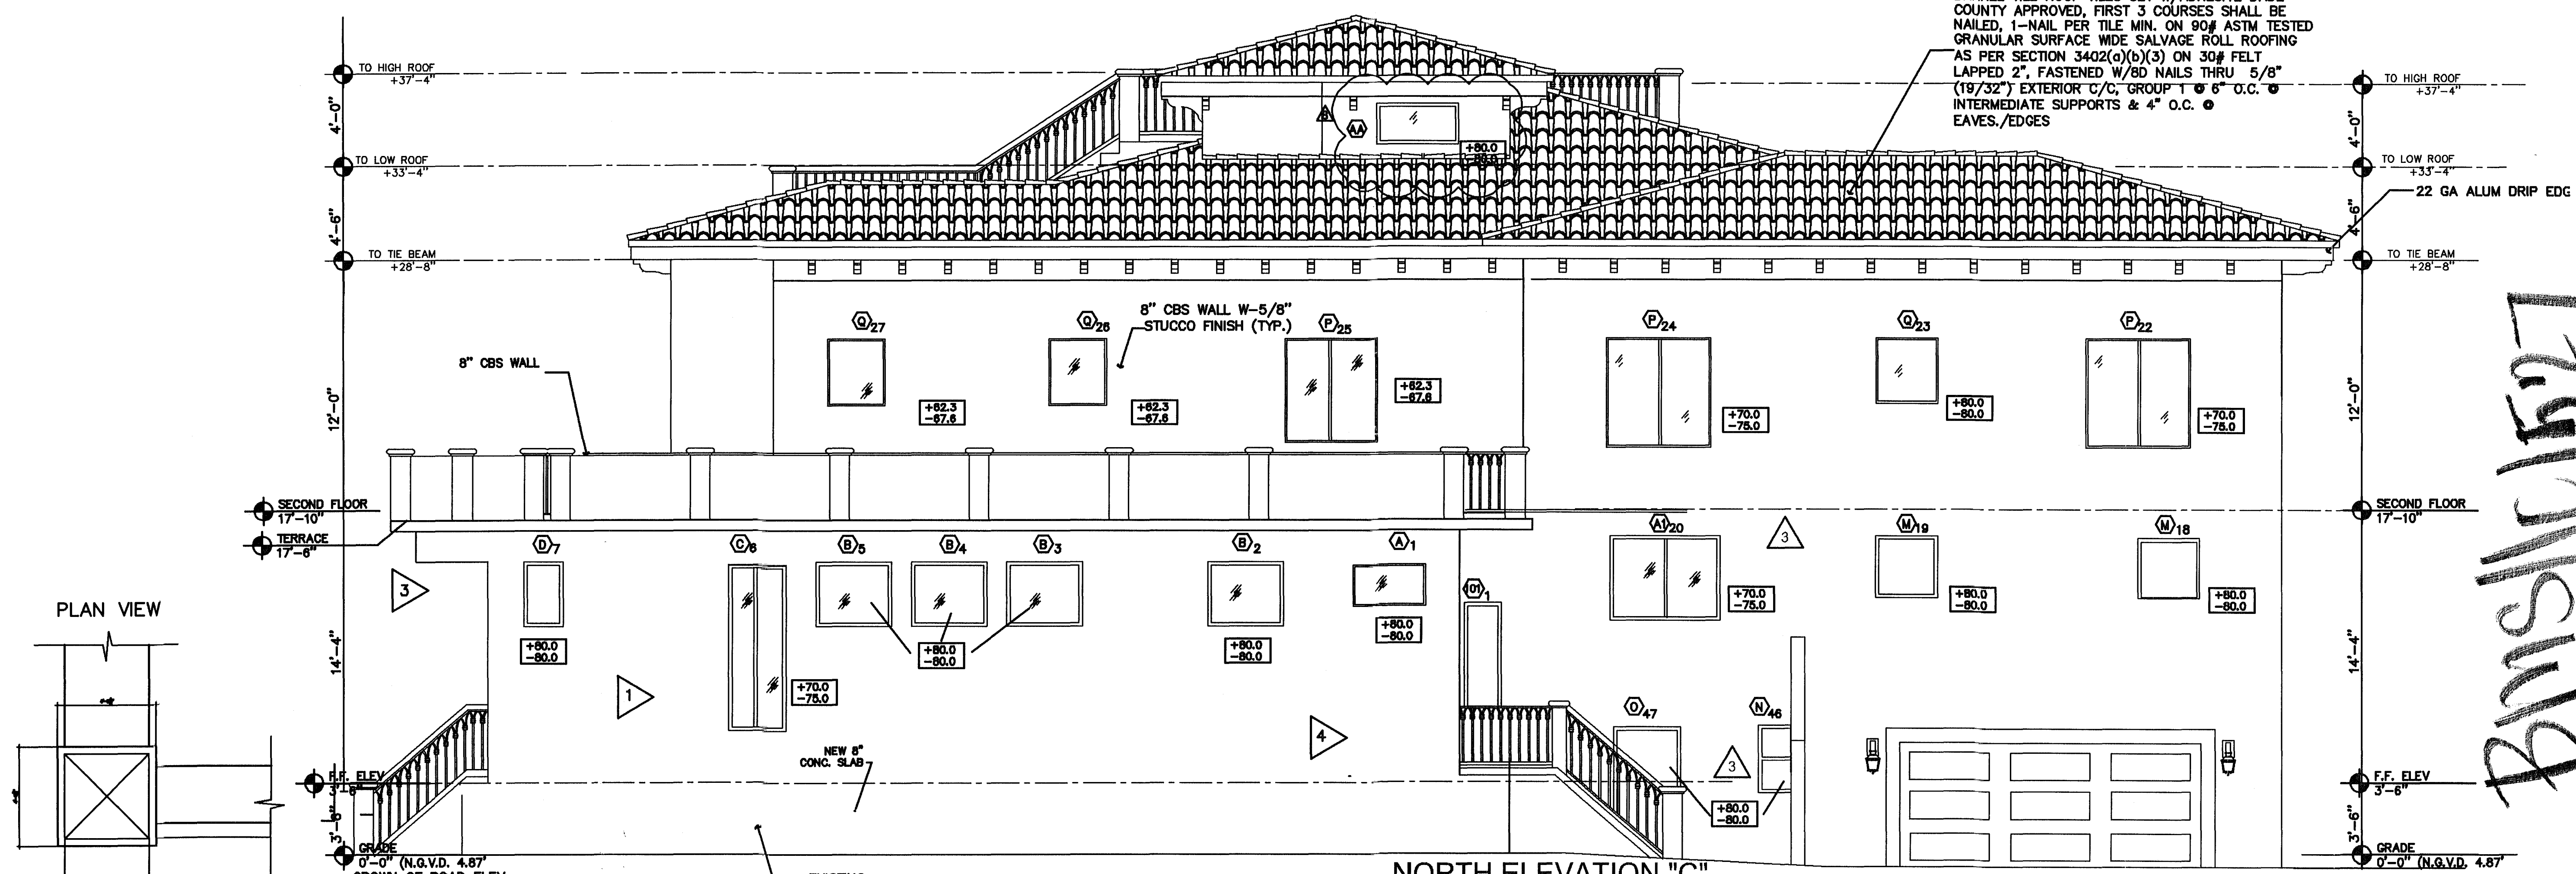

NORTH ELEVATION "C"
SCALE 1/4"=1'-0"

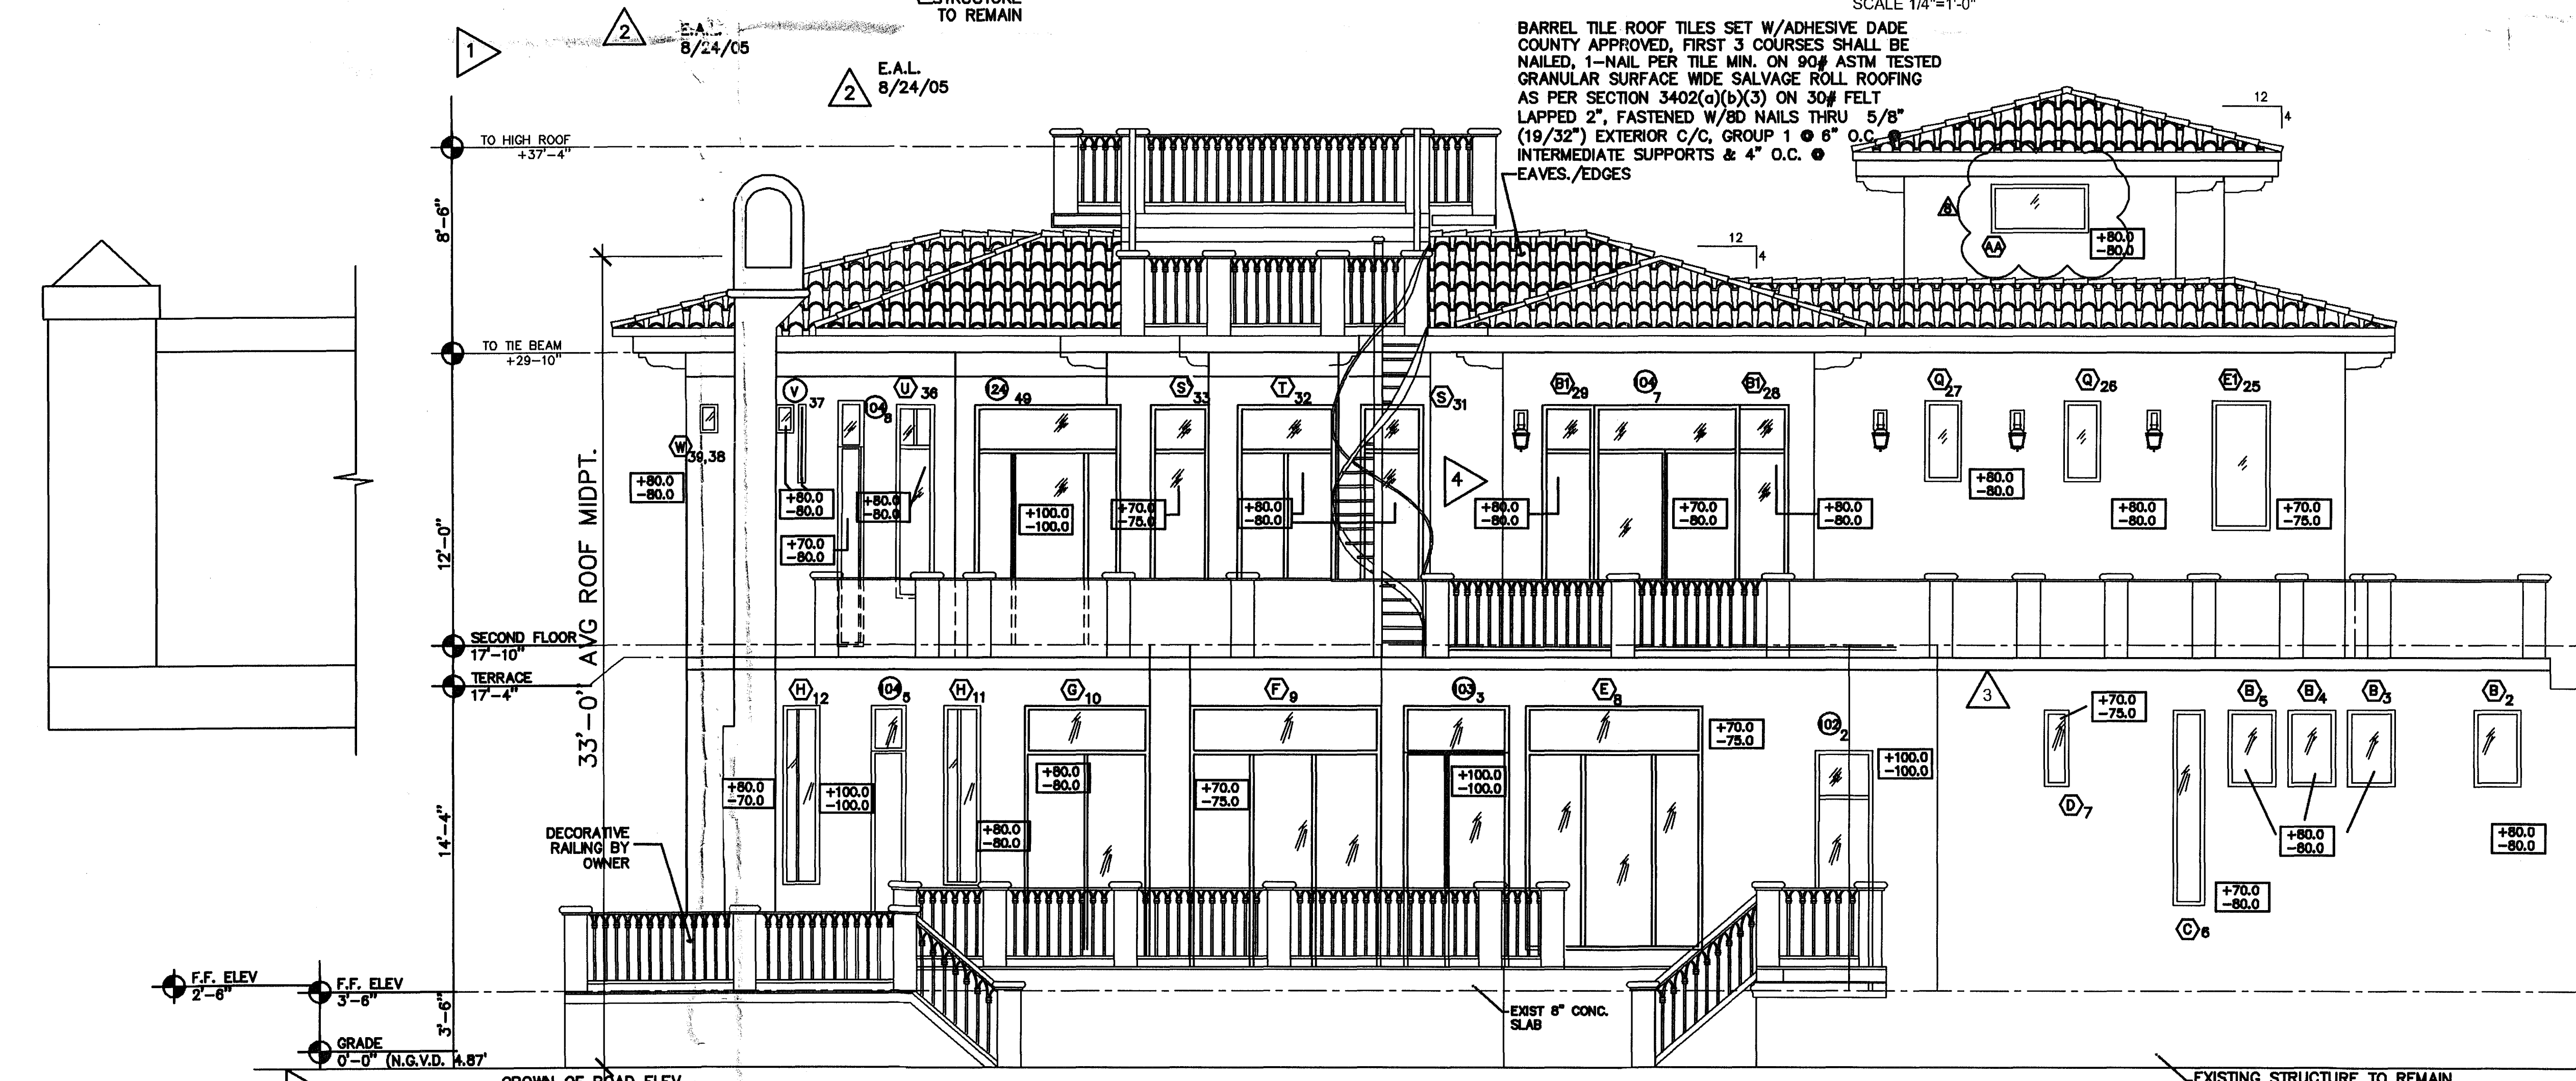

EAST ELEVATION "D"
SCALE 1/4"=1'-0"

BARREL TILE ROOF TILES SET W/ADHESIVE DADE COUNTY APPROVED, FIRST 3 COURSES SHALL BE NAILED, 1-NAIL PER TILE MIN. ON 90# ASTM TESTED GRANULAR SURFACE WIDE SALVAGE ROLL ROOFING AS PER SECTION 3402(a)(b)(3) ON 30# FELT LAPPED 2", FASTENED W/8D NAILS THRU 5/8" (19/32") EXTERIOR C/C, GROUP 1 @ 6" O.C. @ INTERMEDIATE SUPPORTS & 4" O.C. @ EAVES/EDGES

BARREL TILE ROOF TILES SET W/ADHESIVE DADE COUNTY APPROVED, FIRST 3 COURSES SHALL BE NAILED, 1-NAIL PER TILE MIN. ON 90# ASTM TESTED GRANULAR SURFACE WIDE SALVAGE ROLL ROOFING AS PER SECTION 3402(a)(b)(3) ON 30# FELT LAPPED 2", FASTENED W/8D NAILS THRU 5/8" (19/32") EXTERIOR C/C, GROUP 1 @ 6" O.C. @ INTERMEDIATE SUPPORTS & 4" O.C. @ EAVES/EDGES

PUBLIC WORKS PLAN REVIEW NOTICE
Phone 305-673-7000 Fax 305-673-7028

THIS PLAN REVIEW CONSTITUTES APPROVAL FOR OBTAINING BUILDING PERMITS ONLY.

All construction and/or use of equipment in the right-of-way and/or easements, requires a separate Public Works Department permit prior to start of construction.


Permit Requirements: Proof of existing sidewalk/swale area conditions (pictures) and/or posting of sidewalk/roadway bonds (Public Works Inspection of the right-of-way will be required prior to final sign-off on the C.C./C.O., or the release of bonds.)

Approved/Reviewed By: *[Signature]* Date: 03/31/11

OFFICE COPY
CITY OF MIAMI BEACH
APPROVED FOR PERMIT BY THE FOLLOWING:

BUILDING: *[Signature]* 3/31/11
ZONING: *[Signature]* 3/31/11
DRB/HPB:
CONCURRENCY:
ELECTRICAL:
MECHANICAL:
FIRE PROTECTION:
ENGINEER/NO:
PUBLIC WORKS:
STRUCTURAL:
ELEVATOR:

NOTICE: In addition to the requirement of this permit there may be other requirements to this property that may be found in the City of Miami Beach Code. The City of Miami Beach is not responsible for the accuracy of the information provided by the applicant. The City of Miami Beach is not responsible for the accuracy of the information provided by the applicant.

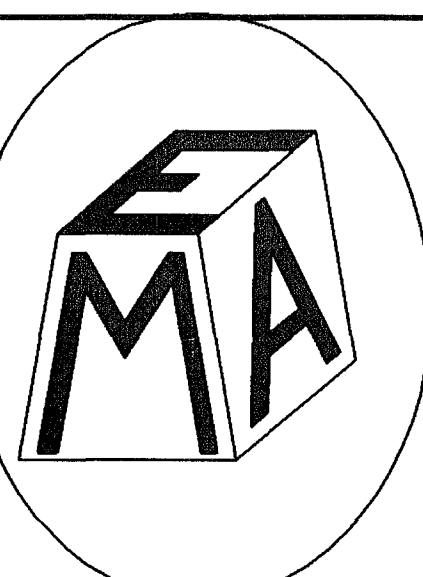

MASTER ARCHITECTURE & ENGINEERING, LLC
MIAMI BEACH, FLORIDA 33139 1701 SUNSET HARBOUR DR., SUITE 202 TEL(305) 531-7911, FAX(305)-531-7912




PERMIT SET

DWG INFO:

Revisions	Date
Rev. 6 OWNER REVISION	12/30/09
Rev. 7 OWNER REVISION	01/22/10
Rev. 8 INSPECTION COMMENT	03/25/11

VILLA TI AMO
2001 LAKE AVENUE MIAMI BEACH, FL 33140

A-4
SHEET NUMBER

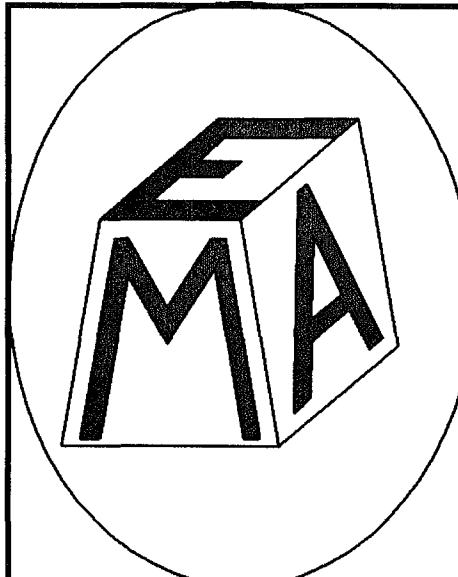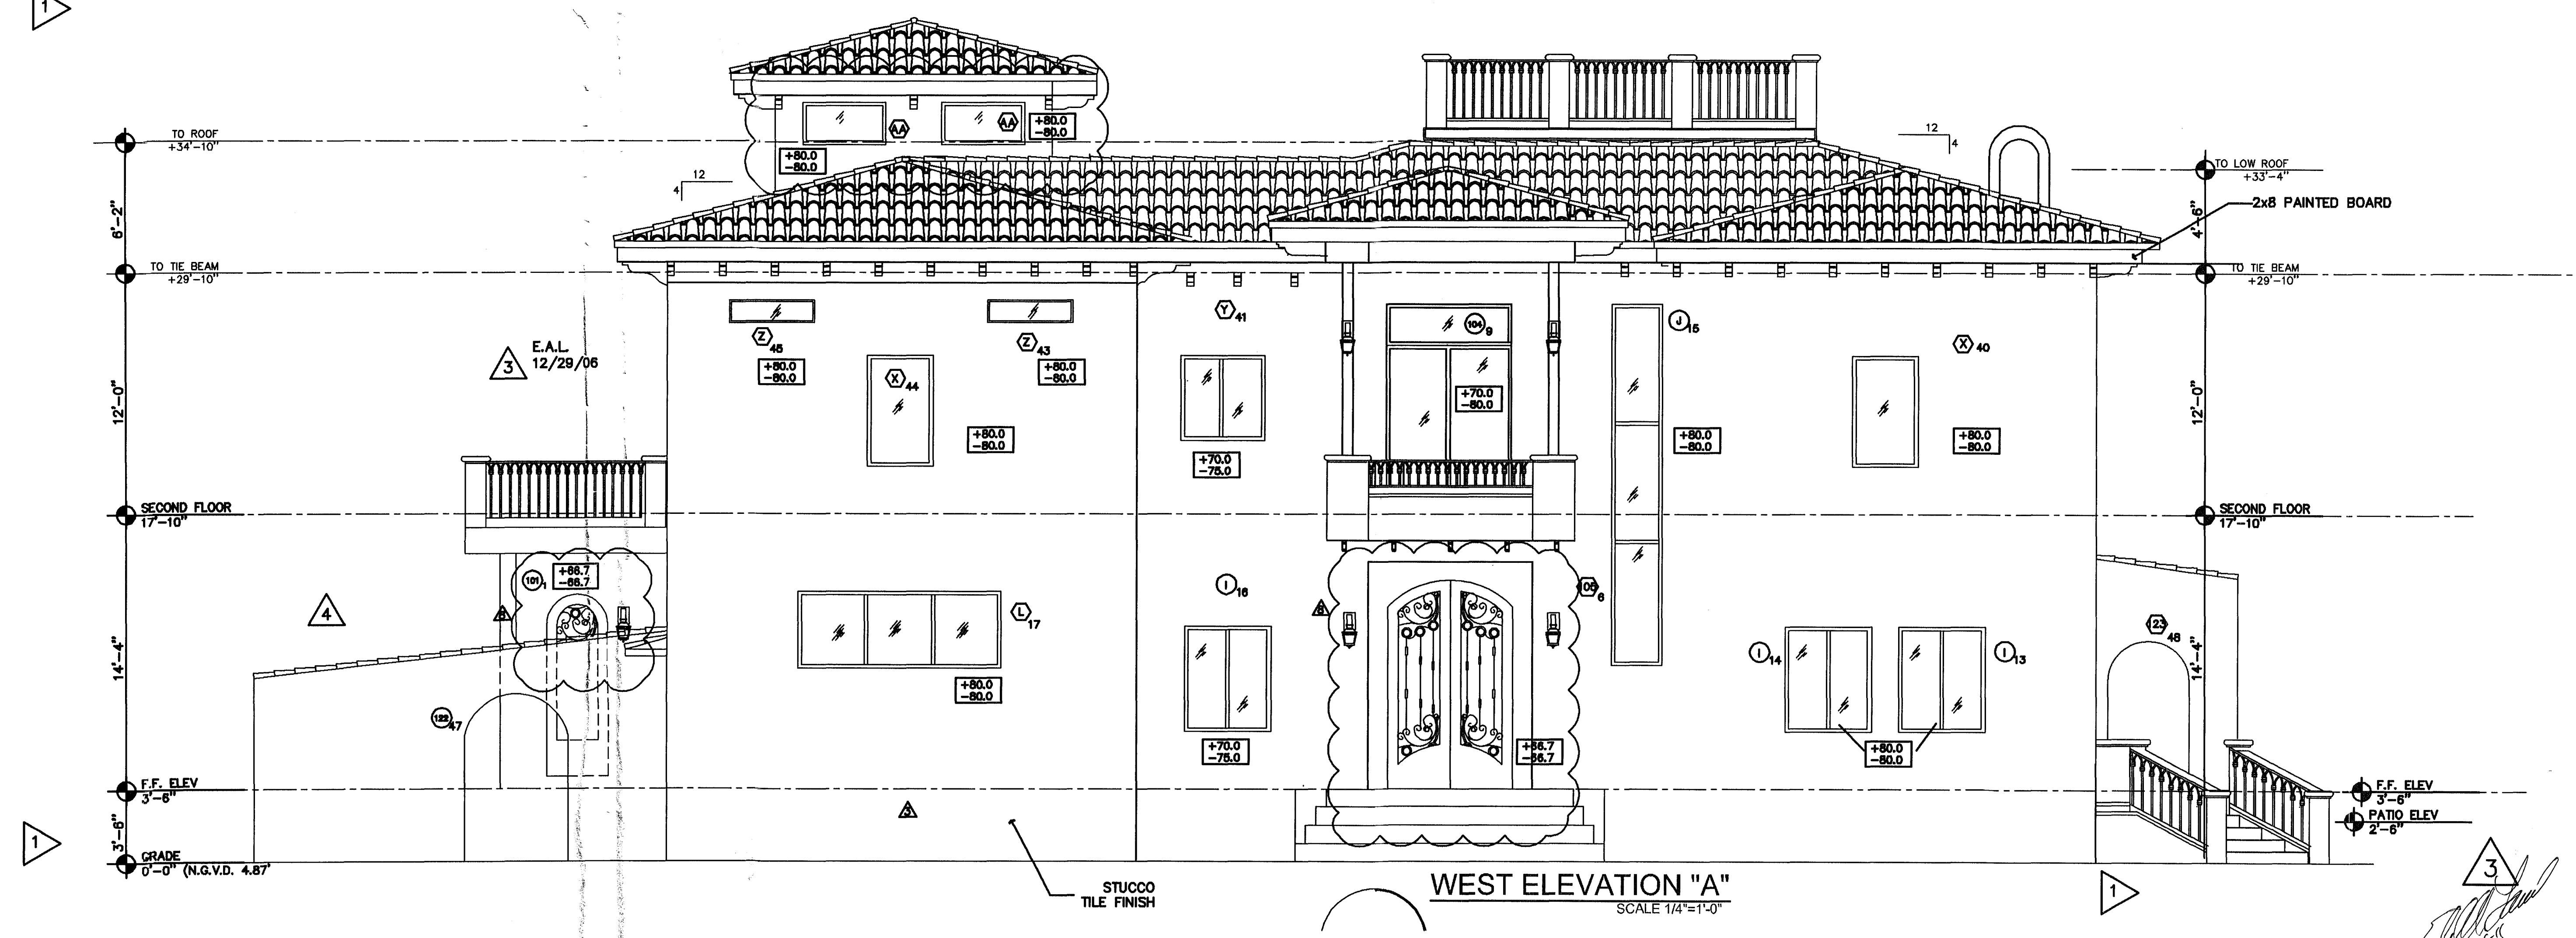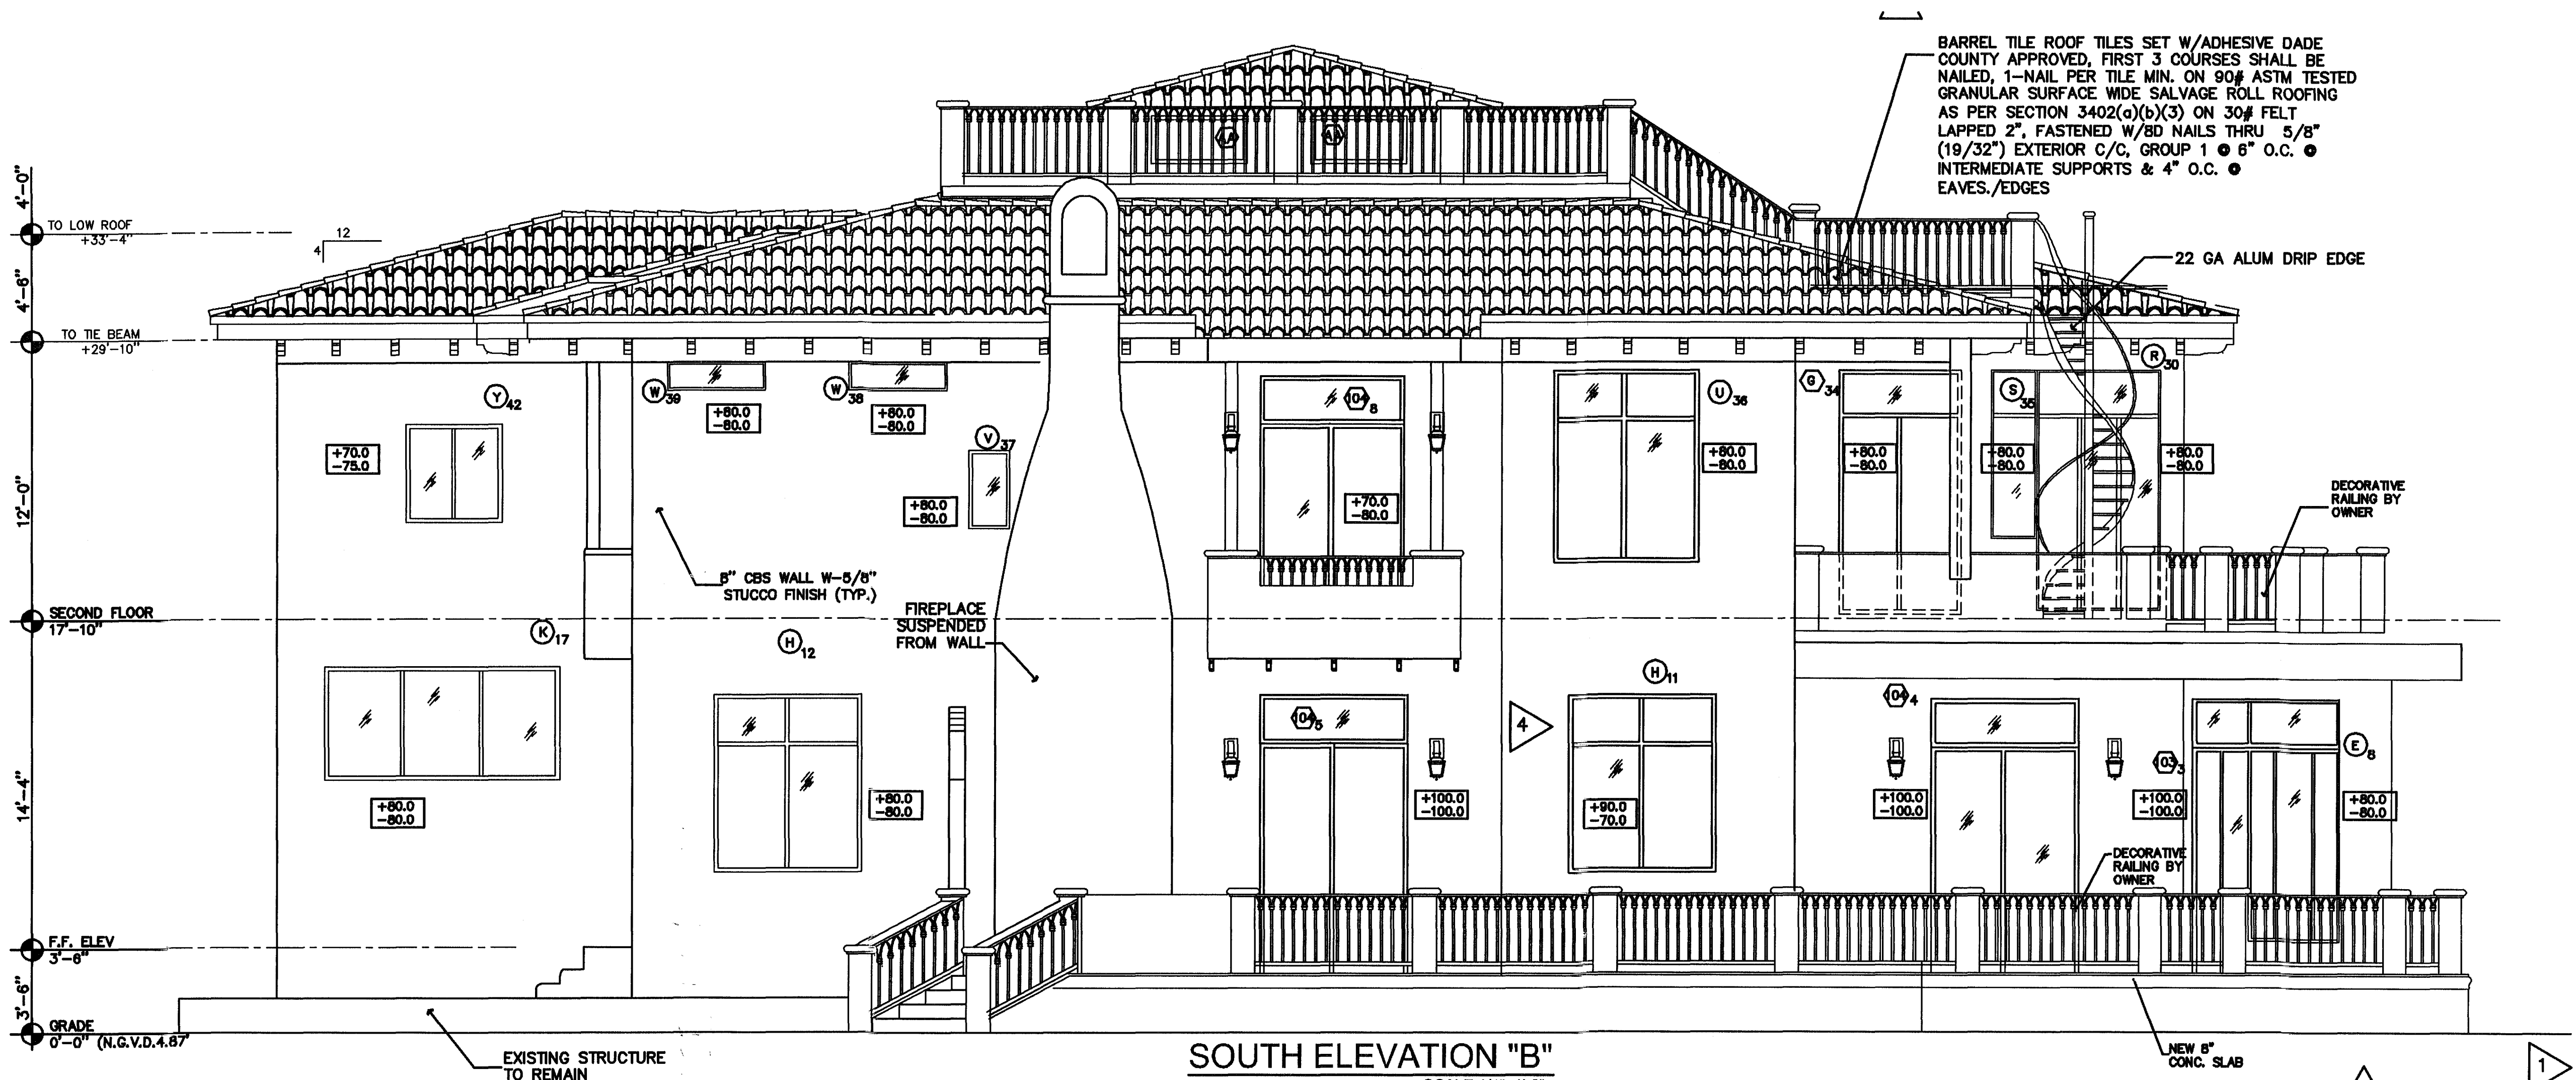

MASTER ARCHITECTURE &
ENGINEERING, LLC
MIAMI BEACH, FLORIDA 33139 1701 SUNSET
HARBOR DR., SUITE 202 TEL(305)
531-7911, FAX(305)-531-7912

PERMIT
SET

Revisions		Date
Rev. 6 OWNER REVISION		12/30/09
Rev. 7 OWNER REVISION		01/22/10
Rev. 8 INSPECTION COMMENT		03/25/11

ADDITION TO:
VILLA TI AMO
2001 LAKE AVENUE MIAMI
BEACH, FL 33140

A-5
SHEET NUMBER