# 300 W 40TH STREET MIAMI BEACH, FL 33140

### GENERAL NOTES

- 1. BOUNDARY, TOPOGRAPHIC, AND UTILITY INFORMATION SHOWN ON PLANS WAS TAKEN FROM A SURVEY PREPARED BY ATLANTIC COAST SURVEYING, INC., LICENSE NO. 5201, DATED MAY 14, 2019.
- 2. ELEVATIONS SHOWN ON THE PLANS REFER TO NATIONAL GEODETIC VERTICAL DATUM 1929 (NGVD29).
- 3. THE SURVEY BENCHMARK OR CONTROL POINT USED IS MIAMI DADE COUNTY ENGINEERING BENCHMARK D-131, LOCATOR 3234 NE, ELEVATION 8.72'.
- 4. ACCORDING TO FLOOD INSURANCE RATE MAP NO. 120651 0317L, PUBLISHED BY THE FEDERAL EMERGENCY MANAGEMENT AGENCY (FEMA), DATED SEPTEMBER 11, 2009, THE SURVEYED PROPERTY SHOWN HEREON LIES WITHIN ENTER HAZARD AREA HERE AND THE FLOOD ELEVATION IS 7.0'; FEET (NGVD29).

### GENERAL CONSTRUCTION NOTES

- 1. REFER TO ARCHITECTURAL, MECHANICAL, ELECTRICAL AND PLUMBING DRAWINGS TO COORDINATE ALL WORK WITHIN 5 FEET OF THE BUILDING.
- CONTRACTOR SHALL COMPLY WITH ALL REQUIREMENTS OF THE CITY OF MIAMI BEACH AND ALL OTHER GOVERNING AUTHORITIES. CONTRACTOR SHALL BE RESPONSIBLE FOR OBTAINING ALL PERMITS RELATED TO
- 3. THE CONTRACTOR SHALL PROPERLY DISPOSE OF ALL UNSATISFACTORY AND/OR WASTE MATERIALS INCLUDING VEGETATION, ROOTS, CONCRETE, AND DEBRIS RELATED TO THE PROJECT IN ACCORDANCE WITH ALL APPLICABLE FEDERAL, STATE AND LOCAL LAWS. CONTRACTOR SHALL NOTIFY OWNER AND ENGINEER PRIOR TO DISPOSING OF ANY SOIL FROM THE SITE TO CONFIRM QUANTITY AND REASON FOR NEEDING TO EXPORT EXCESS SOIL.
- 4. CONTRACTOR SHALL CONFINE ALL WORK TO THE PROJECT BOUNDARY AND AREAS DIRECTLY ADJOINING THE WORK IN THE PUBLIC RIGHT-OF-WAY. EXISTING PAVEMENTS. CURBS. SIDEWALKS, DRIVEWAYS. LANDSCAPING, FENCES AND OTHER EXISTING IMPROVEMENTS DAMAGED OR REMOVED DURING CONSTRUCTION SHALL BE REPLACED IN ACCORDANCE WITH THE CITY OR GOVERNING AUTHORITIES REQUIREMENTS. CONDITION OF THE ROAD AND/OR RIGHT-OF-WAY, DURING AND UPON COMPLETION OF THE JOB, SHALL BE AS GOOD AS THE CONDITION PRIOR TO CONSTRUCTION. CONTRACTOR SHALL PROMPTLY CLEAN MUD. DIRT OR DEBRIS TRACKED ONTO EXISTING STREETS FROM THE PROJECT SITE.
- 5. CONTRACTOR SHALL VERIFY ALL ELEVATIONS, DIMENSIONS AND CONDITIONS IN THE FIELD BEFORE COMMENCING ANY WORK. CONTRACTOR SHALL REPORT ANY CONFLICTS OR VARIATIONS AND RESOLVE ALL CHANGES WITH THE OWNER PRIOR TO COMMENCING THE
- 6. ALL SPECIFICATIONS AND DOCUMENTS REFERRED TO IN THESE PLANS SHALL BE OF THE LATEST REVISION.

### CONSTRUCTION NOTICE NOTES

- CONTRACTOR SHALL NOTIFY THE TOWN, CITY, OR COUNTY AT LEAST 36 HOURS PRIOR TO WORKING IN ANY PUBLIC RIGHT-OF-WAY OR EASEMENTS OR CONNECTING TO STREET, DRAINAGE, WATER OR WASTEWATER FACILITIES.
- 2. CONTRACTOR SHALL NOTIFY FLORIDA DEPARTMENT OF TRANSPORTATION AT LEAST 36 HOURS PRIOR TO CONNECTING TO ANY STREET. (IF NEEDED)
- 3. CONTRACTOR SHALL NOTIFY WATER AND SEWER DOUGLAS OFFICE AT LEAST 36 HOURS PRIOR TO CONNECTING TO ANY PUBLIC WATER FACILITY. (IF NEEDED)
- 4. CONTRACTOR SHALL NOTIFY FLORIDA POWER AND LIGHT AT LEAST 36 HOURS PRIOR TO WORKING IN ANY PUBLIC ELECTRIC FACILITIES. (IF NEEDED)
- 5. CONTRACTOR SHALL NOTIFY MIAMI DERM HAVING JURISDICTION AT LEAST 36 HOURS PRIOR TO DISTURBING ANY SOIL ON THE SITE. (IF NEEDED)

### LIST OF APPROVALS

TOTAL PARCEL AREA:

ADDRESS:

PARCEL ID #:

CURRENT USE:

PROPOSED USE:

FRONT:

PROPOSED PARKING:

SIDE CORNER:

SIDE INTERIOR:

SETBACKS:

PROPOSED IMPERVIOUS COVER: 54.6%

ZONING STATISTICS AND PARKING SUMMARY

RS-2

REQUIRED

15'

TOTAL 17 SPACES

INSTITUTIONAL

±36,438 SF (±0.84 AC)

MIAMI BEACH, FL 33140

440 PLACE OF WORSHIP

57.48'

10.14

133.81

EXISTING

21.80'

37.70

5.00'

300 W. 40TH STREET

02-3227-017-0590

15 REGULAR SPACES

<u>2 H/C SPACES</u>

### APPLICANT: NAME:

ADDRESS: 300 W. 40TH STREET

CIVIL ENGINEER: NAME: TARCISIO NOGUERA, P.E. PHONE: 954-850-4288 ADDRESS: 19244 NW 24TH COURT PEMBROKE PINES, FL 33029

SURVEYOR: NAME: ATLANTIC COAST SURVEYING, INC. PHONE: 954-587-2100 ADDRESS: 6129 STIRLING ROAD, SUITE 2

N. PALM BEACH, FL 33408

ARCHITECT: NAME: MARK A. UGOWSKI, AIA PHONE: 561-452-1399 ADDRESS: 707 BUOY ROAD

DAVIE, FL 33314

LANDSCAPE ARCHITECT:

PHONE: ADDRESS:

GEOTECHNICAL ENGINEER PHONE: ADDRESS:

### CONTACT INFORMATION

DRAWING INDEX 1 COVER SHEET BOUNDARY AND TOPOGRAPHICAL SURVEY JEHOVAH'S WITNESSES CONGREGATION OF CE101 DEMOLITION & EROSION CONTROL PLAN SOUTH MIAMI BEACH, INC. CS101 SITE PLAN CG101 GRADING AND DRAINAGE PLAN CU101 UTILITY PLAN MIAMI BEACH, FL 33140 L-101 LANDSCAPE PLANTING PLAN L-102 LANDSCAPE DETAILS A-101 FLOOR PLAN A-102 FINISH AND SEATING FLOOR PLAN A-201 ELEVATIONS A-202 ELEVATIONS

A-203

TOPSOIL

ES101

SITE CROSS SECTION

UNSUITABLE MATERIAL TO EXPORT TBD CY

ELECTRICAL SITE PLAN

OLIANITIY SI	JMMARY TABLE
· · · · · · · · · · · · · · · · · · ·	DIVINANT TABLE
DESCRIPTION	
CAR PAVEMENT AREA	5,558.84 SQ.FT.
PEDESTRIAN PAVEMENT AREA	3,655.97 SQ.FT.
CURB/CURB & GUTTER LENGTH	_
LANDSCAPE QUANTITIES	SEE LANDSCAPE PLAN
UTILITY QUANTITIES	SEE UTILITY PLAN
EARTHWORK VOLUMES (IN PLACE VOLUMES)	CUT: TBD CY, FILL: TBD CY, NET: TBD CY CUT
LIGHTING & WIRING QUANTITIES	SEE ELECTRICAL PLAN
DRAINAGE STRUCTURES	SEE DRAINAGE PLAN

TBD CY

# ABBREVIATIONS

\ APPROX

)BLDG

CONC

DEG

ЕМ

EOP

REINF

SDMH

SPEC

SSMH

UGND

UTIL

STD

CU YD OR CY

**SBOT** 

ACRES AUTHORITY HAVING JURISDICTION APPROXIMATE BOTTOM OF CURB BUILDING BOTTOM BOTTOM OF WALL CATCH BASIN CAST IRON OR CURB INLET CAST-IN-PLACE CENTER LINE CLEAN OUT COMMUNICATIONS CONCRETE CENTER CUBIC YARD DEPTH DOUBLE DEGREES DEMOLITION DUCTILE IRON

DIAMETER DRAIN DRAWING EAST OR ELECTRIC FACH ELEVATION ELECTRICAL ELECTRIC METER EDGE OF PAVEMENT EXIST OR E EXISTING FLOOR DRAIN OR FOOTING DRAIN FOUNDATION FINISHED FLOOR FIRE PROTECTION FOOTING GALLON

GAS METER GROUND GAS VALVE HIGH-DENSITY POLYETHYLENE INSIDE DIAMETER INVERT ELEVATION INVERT LENGTH LINEAR FEET LIQUID PROPANE GAS

MAXIMUM MANHOLE MINIMUM MISCELLANEOUS MUNICIPAL WATER MAIN NORTH NON-POTABLE WATER ON CENTER OUTSIDE DIAMETER OVERHEAD

PROPERTY LINE POUNDS PER SQUARE INCH POWER RADIUS REINFORCED CONCRETE PIPE ROOF DRAIN

REFERENCE REINFORCED OR REINFORCING SOUTH OR SANITARY SANITARY SCHEDULE STORM DRAIN STORM DRAIN MANHOLE

SPECIFICATION SANITARY SEWER SANITARY SEWER MANHOLE STANDARD SIDEWALK TOP OF CURB

TRENCH DRAIN TYPICAL UNDERGROUND UTILITIES UTILITY POLE

VOLUME WEST OR POTABLE WATER OR WIDTH

JEHOVAH'S WITNESSES CONG. OF S. MIAMI BEACH 300 W. 40TH STREET

MIAMI BEACH, FL 33140

1\ |16 AUG 21 ZONING RESUBMITTAL

28 JUN 21 ZONING SUBMITTAL

ARK: DATE: DESCRIPTION:

TARCISIO NOGUERA, PE 19244 NW 24th COURT PEMBROKE PINES, FL 33029 tnoguera.pe@gmail.com 954-850-4288

> CISIO NOGU **'**(ICENS&''


> > STATE OF


KINGDOM HALL OF JEHOVAH'S WITNESSES

300 W. 40TH STREET MIAMI BEACH, FL 33140

**COVER SHEET** 

VICINITY MAP

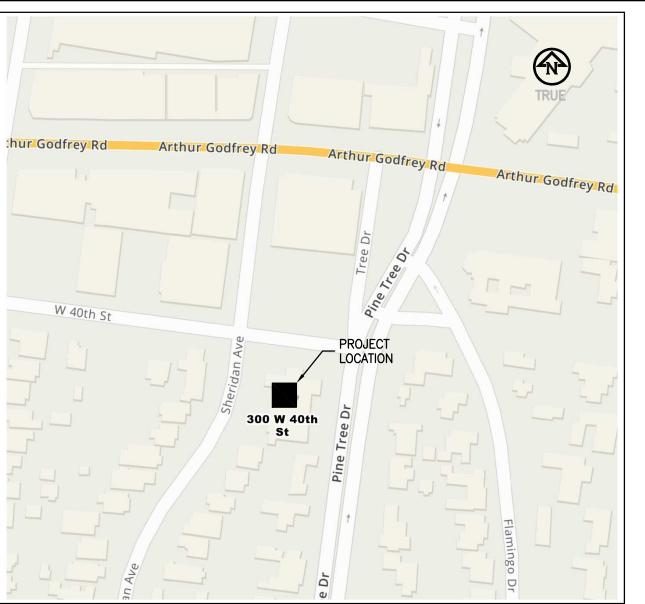

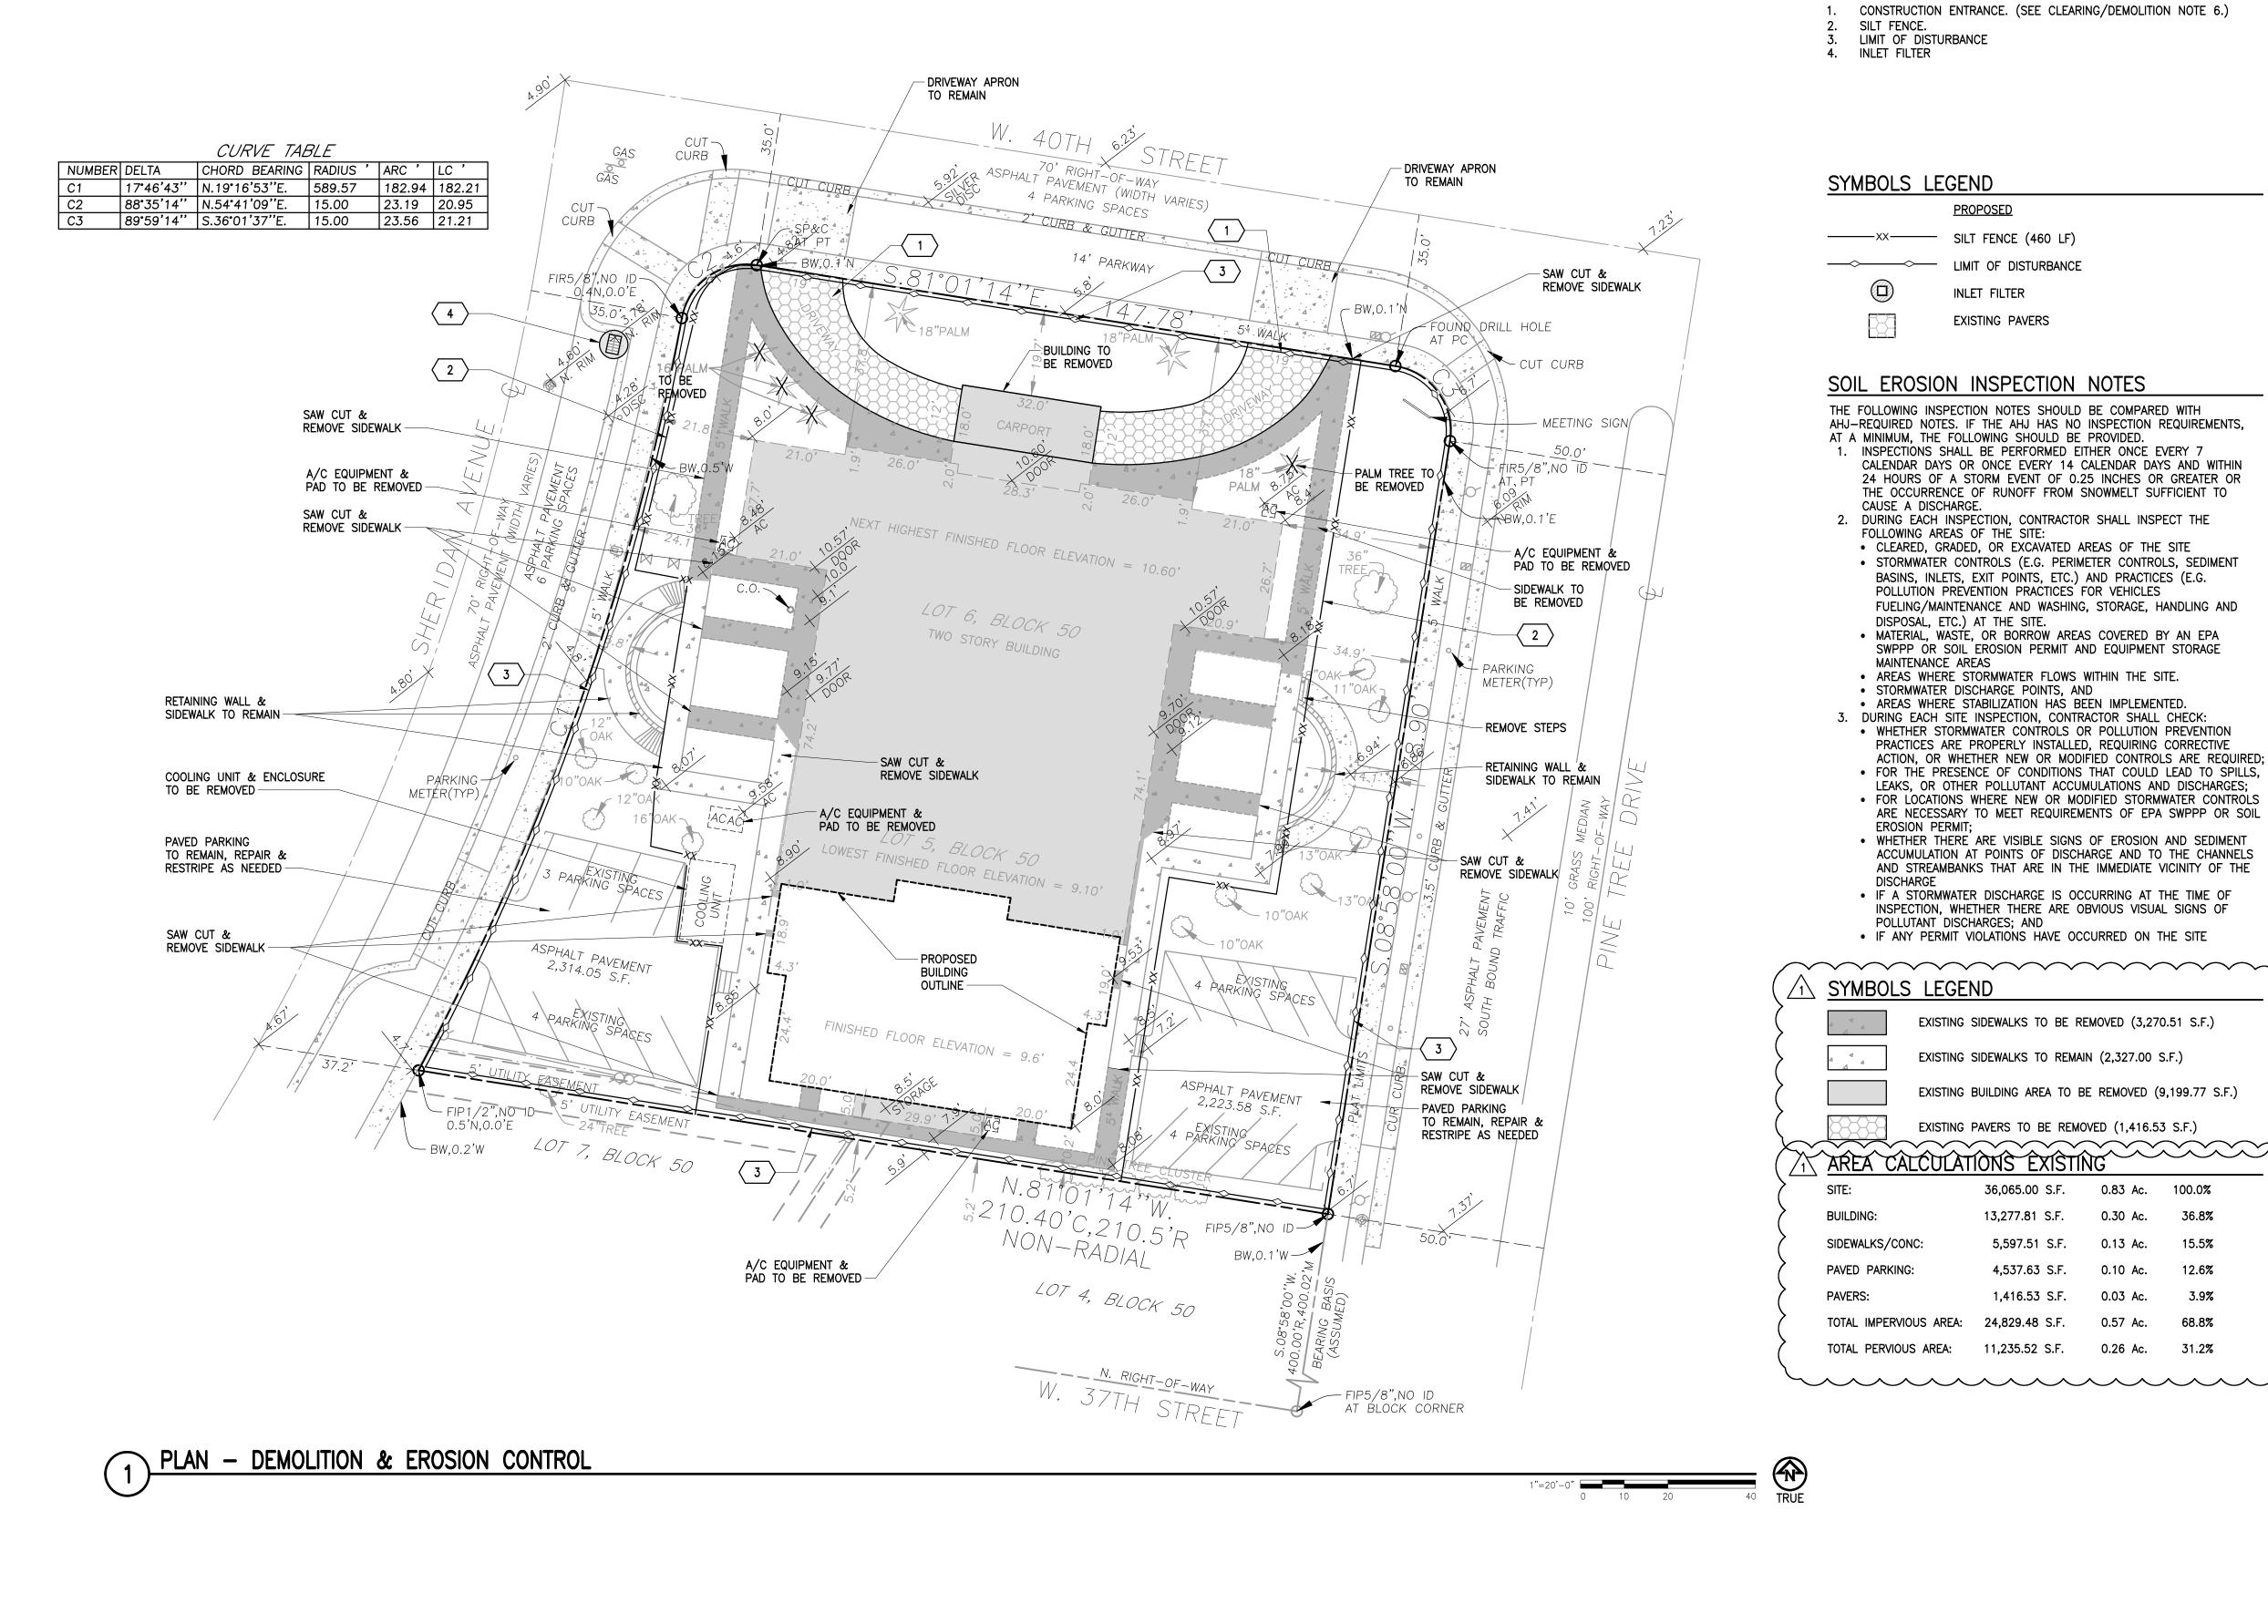

MAGE: MAGE:

XXE: XXE: XXE: XXE: XXE:

XRE: XRE: XRE: XRE:

○ SHEET KEYNOTES

- CONSTRUCTION ENTRANCE. (SEE CLEARING/DEMOLITION NOTE 6.) SILT FENCE.
- LIMIT OF DISTURBANCE INLET FILTER

## SYMBOLS LEGEND

**PROPOSED** 

LIMIT OF DISTURBANCE INLET FILTER EXISTING PAVERS

### SOIL EROSION INSPECTION NOTES

THE FOLLOWING INSPECTION NOTES SHOULD BE COMPARED WITH AHJ-REQUIRED NOTES. IF THE AHJ HAS NO INSPECTION REQUIREMENTS, AT A MINIMUM, THE FOLLOWING SHOULD BE PROVIDED. 1. INSPECTIONS SHALL BE PERFORMED EITHER ONCE EVERY 7 CALENDAR DAYS OR ONCE EVERY 14 CALENDAR DAYS AND WITHIN 24 HOURS OF A STORM EVENT OF 0.25 INCHES OR GREATER OR THE OCCURRENCE OF RUNOFF FROM SNOWMELT SUFFICIENT TO CAUSE A DISCHARGE.

- 2. DURING EACH INSPECTION, CONTRACTOR SHALL INSPECT THE FOLLOWING AREAS OF THE SITE: CLEARED, GRADED, OR EXCAVATED AREAS OF THE SITE
- STORMWATER CONTROLS (E.G. PERIMETER CONTROLS, SEDIMENT BASINS, INLETS, EXIT POINTS, ETC.) AND PRACTICES (E.G. POLLUTION PREVENTION PRACTICES FOR VEHICLES FUELING/MAINTENANCE AND WASHING, STORAGE, HANDLING AND DISPOSAL, ETC.) AT THE SITE.
- MATERIAL, WASTE, OR BORROW AREAS COVERED BY AN EPA SWPPP OR SOIL EROSION PERMIT AND EQUIPMENT STORAGE MAINTENANCE AREAS
- AREAS WHERE STORMWATER FLOWS WITHIN THE SITE. STORMWATER DISCHARGE POINTS, AND
- AREAS WHERE STABILIZATION HAS BEEN IMPLEMENTED. 3. DURING EACH SITE INSPECTION, CONTRACTOR SHALL CHECK: WHETHER STORMWATER CONTROLS OR POLLUTION PREVENTION PRACTICES ARE PROPERLY INSTALLED, REQUIRING CORRECTIVE ACTION, OR WHETHER NEW OR MODIFIED CONTROLS ARE REQUIRED;
- FOR THE PRESENCE OF CONDITIONS THAT COULD LEAD TO SPILLS, LEAKS, OR OTHER POLLUTANT ACCUMULATIONS AND DISCHARGES; FOR LOCATIONS WHERE NEW OR MODIFIED STORMWATER CONTROLS ARE NECESSARY TO MEET REQUIREMENTS OF EPA SWPPP OR SOIL **EROSION PERMIT:**
- WHETHER THERE ARE VISIBLE SIGNS OF EROSION AND SEDIMENT ACCUMULATION AT POINTS OF DISCHARGE AND TO THE CHANNELS AND STREAMBANKS THAT ARE IN THE IMMEDIATE VICINITY OF THE DISCHARGE IF A STORMWATER DISCHARGE IS OCCURRING AT THE TIME OF
- INSPECTION, WHETHER THERE ARE OBVIOUS VISUAL SIGNS OF POLLUTANT DISCHARGES; AND IF ANY PERMIT VIOLATIONS HAVE OCCURRED ON THE SITE

### SYMBOLS LEGEND

EXISTING SIDEWALKS TO BE REMOVED (3,270.51 S.F.)

EXISTING SIDEWALKS TO REMAIN (2,327.00 S.F.)

EXISTING BUILDING AREA TO BE REMOVED (9,199.77 S.F.)

EXISTING PAVERS TO BE REMOVED (1,416.53 S.F.)

AREA CALCULATIONS EXISTING 0.83 Ac. 100.0% 36,065.00 S.F. 0.30 Ac. 36.8% SIDEWALKS/CONC: 15.5% PAVED PARKING: 4,537.63 S.F. 1,416.53 S.F. TOTAL IMPERVIOUS AREA: 24,829.48 S.F. TOTAL PERVIOUS AREA: 0.26 Ac. 31.2%

### GENERAL SHEET NOTES

- REFER TO C-001 COVER SHEET FOR GENERAL NOTES REFERENCING SURVEY INFORMATION, DATUMS, GENERAL PROJECT AND CONSTRUCTION INFORMATION.
- 2. PLEASE REFER TO EARTHWORK AND UTILITY TRENCH NOTES ON THE GRADING PLAN AS WELL AS FOR SPECIFIC REFERENCE TO THE GEOTECHNICAL REPORT.
- 3. ALL SOIL TO BE EXPOSED OR STOCKPILED FOR A PERIOD OF GREATER THAN 60 DAYS, AND NOT UNDER ACTIVE CONSTRUCTION SHALL BE TEMPORARILY SEEDED AND HAY MULCHED OR OTHERWISE PROVIDED WITH VEGETATIVE COVER. THIS TEMPORARY COVER SHALL BE MAINTAINED UNTIL SUCH TIME WHEREBY PERMANENT RESTABILIZATION IS ESTABLISHED.
- 4. SEDIMENT FENCES ARE TO BE PROPERLY TRENCHED AND MAINTAINED UNTIL PERMANENT VEGETATIVE COVER IS ESTABLISHED.
- ALL EROSION CONTROL DEVICES SHALL BE PERIODICALLY INSPECTED, MAINTAINED AND CORRECTED BY THE CONTRACTOR. ANY DAMAGE INCURRED BY EROSION SHALL BE IMMEDIATELY RECTIFIED.
- SEDIMENT IN BASINS SHALL BE REMOVED AT REGULAR INTERVALS. THE LAST TWO FEET OF ANY INFILTRATION BASINS SHOULD NOT BE EXCAVATED IF IT WILL BE USED AS A SEDIMENT BASIN. BASIN CONSTRUCTION MUST NOT COMPACT SOILS AT BASIN BOTTOM.
- PAVED ROADWAYS MUST BE KEPT CLEAN AT ALL TIMES. DO NOT UTILIZE A FIRE OR GARDEN HOSE TO CLEAN ROADS UNLESS THE RUNOFF IS DIRECTED TO A PROPERLY DESIGNED AND FUNCTIONING SEDIMENT BASIN. ALL PUMP DEWATERING SHALL BE DIRECTED TOWARD A SEDIMENT BASIN.
- THE MAXIMUM SOIL SLOPES SHALL NOT EXCEED 3:1 UNLESS ADDITIONAL MEASURES ARE TAKEN AND APPROVED.
- THE CONTRACTOR SHALL BE RESPONSIBLE FOR PROTECTING EXCAVATIONS AGAINST COLLAPSE AND WILL PROVIDE BRACING, SHEETING OR SHORING AS NECESSARY. DEWATERMING METHODS SHALL BE USED TO KEEP TRENCHES DRY WHILE PIPE AND APPURTENANCES ARE BEING PLACED.

### CLEARING/DEMOLITION NOTES

- 1. PRIOR TO ANY SOIL DISTURBANCE OR LAND CLEARING, ALL SOIL EROSION AND SEDIMENT CONTROLS MUST BE IN PLACE.
- PRIOR TO ANY SITE CLEARING, ALL TREES SHOWN TO REMAIN AS INDICATED ON PLANS SHALL BE PROTECTED IN ACCORDANCE WITH LOCAL REGULATIONS. THE CONTRACTOR SHALL MAINTAIN THESE TREES IN GOOD CONDITION.
- THE CONTRACTOR SHALL CLEAR AND GRUB ONLY THOSE PORTIONS OF THE SITE NECESSARY FOR CONSTRUCTION, AS NOTED ON THE PLANS.
- THE CONTRACTOR SHALL COORDINATE WITH LOCAL UTILITY COMPANIES TO DISCONNECT / RELOCATE THEIR FACILITIES WITHIN THE LIMITS OF CONSTRUCTION PRIOR TO ANY DEMOLITION.
- REMAINING EARTHWORK THAT RESULTS FROM CLEARING AND GRUBBING OR SITE EXCAVATION IS TO BE UTILIZED ONSITE. PROVIDED THAT THE MATERIAL IS DEEMED SUITABLE FOR CONSTRUCTION BY THE OWNER'S SOIL TESTING COMPANY.
- EXISTING PAVERS TO REMAIN IN PLACE AS STABILIZED CONSTRUCTION ENTRANCE UNTIL PAVED DRIVEWAY IS INSTALLED.

JEHOVAH'S WITNESSES CONG. OF S. MIAMI BEACH

 $\frac{1}{1}$  16 aug 21 zoning resubmittal 28 JUN 21 ZONING SUBMITTAL

TARCISIO NOGUERA, PE

19244 NW 24th COURT

PEMBROKE PINES, FL 33029

tnoguera.pe@gmail.com 954-850-4288

CISIO NOGU

·:\CENS&··

STATE OF

. CORIDA.

IIII SSIONAL E

MIAMI BEACH, FL 33140


KINGDOM HALL OF

JEHOVAH'S WITNESSES 300 W. 40TH STREET MIAMI BEACH, FL 33140

DEMOLITION & EROSION CONTROL PLAN

PROJECT No. 18879


Always call 811 two full business days before you dig to have underground utilities located and marked. Sunshine 811.com

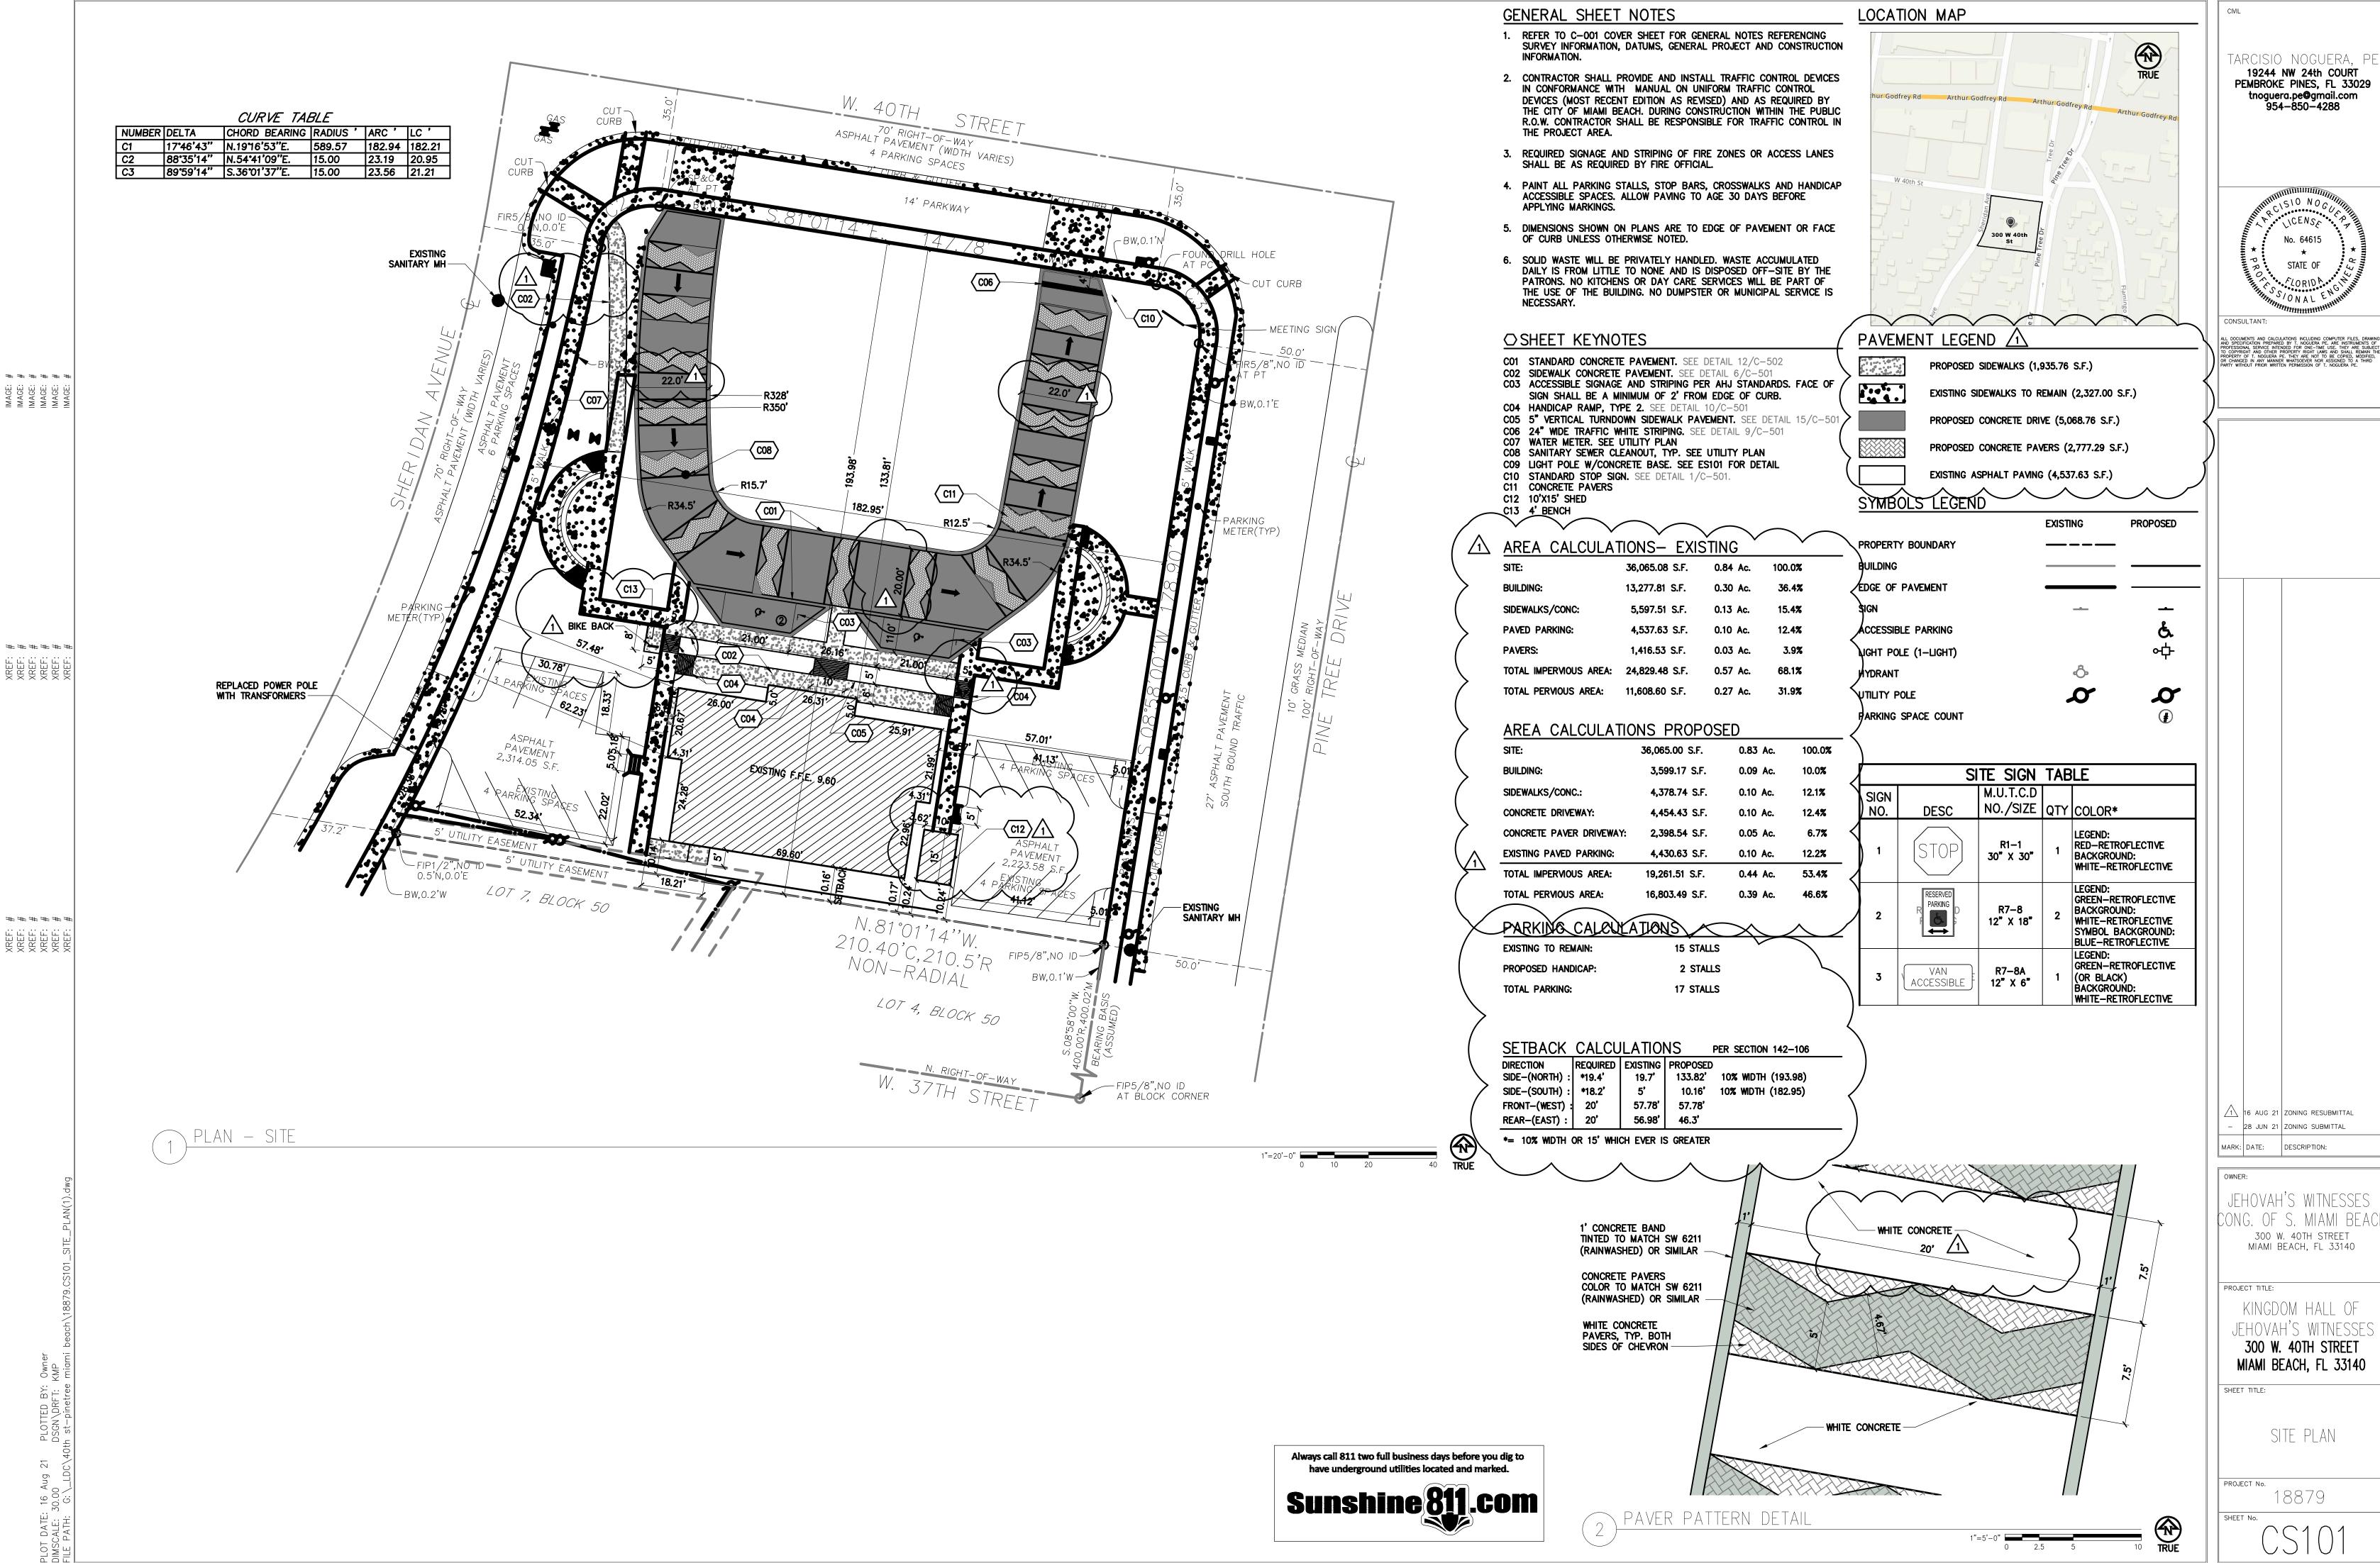


\* \* \* \* \* \*

\*\*\*\*

TARCISIO NOGUERA, PE 19244 NW 24th COURT PEMBROKE PINES, FL 33029 tnoguera.pe**g**gmail.com 954-850-4288

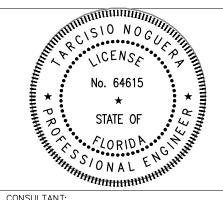

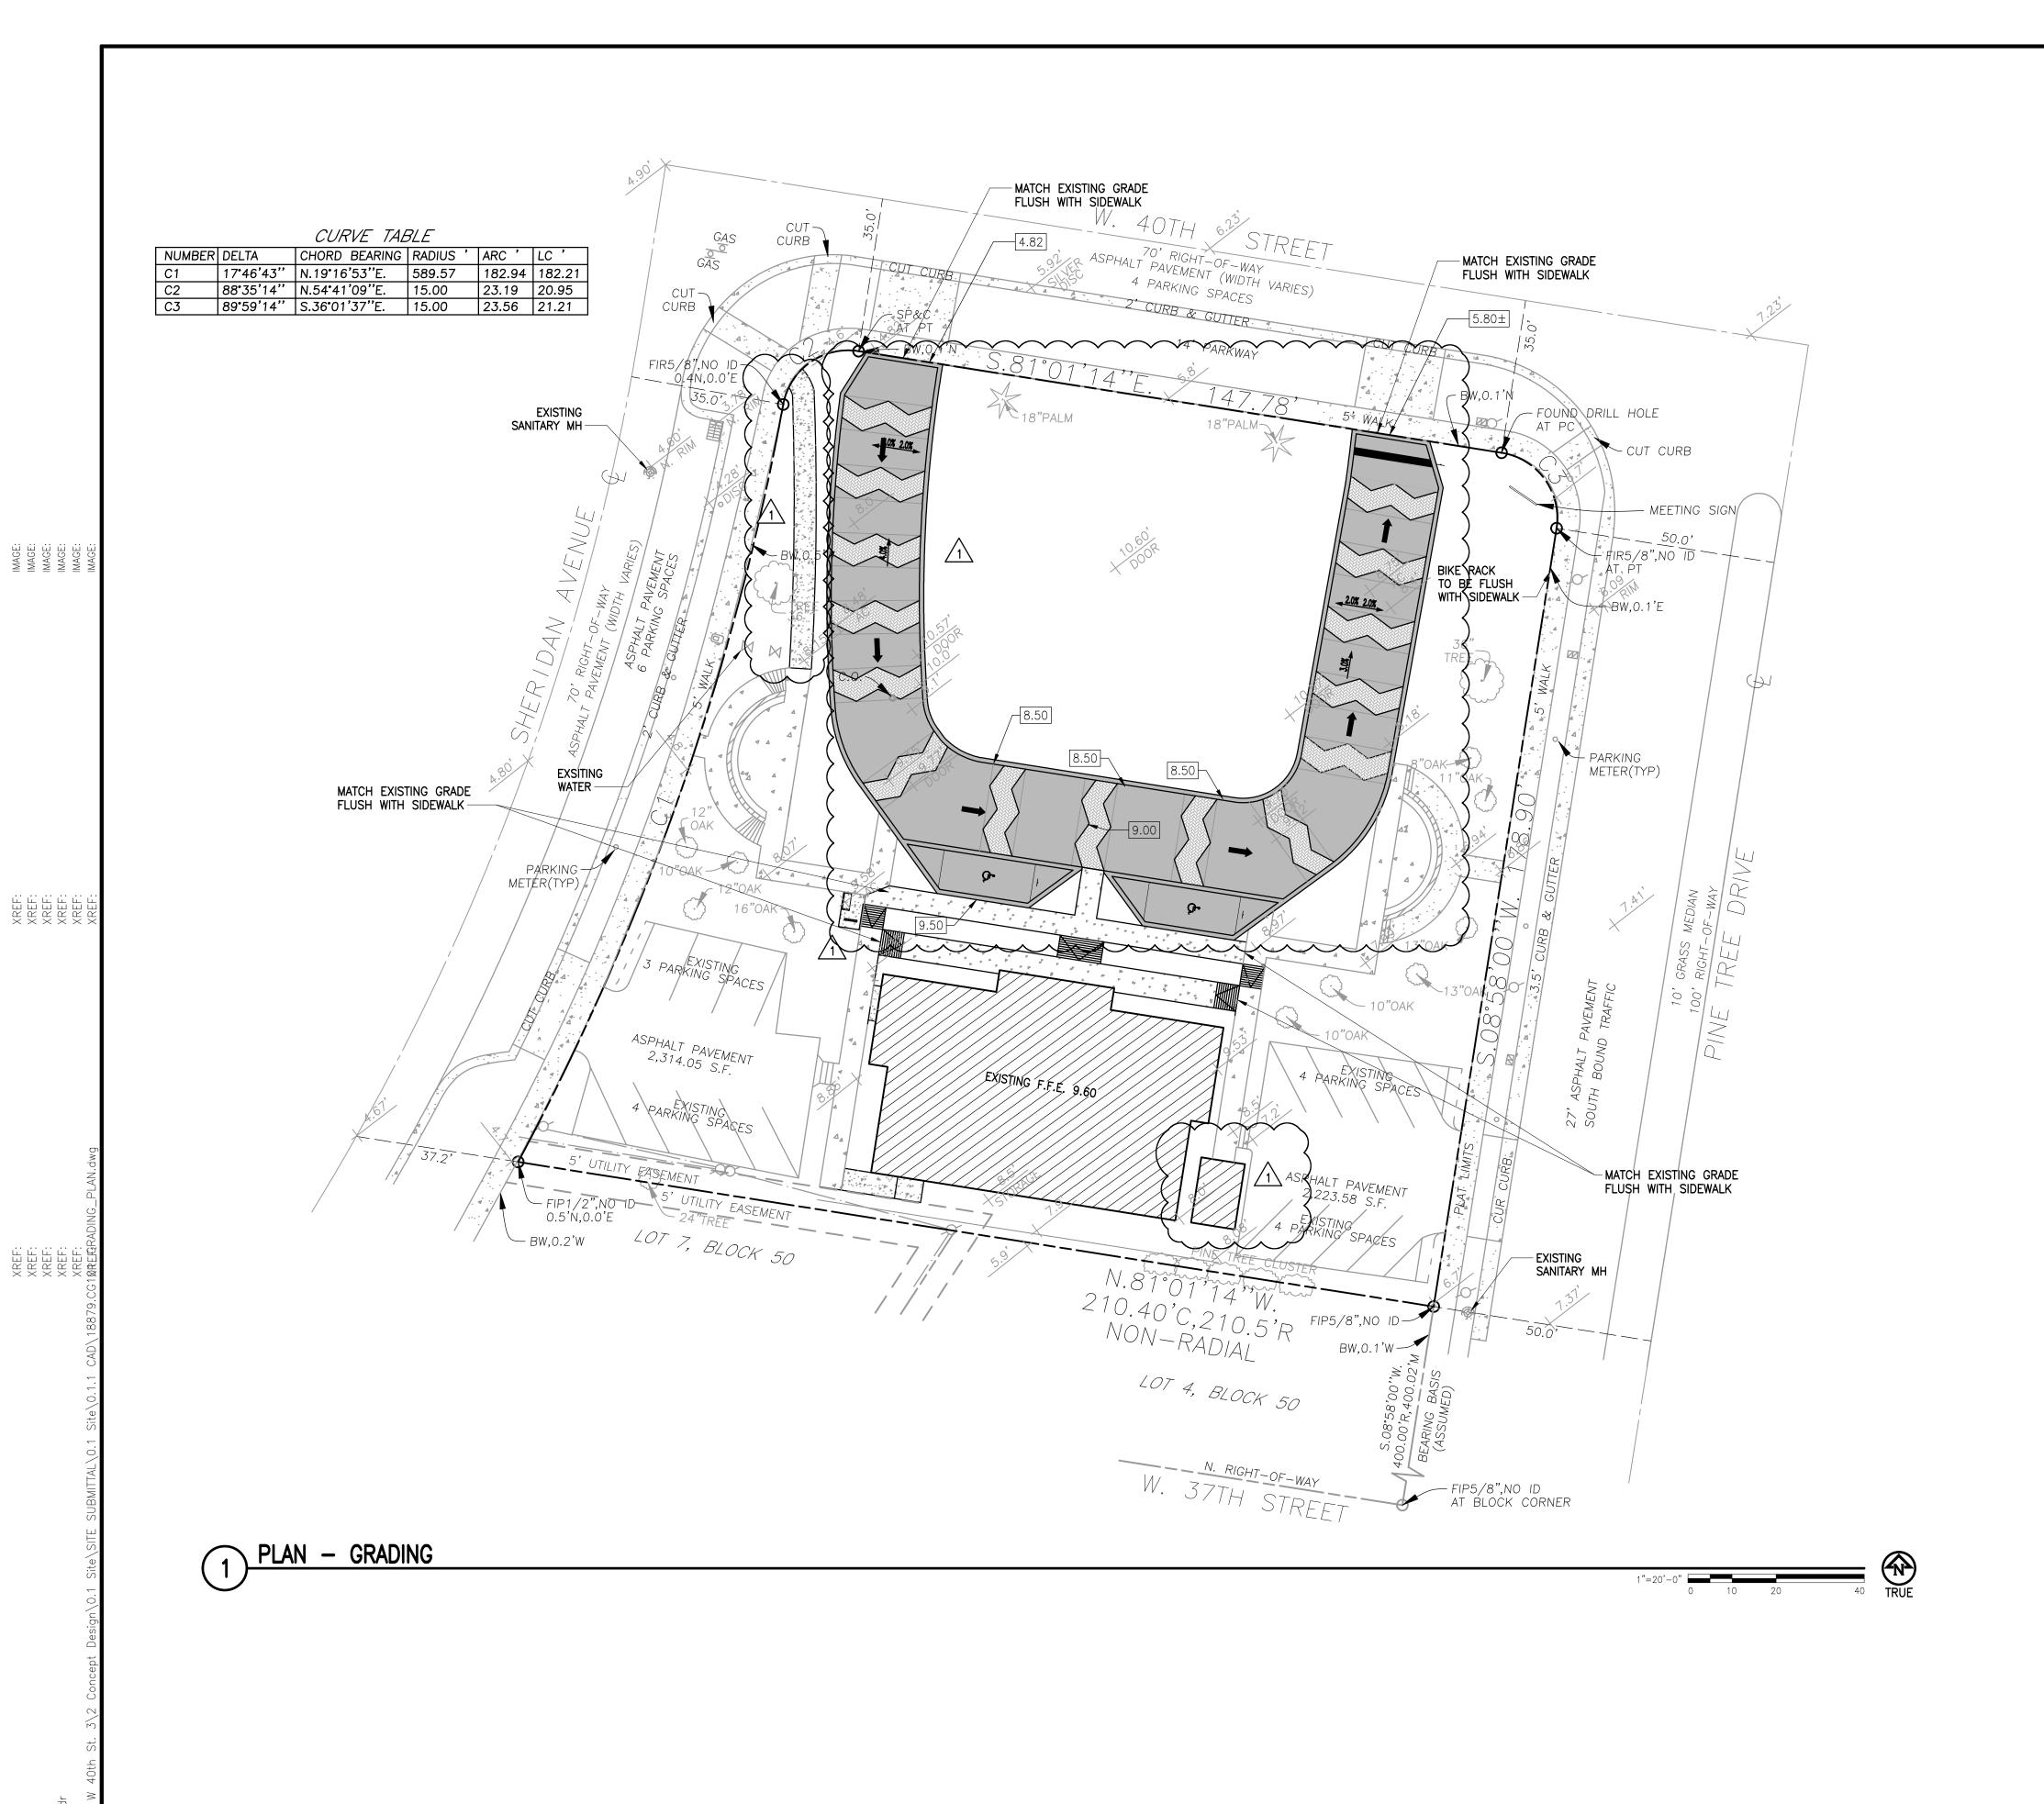

GENERAL GRADING NOTES

1. REFER TO C-001 COVER SHEET FOR GENERAL NOTES REFERENCING SURVEY INFORMATION, DATUMS, GENERAL PROJECT AND CONSTRUCTION INFORMATION

2. CONTRACTOR SHALL MAINTAIN ADEQUATE DRAINAGE AT ALL TIMES DURING CONSTRUCTION OF THE PROJECT.


3. YARD AREAS, SIDEWALKS AND PAVEMENT SHALL BE GRADED TO DRAIN AWAY FROM THE BUILDINGS. FINISHED SURFACES SUCH AS ALL PAVING, SIDEWALKS AND RAMPS IN ACCESSIBLE AREAS SHALL CONFORM TO FLORIDA ACCESSIBILITY STANDARDS, FLORIDA BUILDING CODE 2020, 7TH EDITION. ACCESSIBLE ROUTES SHALL BE CONSTRUCTED IN ACCORDANCE WITH THE ARCHITECTURAL DRAWINGS AND WITH THE FOLLOWING:

PARKING AND LOADING AREAS - MAXIMUM SLOPE OF 1:50 (2%) IN ALL DIRECTIONS IN ACCESSIBLE PARKING SPACES AND AISLES. ACCESSIBLE ROUTES - MAXIMUM SLOPE OF 1:20 (5%) IN THE DIRECTION OF TRAVEL. MAXIMUM CROSS SLOPE OF 1:50 (2%). BUILDING ENTRANCES AND EXITS - AT ALL LOCATIONS 5'X5' (MINIMUM) ACCESSIBLE, CONCRETE WALK WITH A MAXIMUM SLOPE OF 1:50 (2%) IN ALL DIRECTIONS.

4. CONTRACTOR SHALL GRADE THE SITE TO MATCH EXISTING GROUND AT THE LIMITS OF THE PROJECT SITE. ALL DRAINAGE ENTERING THE PROJECT AREA SHALL BE INTERCEPTED IN THE FINAL GRADING. TRANSITIONS TO EXISTING GROUND THAT ARE DIFFERENT FROM THE PLANS SHALL BE COORDINATED PRIOR TO FINAL GRADING. LAWN AREAS TO BE MOWED SHOULD NOT EXCEED A SLOPE OF 4:1.

5. ALL AREAS WITHIN THE PROJECT SITE SHALL BE GRADED TO DRAIN TO ON-SITE STORM SEWERS OR TO THE PUBLIC R.O.W. THE DEVELOPMENT SHALL NOT HAVE ANY ADVERSE IMPACTS TO SURROUNDING PROPERTIES.

TARCISIO NOGUERA, PE 19244 NW 24th COURT PEMBROKE PINES, FL 33029 tnoguera.pe@gmail.com 954-850-4288

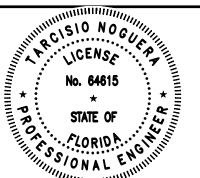

JEHOVAH'S WITNESSES CONG. OF S. MIAMI BEACH

1 | 16 AUG 21 | ZONING RESUBMITTAL - 28 JUN 21 ZONING SUBMITTAL

300 W. 40TH STREET MIAMI BEACH, FL 33140

KINGDOM HALL OF JEHOVAH'S WITNESSES 300 W. 40TH STREET MIAMI BEACH, FL 33140


GRADING PLAN

Always call 811 two full business days before you dig to have underground utilities located and marked.

Sunshine 811.com

18879

CG101

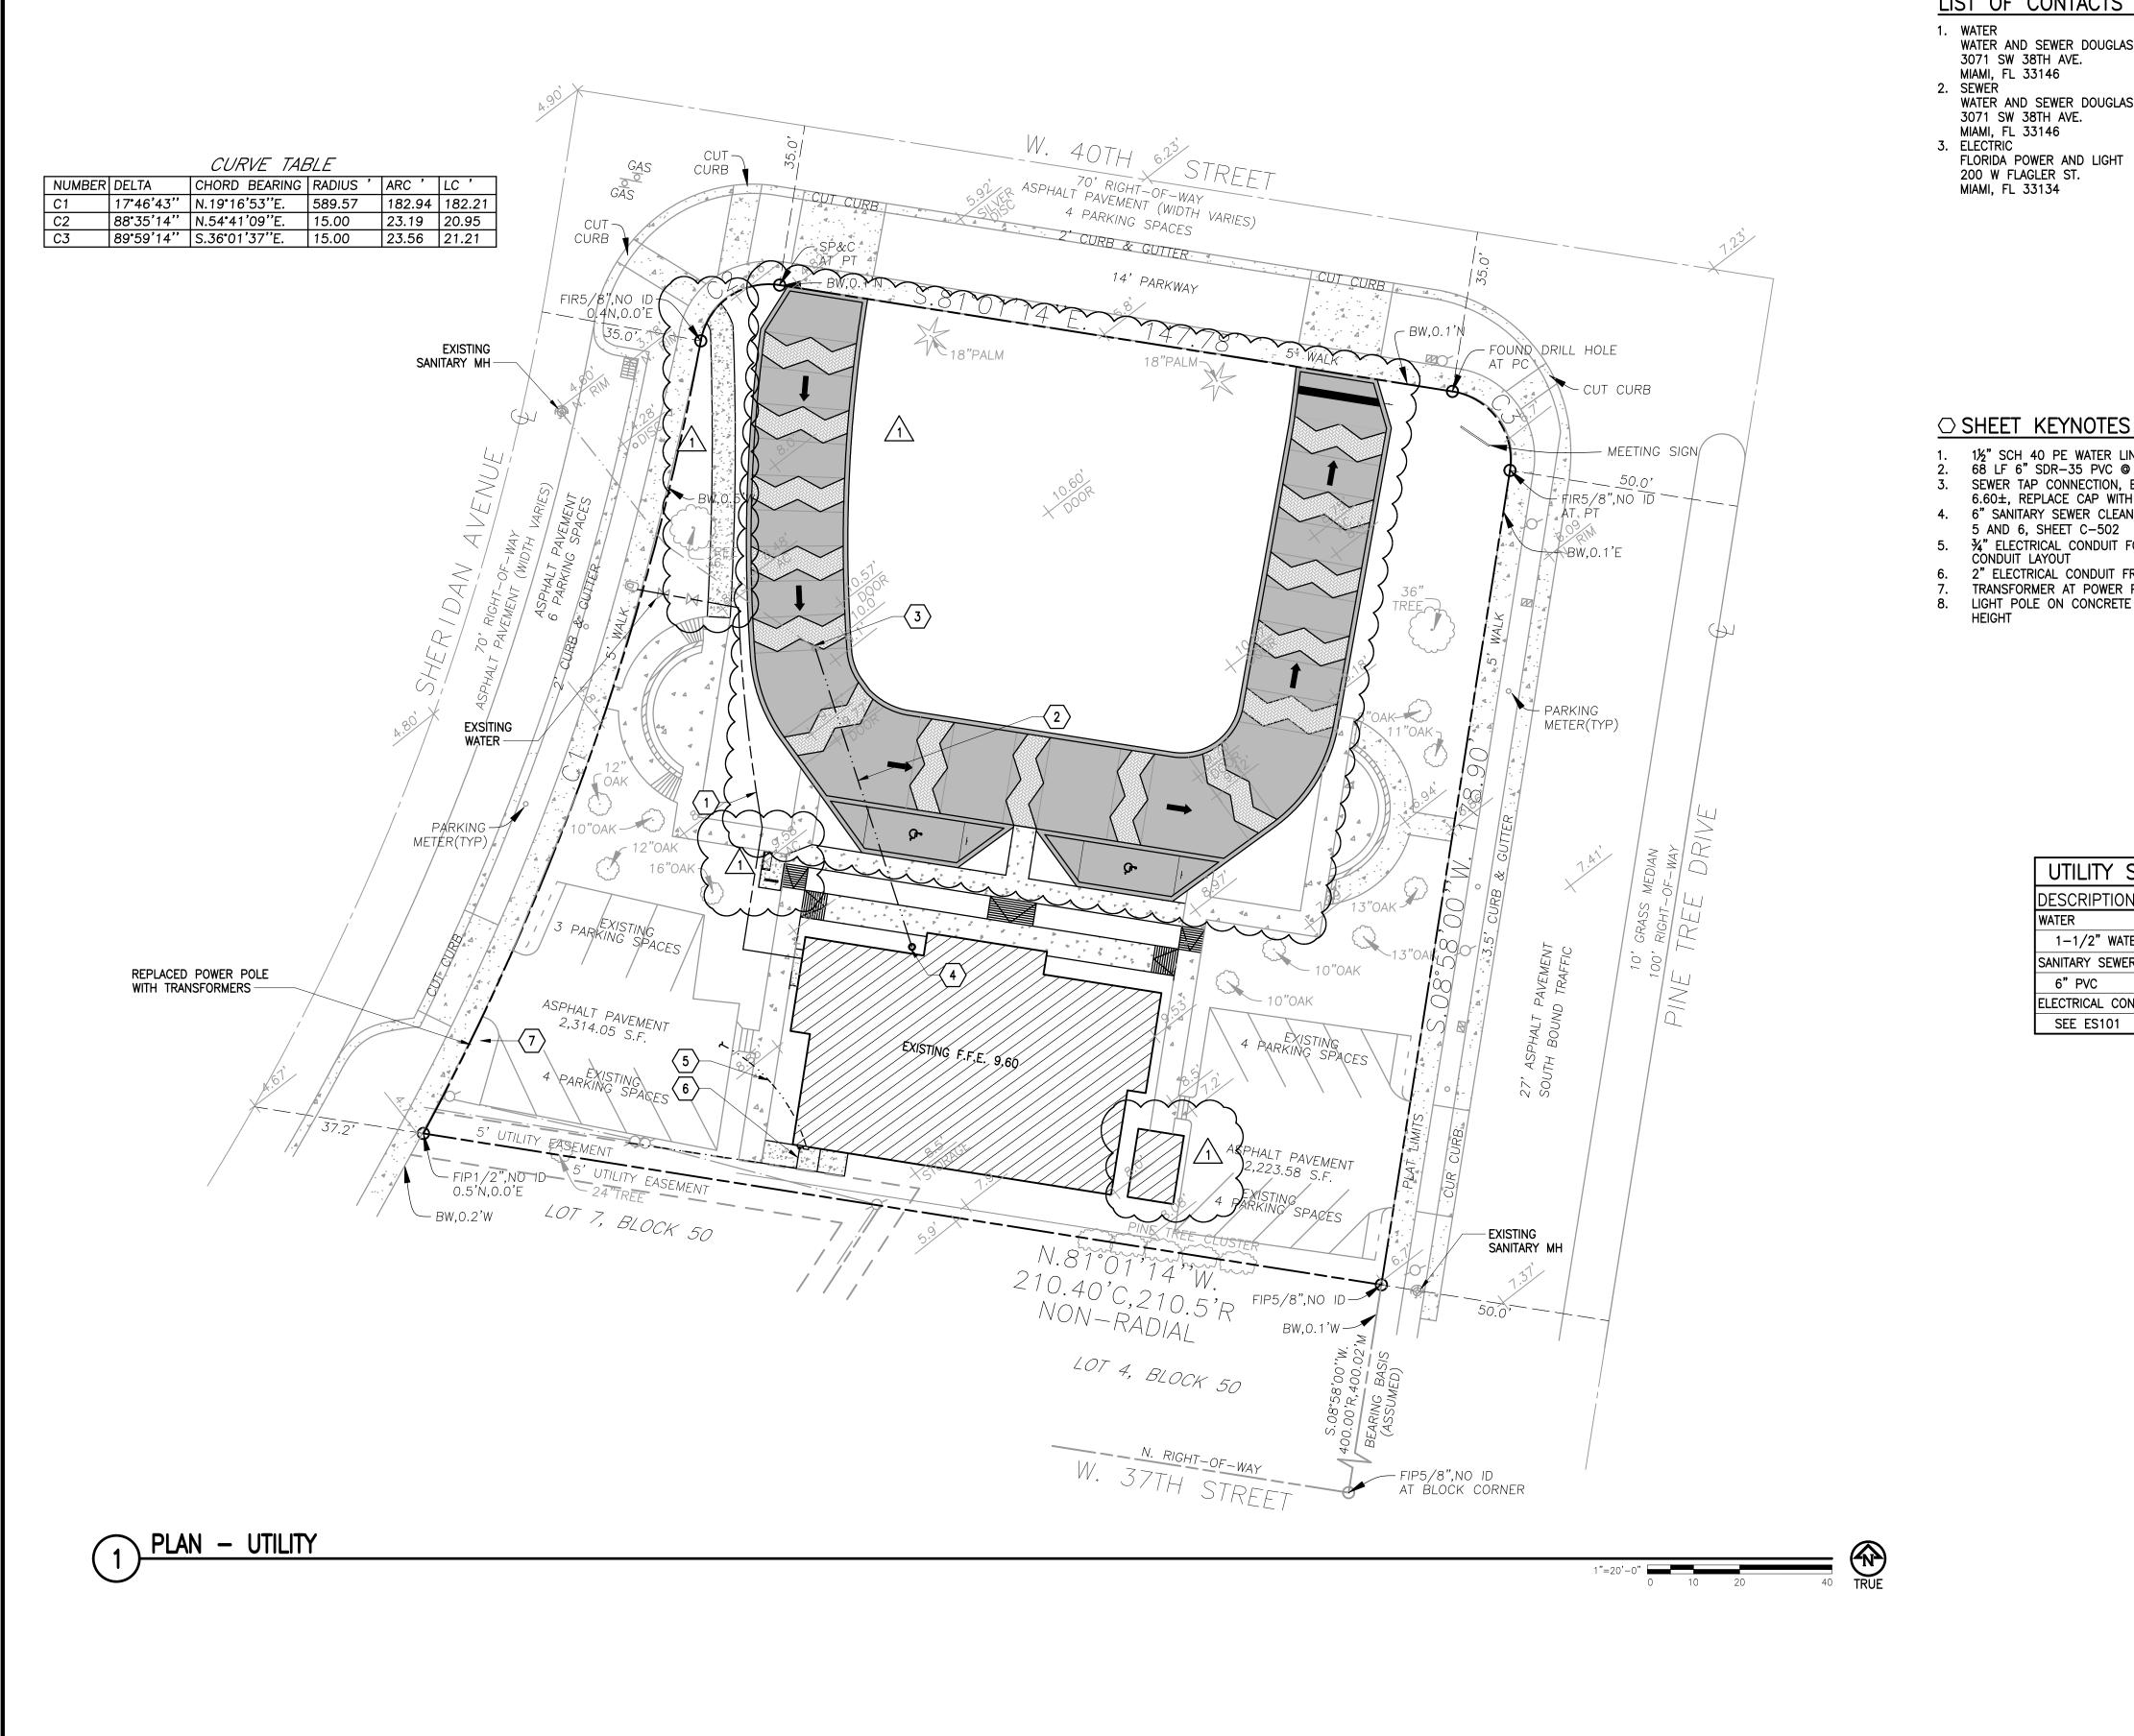

### LIST OF CONTACTS FOR UTILITY COMPANIES

- WATER AND SEWER DOUGLAS OFFICE 3071 SW 38TH AVE. MIAMI, FL 33146
- 2. SEWER WATER AND SEWER DOUGLAS OFFICE 3071 SW 38TH AVE.
- 3. ELECTRIC FLORIDA POWER AND LIGHT 200 W FLAGLER ST. MIAMI, FL 33134

MIAMI, FL 33146

- 1½" SCH 40 PE WATER LINE CONNECTION
- 68 LF 6" SDR-35 PVC @ 1.0% SEWER TAP CONNECTION, EXISTING CLEANOUT INVERT ELEVATION
- 6.60±, REPLACE CAP WITH BRASS TRAFFIC RATED CAP 4. 6" SANITARY SEWER CLEANOUT, INVERT ELEVATION 7.54, SEE DETAILS
- 34" ELECTRICAL CONDUIT FOR LIGHTING CIRCUITS. SEE ES101 FOR CONDUIT LAYOUT
- 2" ELECTRICAL CONDUIT FROM METER

5 AND 6, SHEET C-502

- TRANSFORMER AT POWER POLE LIGHT POLE ON CONCRETE BASE. SEE ES101 FOR DETAIL AND POLE

UTILITY SUMMAR	Y TABLE					
DESCRIPTION	LENGTH					
WATER						
1-1/2" WATER LINE	110 FT.					
SANITARY SEWER						
6" PVC	68 FT.					
ELECTRICAL CONDUIT						
SEE ES101						

### GENERAL UTILITY NOTES

- 1. REFER TO C-001 COVER SHEET FOR GENERAL NOTES REFERENCING SURVEY INFORMATION, DATUMS, GENERAL PROJECT AND CONSTRUCTION INFORMATION
- CONTRACTOR IS NOTIFIED THAT EXISTING UTILITIES ARE PRESENT AND UTILITY INFORMATION SHOWN ON THE PLANS HAVE BEEN COLLECTED FROM VARIOUS SOURCES AND IS NOT GUARANTEED AS TO ACCURACY OF COMPLETENESS. THE CONTRACTOR SHALL VERIFY ALL INFORMATION TO HIS SATISFACTION PRIOR TO EXCAVATION.
- 3. CONTRACTOR SHALL COORDINATE WITH ALL UTILITY COMPANIES WITHIN PROJECT LIMITS TO PREVENT DAMAGE OR IDENTIFY IF ADJUSTMENTS ARE NEEDED. CONTRACTOR SHALL NOTIFY ALL UTILITIES RELATED TO THE PROJECT AT LEAST 3 DAYS PRIOR TO CONSTRUCTION. CONTRACTOR SHALL NOT PROCEED WITH WORK IN AREAS WHERE UTILITIES HAVE NOT BEEN LOCATED AND MARKED BY UTILITY COMPANIES. FOR UTILITY MARKOUT, CALL 811.
- 4. WHERE EXISTING UTILITIES ARE TO BE CROSSED BY PROPOSED CONSTRUCTION, TEST PITS SHALL BE DUG BY THE CONTRACTOR PRIOR TO CONSTRUCTION TO CONFIRM EXISTING INVERTS, MATERIALS AND SIZES, SUCH THAT CONFLICTS MAY BE AVOIDED.
- 5. CONTRACTOR MUST VERIFY ALL EXISTING WATER, SEWER, AND STORMWATER INFRASTRUCTURE WITHIN THE PROPERTY AND PUBLIC RIGHT-OF-WAY BEFORE ORDERING STRUCTURES OR CONNECTING TO EXISTING LINES. CONFIRMATION MUST INCLUDE ALL HORIZONTAL AND VERTICAL LOCATIONS.
- 6. UNLESS OTHERWISE NOTED, MAINTAIN 6 INCHES OF VERTICAL CLEARANCE (MINIMUM) AT CROSSINGS BETWEEN ALL UNDERGROUND CONDUITS.
- REFER TO ELECTRICAL SITE PLAN FOR ELECTRICAL CONDUIT SPECIFICATIONS

### WATER UTILITY NOTES

- 1. WATER CONSTRUCTION NOTES SHALL APPLY TO THE ON-SITE, DOMESTIC FROM FIVE FEET OUTSIDE THE BUILDING TO THE METER OR SERVICE CONNECTION.
- 2. ALL WATER LINE CONSTRUCTION AND TESTING SHALL CONFORM TO THE REQUIREMENTS OF WASAD.
- 3. SEPARATION DISTANCES FOR ALL WATER MAIN AND SANITARY SEWER MAIN CONSTRUCTION SHALL BE IN ACCORDANCE WITH THE SPECIFICATIONS, WASAD (LATEST PRINTING).
- 4. ALL WATER LINES SHALL BE CONSTRUCTED ABOVE SANITARY SEWERS AT ALL CROSSINGS. ALL WATER LINES SHALL BE CONSTRUCTED WITH A MINIMUM OF 36" FROM SEWER LINES. WHEN POTABLE WATER LINES PASS UNDERNEATH SEWER LINES, AN EIGHTEEN-FOOT LONG, CONTINUOUS JOINT OF WATER LINE SHALL BE CENTERED AT ALL CROSSINGS WITH SANITARY SEWERS.
- 5. SPECIFICATIONS: DOMESTIC WATER SERVICE:
- 3/4" TO 2" USE PEX TUBING IN ACCORDANCE WITH ASTM F876
- 6. THE CONTRACTOR SHALL NOT OPERATE ANY VALVES OR PRESSURE TEST AGAINST ANY COUNTY/CITY INSTALLED VALVES OR FITTINGS.


CISIO NOGUL

TARCISIO NOGUERA, PE

19244 NW 24th COURT

PEMBROKE PINES, FL 33029

tnoguera.pe@gmail.com 954-850-4288

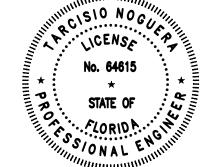

1 | 16 AUG 21 ZONING RESUBMITTAL - 28 JUN 21 ZONING SUBMITTAL

JEHOVAH'S WITNESSES CONG. OF S. MIAMI BEACH

300 W. 40TH STREET MIAMI BEACH, FL 33140


KINGDOM HALL OF JEHOVAH'S WITNESSES 300 W. 40TH STREET

MIAMI BEACH, FL 33140

UTILITY PLAN

Always call 811 two full business days before you dig to have underground utilities located and marked. Sunshine 811.com


18879

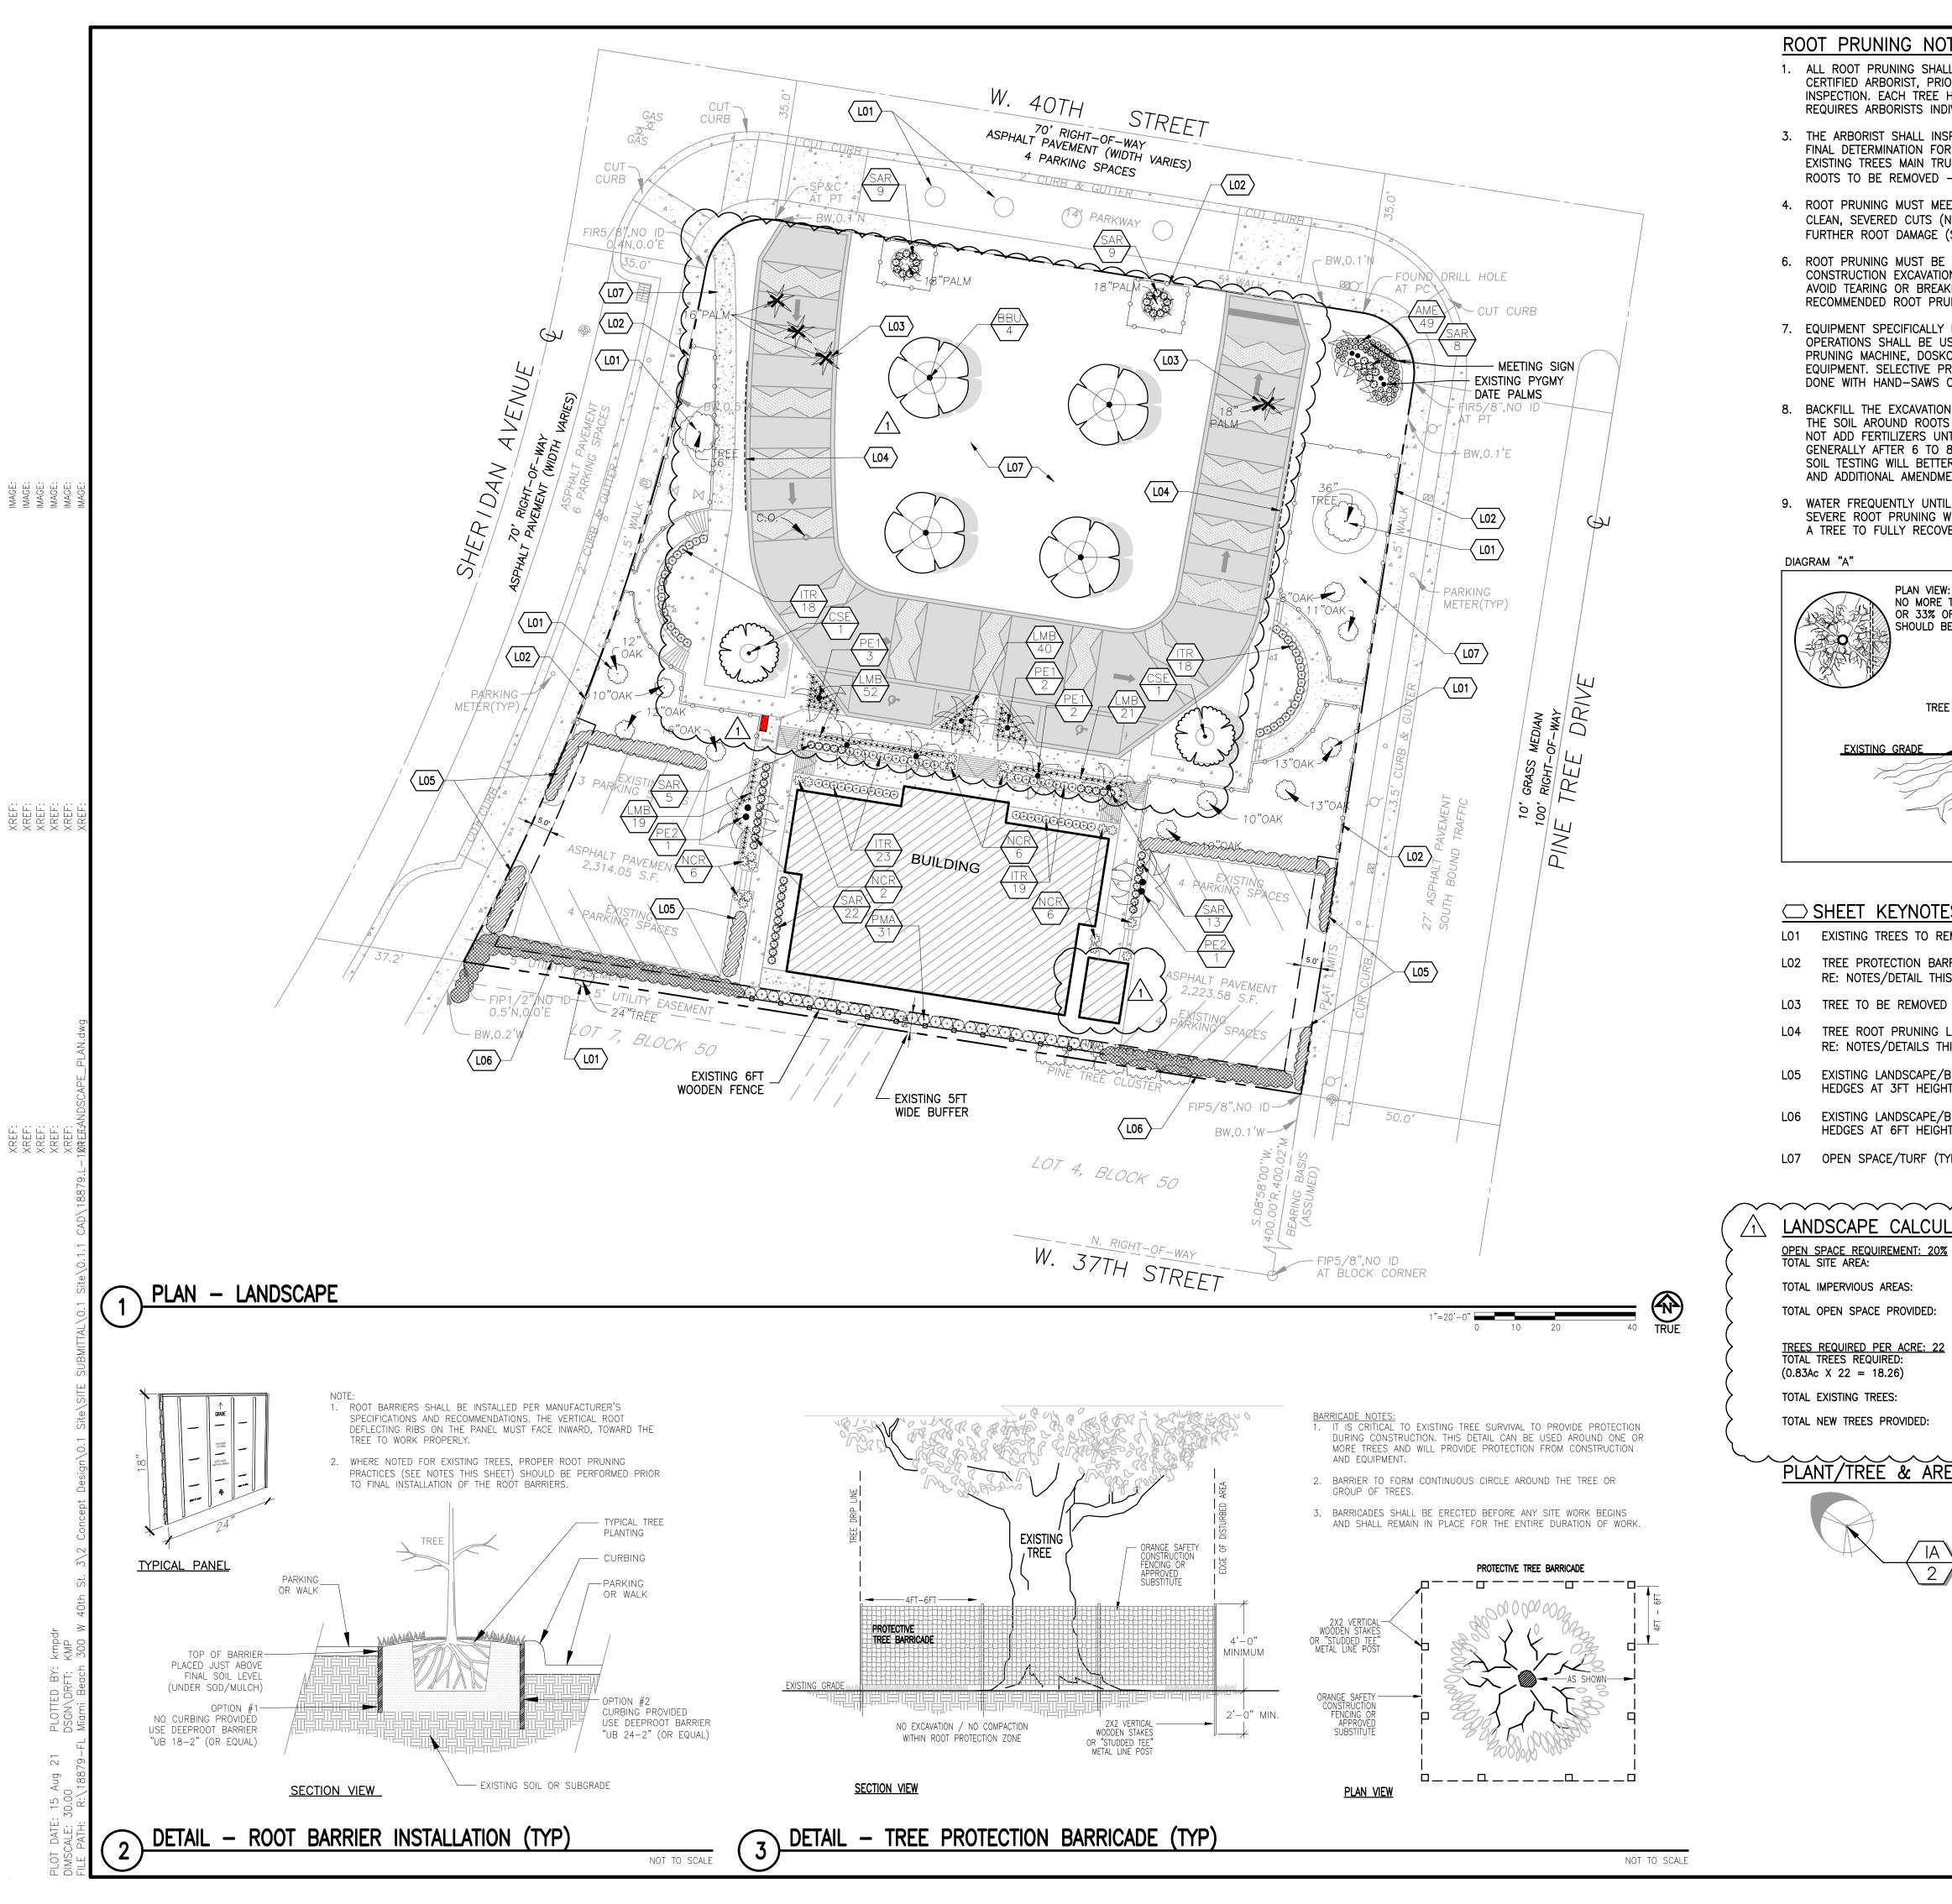

### ROOT PRUNING NOTES

- 1. ALL ROOT PRUNING SHALL BE OVERSEEN AND APPROVED BY A CERTIFIED ARBORIST, PRIOR TO THE PRE-CONSTRUCTION SITE INSPECTION. EACH TREE HAS A DIFFERENT ROOT SYSTEM AND REQUIRES ARBORISTS INDIVIDUAL ANALYSIS AND TREATMENT.
- 3. THE ARBORIST SHALL INSPECT THE TREES NOTED AND MAKE THE FINAL DETERMINATION FOR ALLOWABLE DISTANCES FROM THE EXISTING TREES MAIN TRUNK OR ROOT CROWN, AND AMOUNT OF ROOTS TO BE REMOVED -BASED ON TREE SIZE/HEALTH.
- 4. ROOT PRUNING MUST MEET ALL ANSI A300 STANDARDS, MUST BE CLEAN, SEVERED CUTS (NOT JAGGED, FRAYED, ETC.) TO AVOID FURTHER ROOT DAMAGE (SEE DIAGRAM A).
- ROOT PRUNING MUST BE PERFORMED PRIOR TO ANY CONSTRUCTION EXCAVATION, GRADING OR OTHER ACTIVITIES, TO AVOID TEARING OR BREAKING ROOTS FURTHER THAN THE RECOMMENDED ROOT PRUNING LIMITS.
- 7. EQUIPMENT SPECIFICALLY DESIGNED FOR ROOT PRUNING OPERATIONS SHALL BE USED SUCH AS VERMEER 50TX ROOT PRUNING MACHINE, DOSKO ROOT PRUNER, OR APPROVED EQUAL EQUIPMENT. SELECTIVE PRUNING OF INDIVIDUAL ROOTS MAY BE DONE WITH HAND-SAWS OR CHAIN SAWS WITH CARBIDE BLADES.
- 8. BACKFILL THE EXCAVATION AS SOON AS POSSIBLE AND WATER THE SOIL AROUND ROOTS TO AVOID LEAVING AIR POCKETS. DO NOT ADD FERTILIZERS UNTIL IMPROVED TREE GROWTH IS NOTICED, GENERALLY AFTER 6 TO 8 WEEKS DURING A GROWING SEASON. SOIL TESTING WILL BETTER DETERMINE IF SOIL DEFICIENCIES EXIST AND ADDITIONAL AMENDMENTS MAY BE NEEDED.
- 9. WATER FREQUENTLY UNTIL THE TREE BECOMES WELL ESTABLISHED. SEVERE ROOT PRUNING WILL REQUIRE 6 MONTHS TO A YEAR FOR A TREE TO FULLY RECOVER.

### DIAGRAM "A"

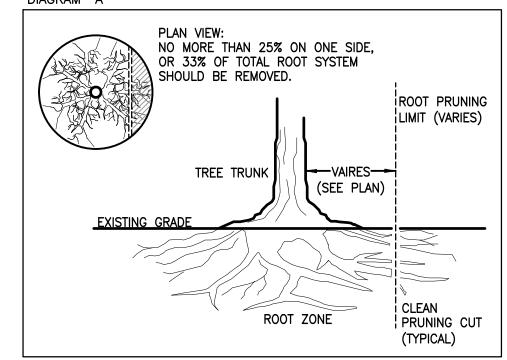

### $\Longrightarrow$ SHEET KEYNOTES

- LO1 EXISTING TREES TO REMAIN
- LO2 TREE PROTECTION BARRICADES AT EXISTING LIMITS RE: NOTES/DETAIL THIS SHEET
- LO3 TREE TO BE REMOVED
- LO4 TREE ROOT PRUNING LINE & ROOT BARRIER INSTALL RE: NOTES/DETAILS THIS SHEET
- LO5 EXISTING LANDSCAPE/BUFFER TO REMAIN HEDGES AT 3FT HEIGHT
- LO6 EXISTING LANDSCAPE/BUFFER TO REMAIN HEDGES AT 6FT HEIGHT
- LO7 OPEN SPACE/TURF (TYPICAL)

### LANDSCAPE CALCULATIONS

OPEN SPACE REQUIREMENT: 20% TOTAL SITE AREA:

36,065.00 sf 0.83 Ac. 100.0% 19,261.51 sf 0.44 Ac. 53.4% TOTAL IMPERVIOUS AREAS:


16,803.49 sf 0.39 Ac. 46.6%

TOTAL OPEN SPACE PROVIDED:

(0.83Ac X 22 = 18.26)

TOTAL EXISTING TREES:

# PLANT/TREE & AREA LABELING

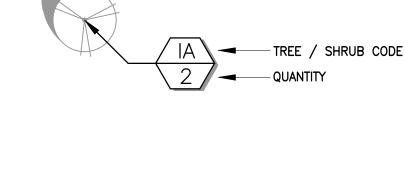

### GENERAL SITE & LANDCAPE NOTES

- . <u>SITE NOTES:</u>
  A. REFER TO CIVIL DEMO PLAN FOR ANY TREE REMOVALS. AND CIVIL SITE PLANS AND NOTES FOR ALL DETAILED INFORMATION REGARDING SURVEY, EXISTING AND PROPOSED UTILITIES, GENERAL PROJECT, AND SITE CONSTRUCTION INFORMATION.
  - B. EXISTING TREES WITHIN AND ADJACENT TO THE LIMITS OF CONSTRUCTION AND SPECIFIED TO REMAIN ARE TO BE PROTECTED THROUGHOUT CONSTRUCTION PER LOCAL REGULATORY AGENCY REGULATIONS. SO THAT NO DAMAGE WILL BE CAUSED BY OPERATION OF EQUIPMENT, STOCKPILING OF MATERIALS, COMPACTION OF ROOT ZONE. DRIVING OR PARKING WITHIN DRIPLINE OF TREES, OR THE SPILLAGE OF DELETERIOUS CHEMICALS, OILS, DIESEL, ETC. WITHIN THE DRIPLINE OF TREES.
  - C. THE CONTRACTOR SHALL BE FULLY ACQUAINTED WITH THE RELATED PAVING, SITE GRADING, WATER SUPPLY, ELECTRICAL SUPPLY, AND OTHER UTILITIES TO PREVENT ANY MISUNDERSTANDING AND TO FACILITATE A TROUBLE FREE INSTALLATION. CALL THE SUNSHINE STATE ONE CALL 811 PRIOR TO ANY CONSTRUCTION FOR UTILITY COORDINATION. IN ADDITION. NOTIFY THE OWNER'S REPRESENTATIVE A MINIMUM OF 72 HOURS IN ADVANCE OF CONSTRUCTION TO IDENTIFY UTILITY LINE LOCATIONS.
  - D. THE CONTRACTOR IS RESPONSIBLE FOR REPAIRING ANY DAMAGES TO EXISTING FACILITIES THAT MAY RESULT FROM WORK PERFORMED BY THE CONTRACTOR.
  - E. IF THE WORK PERFORMED UNDER THIS CONTRACT WILL INTERFACE WITH OTHER WORK BEING PERFORMED BY OTHER CONTRACTORS. IT WILL BE REQUIRED FOR THE CONTRACTOR TO COORDINATE AND SCHEDULE ACTIVITIES WITH OTHER CONTRACTORS AND THEIR SUBCONTRACTORS IN ORDER TO AVOID CONFLICTS.
  - F. PRIOR TO ANY PLANTING THE CONTRACTOR SHALL ENSURE NO ROAD/ASPHALT BASE, OR OVERLY COMPACTED SUB-GRADE IS PRESENT IN PARKING AREA ISLANDS (SUCH AS HARD PAN LAYER). IF NECESSARY ANY SUCH AREAS SHALL BE EXCAVATED TO REMOVE HARD PAN, CONSTRUCTION DEBRIS, OR UNSUITABLE SOIL, AND PROPER PLANTING SOIL BE PROVIDED AT A DEPTH APPROPRIATE FOR THE SPECIFIED PLANTINGS NOTED ON THESE PLANS.
  - G. ALL LANDSCAPE AREAS TO BE CLEARED OF ROCKS. STUMPS. TRASH AND OTHER UNSIGHTLY DEBRIS. ALL FINE GRADED AREAS SHOULD BE HAND RAKED SMOOTH ELIMINATING ANY CLUMPS AND UNEVEN SURFACES PRIOR TO PLANTING OR MULCHING.
  - H. THE CONTRACTOR SHALL ENSURE PROPER SURFACE DRAINAGE AND PERCOLATION OF ALL LANDSCAPE PLANTING BEDS, AND PARKING AREA LANDSCAPE ISLANDS. THE FINAL GRADE PROVIDED SHALL ENSURE POSITIVE DRAINAGE AWAY FROM PLANTING BEDS, AWAY FROM BUILDING STRUCTURES, AND INTO TURF AREAS, PONDS, PARKING OR OTHER ON-SITE AREAS DESIGNATED AS DRAINAGE WAYS.
  - I. THE CONTRACTOR SHALL BE RESPONSIBLE FOR THE FINAL STAKING OF TREES BASED ON SITE CONDITIONS, TO PROVIDE FOR THE STABILITY OF THE TREE AND MATERIALS AND TO PROTECT THE HEALTH AND SAFETY OF THE PUBLIC/PROPERTY.
  - 2. <u>PLANTING NOTES:</u> A. PLANT MATERIALS USED TO MEET THE REQUIREMENTS OF THIS PLAN MUST MEET THE STANDARDS FOR FLORIDA NO. 1 OR BETTER, AS SET OUT IN GRADES AND STANDARDS FOR NURSERY PLANTS, PARTS I AND II, DEPARTMENT OF AGRICULTURAL, STATE OF FLORIDA (AS AMENDED). ROOT BALL SIZES ON ALL TRANSPLANTED PLANT MATERIALS MUST ALSO MEET THESE STANDARDS. REFER TO PLANT LIST FOR ANY FURTHER QUALITY SPECIFICATIONS.
  - B. PLANTING OF ALL TREES AND SHRUBS SHALL BE IN ACCORDANCE WITH THE FLORIDA NURSERYMEN'S AND GROWER'S ASSOCIATION APPROVED PRACTICES. WITH THE PREFERENCE GIVEN TO ANY GRAPHIC DETAILS PROVIDED WITHIN THESE PLANS.
  - C. ALL PLANTINGS SHOULD BE PLACED TO AVOID CONFLICTS WITH UNDERGROUND, ABOVEGROUND, EXISTING AND PROPOSED UTILITIES. AS WELL AS ANY SIGNAGE, PEDESTRIAN TRAFFIC, VIEW CORRIDORS AROUND PARKING AREAS AND ISLANDS. TAKING SPECIAL NOTE OF SIGHT VIEW TRIANGLES WHERE DRIVEWAYS MEET PUBLIC ROADWAYS. FOLLOWING THE LOCAL CODE, OR FDOT INDEX 546, WHICHEVER PROVES TO BE MORE RESTRICTIVE OF PLANTINGS.
  - D. NO PLANTINGS OR IRRIGATION SHOULD BE PLACED DIRECTLY AGAINST BUILDINGS. IN ORDER TO AVOID ANY MOISTURE ISSUES. THIS SHOULD BE COORDINATED CLOSELY WITH THE IRRIGATION CONTRACTOR TO MAINTAIN DESIRED CLEARANCE AS SPECIFIED ON THESE PLANTING
  - E. NO PLANT SHALL BE PUT INTO THE GROUND BEFORE ROUGH GRADING HAS BEEN COMPLETED.
  - F. ALL FENCE OR GUIDE RAIL INSTALLATIONS SHALL BE COMPLETED PRIOR TO STARTING ANY LANDSCAPE PLANTING, LAWN, GRASSES OR IRRIGATION
  - G. NO SUBSTITUTIONS SHALL BE MADE WITHOUT THE WRITTEN PERMISSION OF THE OWNER/REPRESENTATIVE, AND/OR LOCAL JURISDICTION (AS APPLICABLE) PRIOR TO INSTALLATION OF SUCH MATERIALS.
  - H. IN THE EVENT DISCREPANCIES ARE NOTED BETWEEN THE MATERIALS LIST AND THE ACTUAL NUMBER OF PLANTS SHOWN ON THE PLANS, THE GRAPHIC PLANS SHALL CONTROL. PLEASE NOTIFY OWNER/REPRESENTATIVE IMMEDIATELY WHEN DISCREPANCIES ARE DISCOVERED.
  - ALL PLANTING BEDS AND TREE RINGS SHALL RECEIVE A MINIMUM OF 3-INCHES OR ORGANIC MULCH. FINAL GRADE OF MULCH SHALL MEET ANY HARDSCAPE, CURBING, SIDEWALKS, OR TURF AREAS AT 1-2 INCHES BELOW FINAL GRADE.
  - J. ALL OTHER EXPOSED GROUND SURFACES THAT ARE NOT PAVED WITHIN THE LIMIT OF DISTURBANCE LINE AND THAT ARE NOT COVERED BY LANDSCAPE PLANTING OR SEEDING/TURF AS SPECIFIED, SHALL BE COVERED BY A ORGANIC MULCH THAT WILL PREVENT SOIL EROSION AND THE RELEASE OF DUST.
  - K. A HORTICULTURAL SOIL ANALYSIS SHALL MADE FOR ANY NEW LANDSCAPE AREAS, TO ENSURE THE P.H. AND NUTRIENTS ARE SUFFICIENT FOR THE PLANTS SELECTED FOR USE ON THIS PLANTING PLAN. USING A LOCAL UF/IFAS EXTENSION OFFICE, OR OTHER DEPENDABLE SOIL TESTING LABORATORY. RESULTS SHALL BE SUBMITTED TO OWNER/REPRESENTATIVE, AND SOIL AMENDMENTS ADJUSTMENTS MADE BASED ON THE LAB RECOMMENDATIONS FOR LONG TERM PLANT HEALTH AND VITALITY.
  - L. ALL PLANTS SHALL BE WATERED THOROUGHLY TWICE DURING THE FIRST 24 HOUR PERIOD AFTER PLANTING. ALL PLANTS SHALL THEN BE WATERED WEEKLY OR AS REQUIRED BY SITE AND WEATHER CONDITIONS TO MAINTAIN VIGOROUS AND HEALTHY PLANT GROWTH. CONTRACTOR MAY NEED TO ADJUST QUANTITY AND FREQUENCY OF WATERING TO ENSURE PROPER ESTABLISHMENT.
  - M. NEW PLANT MATERIAL SHALL BE GUARANTEED TO BE ALIVE AND IN VIGOROUS GROWING CONDITION FOR A PERIOD OF TWO YEARS FOLLOWING ACCEPTANCE BY THE OWNER.

Always call 811 two full business days before you dig to have underground utilities located and marked.



JEHOVAH'S WITNESSES CONG. OF S. MIAMI BEACI 300 W. 40TH STREET MIAMI BEACH, FL 33140

16 AUG 21 ZONING RESUBMITTAL


- 28 JUN 21 ZONING SUBMITTAL


K: DATE: DESCRIPTION:


KINGDOM HALL OF JEHOVAH'S WITNESSES 300 W. 40TH STREET MIAMI BEACH, FL 33140


> LANDSCAPE PLAN


18879

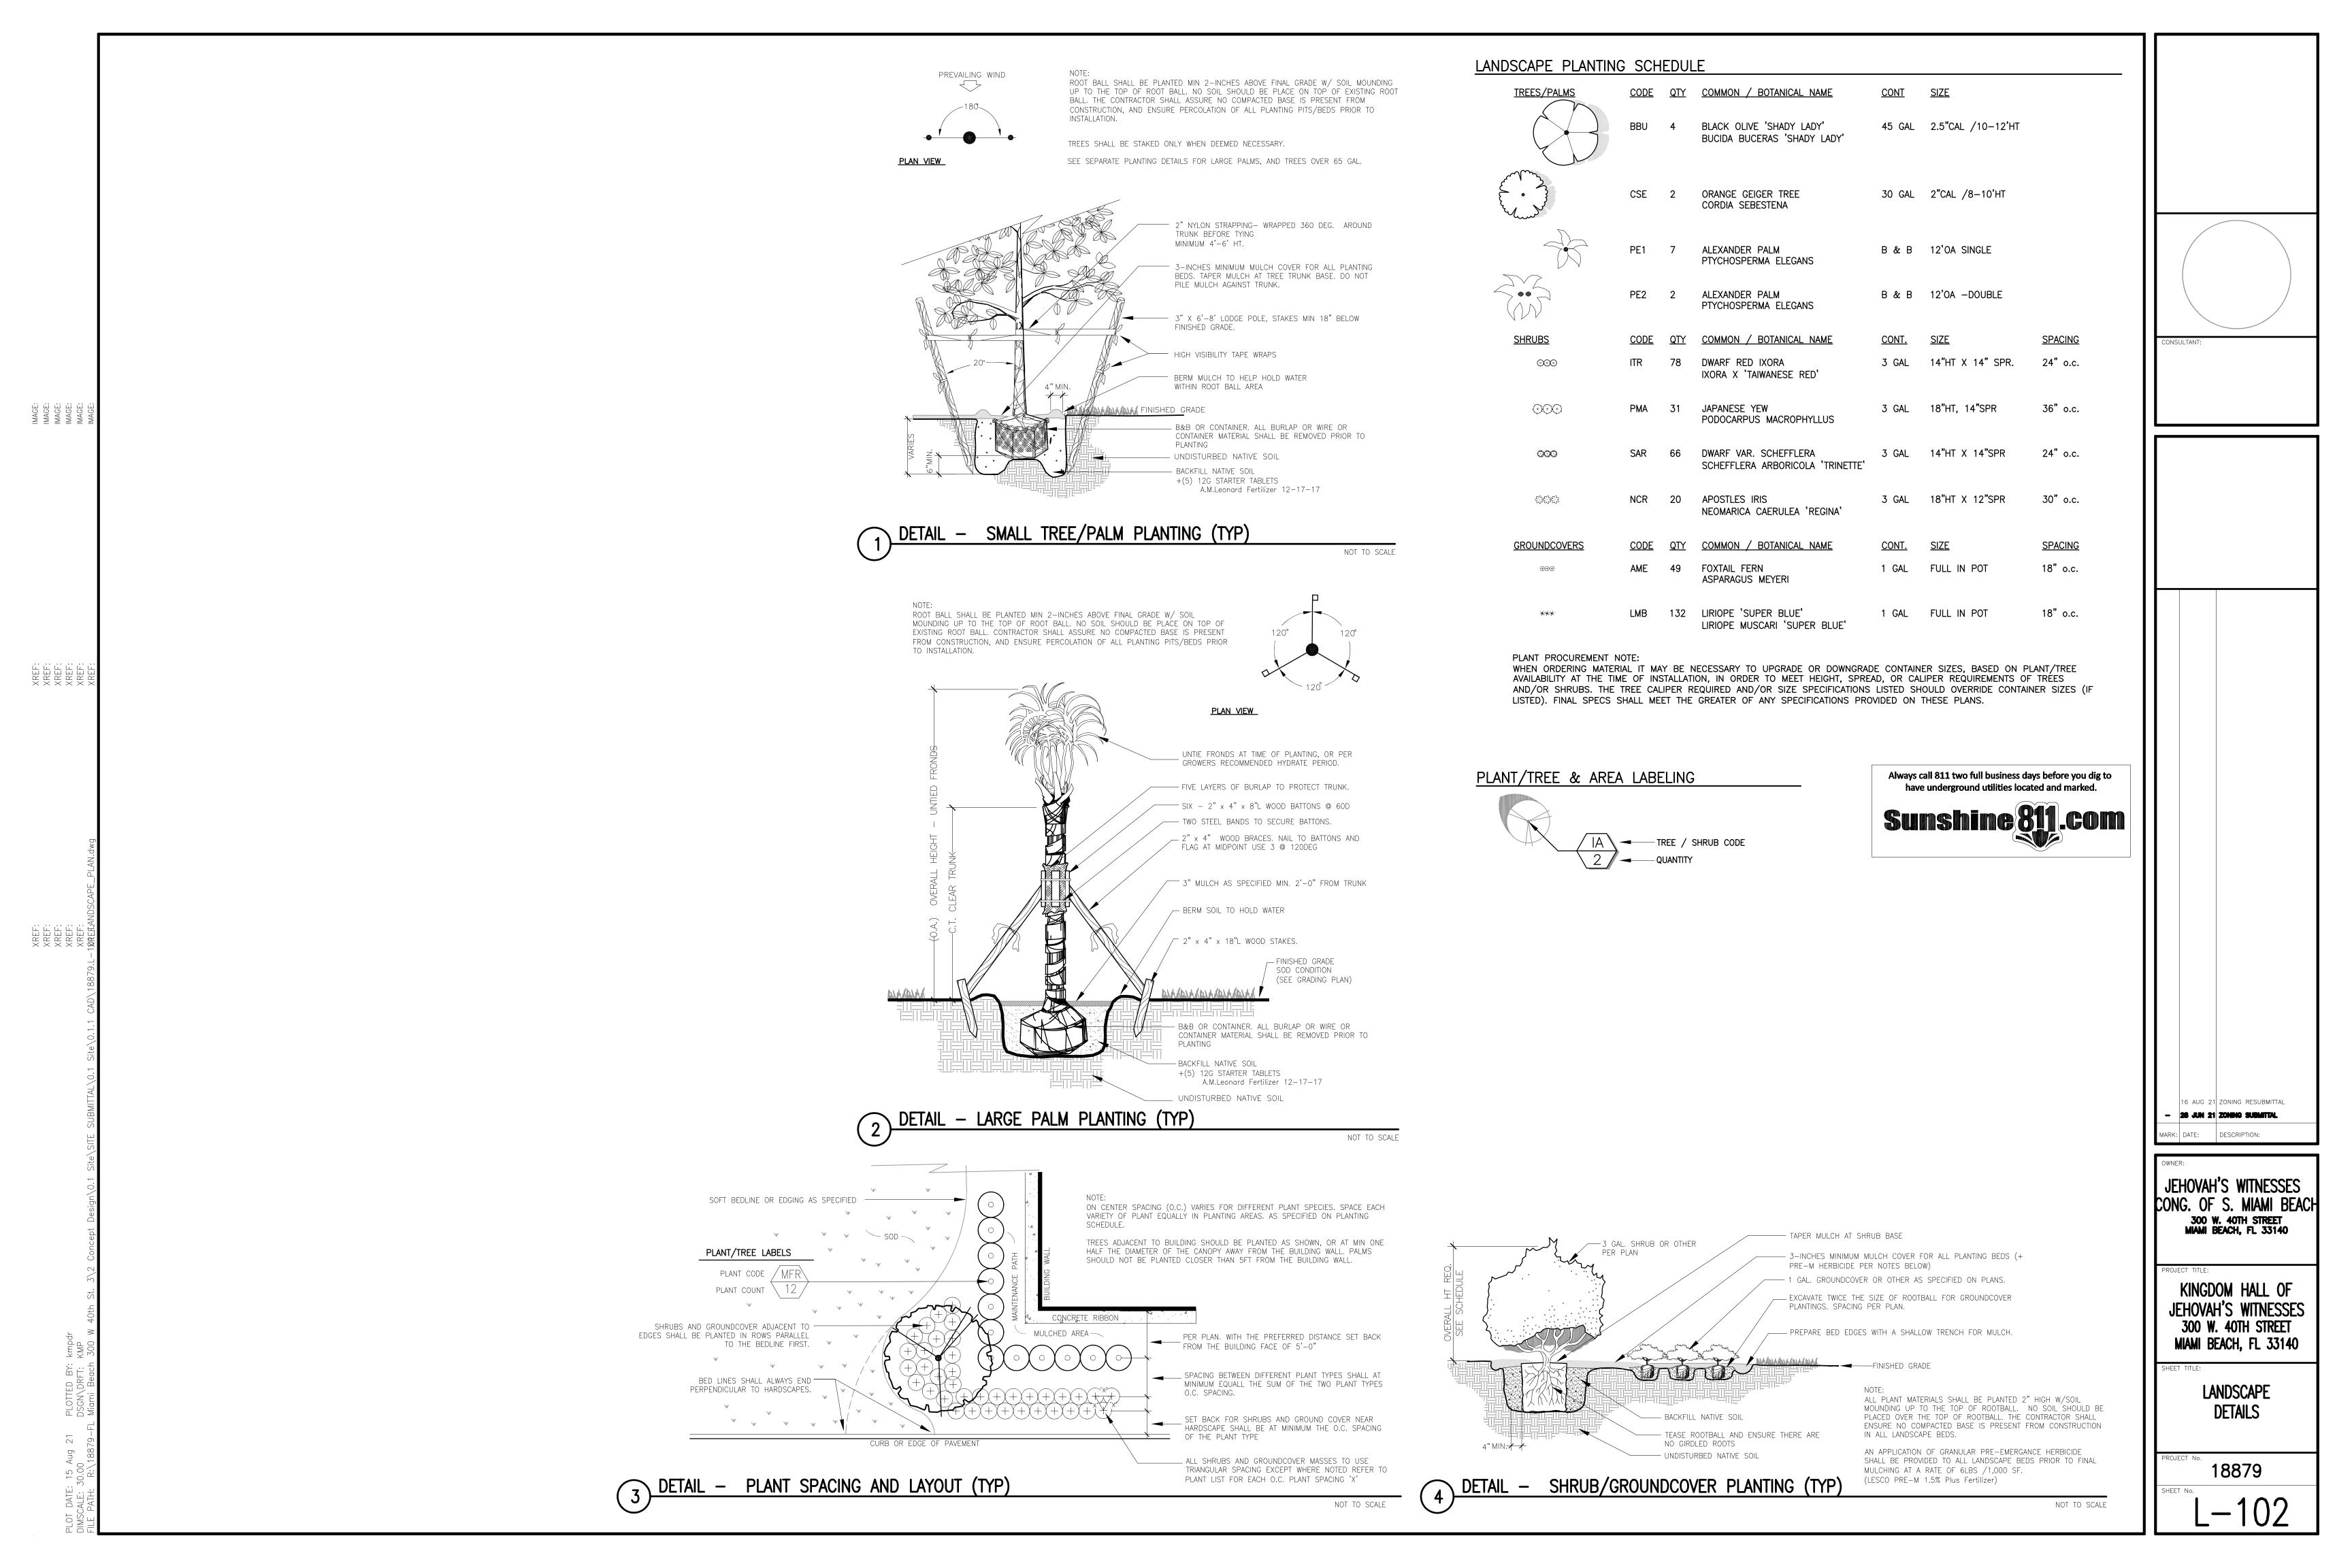


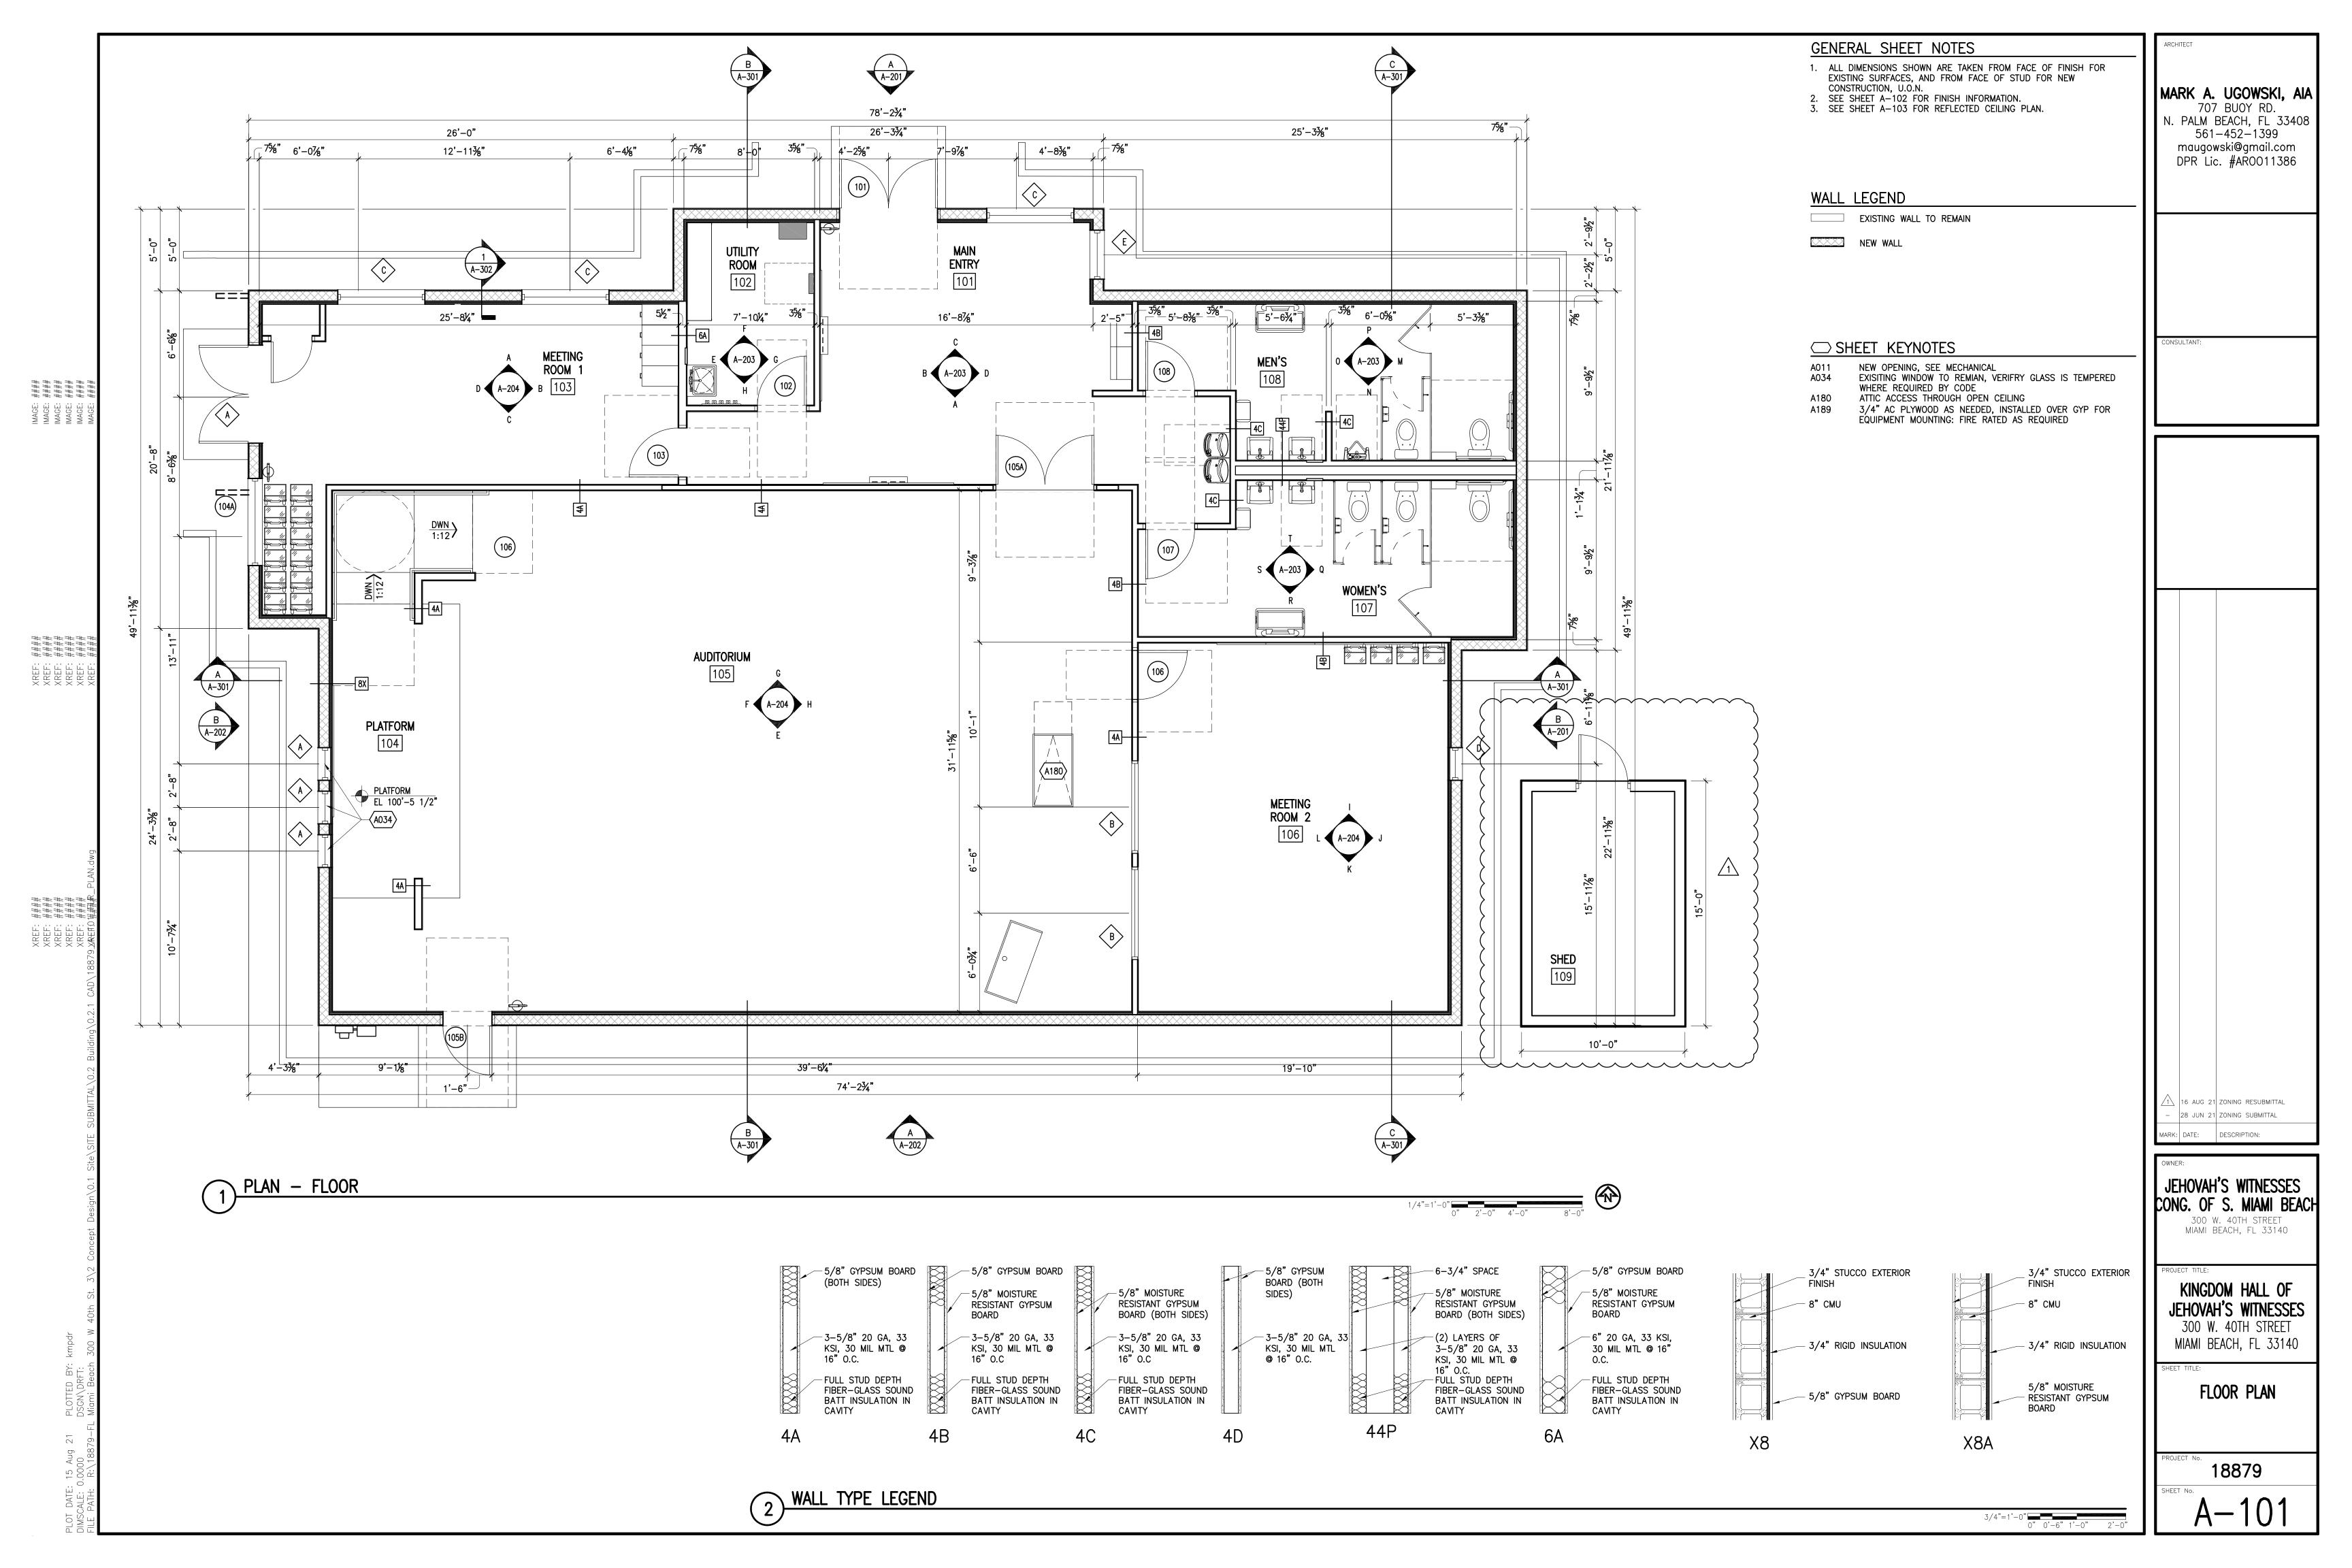

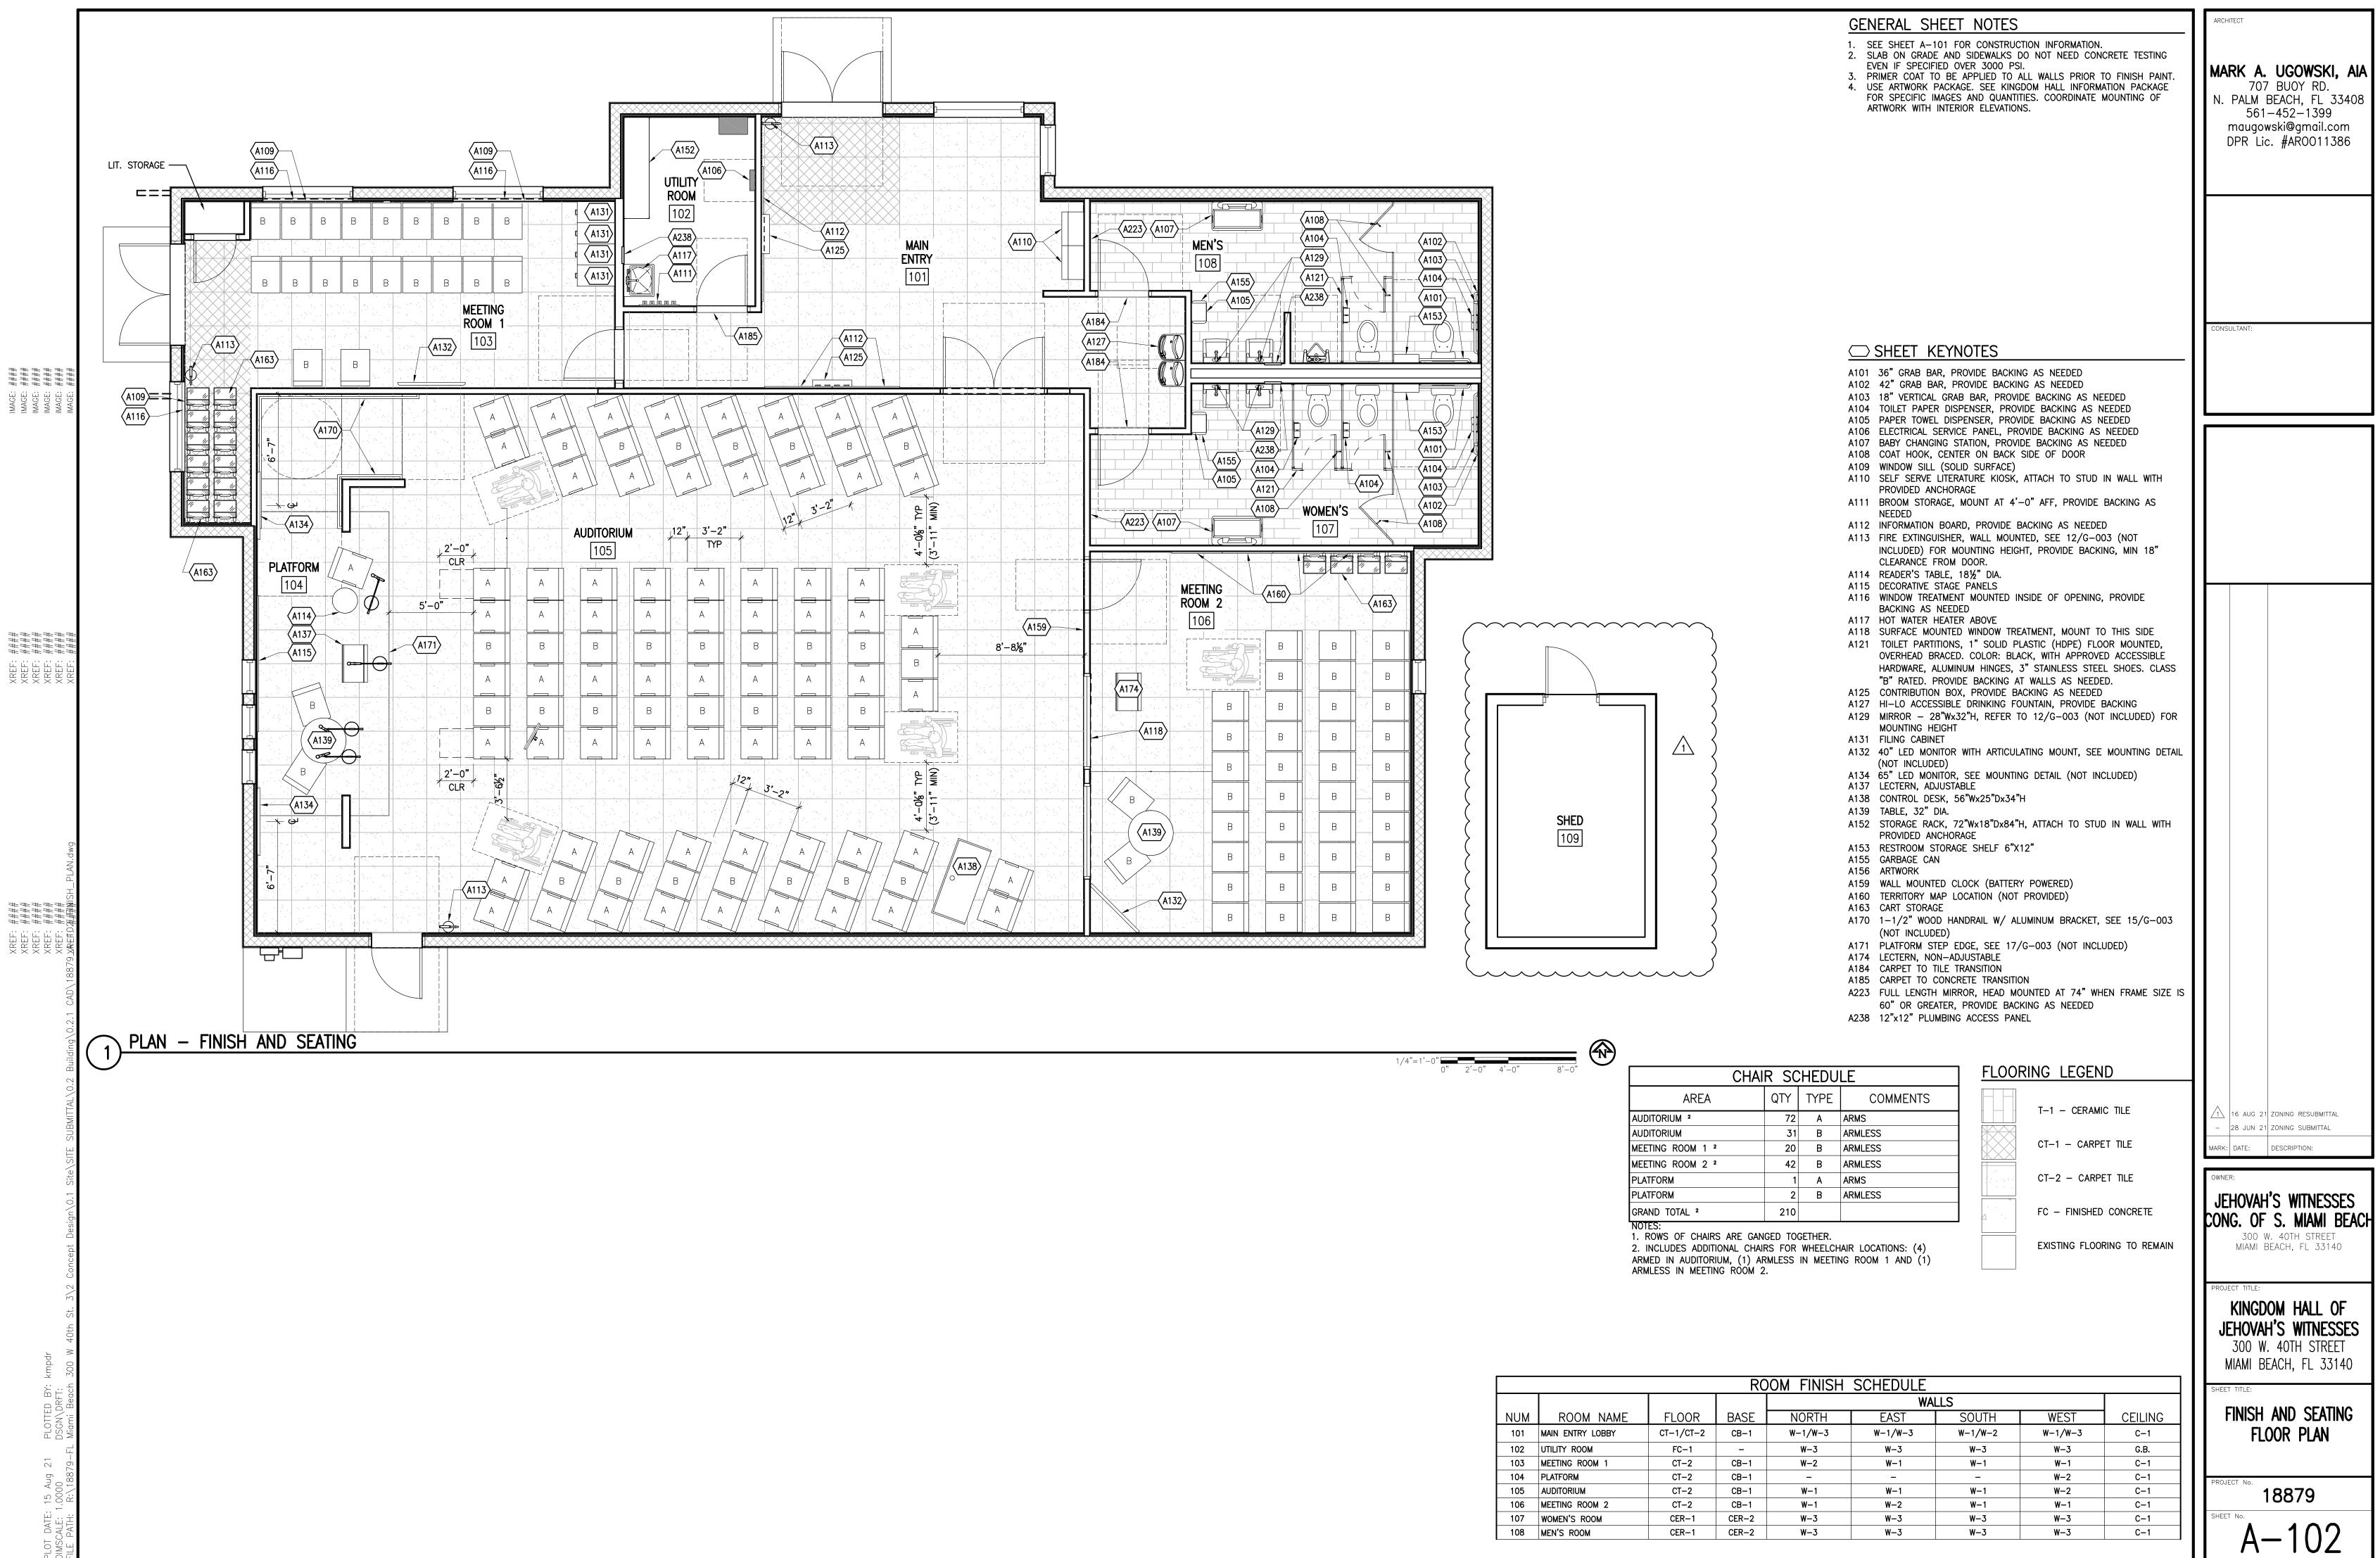

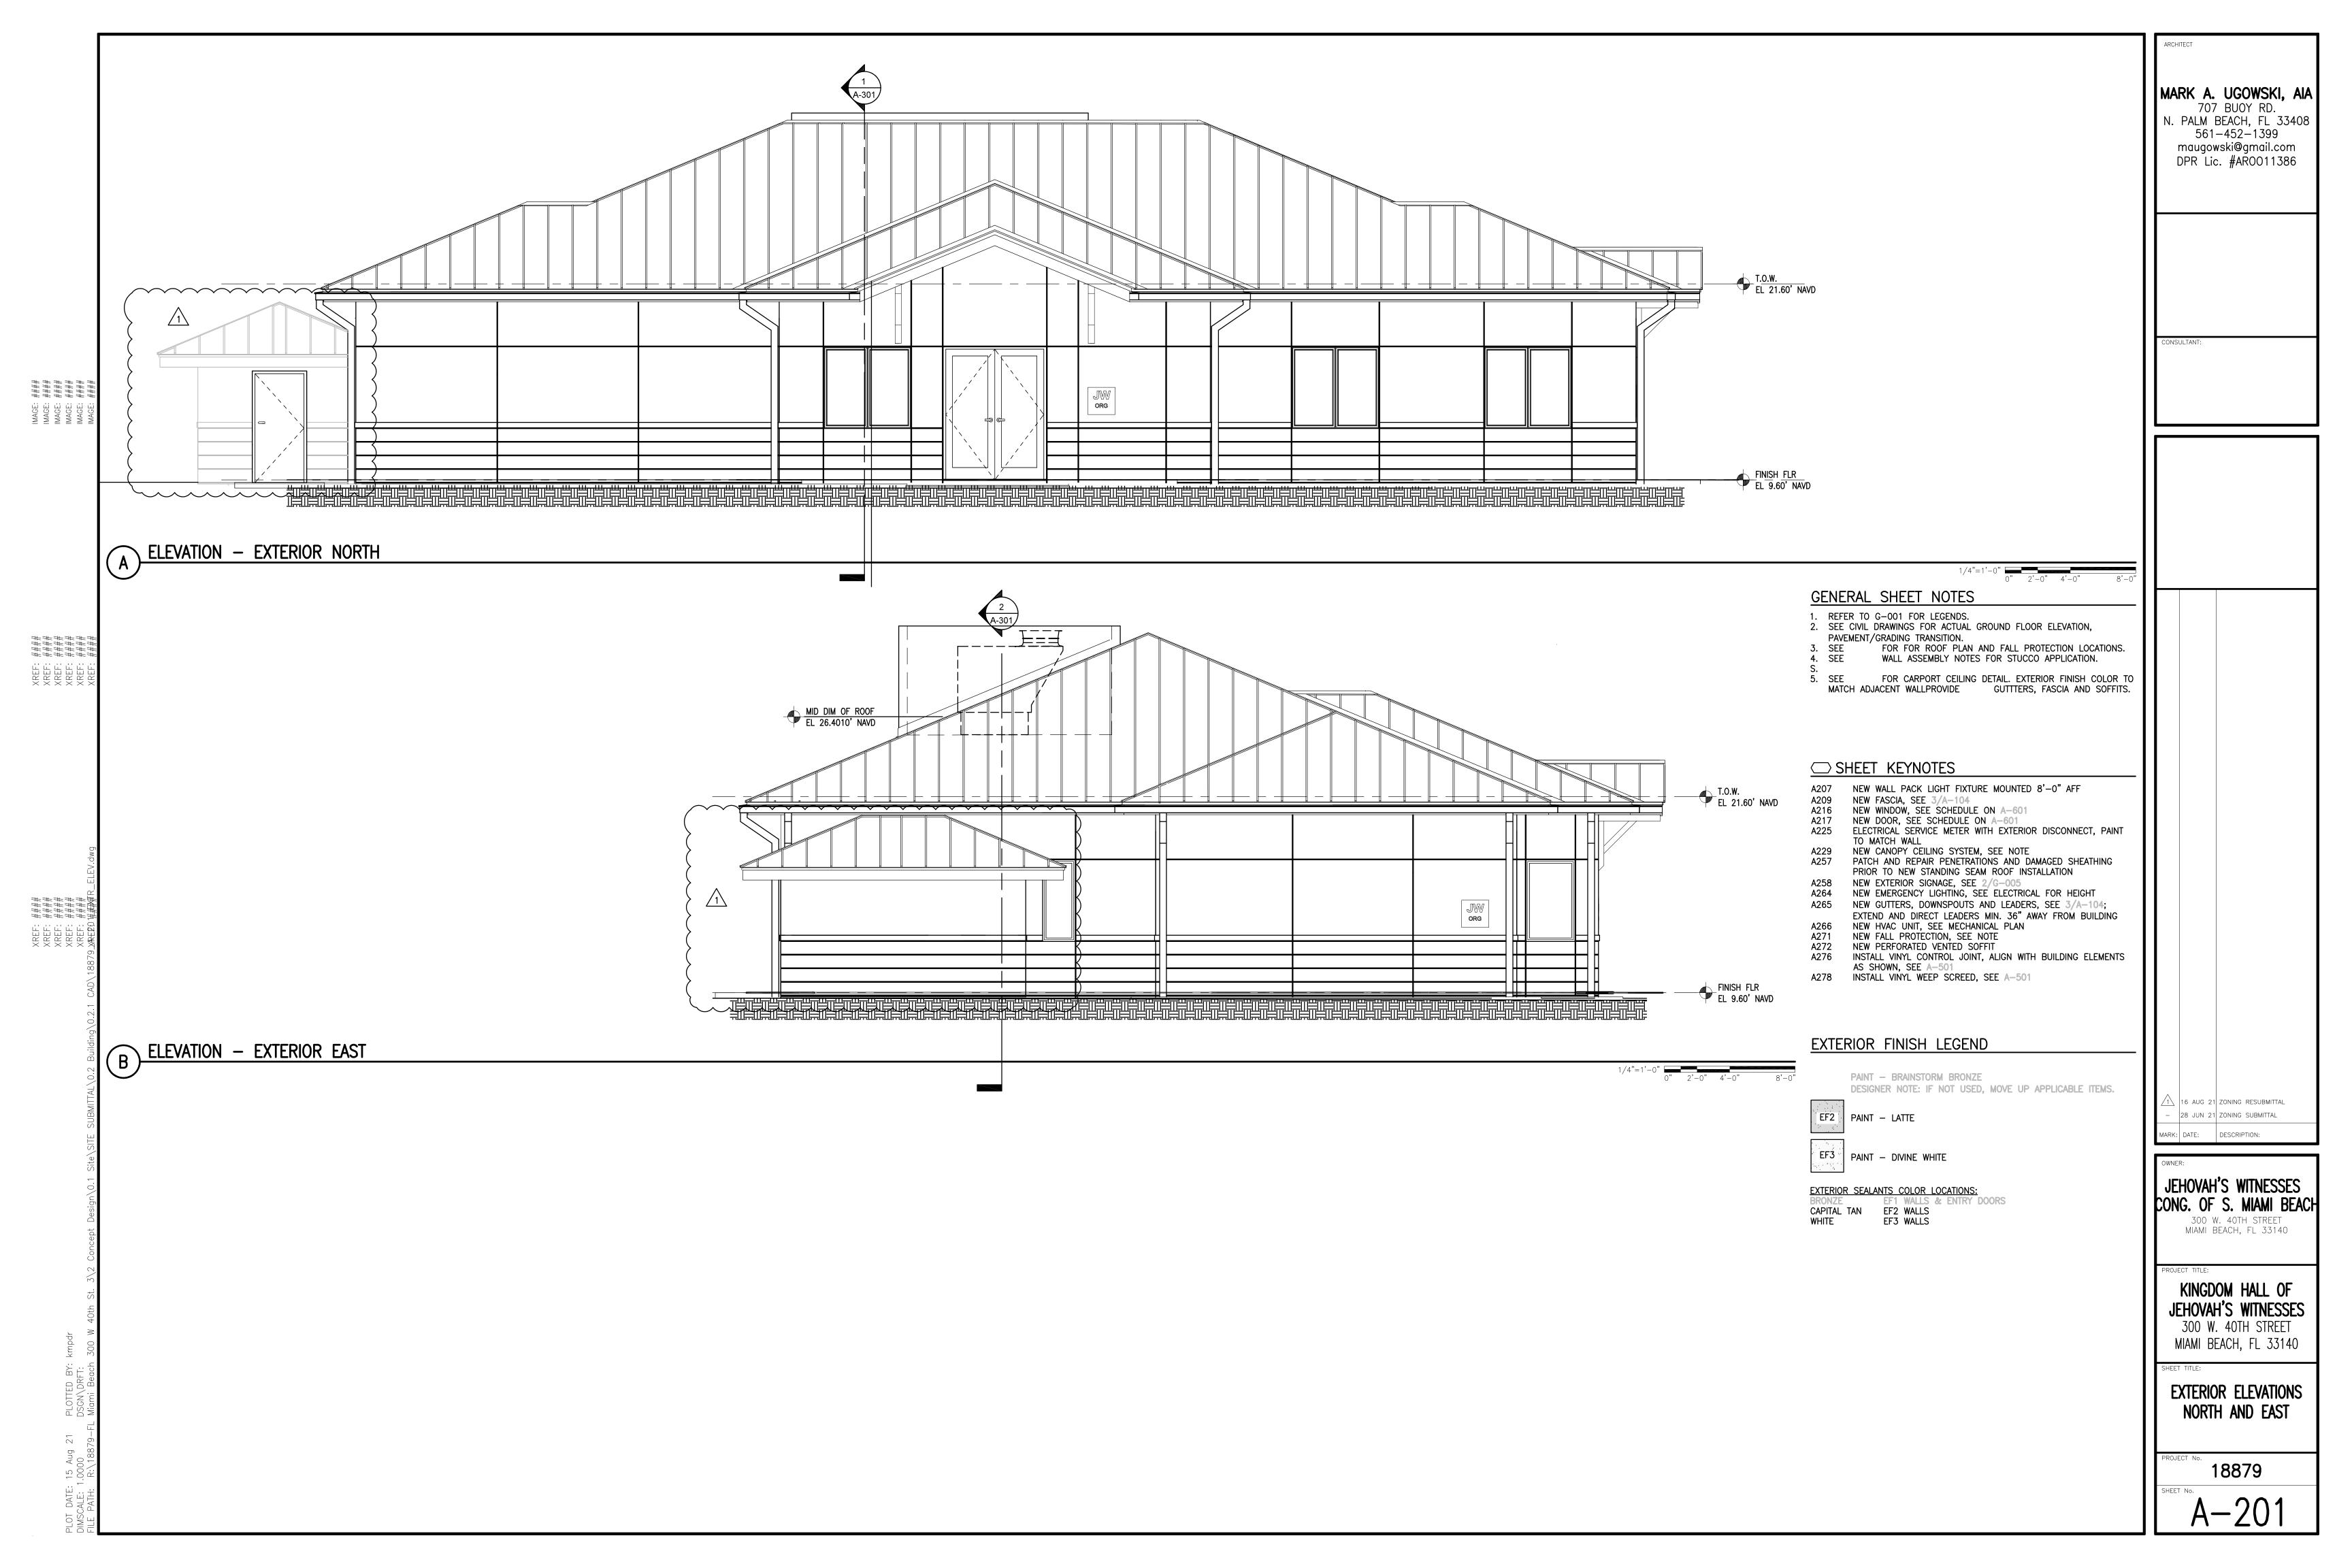

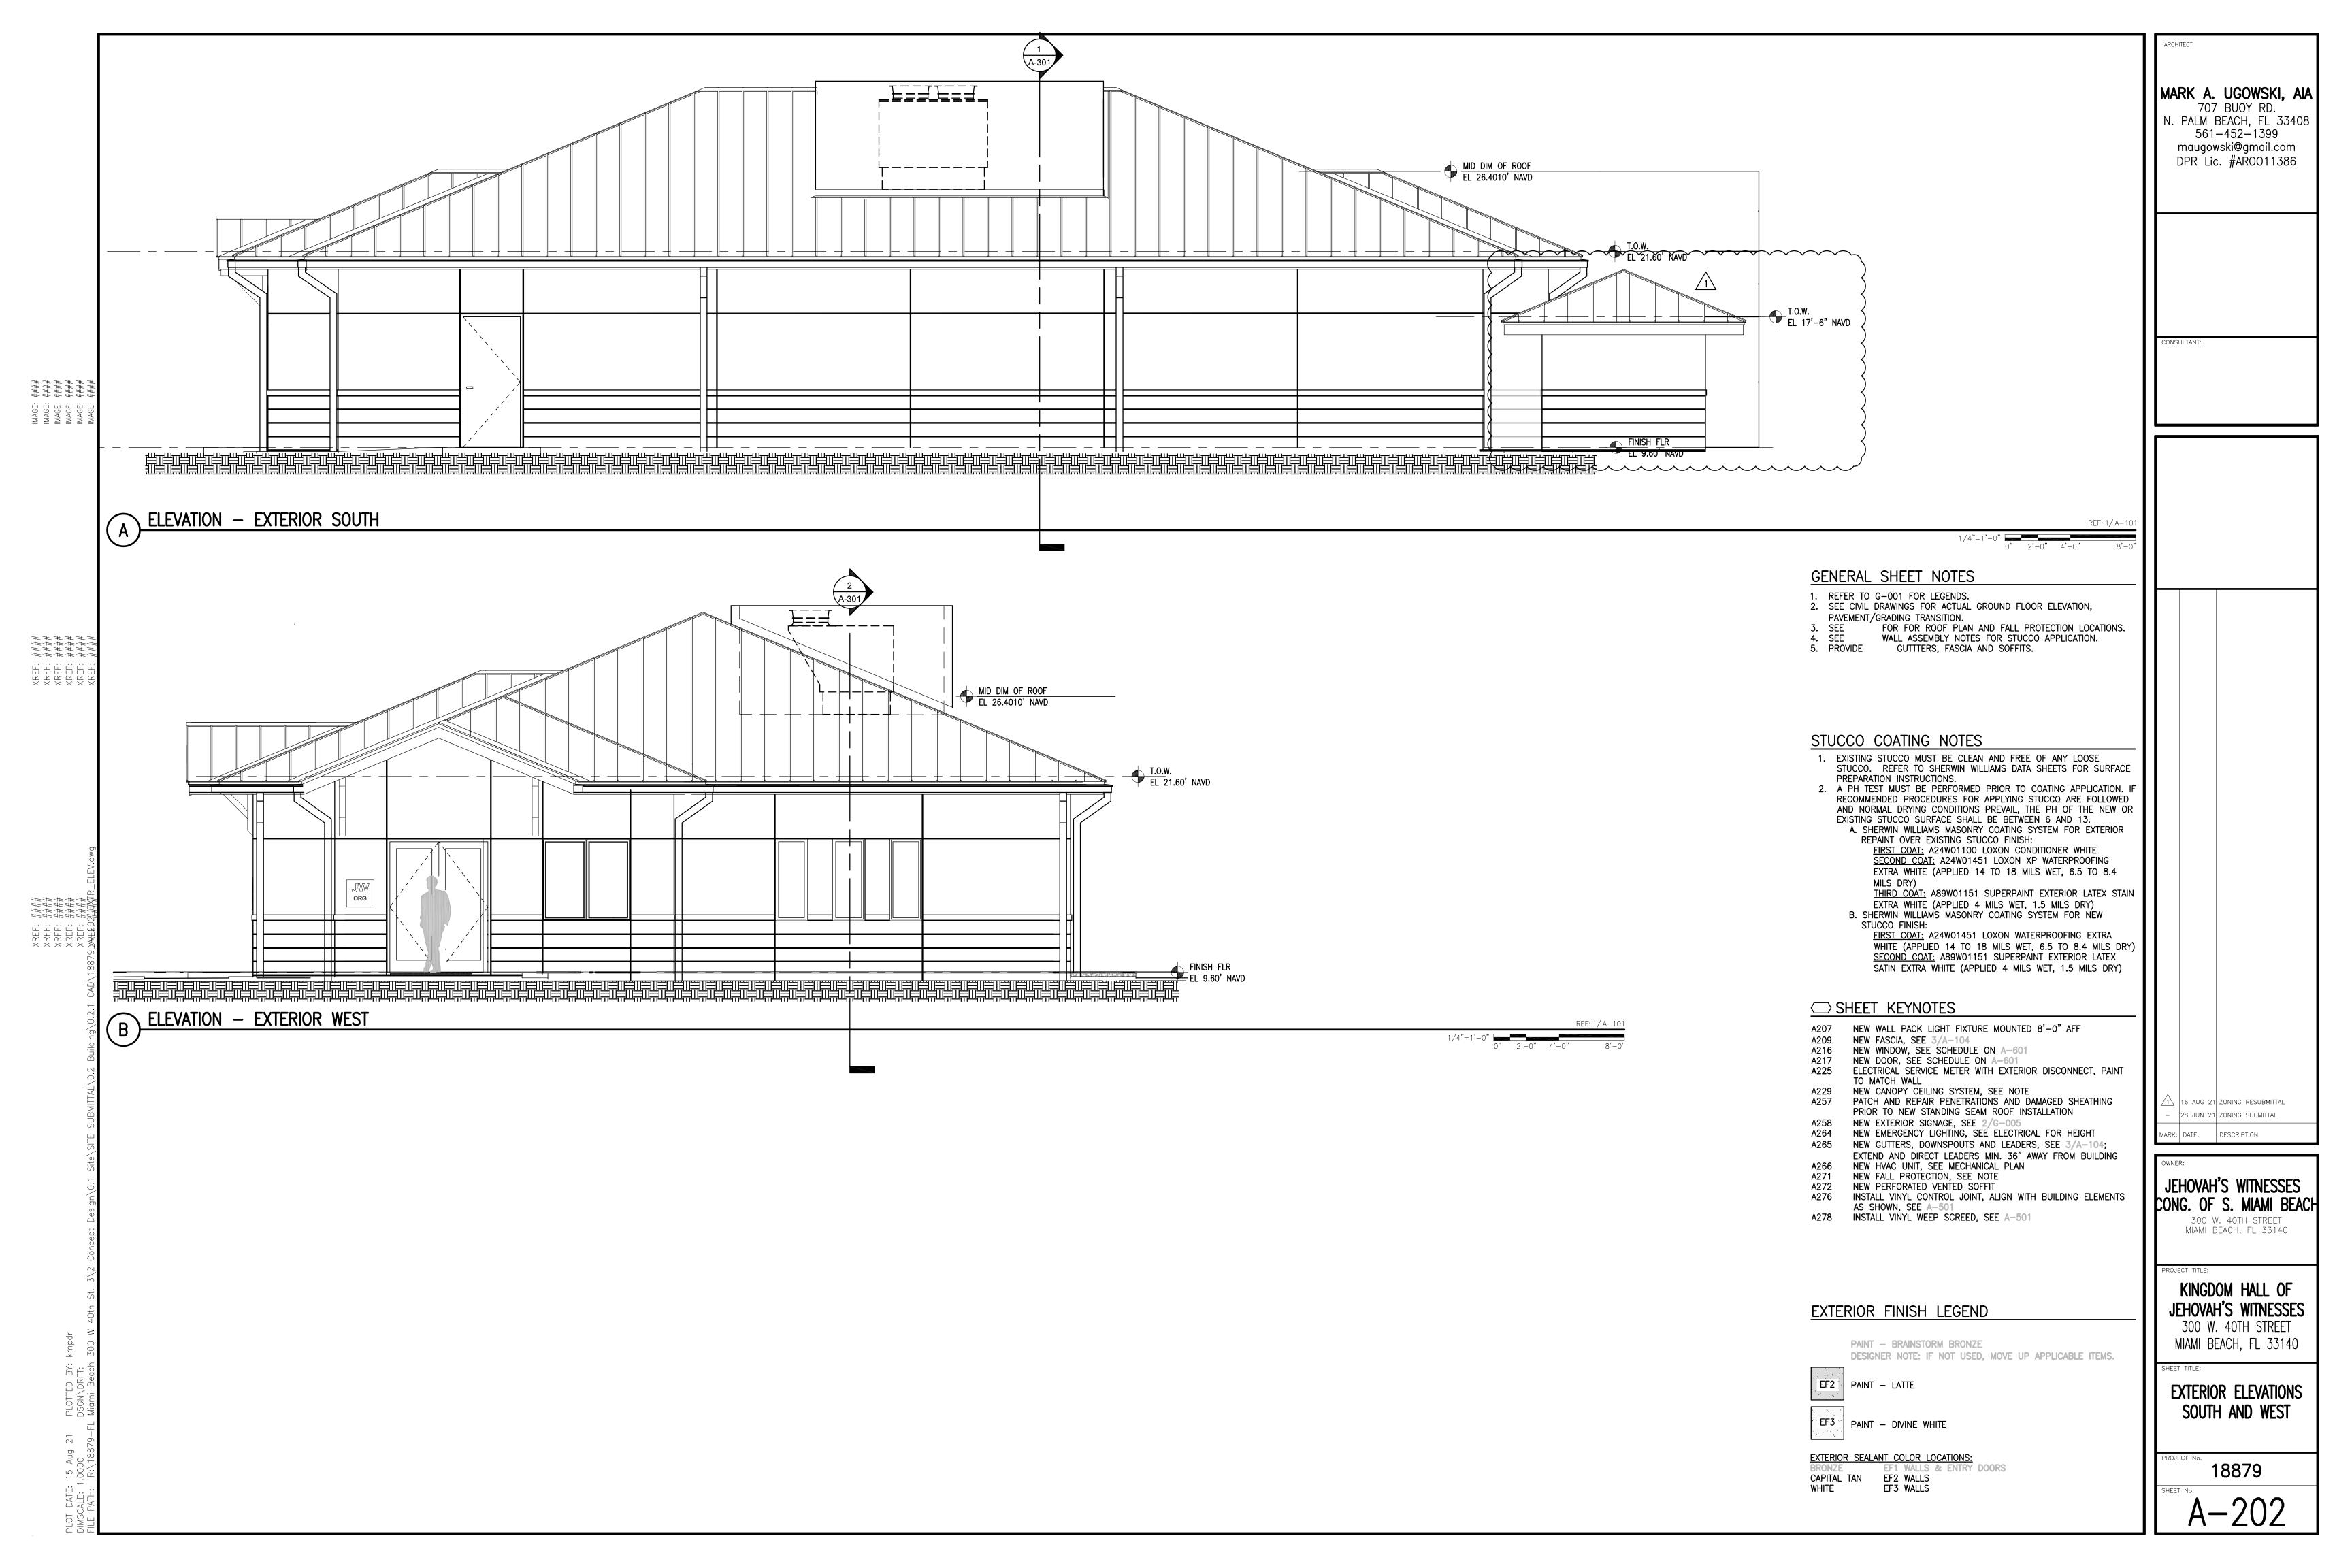

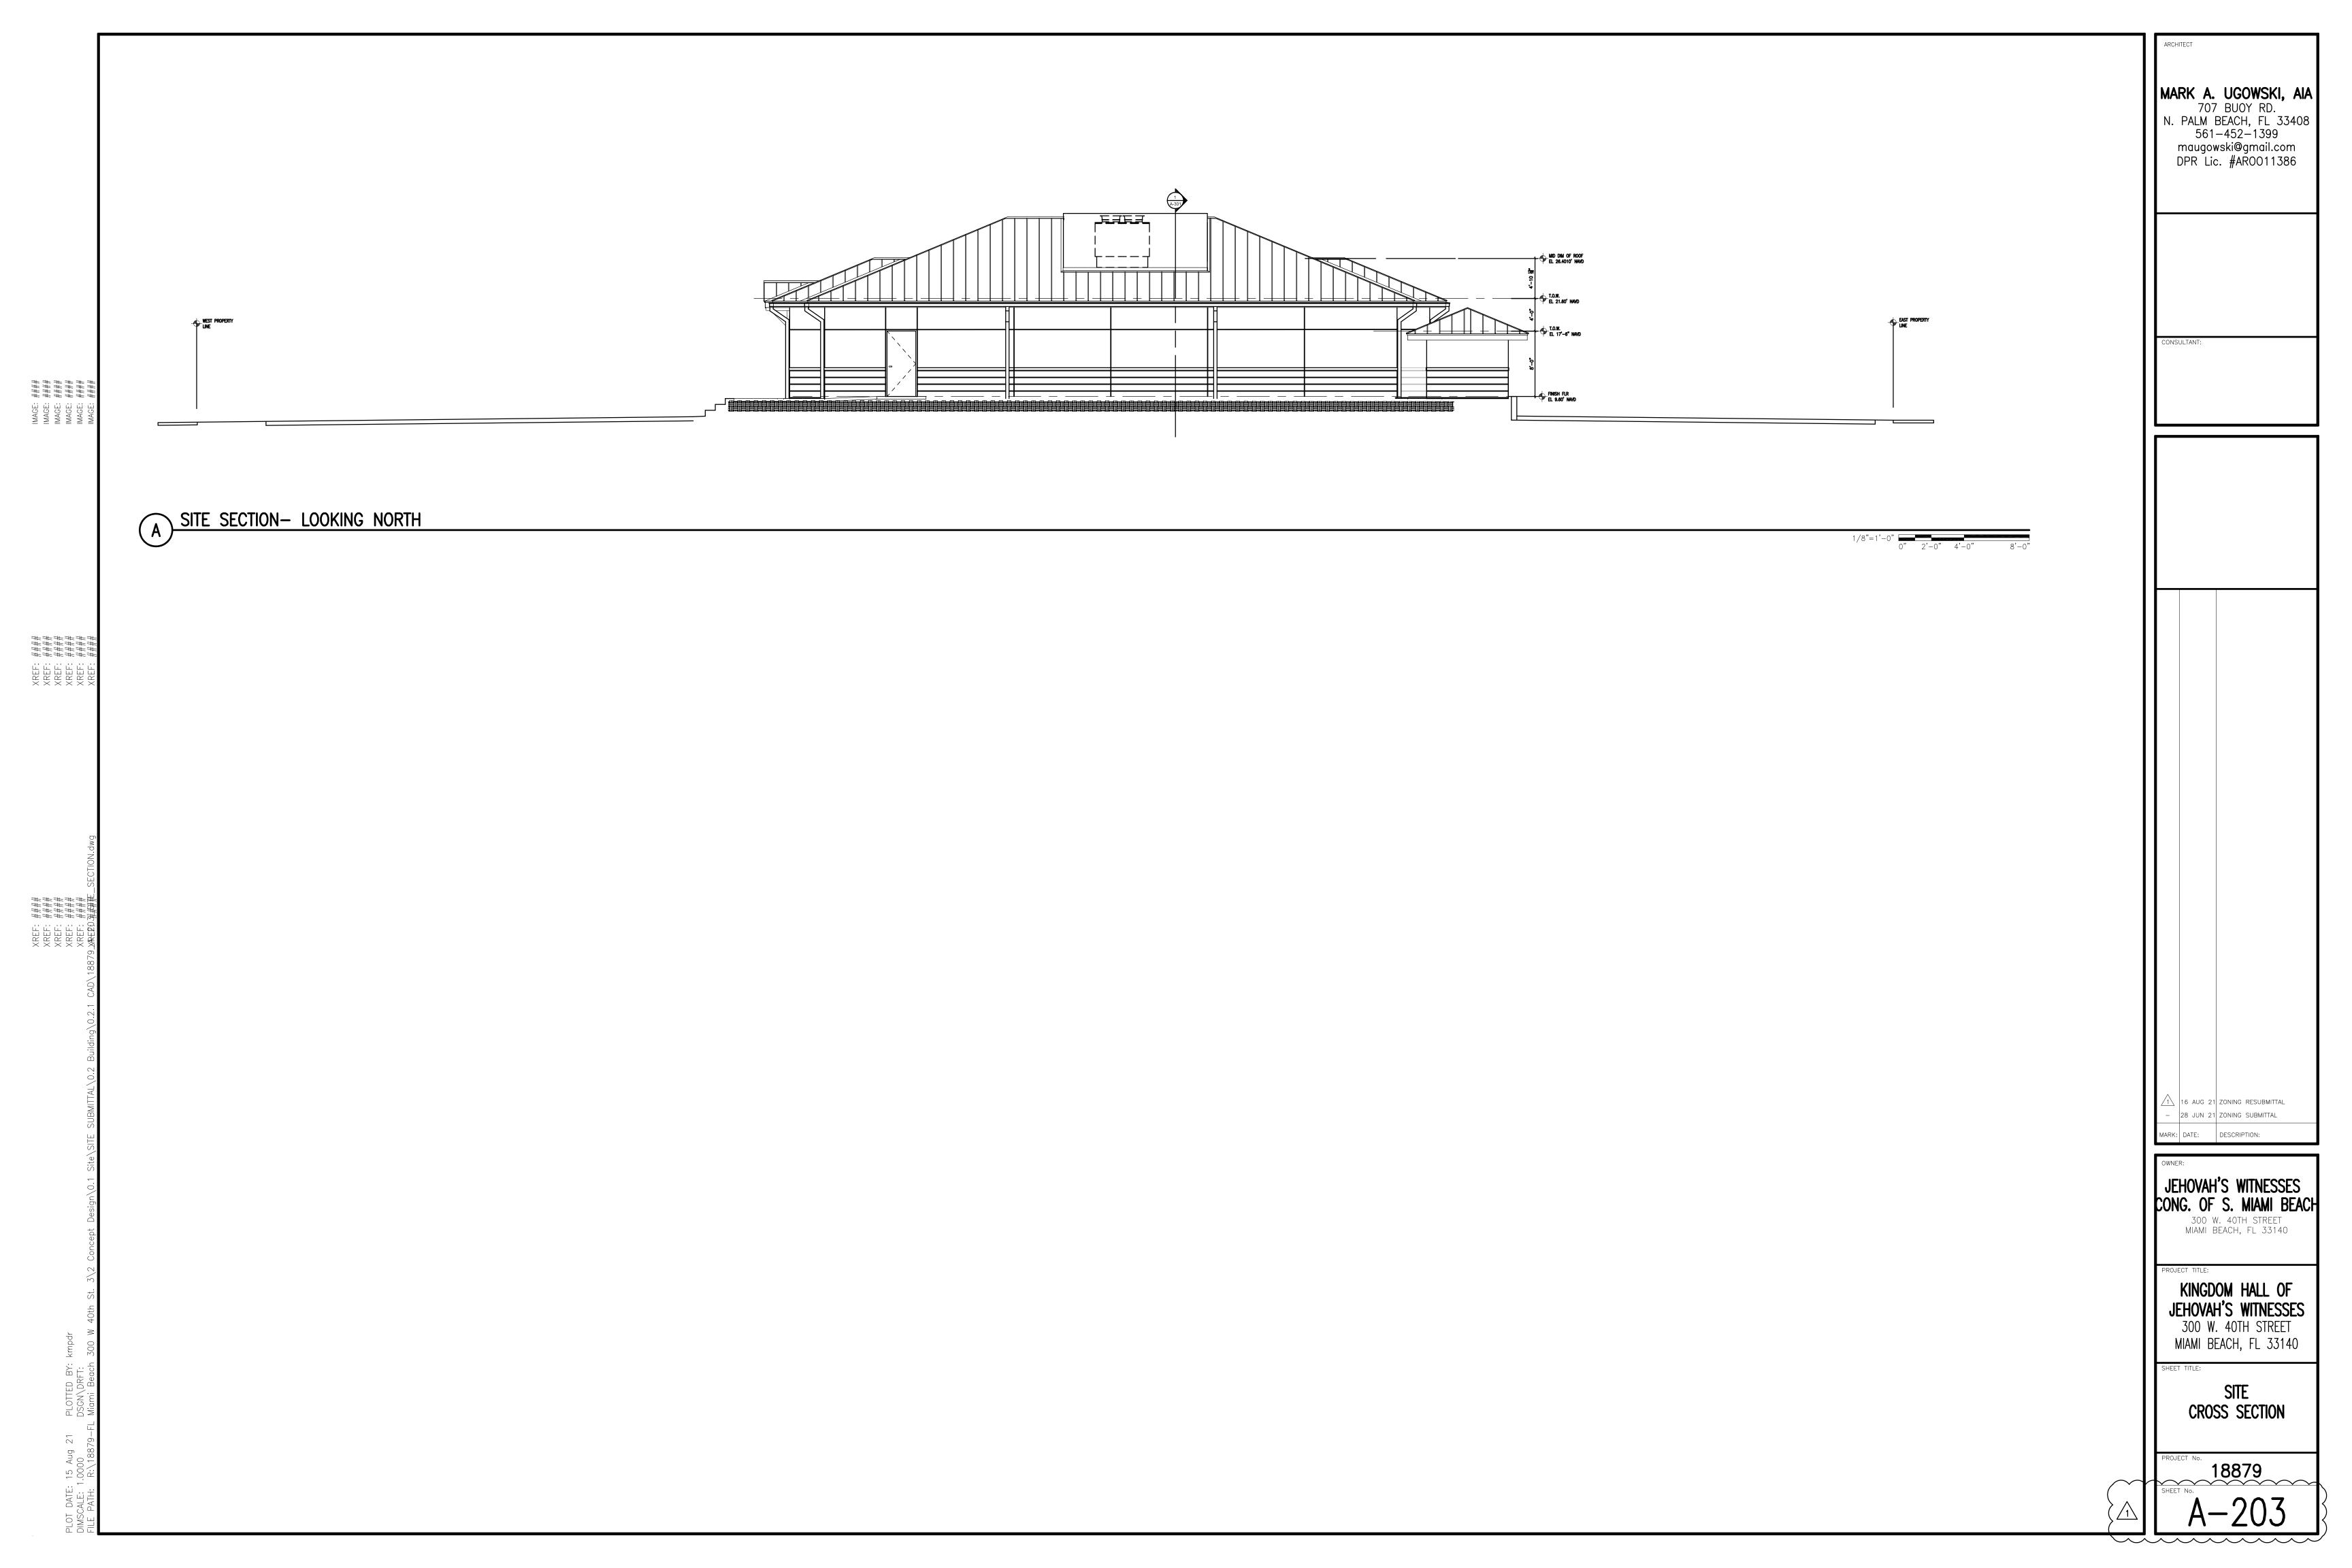

SITE LIGHTING SCHEDULE																			
FIXTURE					BUG	RAT	ING					POLE							
SYMBOL	LABEL	. QTY	MANUFACTURER	MODEL	DESCRIPTION	CATOLOG No.	MOUNT HT	LAMP	OPTICS	В	U	G	LUMENS	LLF	IES FILE	MANUFACTURER	DESCRIPTION	LENGTH	CATOLOG No.
W2	Н	*	SIGNIFY STONCO	LYTEPRO	EXTERIOR WALL SCONCE	LPW16-20W-NW-G3-3-UNV-BZ	SEE ELEVATIONS	LED	N/A	В1	UO	G1	2,242	1.0	LPW16-20-NW-G3-3 -UNV.ies	N/A	N/A	N/A	N/A
X1	<b>-</b> ф	- 8	SIGNIFY GARDCO	ECOFORM	FULL CUT-OFF AREA LIGHT	ECF-S-32L-365-NW-G2-AR- 4-UNV-BZ	10'-6"	LED	4	В1	UO	G2	5,934	1.0	ECF-S-32L-365-NW- G2-4.ies	VISIONAIRE	4" STRAIGHT SQUARE STEEL	10'-0"	SNTS-4S-11- 10-9BC-QD-BZ
X2	<b>о-</b> ф	- 2	SIGNIFY GARDCO	ECOFORM	FULL CUT-OFF AREA LIGHT	ECF-S-32L-365-NW-G2-AR- 4-UNV-HIS-BZ	10'-6"	LED	4	B1	U0	G2	4,700	1.0	ECF-S-32L-365-NW- G2-4-HIS.ies	VISIONAIRE	4" STRAIGHT SQUARE STEEL	10'-0"	SNTS-4S-11- 10-9BC-QD-BZ

LIGHTING STATISTICS								
DESCRIPTION	AVG	MAX	MIN	MAX/MIN				
ENTRY DRIVE	_	-	-	-/-				
PARKING LOT	2.86	9.86	0.97	10.13 / 1				
SIDEWALKS	3.0	_	_	- / -				
BUILDING ENTRY	5.0	_	_	- / -				

SYMBOLS LEGEND		
	EXISTING	PROPOSE
LIGHT POLE (1-LIGHT)	0	~-
WALL MOUNTED LIGHT	Н	Н
SIGN FLOODLIGHT	•—(	<b>-</b> -()
UTILITY POLE	X	X
UNDERGROUND CIRCUIT		

### # SHEET KEYNOTES

E101 CIRCUIT MP-13,15 VIA TIME CLOCK, SEE DETAIL 1/E-601. 2#10 AND 1#10 GROUND IN 3/4" MINIMUM CONDUIT. CONDUIT SHALL BE 24" BELOW GRADE TO TOP, MINIMUM.


E102 STUB 3/4" CONDUIT BEYOND POLE BASE FOR FUTURE USE. CAP CONDUIT. CONDUIT SHALL BE 24" BELOW GRADE TO TOP, MINIMUM.


### GENERAL LIGHTING NOTES

٠٠.٥٠ ١٥.٥٠ ١٥.٥٠

SITE PHOTOMETRIC PLAN

- REFER TO C-001 COVER SHEET FOR GENERAL NOTES REFERENCING SURVEY INFORMATION, DATUMS, GENERAL PROJECT AND CONSTRUCTION INFORMATION.
- 2. CONTRACTOR TO COORDINATE THE INSTALLATION OF UNDERGROUND CONDUIT AND WIRING FOR EXTERIOR LIGHTING WITH EXISTING AND PROPOSED UTILITIES, SITE DRAINAGE SYSTEMS, AND PAVING.
- 3. CONTRACTOR TO COORDINATE ALL INSTALLATION OF WALL MOUNTED FIXTURES AND ELECTRICAL CONNECTIONS TO SITE STRUCTURES WITH BUILDING ARCHITECT, MEP AND OWNER.
- 4. CONTRACTOR TO OPERATE EACH LUMINAIRE AFTER INSTALLATION AND CONNECTION TO VERIFY PROPER OPERATION AND CONTROL SEQUENCE.
- 5. POINT SPACING ON PLANE CALCULATION IS 5 FT, LEFT TO RIGHT, AND 5 FT, TOP TO BOTTOM. POINT-BY-POINT CALCULATIONS ARE BASED ON A 1.0 LIGHT-LOSS FACTOR (LLF).
- 6. SITE CONTRACTOR SHALL EXAMINE AND VERIFY THAT SOIL CONDITIONS ARE SUITABLE TO SUPPORT LOADS EXERTED UPON FOUNDATIONS DURING EXCAVATION. CONTACTOR SHALL NOTIFY ENGINEER OF UNSATISFACTORY CONDITIONS.
- 7. POLE FOUNDATIONS SHALL NOT BE POURED IF FREE-STANDING WATER IS PRESENT IN THE EXCAVATED
- 8. THE SITE LIGHTING DESIGN IS BASED ON A NATIONAL STANDARD USED BY JWCS, INC. NO SUBSTITUTIONS ARE PERMITTED UNLESS WRITTEN APPROVAL IS OBTAINED.

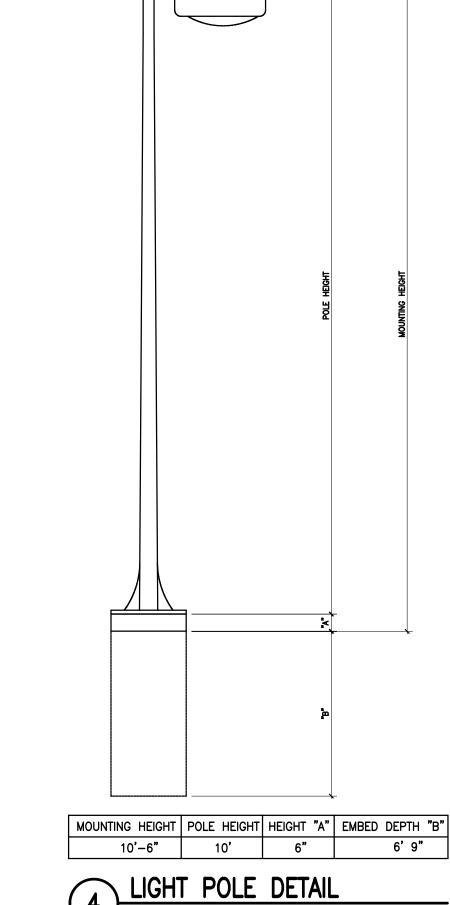

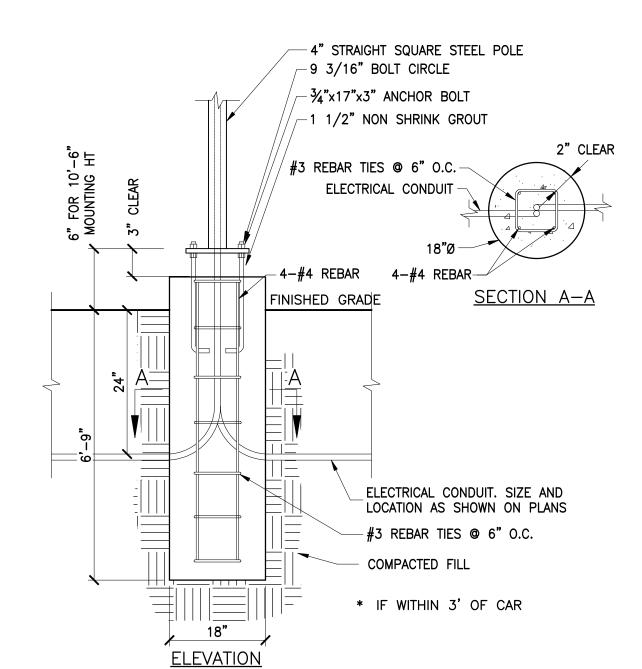

1. ALL CONCRETE f'c = 3,000 PSI MIN. (OR SIMILAR) 2. ALL REBAR Fy = 60 KSI 3. PROVIDE AND INSTALL EQUIPMENT GROUNDING CONDUCTOR ALONG WITH BRANCH CIRCUIT, SIZED PER TABLE 250.122 AND ARTICLE 250.122 OF THE NEC. PROVIDE AND INSTALL 1 NO. 6 THWN COPPER BONDING JUMPER FROM

EQUIPMENT GROUNDING CONDUCTOR. 4. NON-SHRINK GROUT SHALL COMPLY WITH ASTM C 1107, NON-SHRINK AND NONMETALLIC, DRY HYDRAULIC-CEMENT GROUT AND SHALL COMPLY WITH THE FOLLOWING: DESIGN MIX: 5,000-PSI (34.5-MPa), 28-DAY COMPRESSIVE STRENGTH; PREMIXED AND FACTORY PACKAGED; POST HARDENING, VOLUME ADJUSTING, NONSTAINING, NONCORROSIVE, NONGASEOUS, AND RECOMMENDED FOR INTERIOR AND EXTERIOR APPLICATIONS.

NOT TO SCALE

INTEGRAL GROUNDING LUG WITHIN STEEL POLE HAND HOLE AND BOND TO

RCISIO NOGU : CENSE: STATE OF

TARCISIO NOGUERA, PE 19244 NW 24th COURT PEMBROKE PINES, FL 33029 tnoguera.pe@gmail.com 954-850-4288

**NOT FOR** CONSTRUCTION THIS DRAWING PROVIDED ONLY FOR **ESTIMATING PURPOSES** 

JEHOVAH'S WITNESSES CONG. OF S. MIAMI BEACI

1\ 16 AUG 21 ZONING RESUBMITTAL 28 JUN 21 ZONING SUBMITTAL

KINGDOM HALL OF JEHOVAH'S WITNESSES 300 W. 40TH STREET MIAMI BEACH, FL 33140

> ELECTRICAL SITE PLAN

