
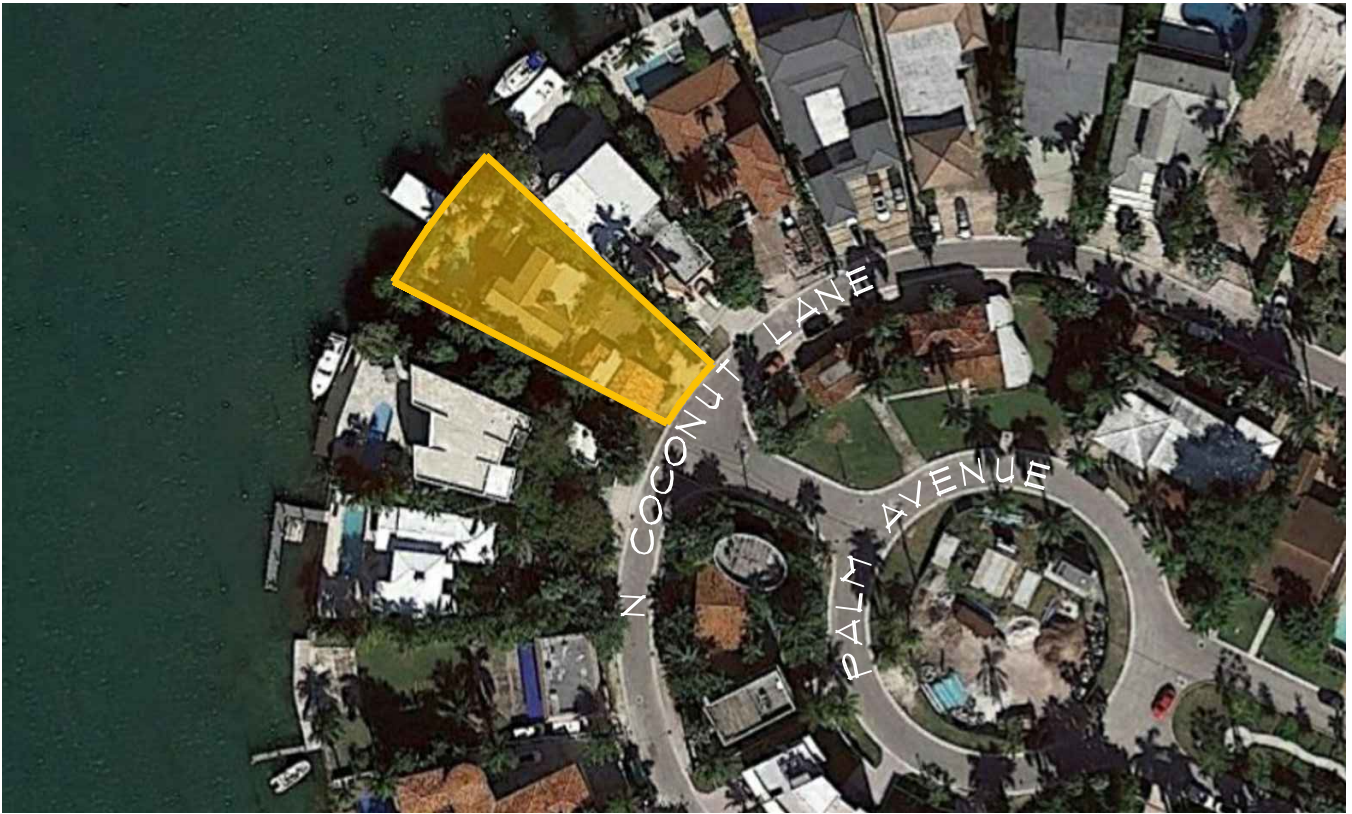



Nov 08, 2021 - 10:58pm

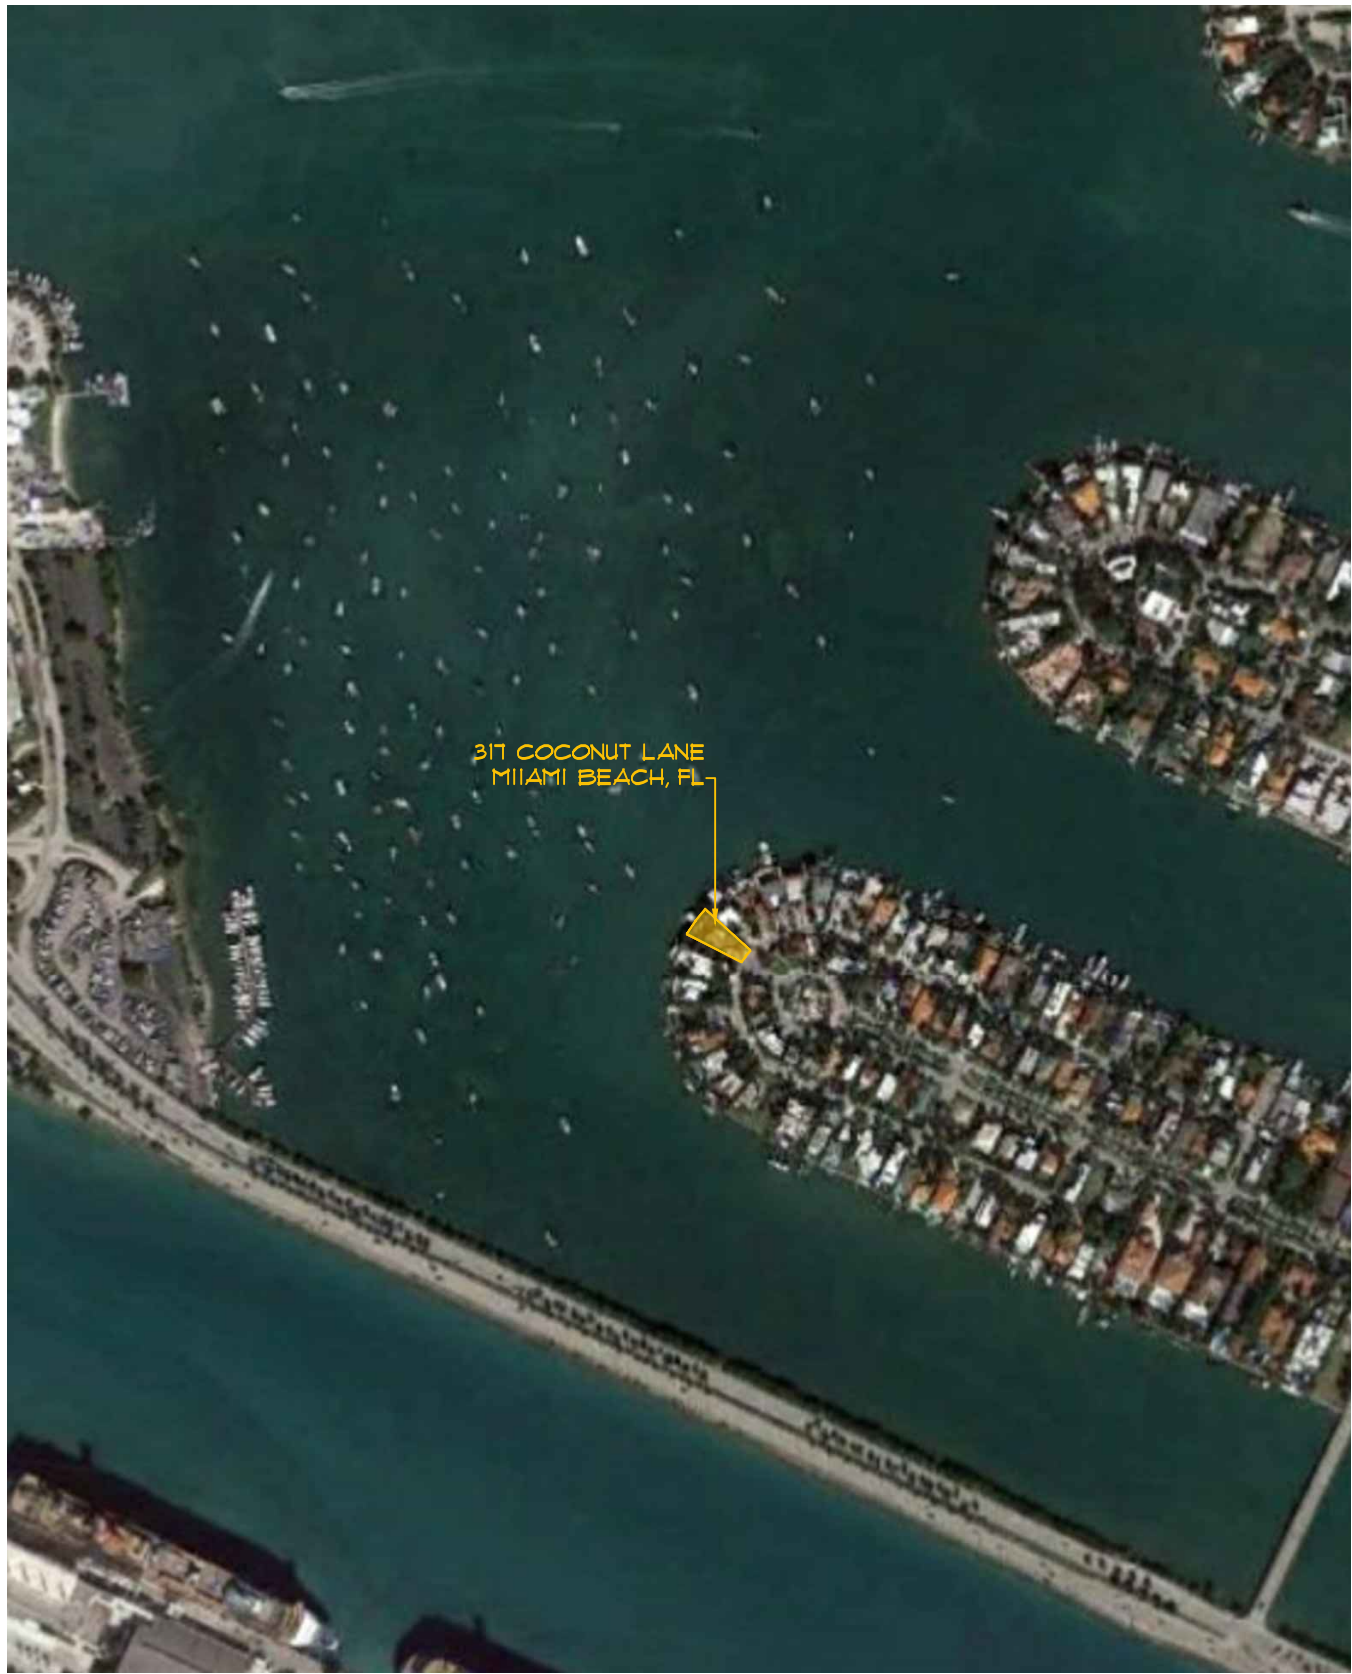

**FAIRFAX & SAMMONS**  
NEW YORK ~ PALM BEACH

317 N. COCONUT LANE RESIDENCE  
FINAL SUBMITTAL | MIAMI BEACH, FLORIDA | NOVEMBER 8, 2021

SITE LOCATION

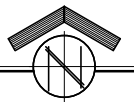

DRAWINGS, SPECIFICATIONS AND OTHER DOCUMENTS PREPARED BY THE ARCHITECT ARE THE INSTRUMENTS OF THE ARCHITECT'S SERVICE AND SHALL REMAIN THE PROPERTY OF THE ARCHITECT, WHETHER OR NOT THE PROJECT FOR WHICH THEY ARE INTENDED IS CONSTRUCTED OR NOT. THE ARCHITECT'S DRAWINGS, SPECIFICATIONS AND OTHER DOCUMENTS WILL NOT BE USED ON ANY OTHER PROJECTS FOR ADDITIONS TO THIS PROJECT AND/OR FOR COMPLETION OF THIS PROJECT BY OTHERS, EXCEPT BY AGREEMENT IN WRITING AND WITH APPROPRIATE COMPENSATION TO THE ARCHITECT.  
© 2021 FAIRFAX, SAMMONS & PARTNERS, LLC



This item has been electronically signed and sealed by Richard F. Sammons using a SHA-1 authentication code.  
Printed copies of the document are not considered signed and sealed and all SHA-1 authentication code must be verified on any electronic copies.




Nov 08, 2021 - 10:58pm



**FAIRFAX & SAMMONS**  
NEW YORK ~ PALM BEACH

**317 N. COCONUT LANE RESIDENCE**  
FINAL SUBMITTAL | MIAMI BEACH, FLORIDA | NOVEMBER 8, 2021

CONTEXT LOCATION PLAN

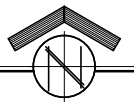

DRAWINGS, SPECIFICATIONS AND OTHER DOCUMENTS PREPARED BY THE ARCHITECT ARE THE INSTRUMENTS OF THE ARCHITECT'S SERVICE AND SHALL REMAIN THE PROPERTY OF THE ARCHITECT, WHETHER OR NOT THE PROJECT FOR WHICH THEY ARE INTENDED IS CONSTRUCTED OR NOT. THE ARCHITECT'S DRAWINGS, SPECIFICATIONS AND OTHER DOCUMENTS WILL NOT BE USED ON ANY OTHER PROJECTS FOR ADDITIONS TO THIS PROJECT AND/OR FOR COMPLETION OF THIS PROJECT BY OTHERS, EXCEPT BY AGREEMENT IN WRITING AND WITH APPROPRIATE COMPENSATION TO THE ARCHITECT.  
© 2021 FAIRFAX, SAMMONS & PARTNERS, LLC



This item has been electronically signed and sealed by Richard F. Sammons using a SHA-1 authentication code.  
Printed copies of the document are not considered signed and sealed and all SHA-1 authentication code must be verified on any electronic copies.

A-004






(C) FRONT - BIRD'S EYE VIEW




(B) STREET FRONT



(C) EXISTING MAIN GATE

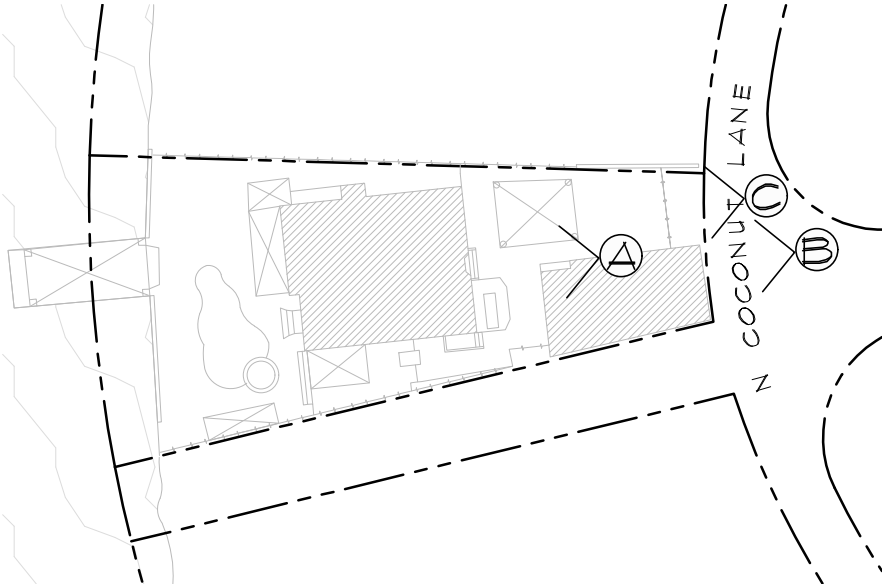

STREET VIEW

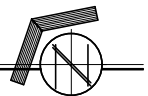

DRAWINGS, SPECIFICATIONS AND OTHER DOCUMENTS PREPARED BY THE ARCHITECT ARE THE INSTRUMENTS OF THE ARCHITECT'S SERVICE AND SHALL REMAIN THE PROPERTY OF THE ARCHITECT, WHETHER OR NOT THE PROJECT FOR WHICH THEY ARE INTENDED IS CONSTRUCTED OR NOT. THE ARCHITECT'S DRAWINGS, SPECIFICATIONS AND OTHER DOCUMENTS WILL NOT BE USED ON ANY OTHER PROJECTS FOR ADDITIONS TO THIS PROJECT AND/OR FOR COMPLETION OF THIS PROJECT BY OTHERS, EXCEPT BY AGREEMENT IN WRITING AND WITH APPROPRIATE COMPENSATION TO THE ARCHITECT.  
© 2021 FAIRFAX, SAMMONS & PARTNERS, LLC



**FAIRFAX & SAMMONS**  
NEW YORK ~ PALM BEACH

317 N. COCONUT LANE RESIDENCE  
FINAL SUBMITTAL | MIAMI BEACH, FLORIDA | NOVEMBER 8, 2021



This item has been electronically signed and sealed by Richard F. Sammons using a SHA-1 authentication code.  
Printed copies of the document are not considered signed and sealed and all SHA-1 authentication code must be verified on any electronic copies.





(A) EXISTING BUILDING - GARAGE FRONT



(B) EXISTING BUILDING - GARAGE NORTHEAST




(C) EXISTING BUILDING - GARAGE REAR




(D) EXISTING BUILDING - MAIN FRONT



(E) EXISTING BUILDING - GAZEBO

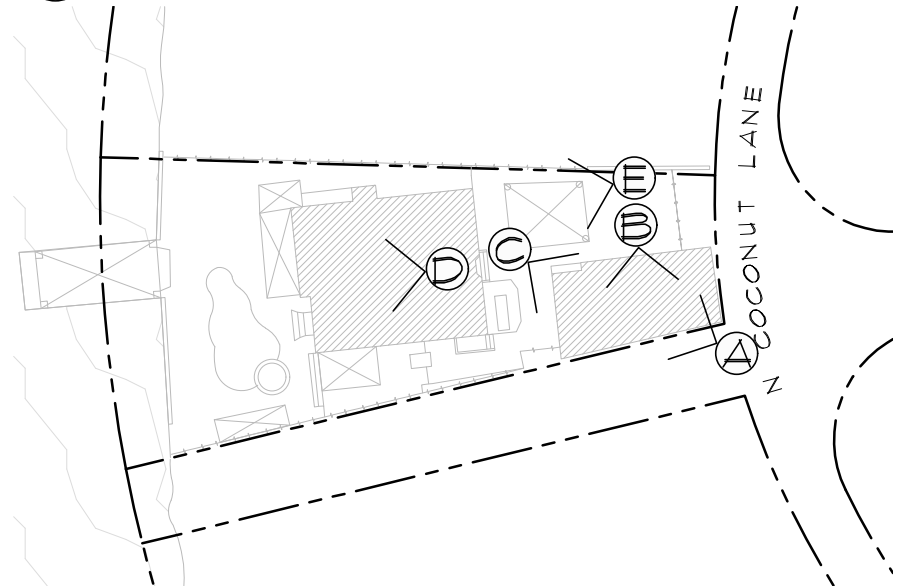

EXISTING BUILDING

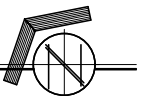

**FAIRFAX & SAMMONS**  
NEW YORK ~ PALM BEACH

317 N. COCONUT LANE RESIDENCE  
FINAL SUBMITTAL | MIAMI BEACH, FLORIDA | NOVEMBER 8, 2021



This item has been electronically signed and sealed by Richard F. Sammons using a SHA-1 authentication code.  
Printed copies of the document are not considered signed and sealed and all SHA-1 authentication code must be verified on any electronic copies.



Nov 08, 2021 - 10:48am




(C) WATERFRONT - BIRD'S EYE VIEW




(A) EXISTING BUILDING - REAR



(A) EXISTING BUILDING - REAR

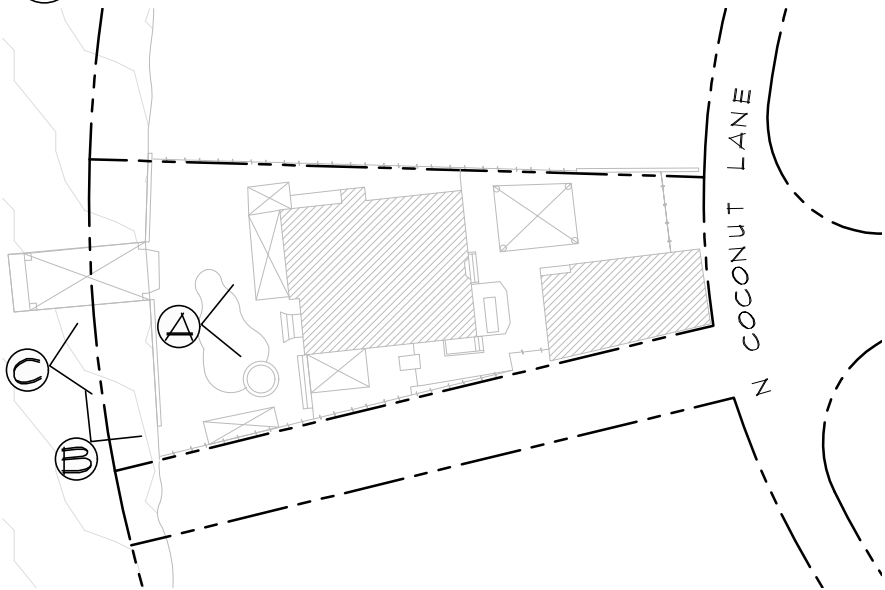

EXISTING BUILDING

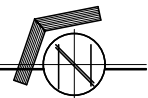

DRAWINGS, SPECIFICATIONS AND OTHER DOCUMENTS PREPARED BY THE ARCHITECT ARE THE INSTRUMENTS OF THE ARCHITECT'S SERVICE AND SHALL REMAIN THE PROPERTY OF THE ARCHITECT, WHETHER OR NOT THE PROJECT FOR WHICH THEY ARE INTENDED IS CONSTRUCTED OR NOT. THE ARCHITECT'S DRAWINGS, SPECIFICATIONS AND OTHER DOCUMENTS WILL NOT BE USED ON ANY OTHER PROJECTS FOR ADDITIONS TO THIS PROJECT AND/OR FOR COMPLETION OF THIS PROJECT BY OTHERS, EXCEPT BY AGREEMENT IN WRITING AND WITH APPROPRIATE COMPENSATION TO THE ARCHITECT.  
© 2021 FAIRFAX, SAMMONS & PARTNERS, LLC



**FAIRFAX & SAMMONS**  
NEW YORK ~ PALM BEACH

317 N. COCONUT LANE RESIDENCE  
FINAL SUBMITTAL | MIAMI BEACH, FLORIDA | NOVEMBER 8, 2021



This item has been electronically signed and sealed by Richard F. Sammons using a SHA-1 authentication code.  
Printed copies of the document are not considered signed and sealed and all SHA-1 authentication code must be verified on any electronic copies.

A-007





(A) EXISTING BUILDING - NORTHEAST




(B) EXISTING BUILDING - NORTHEAST




(C) EXISTING BUILDING - NORTHEAST



(D) EXISTING BUILDING - DOCK

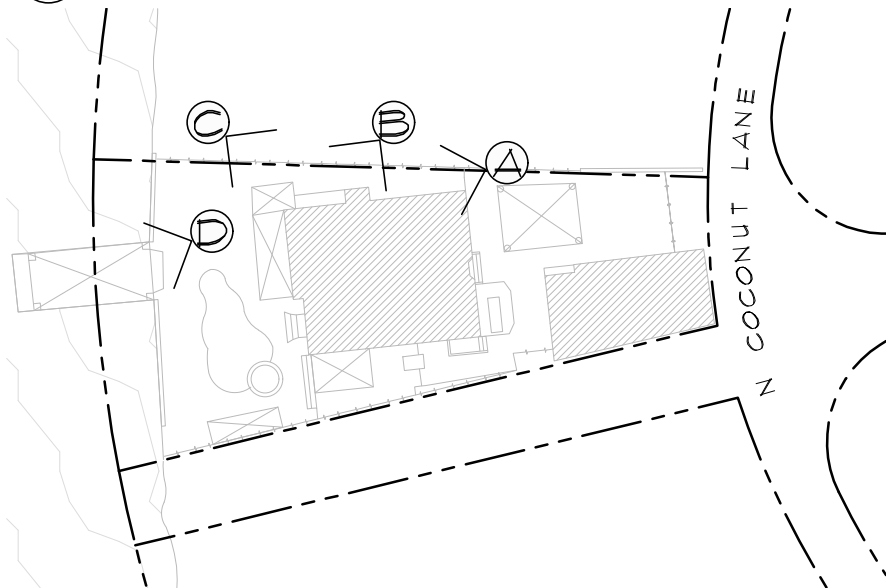

EXISTING BUILDING

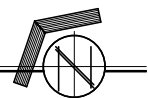

**FAIRFAX & SAMMONS**  
NEW YORK ~ PALM BEACH

317 N. COCONUT LANE RESIDENCE  
FINAL SUBMITTAL | MIAMI BEACH, FLORIDA | NOVEMBER 8, 2021



This item has been electronically signed and sealed by Richard F. Sammons using a SHA-1 authentication code.  
Printed copies of the document are not considered signed and sealed and all SHA-1 authentication code must be verified on any electronic copies.




Nov 08, 2021 - 10:53pm



(A) EXISTING BUILDING - SOUTHWEST




(B) EXISTING BUILDING - SOUTHWEST

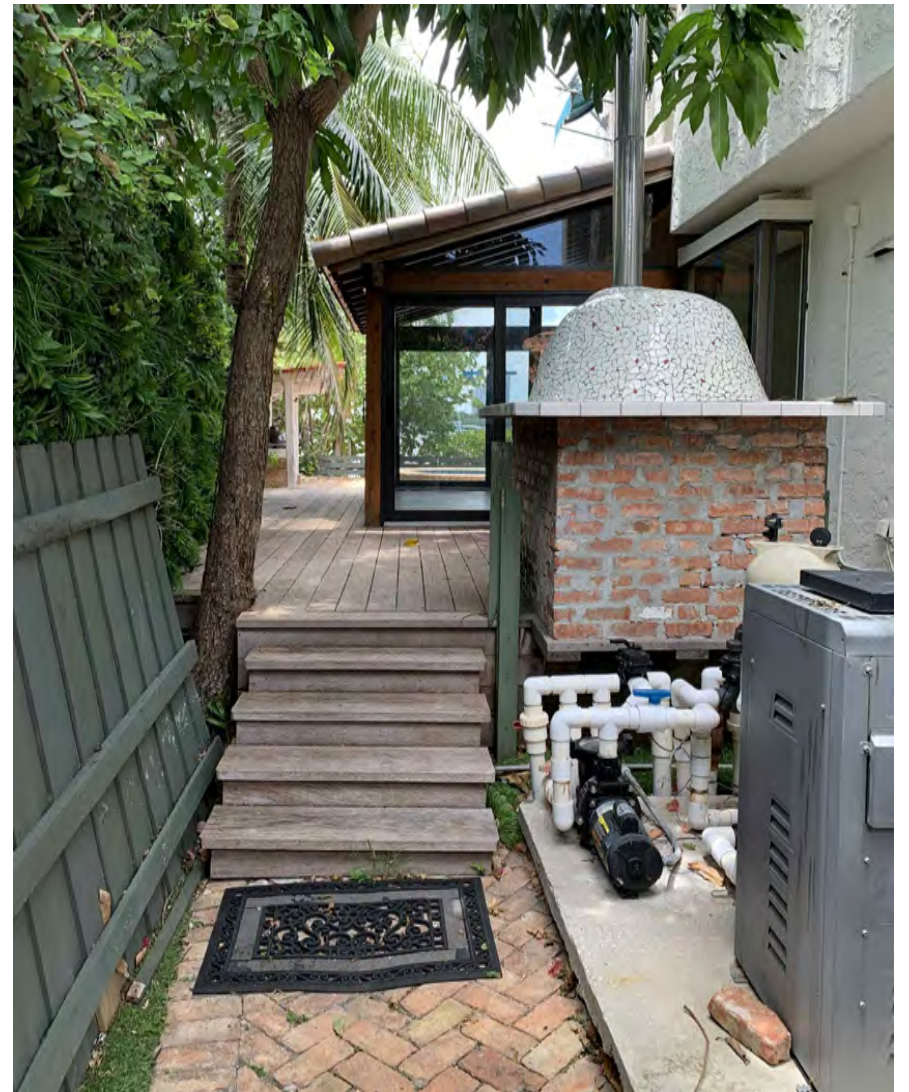


(C) EXISTING BUILDING - SOUTHWEST



(D) EXISTING BUILDING - REAR TERRACE, POOL & BBQ

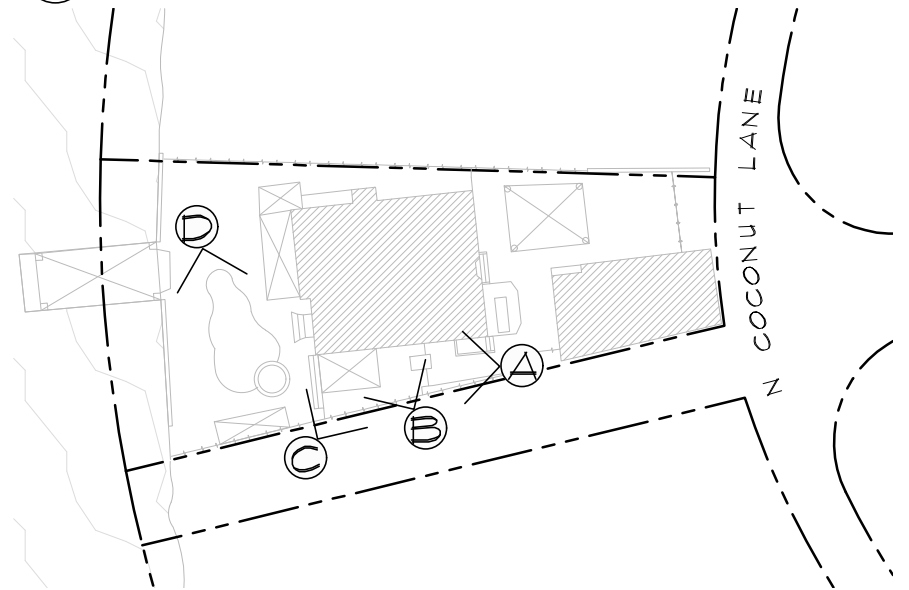

EXISTING BUILDING

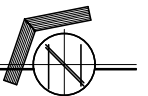

DRAWINGS, SPECIFICATIONS AND OTHER DOCUMENTS PREPARED BY THE ARCHITECT ARE THE INSTRUMENTS OF THE ARCHITECT'S SERVICE AND SHALL REMAIN THE PROPERTY OF THE ARCHITECT, WHETHER OR NOT THE PROJECT FOR WHICH THEY ARE INTENDED IS CONSTRUCTED OR NOT. THE ARCHITECT'S DRAWINGS, SPECIFICATIONS AND OTHER DOCUMENTS WILL NOT BE USED ON ANY OTHER PROJECTS FOR ADDITIONS TO THIS PROJECT AND/OR FOR COMPLETION OF THIS PROJECT BY OTHERS, EXCEPT BY AGREEMENT IN WRITING AND WITH APPROPRIATE COMPENSATION TO THE ARCHITECT.  
© 2021 FAIRFAX, SAMMONS & PARTNERS, LLC



**FAIRFAX & SAMMONS**  
NEW YORK • PALM BEACH

317 N. COCONUT LANE RESIDENCE  
FINAL SUBMITTAL | MIAMI BEACH, FLORIDA | NOVEMBER 8, 2021



This item has been electronically signed and sealed by Richard F. Sammons using a SHA-1 authentication code.  
Printed copies of the document are not considered signed and sealed and all SHA-1 authentication code must be verified on any electronic copies.

A-009





① NEIGHBOR RESIDENCE



⑥ SITE EXISTING OWNER RESIDENCE



② NEIGHBOR RESIDENCE



③ NEIGHBOR RESIDENCE



④ NEIGHBOR RESIDENCE



⑤ NEIGHBOR RESIDENCE




⑥ NEIGHBOR RESIDENCE



**FAIRFAX & SAMMONS**  
NEW YORK ~ PALM BEACH

317 N. COCONUT LANE RESIDENCE  
FINAL SUBMITTAL | MIAMI BEACH, FLORIDA | NOVEMBER 8, 2021

NEIGHBORING CONTEXT

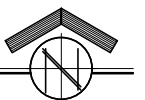


This item has been electronically signed and sealed by  
Richard F. Sammons using a SHA-1 authentication code.  
Printed copies of the document are not considered  
signed and sealed and all SHA-1 authentication code  
must be verified on any electronic copies.

DRAWINGS, SPECIFICATIONS AND OTHER DOCUMENTS PREPARED BY THE ARCHITECT ARE THE INSTRUMENTS OF THE ARCHITECT'S SERVICE AND SHALL REMAIN THE PROPERTY OF THE ARCHITECT, WHETHER OR NOT THE PROJECT FOR WHICH THEY ARE INTENDED IS CONSTRUCTED OR NOT. THE ARCHITECT'S DRAWINGS, SPECIFICATIONS AND OTHER DOCUMENTS WILL NOT BE USED ON ANY OTHER PROJECTS FOR ADDITIONS TO THIS PROJECT AND/OR FOR COMPLETION OF THIS PROJECT BY OTHERS, EXCEPT BY AGREEMENT IN WRITING AND WITH APPROPRIATE COMPENSATION TO THE ARCHITECT.  
© 2021 FAIRFAX, SAMMONS & PARTNERS, LLC


A-010



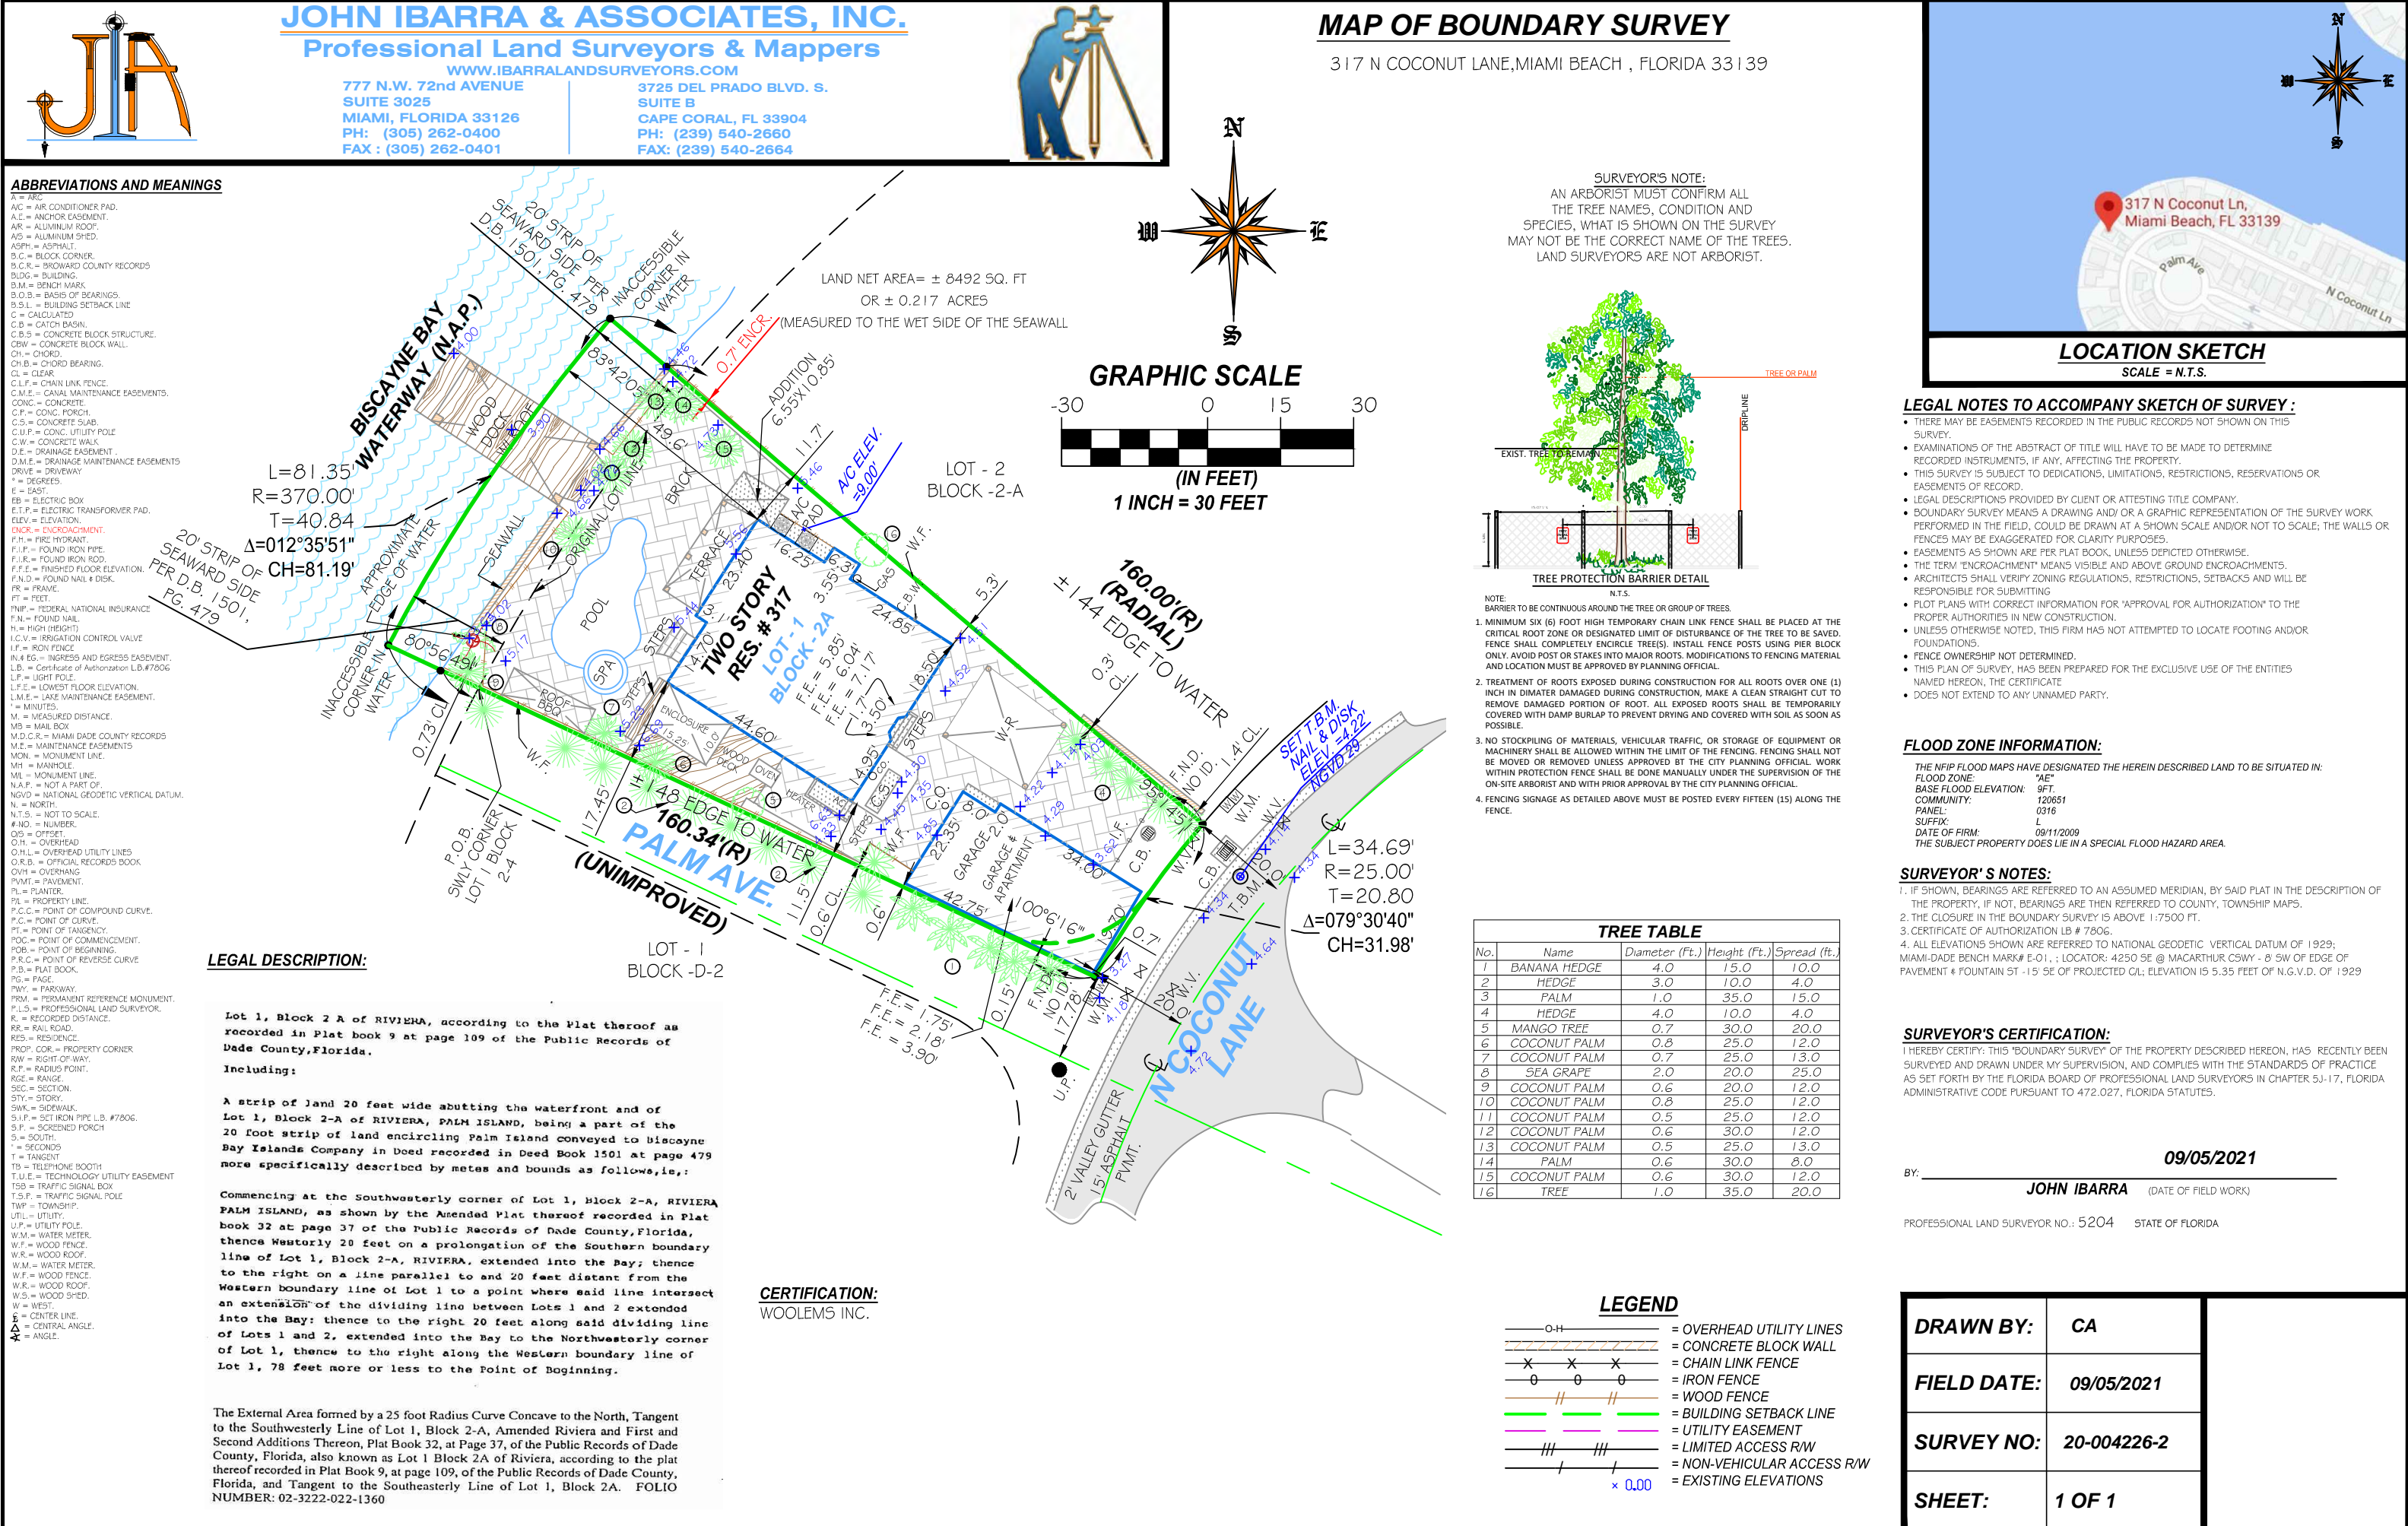




**NOTE: ELEVATIONS  
REFERENCED TO NGVD  
SURVEY ELEVATIONS**

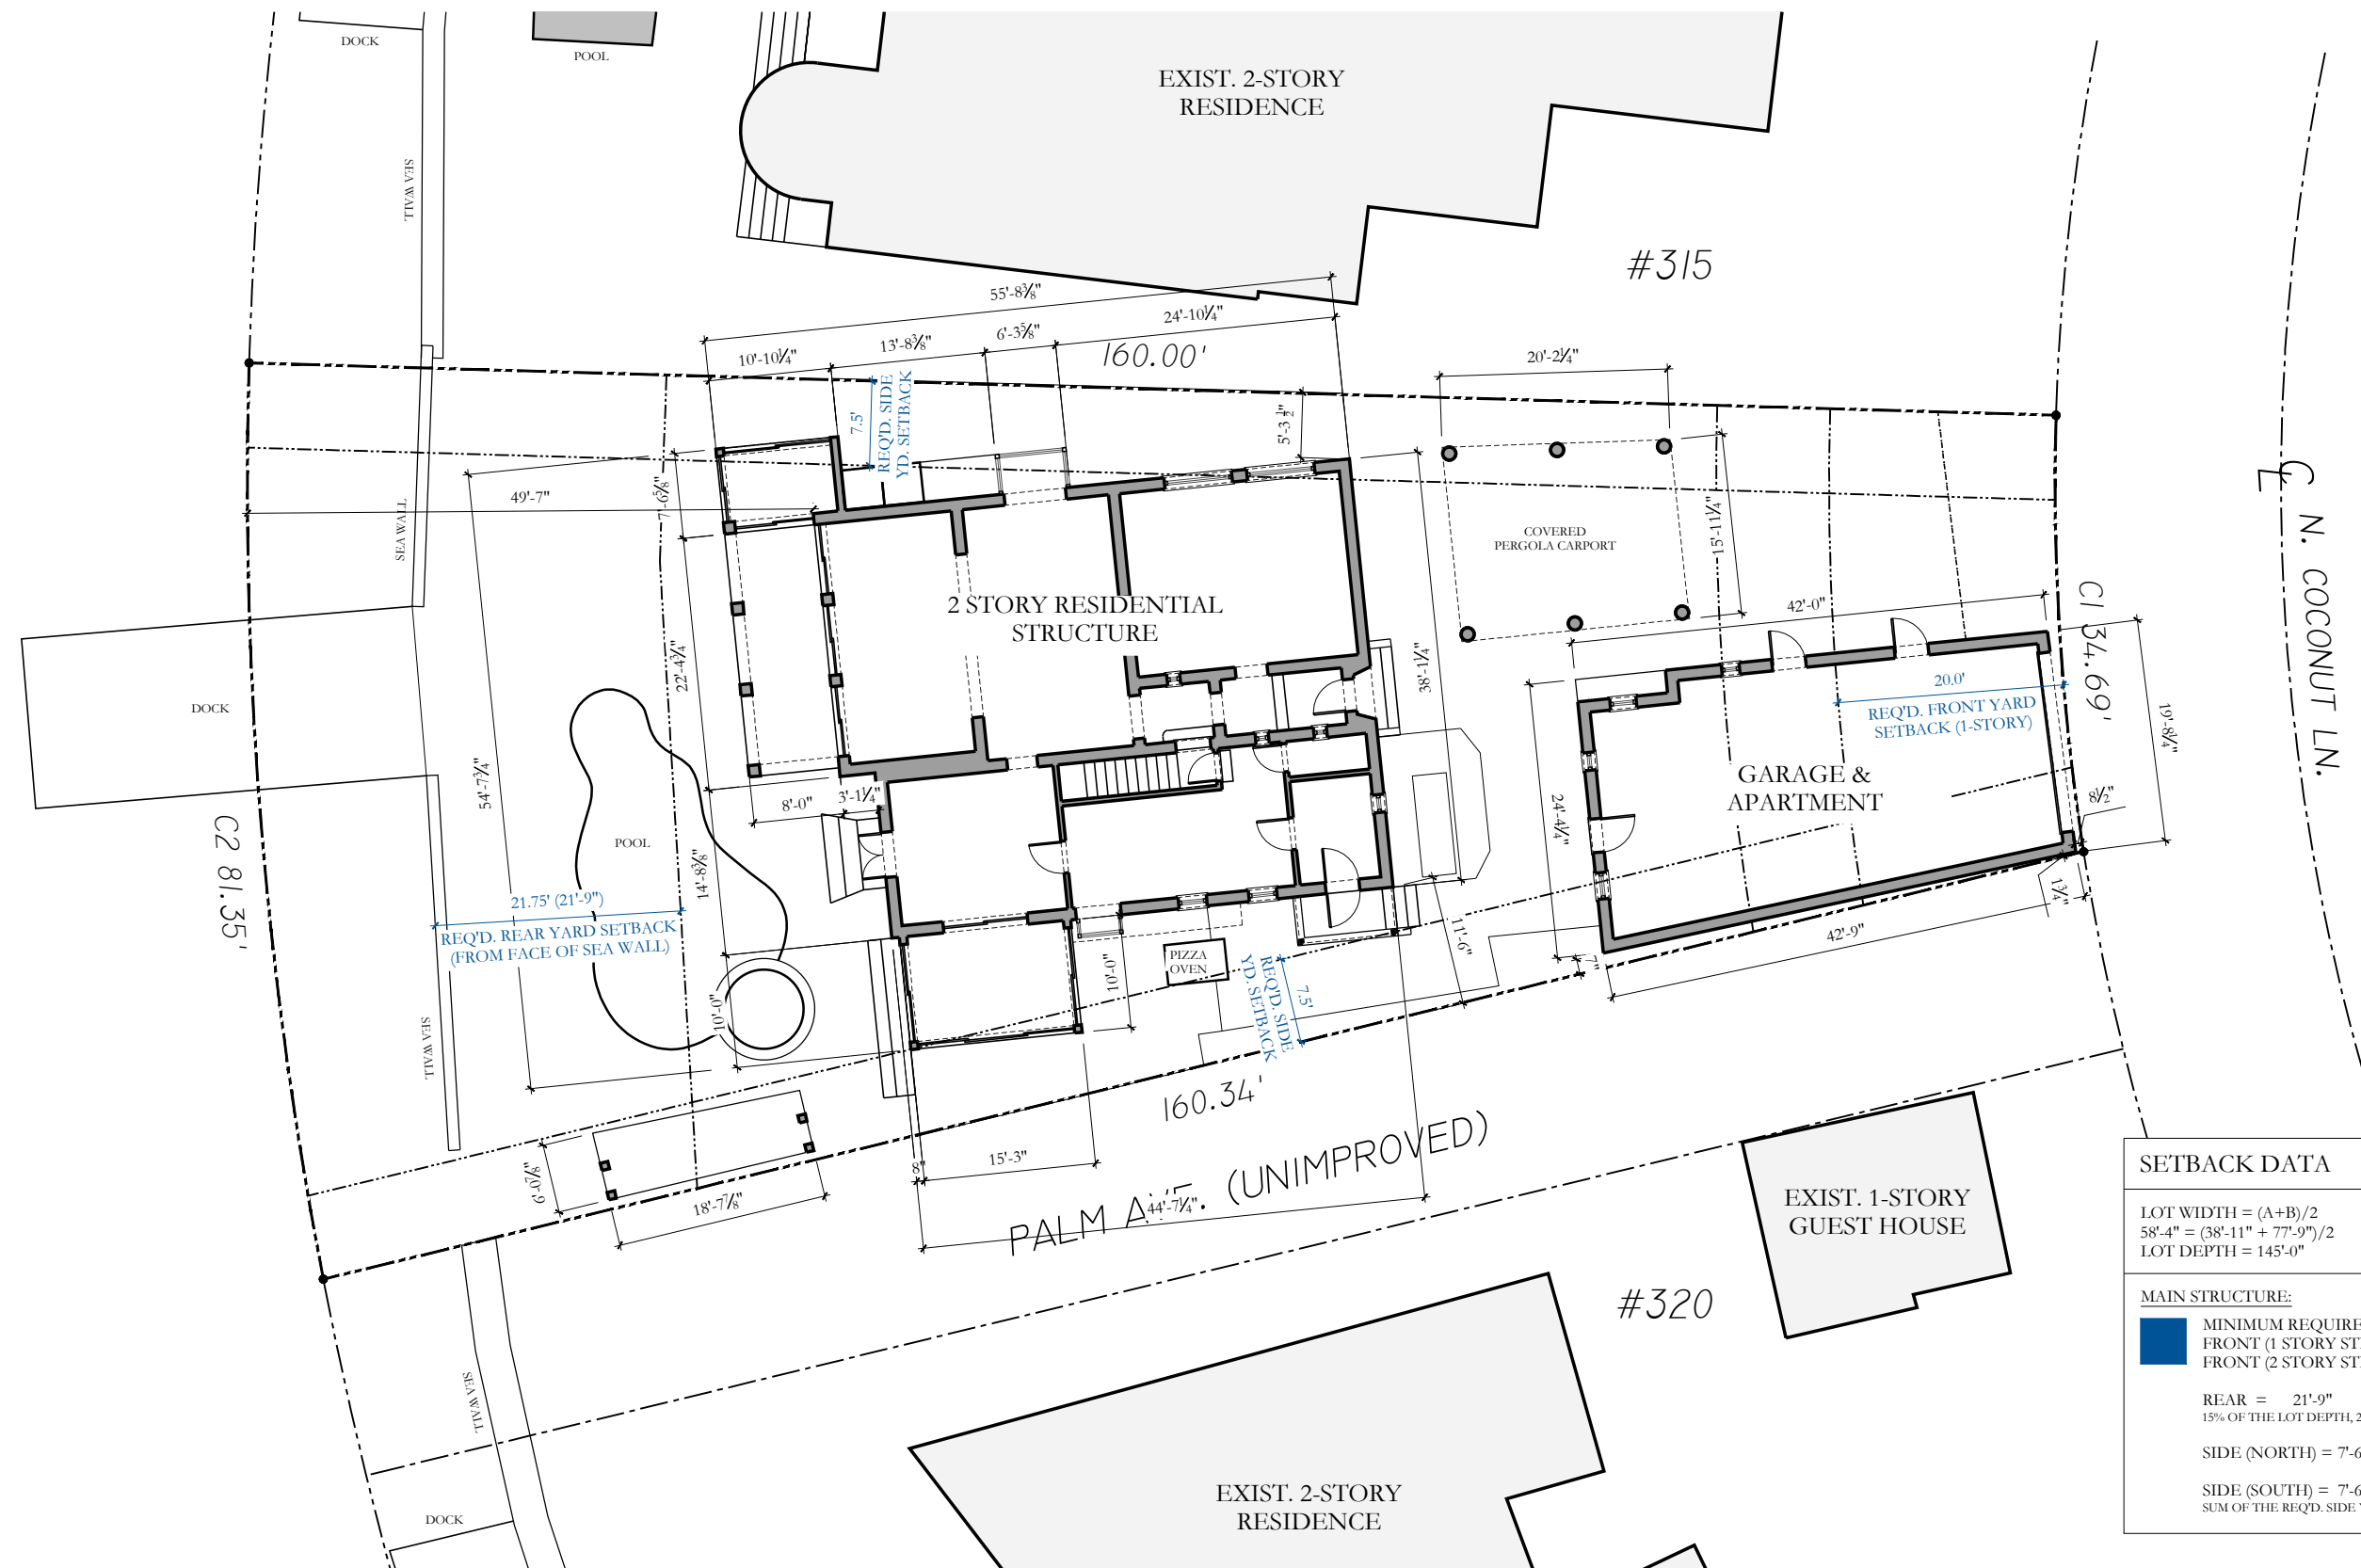

<h1>SETBACK DATA</h1>	
<p>LOT WIDTH = (A+B)/2  58'-4" = (38'-11" + 77'-9")/2  LOT DEPTH = 145'-0"</p>	
<h2><u>MAIN STRUCTURE:</u></h2>	
	<p>MINIMUM REQUIRED SETBACKS:</p> <p>FRONT (1 STORY STRUCTURE) = 20'-0"</p> <p>FRONT (2 STORY STRUCTURE) = 30'-0"</p>
	<p>REAR = 21'-9"</p> <p>15% OF THE LOT DEPTH, 20 FEET MINIMUM, 50 FEET MAXIMUM</p>
	<p>SIDE (NORTH) = 7'-6"</p>
	<p>SIDE (SOUTH) = 7'-6"</p>
	<p>SUM OF THE REQ'D. SIDE YARDS SHALL BE 25% OF THE LOT WIDTH (MIN.)</p>

1 EXISTING CONDITIONS SITE PLAN  
1/16"=1'-0"




**FAIRFAX & SAMMONS**  
— NEW YORK ~ PALM BEACH —

317 N. COCONUT LANE RESIDENCE  
D.R.B. FINAL SUBMITTAL | MIAMI BEACH, FLORIDA | NOVEMBER 8, 2021



This item has been electronically signed and sealed by Richard F. Sammons using a SHA-1 authentication code.

Printed copies of the document are not considered signed and sealed and all SHA-1 authentication code must be verified on any electronic copies.

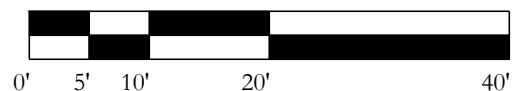

A-101

DRAWINGS, SPECIFICATIONS AND OTHER DOCUMENTS PREPARED BY THE ARCHITECT ARE THE INSTRUMENTS OF THE ARCHITECT'S SERVICE AND SHALL REMAIN THE PROPERTY OF THE ARCHITECT, WHETHER OR NOT THE PROJECTS TO WHICH THEY ARE INTENDED IS CONSTRUCTED OR NOT. THE ARCHITECT'S DRAWINGS, SPECIFICATIONS AND OTHER DOCUMENTS WILL NOT BE USED ON ANY OTHER PROJECTS FOR ADDITIONS TO THIS PROJECT AND/OR FOR COMPLETION OF THIS PROJECT BY OTHERS, EXCEPT BY AGREEMENT IN WRITING AND WITH APPROPRIATE COMPENSATION TO THE ARCHITECT.


© 2021 FAIRFAX, SAMMONS & PARTNERS, LLC








NOTE: ELEVATIONS  
REFERENCED TO NGVD  
SURVEY ELEVATIONS

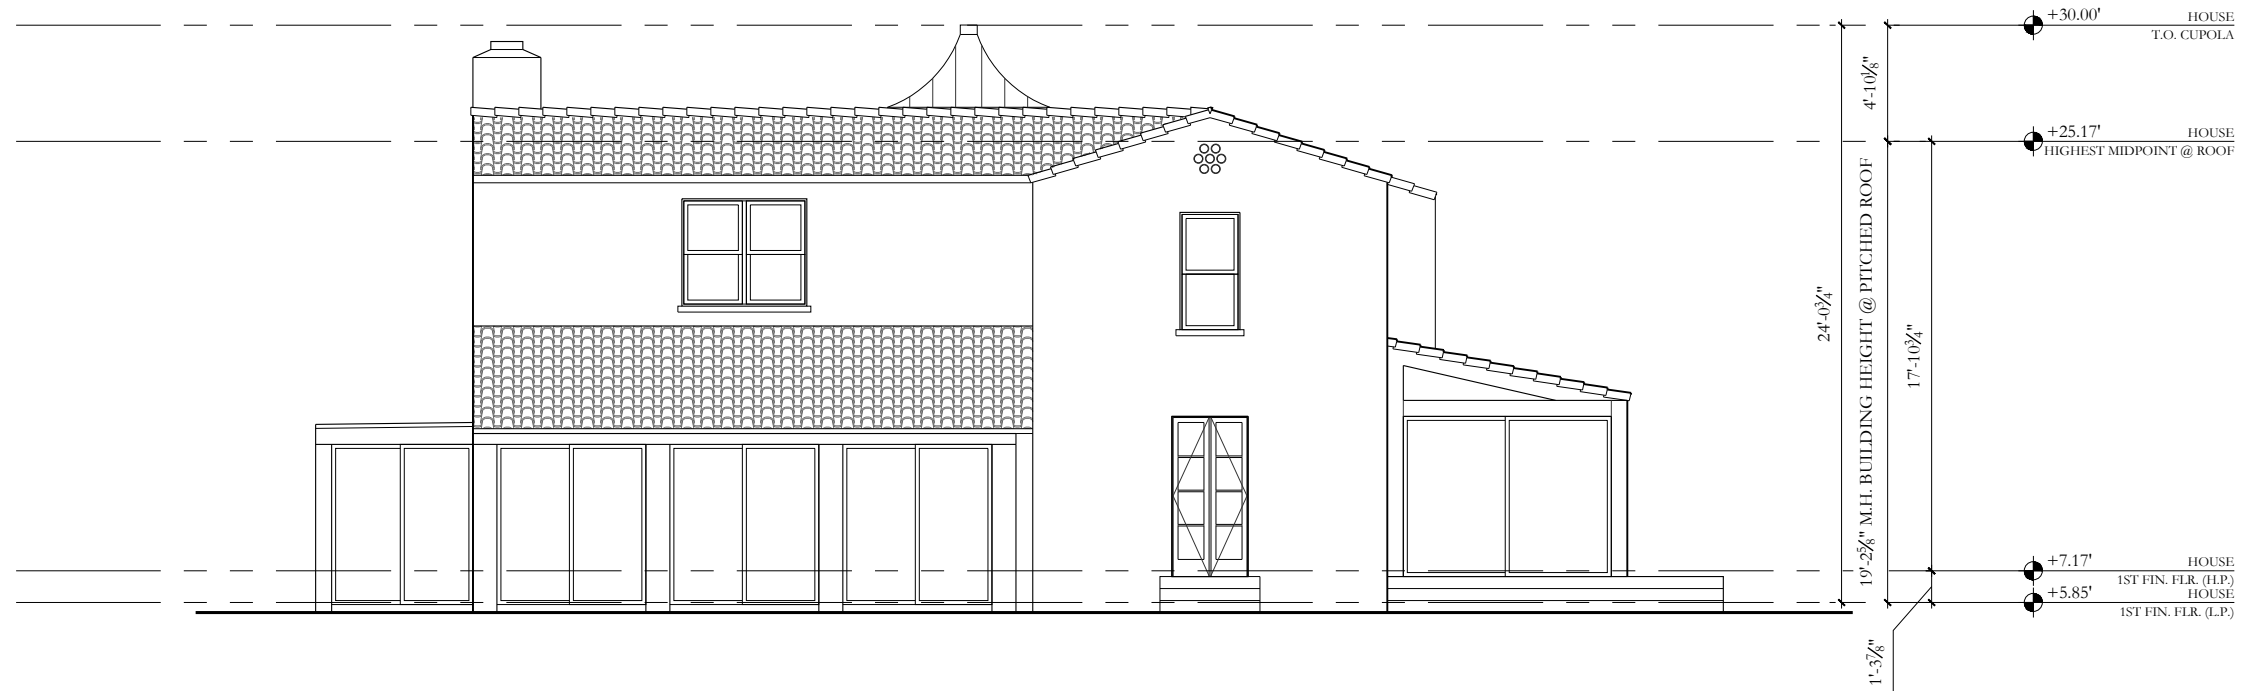

1 EXISTING/DEMO REAR ELEVATION (WEST)  
1/8"=1'-0"

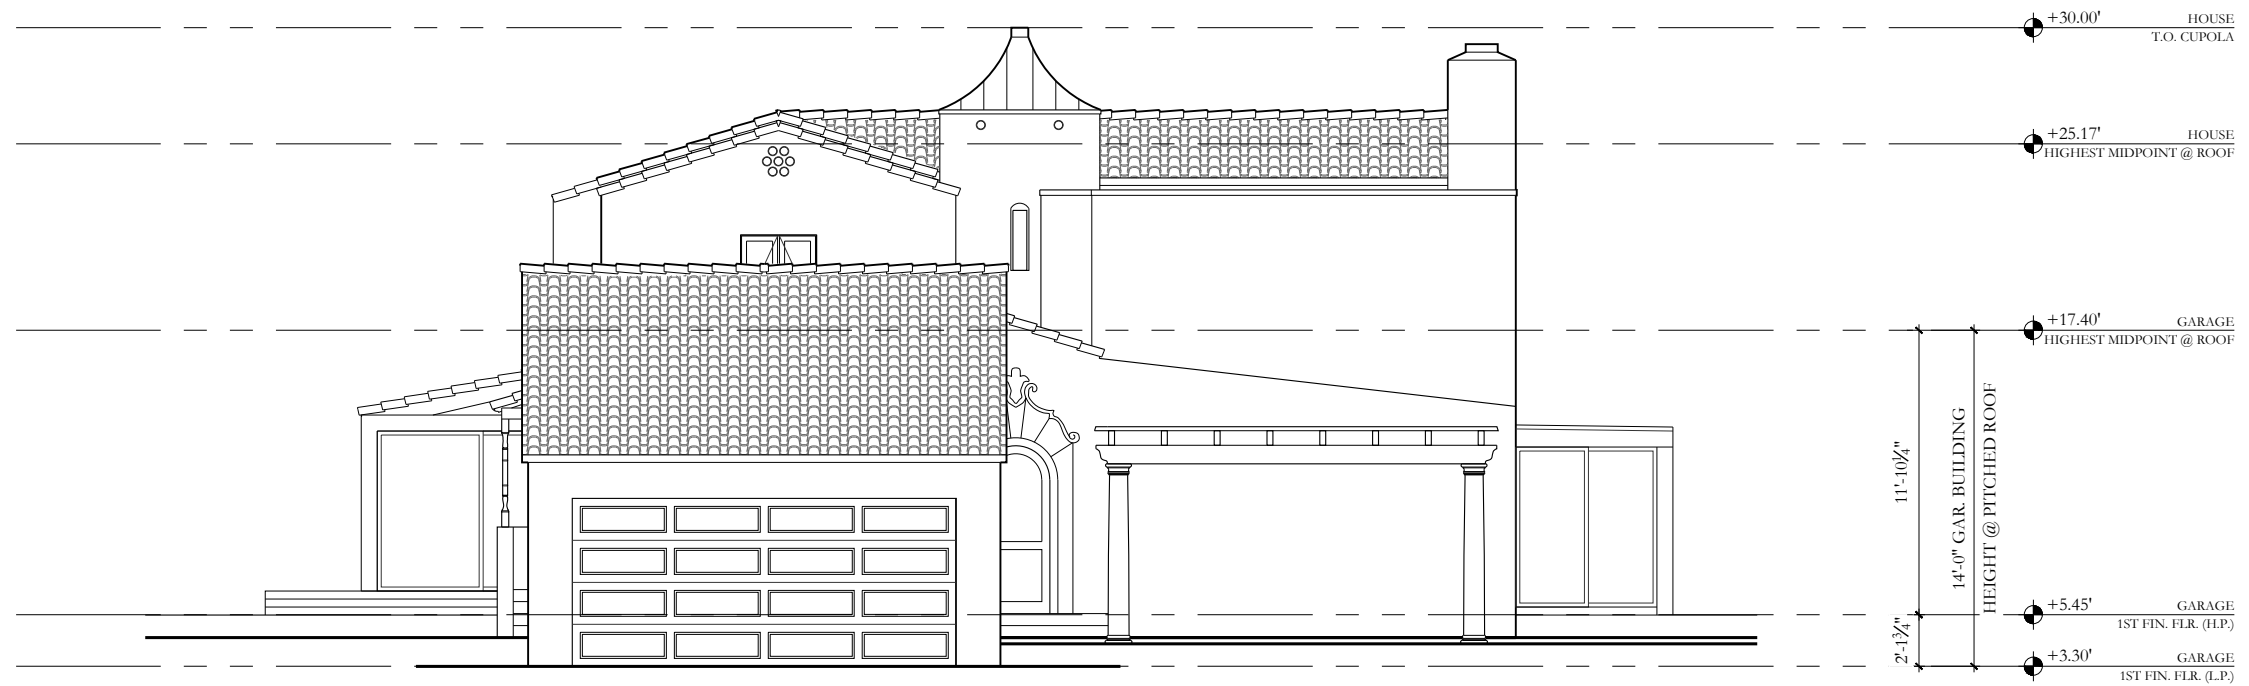


2 EXISTING/DEMO FRONT ELEVATION (EAST)  
1/8"=1'-0"



**FAIRFAX & SAMMONS**  
— NEW YORK ~ PALM BEACH —

317 N. COCONUT LANE RESIDENCE  
D.R.B. FINAL SUBMITTAL | MIAMI BEACH, FLORIDA | NOVEMBER 8, 2021

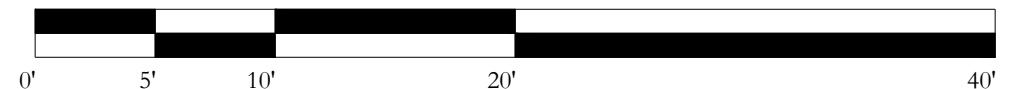


This item has been electronically signed and sealed by Richard F. Sammons using a SHA-1 authentication code.

Printed copies of the document are not considered signed and sealed and all SHA-1 authentication code must be verified on any electronic copies.

DRAWINGS, SPECIFICATIONS AND OTHER DOCUMENTS PREPARED BY THE ARCHITECT ARE THE INSTRUMENTS OF THE ARCHITECT'S SERVICE AND SHALL REMAIN THE PROPERTY OF THE ARCHITECT, WHETHER OR NOT THE PROJECT FOR WHICH THEY ARE INTENDED IS CONSTRUCTED OR NOT. THE ARCHITECT'S DRAWINGS, SPECIFICATIONS AND OTHER DOCUMENTS WILL NOT BE USED ON ANY OTHER PROJECTS FOR ADDITIONS TO THIS PROJECT AND/OR FOR COMPLETION OF THIS PROJECT BY OTHERS, EXCEPT BY AGREEMENT IN WRITING AND WITH APPROPRIATE COMPENSATION TO THE ARCHITECT.

A-110



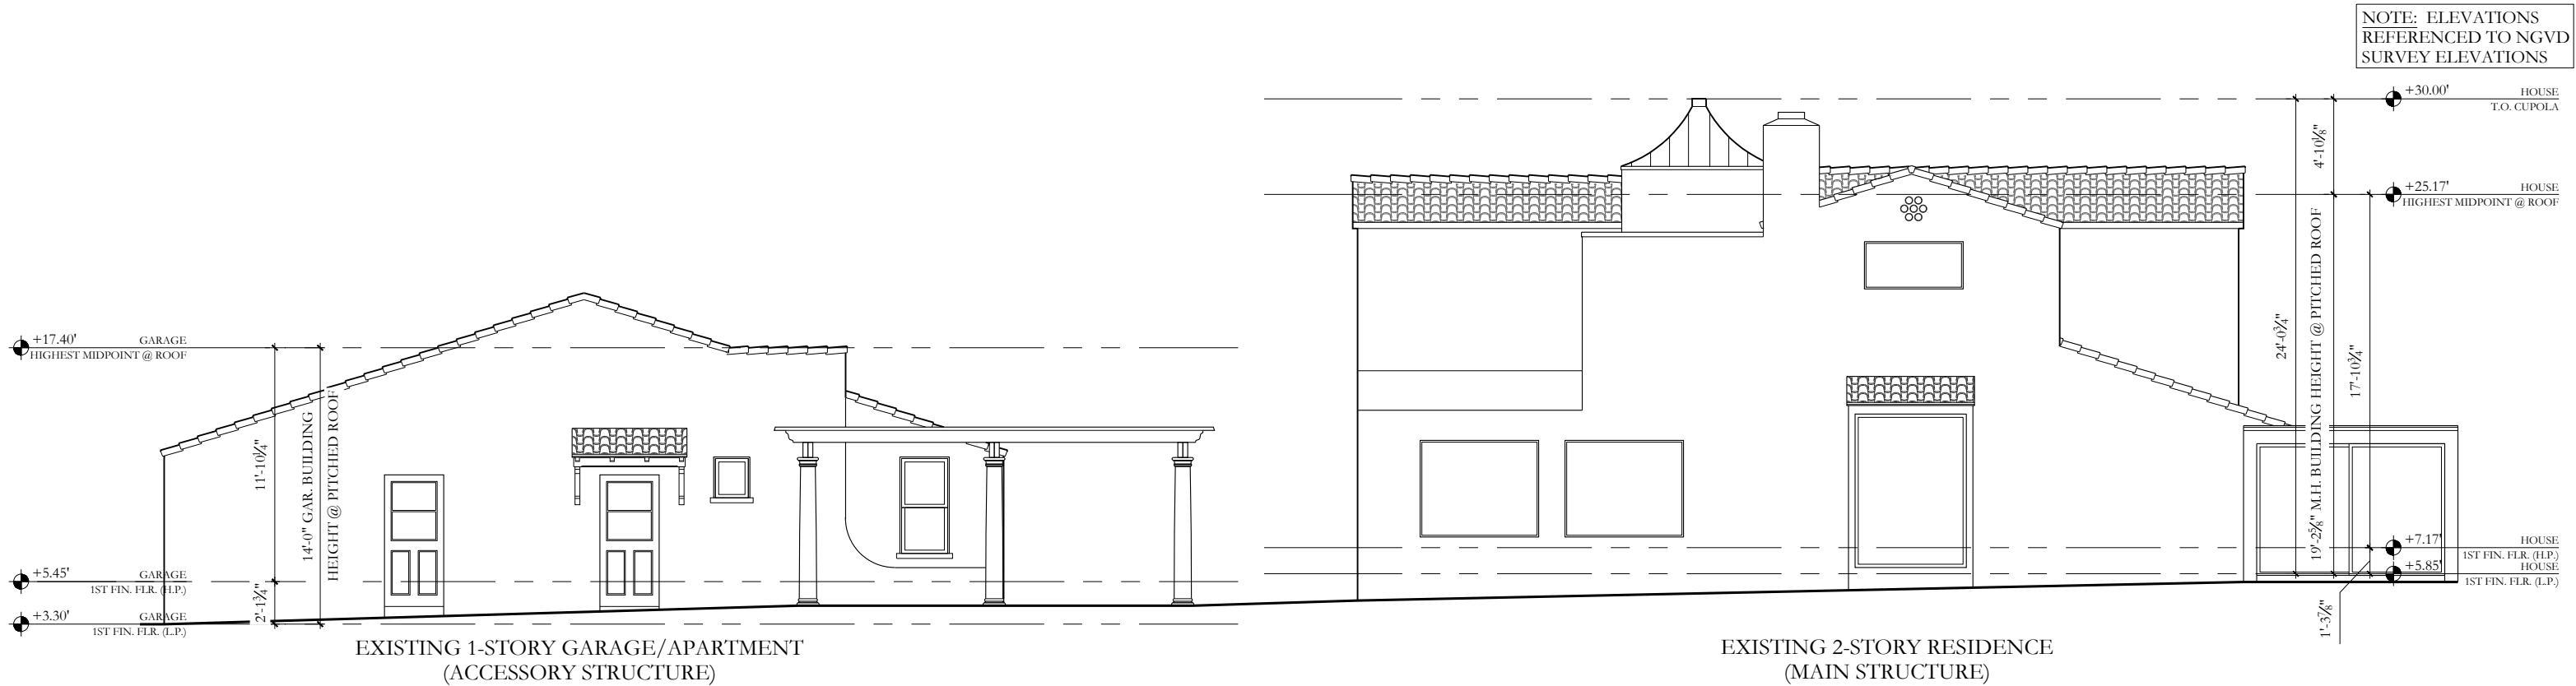

1 EXISTING/DEMO RIGHT ELEVATION (NORTH)  
1/8"=1'-0"



2 EXISTING/DEMO LEFT ELEVATION (SOUTH)  
1/8"=1'-0"



**FAIRFAX & SAMMONS**  
NEW YORK ~ PALM BEACH



DRAWINGS, SPECIFICATIONS AND OTHER DOCUMENTS PREPARED BY THE ARCHITECT ARE THE INSTRUMENTS OF THE ARCHITECT'S SERVICE AND SHALL REMAIN THE PROPERTY OF THE ARCHITECT, WHETHER OR NOT THE PROJECT FOR WHICH THEY ARE INTENDED IS CONSTRUCTED OR NOT. THE ARCHITECT'S DRAWINGS, SPECIFICATIONS AND OTHER DOCUMENTS WILL NOT BE USED ON ANY OTHER PROJECTS FOR ADDITIONS TO THIS PROJECT AND/OR FOR COMPLETION OF THIS PROJECT BY OTHERS, EXCEPT BY AGREEMENT IN WRITING AND WITH APPROPRIATE COMPENSATION TO THE ARCHITECT.  
© 2021 FAIRFAX, SAMMONS & PARTNERS, LLC

317 N. COCONUT LANE RESIDENCE  
D.R.B. FINAL SUBMITTAL | MIAMI BEACH, FLORIDA | NOVEMBER 8, 2021



This item has been electronically signed and sealed by Richard F. Sammons using a SHA-1 authentication code.  
Printed copies of the document are not considered signed and sealed and all SHA-1 authentication code must be verified on any electronic copies.

A-111



MODIFICATION HISTORY NOTES

MAJOR MODIFICATIONS PER PERMIT RECORDS AVAILABLE FROM PUBLIC RECORD SOURCES:

PERMIT #[UNKNOWN] (1929): GARAGE & DOCK ADDITION

PER PERMIT #88966 (1975): ADDED PERGOLA TO WEST SIDE; REMOVED WEST WALL AND ADDED COLUMNS; ADDED TRELLIS AND PERIMETER WALL AT NORTHEAST PATIO; ADDED BAHAMA SHUTTERS TO FACADE; ADDED STORAGE LOFT TO GARAGE INTERIOR

PERMIT NUMBER UNKNOWN (1976): WAIVER TO BUILD A CARPORT

PER PERMIT #BS931703 (1993): REMOVED AND REPLACED TILE W/SAME ALTUSA CLAY

PER PERMIT #B0303409 (2003): INSTALLED NEW SWIMMING POOL & SPA (NO DECK)

PER PERMIT #B0400039 (2003): ADDED 12 WINDOW AWNINGS

PER PERMIT #B0402754 (2004): INSTALLED 18 IMPACT WINDOWS

PER PERMIT #UNKNOWN (TBD): INSTALLED BBQ PERGOLA FOLLOWING MINOR PERMIT B070491 FOR RESURFACING & MISC. PERMITS FOR ELEC, PLUMBING & BOILER

PER PERMIT #B0400039 (2014): INSTALLED 7 ALUM. PANEL SHUTTERS, 5 IMPACT WINDOWS, 3 IMPACT SLIDING GLASS DOORS, 1 IMPACT SWING DOOR AND 1 ACCORDION (9 OPENINGS)

PER PERMIT #RFR1900905 (2019): RE-ROOF OF TILE & FLAT ROOFS

MODIFICATION HISTORY LEGEND

MODIFIED AREA PER #[UNKNOWN] (1929) SHOWN IN GREEN

MODIFIED AREA PER #88966 (1975) SHOWN IN BLUE

MODIFIED AREA PER #[UNKNOWN] (1976) SHOWN IN RED

MODIFIED AREA PER #B0303409 (2003) SHOWN IN YELLOW

MODIFIED AREA PER #B0402754 (2004) SHOWN IN CYAN

MODIFIED AREA #B0400039 (2014) SHOWN IN MAGENTA

MODIFIED AREA (DATE UNKNOWN) SHOWN IN GRAY

SETBACK DATA


LOT WIDTH = (A+B)/2  
58'-4" = (38'-11" + 77'-9")/2  
LOT DEPTH = 145'-0" [LAND]

MAIN STRUCTURE:  
MINIMUM REQUIRED SETBACKS:  
FRONT (1 STORY STRUCTURE) = 20'-0" (A.)  
FRONT (2 STORY STRUCTURE) = 30'-0" (B.)

REAR = 21'-9" (C.)  
15% OF THE LOT DEPTH, 20 FEET MINIMUM, 50 FEET MAXIMUM

SIDE (NORTH) = 7'-6" (D.)


SIDE (SOUTH) = 7'-6" (E.)  
SUM OF THE REQ'D. SIDE YARDS SHALL BE 25% OF THE LOT WIDTH (MIN.)

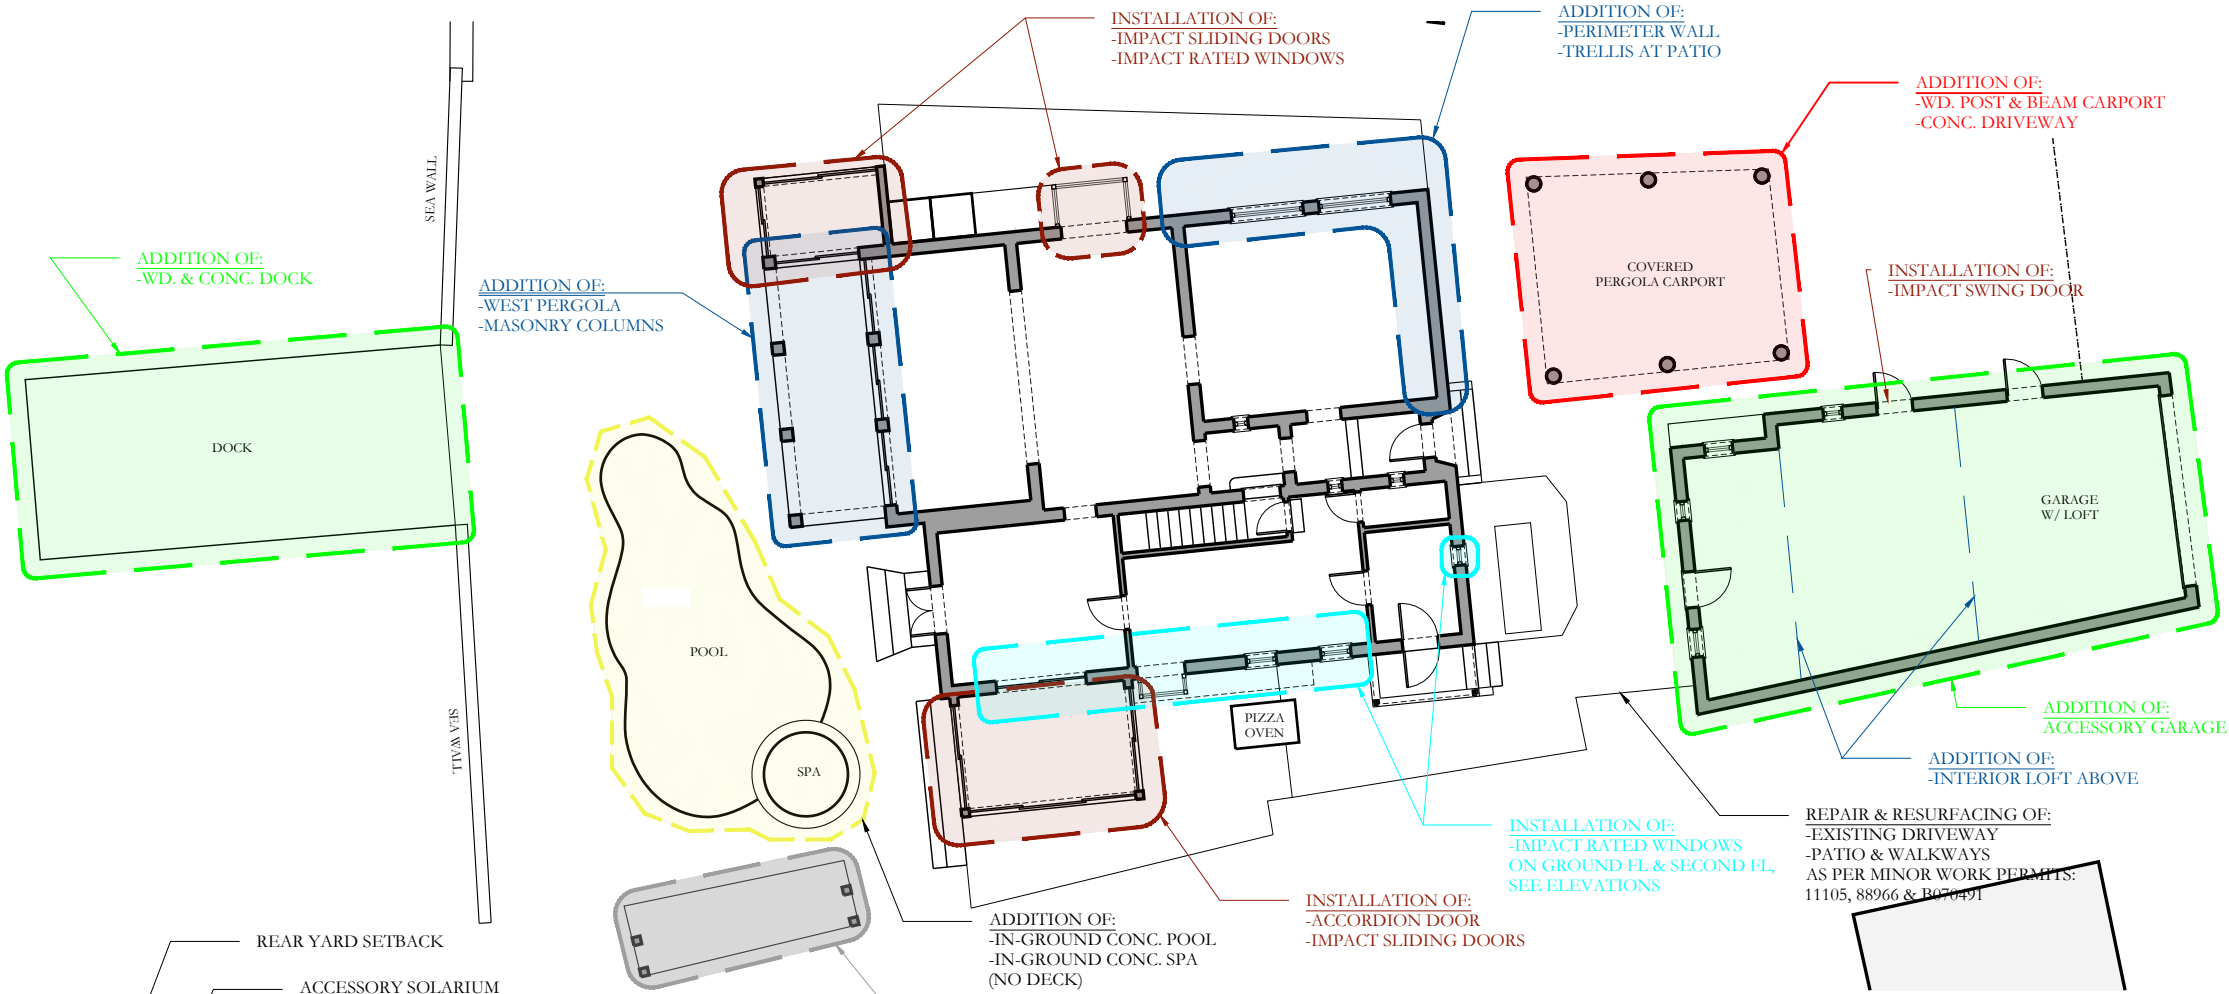

1

EXISTING RESIDENCE MODIFICATION HISTORY PLAN

1/16"=1'-0"

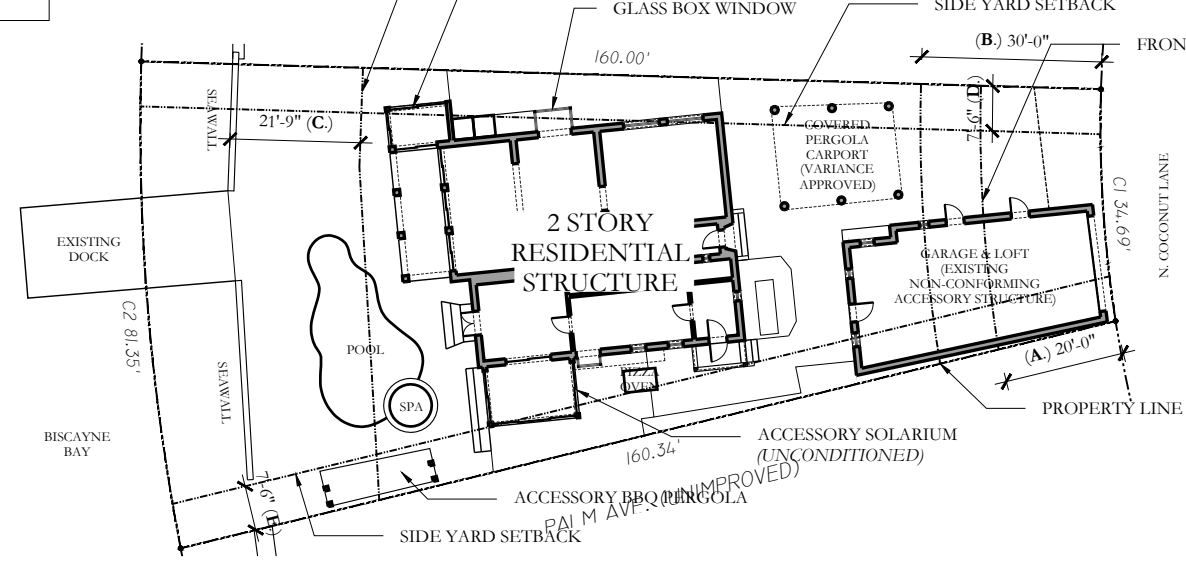

2

EXISTING SITE & RESIDENCE KEY PLAN

1/32"=1'-0"


DRAWINGS, SPECIFICATIONS AND OTHER DOCUMENTS PREPARED BY THE ARCHITECT ARE THE INSTRUMENTS OF THE ARCHITECT'S SERVICE AND SHALL REMAIN THE PROPERTY OF THE ARCHITECT, WHETHER OR NOT THE PROJECT FOR WHICH THEY ARE INTENDED IS CONSTRUCTED OR NOT. THE ARCHITECT'S DRAWINGS, SPECIFICATIONS AND OTHER DOCUMENTS WILL NOT BE USED ON ANY OTHER PROJECTS FOR ADDITIONS TO THIS PROJECT AND/OR FOR COMPLETION OF THIS PROJECT BY OTHERS, EXCEPT BY AGREEMENT IN WRITING AND WITH APPROPRIATE COMPENSATION TO THE ARCHITECT.

© 2021 FAIRFAX, SAMMONS & PARTNERS, LLC




MODIFICATION HISTORY LEGEND	
MODIFIED AREA PER #[UNKNOWN] (1929) SHOWN IN GREEN	
MODIFIED AREA PER #88966 (1975) SHOWN IN BLUE	
MODIFIED AREA PER #[UNKNOWN] (1976) SHOWN IN RED	
MODIFIED AREA PER #B0303409 (2003) SHOWN IN YELLOW	
MODIFIED AREA PER #B0402754 (2004) SHOWN IN CYAN	
MODIFIED AREA #B0400039 (2014) SHOWN IN MAGENTA	
MODIFIED AREA (DATE UNKNOWN) SHOWN IN GRAY	

NOTE: ELEVATIONS  
REFERENCED TO NGVD  
SURVEY ELEVATIONS

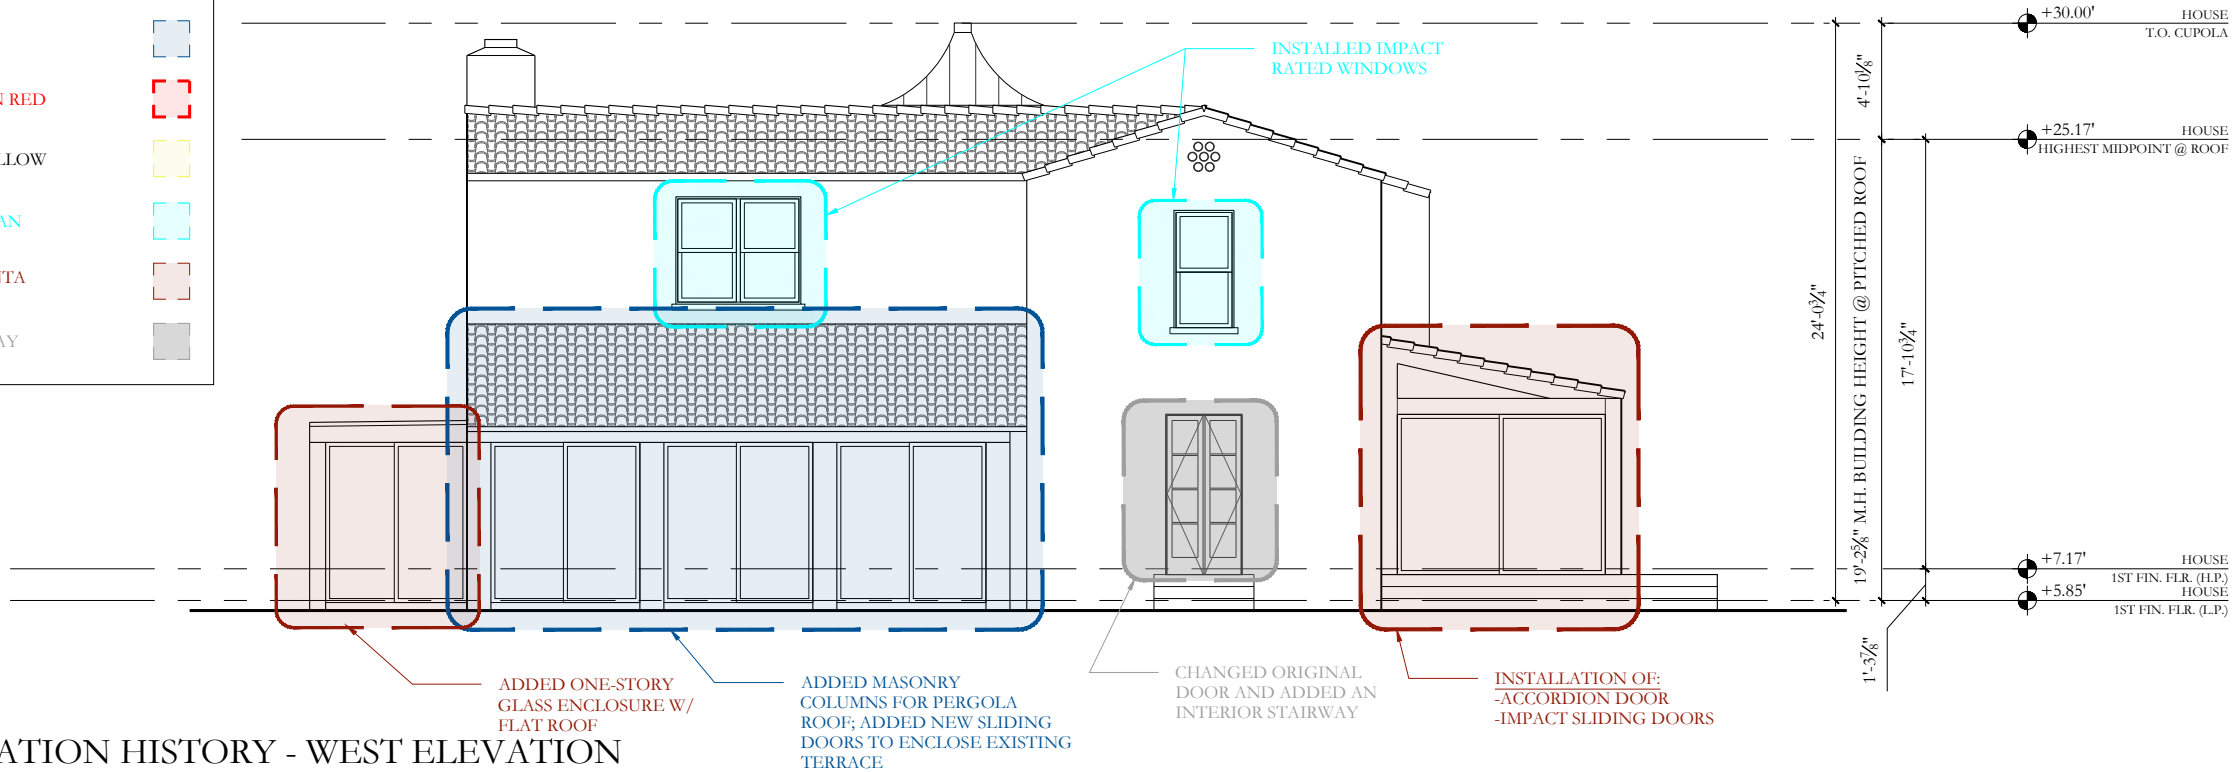

1 MODIFICATION HISTORY - WEST ELEVATION  
1/8"=1'-0"

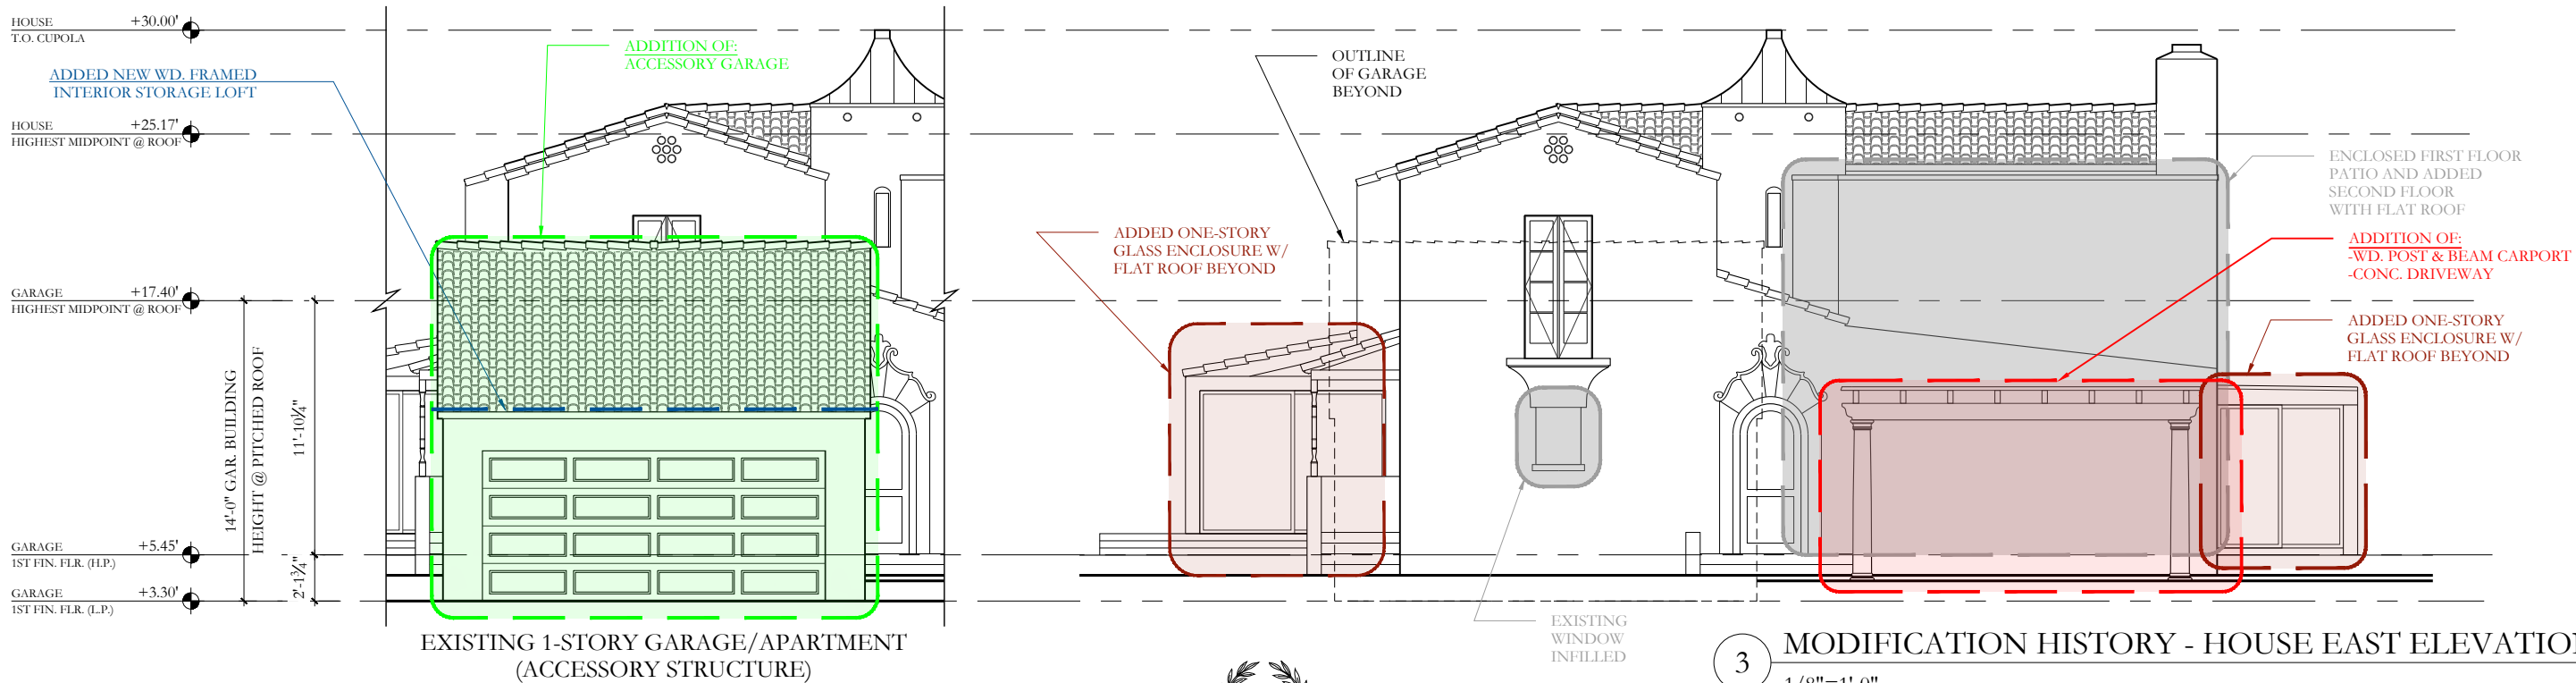

2 MODIFICATION HISTORY - GARAGE EAST ELEVATION  
1/8"=1'-0"

3 MODIFICATION HISTORY - HOUSE EAST ELEVATION  
1/8"=1'-0"



**FAIRFAX & SAMMONS**  
NEW YORK ~ PALM BEACH

317 N. COCONUT LANE RESIDENCE  
D.R.B. FINAL SUBMITTAL | MIAMI BEACH, FLORIDA | NOVEMBER 8, 2021


 







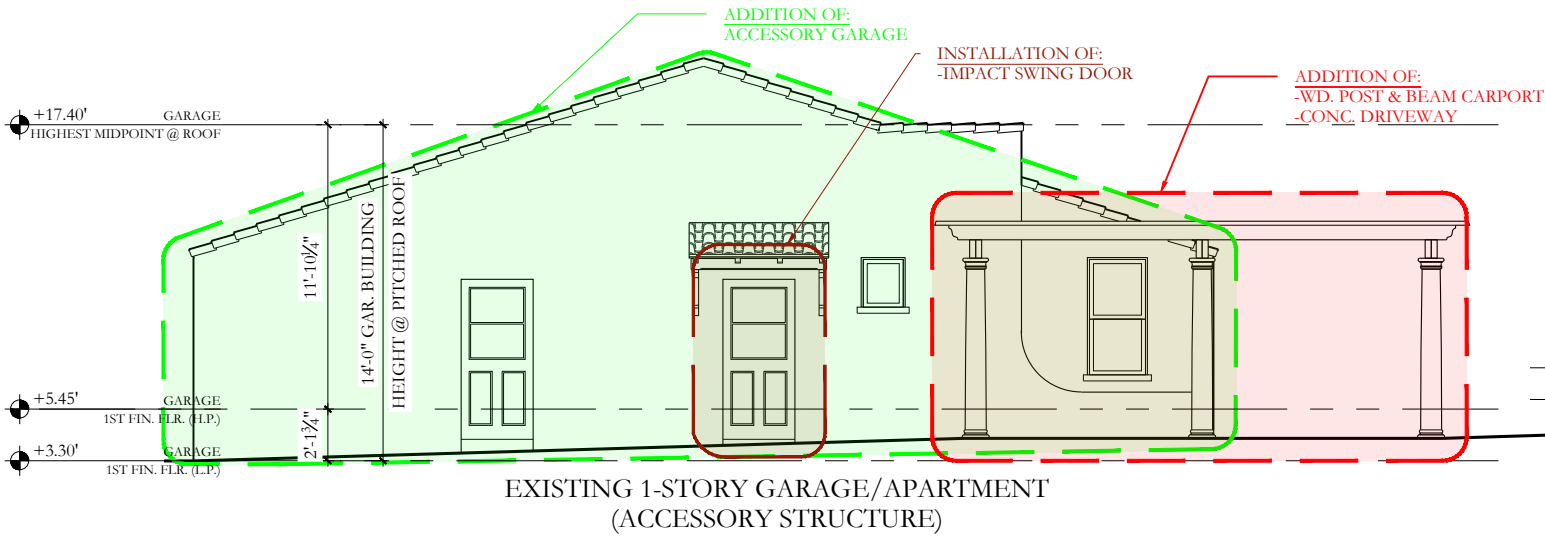
This item has been electronically signed and sealed by  
Richard F. Sammons using a SHA-1 authentication code.  
Printed copies of this document are not considered  
signed and sealed and all SHA-1 authentication code  
must be verified on any electronic copies.

DRAWINGS, SPECIFICATIONS AND OTHER DOCUMENTS PREPARED BY THE ARCHITECT ARE THE INSTRUMENTS OF THE ARCHITECT'S SERVICE AND SHALL REMAIN THE PROPERTY OF THE ARCHITECT, WHETHER OR NOT THE PROJECT FOR WHICH THEY ARE INTENDED IS CONSTRUCTED OR NOT. THE ARCHITECT'S DRAWINGS, SPECIFICATIONS AND OTHER DOCUMENTS WILL NOT BE USED ON ANY OTHER PROJECTS FOR ADDITIONS TO THIS PROJECT AND/OR FOR COMPLETION OF THIS PROJECT BY OTHERS, EXCEPT BY AGREEMENT IN WRITING AND WITH APPROPRIATE COMPENSATION TO THE ARCHITECT.  
© 2021 FAIRFAX, SAMMONS & PARTNERS, LLC


A-121




MODIFICATION HISTORY LEGEND			
MODIFIED AREA PER #[UNKNOWN] (1929) SHOWN IN GREEN		MODIFIED AREA PER #B0402754 (2004) SHOWN IN CYAN	
MODIFIED AREA PER #88966 (1975) SHOWN IN BLUE		MODIFIED AREA #B0400039 (2014) SHOWN IN MAGENTA	
MODIFIED AREA PER #[UNKNOWN] (1976) SHOWN IN RED		MODIFIED AREA (DATE UNKNOWN) SHOWN IN GRAY	
MODIFIED AREA PER #B0303409 (2003) SHOWN IN YELLOW			



1 MODIFICATION HISTORY - NORTH ELEVATION  
1/8"=1'-0"

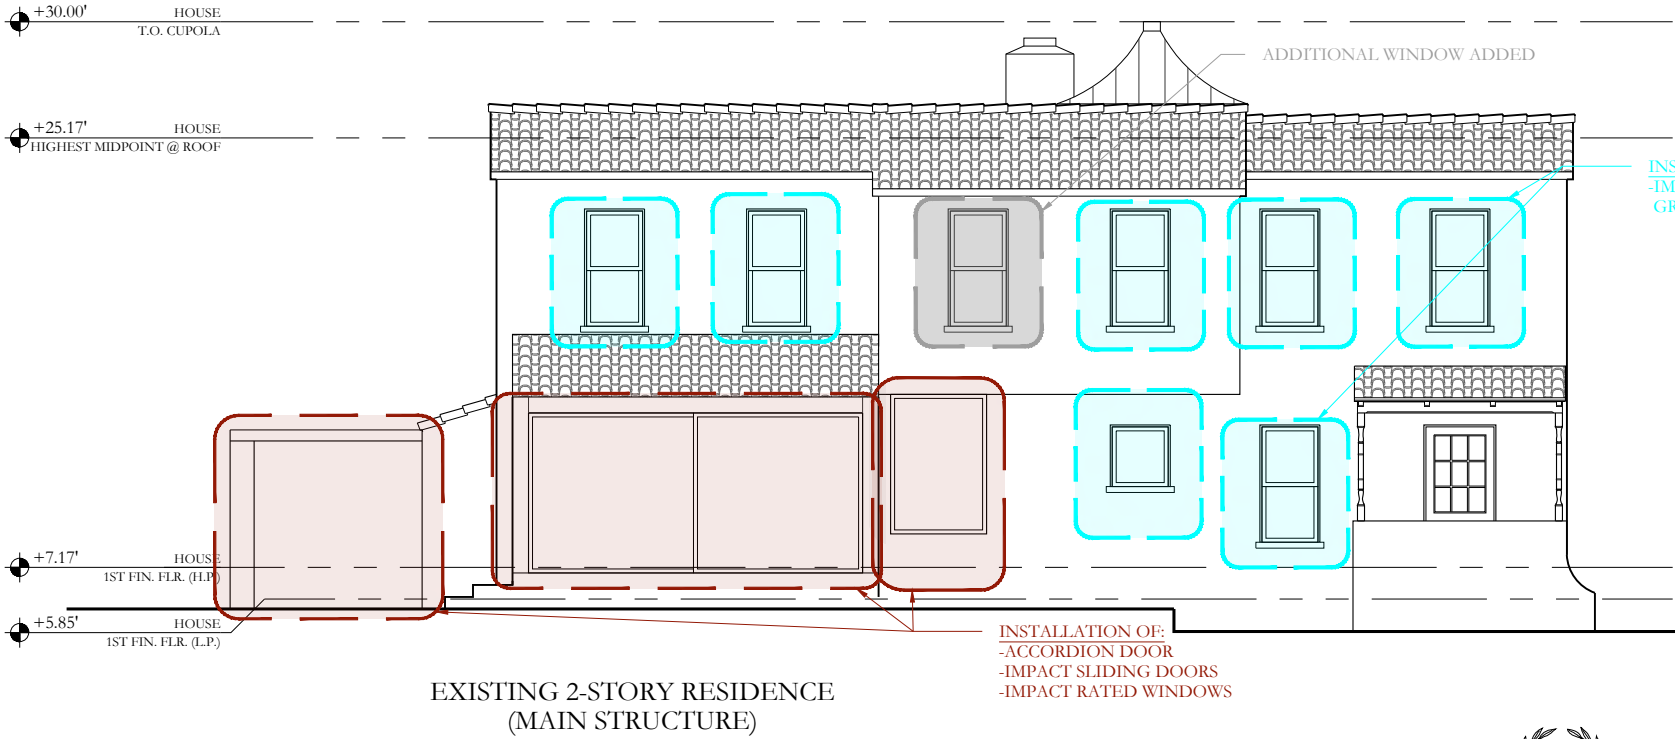

2 MODIFICATION HISTORY - SOUTH ELEVATION  
1/8"=1'-0"

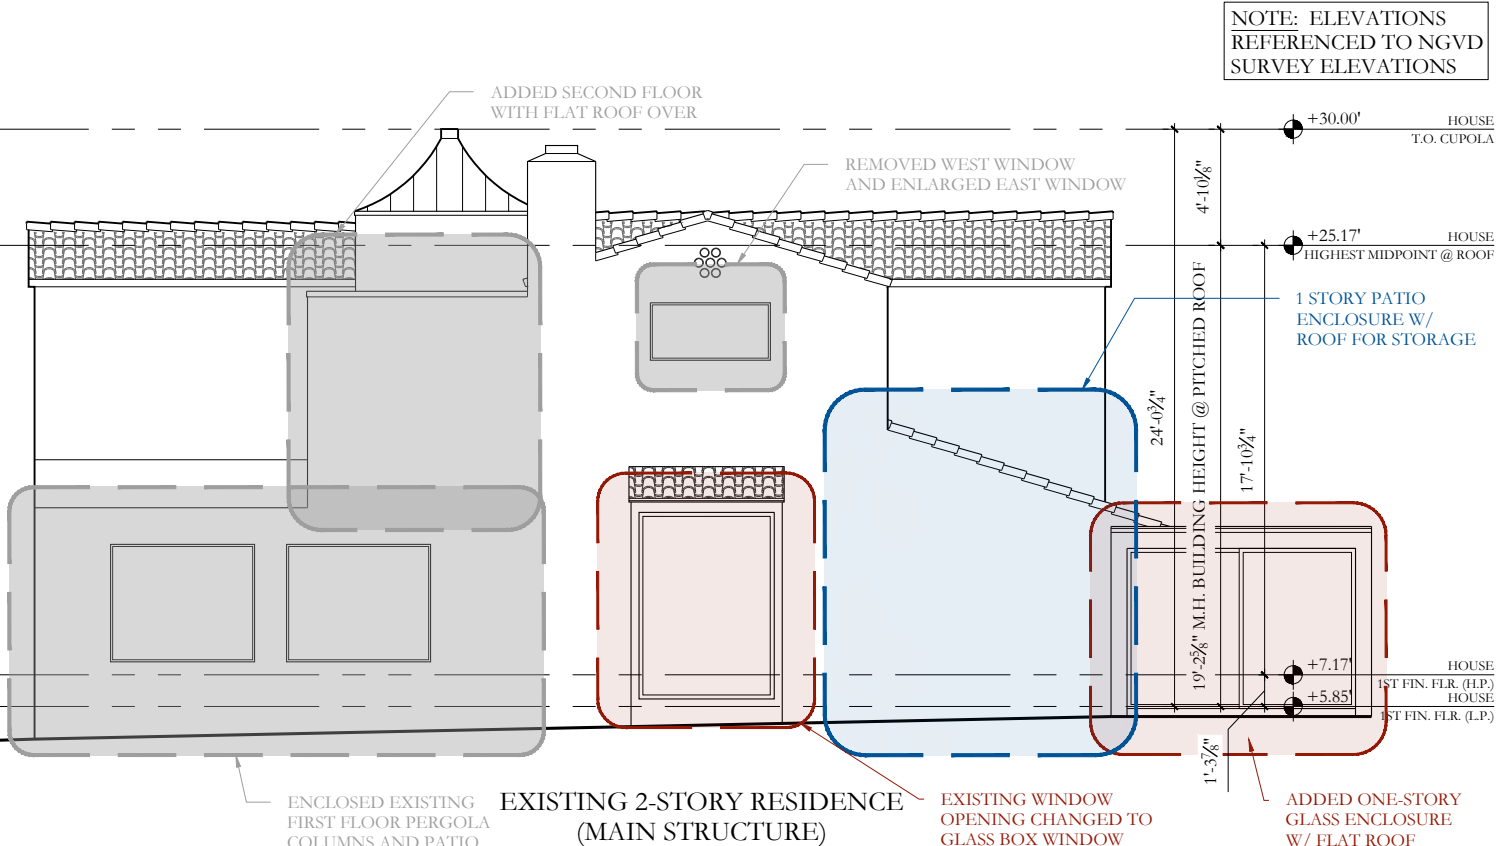


NOTE: ELEVATIONS REFERENCED TO NGVD SURVEY ELEVATIONS



**FAIRFAX & SAMMONS**  
NEW YORK ~ PALM BEACH

317 N. COCONUT LANE RESIDENCE  
D.R.B. FINAL SUBMITTAL | MIAMI BEACH, FLORIDA | NOVEMBER 8, 2021

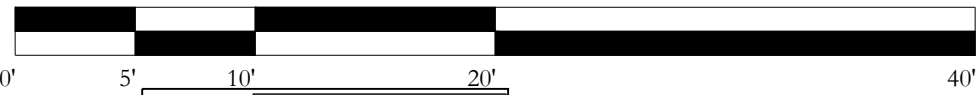

DRAWINGS, SPECIFICATIONS AND OTHER DOCUMENTS PREPARED BY THE ARCHITECT ARE THE INSTRUMENTS OF THE ARCHITECT'S SERVICE AND SHALL REMAIN THE PROPERTY OF THE ARCHITECT, WHETHER OR NOT THE PROJECT FOR WHICH THEY ARE INTENDED IS CONSTRUCTED OR NOT. THE ARCHITECT'S DRAWINGS, SPECIFICATIONS AND OTHER DOCUMENTS WILL NOT BE USED ON ANY OTHER PROJECTS FOR ADDITIONS TO THIS PROJECT AND/OR FOR COMPLETION OF THIS PROJECT BY OTHERS, EXCEPT BY AGREEMENT IN WRITING AND WITH APPROPRIATE COMPENSATION TO THE ARCHITECT.  
© 2021 FAIRFAX, SAMMONS & PARTNERS, LLC

This item has been electronically signed and sealed by Richard F. Sammons using a SHA-1 authentication code.

Printed copies of the document are not considered signed and sealed and all SHA-1 authentication code must be verified on any electronic copies.






1 FRONT VIEW (1929 - 1975 ) PRIOR TO CAR PORT & GATE  
1/32"=1'-0"



2 FRONT VIEW (PRESENT DAY) AFTER CAR PORT & GATE  
1/32"=1'-0"

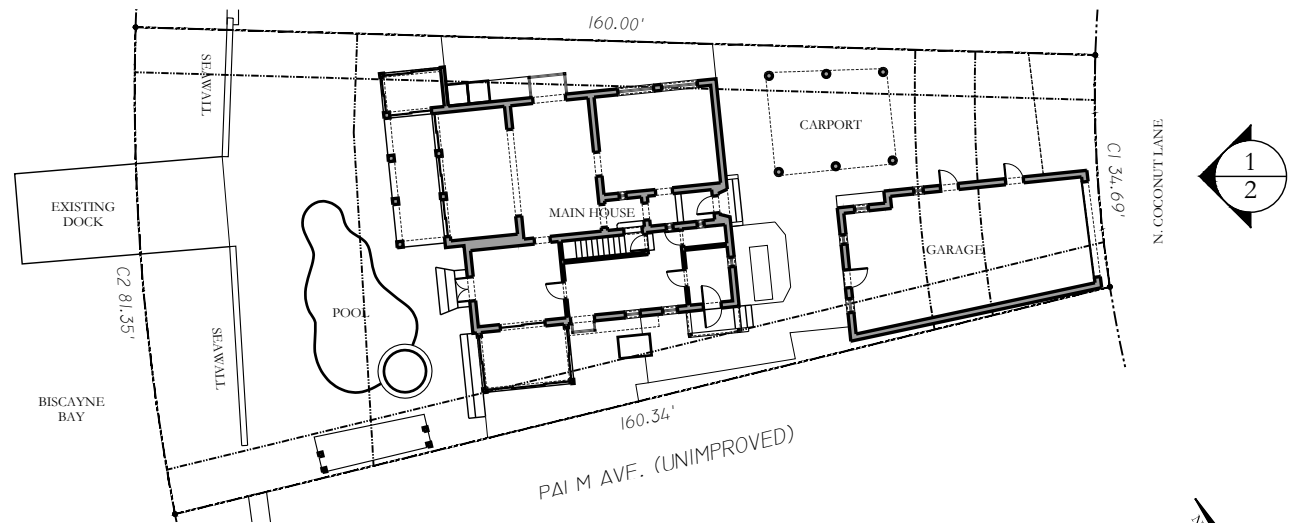


3 EXISTING SITE & RESIDENCE KEY PLAN  
1/32"=1'-0"



**FAIRFAX & SAMMONS**  
NEW YORK ~ PALM BEACH

317 N. COCONUT LANE RESIDENCE  
D.R.B. FINAL SUBMITTAL | MIAMI BEACH, FLORIDA | NOVEMBER 8, 2021

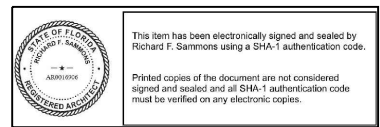

A-123

DRAWINGS, SPECIFICATIONS AND OTHER DOCUMENTS PREPARED BY THE ARCHITECT ARE THE INSTRUMENTS OF THE ARCHITECT'S SERVICE AND SHALL REMAIN THE PROPERTY OF THE ARCHITECT, WHETHER OR NOT THE PROJECT FOR WHICH THEY ARE INTENDED IS CONSTRUCTED OR NOT. THE ARCHITECT'S DRAWINGS, SPECIFICATIONS AND OTHER DOCUMENTS WILL NOT BE USED ON ANY OTHER PROJECTS FOR ADDITIONS TO THIS PROJECT AND/OR FOR COMPLETION OF THIS PROJECT BY OTHERS, EXCEPT BY AGREEMENT IN WRITING AND WITH APPROPRIATE COMPENSATION TO THE ARCHITECT.  
© 2021 FAIRFAX, SAMMONS & PARTNERS, LLC






1 FRONT VIEW (1929 - 1975 ) PRIOR TO CAR PORT & GATE  
NTS



2 FRONT VIEW (1975 - 2000s) AFTER CAR PORT  
NTS



3 FRONT VIEW (PRESENT DAY) AFTER REPAVING  
NTS


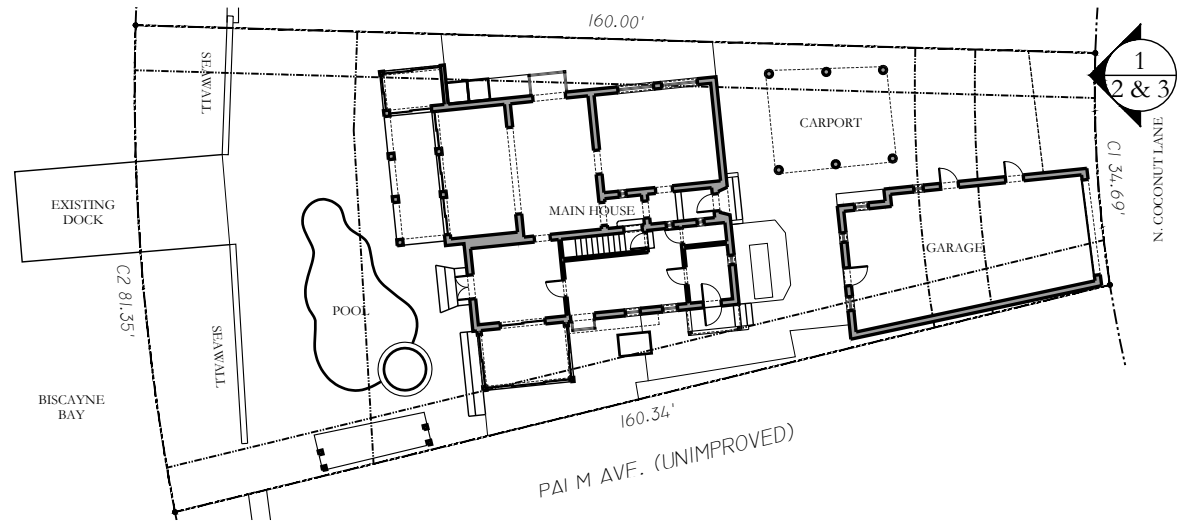


4 EXISTING SITE & RESIDENCE KEY PLAN  
1/32"=1'-0"



**FAIRFAX & SAMMONS**  
NEW YORK ~ PALM BEACH

317 N. COCONUT LANE RESIDENCE  
D.R.B. FINAL SUBMITTAL | MIAMI BEACH, FLORIDA | NOVEMBER 8, 2021

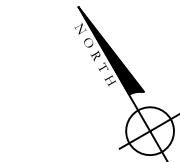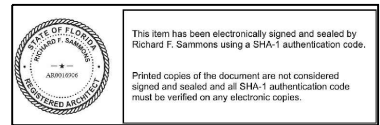

A-124

DRAWINGS, SPECIFICATIONS AND OTHER DOCUMENTS PREPARED BY THE ARCHITECT ARE THE INSTRUMENTS OF THE ARCHITECT'S SERVICE AND SHALL REMAIN THE PROPERTY OF THE ARCHITECT, WHETHER OR NOT THE PROJECT FOR WHICH THEY ARE INTENDED IS CONSTRUCTED OR NOT. THE ARCHITECT'S DRAWINGS, SPECIFICATIONS AND OTHER DOCUMENTS WILL NOT BE USED ON ANY OTHER PROJECTS FOR ADDITIONS TO THIS PROJECT AND/OR FOR COMPLETION OF THIS PROJECT BY OTHERS, EXCEPT BY AGREEMENT IN WRITING AND WITH APPROPRIATE COMPENSATION TO THE ARCHITECT.  
© 2021 FAIRFAX, SAMMONS & PARTNERS, LLC






1 SIDE VIEW (1929 - 1975 ) PRIOR TO WINDOW REPLACEMENTS  
NTS



2 SIDE VIEW (PRESENT DAY) AFTER WINDOW REPLACEMENTS & AWNINGS ADDED  
NTS

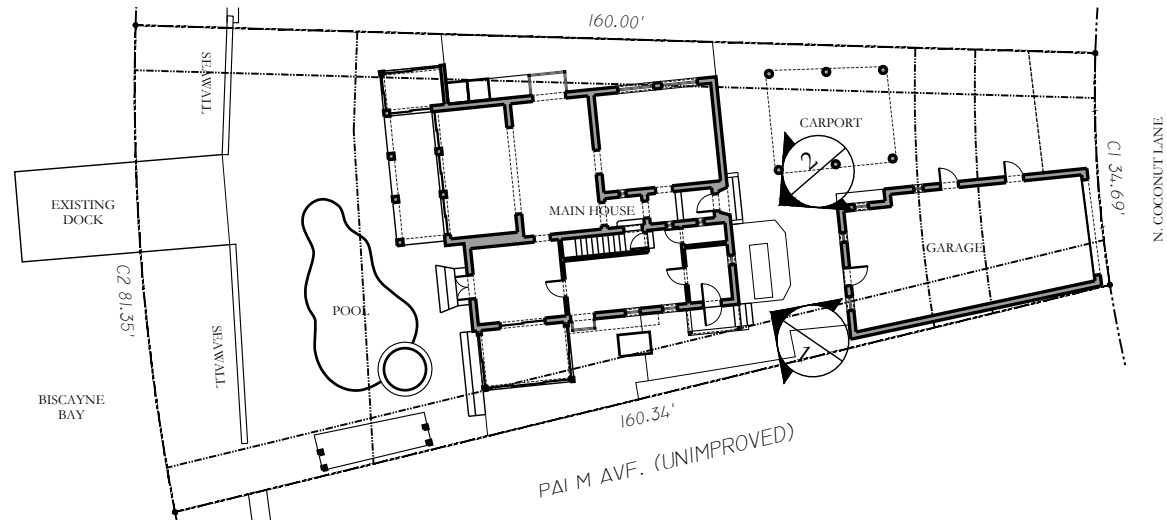


3 EXISTING SITE & RESIDENCE KEY PLAN  
1/32"=1'-0"



**FAIRFAX & SAMMONS**  
NEW YORK ~ PALM BEACH

317 N. COCONUT LANE RESIDENCE  
D.R.B. FINAL SUBMITTAL | MIAMI BEACH, FLORIDA | NOVEMBER 8, 2021

DRAWINGS, SPECIFICATIONS AND OTHER DOCUMENTS PREPARED BY THE ARCHITECT ARE THE INSTRUMENTS OF THE ARCHITECT'S SERVICE AND SHALL REMAIN THE PROPERTY OF THE ARCHITECT, WHETHER OR NOT THE PROJECT FOR WHICH THEY ARE INTENDED IS CONSTRUCTED OR NOT. THE ARCHITECT'S DRAWINGS, SPECIFICATIONS AND OTHER DOCUMENTS WILL NOT BE USED ON ANY OTHER PROJECTS FOR ADDITIONS TO THIS PROJECT AND/OR FOR COMPLETION OF THIS PROJECT BY OTHERS, EXCEPT BY AGREEMENT IN WRITING AND WITH APPROPRIATE COMPENSATION TO THE ARCHITECT.  
© 2021 FAIRFAX, SAMMONS & PARTNERS, LLC

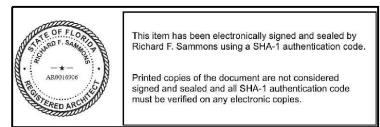

This item has been electronically signed and sealed by Richard F. Sammons using a SHA-1 authentication code.  
Printed copies of this document are not considered signed and sealed and all SHA-1 authentication code must be verified on any electronic copies.








1 REAR VIEW - GARAGE/APT (1929 - 1975 ) PRIOR TO CAR PORT  
NTS



2 REAR VIEW - GARAGE/APT (PRESENT ) AFTER CAR PORT & WINDOW REPLACEMENTS  
NTS

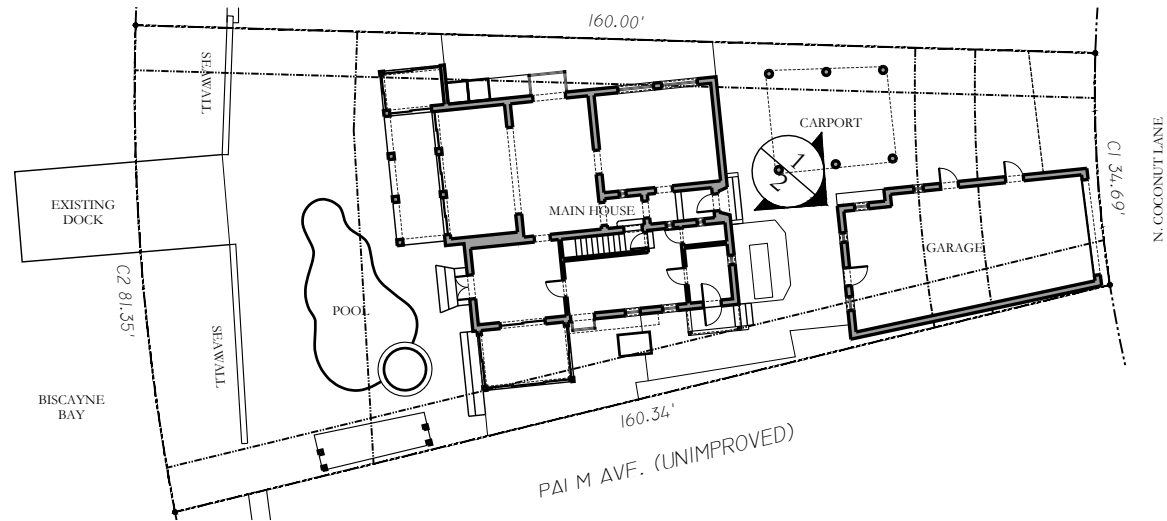


3 EXISTING SITE & RESIDENCE KEY PLAN  
1/32"=1'-0"



**FAIRFAX & SAMMONS**  
NEW YORK ~ PALM BEACH

317 N. COCONUT LANE RESIDENCE  
D.R.B. FINAL SUBMITTAL | MIAMI BEACH, FLORIDA | NOVEMBER 8, 2021

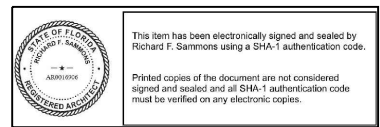

A-126






1 REAR VIEW (1929 - 1975 ) PRIOR TO TRELLIS  
NTS



2 REAR VIEW (1975 - 2000s) AFTER TRELLIS  
NTS



3 REAR VIEW (2000s - PRESENT) AFTER POOL & WINDOW REPLACEMENTS  
NTS


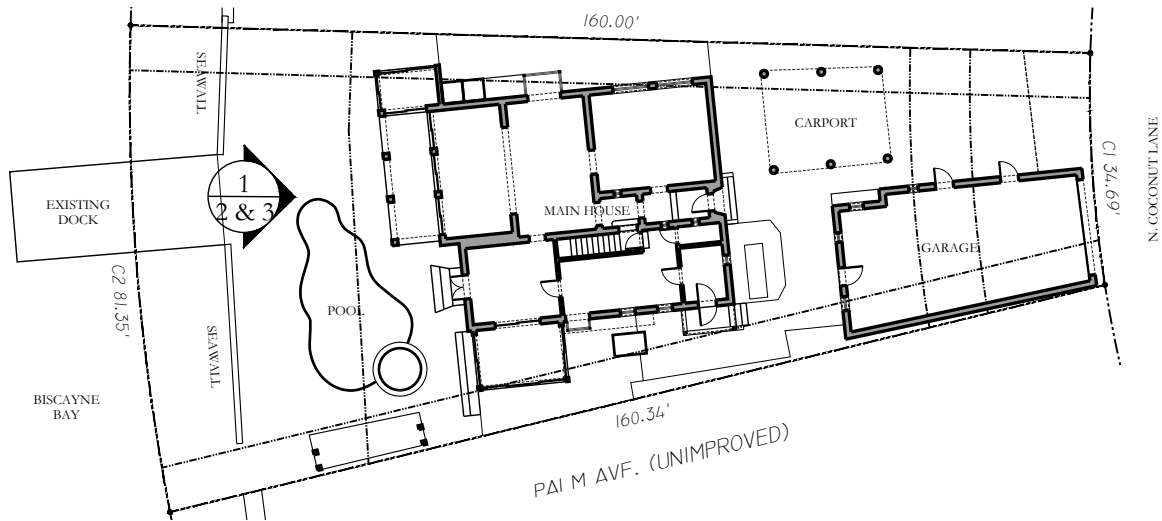


4 EXISTING SITE & RESIDENCE KEY PLAN  
1/32"=1'-0"



**FAIRFAX & SAMMONS**  
NEW YORK ~ PALM BEACH

317 N. COCONUT LANE RESIDENCE  
D.R.B. FINAL SUBMITTAL | MIAMI BEACH, FLORIDA | NOVEMBER 8, 2021

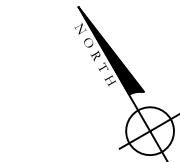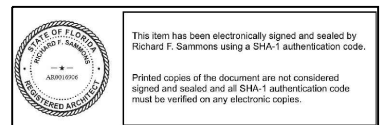

A-127

DRAWINGS, SPECIFICATIONS AND OTHER DOCUMENTS PREPARED BY THE ARCHITECT ARE THE INSTRUMENTS OF THE ARCHITECT'S SERVICE AND SHALL REMAIN THE PROPERTY OF THE ARCHITECT, WHETHER OR NOT THE PROJECT FOR WHICH THEY ARE INTENDED IS CONSTRUCTED OR NOT. THE ARCHITECT'S DRAWINGS, SPECIFICATIONS AND OTHER DOCUMENTS WILL NOT BE USED ON ANY OTHER PROJECTS FOR ADDITIONS TO THIS PROJECT AND/OR FOR COMPLETION OF THIS PROJECT BY OTHERS, EXCEPT BY AGREEMENT IN WRITING AND WITH APPROPRIATE COMPENSATION TO THE ARCHITECT.  
© 2021 FAIRFAX, SAMMONS & PARTNERS, LLC