# JOHN IBARRA & ASSOCIATES, INC.

TITLE COMMITMENT NOTES:

THAT I HAVE REVIEWED THE COMMITMENT AND ALL ITEMS ARE SHOWN ON THE SURVEY. THE ITEMS SHOWN HERE FORTH ARE PER SCHEDULE B-II OF FIRST AMERICAN TITLE INSURANCE COMPANY, COMMITMENT FILE NUMBER 102-580754, ISSUING OFFICE FILE NUMBER: 21-4541 NBR, DATED AUGUST 05, 2021, AT 8:00 A.M.;


ITEM 9. RESTRICTIONS, DEDICATIONS, CONDITIONS, RESERVATIONS, EASEMENTS AND OTHER MATTERS SHOWN ON THE PLAT OF NAUTILUS SUBDIVISION, AS RECORDED IN PLAT BOOK 8, PAGE(S) 95, BUT DELETING ANY COVENANT, CONDITION OR RESTRICTION INDICATING A PREFERENCE, LIMITATION OR DISCRIMINATION BASED ON RACE, COLOR, RELIGION, SEX, HANDICAP, FAMILIAL STATUS OR NATIONAL ORIGIN TO THE EXTENT SUCH COVENANTS,

CONDITIONS OR RESTRICTIONS VIOLATE 42 USC 3604(C). AFFECTS THE SUBJECT PROPERTY AND IS BLANKET IN NATURE.


**Professional Land Surveyors & Mappers** 



# MAP OF BOUNDARY SURVEY

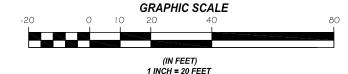



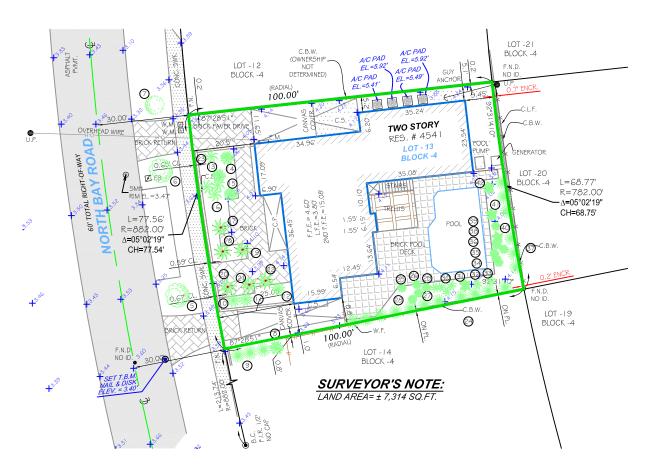

TREE TABLE					
ю.	Name	Diameter (Ft.		) Spread (ft.	
1	TREE	0.3	13.0	10.0	
2	TREE	1.5	20.0	5.0	
3	TREE	0.8	20.0	20.0	
4	TREE	0.4	20.0	12.0	
5	TREE	1.5	25.0	30.0	
6	TREE	1.5	35.0	25.0	
7	TREE	0.4	20.0	10.0	
8	PALM	1.5	20.0	8.0	
9	EDGE	4.0	10.0	5.0	
10	PALM	0.5	10.0	5.0	
П	PALM	0.5	10.0	5.0	
12	PALM	0.6	15.0	6.0	
13	PALM	0.7	25.0	12.0	
14	PALM	0.8	30.0	12.0	
15	PALM	0.8	25.0	12.0	
16	PALMS CLUSTER (3)	1.5	12.0	10.0	
17	PALM	1.7	45.0	15.0	
18	PALM	2.0	45.0	15.0	
19	PALM	1.6	45.0	15.0	
20	PALM	1.6	40.0	10.0	
21	PALM	2.0	45.0	15.0	
22	PALM	2.0	30.0	15.0	
23	PALM	1.6	15.0	10.0	
24	EDGE	4.0	10.0	5.0	
25	PALM	0.6	20.0	3.0	
26	PALM	0.6	20.0	8.0	
27	PALM	0.7	25.0	3.0	
28	PALM	0.3	30.0	8.0	
29	PALM	0.4	12.0	3.0	
30	PALMS CLUSTER (6)	5.0	40.0	20.0	
31	COCONUT PALM	0.6	45.0	13.0	
32	PALM	0.2	5.0	2.0	
33	PALM	0.2	7.0	3.0	
34	PALM	0.7	35.0	13.0	
35	PALM	1.0	20.0	10.0	
36	PALM	0.3	8.0	5.0	
37	PALM	0.3	15.0	2.0	
38	PALM	1.0	20.0	15.0	
39	COCONUT PALM	0.6	30.0	10.0	
40	PALM	0.6	13.0	10.0	
41	COCONUT PALM	0.7	40.0	15.0	
42	COCONUT PALM	0.7	38.0	15.0	

SURVEYOR'S NOTE:
AN ARBORIST MUST CONFIRM ALL THE TREE NAMES, CONDITION AND SPECIES, WHAT IS SHOWN ON THE SURVEY

MAY NOT BE THE CORRECT NAME OF THE TREES. LAND SURVEYORS ARE NOT ARBORIST.





LEGAL DESCRIPTION:
THE LAND REFERRED TO HEREIN BELOW IS SITUATED IN THE COUNTY OF MIAMI-DADE,
STATE OF FLORIDA, AND DESCRIBED AS FOLLOWS:
LOT 13, BLOCK 4 OF NAUTILUS SUBDIVISION, ACCORDING TO THE PLAT THEREOF AS

RECORDED IN PLAT BOOK 8, PAGE(S) 95, OF THE PUBLIC RECORDS OF MIAMI-DADE COUNTY, FLORIDA.

### PROPERTY ADDRESS:

4541 N BAY ROAD MIAMI BEACH, FLORIDA 33140

**ABBREVIATIONS** 

CERTIFICATION:
454 I NBR LLC; STACI J. RUTMAN, P.A. D/B/A
RUTMAN LAW; FIRST AMERICAN TITLE INSURANCE COMPANY,
ITS SUCCESSORS AND OR ASSIGNS, AS THEIR

INTEREST MAY APPEAR

- LEGAL NOTES TO ACCOMPANY SKETCH OF SURVEY:

   THERE MAY BE EASEMENTS RECORDED IN THE PUBLIC RECORDS NOT SHOWN ON THIS SURVEY.

   EXAMINATIONS OF THE ABSTRACT OF TITLE WILL HAVE TO BE MADE TO DETERMINE RECORDED INSTRUMENTS, IF ANY, AFFECTING THE PROPERTY.

- INSTRUMENTS, IF ANY, AFFECTING THE PROPERTY.

  \* THIS SURVEY IS SUBJECT TO DEDICATIONS, LIMITATIONS, RESTRICTIONS, RESERVATIONS OR EASEMENTS OF RECORD.

  \* LEGAL DESCRIPTIONS PROVIDED BY CLIENT OR ATTESTING TITLE COMPANY.

  \* BOUNDARY SURVEY MEANS A DRAWING AND/OR A GRAPHIC REPRESENTATION OF THE SURVEY WORK PERFORMED IN THE FIELD, COULD BE DRAWN AT A SHOWN SCALE AND/OR NOT TO SCALE; THE WALLS OR FENDES MAY BE EXAGGERATED FOR CLARITY PURPOSES.

  \* EASEMENTS AS SHOWN ARE PER PLAT BOOK, LINLESS DEPICITED OTHERWISE.

  \* THE TERM THOROACHMENT MEANS VISIBLE AND ABOVE GROUND ENTOCACHMENTS.

  \* ARCHITECTS SHALL VERIFY ZOMING REGULATIONS, RESTRICTIONS, SETBACKS AND WILL BE RESPONSIBLE FOR SUBMITTING PLOT PLANS WITH CORRECT INFORMATION FOR "APPROVAL FOR AUTHORIZATION" TO THE PROPER AUTHORITIES IN NEW CONSTRUCTION.

  \* UNLESS OTHERWISE NOTED, THIS FIRM HAS NOT ATTEMPTED TO LOCATE FOOTING AND/OR FOUNDINGS.

FOUNDATIONS.

FENCE OWNERSHIP NOT DETERMINED.

FENCE OWNERSHIP NOT DETERMINED.

HIS PLAN OF SURVEY, HAS BEEN PREPARED FOR THE EXCLUSIVE USE OF THE ENTITIES NAMED HEREON, THE CERTIFICATE DOES NOT EXTEND TO ANY UNNAMED PARTY.

### FLOOD ZONE INFORMATION:

THE NFIP FLOOD MAPS HAVE DESIGNATED THE HEREIN DESCRIBED LAND TO BE SITUATED IN:
FLOOD ZONE: "AE"
BASE FLOOD ELEVATION: 7 FT.
COMMUNITY: 120651
PANEL: 30309

0309

THE SUBJECT PROPERTY DOES LIE IN A SPECIAL FLOOD HAZARD AREA.

SURVEYOR'S NOTES:

1. IF SHOWN, BEARINGS ARE REFERRED TO AN ASSUMED MERIDIAN, BY SAID PLAT IN THE DESCRIPTION OF THE PROPERTY, IF NOT, BEARINGS ARE THEN REFERRED TO COUNTY, TOWNSHIP MAPS.

2. THE CLOSURE IN THE BOUNDARY SURVEY IS ABOVE 1:7500 FT.

3. CERTIFICATE OF AUTHORIZATION LB # 7806.

4. ALL ELEVATIONS SHOWN ARE REFERRED TO NATIONAL GEODETIC VERTICAL DATUM OF 1929 MIAM DADE COUNTY BENCH MARK #D-157-R. LOCATOR NO. 3223 SW @ 44TH STREET & ALTON ROAD; ELEVATION IS 4.93 FEET OF N.G.V.D. OF 1929.

### SURVEYOR'S CERTIFICATION:

## 11/01/2021

JULIO E. PEREZ PROFESSIONAL LAND SURVEYOR NO.:6029 STATE OF FLORIDA

REVISED ON: ADD TREES 11-01-21 REVISED ON: ORIGINAL SURVEY 08-26-21

### LEGEND

	= OVERHEAD UTILITY LINES	DRAWN BY:	LK
///////	= CONCRETE BLOCK WALL	DRAWN BT.	LA
<del></del>	= CHAIN LINK FENCE		
0 0	= IRON FENCE	FIELD DATE:	11/01/2021
	= WOOD FENCE		
	= BUILDING SETBACK LINE		
	= UTILITY EASEMENT	SURVEY NO:	21-003099-3
111 111	= LIMITED ACCESS R/W		
<del>-//</del>	= NON-VEHICULAR ACCESS R/W	CHEET.	1051

× 0.00 = EXISTING ELEVATIONS

SHEET: 1 OF 1