Owner <sup>Ameri</sup> Lot <sup>1</sup> General Contra Architect	can Oil Co. Block 17A ctor	Subdivisio	n ISLAND VIEW	Permit No. Address <sup>1</sup> Bond No. Engineer	8742 orig #52911 for 790 Alton Ro	ecard. Cost Serv. Sta. ad	
Zoning Regulation	ons: U	se	Area	Lot Size			۰ ۲
Building Size:	F	ront	Depth	Height		Storie	S
Certificate of C	Occupancy No.			Use SE	RVICE STATIO	N	
Type of Constru	iction		Foundation		Roof		Date
PLUMBING Con RIGINAL CARD 3 Water Closets			ERE STORES ON THIS Swimming Pool Traps	Sewer C LOT WHICH WERE Temporary	Connection C DEMOLISHED Water Closet	UNDER PERMIT	41-
Lavatories			Steam or Hot Water	Boilers		Wells	•
Bath Tubs	AG L		ROUGH APPROVAL			v v cha	
Showers Urinals			FINAL APPROVAL				
Sinks Dish Washing M Laundry Trays Laundry Wash Drinking Founta Floor Drains Grease Traps Safe Wastes AIR CONDITIC SEPTIC TANK OIL BURNER C SPRINKLER CO	ing Machines ns NING Contrac Contractor Contractor		GAS Contractor Gas Ranges Gas Water Heaters Gas Space Heaters Gas Refrigerators Gas Steam Tables Gas Broilers	GAS Rough A GAS FINAL A	Gas F Gas V PPROVAL	Date Frylators Pressing Machine Vents for Stove	<b>)</b> 
ELECTRICAL C	Contractor		Date				
OUTLETS L	witches ights eceptacles	Ranges Irons Refrigerators Fans Motors	Neor Sign Mete	oorary Service Transformers Outlets er Change		APROVAL	
HEATERS V	Vater	Appliances	Servi	ers of Distributio	ns	APP	
	pace			tions			
FIXTURES		Electrical Contra	rtor	Date		FINA By	

. .

8 5 45

ma si is Se

## **ALTERATIONS & ADDITIONS**

Building Permits: #77467 Service Station Maintenance: Install shelving, block up two windows - \$1,000 - 11/30/66 #82439 Kemp & Guest Roofing Co: Re-roof 13 squares \$1090 5/28/69 #1408 - W.F. Wynne Co. - underground tanks 3- 6000,6000,8000 **12**/ 11/25/70 #88192-W.F. Wynne Co.-Addition to existing station-\$2300-12-18 72

#04275-Beaudry Signs, Inc.-Sign-\$200-10-11-73

#05047-Beaudry Signs-Change of copy-\$300-2-7-74 #89181-A J McKiney-Addition of 15 x 30 CBS structure to be used for Car Wash-\$10,000-10-13-76 #10351-Beaudry Signs-AmocSign-\$850-12-6-76 #10493-Obenour Roofing-Re-roof 4 1/2 sqs-\$442-12-30-76

Plumbing Permits:

#54197-Ringeman Plumbing- car wash-10-19-76 water supply

#65739 Jones Electric Emerg. Service, Inc.: 1 telephone outlet - 5/10/68 #66388 Bartnett Electric 2 Motors 0-1 H.P. Gas Pumps 11/14/68 #66446 Bartnett Electric, 1 Motors, 0-1 H.P. Gas Pump #70351-Dick Williams Electric- 12 fixtures; 6 motors, 0-1HP-2-20-73 73330-County Wide Electric-Telephone booth-8-5-76 #73642-Peeples Electric- 1 switch outlet; 2 light outlet; 1 size service 225; 6 fixtures-11-16-76 #73698-Beaudry Signs- 12 sign tubes; 4 ballast-12-6-76 000000

Electrical Permits: #63095 Bartnett Electric, Inc.: Storm repairs - 1/3/66

ELECTRICAL PERMITS: #E8801039 - Rival Electric - 1 Motors, 1 sign repair - 6-10-88

ADDRESS

## ALTERATIONS & ADDITIONS

## **Building Permits:**


- 4/21/81 # 20124 Cherokee Structures Replace stucco on existing canopy \$3,000
- 5/14/81 #20242 C & K Roofing Co. Roof canopy \$1,200.00
- #90745 1/7/82 Crown neon Inc. remove old sign and install new one 33 sq ft \$1,000.
- #23797 4/28/83 C.E. Sheppard Roof reroof 18 sqs \$4,395.
- #25374 5/24/84 H.L. Edwards fill in exist curbs with concrete within the property lines not on city prop O.Ferro 400 sq ft \$1,200.

**Plumbing Permits:** 


#79828 11/2/84 Ray Williams Elect Serv - 3 motors 0-1 hp, 6 special purpose, 2 outlets commercial #81709 1/23/87 Ray Williams Elec - 3 outlets commercial




# PERMIT #

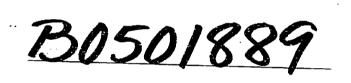




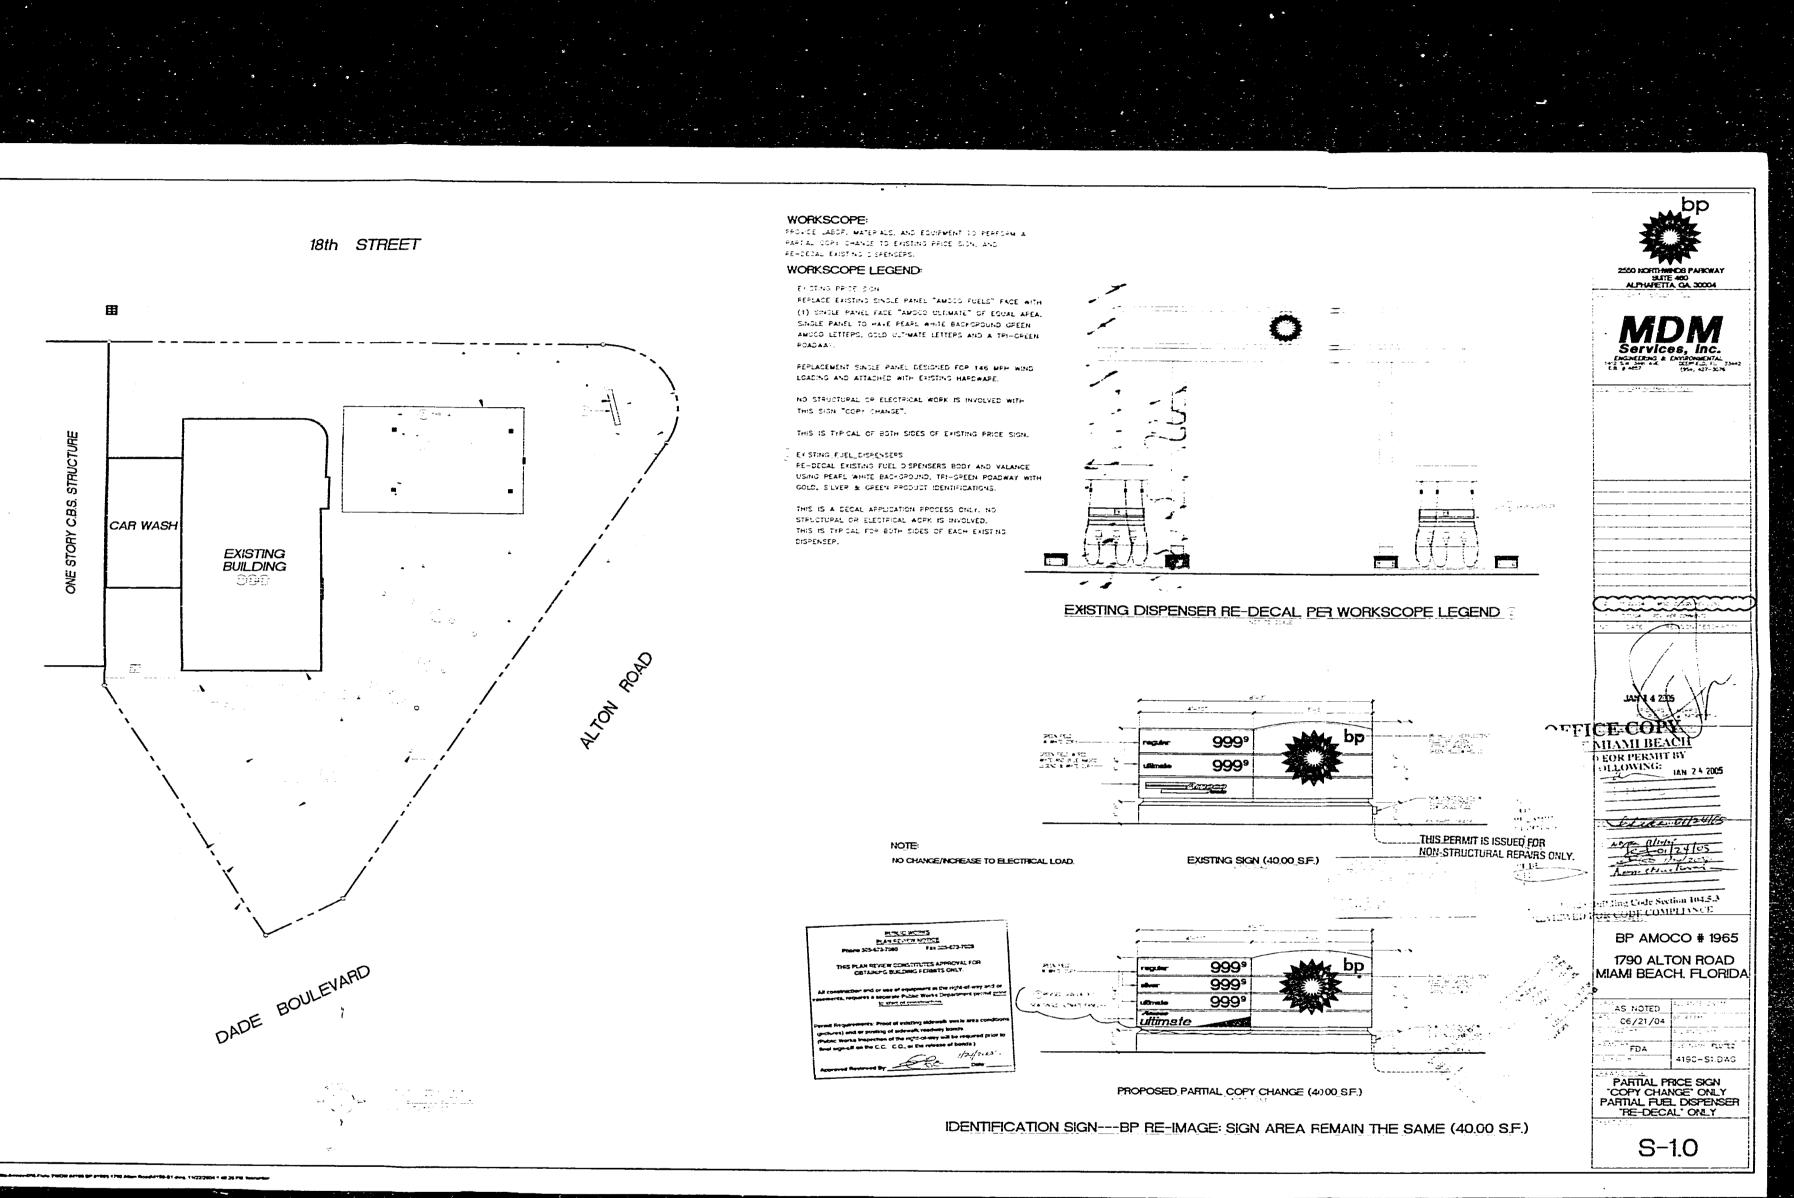

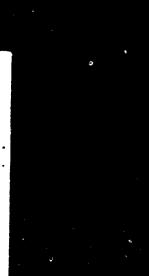


BUDD/888

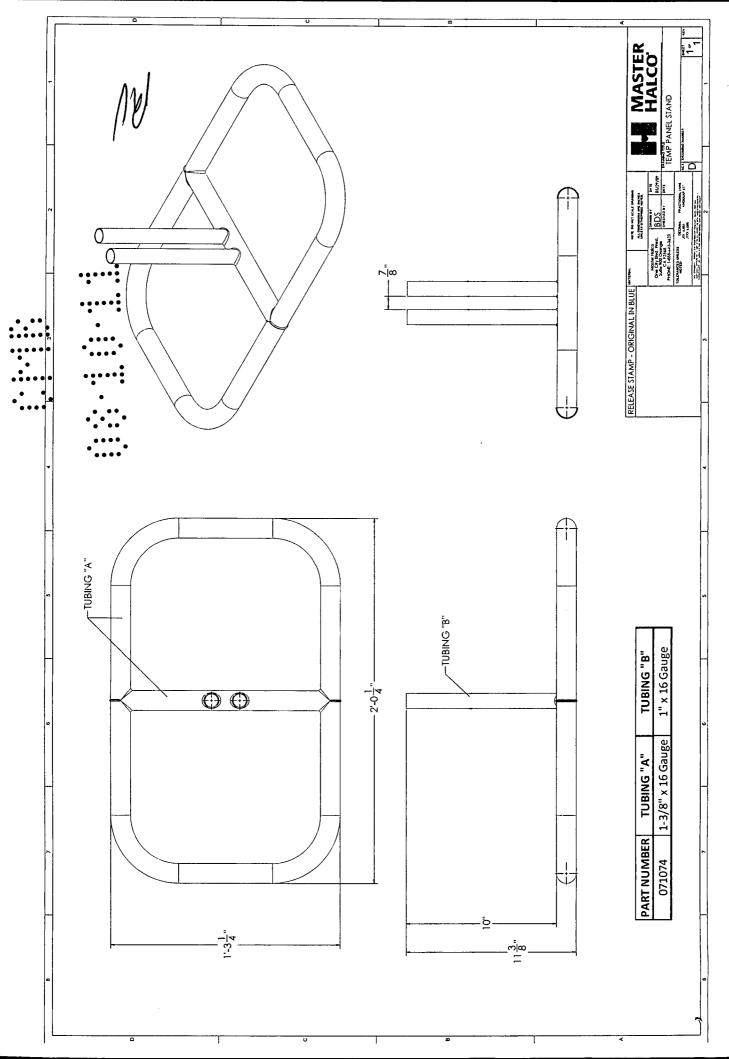

.


CHAIN LINK FENCE DETAIL SHEET

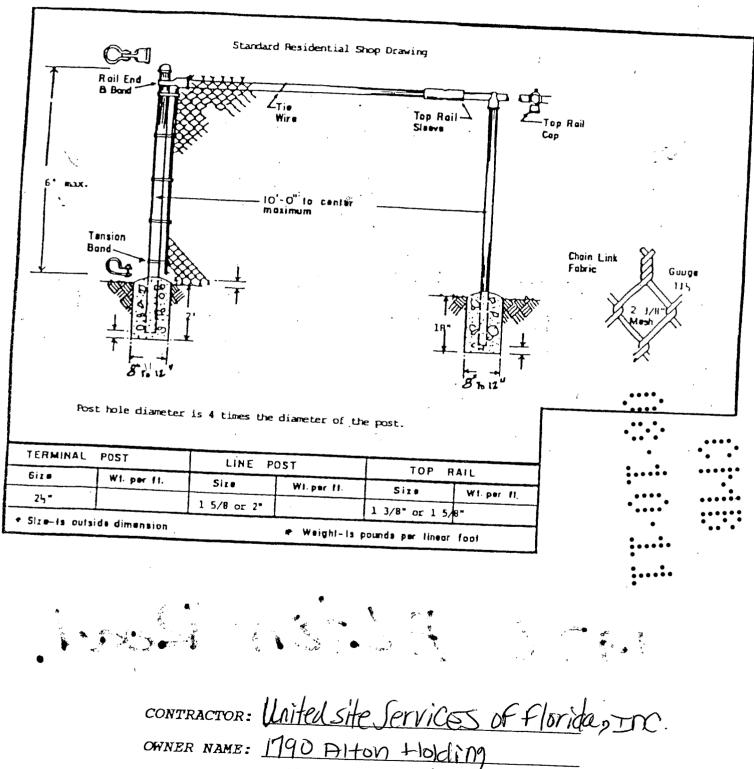


JOB ADDRESS: 1790 AHON Rd

48 HOURS PRIOR TO EXCAVATING PUBLIC WORKS CONTRACTOR SHALL CALL FOR LOCATION PLAN REVIEW NOTICE Phone 305-673-7080 OF UNDERGROUND UTILMES Fax 305-673-7028 SUNSHINE ONE-CALL 1-800-432-4770 THIS PLAN REVIEW CONSTITUTES APPROVAL FOR CITY OF MIAMI BEACH 305-673-7080 OBTAINING BUILDING PERMITS ONLY. All construction and/or use of equipment in the right-of-way and/or easements, requires a separate Public Works Department permit prior to start of construction. NO. Permit Requirements: Proof of existing sidewalk/swale area conditions en las (pictures) and/or posting of sldewalk/roadway bonds (Public Works Inspection of the right-of-way will be required prior to final sign-off on the C.C. / C.O., or the release of bonds.) AA assumes hare PERMIT BY R Rules, and Regulations. Ž K[[0/ ibility for accuracy to compliance with managements CO pennis 1. N. C. L. C. <u>o</u> 9 AAF FIRE PREVERS 8/10/11 41 ENGINEERING: PUBLIC WORKS: ENL-08 10 2 01 STRUCTURAL: ELEVATOR: ,0 ALton

104/607 idd...ions/ recursions applicable to this property that may be made in the Public Records of this County and there may be additional permits adjustices, state agencies, or federal acception as water management's (J.LE 99 results from these plans which are all Federal, State and Local Lect DISINICIANS MAIN ON W to comple 1790 Alton Ross હે er, 20.99 Chainlink 305-6701 temp paret BUI DING ONLY. fine (ol-0" .91 Sr age gquipment in the right of way and/or Derate Public Works Department permit prie 山 easements Start of construction. LENGE 1 **IAJ3M** Requirements: Proof of existing sidewalk/swale area conditions 311) ure and/or posting of sidewalk/roadway bonds ç:0 final sign-off on the C.C. / C.O., or the release of bonds sign-off on the C.C. / C.O., or the release of bonds.) Z 0 Approved/Reviewed By: UTOL Date: 8 48/HOURS PRIOR & EXCAVATING PB 6-115 FOR LOCATION NOISINICIANS MANA GINATSI. OUTIO UTILITIES AU 1 300 432-4770 SUNSHINE ON SOT MARY EEACH SITY CITY OF MIA ARBENTED FOR PERMIT BY THE FOLLOWING: MS 08/10/1/8 ING BUILDING 75,1 BUDING: (CHOKD) 102 ZONING: 11.92 19 (c) DR8/123: 221.59.29.E . ეე CONCURRENCY: 6 15.10.171=7 PLUMBING: 69.15=ALCHUNCH .00.21=8= KSRAE (FO): A m (mor 8/10/11 (B) CINERY BANC WILLS 2011 EN  $(\mathbf{0})$ (W28)1499,86: M. 60.70.885 500 Ø  $\bigcirc$ 1. \_ 1! 98.35A 2 119.84 46 ×15.00fi × 15.00 16 147502512 1797.6) (4) base: 98.3341 heirst - 75.1-15.000 3 66.02 Fd 60.141 13-17-64 98.3511 + 60.12 Gres " J69.483444 9: 2955. 4175 fl2

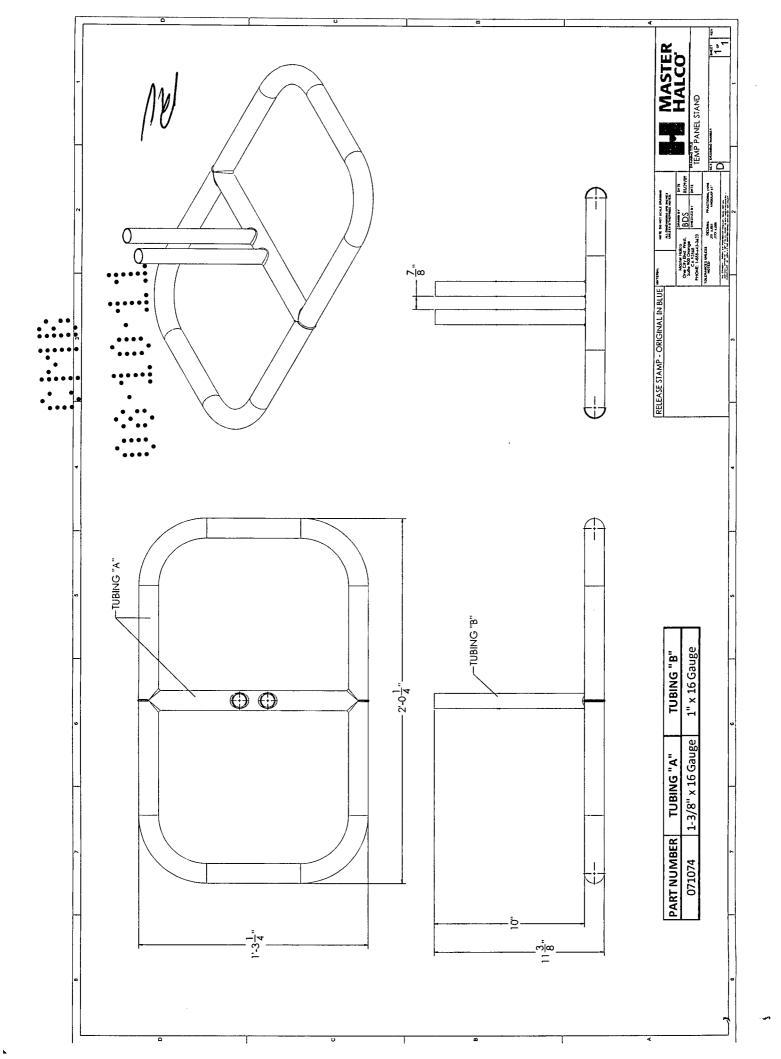


#### CHAIN LINK FENCE DETAIL SHEET

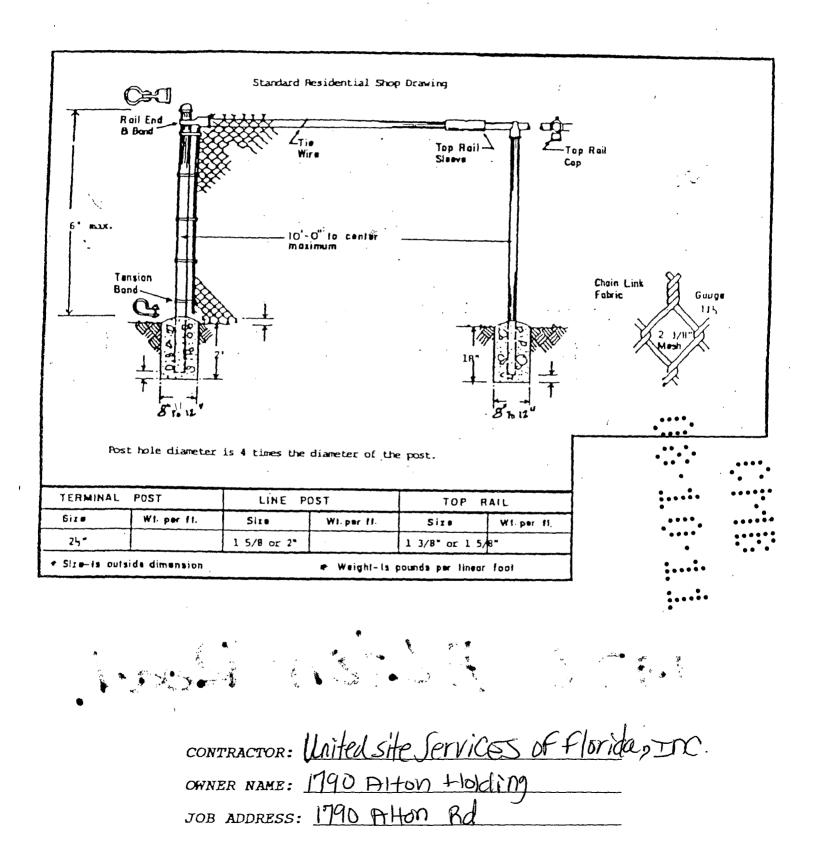



**48 HOURS PRIOR TO EXCAVATING** PUBLIC WORKS CONTRACTOR SHALL CALL FOR LOCATION **PLAN REVIEW NOTICE** OF UNDERGROUND UTILMES Phone 305-673-7080 Fax 305-673-7028 SUNSHINE ONE-CALL 1-800-432-4770 CITY OF MIAMI BEACH 305-673-7080 THIS PLAN REVIEW CONSTITUTES APPROVAL FOR OBTAINING BUILDING PERMITS ONLY. All construction and/or use of equipment in the right-of-way and/or easements, requires a separate Public Works Department permit prior to start of construction. To Permit Requirements: Proof of existing sidewalk/swale area conditions ł (pictures) and/or posting of sldewalk/roadway bonds (Public Works Inspection of the right-of-way will be required prior to final sign-off on the C.C. / C.O., or the release of bonds.) Date: ERMIT BY )S b 1 2 1.0/14 A Regulations. to compliance with ē managements 270 CO YE . pernus 9 5 <u>9</u> AA F FIRE PREVEN 110/4 A ENGINEERING: 10 2 PUBLIC WORKS: ENL-08 01 STRUCTURAL: ELEVATOR: ALton 70


104607 -1145 - 85H L'SEN WTVE: In addition to the requirement of this permit therefore set indicional restrictions applicable to this property that may be found in the Public Records of this County and there may be additional permits required from other government entities such as water management's districts, state agencies, or federal egencies. The City of Miami Beach assumes into the provide results from these plans which are approved solved to compliance with all Federal, State, and Local Later Public Anto Records (THE A) 10.09 ali Federal, State, and Local Later 1290 Alton Kossi Chainlink Jemp Period Fence 61-011 WNOJICE PROVAL FOR 305-670 (3 1.0001.1cs DING INNG BUI r-way and/or auipment in the rightequires Derstate Public Works Department permit prior ion and or side AN easement (312) Requirements: Proof of existing sidewalk/swale area conditions <u>د:</u>0 もり uto Works Inspection of the right-of-way will be required in the C.C. / C.O., or the release of bonds.) 20 Upl Date: 8/7 Approved/Reviewed By: LOCATIONNOISINICIENTS MENA SINUCISI. 511-9 Ed 48 HOURS BEIOR 10 Ø N0200 EXISTING BUILDING EXCAVATING BOT PRYNN EEACH ¥.8. CONTRACT OUND UTILITIES OF UNDERG APBENSIVED FOR PERMIT BY SIV ASOMAL + SUNSHINE ON ALL (1-800-432-4770 CITY OF MEAN GRACH SOS 673-7080 1 M/ 08/10/1/# THE FOLLOWING: 79.65 Ô. 8.6 No BURDING: ZONING: ;6 (CHOGO) (REAL DRB/HUB3: 56.17 (C)( 231.56,26°E CONCURRENCY: (15.10.121= PLUMBING: 29.92=UDLELSONCOLL .69.15=WECHANC 6 FAMIMOL 8/10/11 2011  $(\mathfrak{I})$ '00.21=A **Z**.0 U 1.61 (A).CI W28 2 FLISS 86: M. 60.20.885 119.84 ft × 15.00 st 2) 98.35A × 15.00fi [14]75.25f[2]  $\bigcirc$ 1797.6 (4) base: 98.33-61 heirid - 75.1-15.00: 60.161 No and address of the second second 98-3511 - 60-141 66.02 Fd CATES T  $(\mathbf{3})$ 12-17 (2 Q . 2955. 4175 12 J69.4834-642 

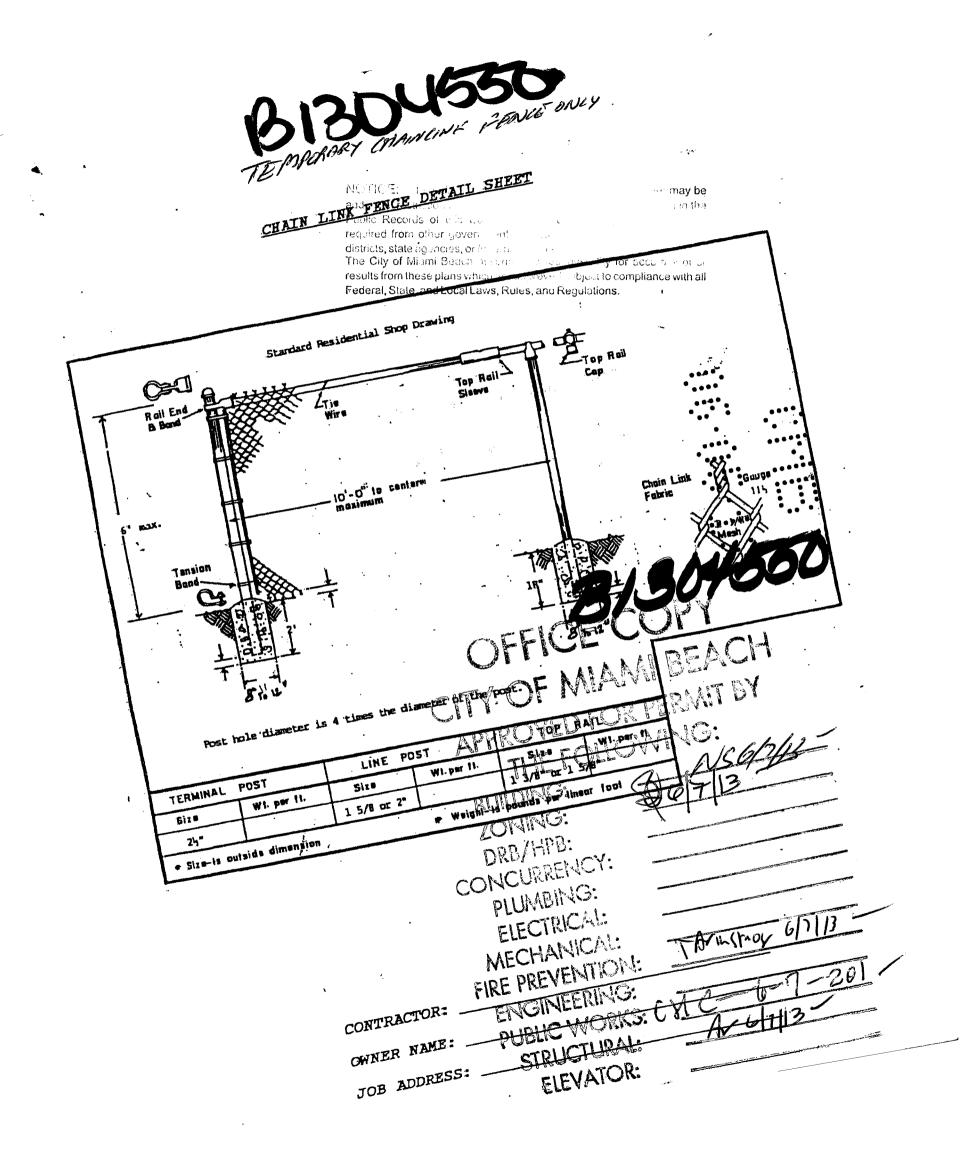

East 0 r 100 - $\mathcal{P}$ Office Depot Wath west Side of Property 1790 Alton Rood, Mini Bloch, Fl. 33139 Nathonal Casher

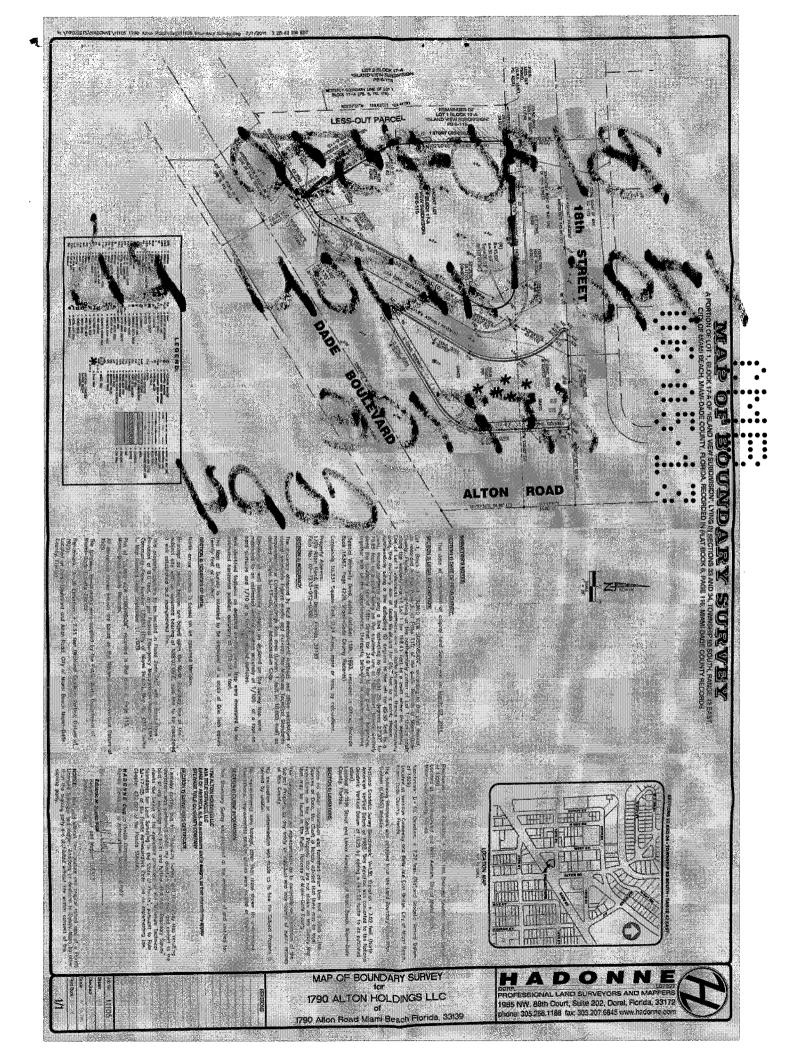

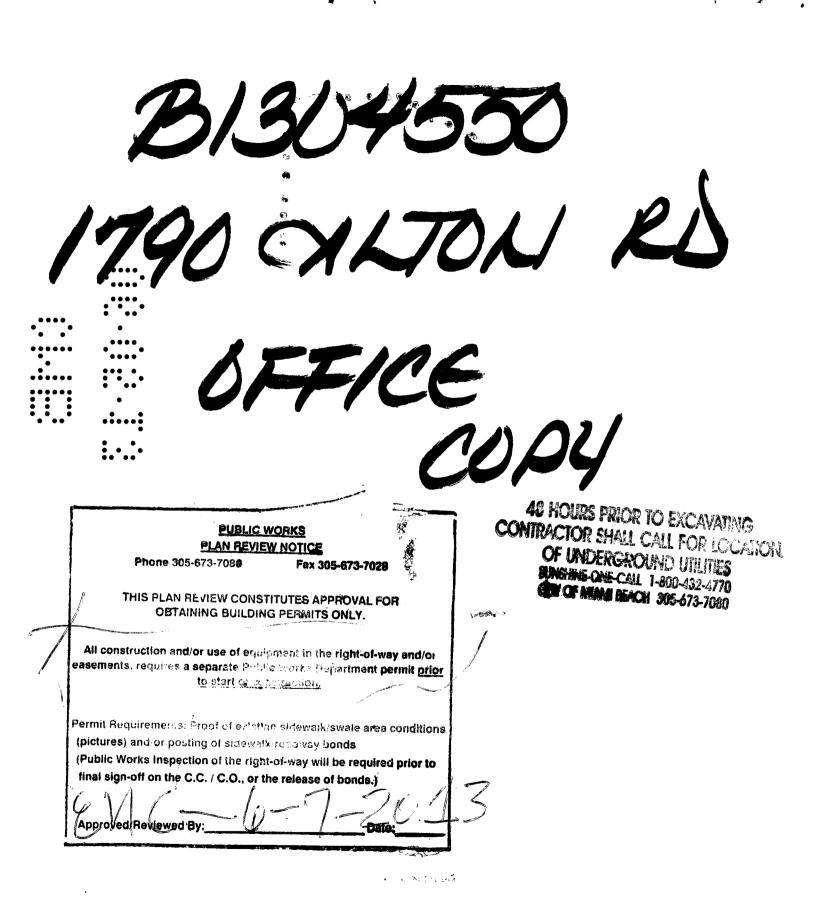

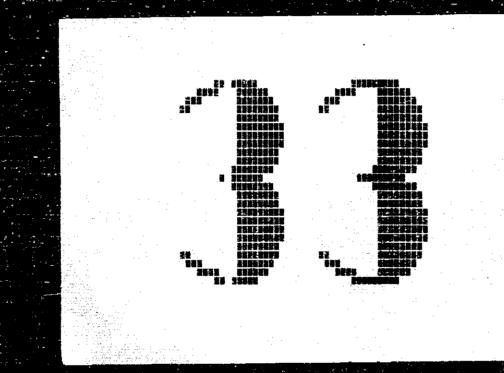


PERMIT B 91000 SI

ومعتر والمعرو المرا

· · · ·

. . . .

9

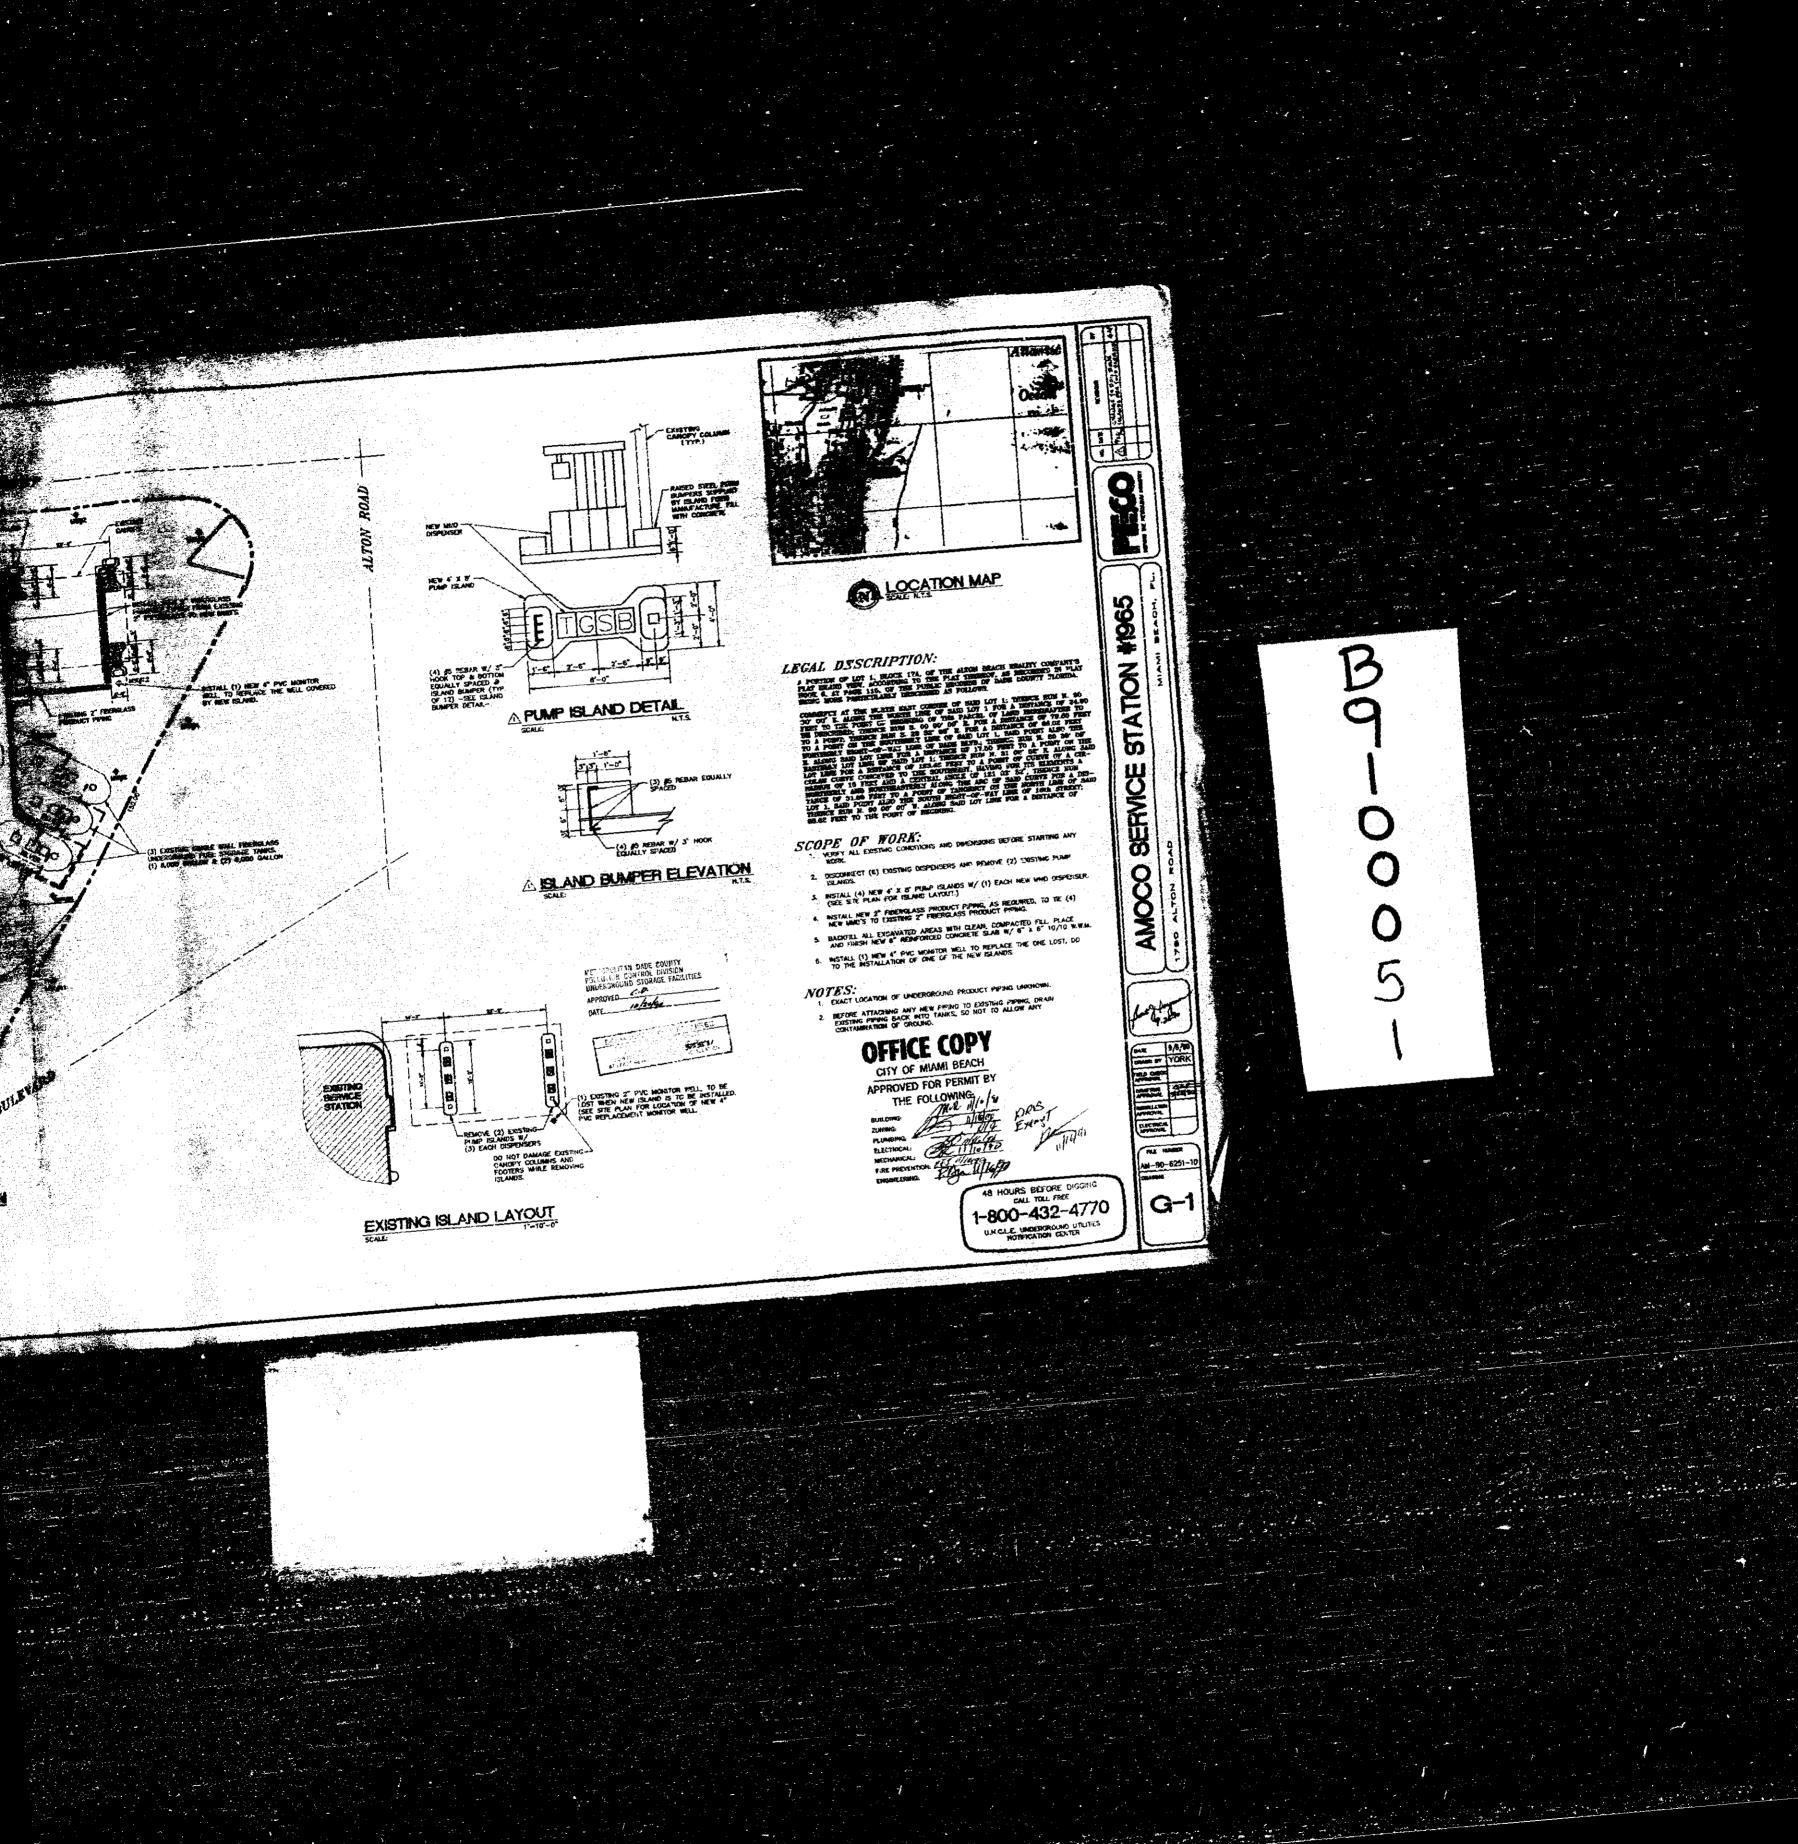



B


C

0

0


0


5

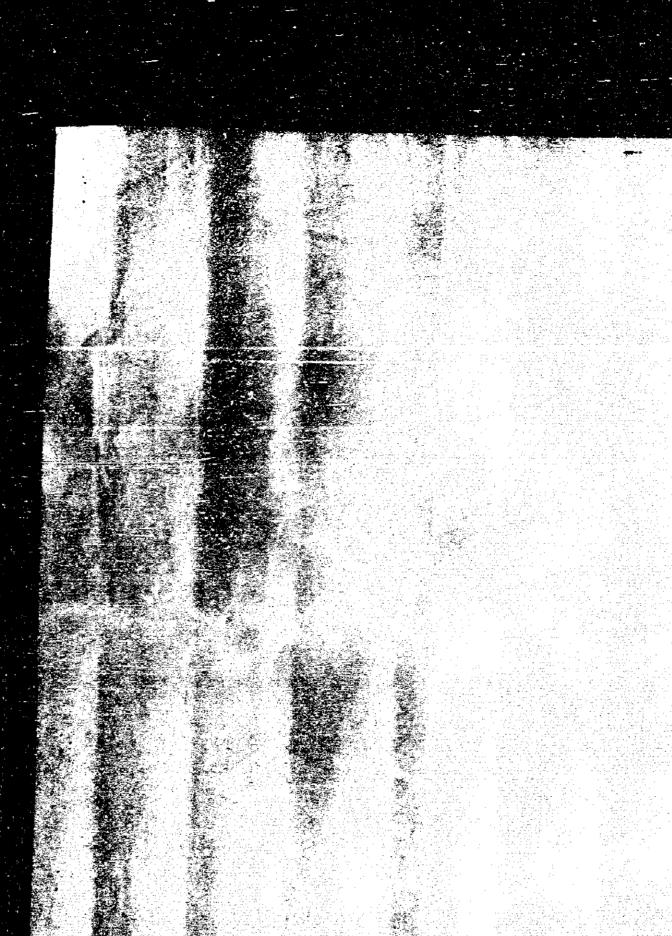


Ş.,


مع الانتجاز المعالي مشور ( والار ال

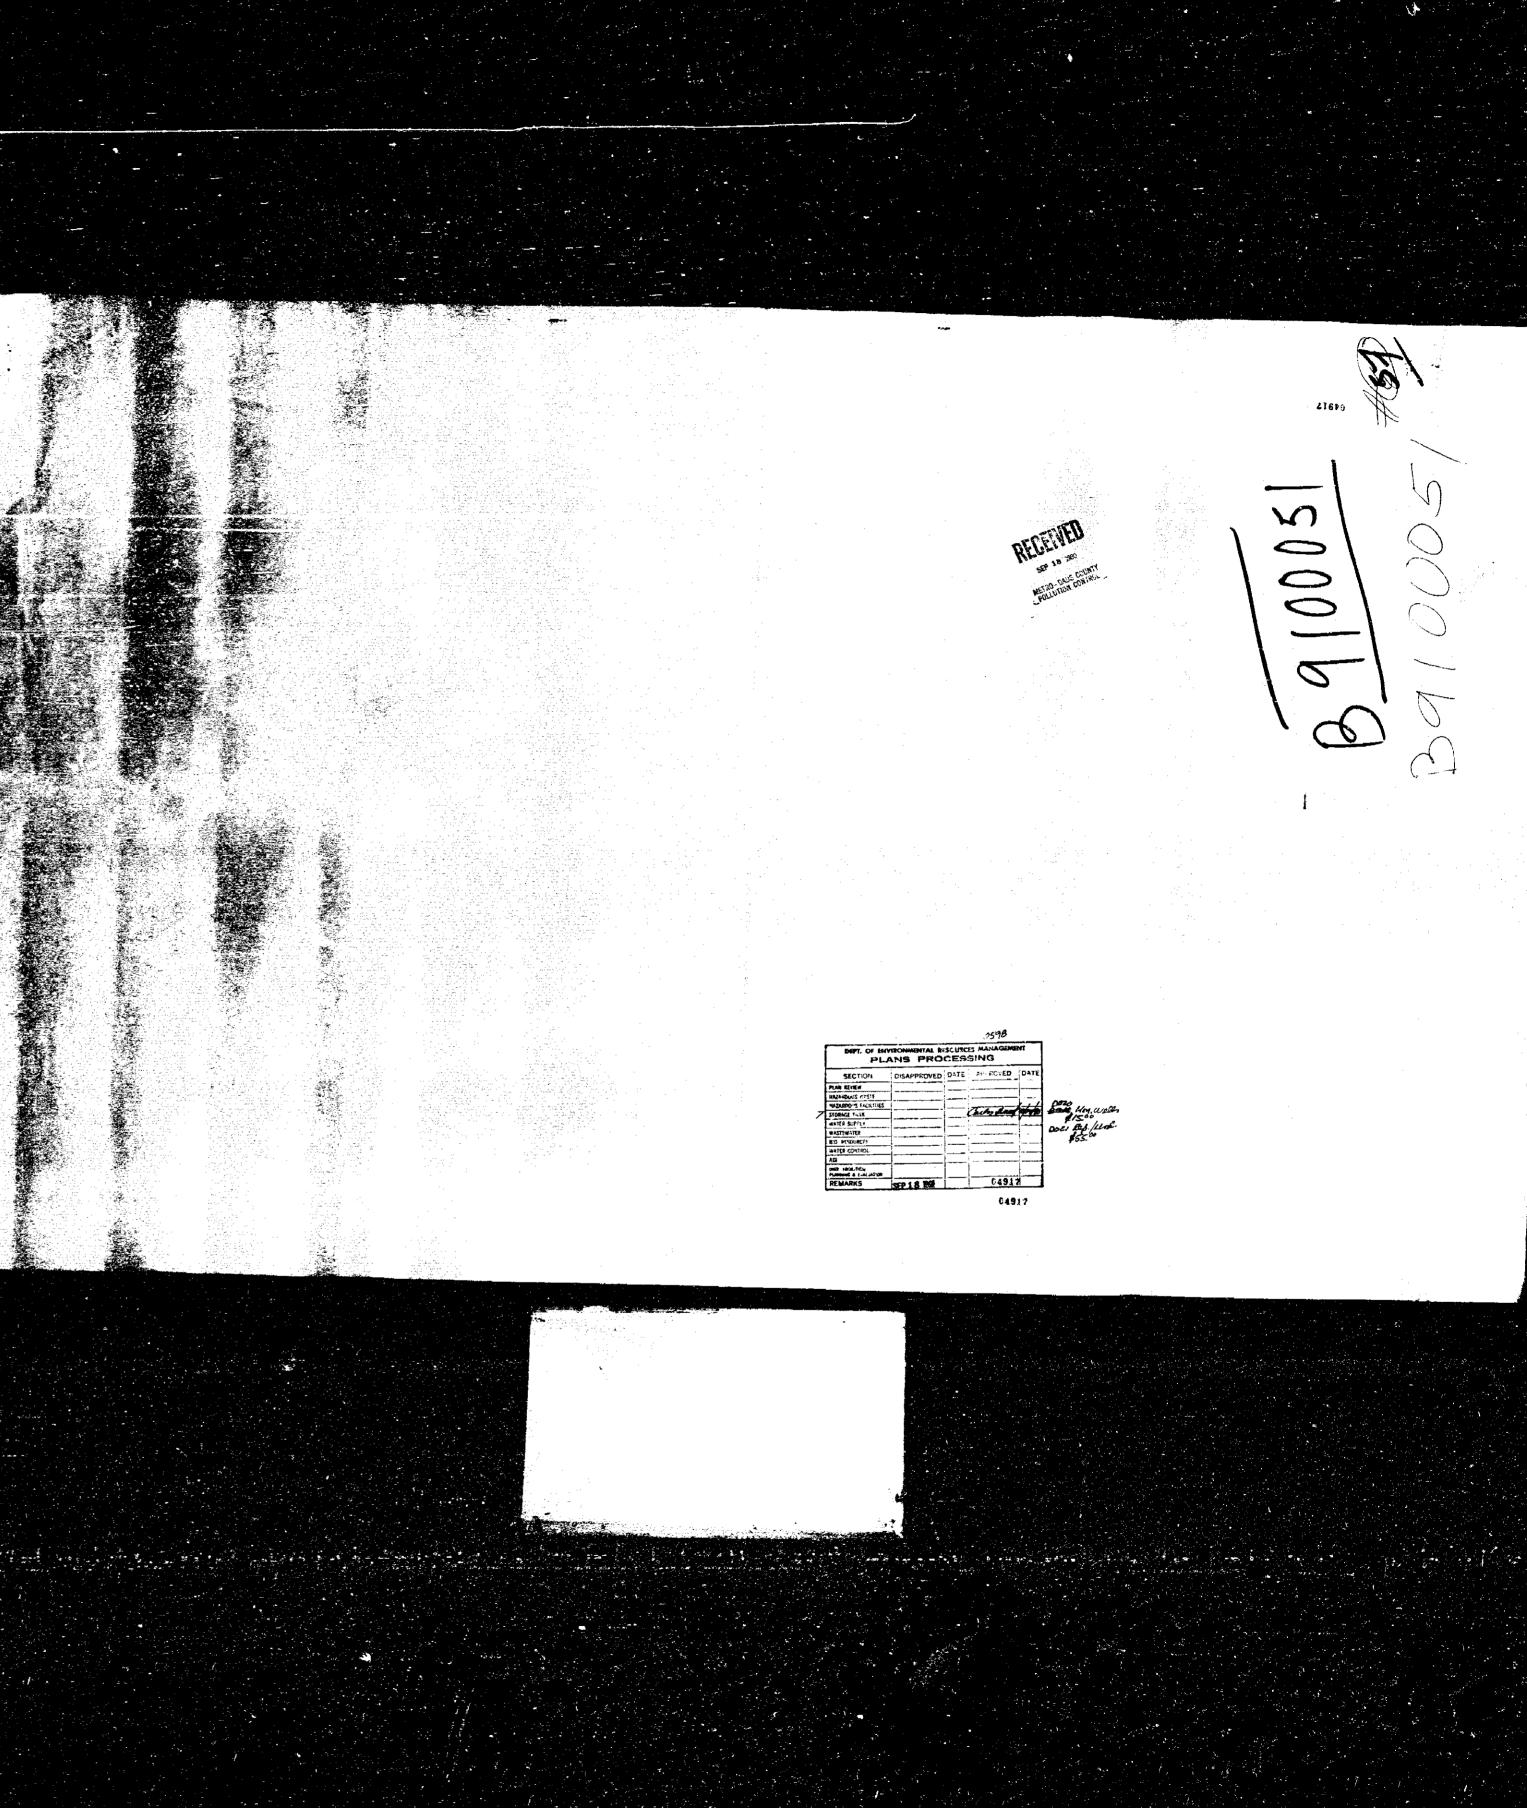


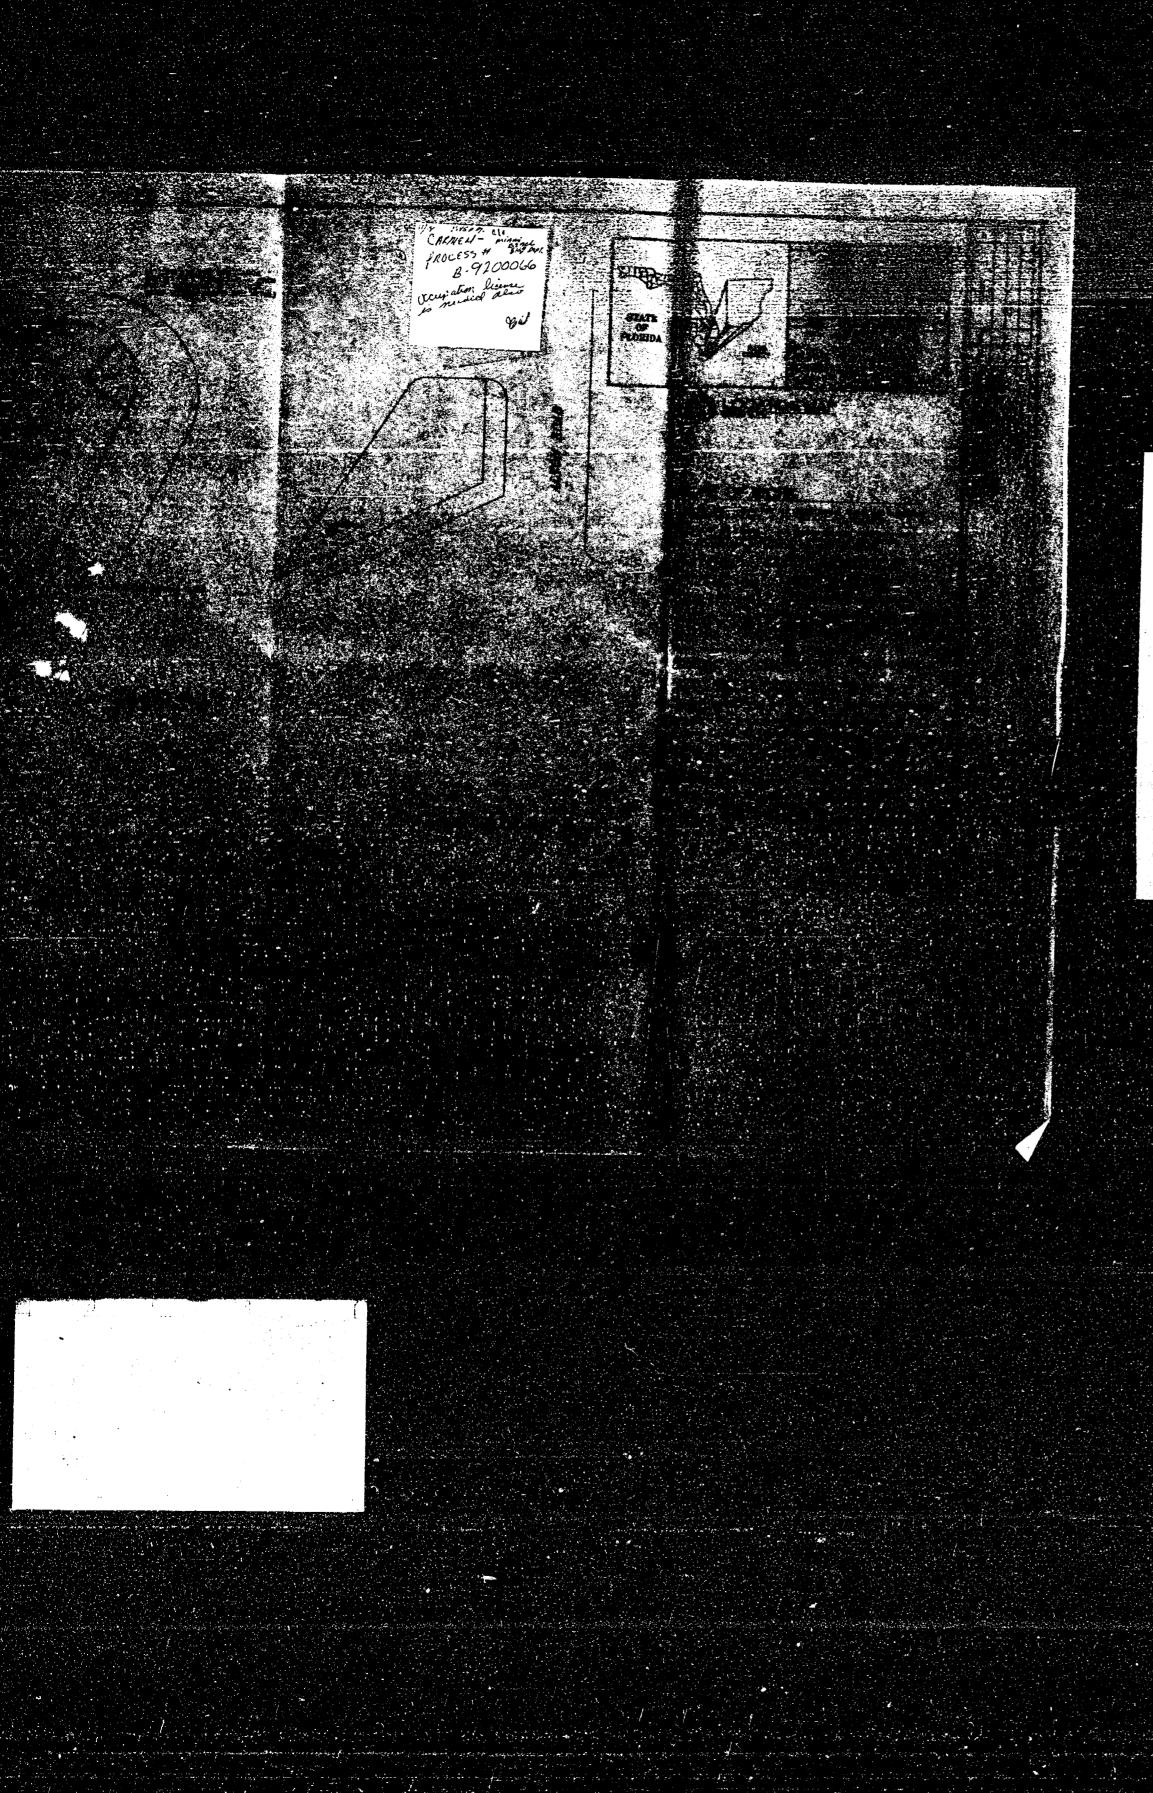


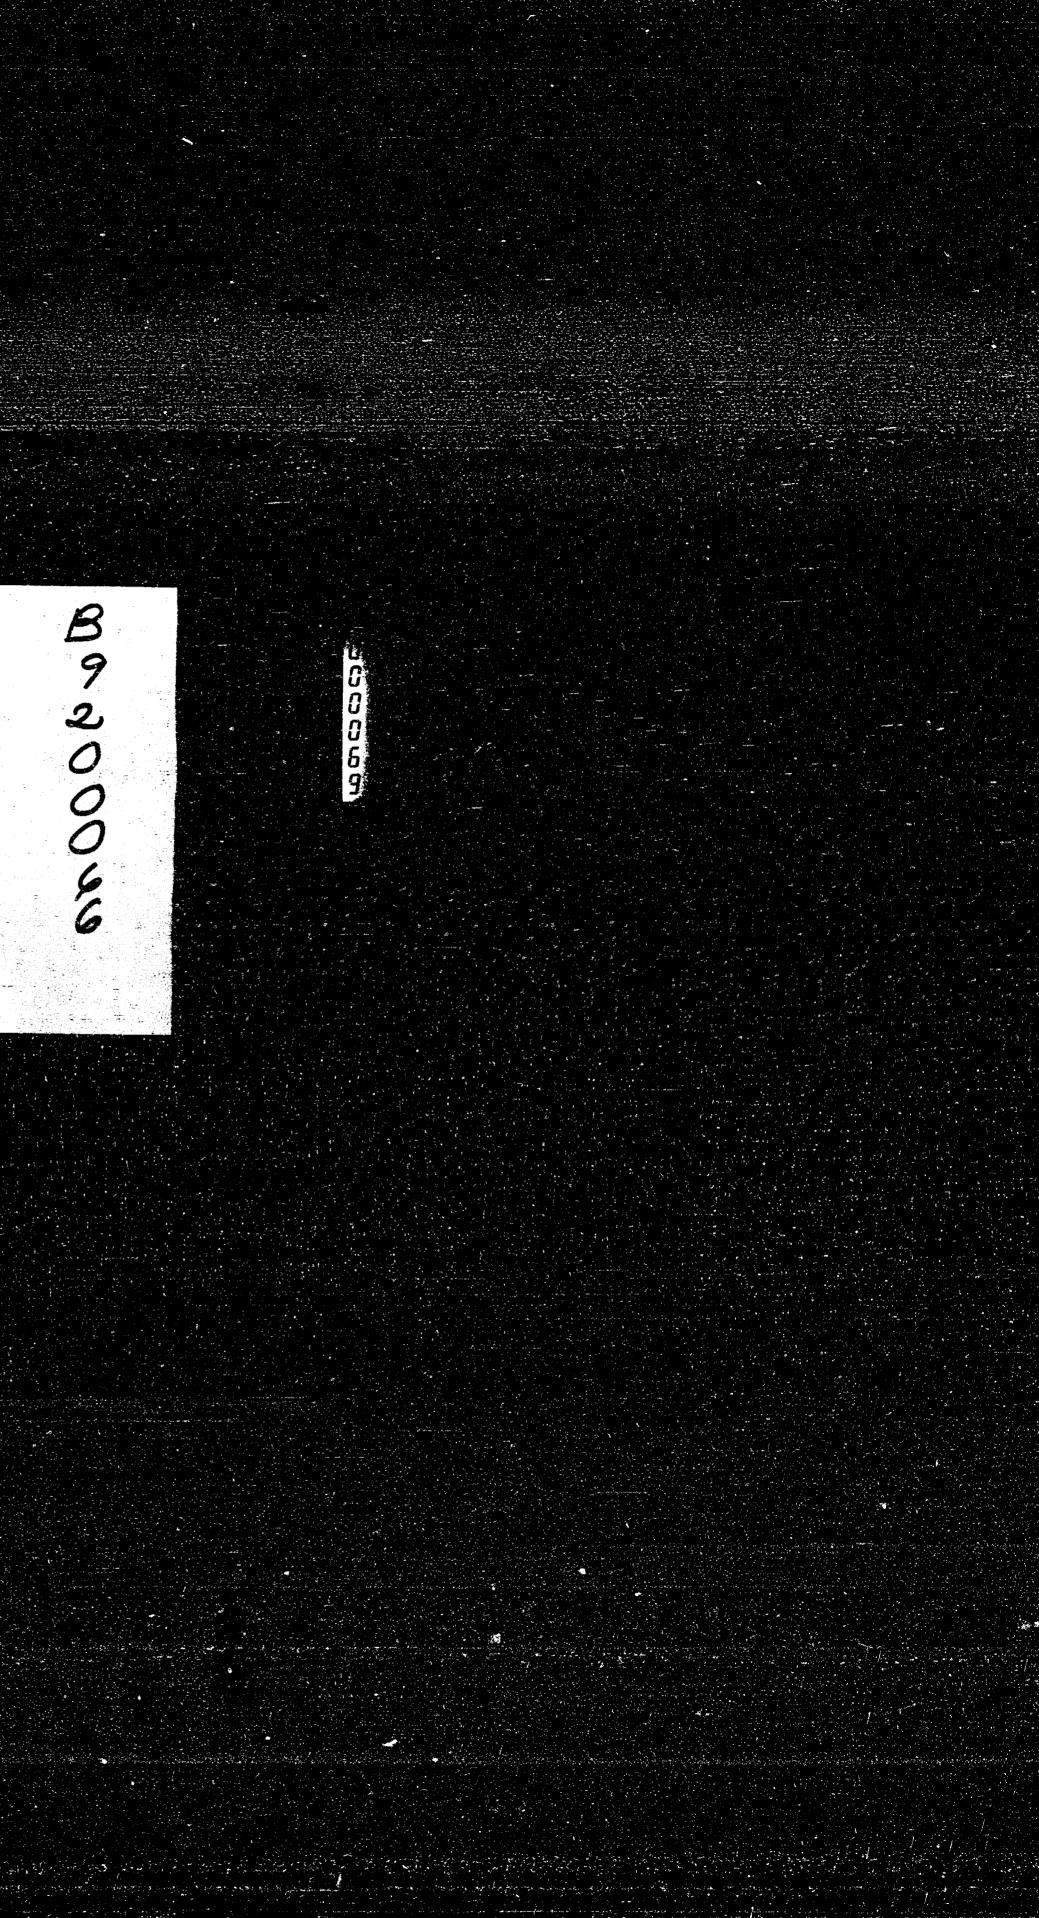





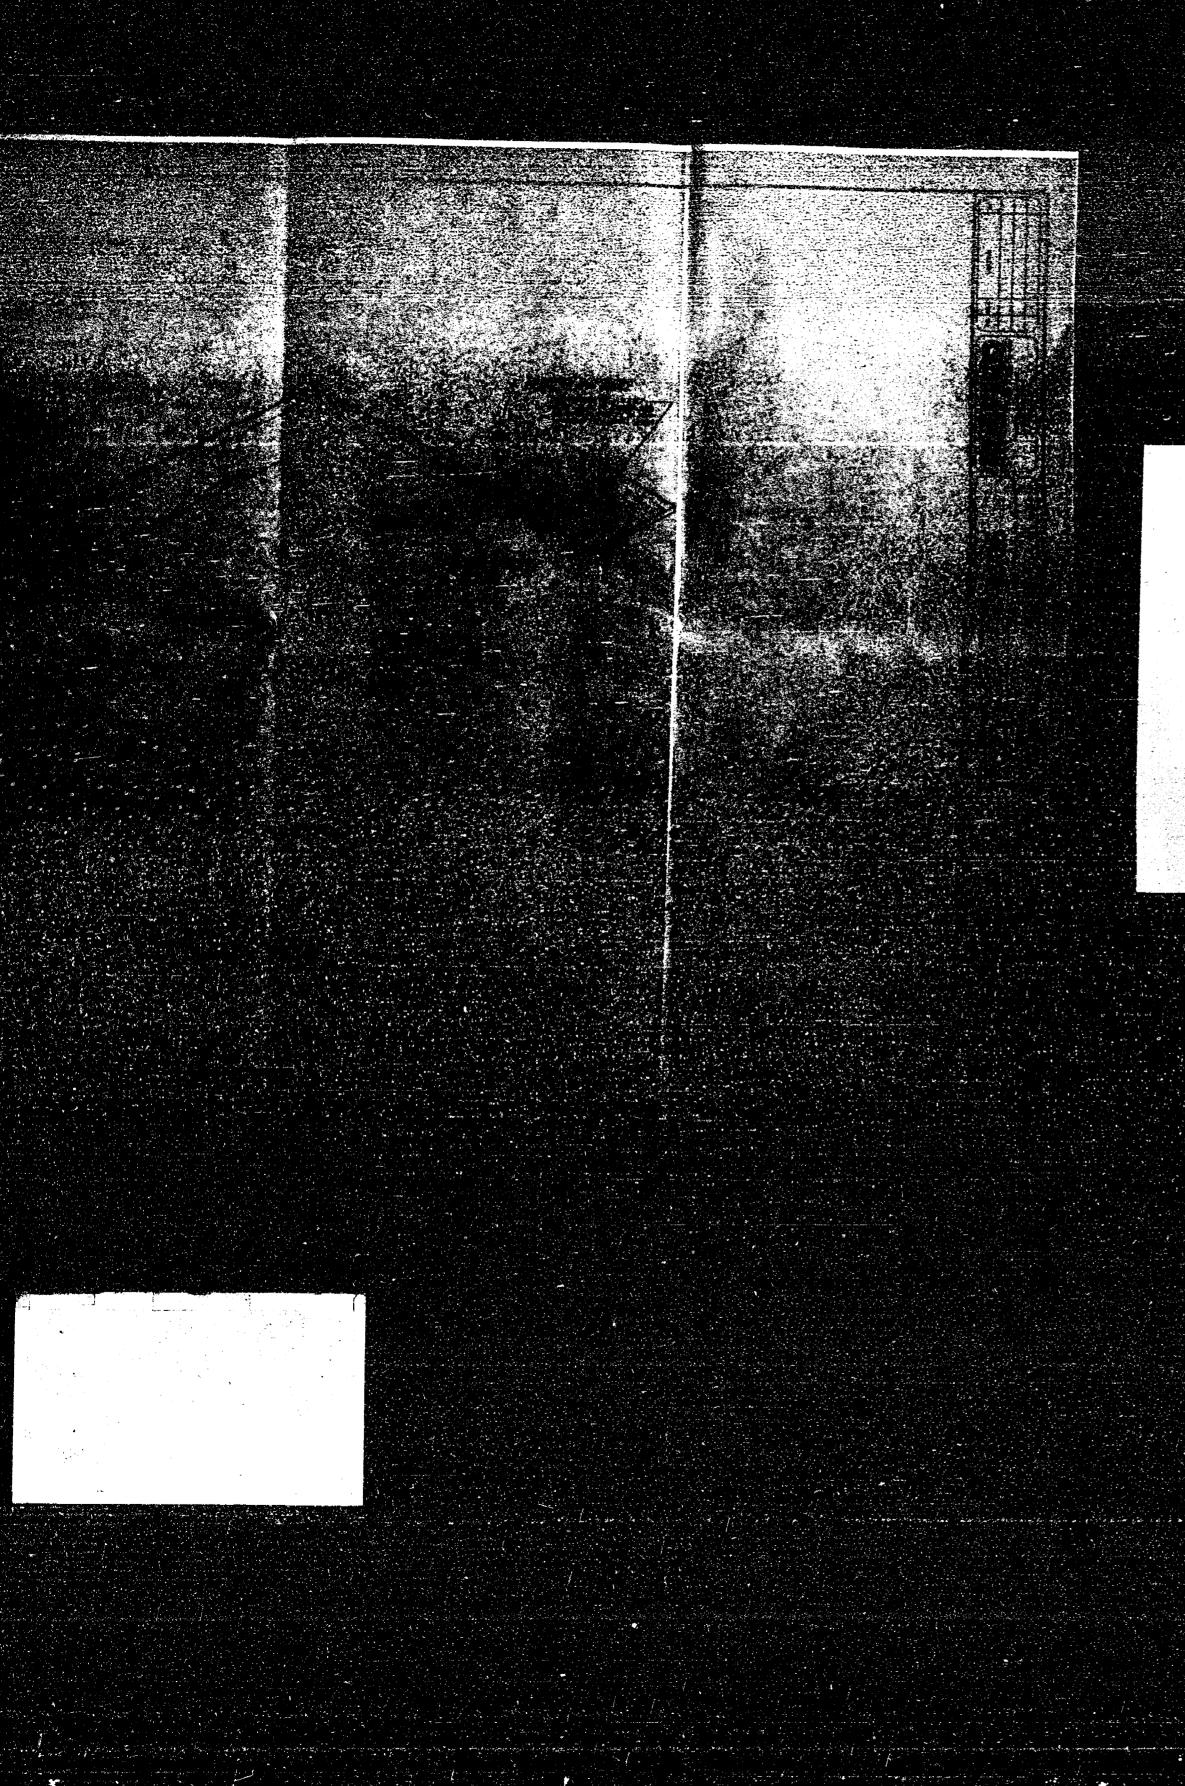

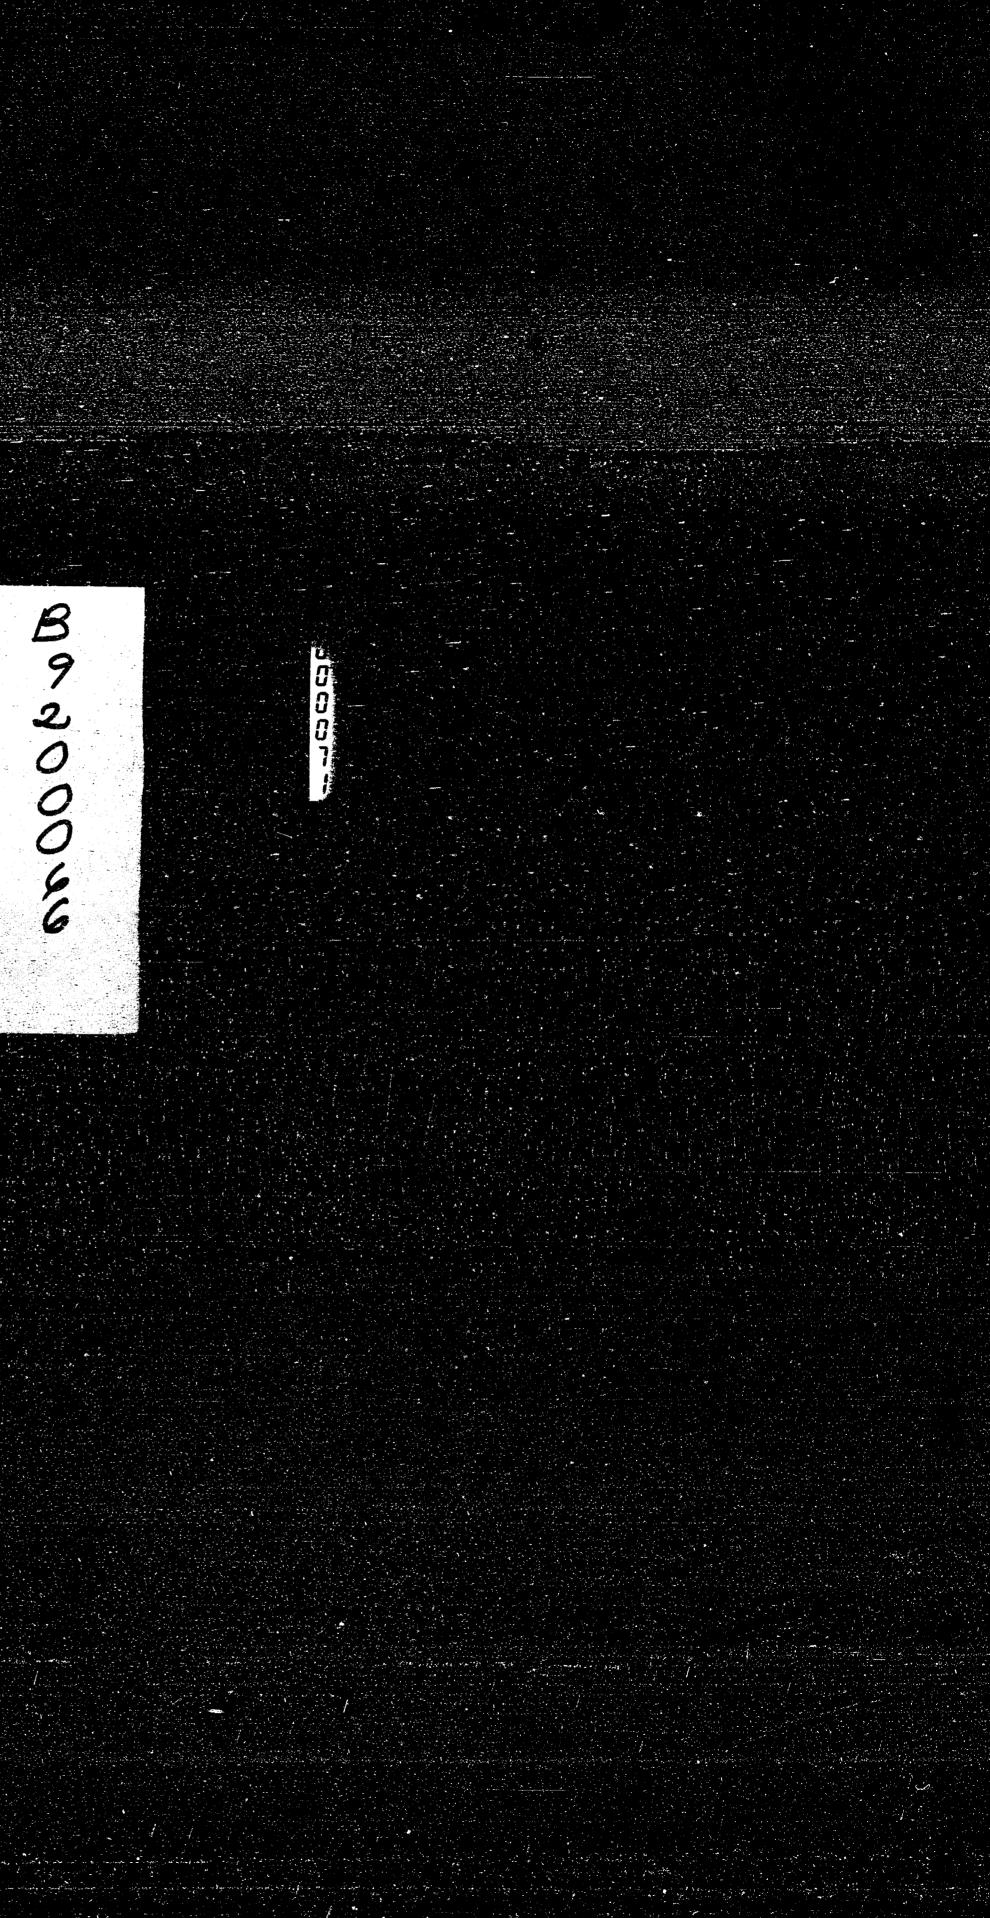

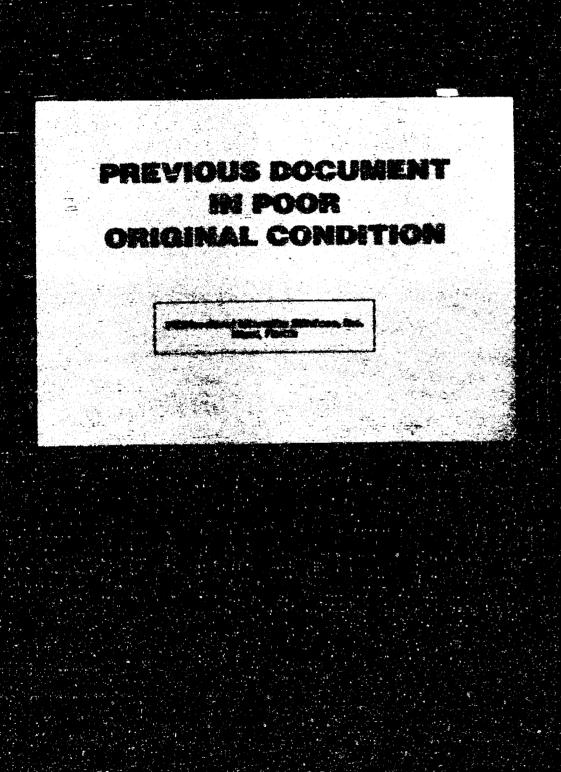

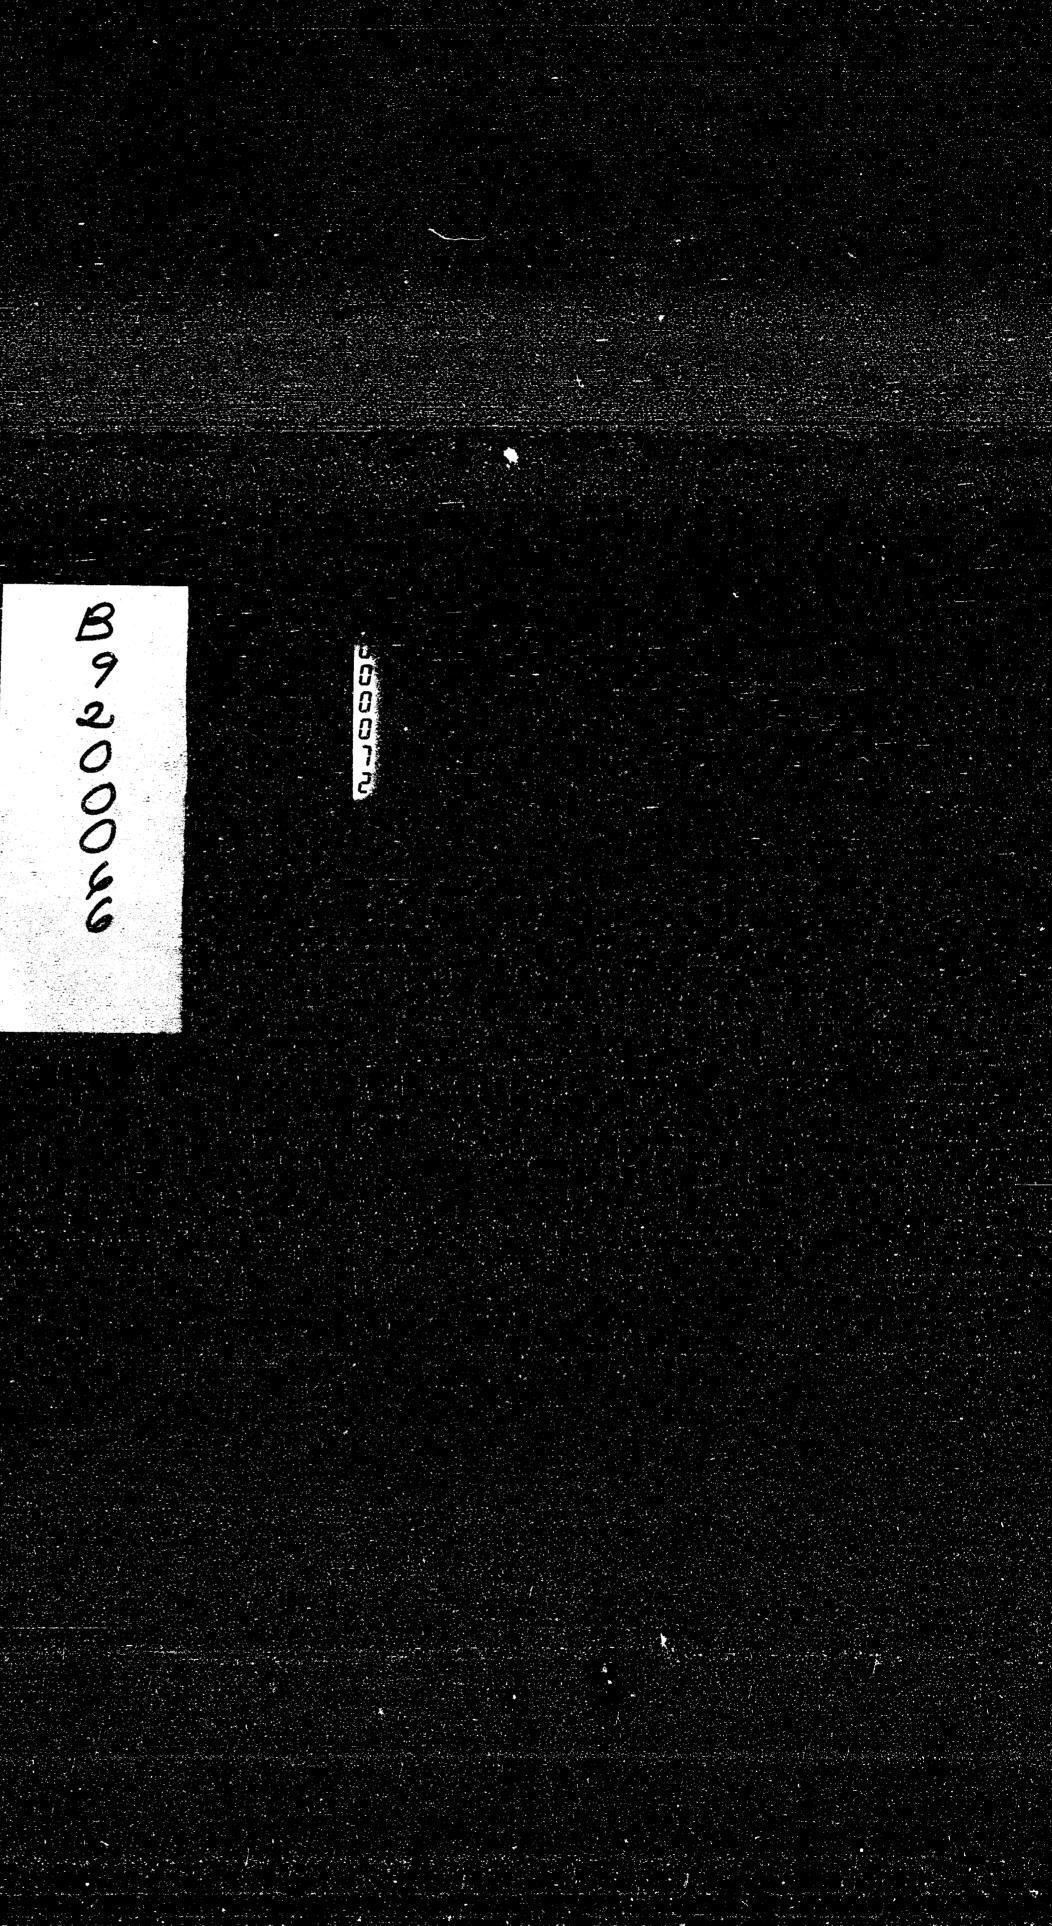

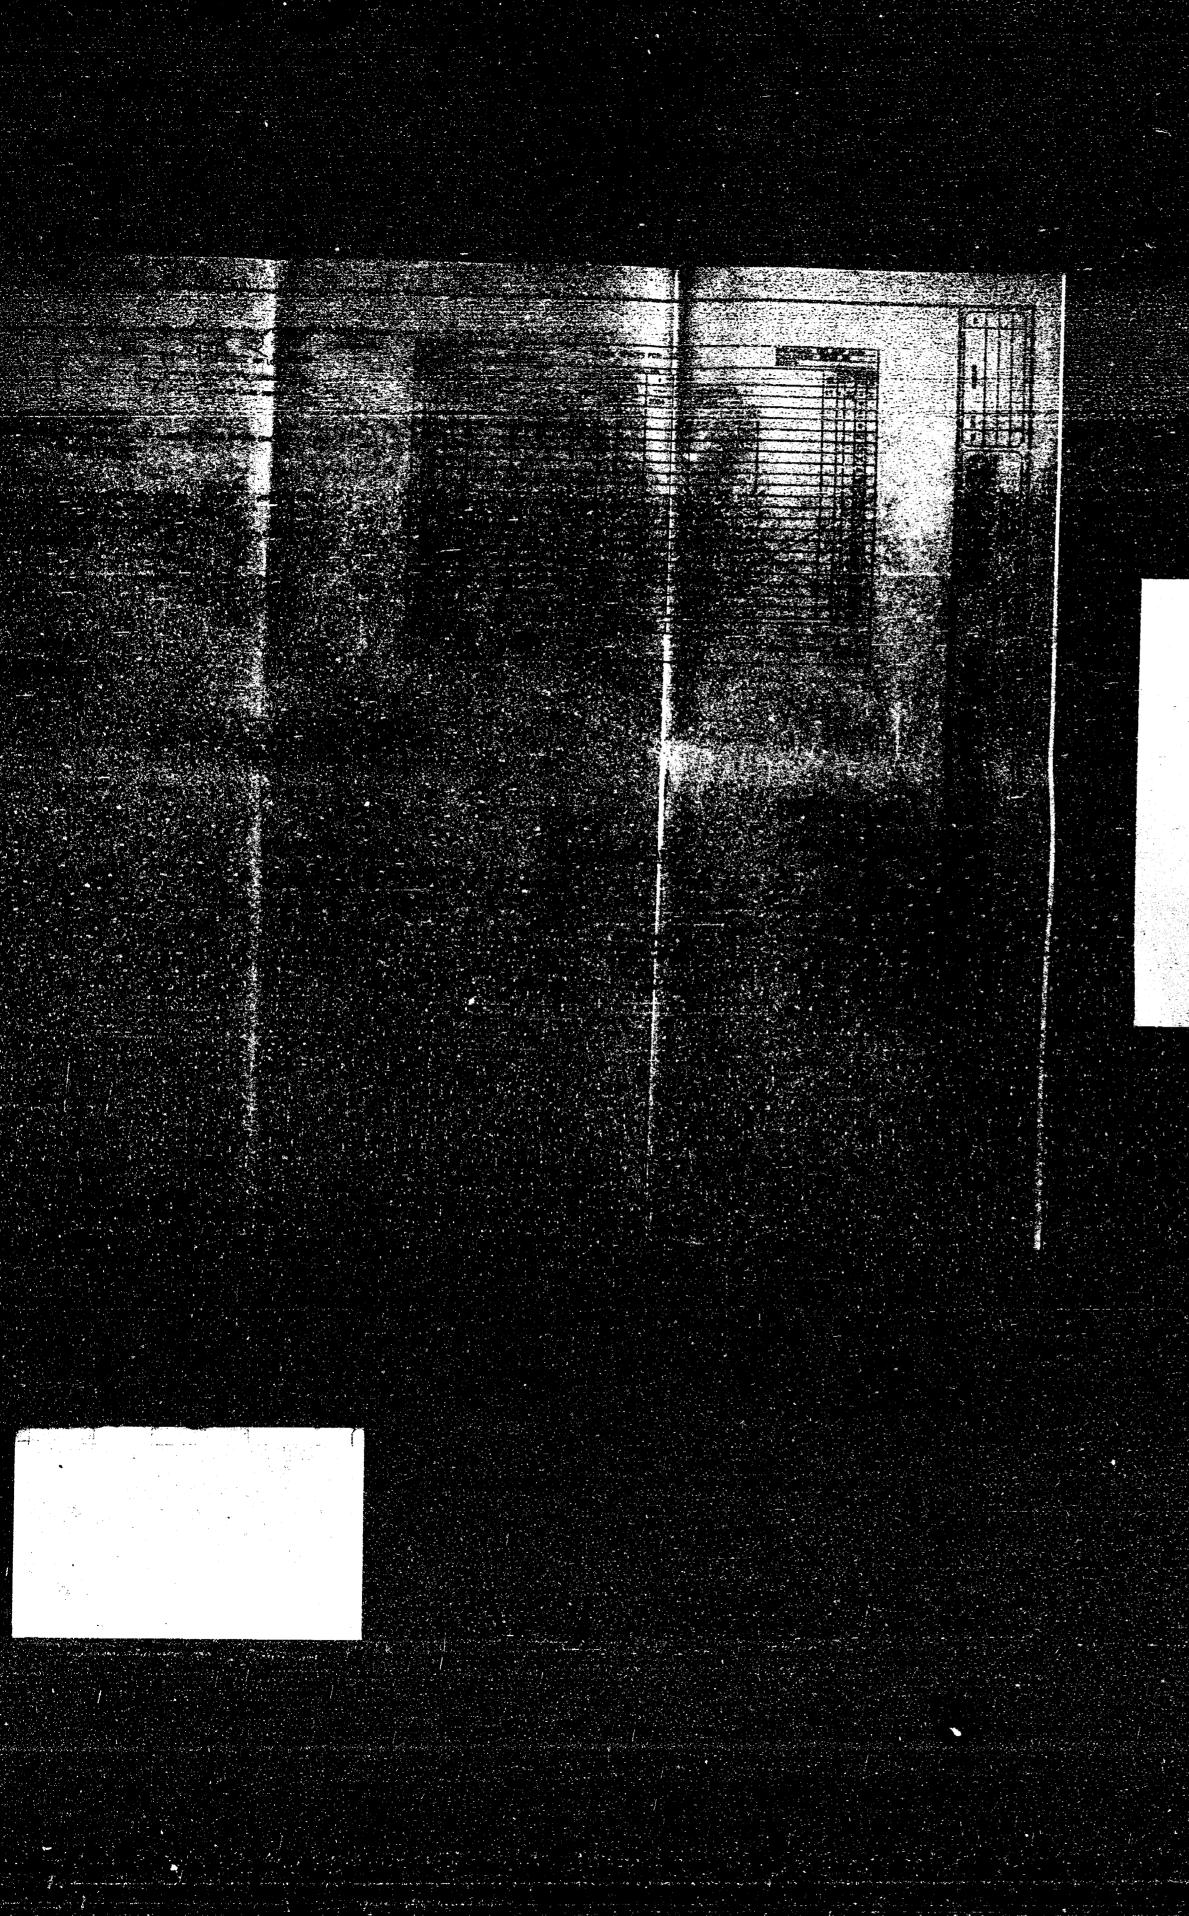



B 9 200046




 $\sim \sim$ B 200046 Ч



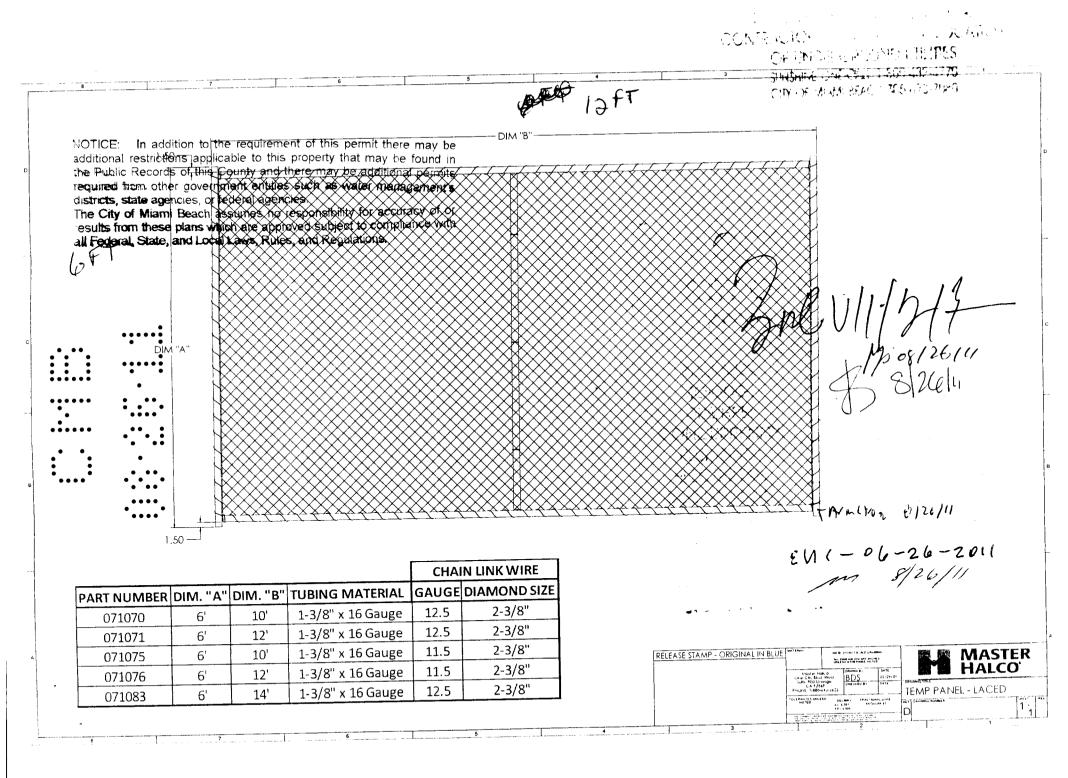

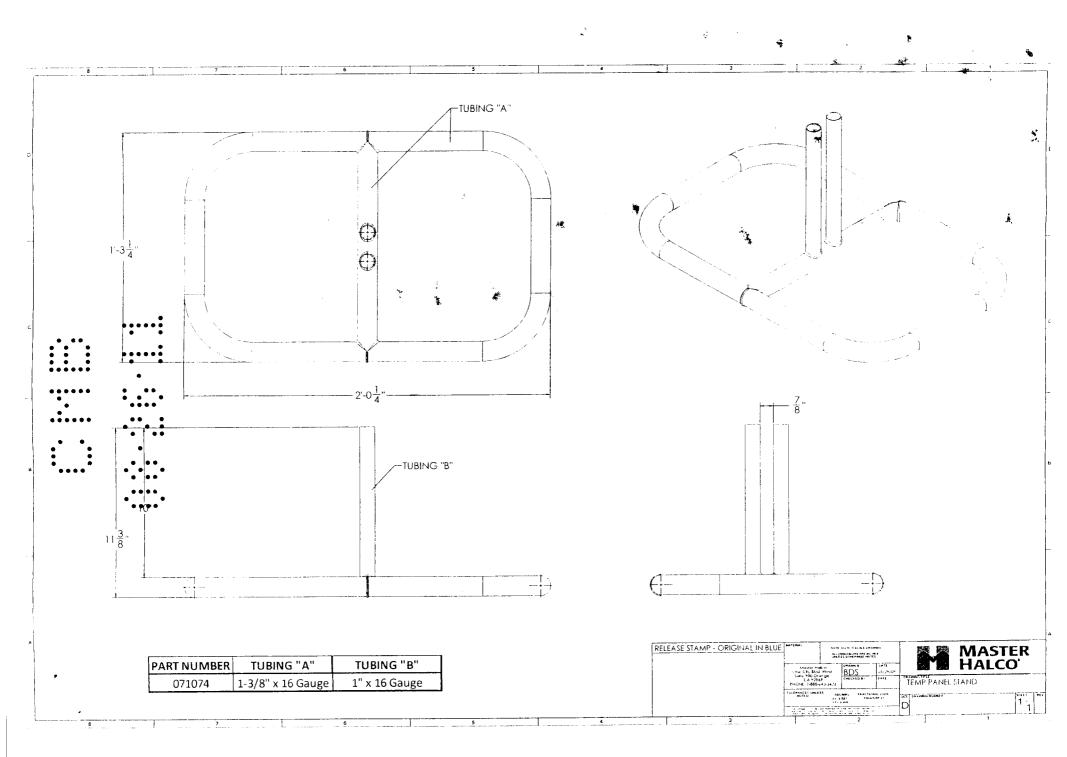

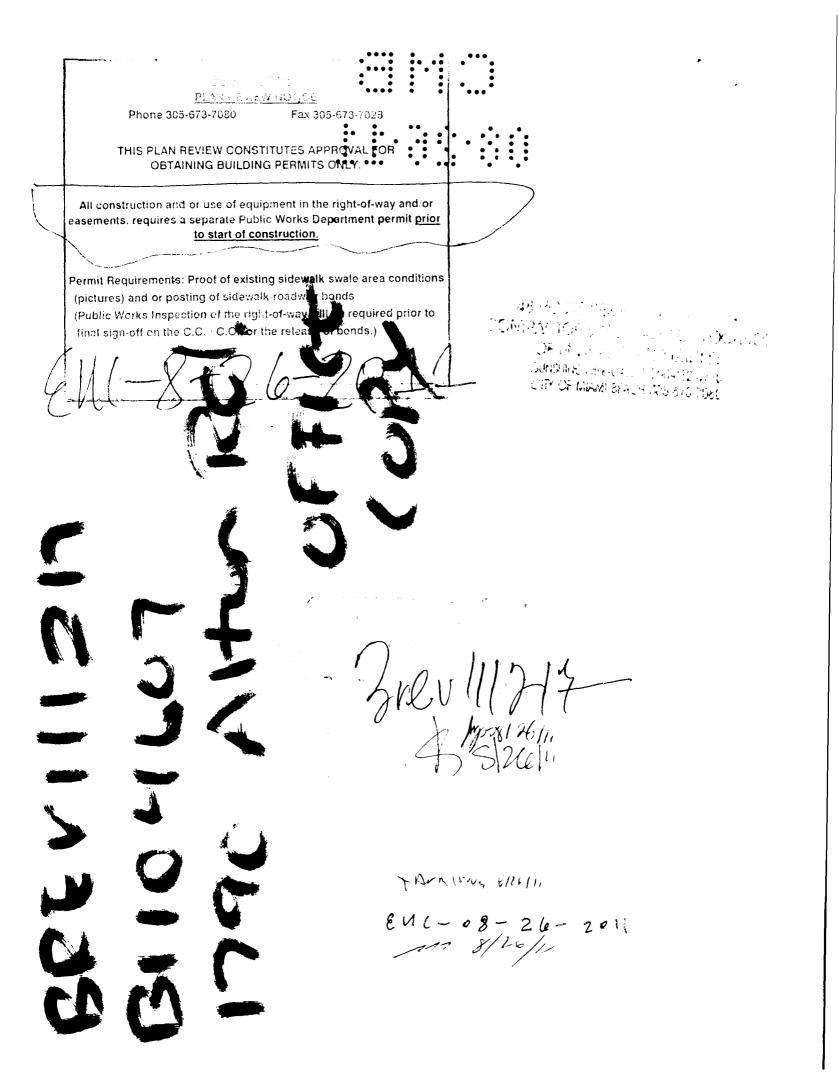



# **RECORDS REQUEST FORM**

Please allow up to 5 - 7 business days for processing

Name:		Date:
Phone No:	Alt No:	_ Email:
erty Information		
Property Address:		Unit No:
Parcel No:	Name:	
uest Type		
Survey/Site Plan	🗌 Plumbing Plan	Lost Plans, Permit #:
🗌 Orig. Construction Plan	C.O./C.C	Permit Application
🗌 Floor Plan	Building Recertification	Other, explain:
Structural Plan	Open Violations Report	t
Electrical Plan	Building Card	
Elevation Plan	Permit History Report	
🗌 Mechanical Plan	□ Inspection History Repo	rt
a Type		

-----

CD - \$3.00

To be used for inspections/permit renewals. Lost Plans Fee - \$50.00 plus \$1.00 plus 15¢ (Letter/Legal) and 20¢ (Ledger) per sheet

<u>Note:</u> Plans used for inspections and permit renewals are 11 in x 17 in. This size may not be legible for inspections/permit renewal. You may purchase a CD for \$3.00 containing the plans to be enlarged by a private vendor. <u>Certified</u> 11 in x17 in plans provided by Building Records Management must be attached to the enlarged set.

#### **City of Miami Beach Mission** We are committed to providing excellent public service and safety to all who live, work and play in our vibrant, tropical, historic community.

Form Name: Records Request Form.

**Purpose:** To request information for a property.


**Form Submittal:** Records Request should be submitted in a timely manner by email, fax, or in person at Records Department.


# Please allow up to 5 - 7 business days for processing.


- **Associated Fees** Certified Copy Requests are \$1.00 plus 15¢ (Letter/Legal) and 20¢ (Ledger) per sheet, CD \$3.00, Lost Plans Fee \$50.00 plus \$1.00 plus 15¢ (Letter/Legal) and 20¢ (Ledger) per sheet based on the current Fee Schedule.
- For Assistance Please contact:
  - In-Person: Building Department, Miami Beach City Hall RECORDS DIVISION 1700 Convention Center Drive, 2<sup>nd</sup>, Miami Beach, FL 33139
  - 2. Via Telephone: 305-673-7610, option #3, then #4 Main Extension: 26189
  - 3. Via E-mail: <u>buildingrecords@miamibeachfl.gov</u>
  - 4. **Fax Number:** 786-394-4050


### Building Department Mission

We are dedicated to serving the public by the efficient and effective supervision of construction, business, professional and personal activities to safeguard the public health, safety and general welfare of the City's residents and visitors by enforcing the Florida Building Code and the City Code of Ordinances.

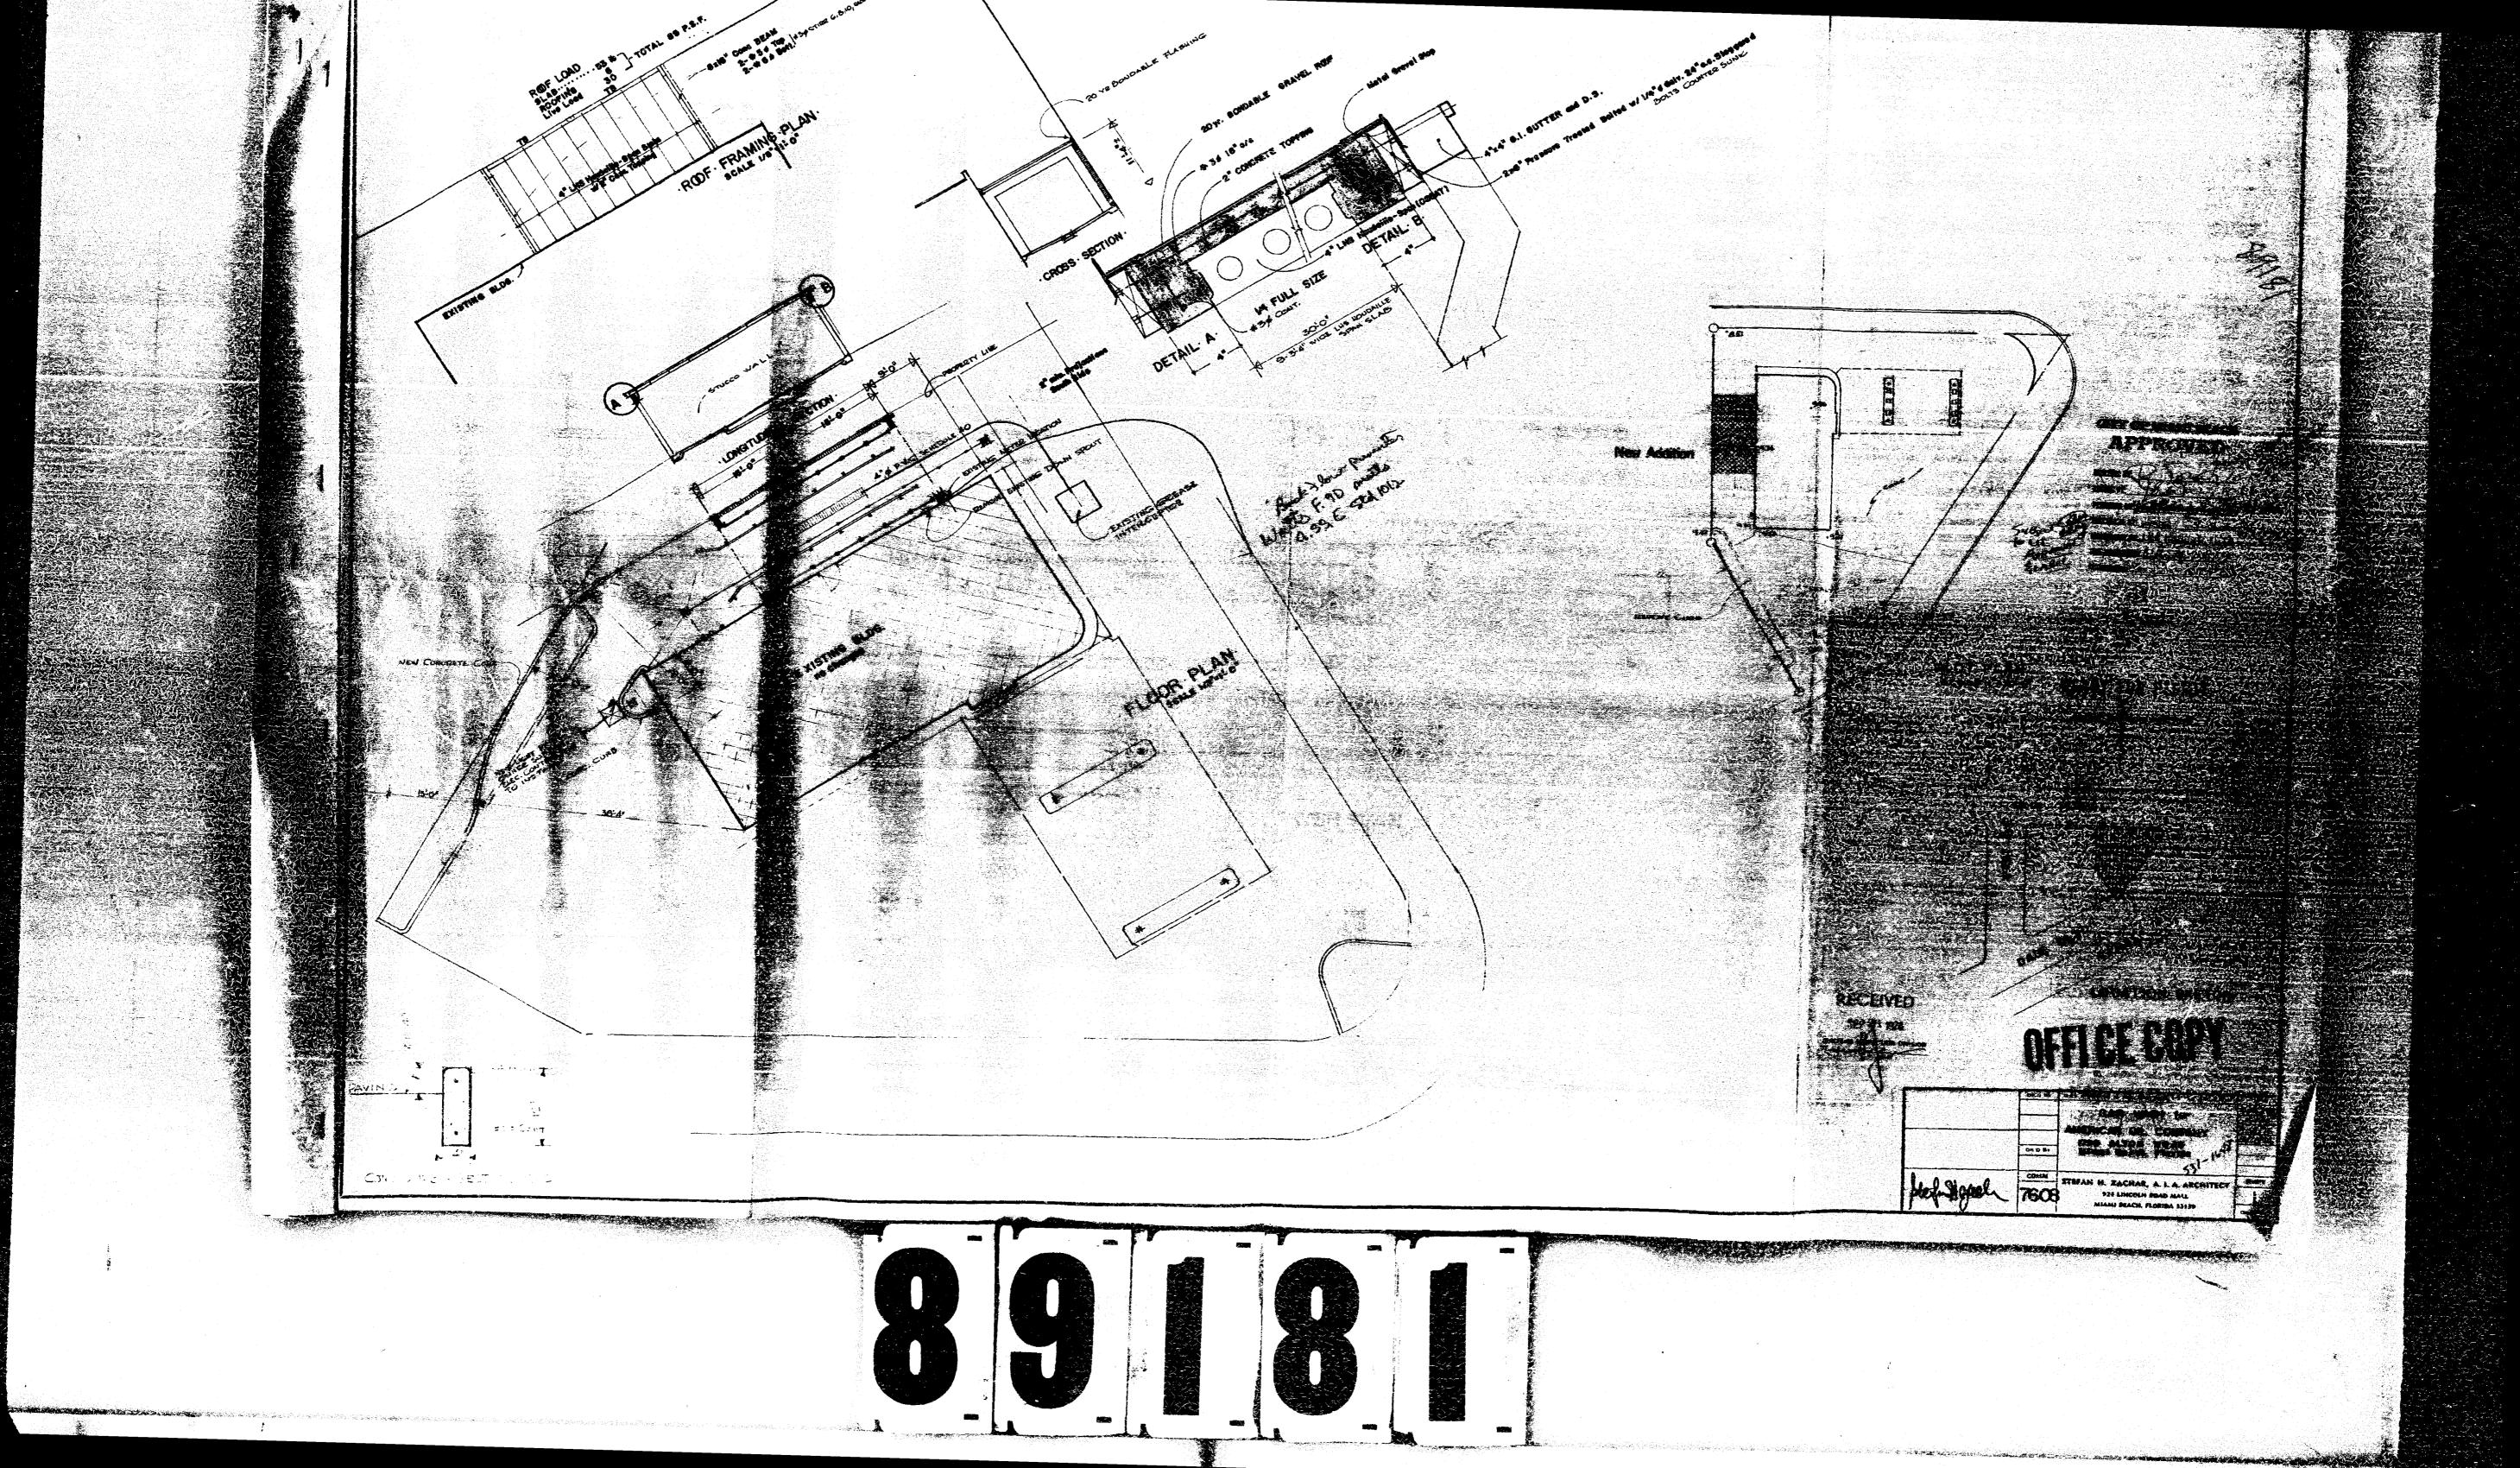


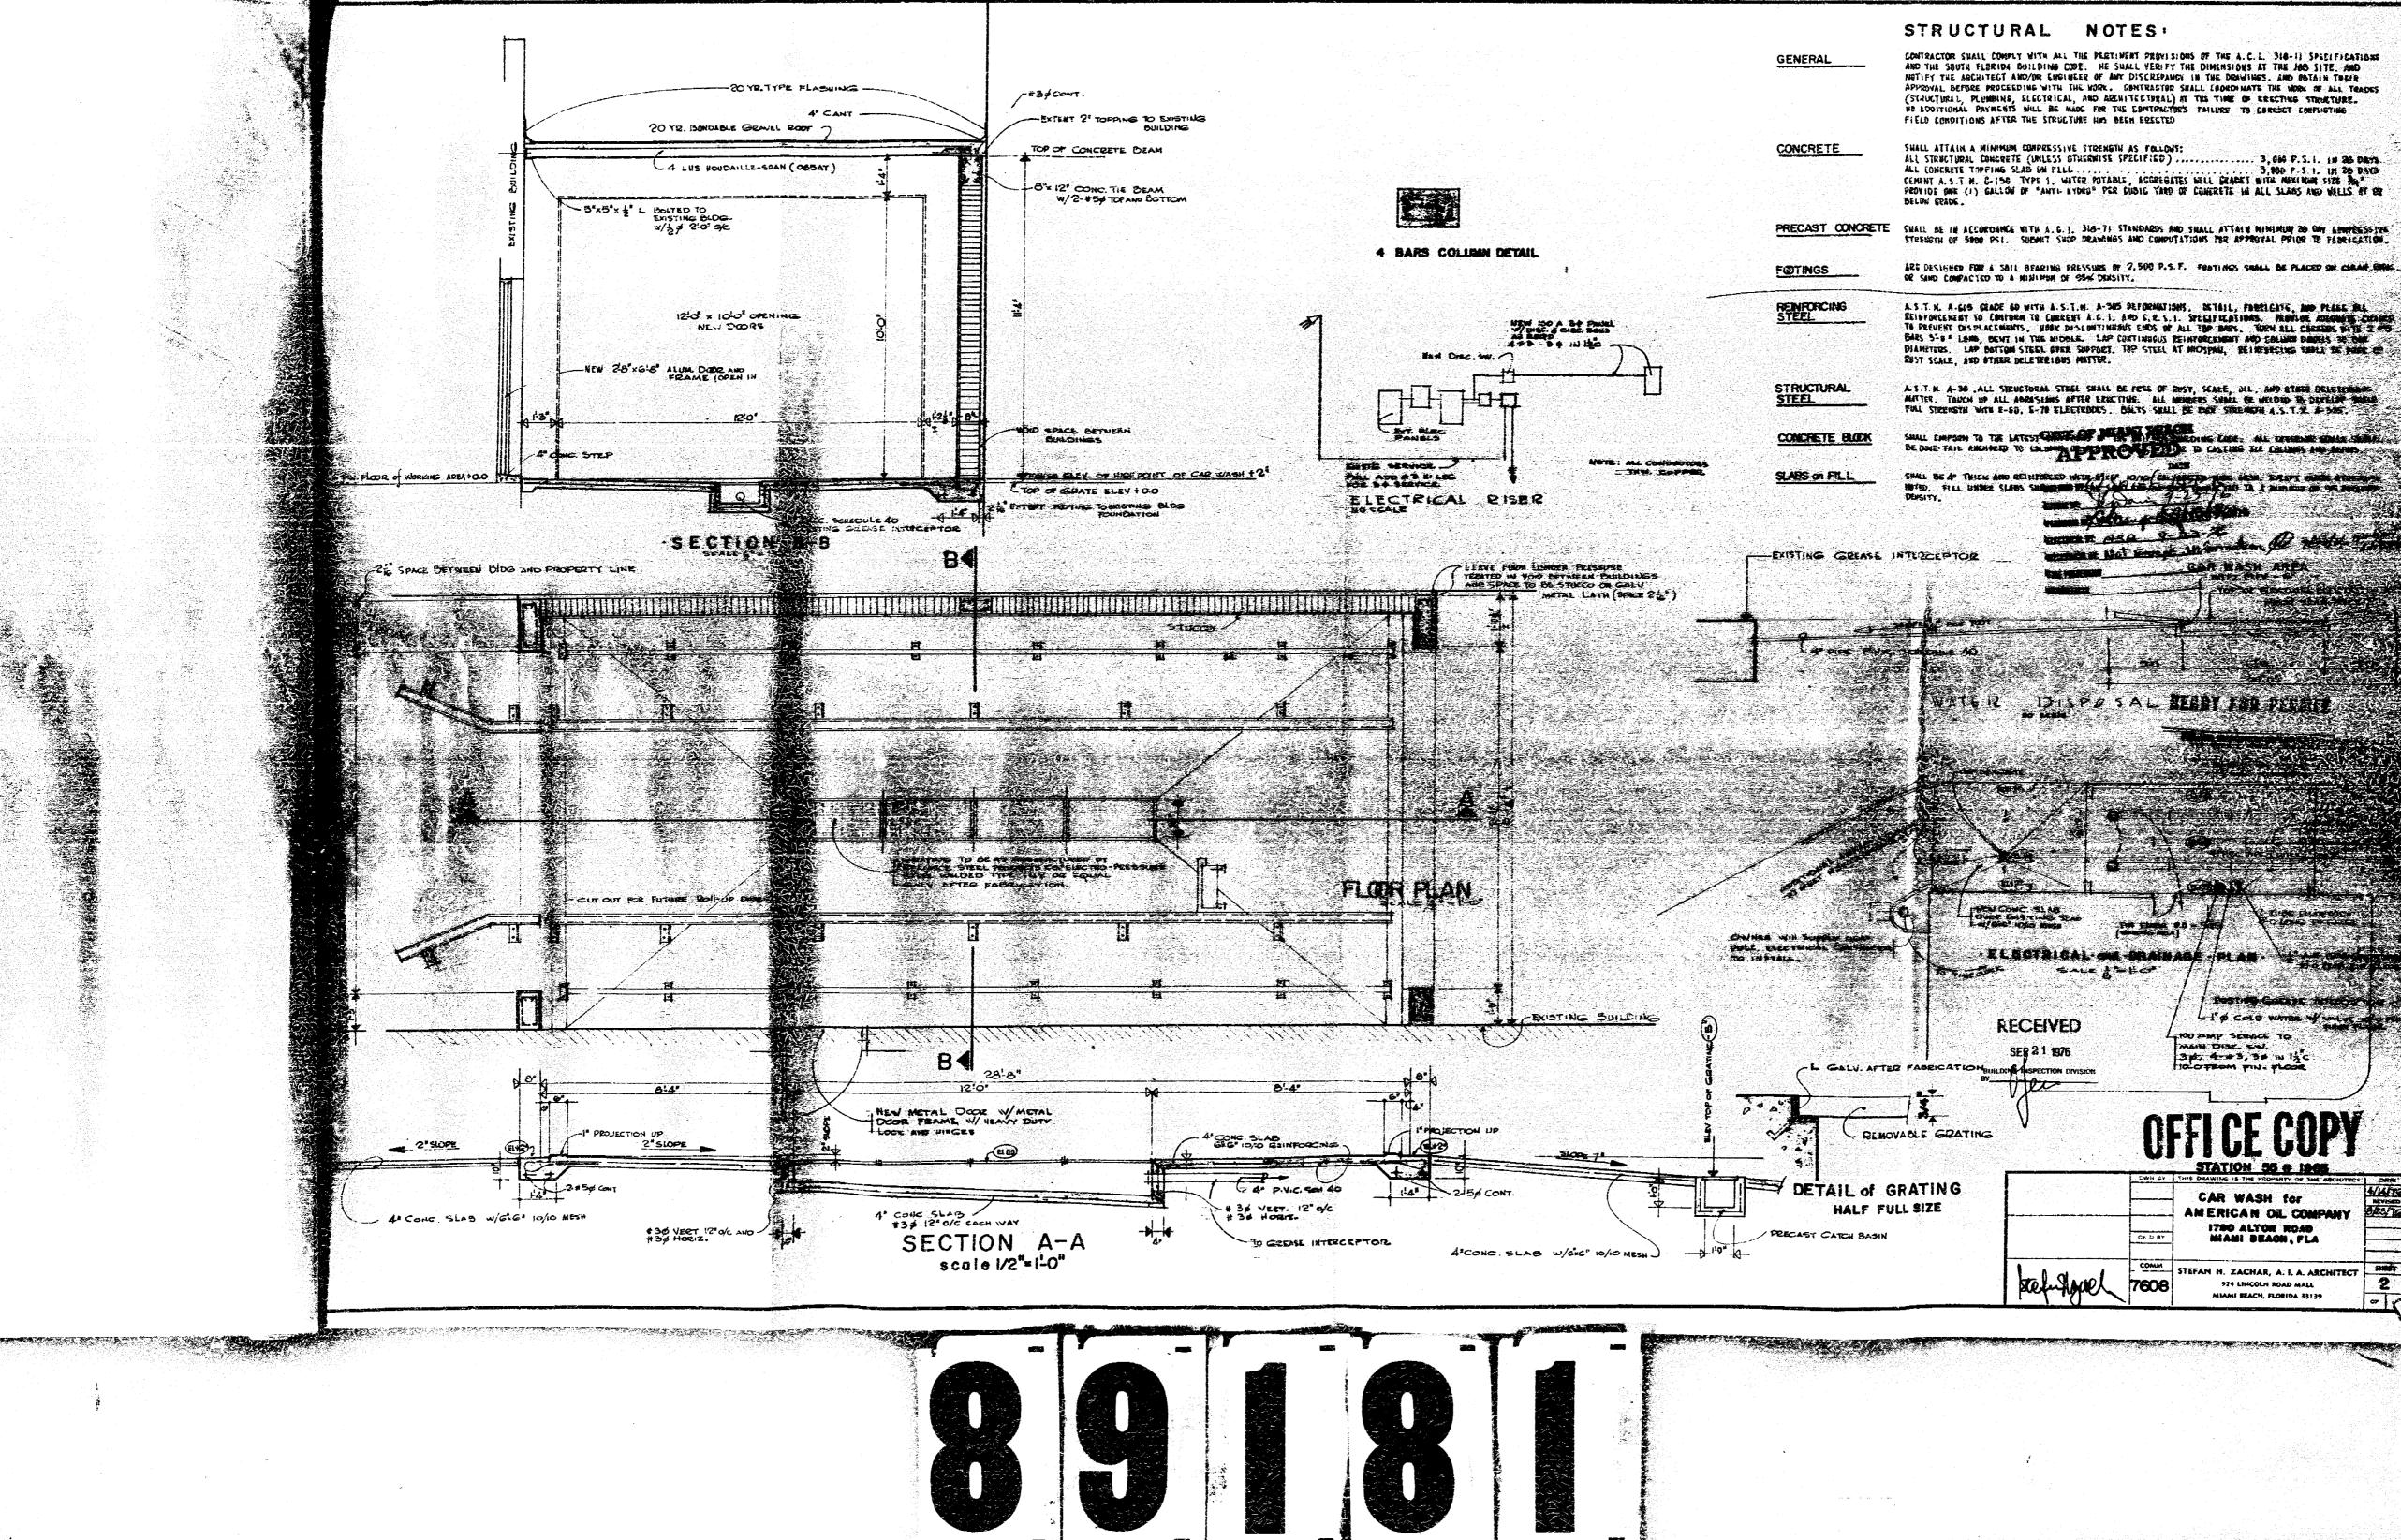

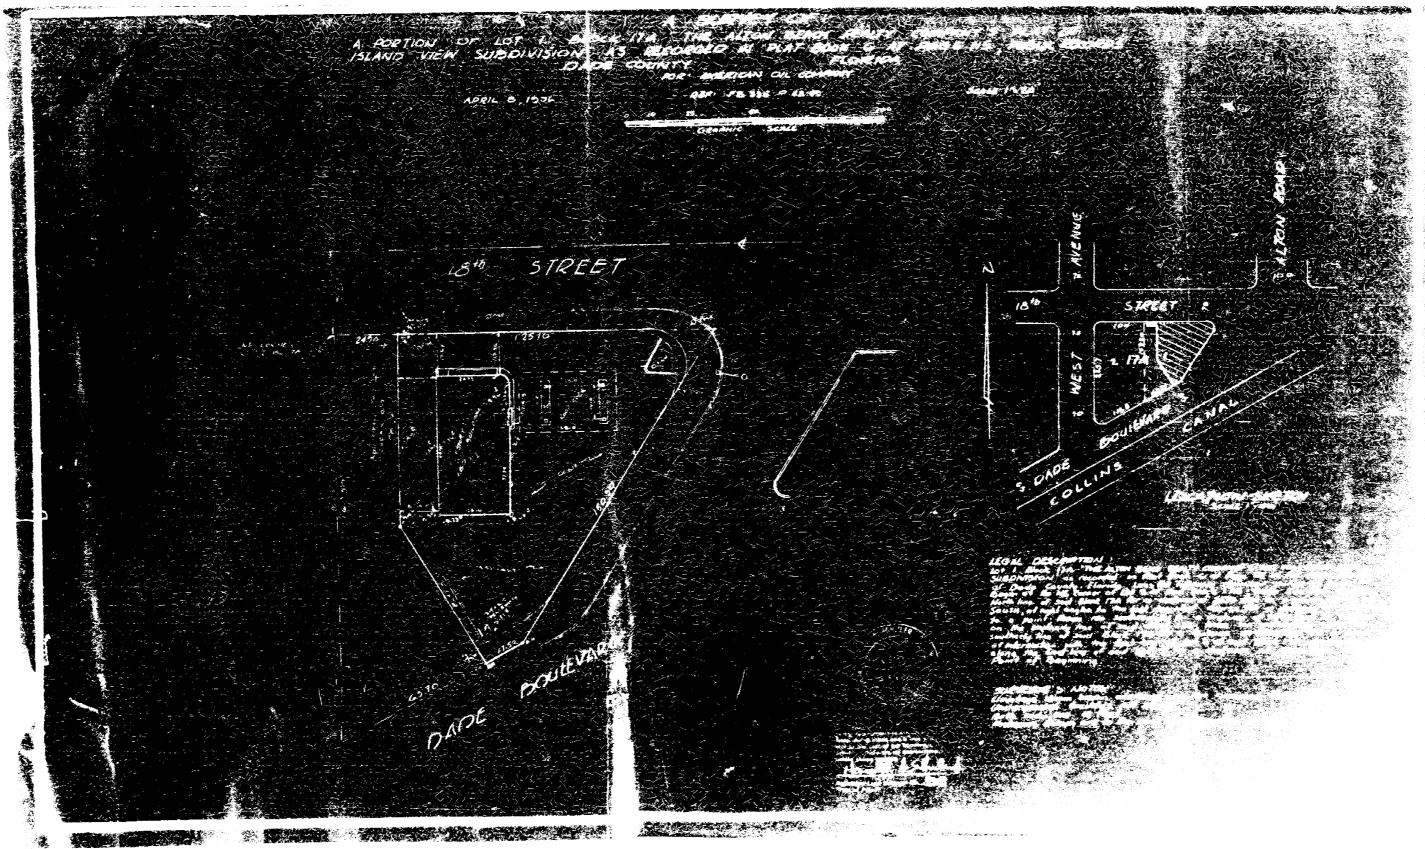

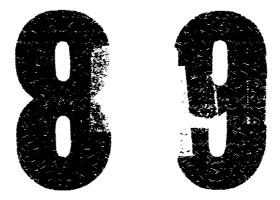



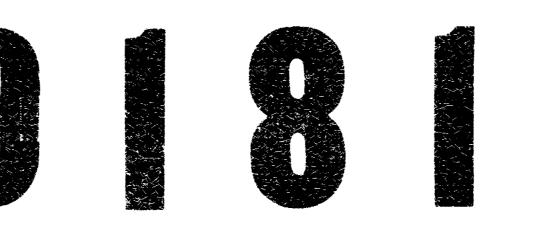












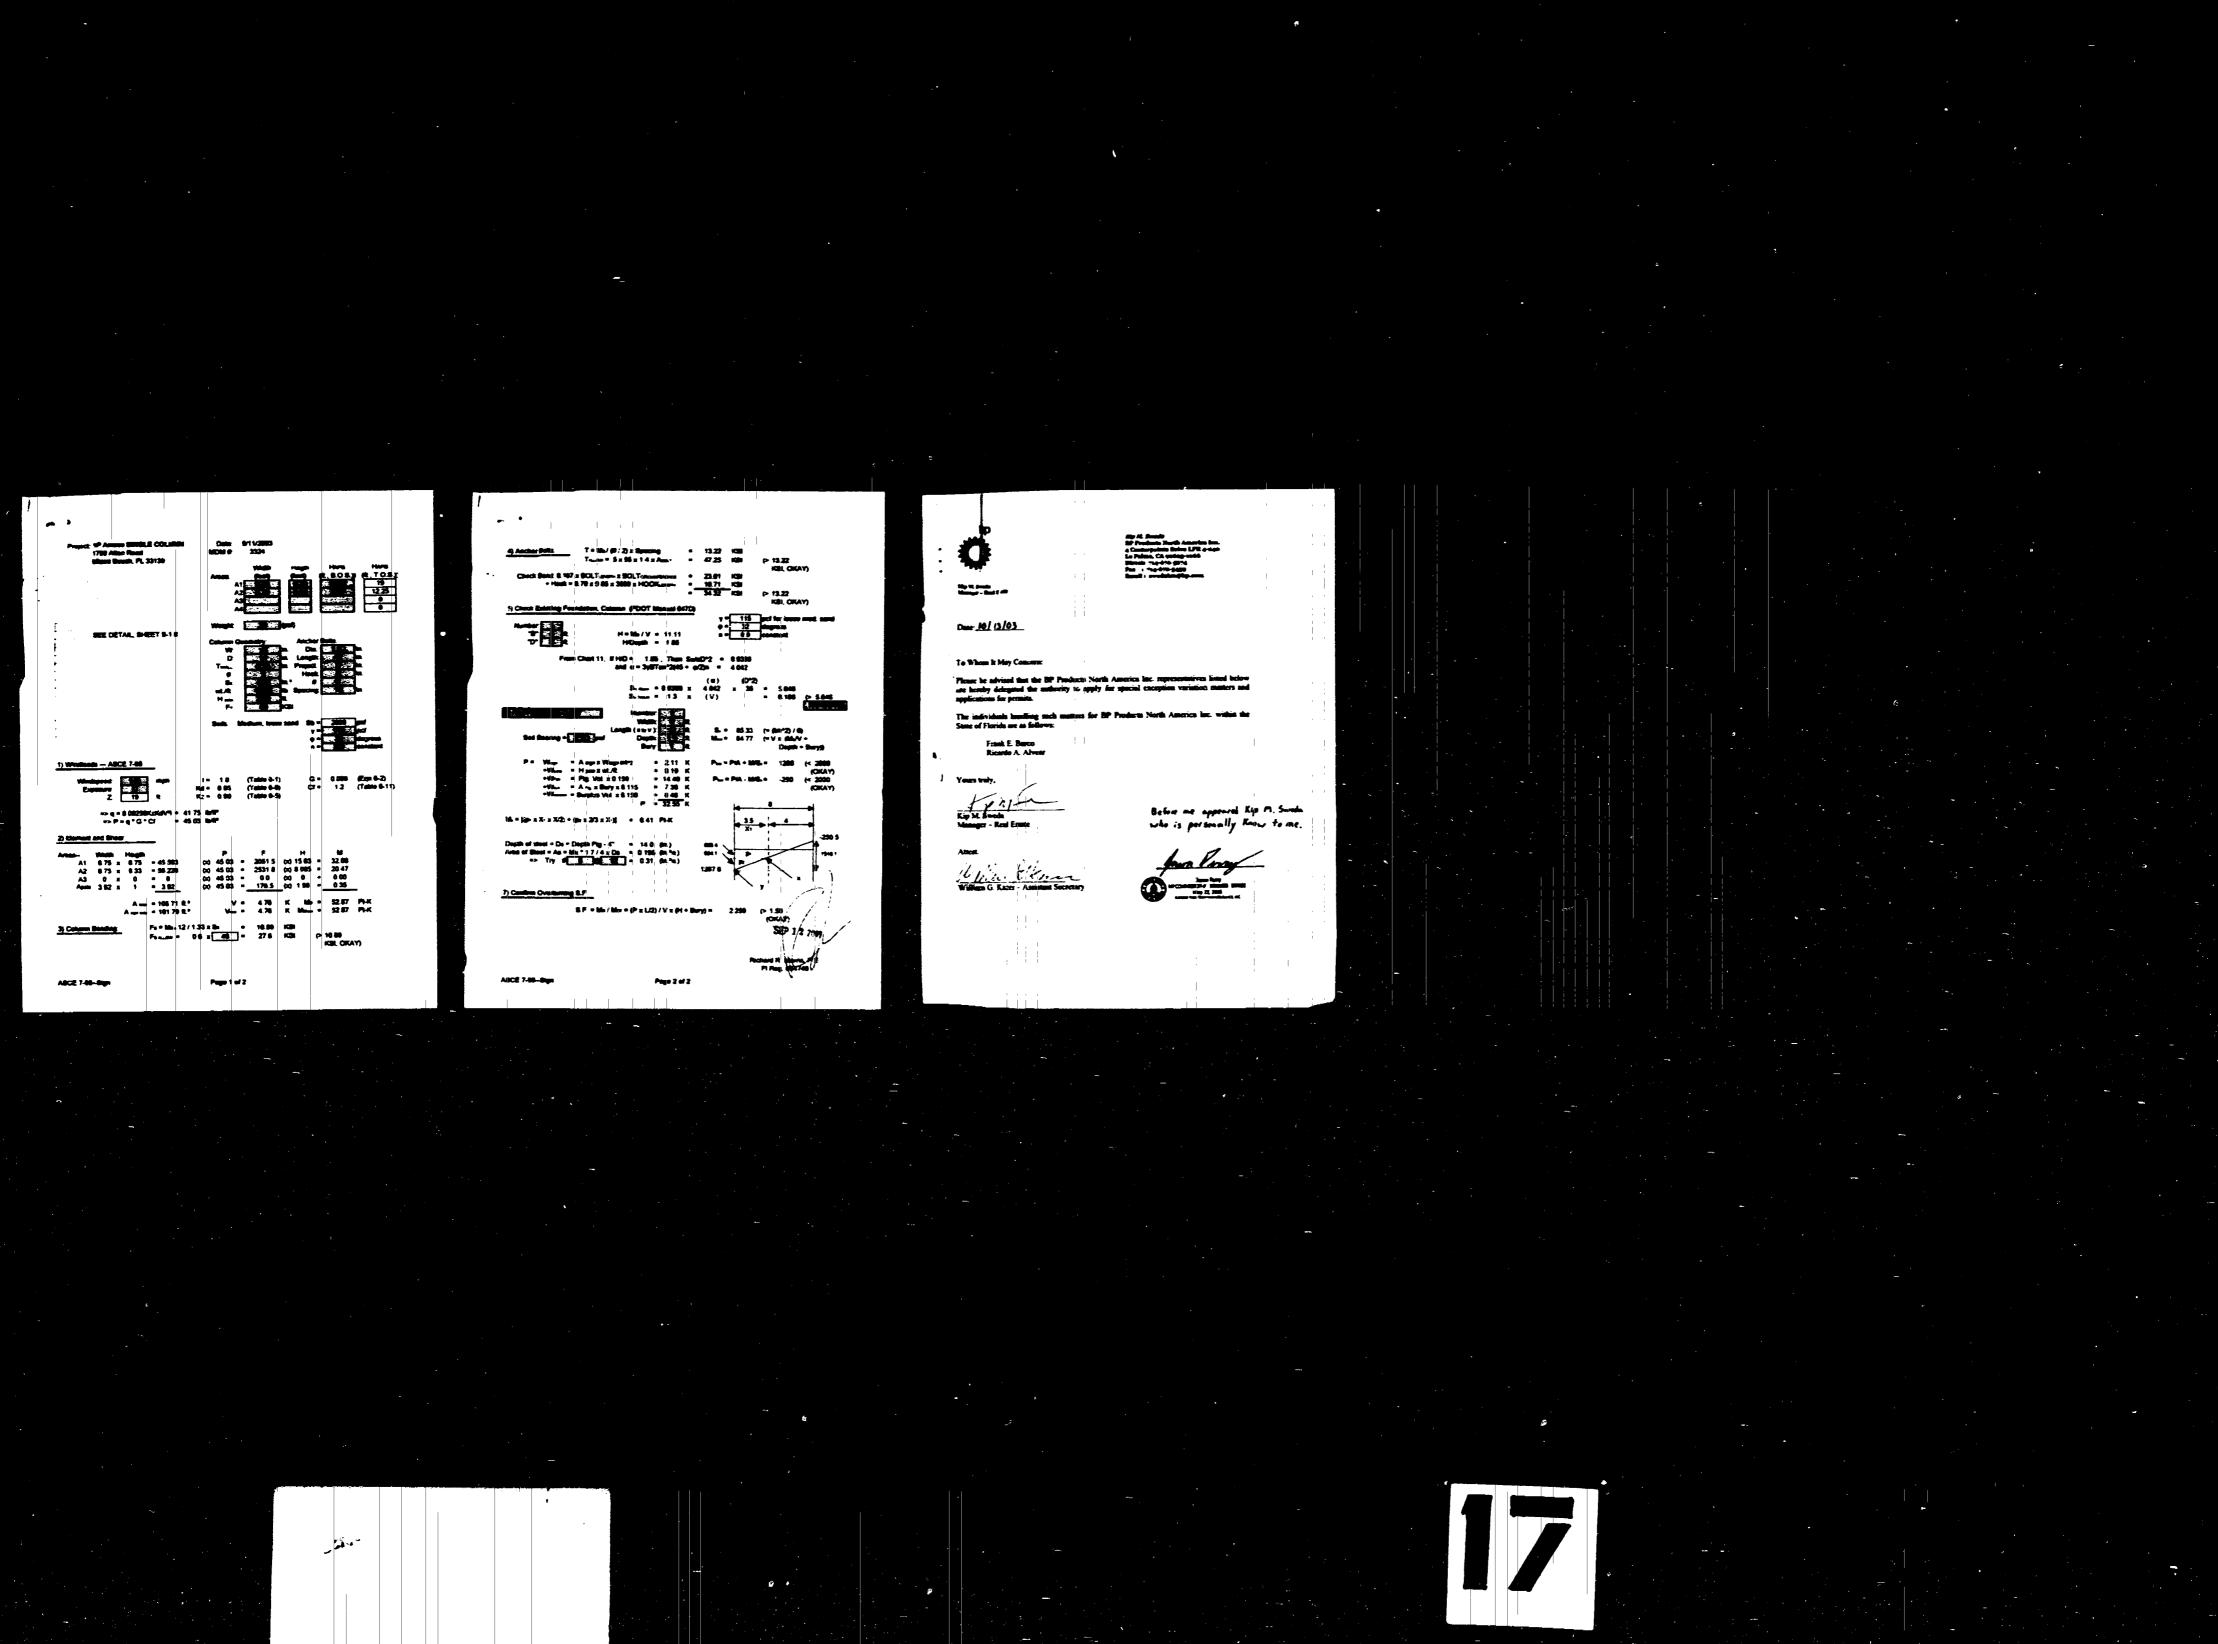

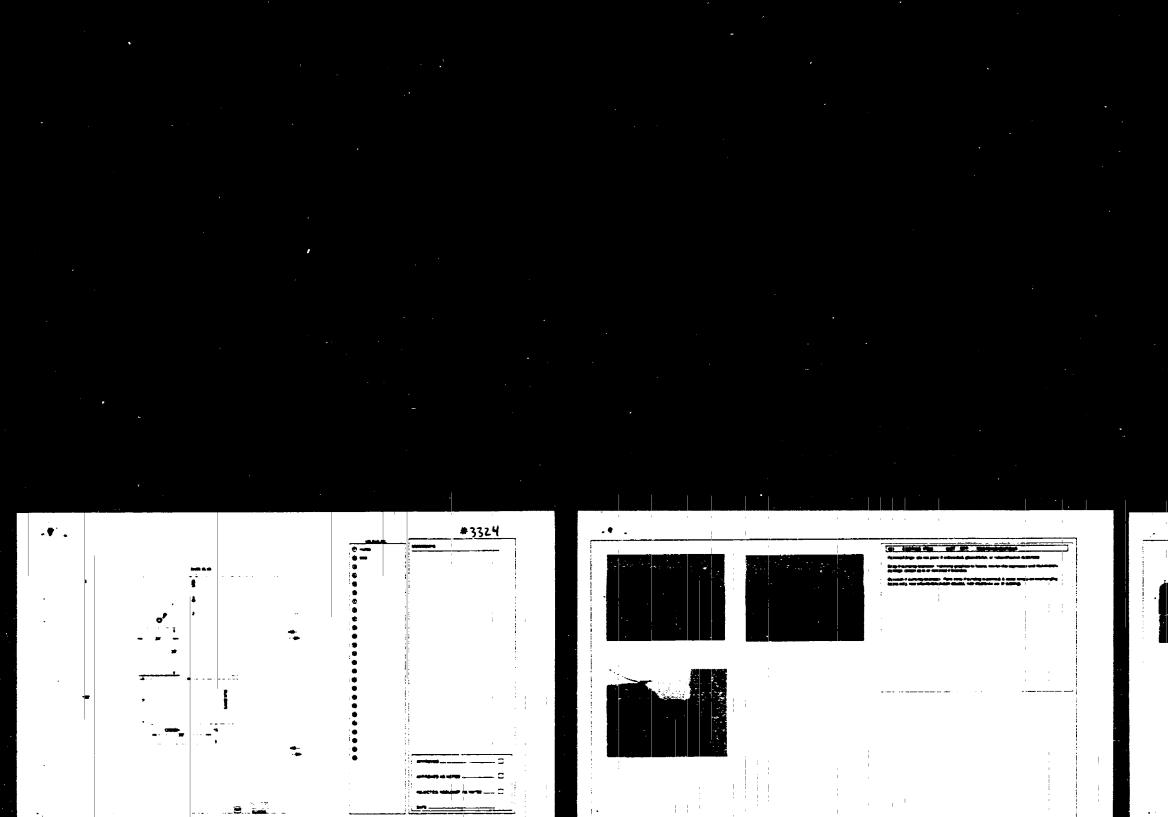

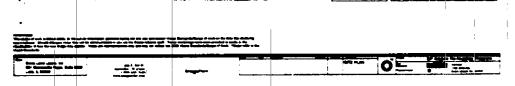





مع**لار** 

<u> The sector composed a sector tot.</u>

The Starts and which it is a start of the st

0

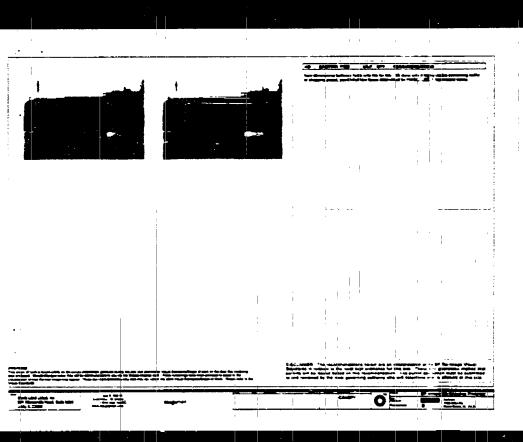


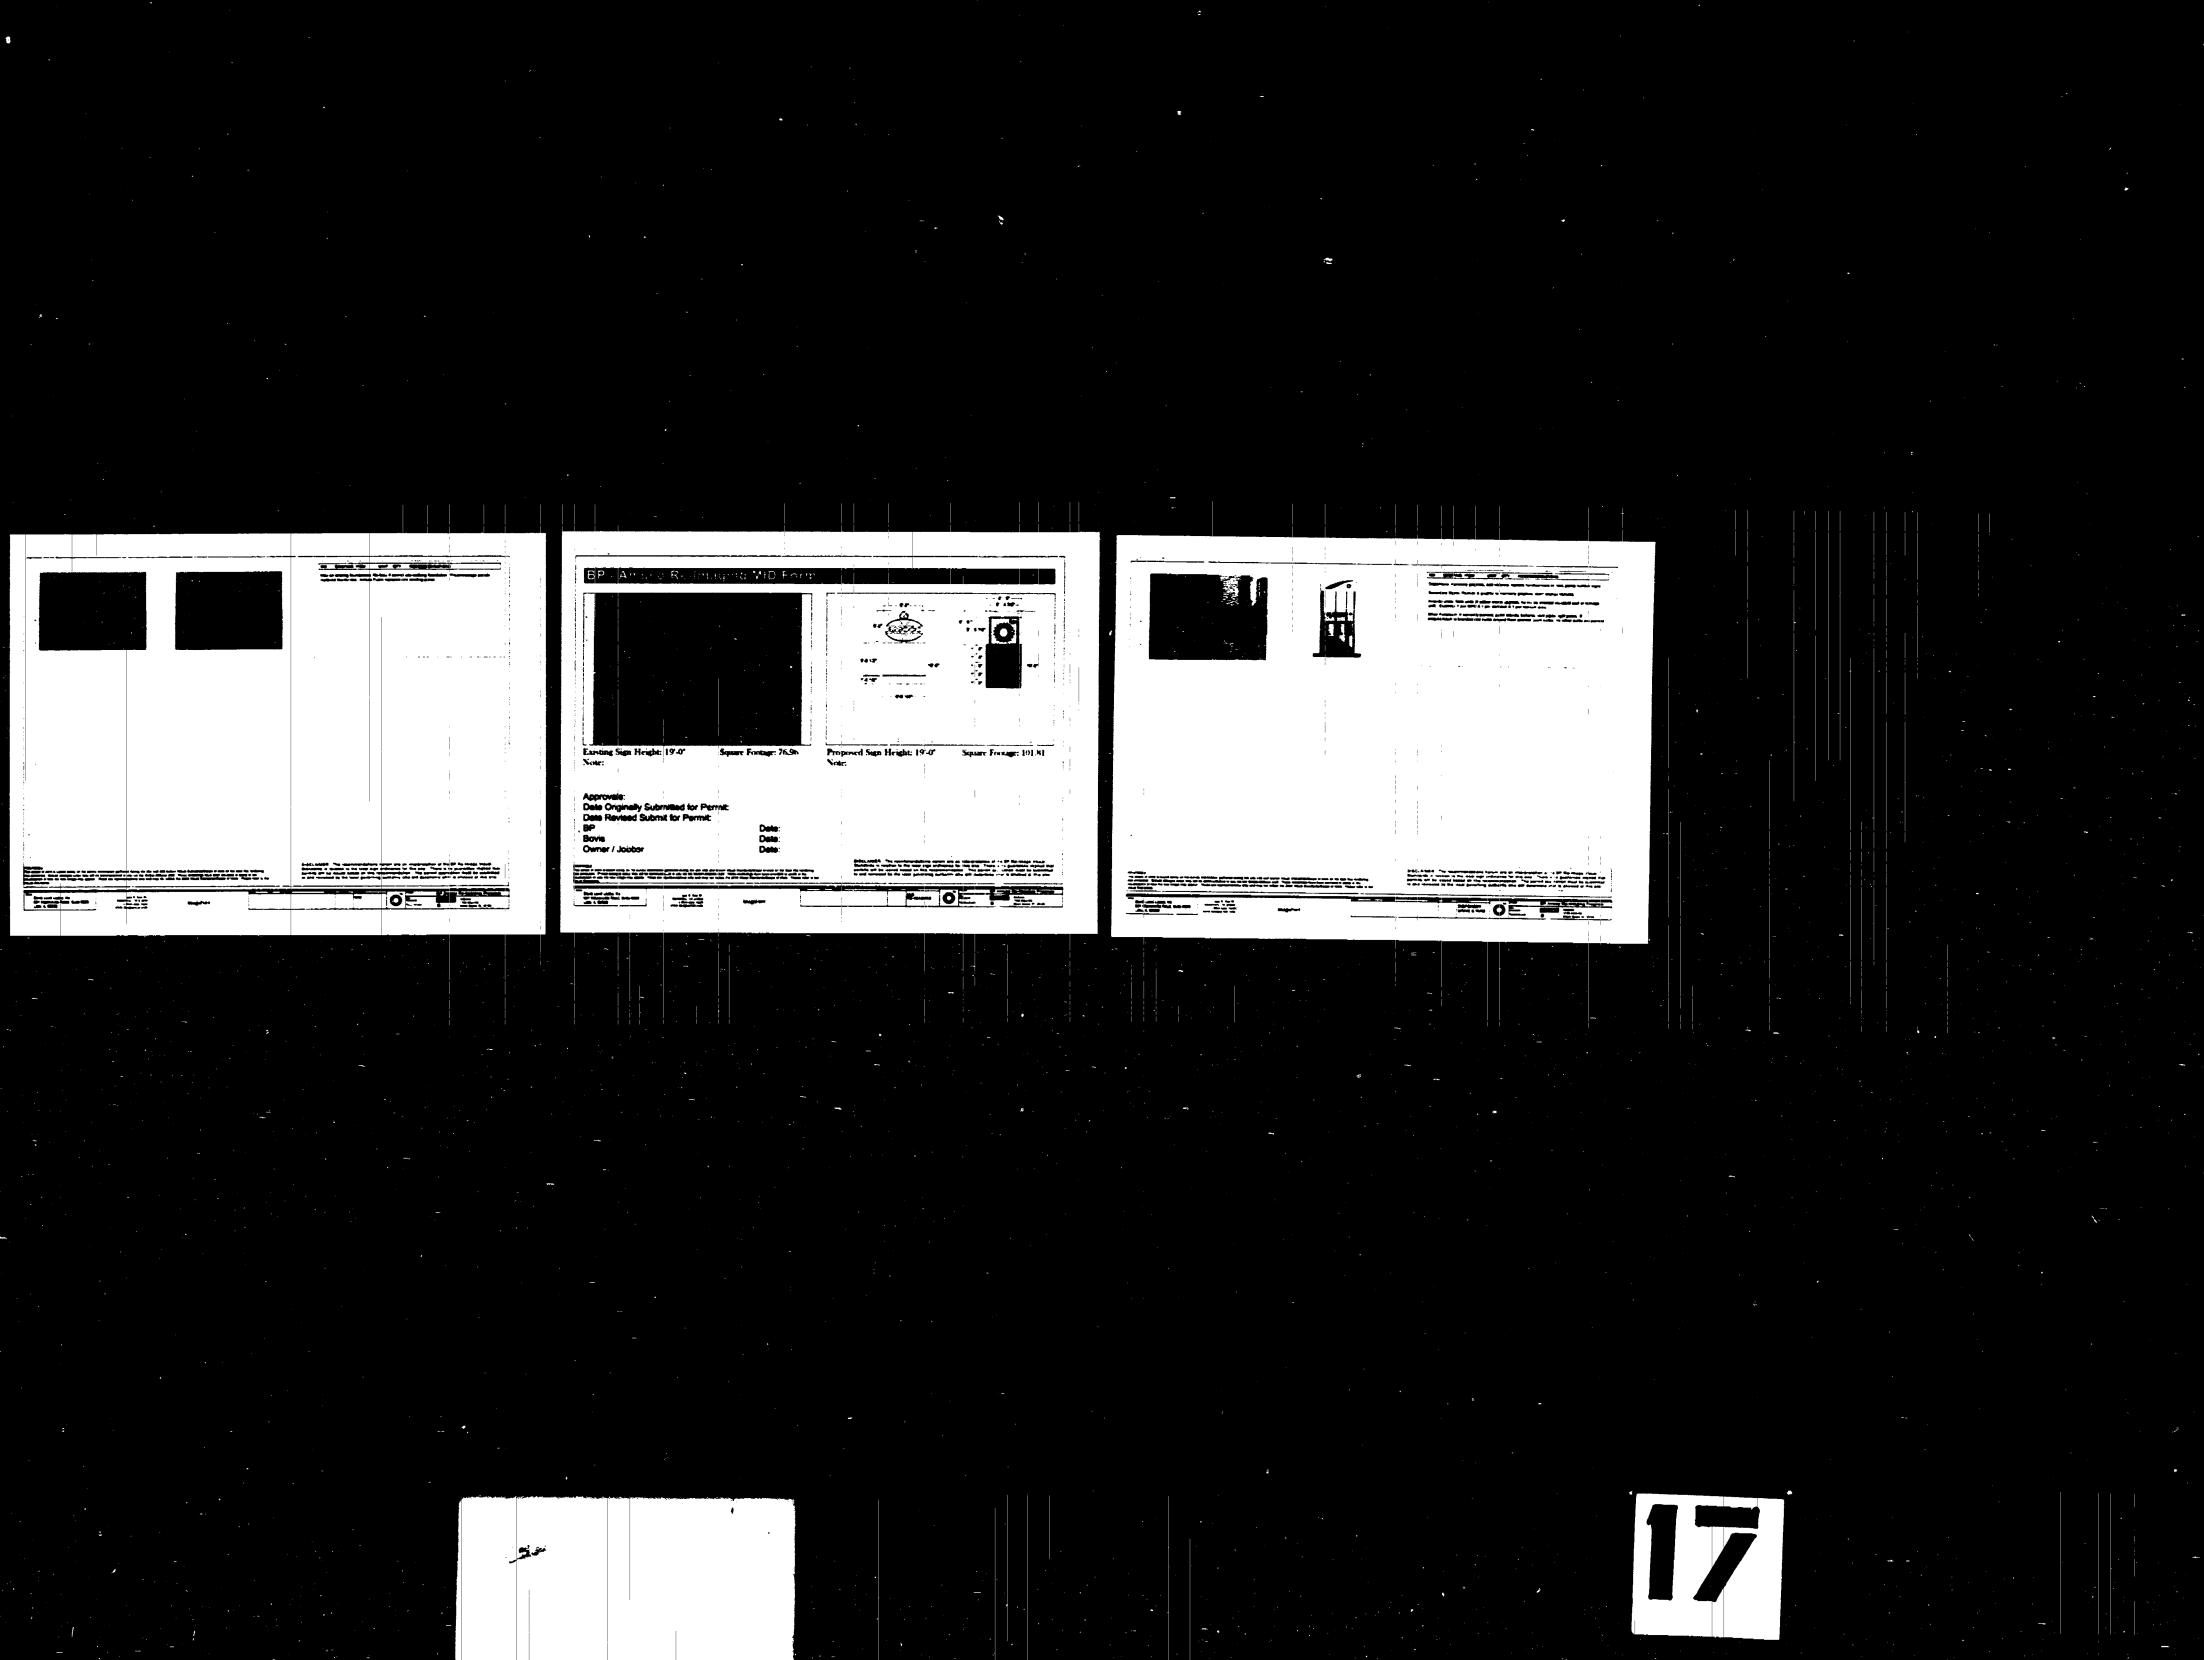



				1		1	
2 - 1 - 1 - 1 - 1 - 1 - 1 - 1 - 1 - 1 -					4444		
and the second second		10 - 10000 - 10000 - 1000 - 1000 - 1000 - 1000 - 1000 - 1000 - 1000 - 10	**	An and the second second second	Come of Street, or		
			-	An table (any in and 1.65	-		
****						and the second s	
		**	· · · ·				
				44			
			-	-		-	
	5			Page 1			
-		1 20 V 2 2000 Que-		Anne Mainer Challenger & Rad. State Warmanner & Samp With Challe			
		-					
	-	Ber Viele Seres		Ann Ann Cashy bro brill Of Ca		State Car St Sardy	
	-	100.0					
	•		1				
	Realized in contract						
-	-	Die Hilber fangenet					
					440		
	-			Prat harpen (***			
· · . ·				- Citize	-		
				Aller Jahr Anna Andra Jahren F Das Anna Language ( 1915			
	4	States				- Contraction of the second se	
				<b>`</b>	-	~ ~ ~ ~ ~ ~ ~ ~ ~ ~ ~ ~ ~ ~ ~ ~ ~ ~ ~ ~	
	-						
	National Constraints	•			-		
				reg. alla. als are surrently barry surranged		المرجع ومحمد والمرجع والم	
					س میشوانین بانین اوم	r probled, apriliter or 7 Mary State Classe Parriage, Inc. State Darrange Inc. Half Barrange Inc. - 1917 (175-001)	
						skil žerenije ka danagoja, in diliti	


Contraction of the local division of the loc OE


مع المرز

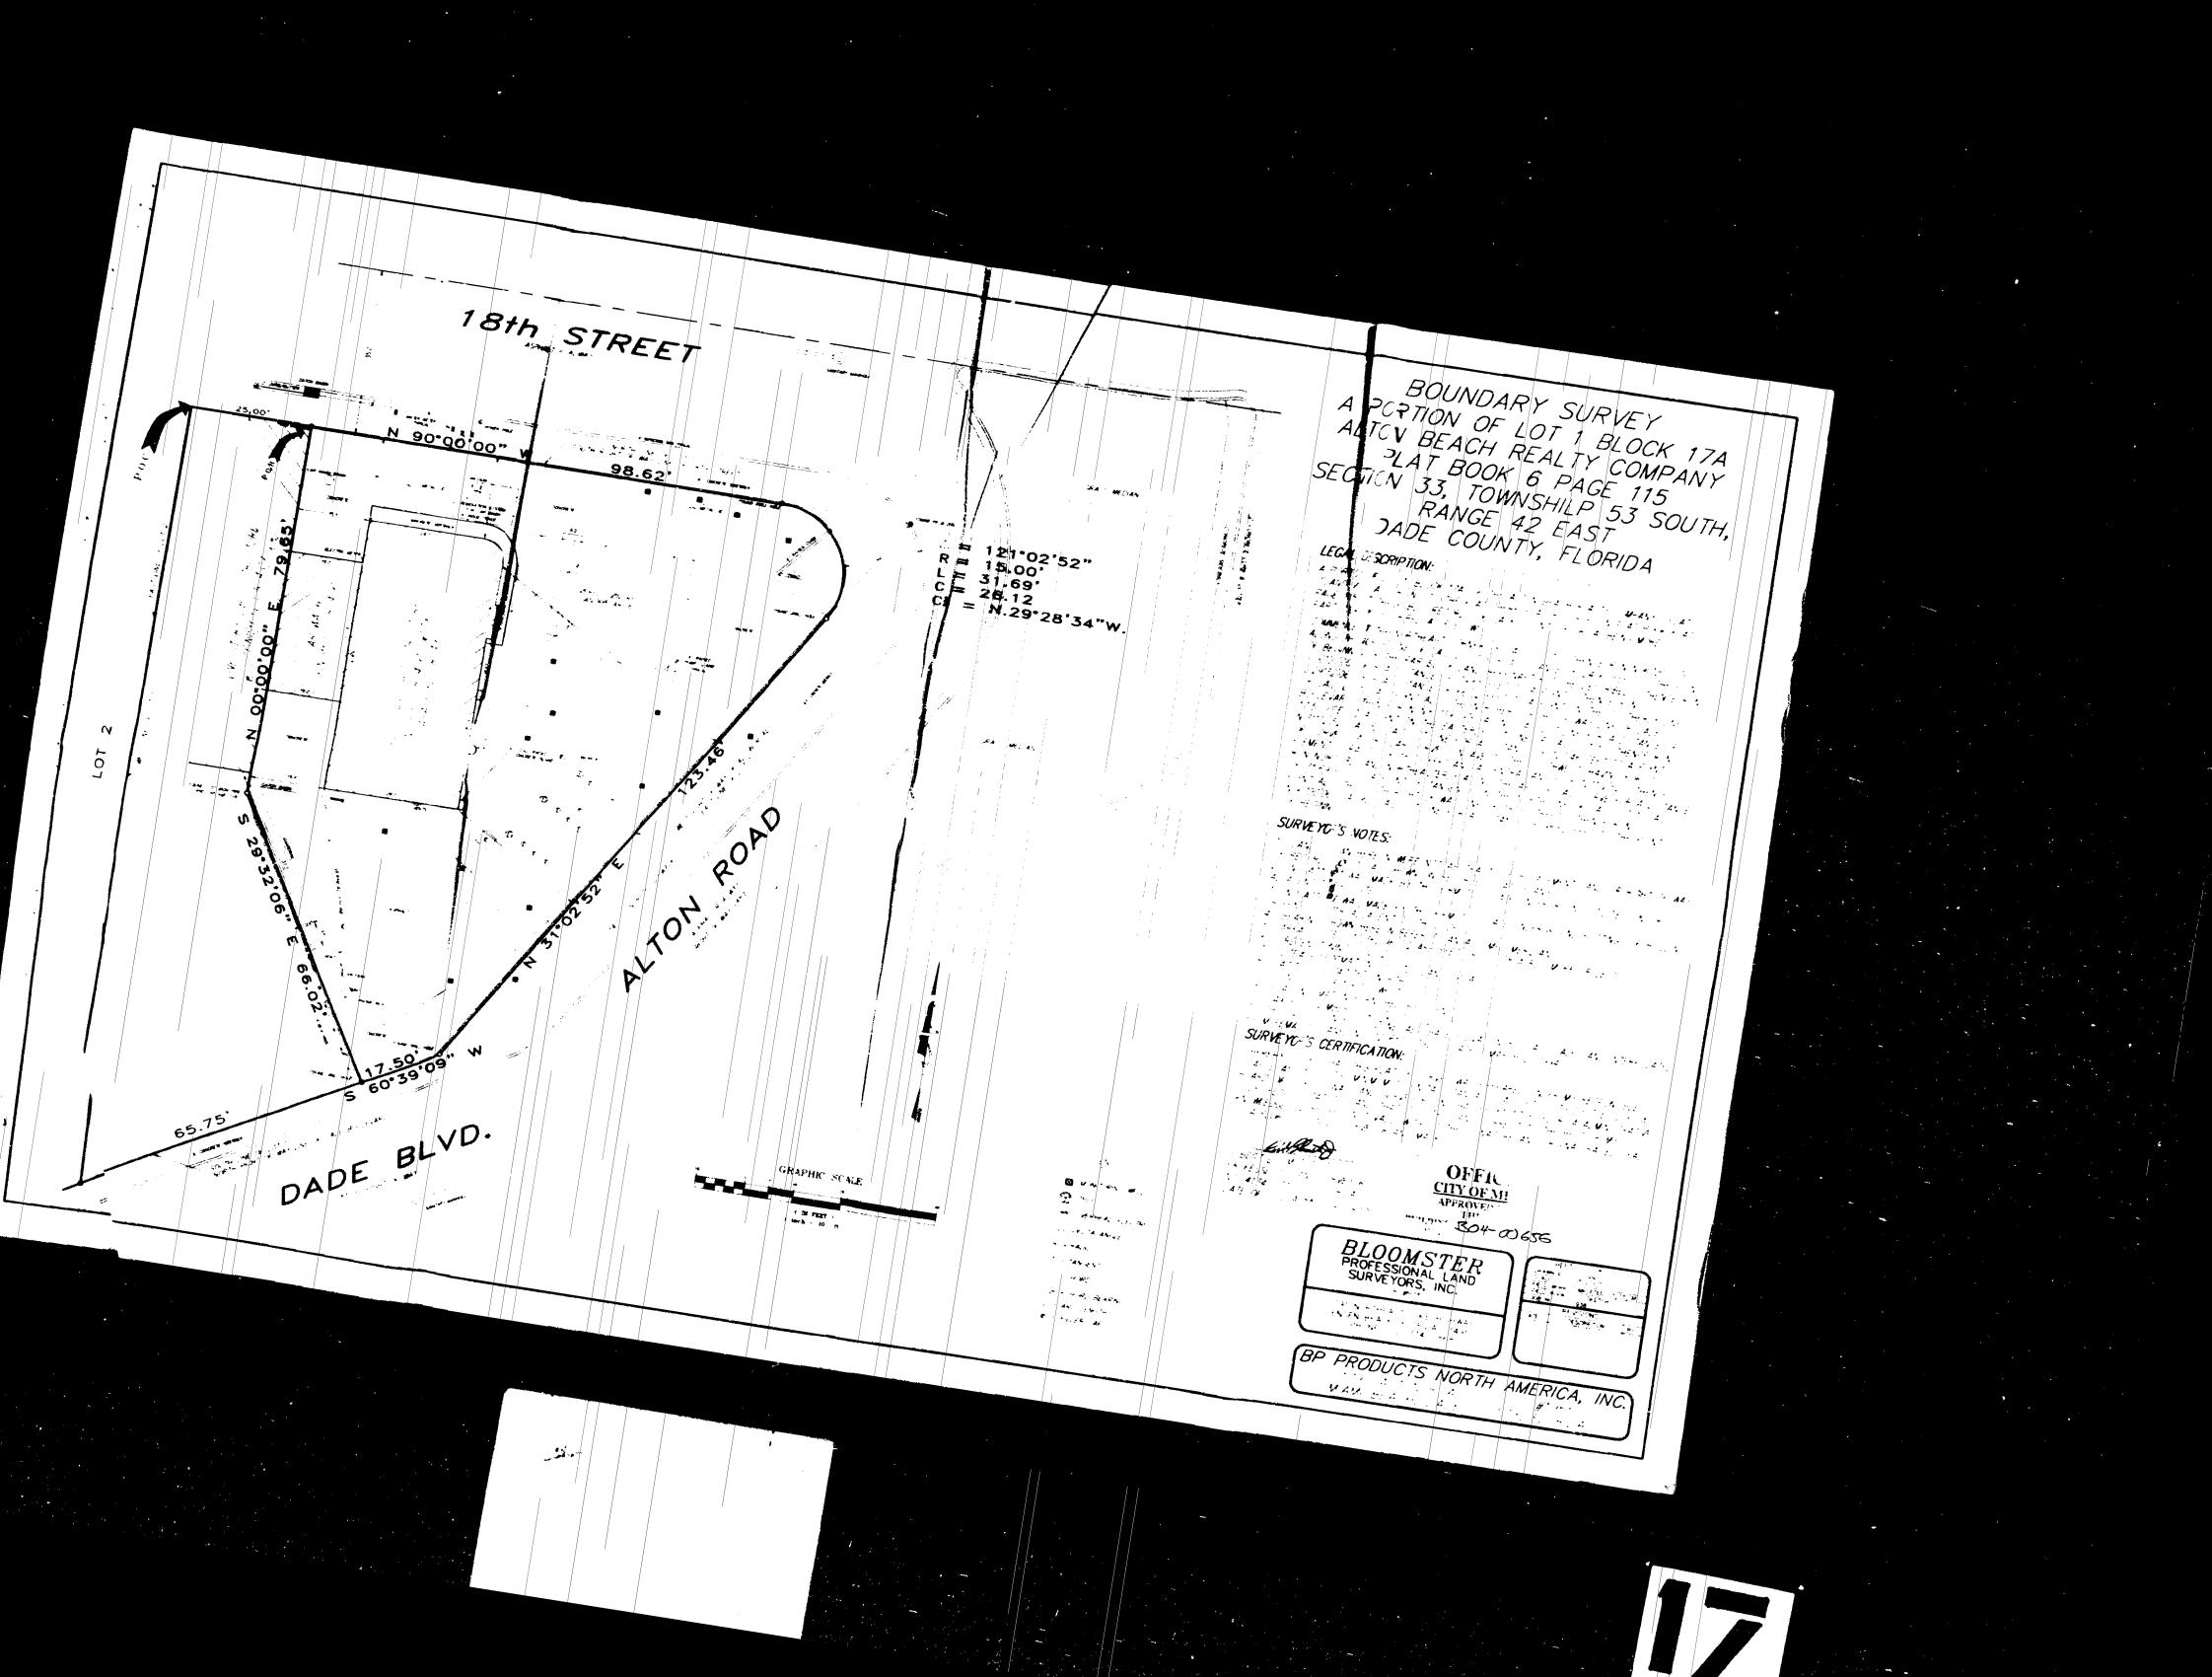


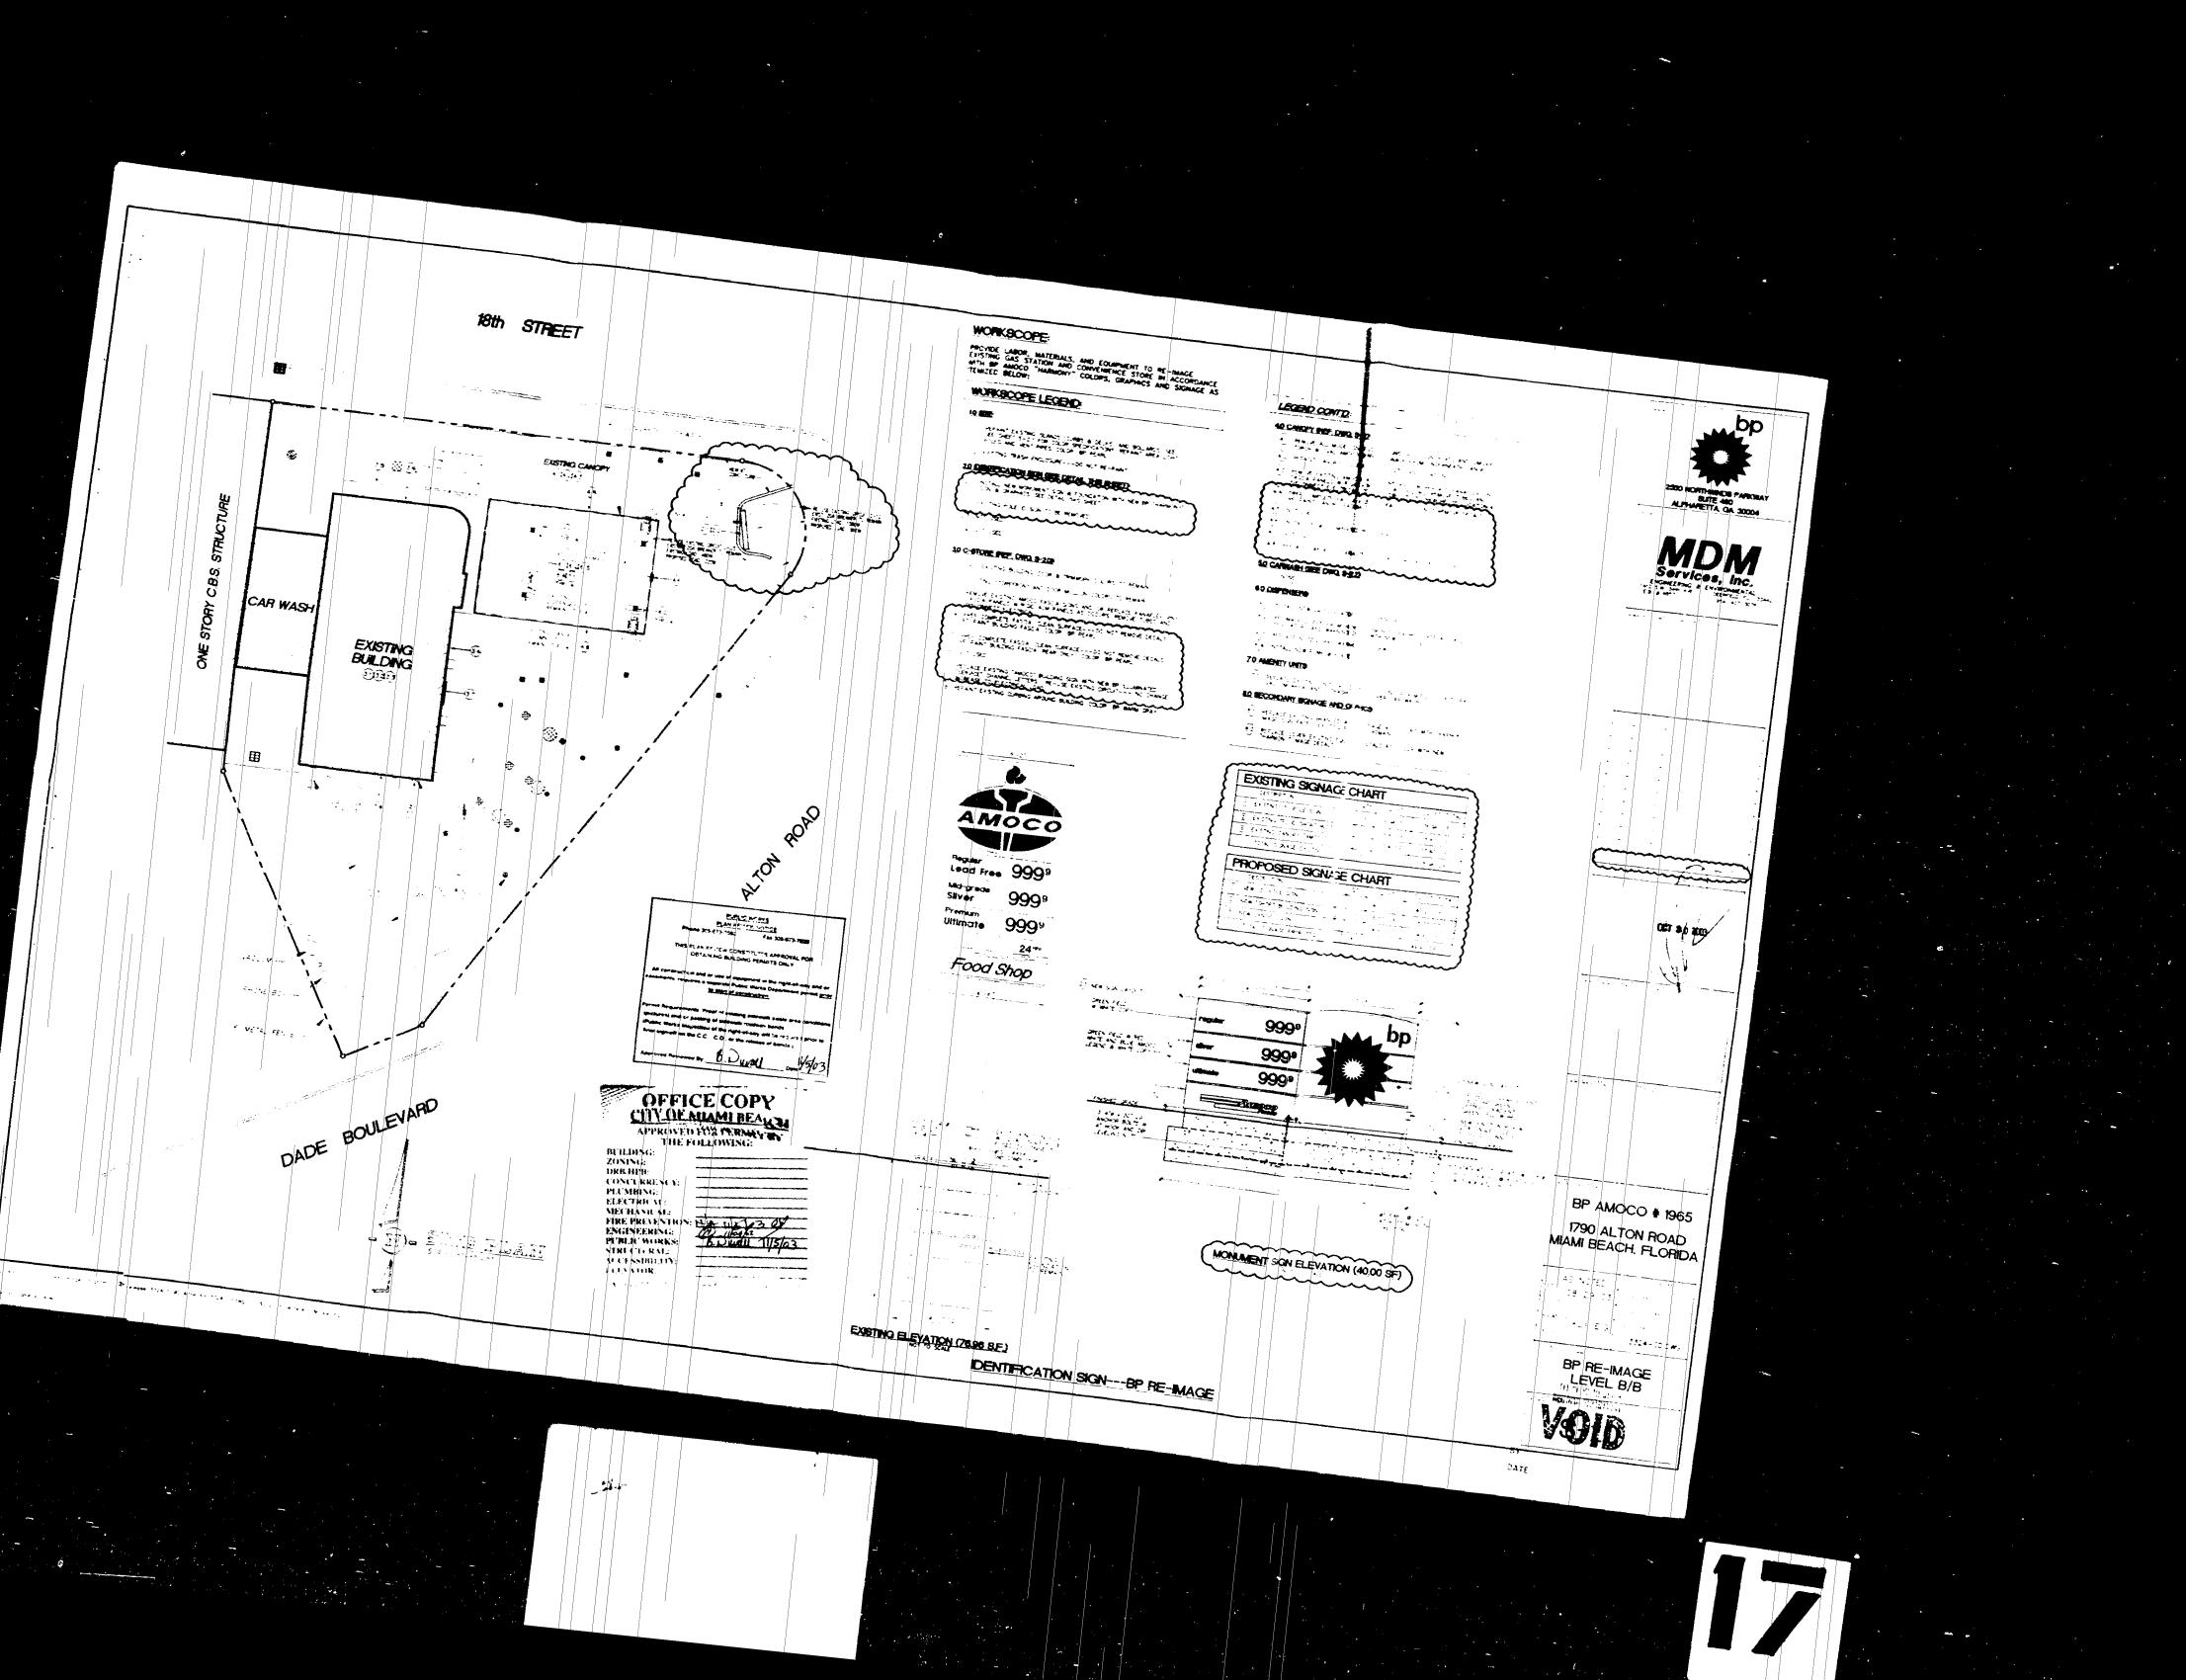


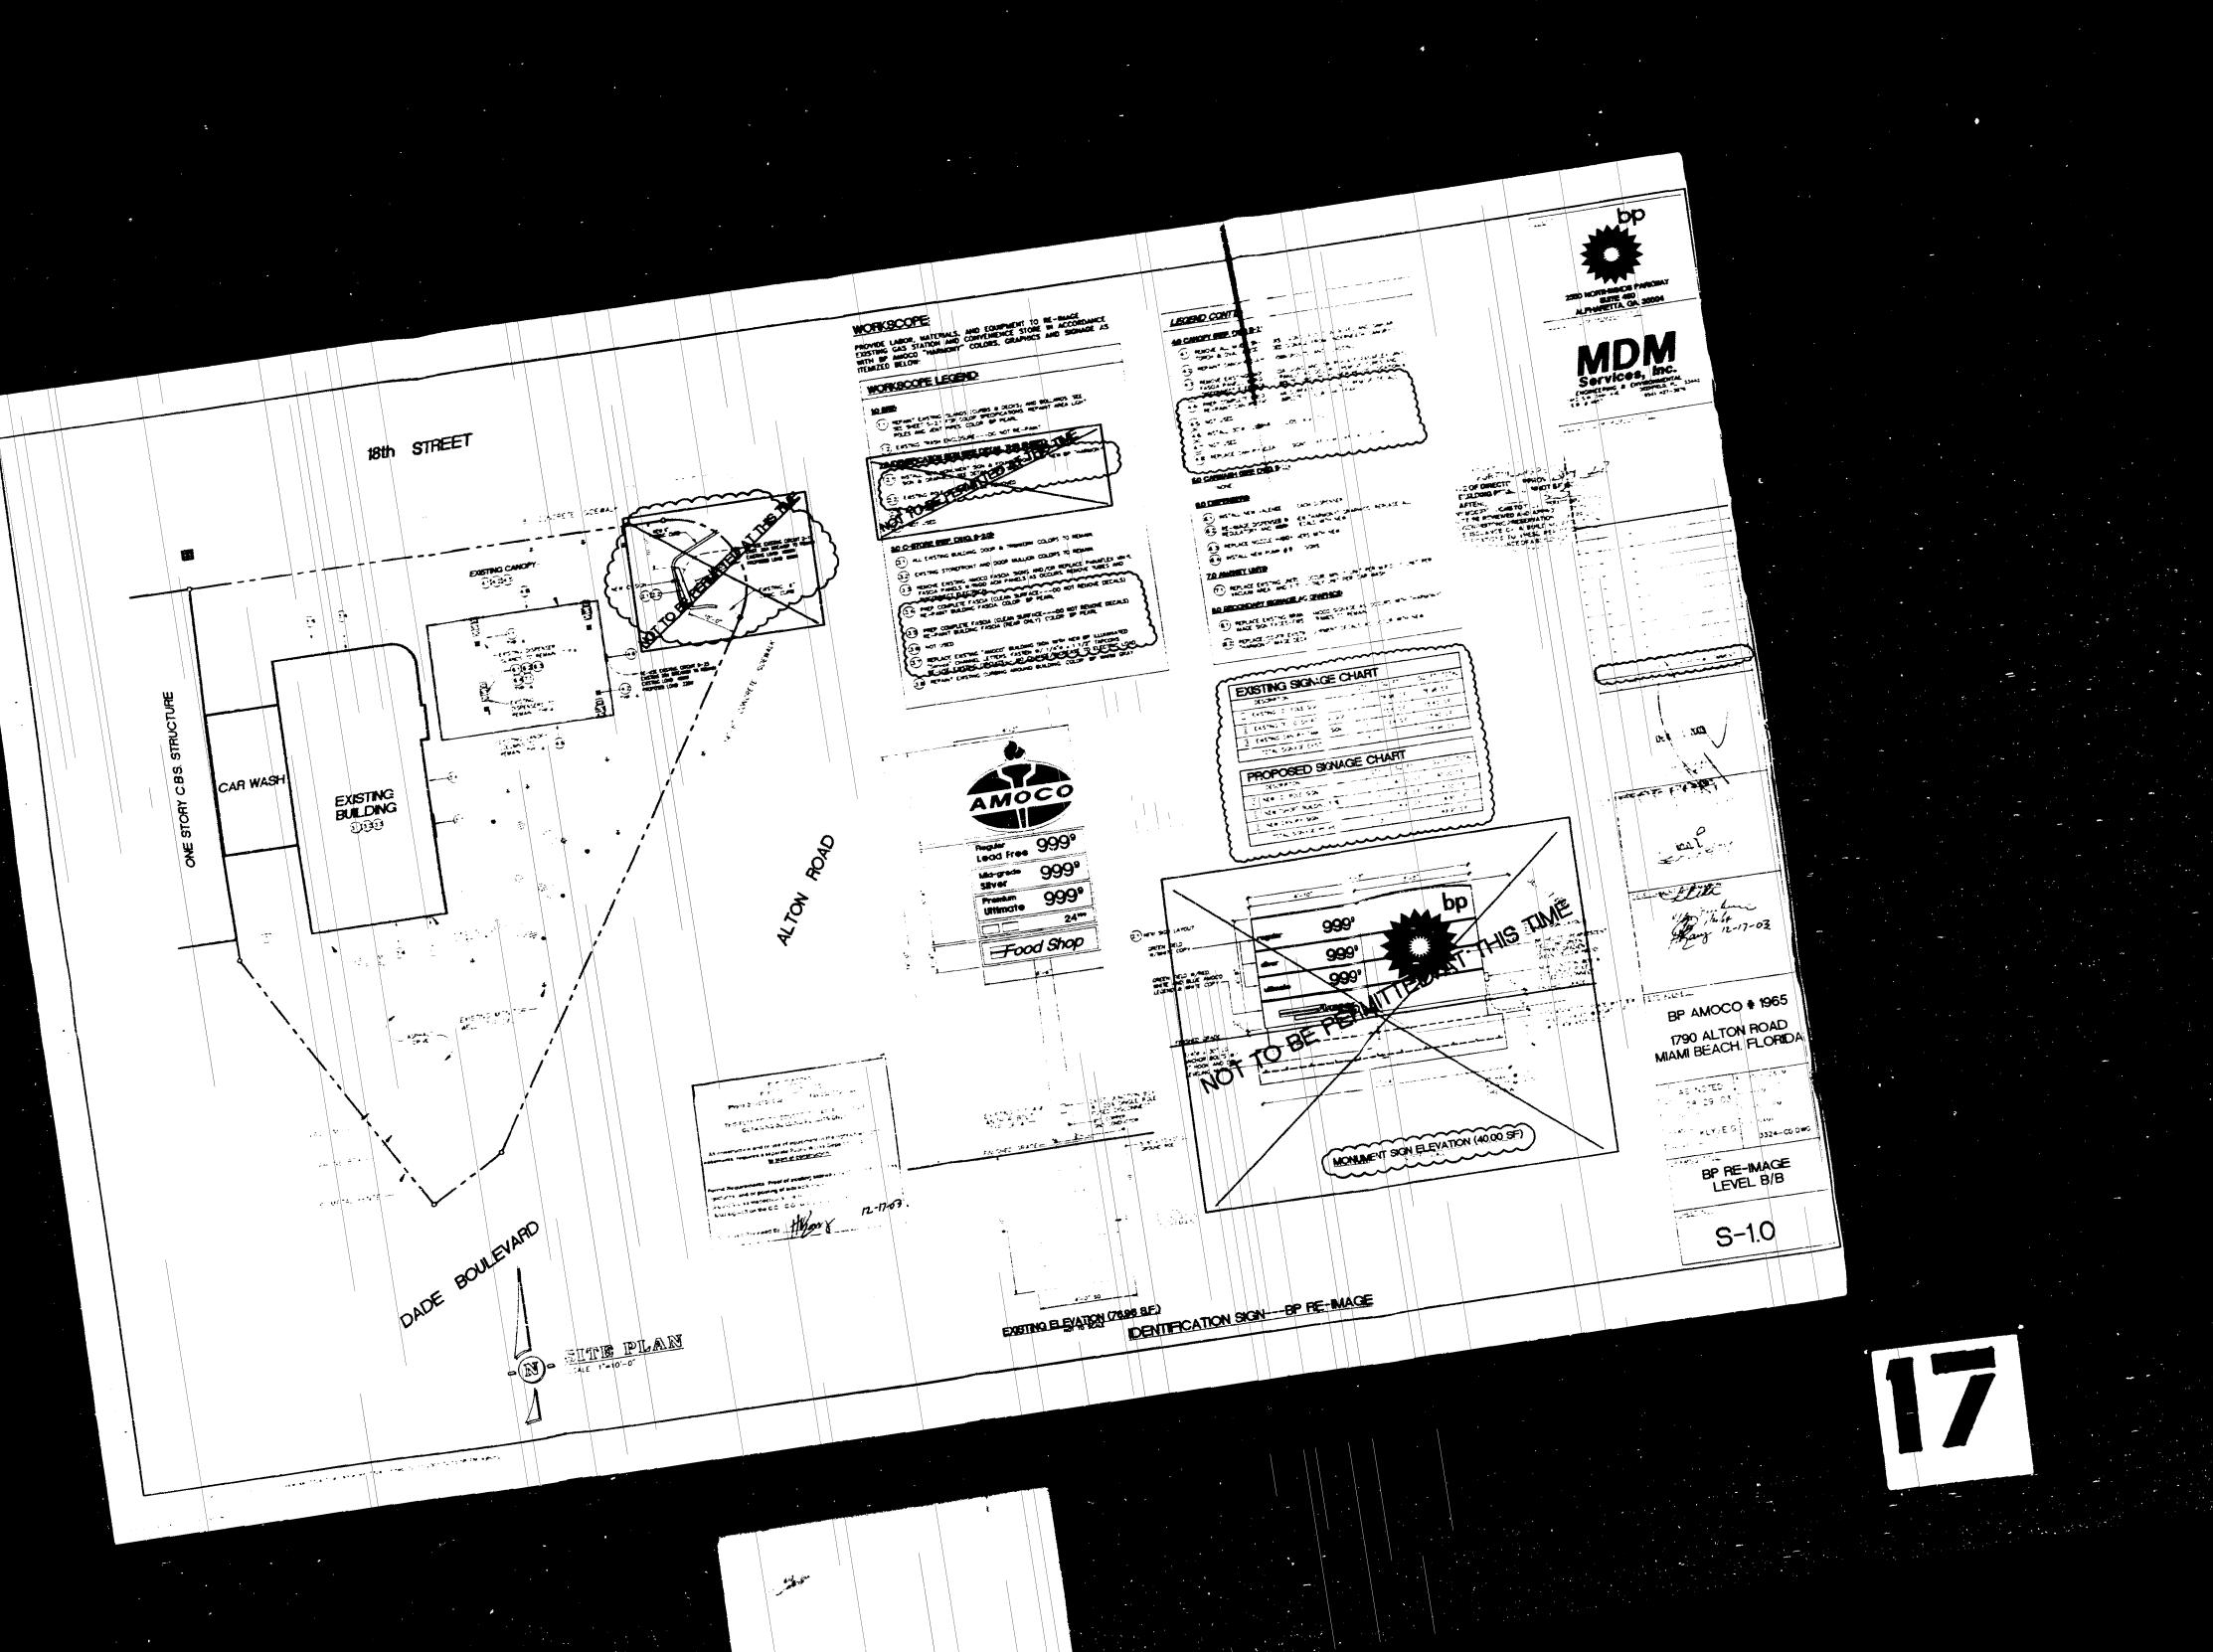

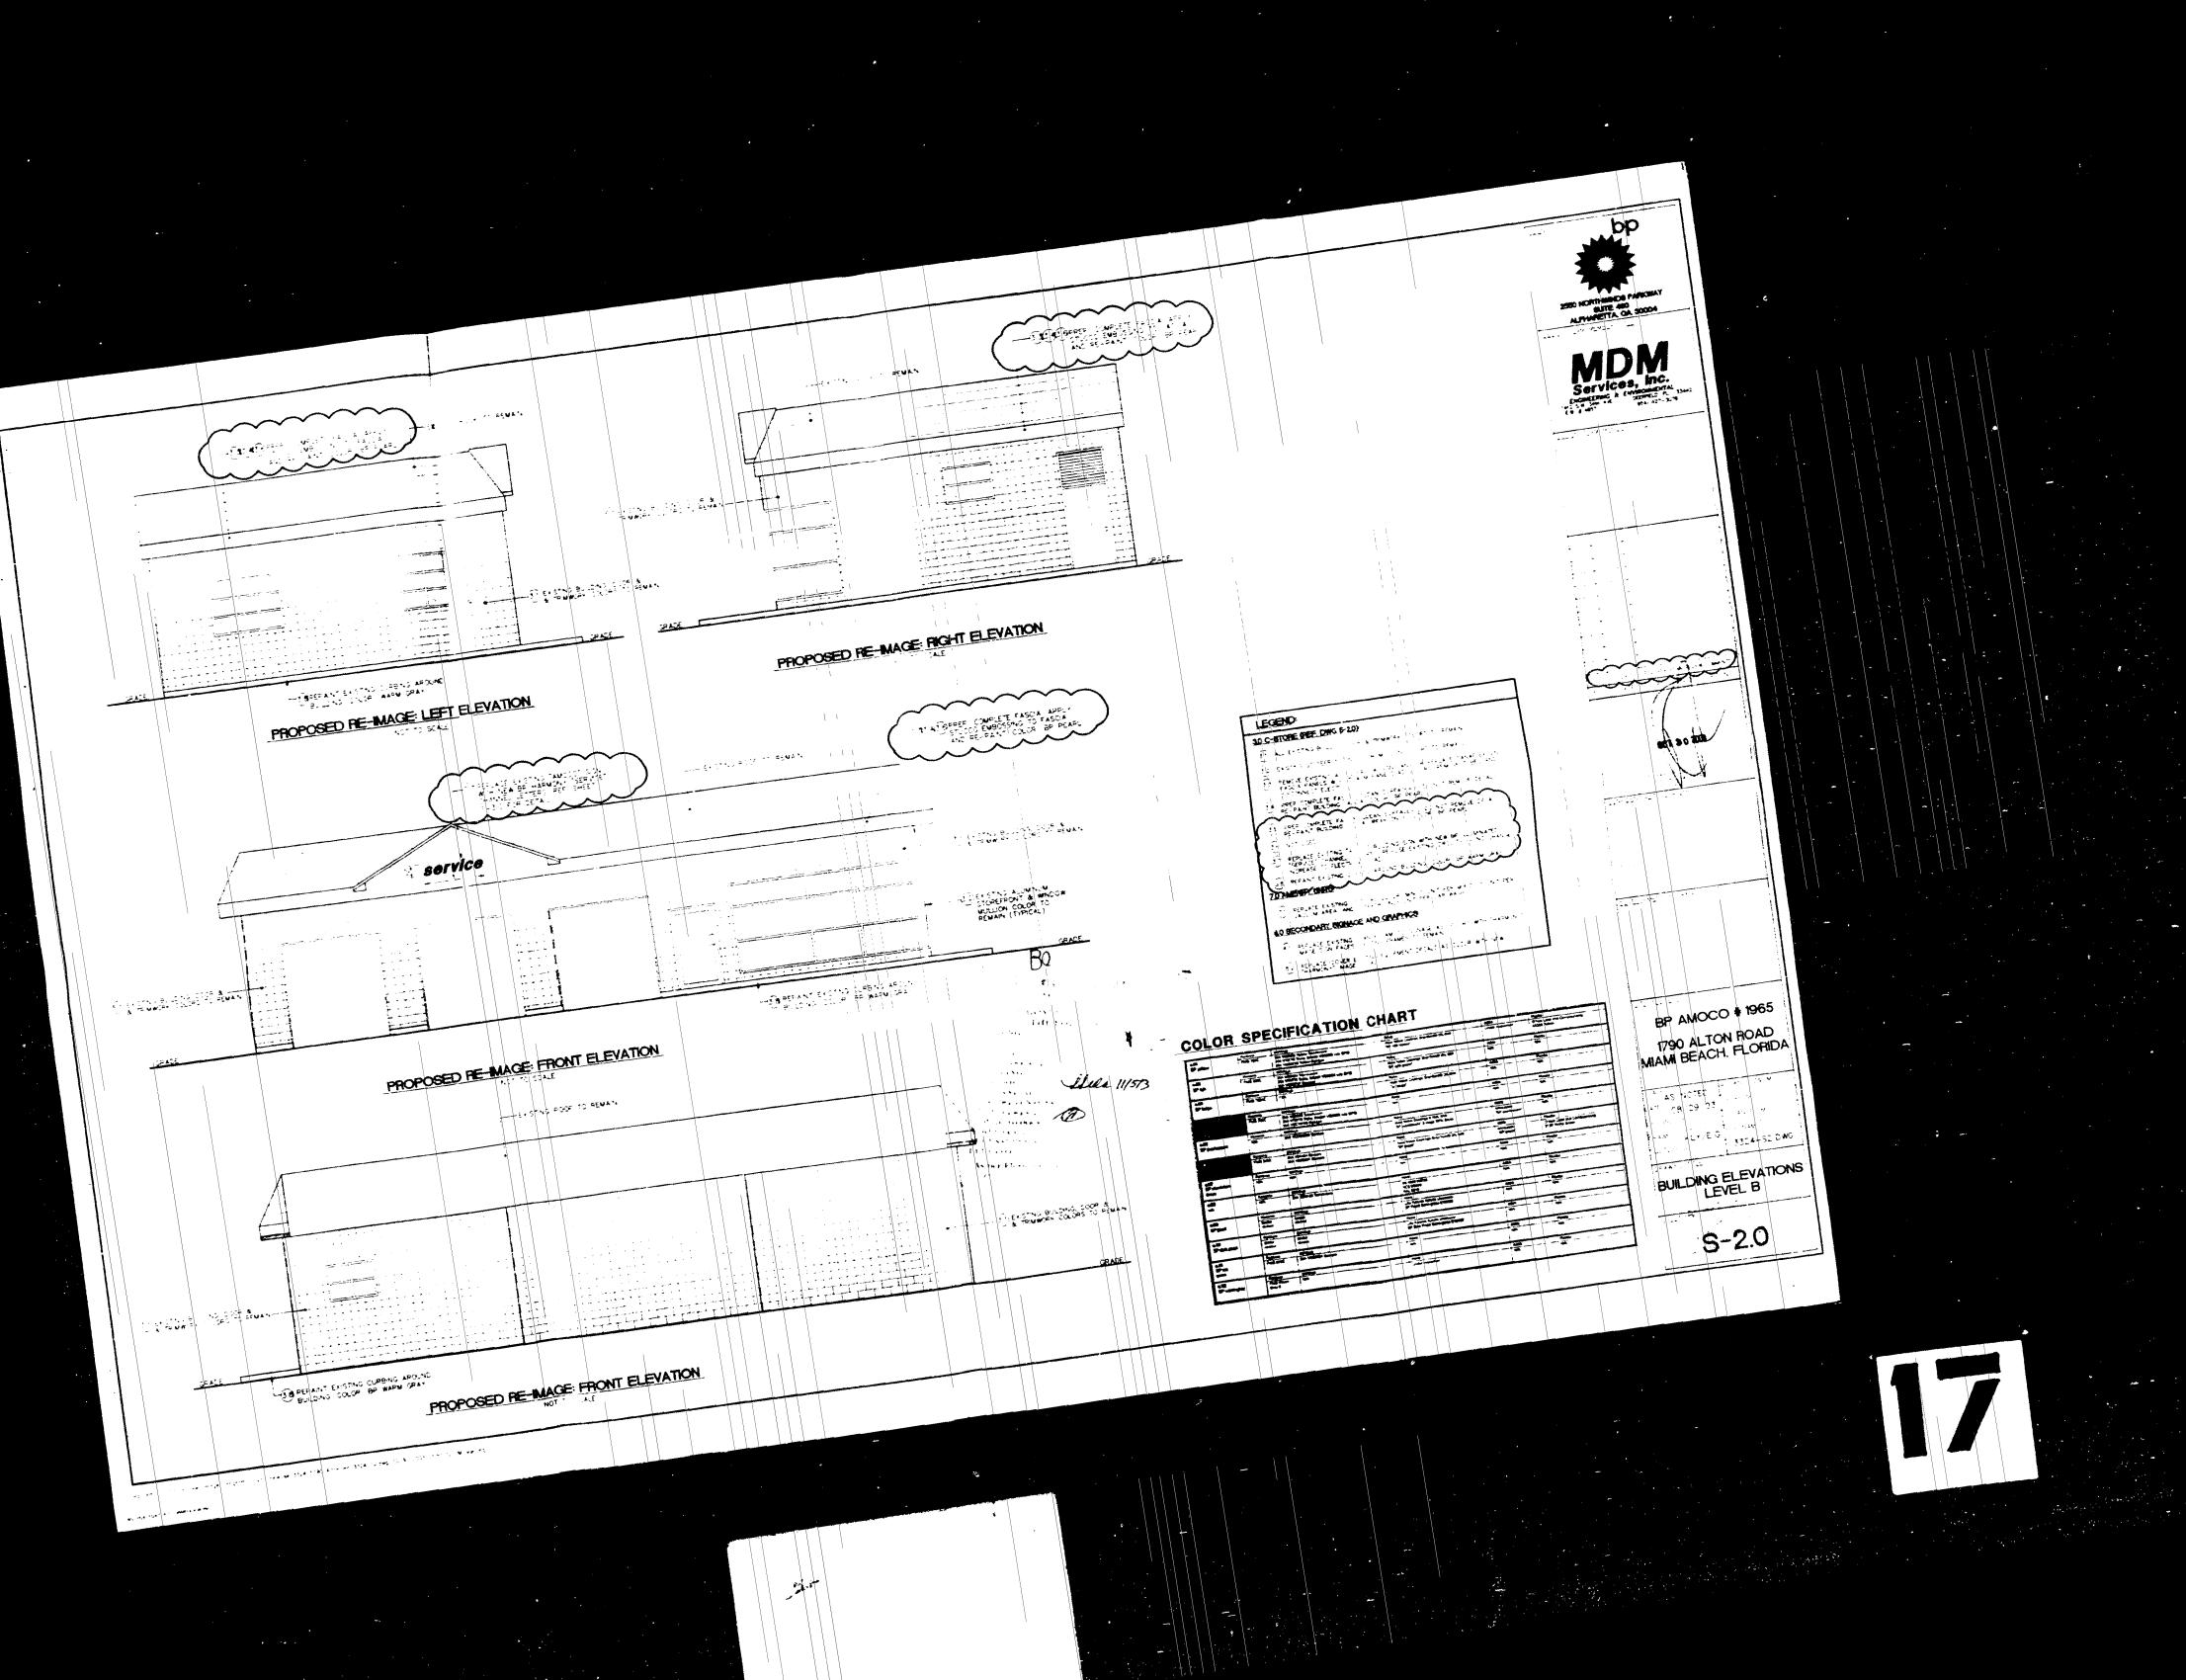


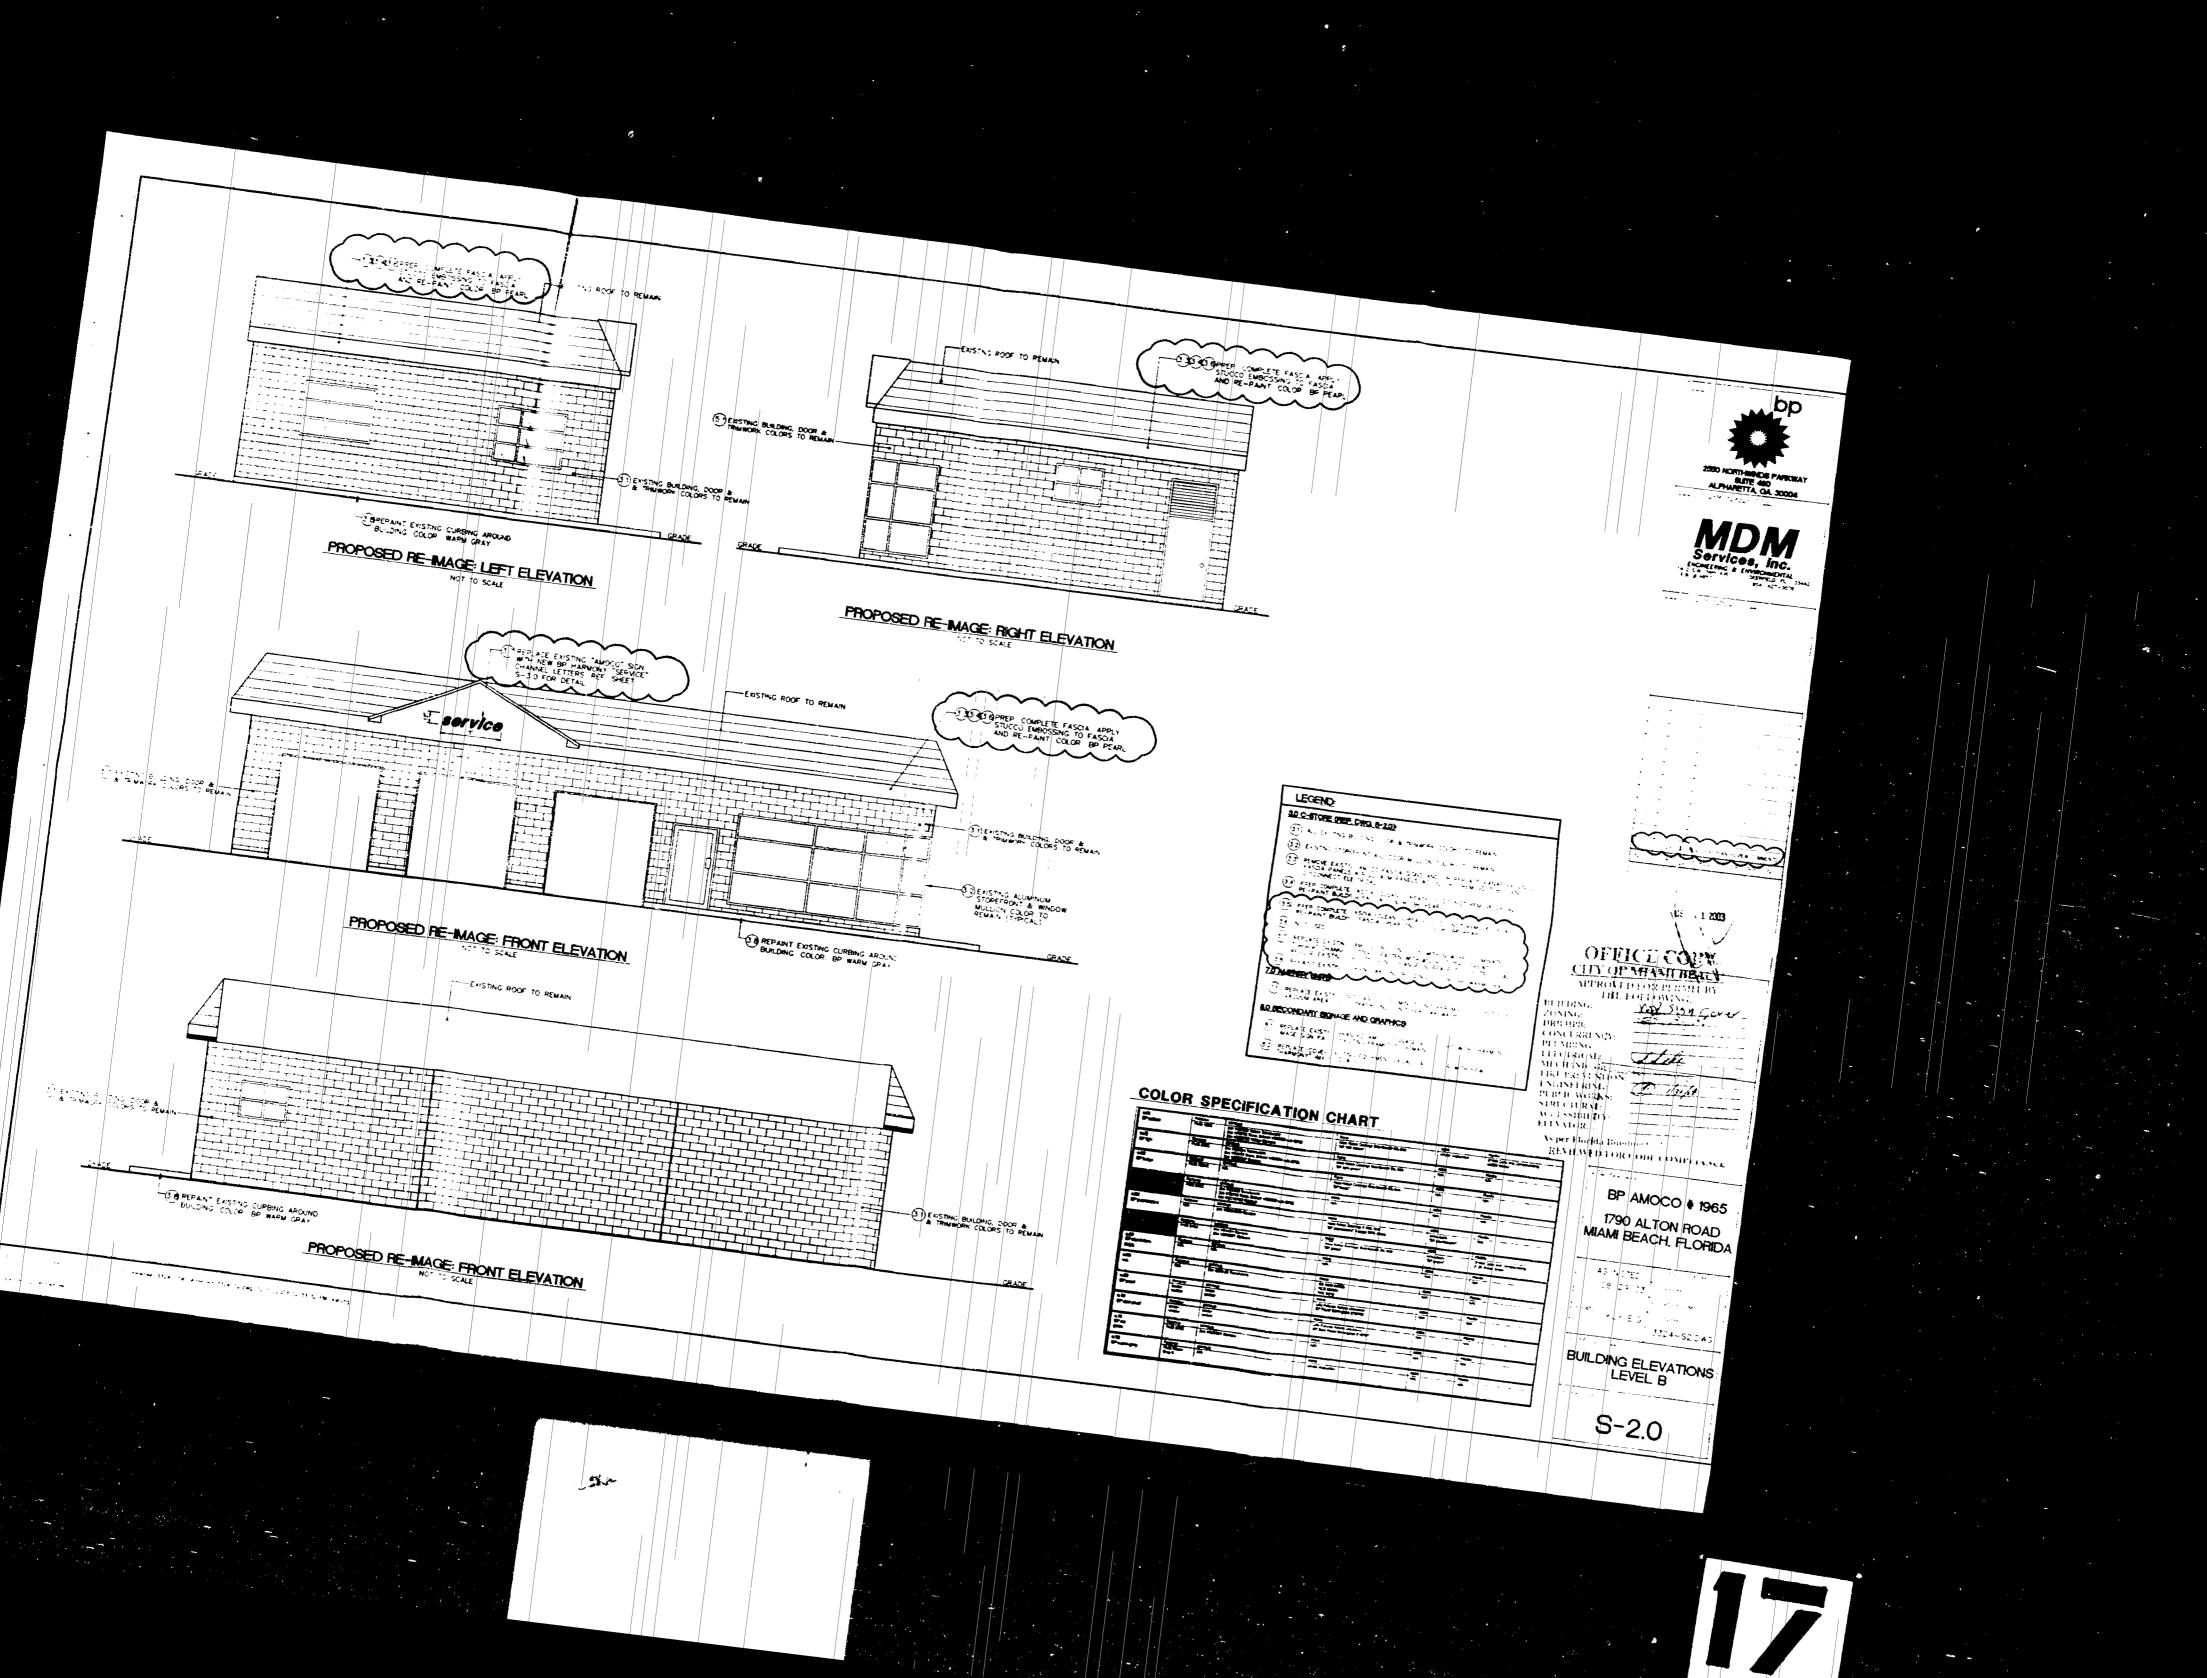

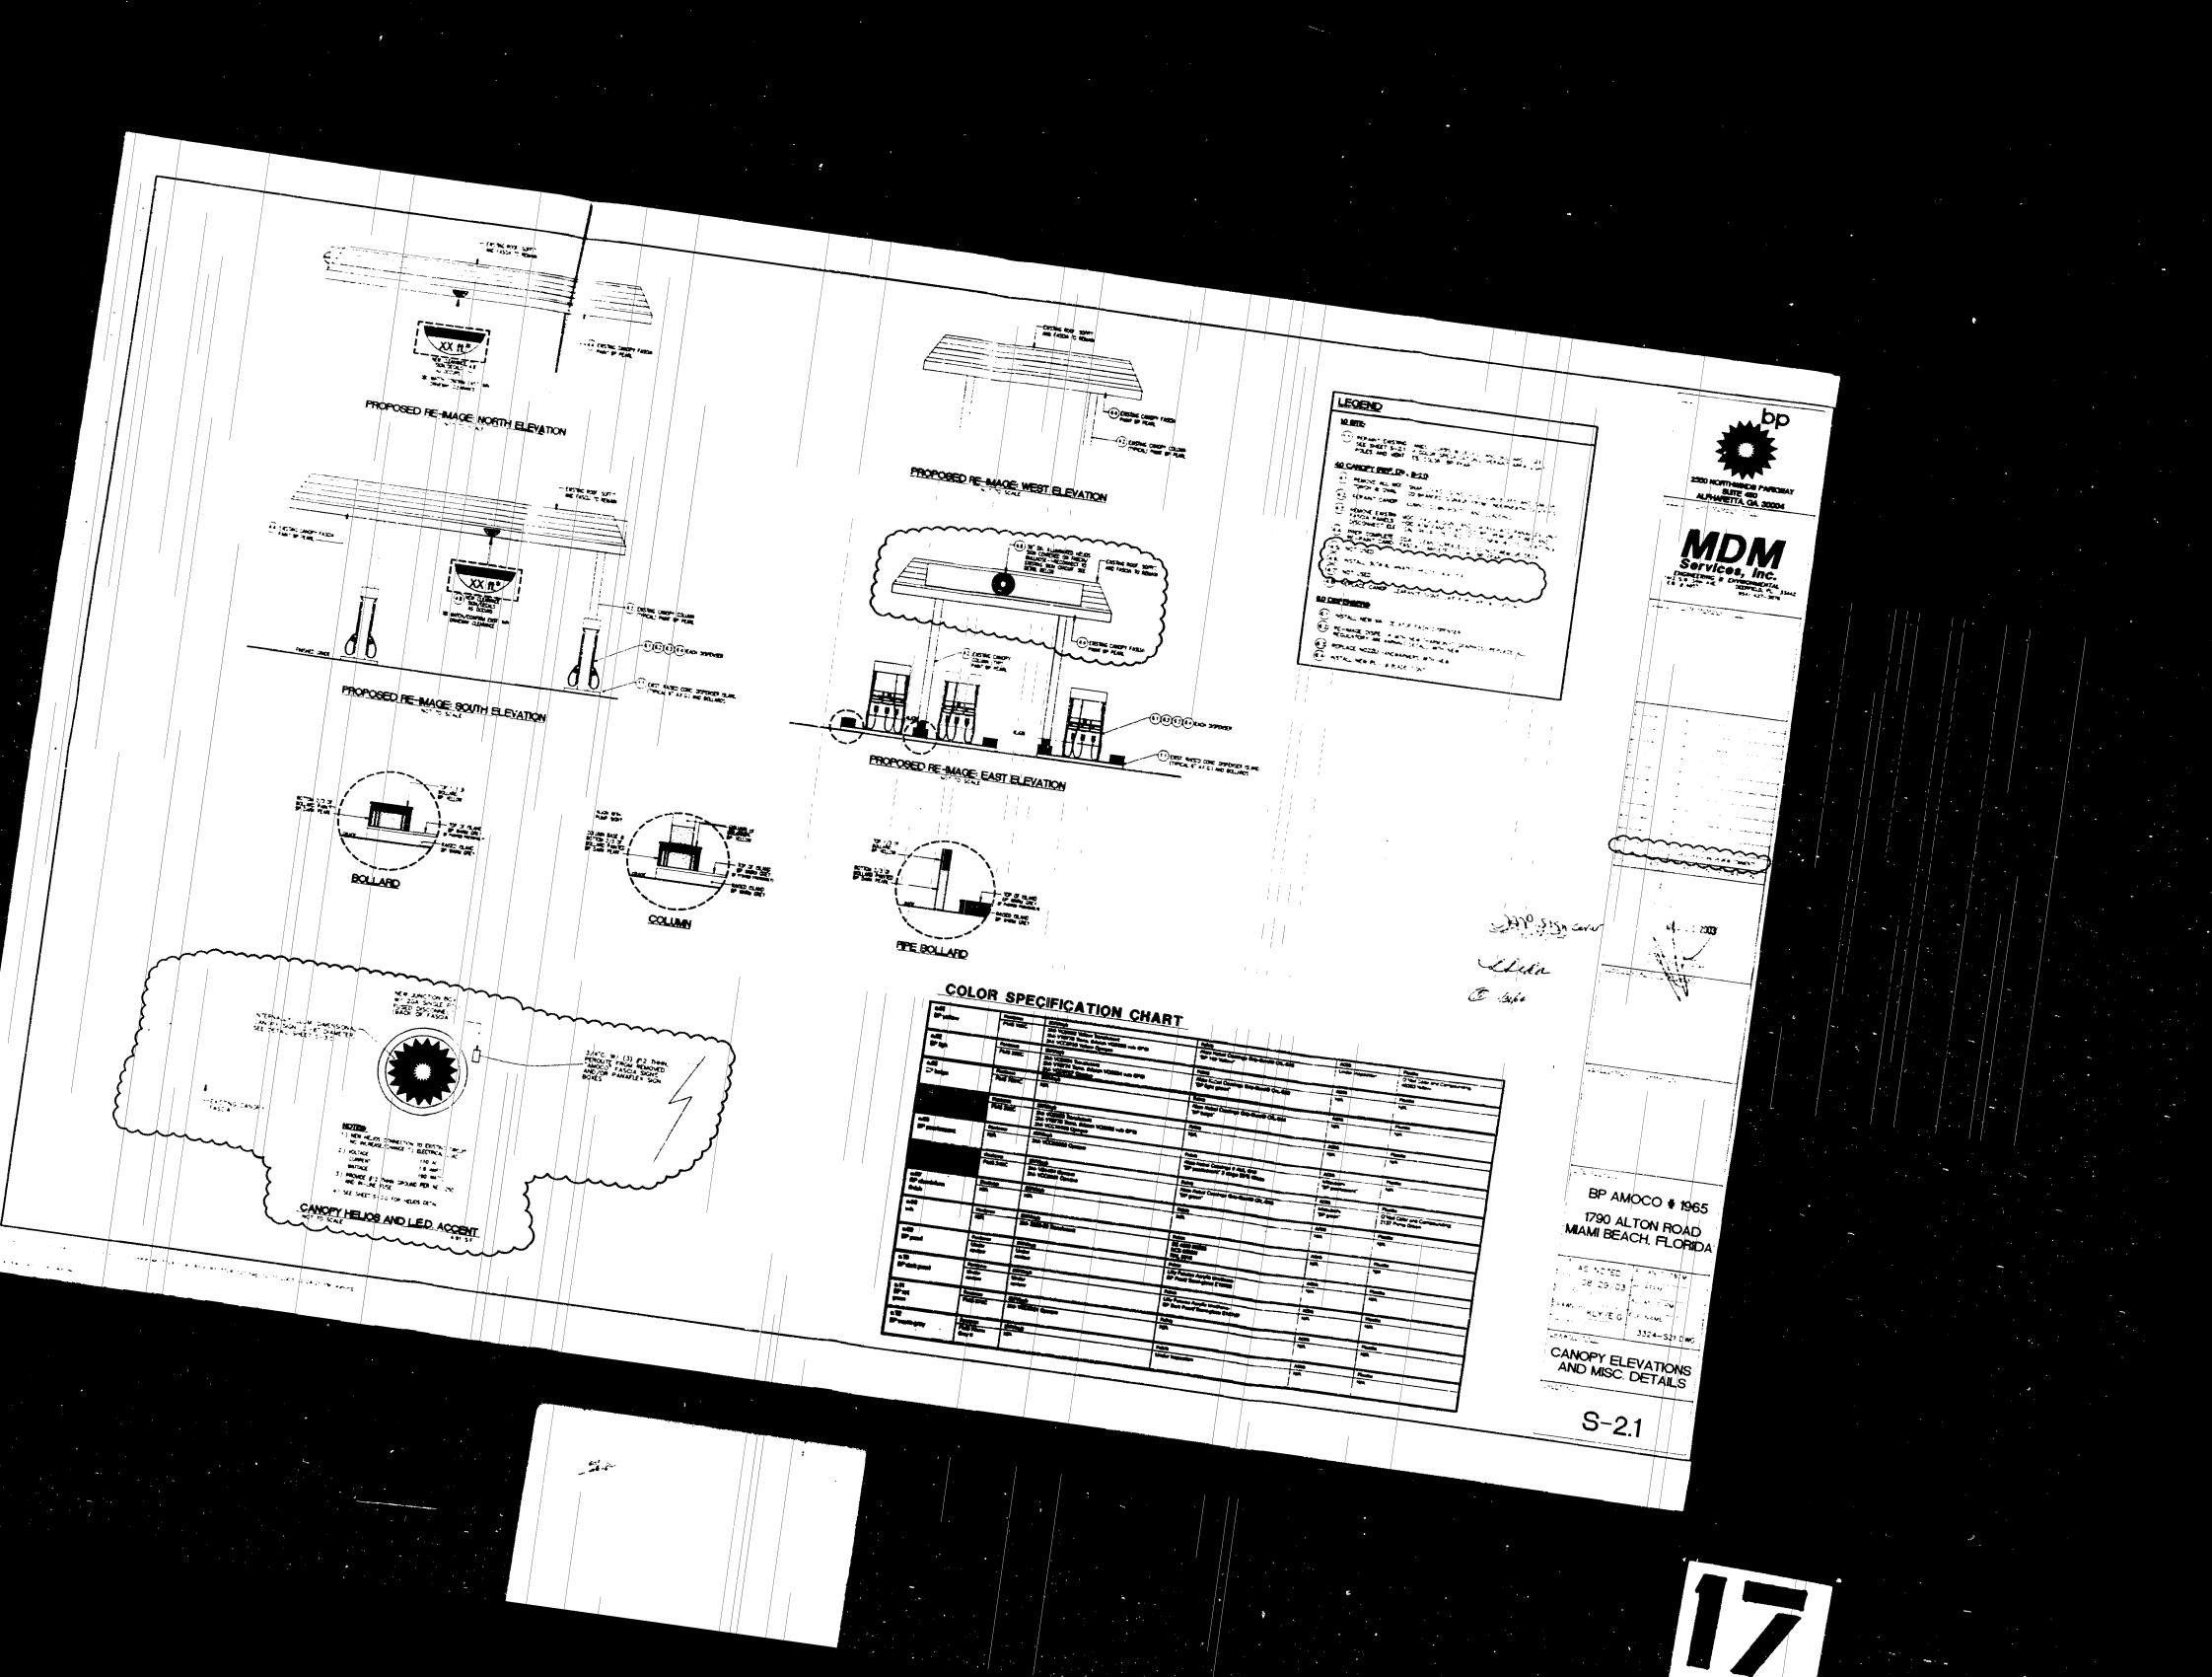

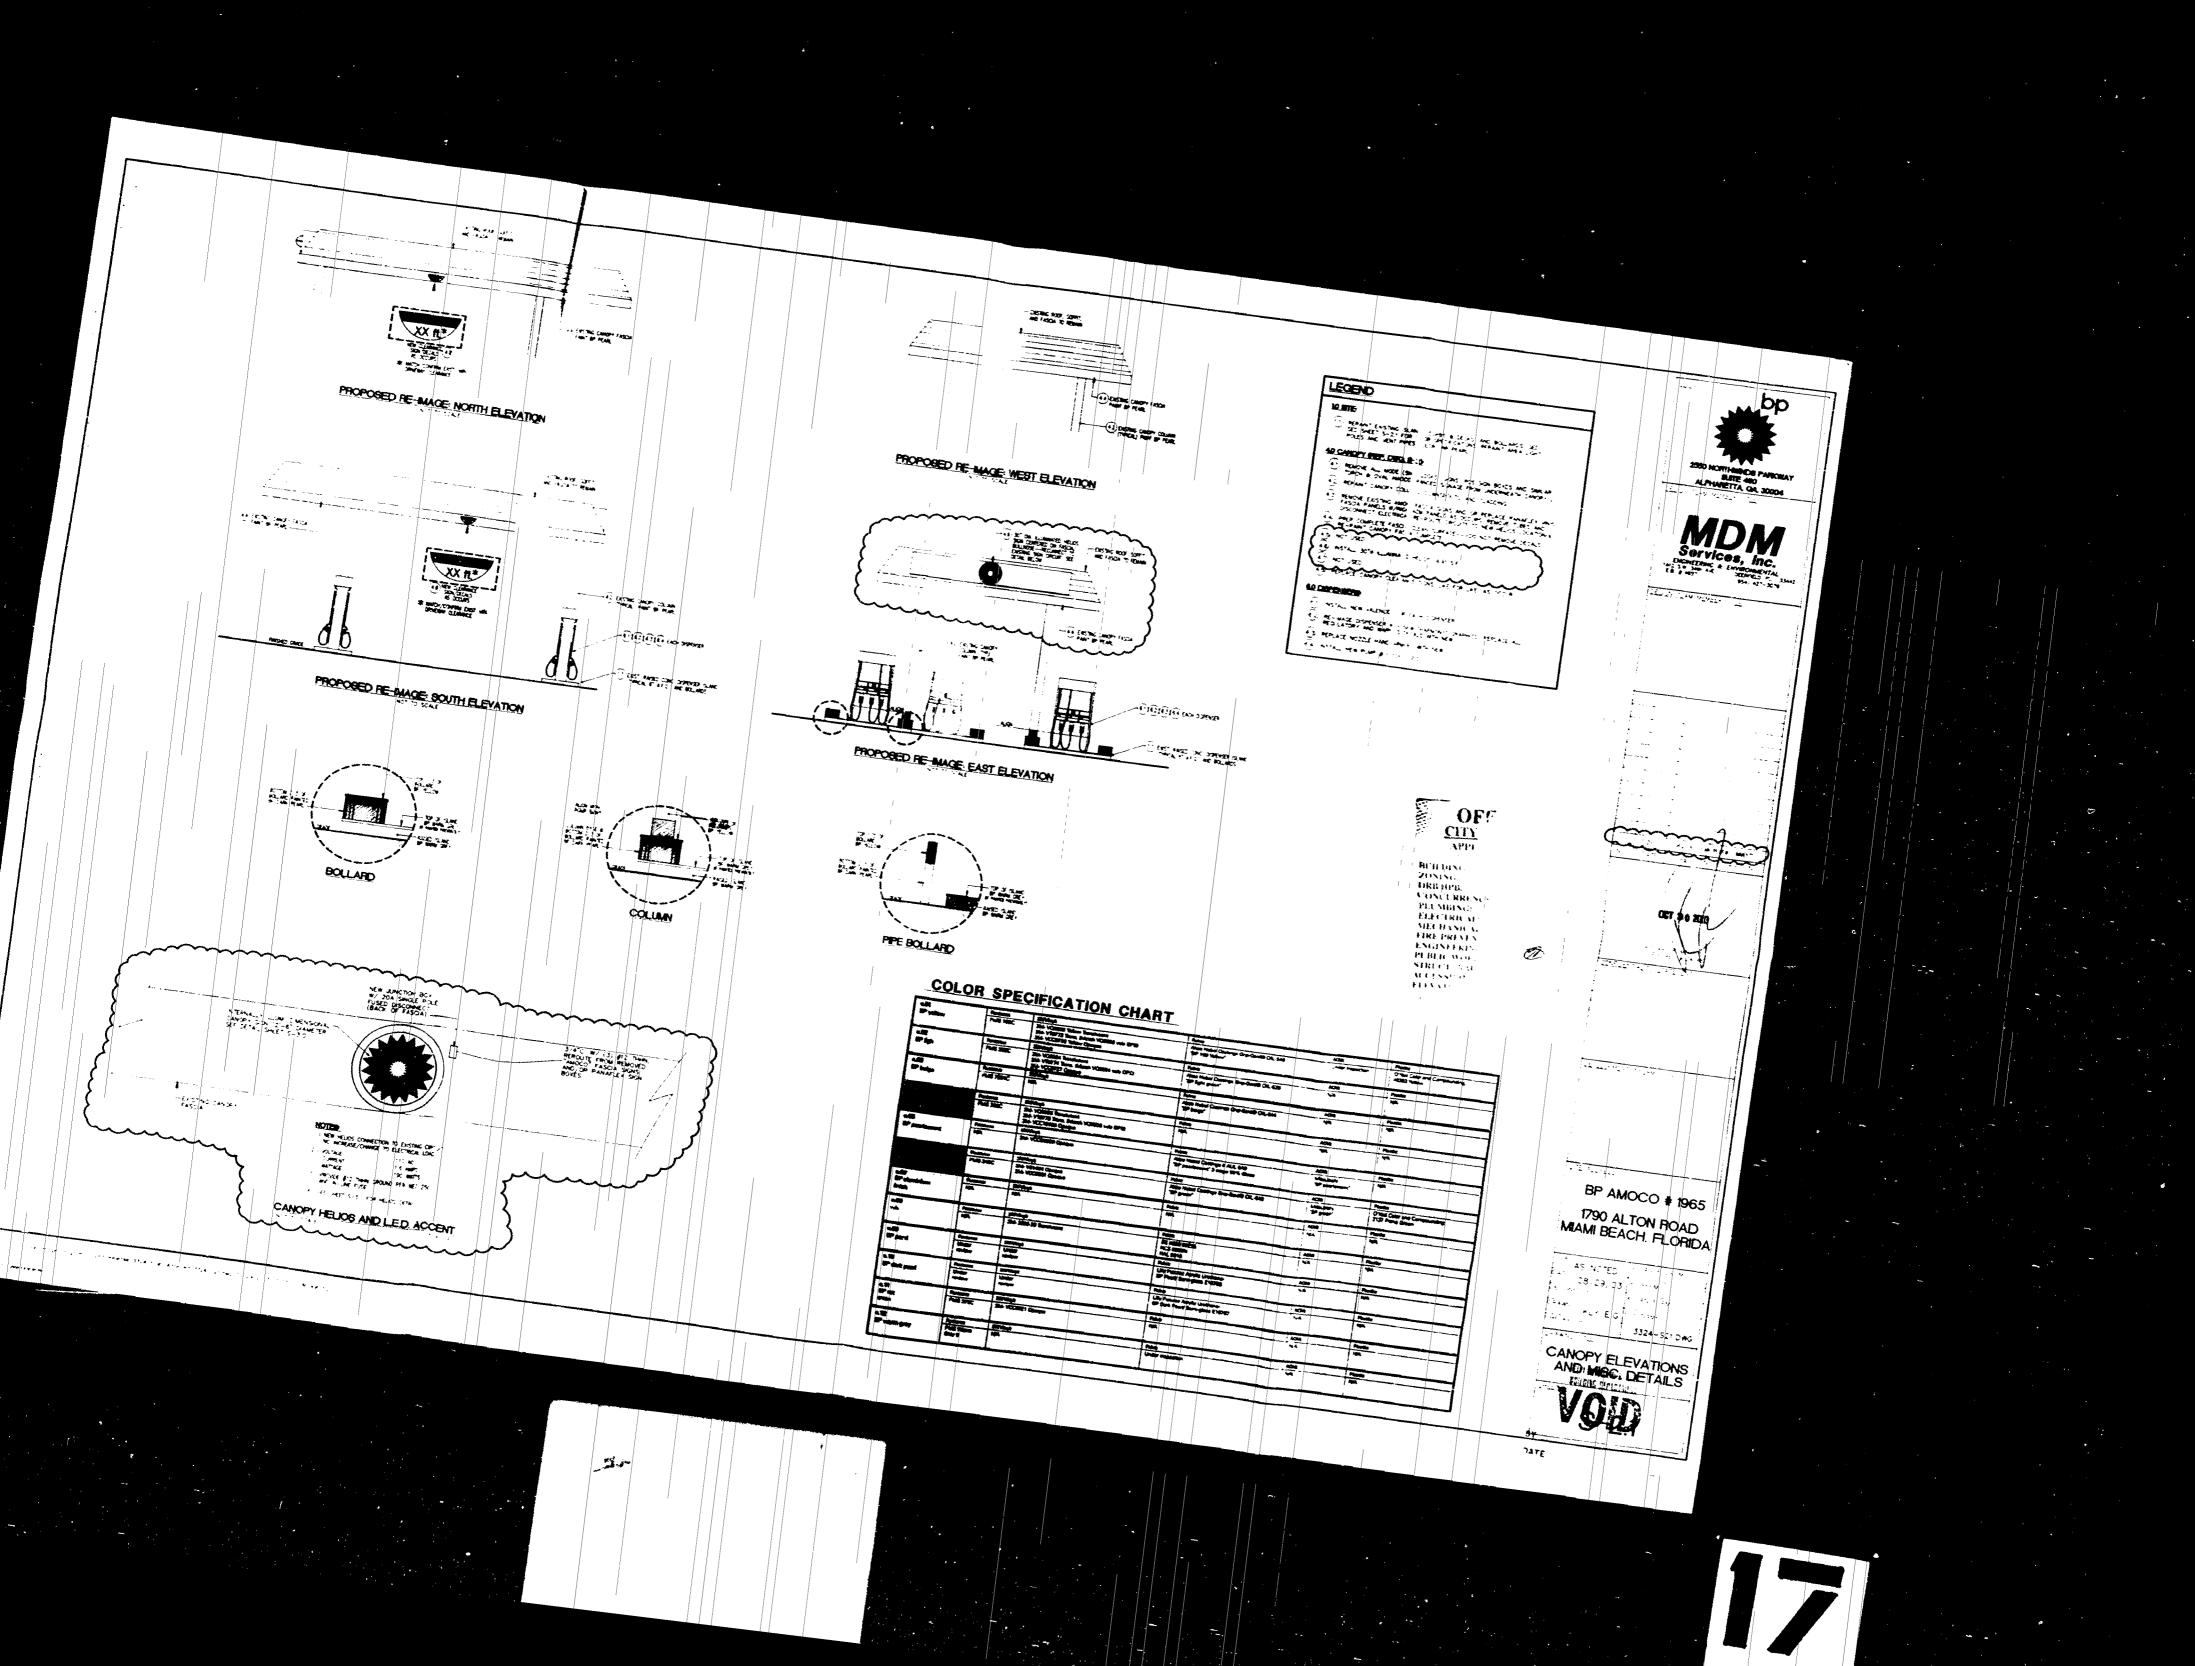

•4

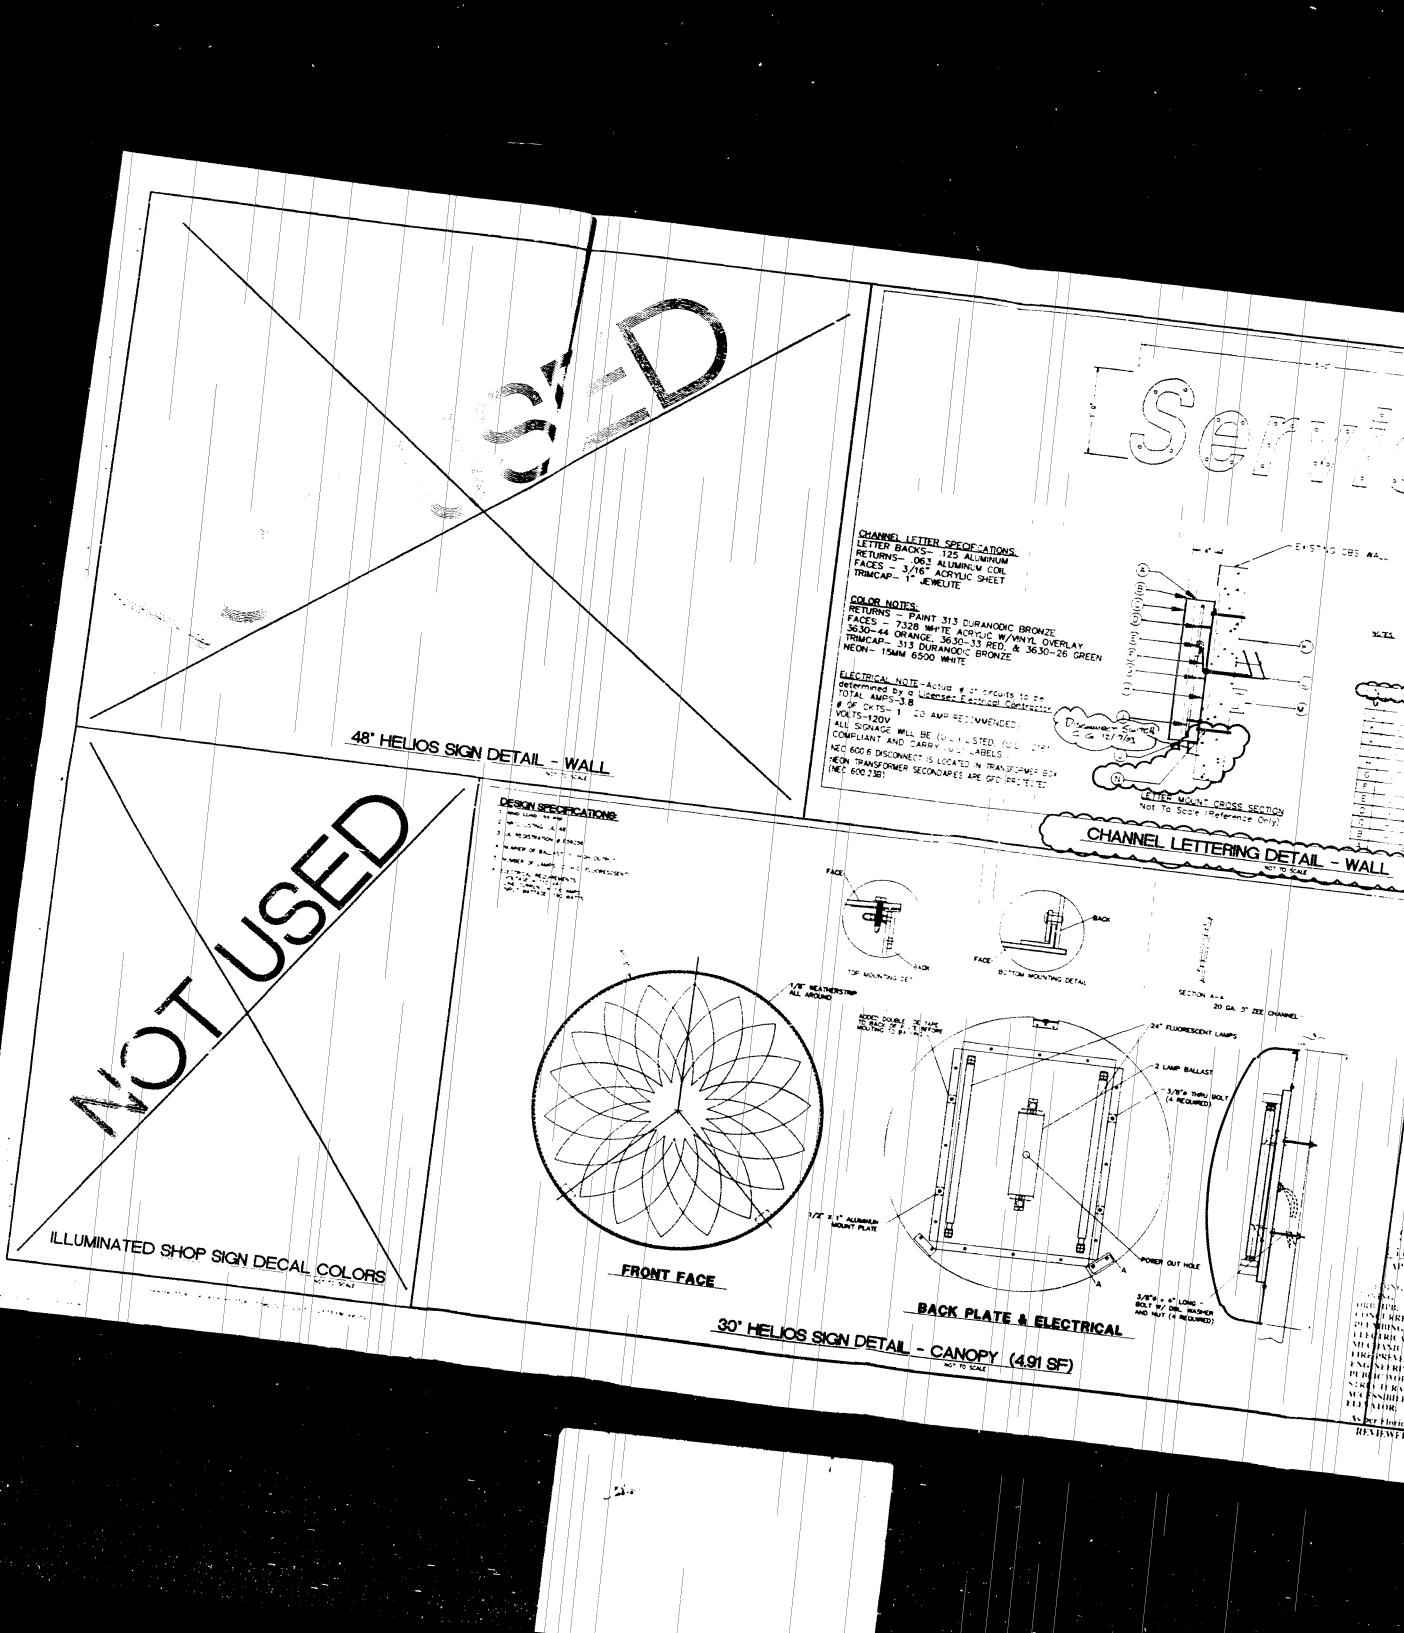

 $\sim$ 

· )

-----

--- î

.

Y.TS

<u>\_\_\_</u>

<u>\_</u>\_\_\_\_

\_\_\_\_

:4

-

鬥

0 × 01


EPST O CHE MAL

·----

bn +----÷ ‡ . . . Services, Inc.

محصور Jan marine marine 2 V 1 3 4 =34=( \*e.( f. e. --------man DEC 1 1 2003 ELECTFICAL NOTES Contraction of the state of the The second secon NC ........ Free VS 1 कि 

BP AMOCO # 1965 1790 ALTON ROAD MIAMI BEACH, FLORIDA DFFICE COPY - the Stap (exter ka Dik: PROFILE PRO 1110 " EG · • [ • • • ----title 3324-53 Jug 1 CO livet SIGN DETAILS ---------lding Code State p. 1043 -----ber Florida B S-3.0 REVIEWED FOR CODE

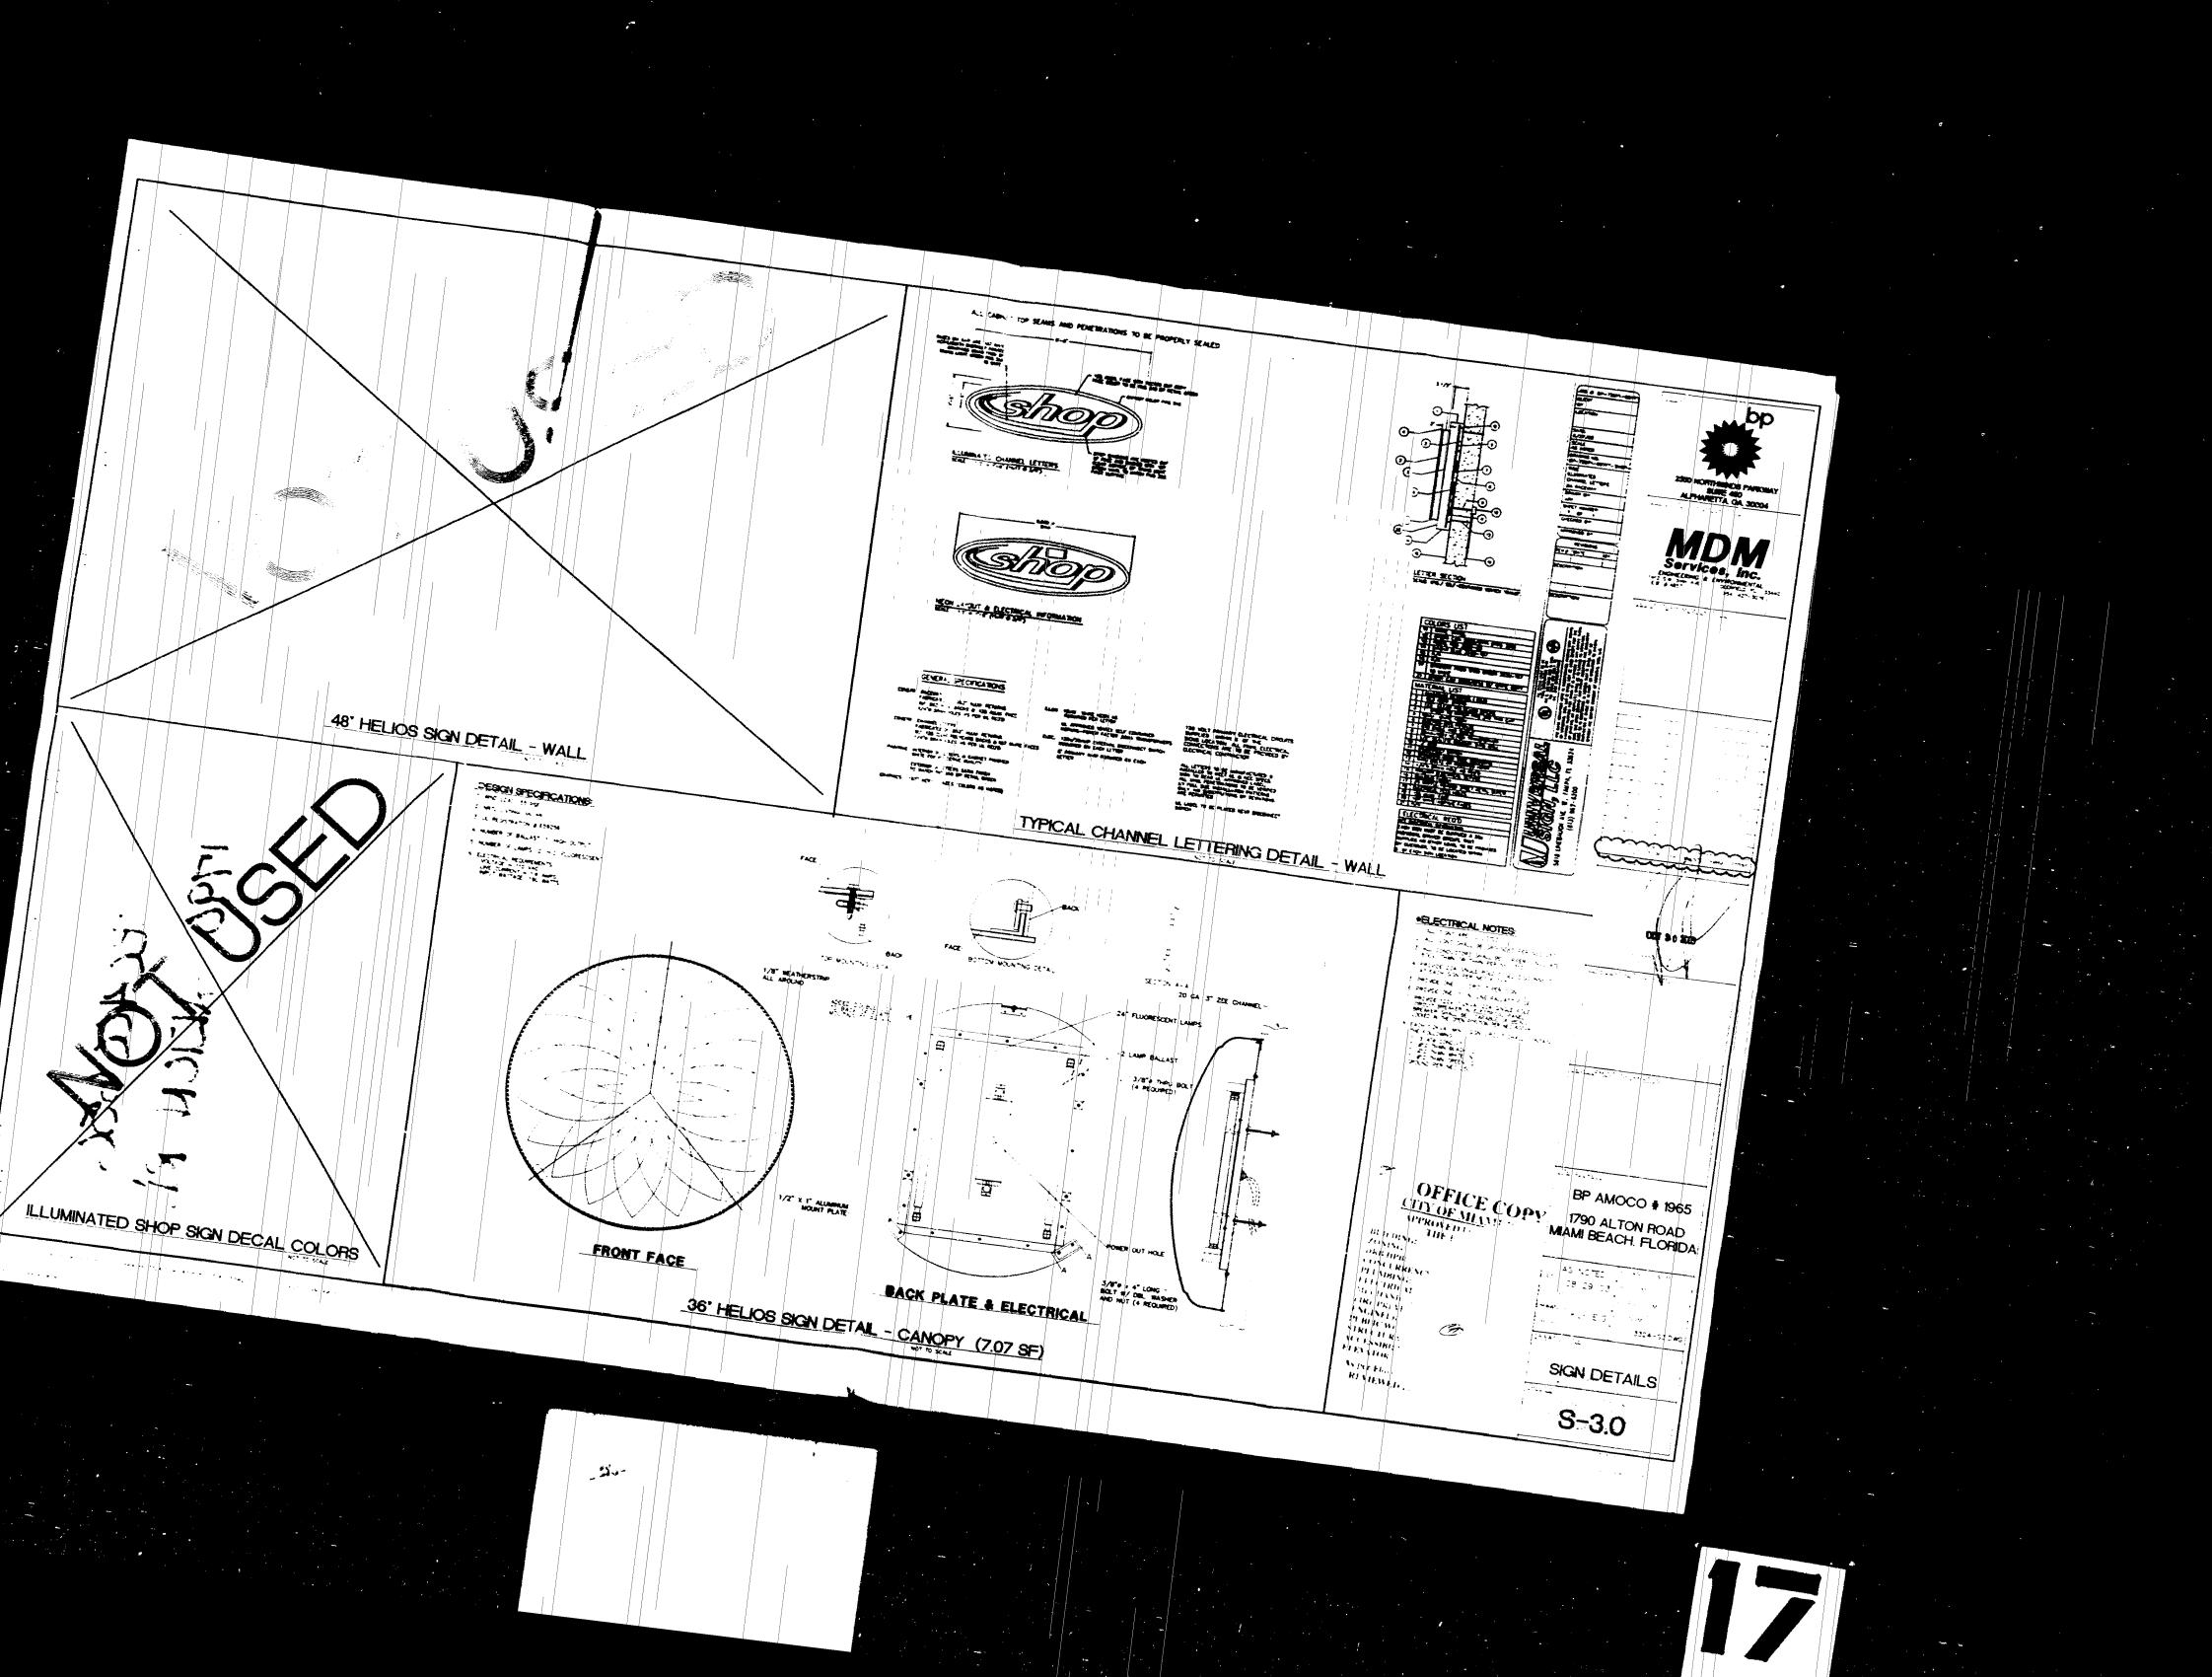

## 

LASON

**PERMIT** #

B0401638



Parena 2 17 Kino Riad Matti Brain H

Alternatives Pile Foundation

Pro Pico Transformation Transformation Agent Case Pico Proved Concerner Pice Pice

BIS Below Fristing Land Sufface

Bared on our understanding of the proposed countine and four field worrs (100,000) for that the dues Frendetion system are needed to support the proposed address with rat dominicative theory of the tractice of the tractice of the state of the tractice of the state of the tractice of the state of the tractice of the tractice of the state of the tractice of the state of the tractice of the state of the sta

Sure Pile Capacity Pile Capacity Allow able in Tons in Tens Lateral Compression Letsine Capacity in

• 1 m. - 1 m.

Capacity in Tens

Deep foundation systems shall consist of one of the following allematises

Estimated Lateral Load for a pile Top Deflection of suich. The proposed pole length whated with eviding strandle evaluation at the time of lenting. Pole length may kary depending on proposed grade hear clevation and subproble

In the characterize Pin. Herical, by Precise piles a minimum of a piles shall be driven to determ no production pile length - All work shall be performed in actordance with the applicable building code

In case of executing structures in the solution of the pile driving operation, care shall be taken not r create excessive obtaining. Vibration levels shall be montored to serve possible and to be an operation of the solution of the soluti

Approximete. Pile Deptie

SECTEDING CAL LEVI NONLEVIAL HYDRIGEDICGI AUREETIDS

Marris N. Senter (N. 29-3

No Pesi Lingoleian MOM SERVICES, INC 1412 SM 343 Avenue Develieid Baub, FL 30442

Re – Propried Sign a Unit Alvin Road Mamij Reach FL

Den Mr. Lingutfeldt

<u>.</u>

8-47 21 ( 15 ( -

S. 5 27- 17" 37- (\*\* 41-97 71-0

DYNATECH ENGINEERING CORP.

Pursuant to Note request, DNN NIECH ENGINEERING (CORP., complified a Native) investigation on Nonember 19, 2, 43 at the above references project. The purpose of our intervigation was to sents sub-out to induces relative to foundation doe an of the project state.

א שלשו יד די יישטלשים פרורידור. וו איזוקן צפר אאא פרו יודופי אנגיד בחקר יד 1863 וידוא בי אומי שו איזו איז איז לרוא ייד בי אינויא באווי דע ברושל אנדשים

The S Sound of graph was developed as a general condition for the sub-ext site of the Sound Sou Sound Sound

Parenterin Concrete Tan beach wind Tan with beach wind Suit

Pear Pearls with

En sond water table elevation was maximal immediate's at the completion of each homogrand was build at an average doption of some elevation ground attace. Elevitation in water level should be anticipated due to a completion of the source of

759) West 24 Street, Huleub, F2, 52014/2618 \* Phone (305) 828-74995 Fax (305) 828 9598

Francisco And Gray beach und Fan saudy formers al

237-632 24-24 237-632 40-235-24 24 40-235-24

### Page No. 1 Che Mart Road Marti Road, FL


Nopiles stall reide oktop togation a protección al envirent and stall Pepto a stora teoristico de monto de sobre Engineer to sendo somplitative wolfs out reconterentationes

An even of the service process of the service service of the servi

ENTERN LETTER, PI Division Letter, PI Division

litasteen apleas ze working with so and had transfording in the non-out at files of mitteen so that

ं में ह

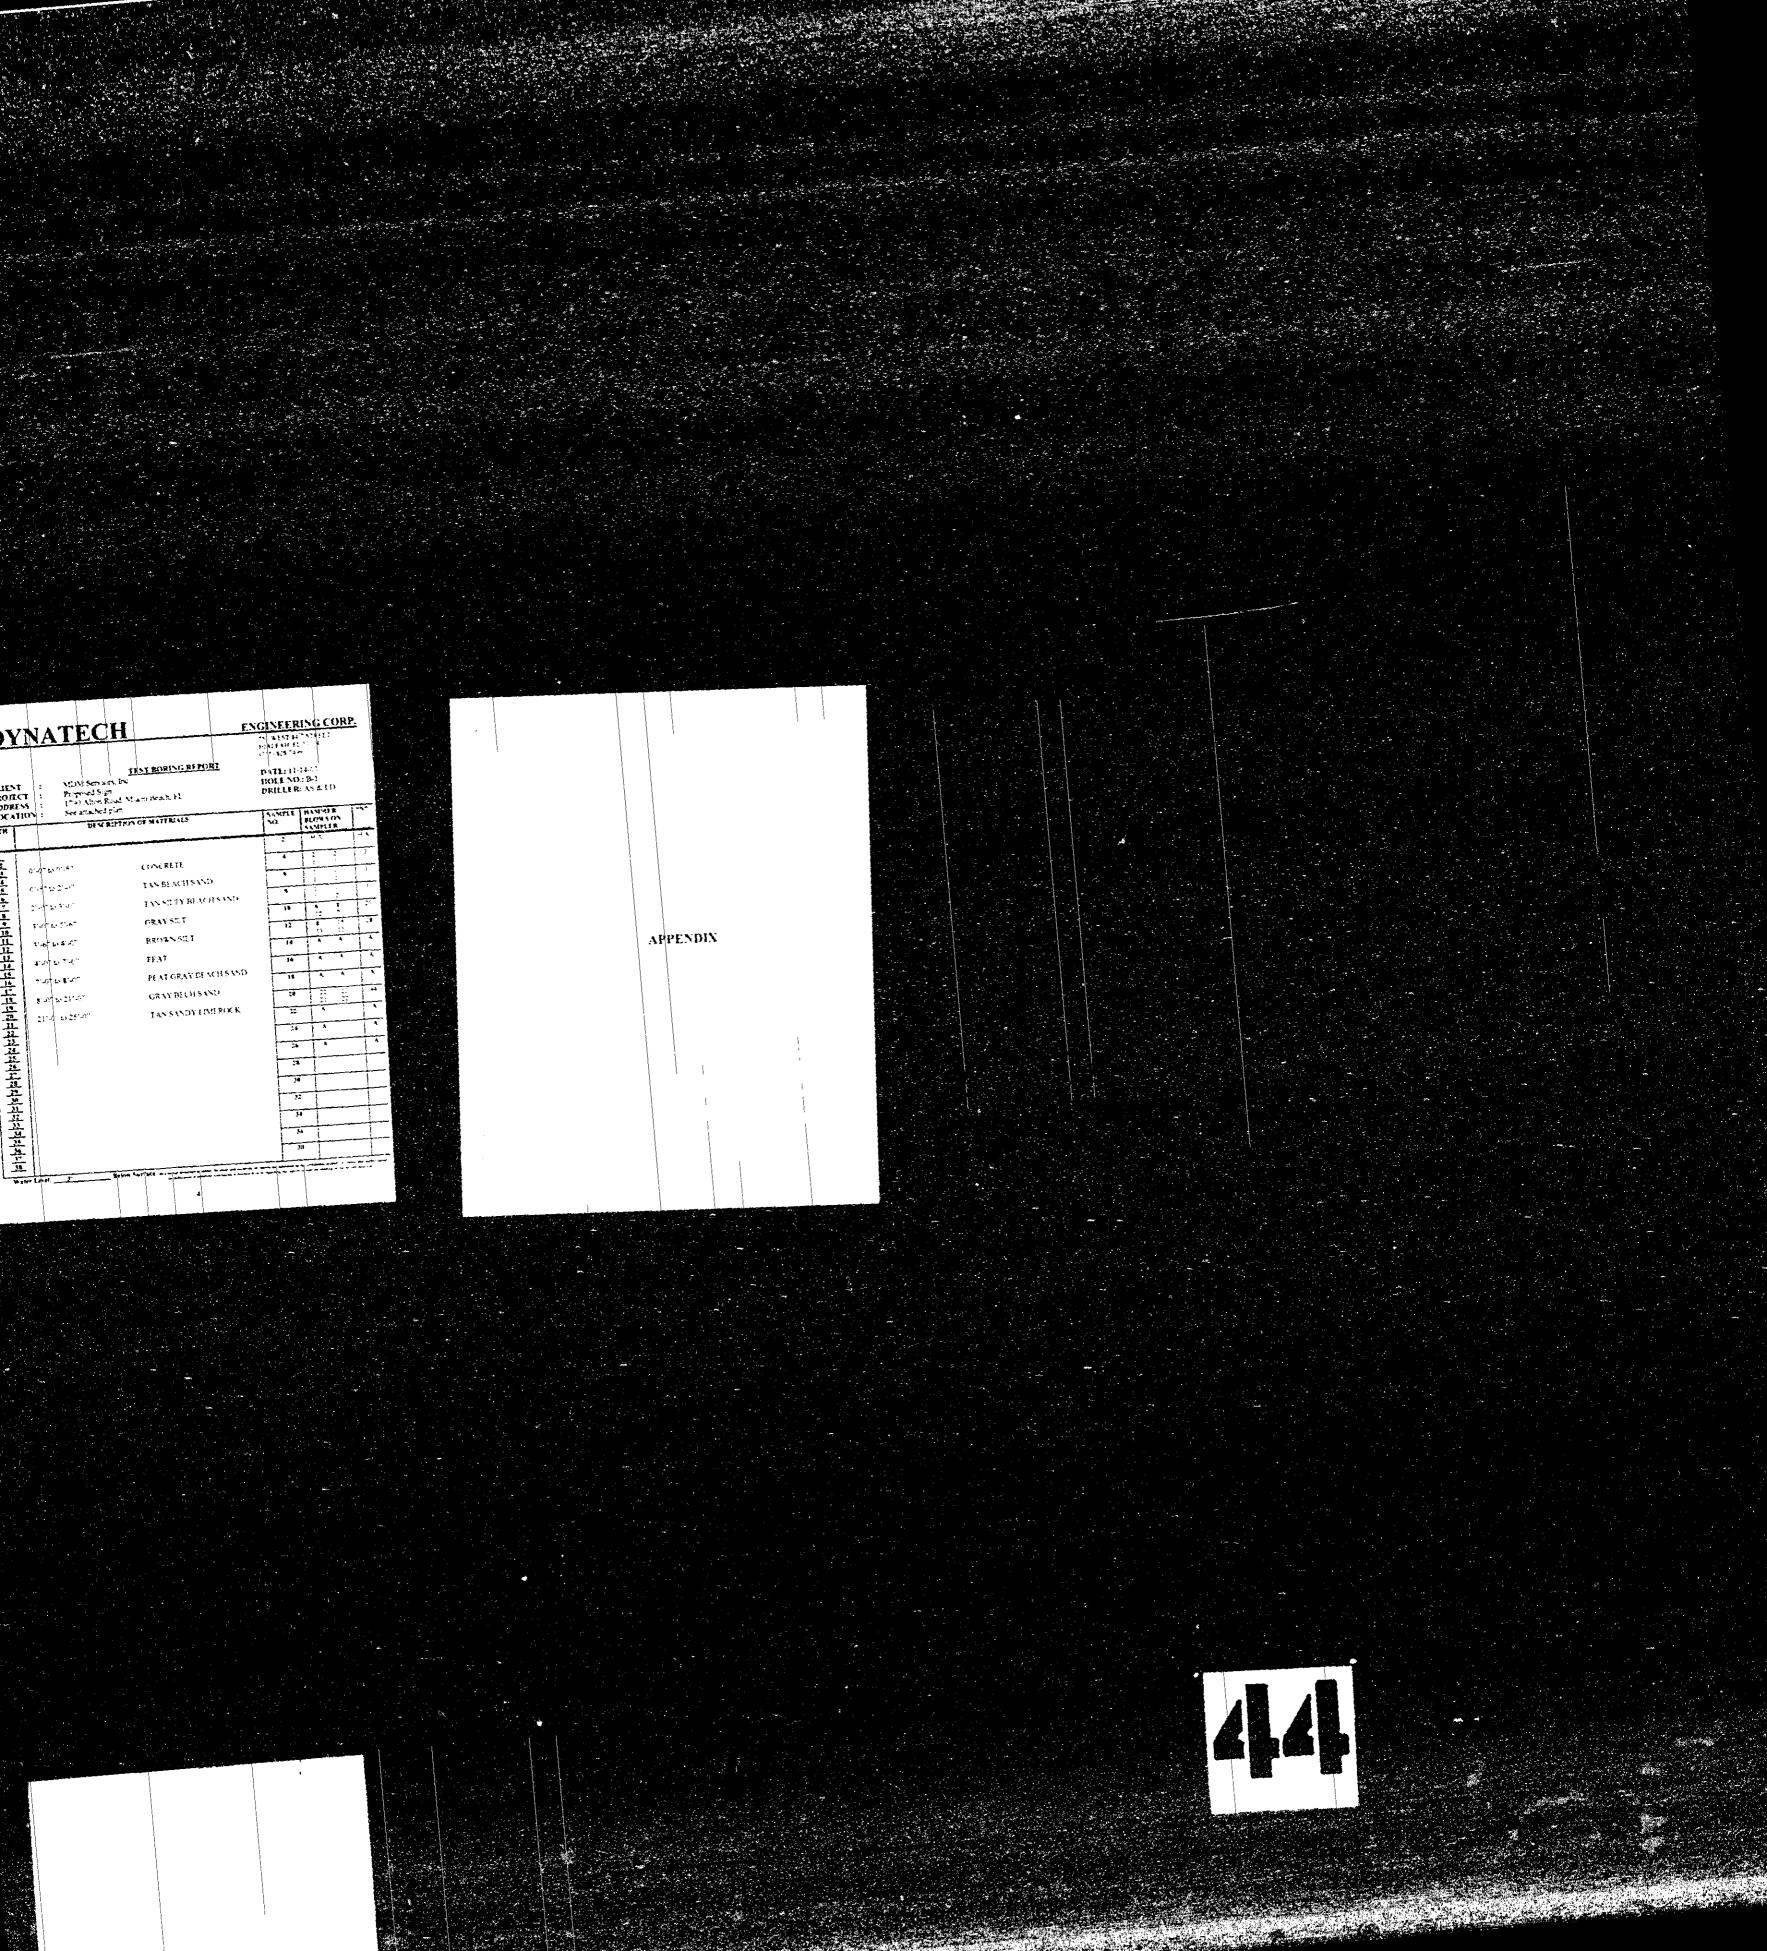

# Appendix Dulling Privedures

The burings are conducted in accordance with procedures outlined for standard penetration test and split spoon sampling of soils by ASTM D-1556

A two-fort how, two inch OD splat speen sampler was driven into the ground by successive bloasy with a 140 lbs, bartiner dropping 30 million. The soli sampler was driven (2) at a time, then extracted for vocal examination and classification of the relation disclosurgies.

the purples of blows required for enertistic perenation of the sumples to designated as "N" therean as the Standard Periopation Residuce Values

The -N- value provides an indication of the relative density of non-cohesive soils and the consistency of cohesive soils.

It is general gractice that the sum of the number of blows required for the second and third six-inch penetration are added to determine the NT value Suitche constants are applied to this number, in order to include the effects of swifescebarden pressure and other factors. A general evaluation of swifes made point the established correlation between TT and the relative density of considering of sub-

This dynamic method of soil unting has been widely accepted by foundation engineers and architerts to conservatively evaluate the bearing capacity of soils


A continuous duiling and sampling procedure was used. Therefore the sample, were taken at intervals of 2 feet of at every change in well-sharacteristics.


### TENATETE ENSTREETING SORT م بعد والامر فالمانيم ماليم الاسم ماليم جريب ا 1. ers - 3. - 7. 12 (2. 22) NUT ANALYSIS SCREEMEN موجع المروا موجوع والروو ومريعة والمعاصين والمعاوية المهجون المهم الله الله الله المراجع \*:::**:**\* en a grad af preis ar ser en tar. 1. 1. 1. junt preis en grad <u>....</u> سيدو دينو . **-**1 \*

\* li∟ ---------Ē ۲. And a second sec ٠.

;-:-.... - · , .--2 2 2.2.2.2 .... -----:== Analas an Upan M Pranting Analas an Pranting Analas an Analas an Analas an Analas an ستعر 

with the second second second

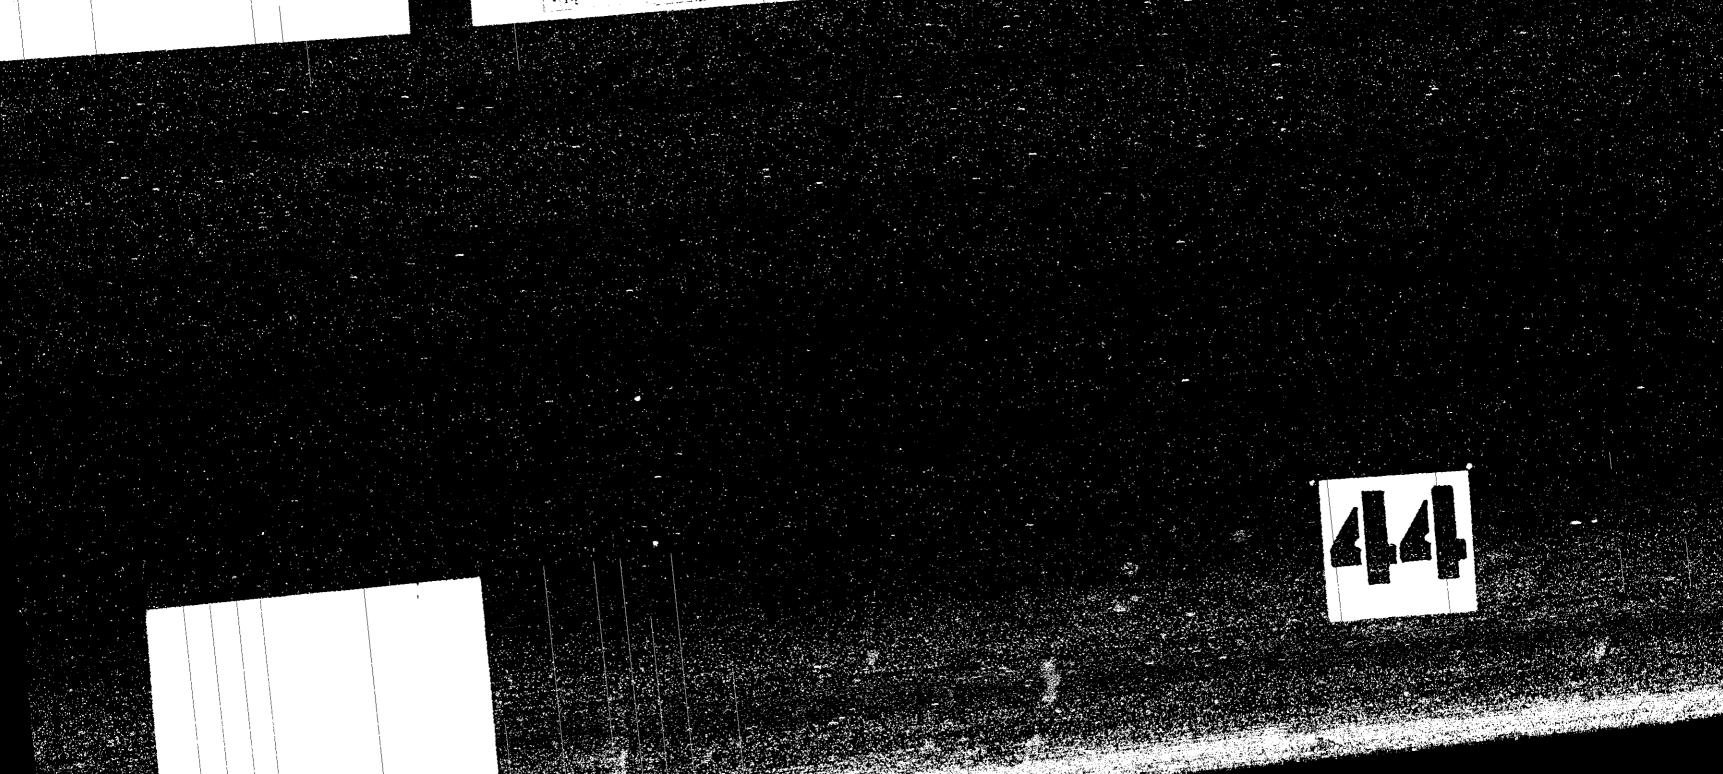

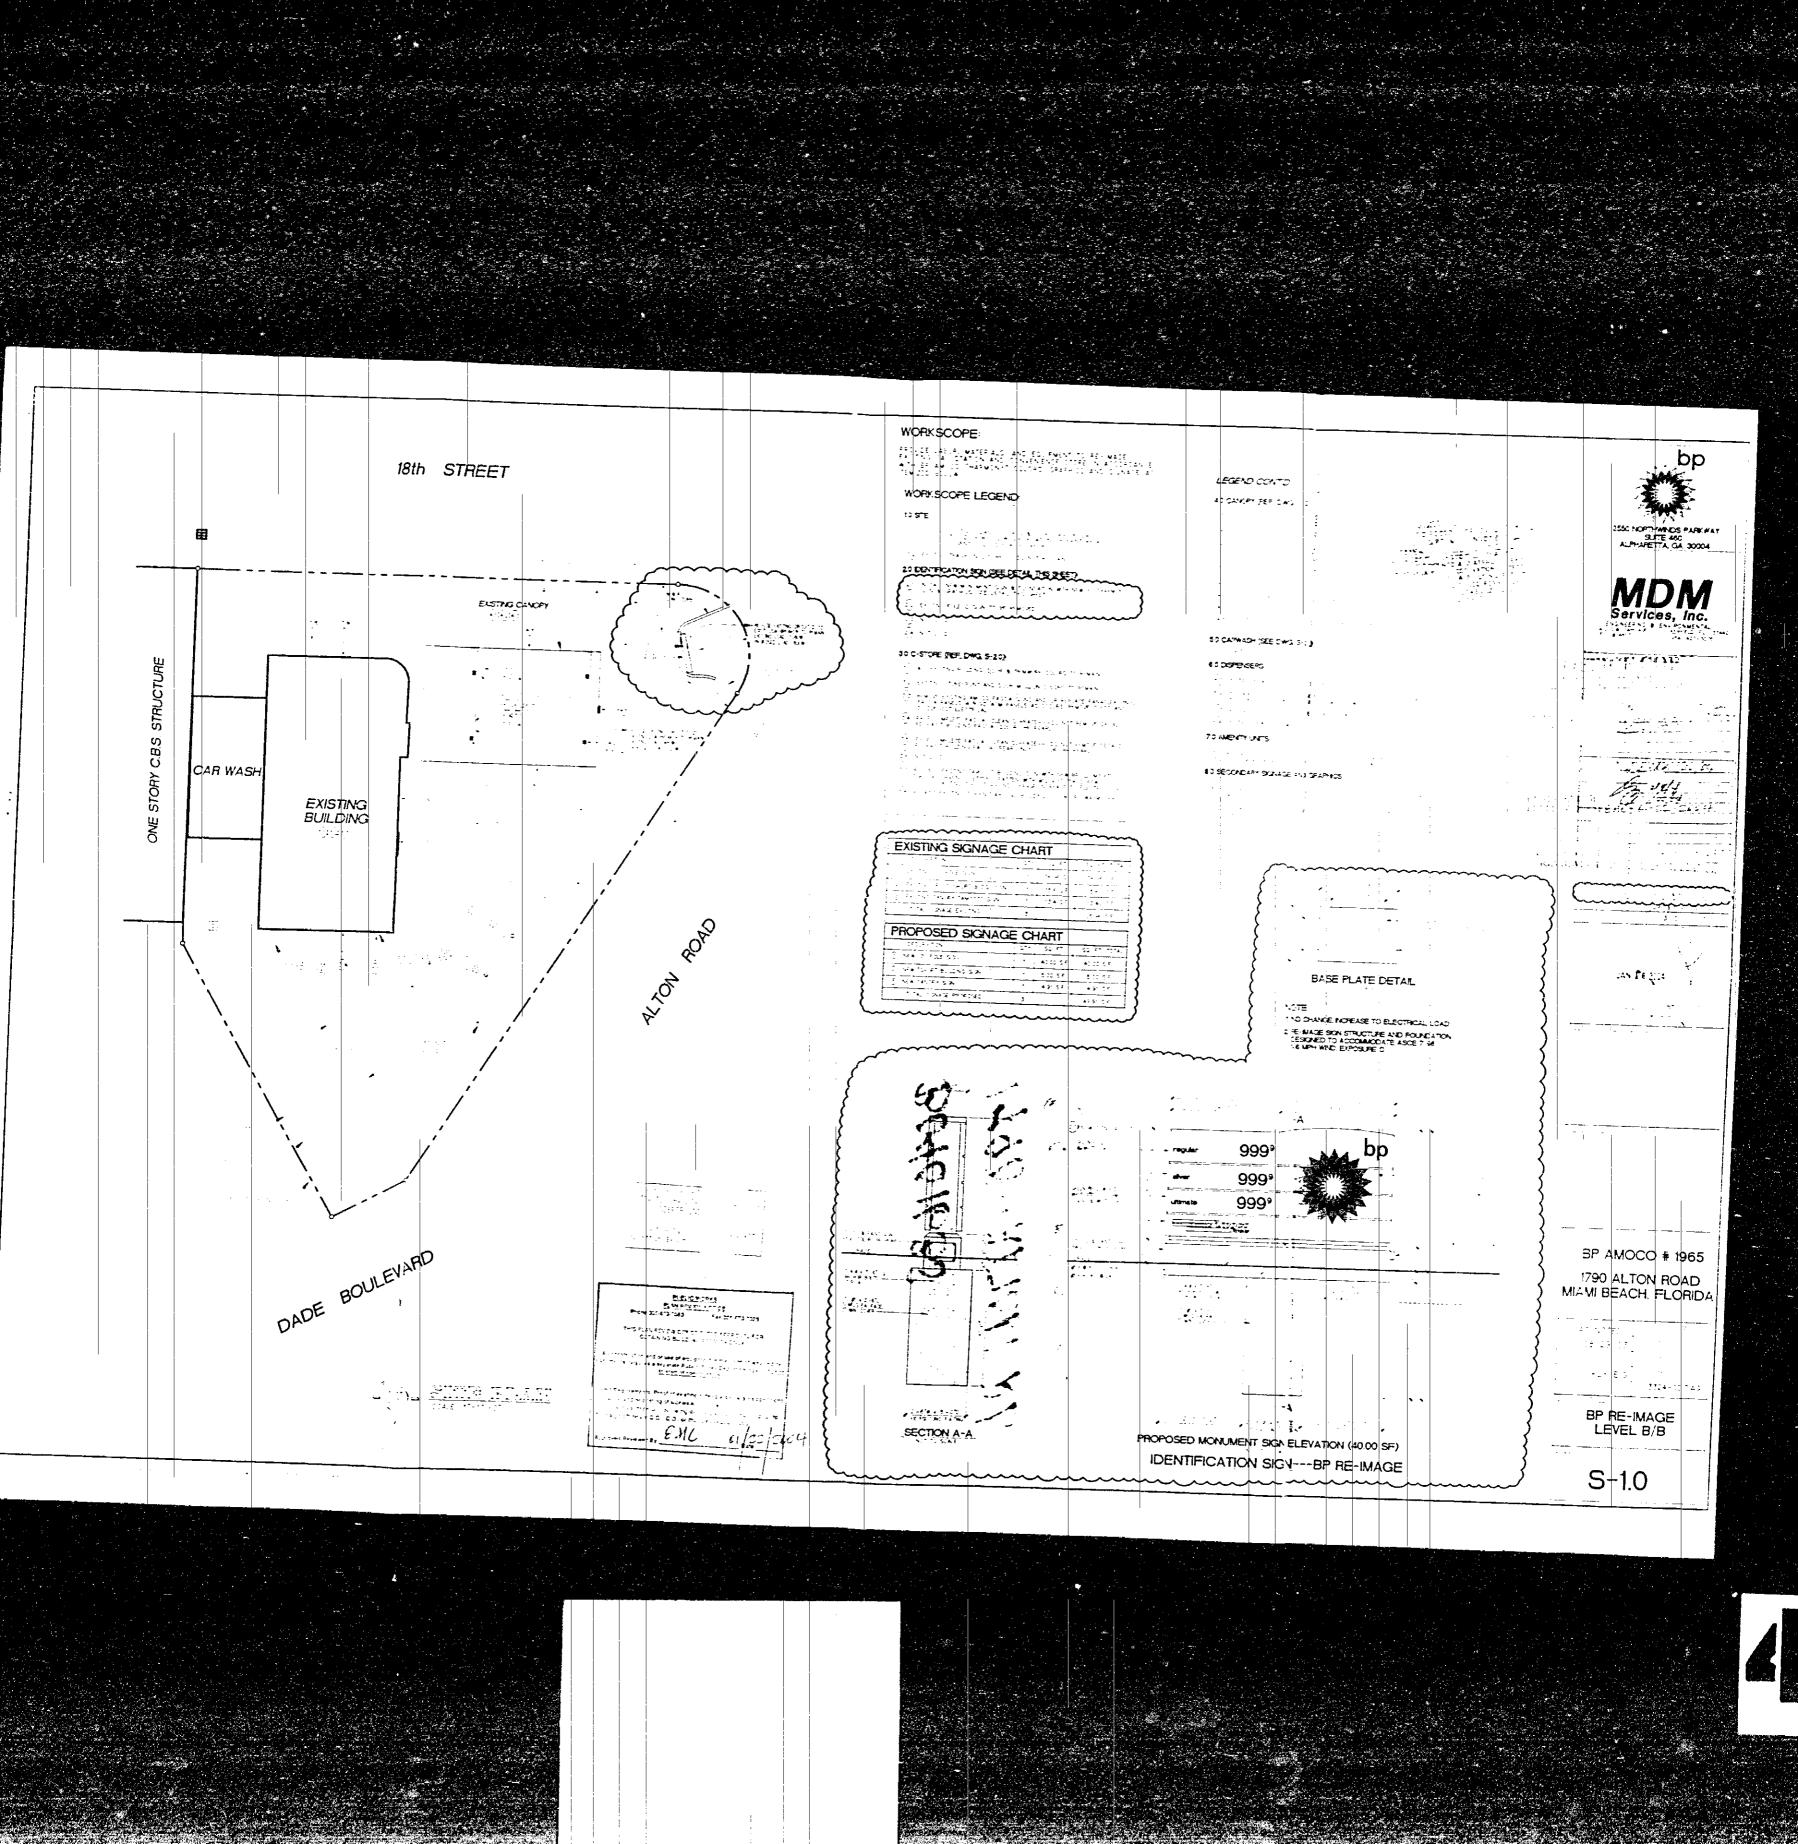

BORGIASS 1790 XLBU RD OF FICE COPY

