NEW CONSTRUCTION 456 W 41ST STREET MIAMI, FL 33140



PROJECT TEAM


ARCHITECT ANTHONY LEON #0016752 3 DESIGN, INC. 3260 NW 7th St. MIAMI, FLORIDA 33125 Off: 305.438.9377 Fax: 305.438.9379 E-mail: 3dtony@bellsouth.net FINAL SUBMITTAL - DRB 22-0866

ARCHITECT'S CONCEPT DRAWING FOR ILLUSTRATIVE PURPOSES ONLY. NOT TO BE USED FOR CONSTRUCTION OR SHOP DRAWING PRODUCTION.




SCOPE OF WORK:

- 1. DEMOLITION EXISTING BUILDING
- 2. NEW VANILLA SHELL
- 3. TRASH ROOM

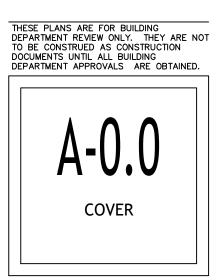

GENERAL DEMOLITION NOTES:

- 1. SECURE ANY DEMOLITION PERMITS REQUIRED BY LOCAL AUTHORITIES HAVING JURISDICTION OVER SUCH WORK. NO WORK SHALL COMMENCE PRIOR TO OBTAINING REQUIRED PERMITS.
- 2. CONTRACTOR TO VERIFY ALL EXISTING CONDITIONS AND DIMENSIONS PRIOR TO BIDDING AND AGAIN PRIOR TO COMMENCEMENT OF ANY WORK. REPORT ANY DISCREPANCIES TO ARCHITECT IMMEDIATELY.
- 3. CONTRACTOR TO ARRANGE ON SITE CONSTRUCTION MEETING WITH ARCHITECT PRIOR TO ANY DEMOLITION OR CONSTRUCTION. 4. REVIEW DEMOLITION/CONSTRUCTION SEQUENCE WITH ARCHITECT. COORDINATE WORK WITH OWNER TO MINIMIZE DISRUPTION TO OCCUPIED
- LIMITS OF CONSTRUCTION AS REQUIRED. 5. ALL WORK SHALL COMPLY WITH ANY GOVERNING AND APPLICABLE
- CODES. 6. REVIEW LOCATION OF DUMPSTER WITH OWNER. KEEP AREA CLEAN AND
- FREE OF DEBRIS. REMOVE ALL UNUSABLE DEBRIS DAILY. 7. SHORE AREAS OF EXISTING AND NEW CONSTRUCTION AS REQUIRED.
- 8. VERIFY ALL ITEMS TO BE SALVAGED WITH OWNER. REVIEW SALVAGE OF
- EXISTING PLUMBING FIXTURES WITH OWNER. 9. VERIFY LOCATION OF EXISTING UTILITY LINES PRIOR TO DEMOLITION/EXCAVATION. COORDINATE WITH OWNER TO MINIMIZE
- INTERRUPTION OF SERVICE. 10. DISCONNECT ANY EXISTING ELECTRICAL, MECHANICAL AND PLUMBING AS REQUIRED. CAP ANY ABANDONED PLUMBING LINES AS REQUIRED.
- 11. EXERCISE EXTREME CARE WHEN WORKING AROUND SUSPECTED ASBESTOS; INCLUDING DUCT COVERINGS, PIPE COVERINGS, TANK COVERINGS, FLOOR TILE AND ACOUSTICAL TILE. REPORT SUCH FINDINGS TO THE ARCHITECT IMMEDIATELY. REMOVAL OF ALL ASBESTOS CONTAINING MATERIALS SHALL BE BY A CONTRACTOR LICENSED FOR THE REMOVAL OF ASBESTOS.
- 12. COORDINATE CONSTRUCTION SITE ACCESS & HOURS OF WORKING WITH THE OWNER.

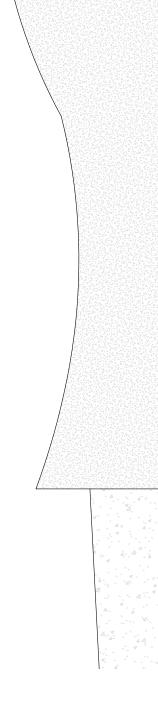

AREAS. PROVIDE TEMPORARY CLOSURES AND/OR DUST BARRIERS AT

LEGAL DESCRIPTION:

ORCHARD SUB 2 & 3 PB 8-116 LOT 11 BLK 54 LOT SIZE 50.000 X 110 74R-10302

SITE PLAN INFORMATION:

ZONING DESIGNATION:

02-3227-017-1230

FOLIO NUMBER


CD-3 COMMERCIAL, HIGH INTENSITY DISTRICT

DEMOLITION

CLASSIFICATION OF WORK:

DEMOLITION: SCOPE OF WORK KEY

- REMOVE ALL PLUMBING LINES CAP SEWER AND WATER AT PROPERTY LINE
- (-) REMOVE ALL ELECTRICAL LINES TO SOURCE.
- (-) REMOVE FLOOR SLAB, ALL WALLS, WINDOWS, DOORS AND ROOF.

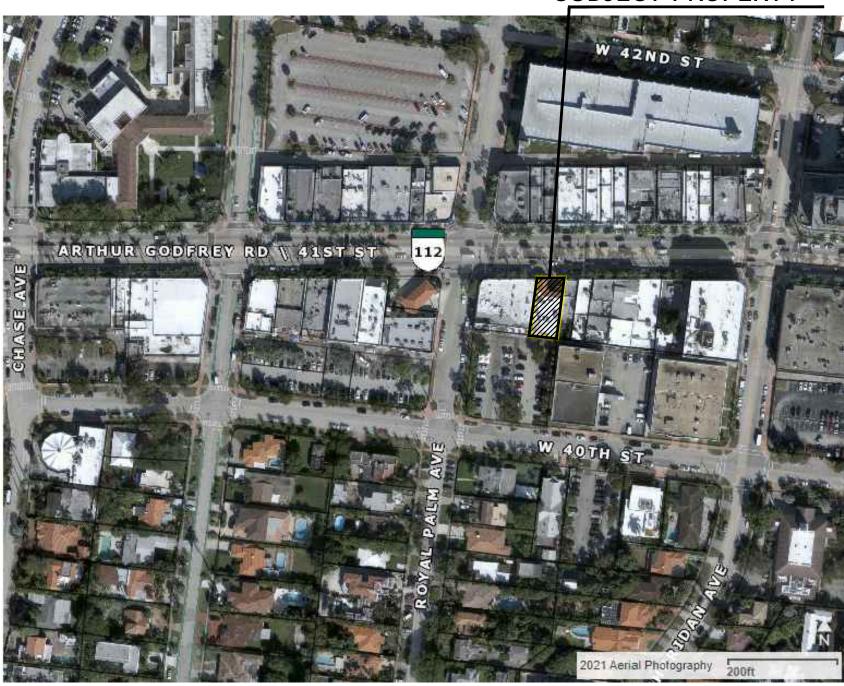

EXISTING 1 STORY BUILDING TO BE DEMOLISHED #456	
5,380/\$Q. XX.//////////////////////////////////	
77/////////////////////////////////////	╱╱╱╱╱╱╱╱╢ ╱╱╱╱╱╱╱╱
EXISTING/DEMOLITION PL	





SCALE 1/8" = 1'-0


SUBJECT PROPERTY



LOCATION MAP SCALE: N.T.S

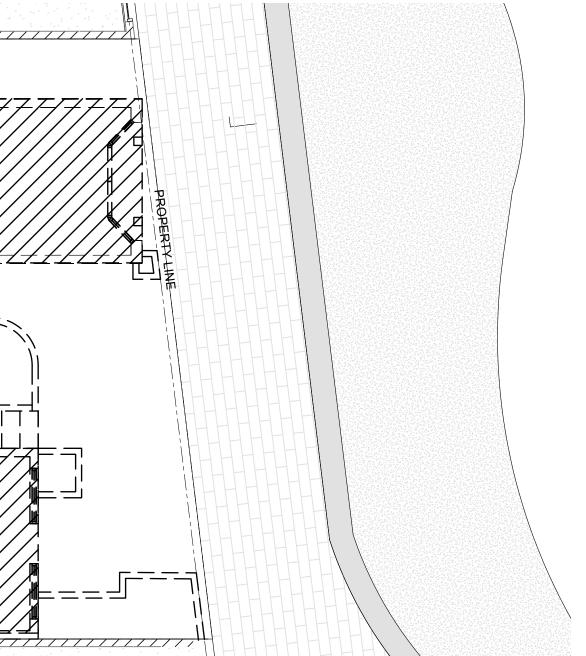

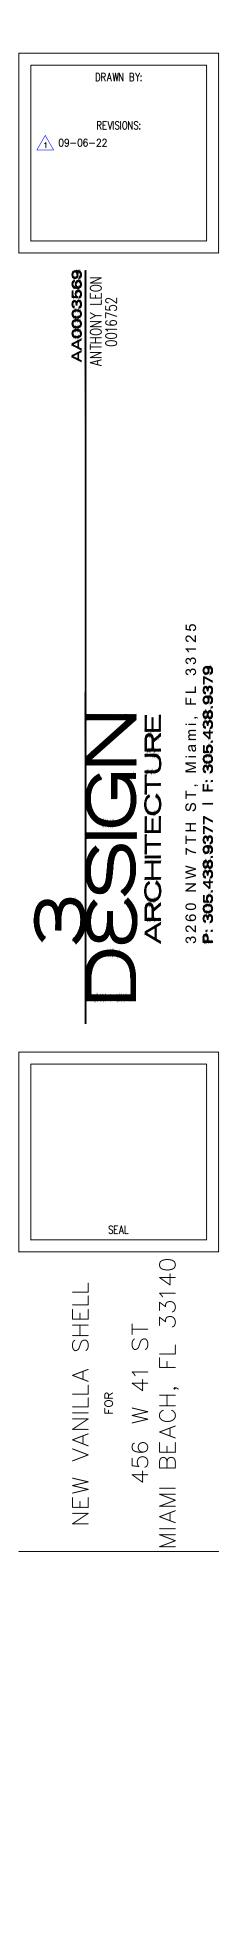


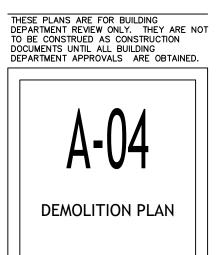







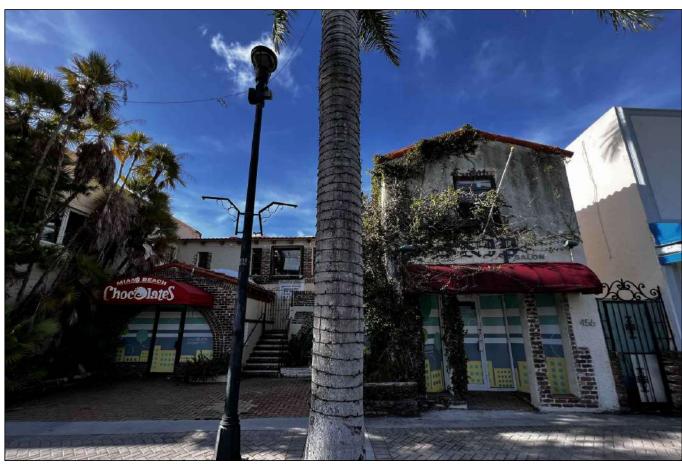

STREET VIEW - FRONT

4






ROOF 8







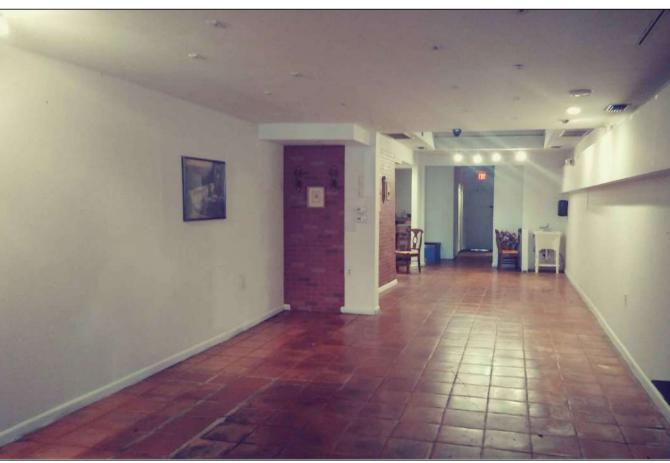


STREET VIEW - FRONT 1

REAR VIEW - SOUTH 5

> INTERIOR g

 $\frac{\text{INTERIOR}}{^{13}}$

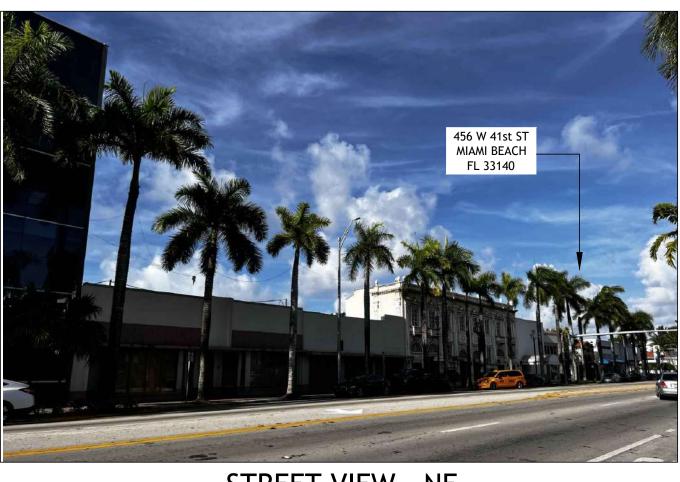

STREET VIEW - NE 2



 $\frac{\mathsf{ALLEY}}{^6}$



INTERIOR 10



INTERIOR 14






SIDE WALKWAY




INTERIOR 11



INTERIOR 15

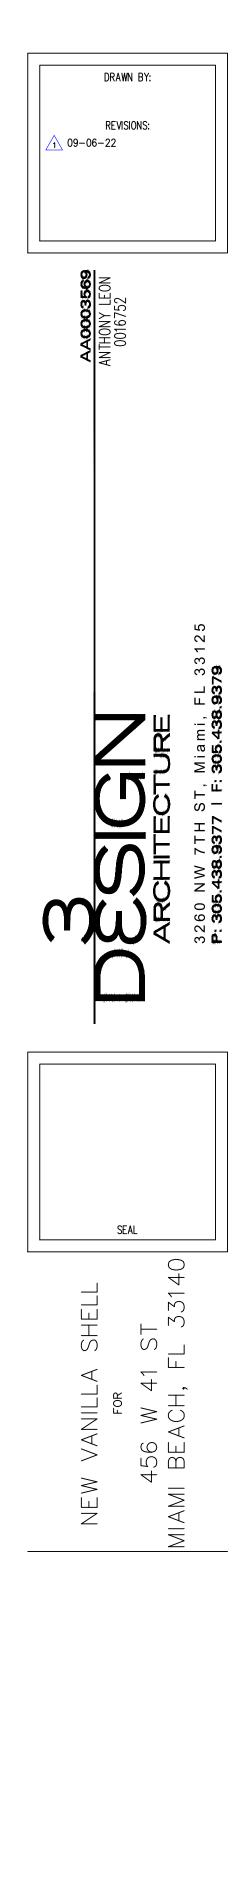

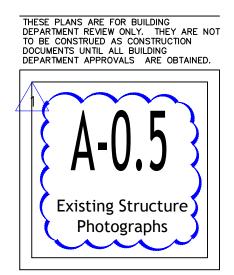

FOLIO NUMBER 02-3227-017-1230 LEGAL DESCRIPTION

ORCHARD SUB 2 & 3 PB 8-116 LOT 11 BLK 54 LOT SIZE 50.0 X 110.0 74R-10302

ZONING DATA:

ZONING DESIGNATION:..... CD-3 COMMERCIAL, HIGH INTENSITY DISTRICT FLOOD ZONE:..... AE

ZONING DATA:

APPLICABLE CODES: Florida Building Code, Existing - 2020 Florida Fire Prevention Code - 2020 Seventh Edition City of Miami Beach zoning code - Latest edition

SCOPE OF WORK:

- DEMOLISH EXISTING BUILDING 1
- 2. NEW VANILLA SHELL BUILDING
- 3. TRASH ROOM

CLASSIFICATION OF WORK:

NEW CONSTRUCTION

CONSTRUCTION TYPE:


VB

COMMERCIAL HIGH INTENSITY DISTRICT - ZONING DATA SHE

ITEM #	Zoning Information				
1	Address:	456 W. 41st ST Miami Be			
2	Folio number(s):	02-3227-017-1230			
3	Board and file numbers :				
4	Year built:	1930	Zoning District:		
5	Based Flood Elevation:	7.0 N.G.V.D Grade value in N		IGVD:	
6	Adjusted grade (Flood+Grade/2):	5.86 N.G.V.D	Free board:		
7	Lot Area:	5517.50 sqft			
8	Lot width:	50 FT.	Lot Depth:		
9	FAR:	2.25			
	Allowed square footage:	2.25 x (5517.50) = 12414.38 sqf	:		
	Proposed square footage:	5267.0 sqft		_	
		Required	Existing	Proposed	
10	Height:	75 FT. MAX	25 FT	25 FT	
	Setbacks:				
11	Front First level:	0 FT. MIN.	0 FT.	0 FT.	
12	Front Second level:	N/A	N/A	N/A	
13	Side 1:	0 FT. MIN.	0 FT.	0 FT.	
14	Side 2 or (facing street):	0 FT. MIN.	0 FT.	0 FT.	
15	Rear:	5 FT. MIN.	5 FT.	5 FT.	
16	Located within a Local Historic District?			NO	
17	Designated as an individual Historic Single	Family Residence Site?		NO	
18	Determined to be Architecturally Significar	it?		NO	

OCCUPANT LOAD - FFPC 101 TABLE 7.3.1.2.			
Mercantile Use Sales area on street floor	VANILLA SHE		
30	TENANT.		
2.8	OCCUPANT L CALCULATIO		
5193 SF	<u>REFERENCE (</u>		
173 persons			
	Mercantile Use Sales area on street floor 30 2.8 5193 SF		



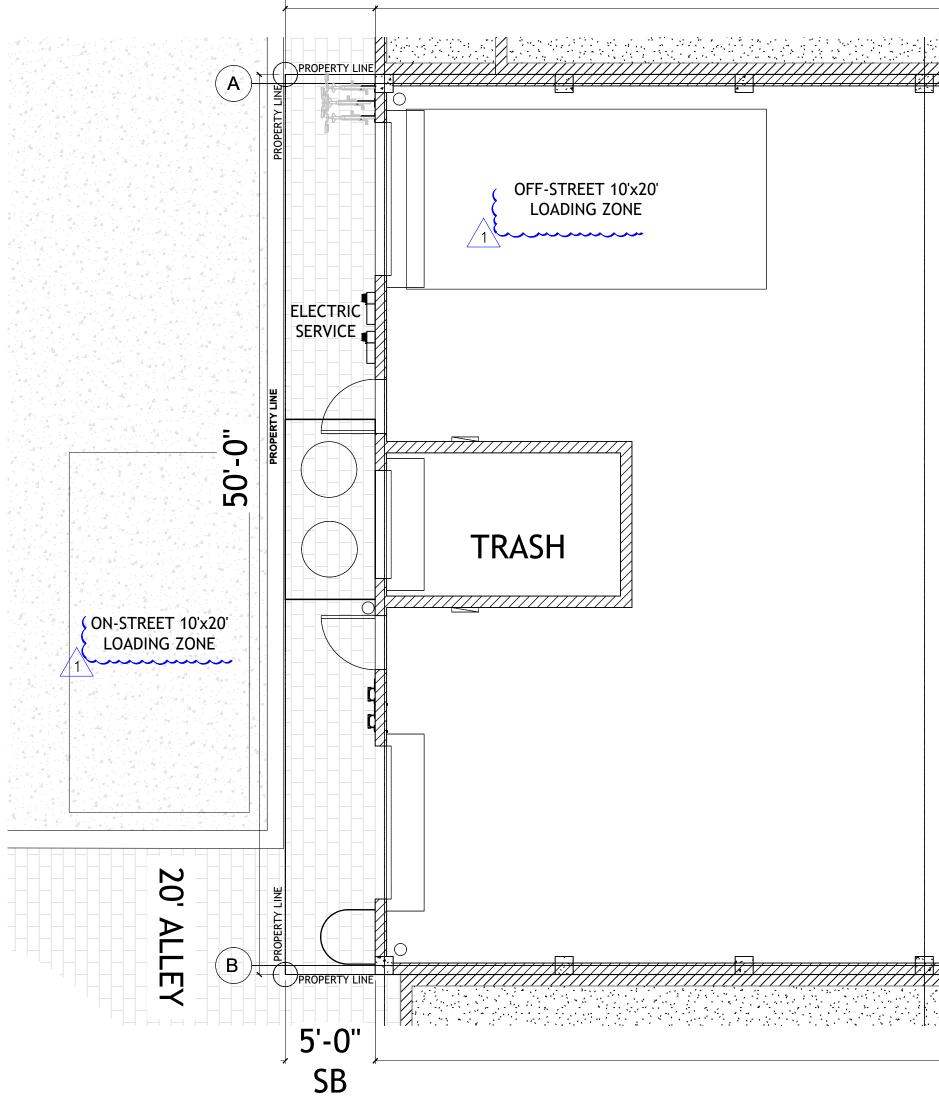


	Planning Department, 17 Miami Beach, Florida 331	39, www.miamibeachfl.go					
	305.67 COMMERCIAL HIGH INTER	73.7550 NSITY DISTRICT - Z	ONING DATA SHEET				
ITEM # Zoning Information							1/1 Martin
1 Address:		ami Beach, FL 33140					
2 Folio number(s): 3 Board and file numbers :	02-3227-017-1230						
4 Year built: 5 Based Flood Elevation:	1930 7.0 N.G.V.D	Zoning District: Grade value in		CD-3 4.73 N.G.V.D			
6 Adjusted grade (Flood+Grade/2) 7 Lot Area:	5517.50 sqft	Free board:		1'-0"			
8 Lot width: 9 FAR: Allowed square footage:	50 FT. 2.25	Lot Depth:		110 FT.			
Proposed square footage:	2.25 x (5517.50) = 12414.3 5267.0 sqft						
10 Height:	Required 75 FT. MAX	Existing 25 FT	Proposed 25 FT	Deficiencies			
Setbacks: 11 Front First level:	0 FT. MIN. N/A	0 FT. N/A	0 FT. N/A			FAR DIAGRAM SCALE: 1/16"=1'-0"	
12Front Second level:13Side 1:14Side 2 or (facing street):	0 FT. MIN. 0 FT. MIN.	0 FT.	0 FT. 0 FT.				
15 Rear:	5 FT. MIN.	5 FT.	5 FT.				
 16 Located within a Local Historic D 17 Designated as an individual Histo 18 Determined to be Architecturally 	pric Single Family Residence Site?		NO NO NO			<u>F.A.R = 2.25</u>	
	Jigimeant:					LOT AREA = 5517.50 SQFT MAXIMUM SQFT ALLOWED = 2.25 X 5517.50 SQFT = 12414.38 SQFT	
	~~~~~~~~~~~~~~~~~~~~~~~~~~~~~~~~~~~~~~~	~~~~~	~~~~~~	~~~~~			
OCCUPANT LOAD -	FFPC 101 TABLE 7.3	3.1.2.	NOTE:		$\neg$	EXISTING BUILT AREA (TO BE DEMOLISHED) = 4154.5 SQFT	
USE	Mercantile Use Sales area on street floc	or		L WITH NO USE		PROPOSED ADDED AREA = 1075.0 SQFT	
(ft²/person) ^a	30		TENANT.	BE DEFINED BY		TOTAL PROPOSED AREA = 5267.0 SQFT	
(m²/person) ^a	2.8			AD TABLE AND			
			CALCULATION REFERENCE OF				
UNIT AREA	5193 SF						
OCCUPANCY ALLOWED	173 persons						
PROPERTY LIP	OFF-STREET 10'x20' LOADING ZONE	///////////////////////////////////////	///////////////////////////////////////	///////////////////////////////////////			/////////////////////////////
PROPERTY LINE 5'-0" SB					EXISTING TENANT 108'-5" SITE PLAN SCALE 1/8" = 1'-0		







# ELEVATION CERTIFICATE NOTES:

- 1. UPON PLACEMENT OF THE LOWEST FLOOR AND PRIOR TO FURTHER VERTICAL CONSTRUCTION, THE GC SHALL SUBMIT AN "ELEVATION CERTIFICATE" PER FBC 2014, BUILDING - SECTION 110.3.3., & A FLOOD-PROOFING CERTIFICATE FOR BUILDING UNDER CONSTRUCTION.
- 2. THE GC SHALL SUBMIT A FINAL "ELEVATION CERTIFICATE" FOR FINISHED CONSTRUCTION PRIOR TO ISSUE OF ANY C.O., T.C.O., OR BUILDING FINAL INSPECTION.

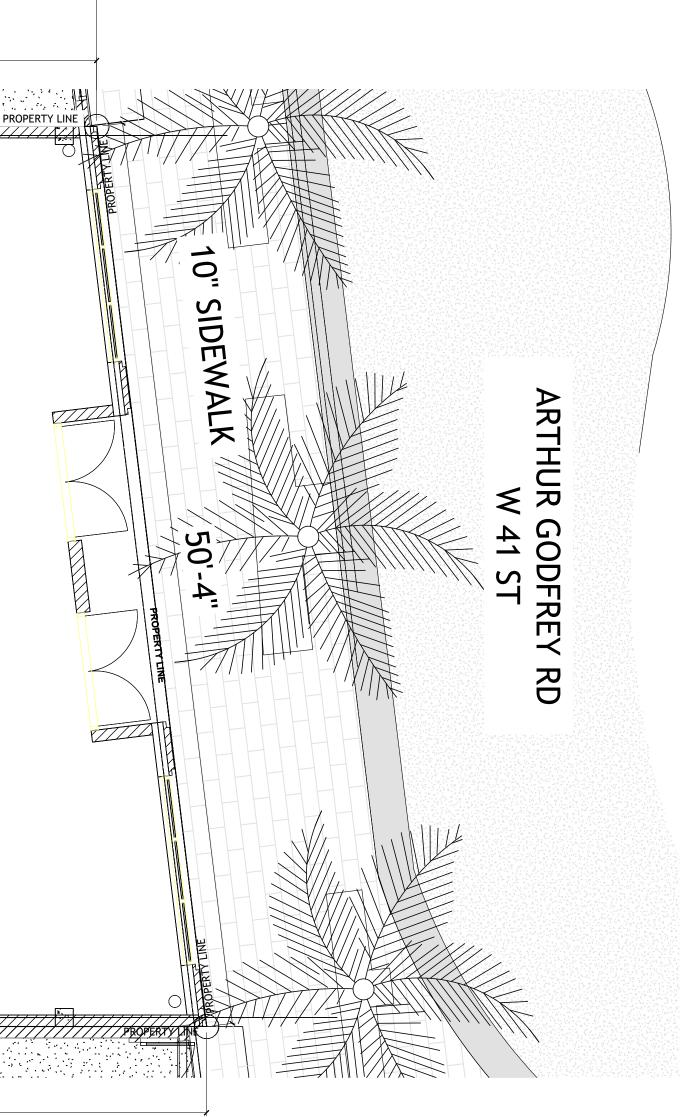

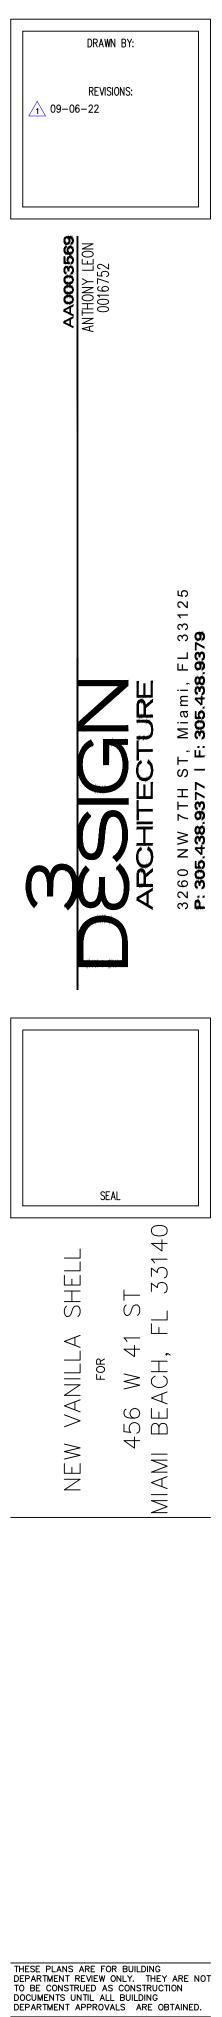




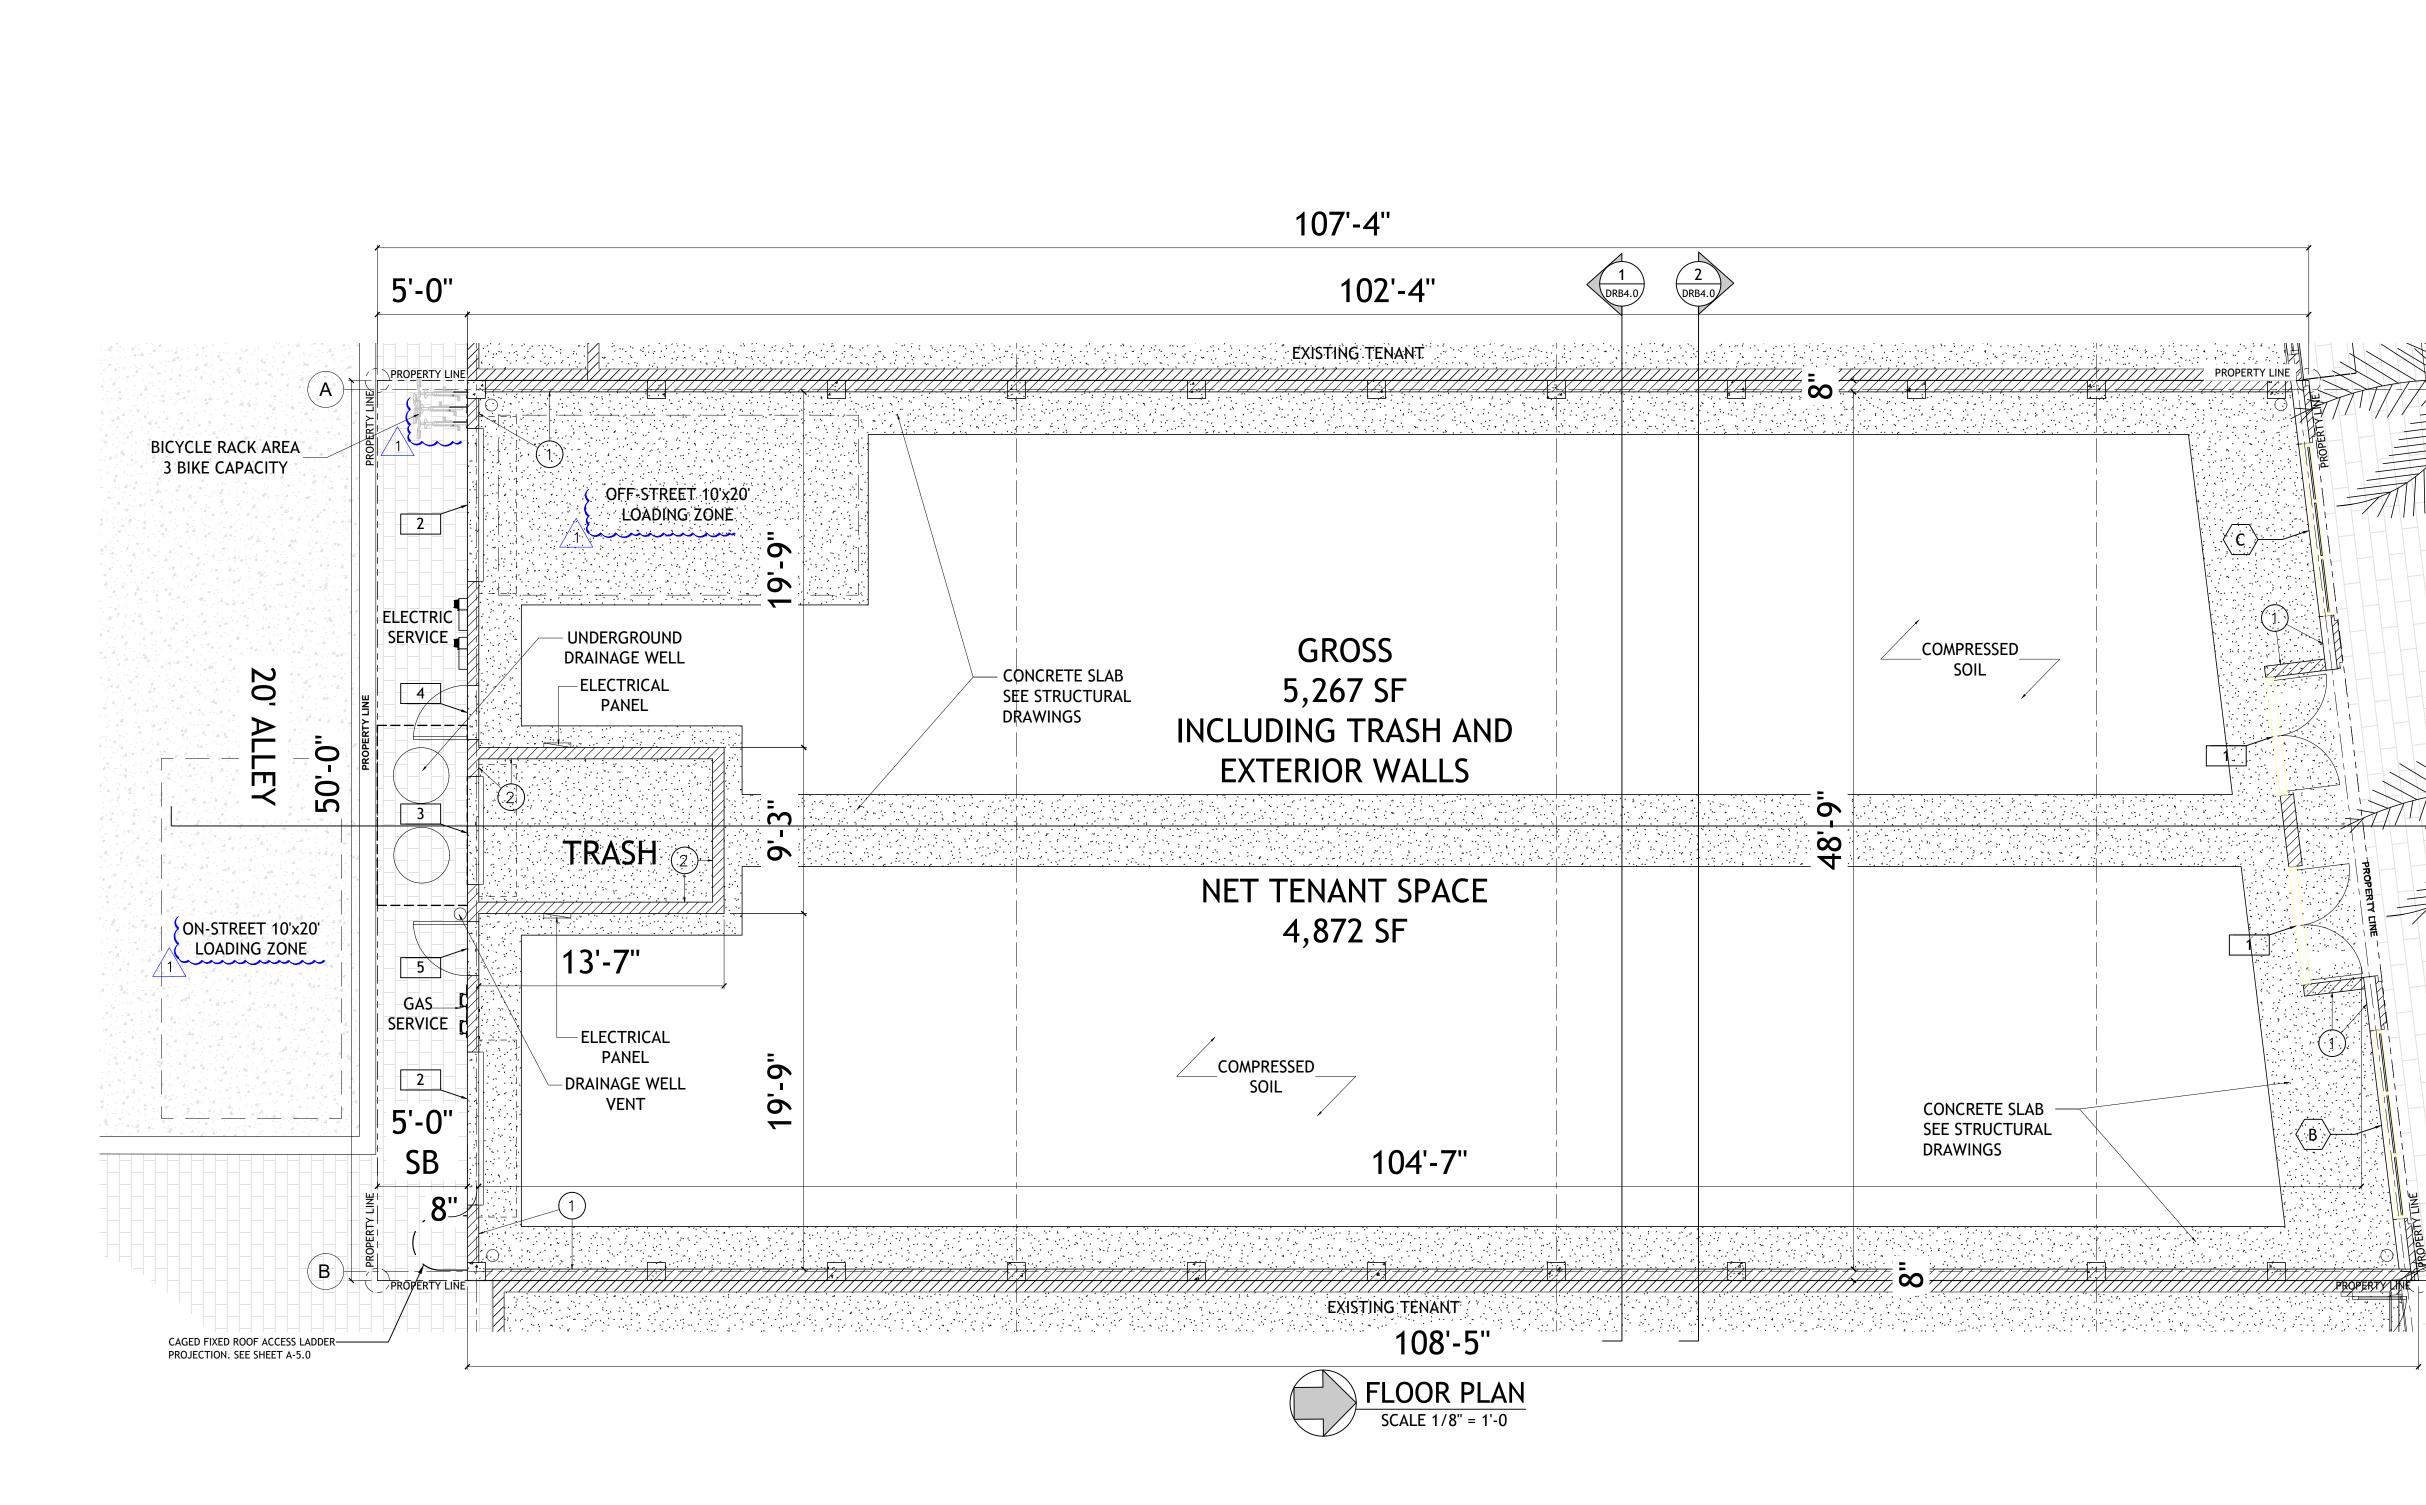









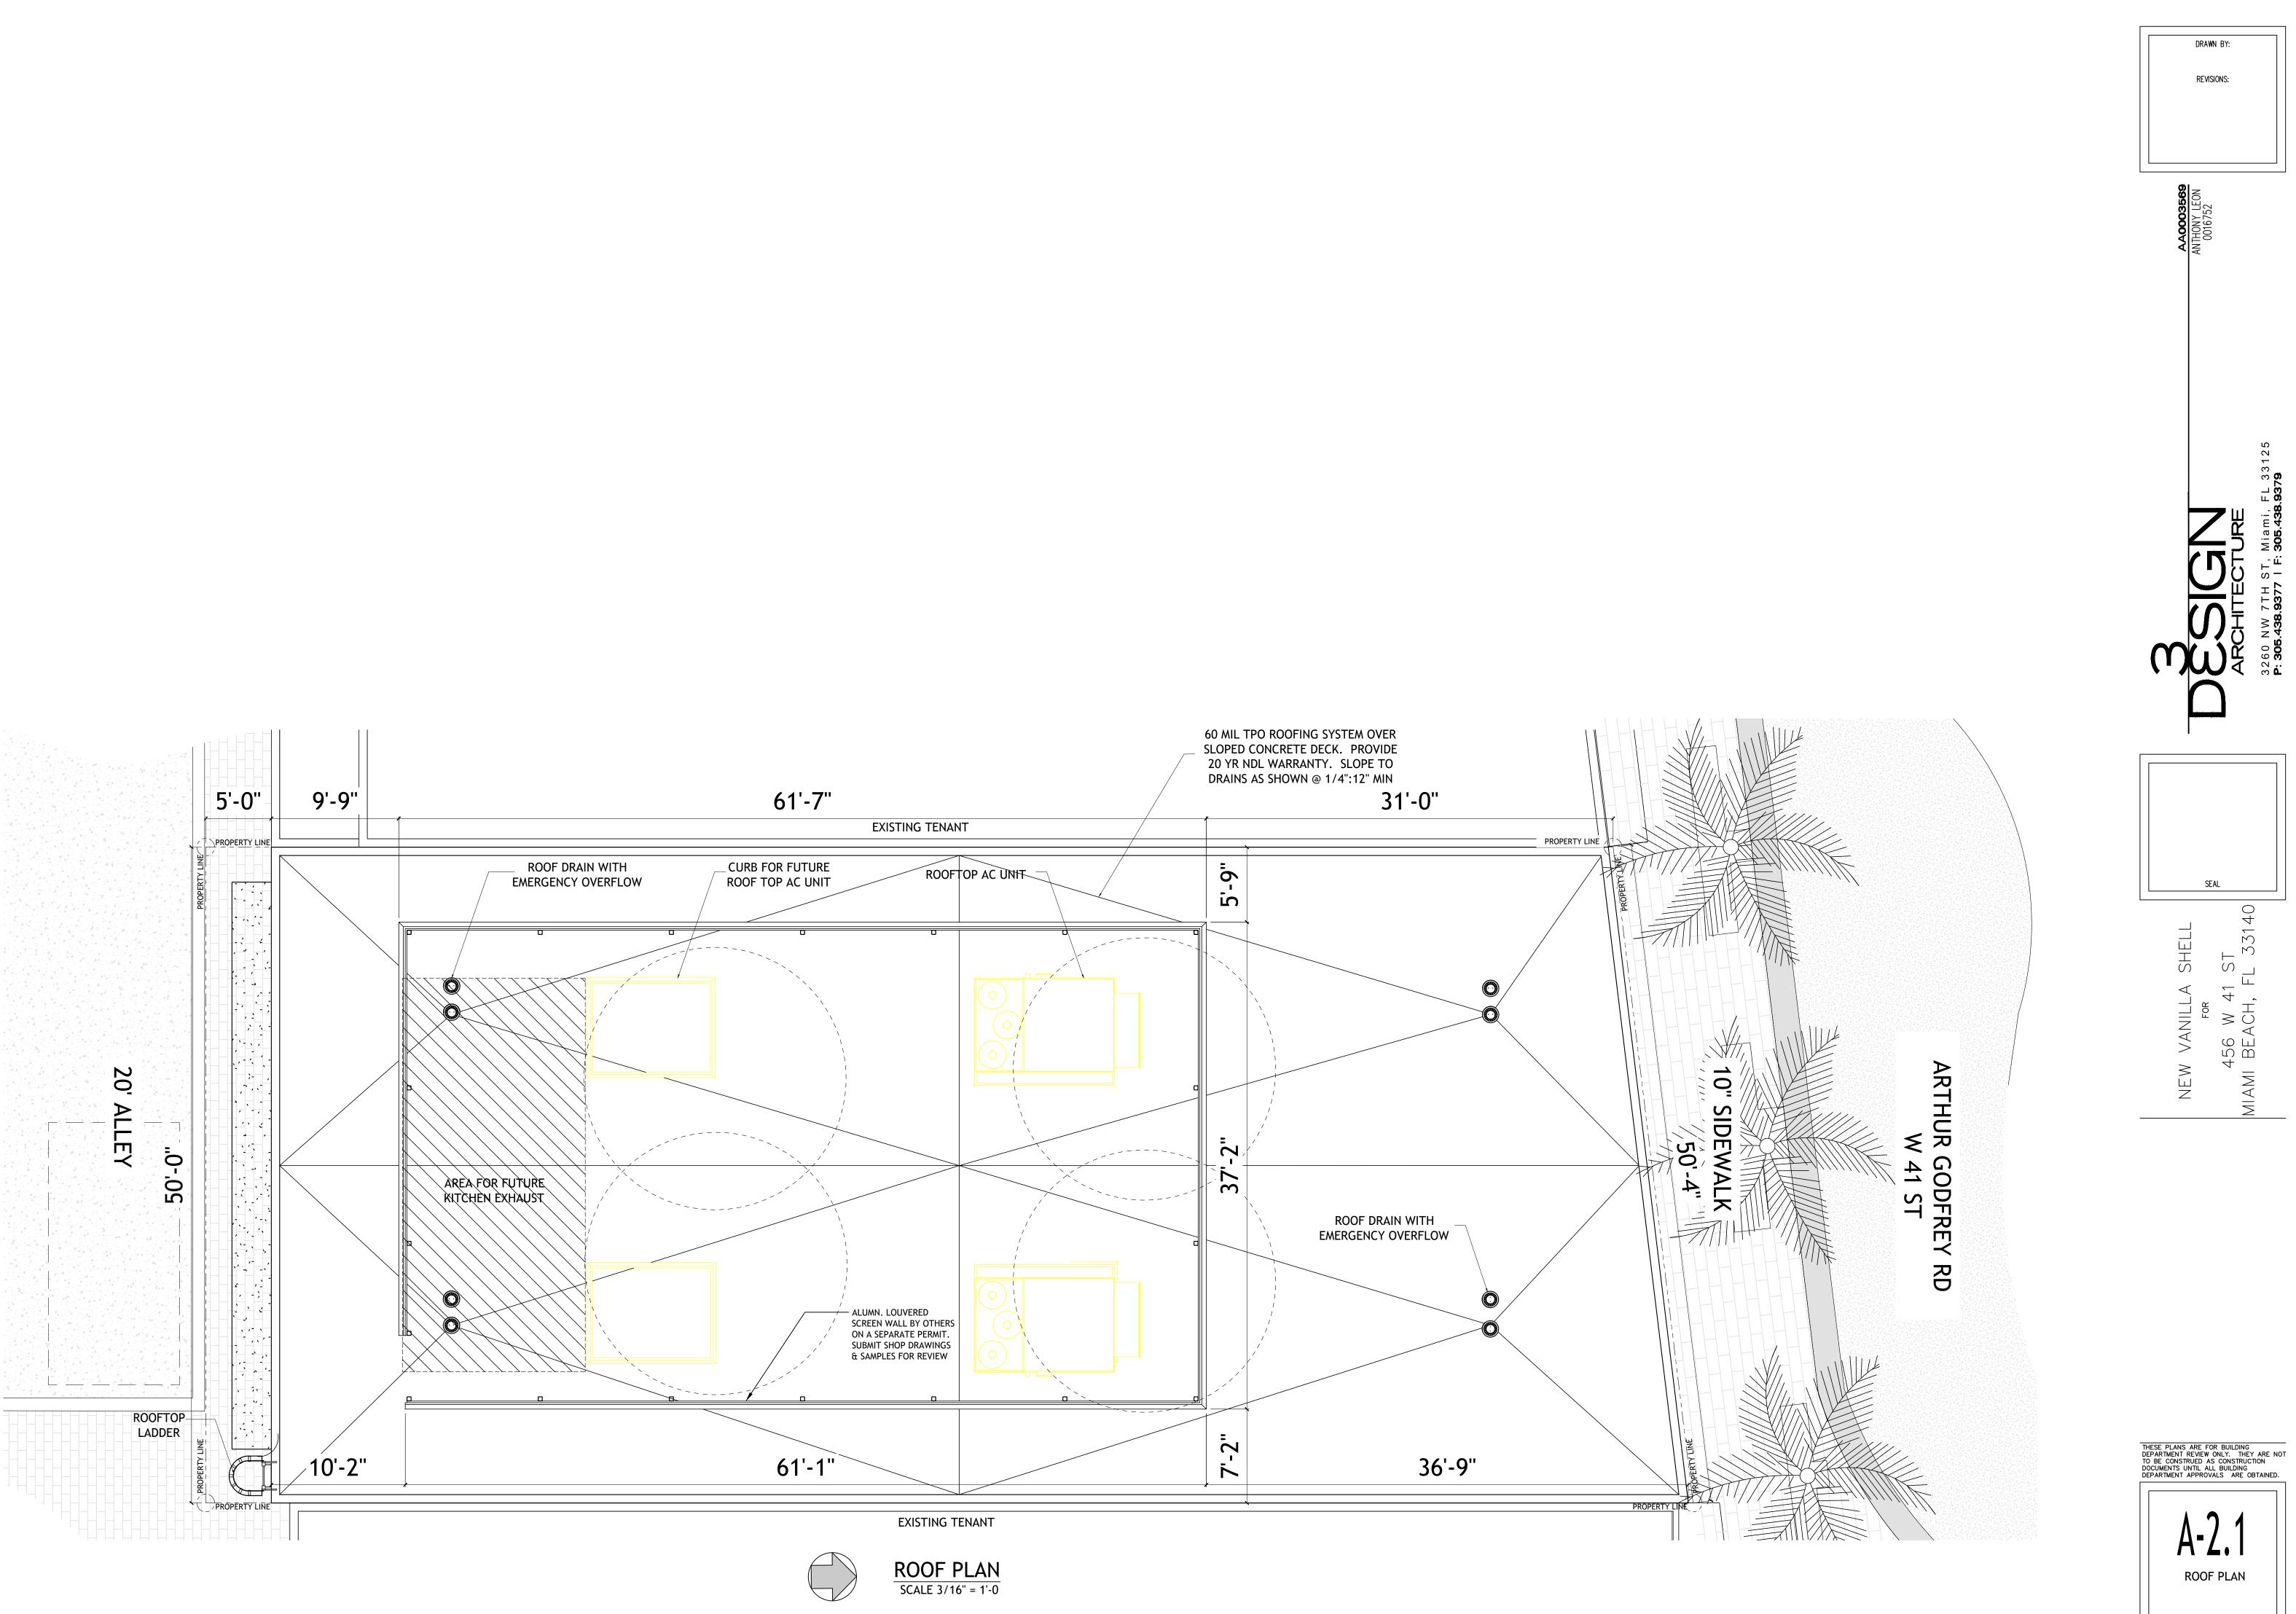



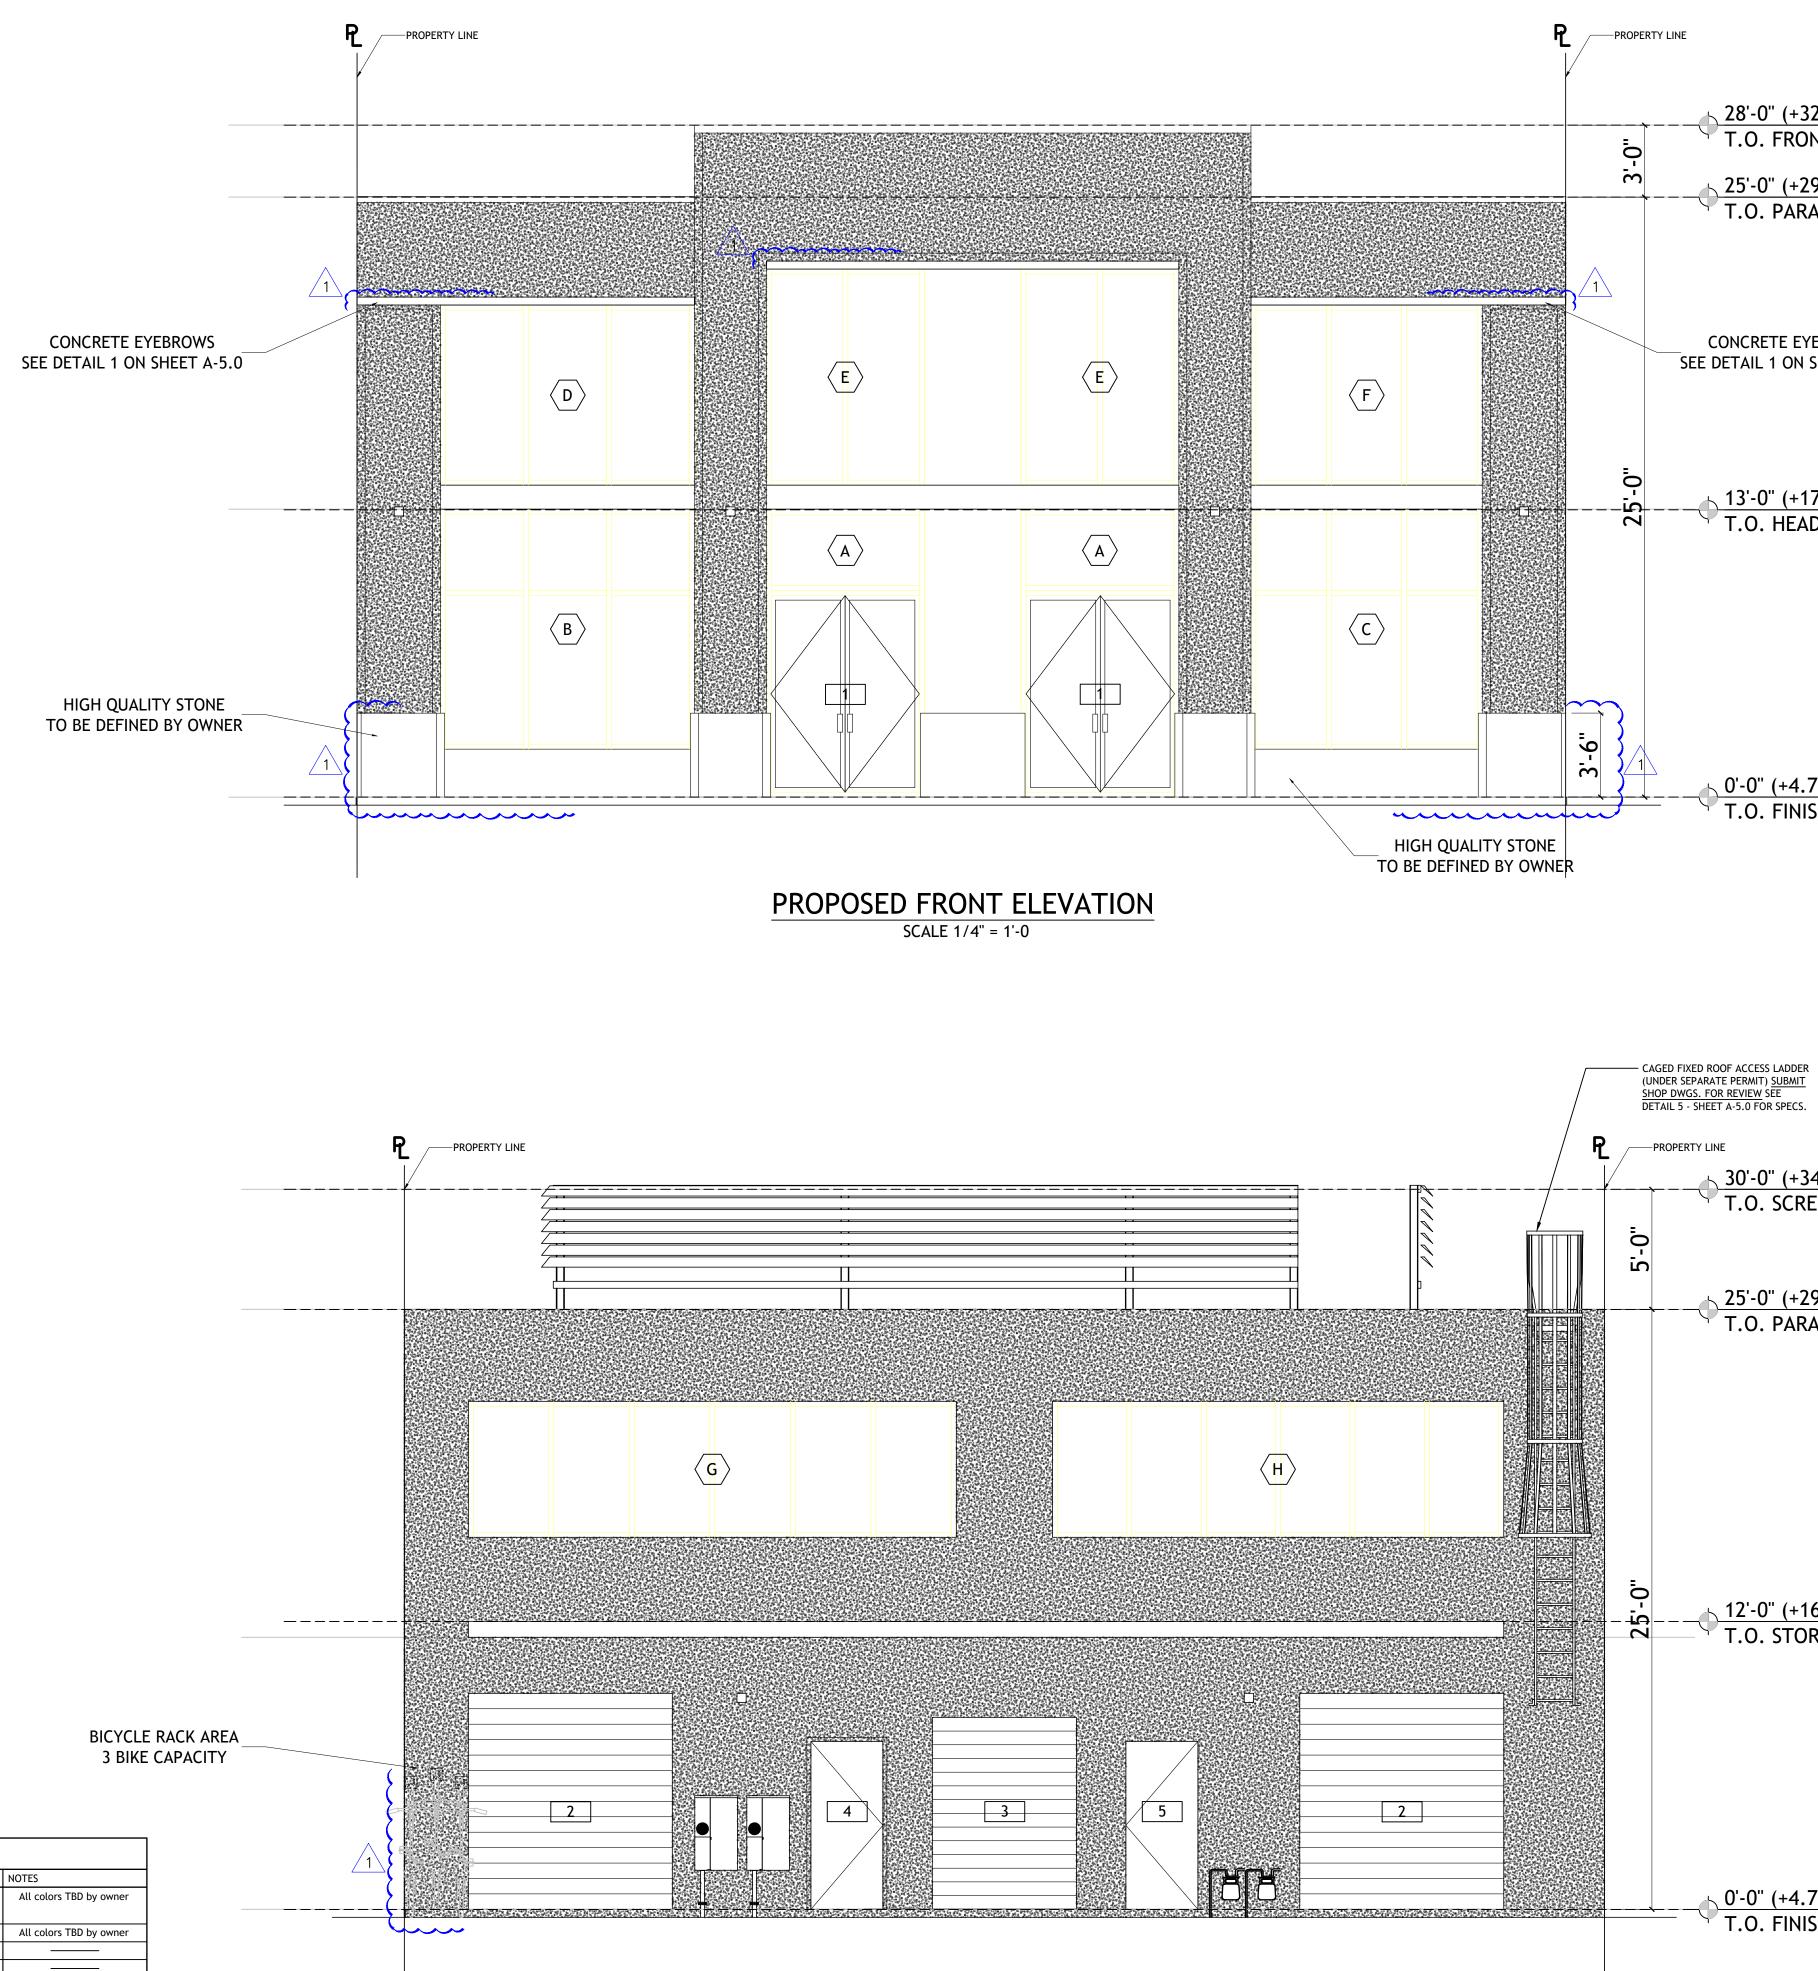

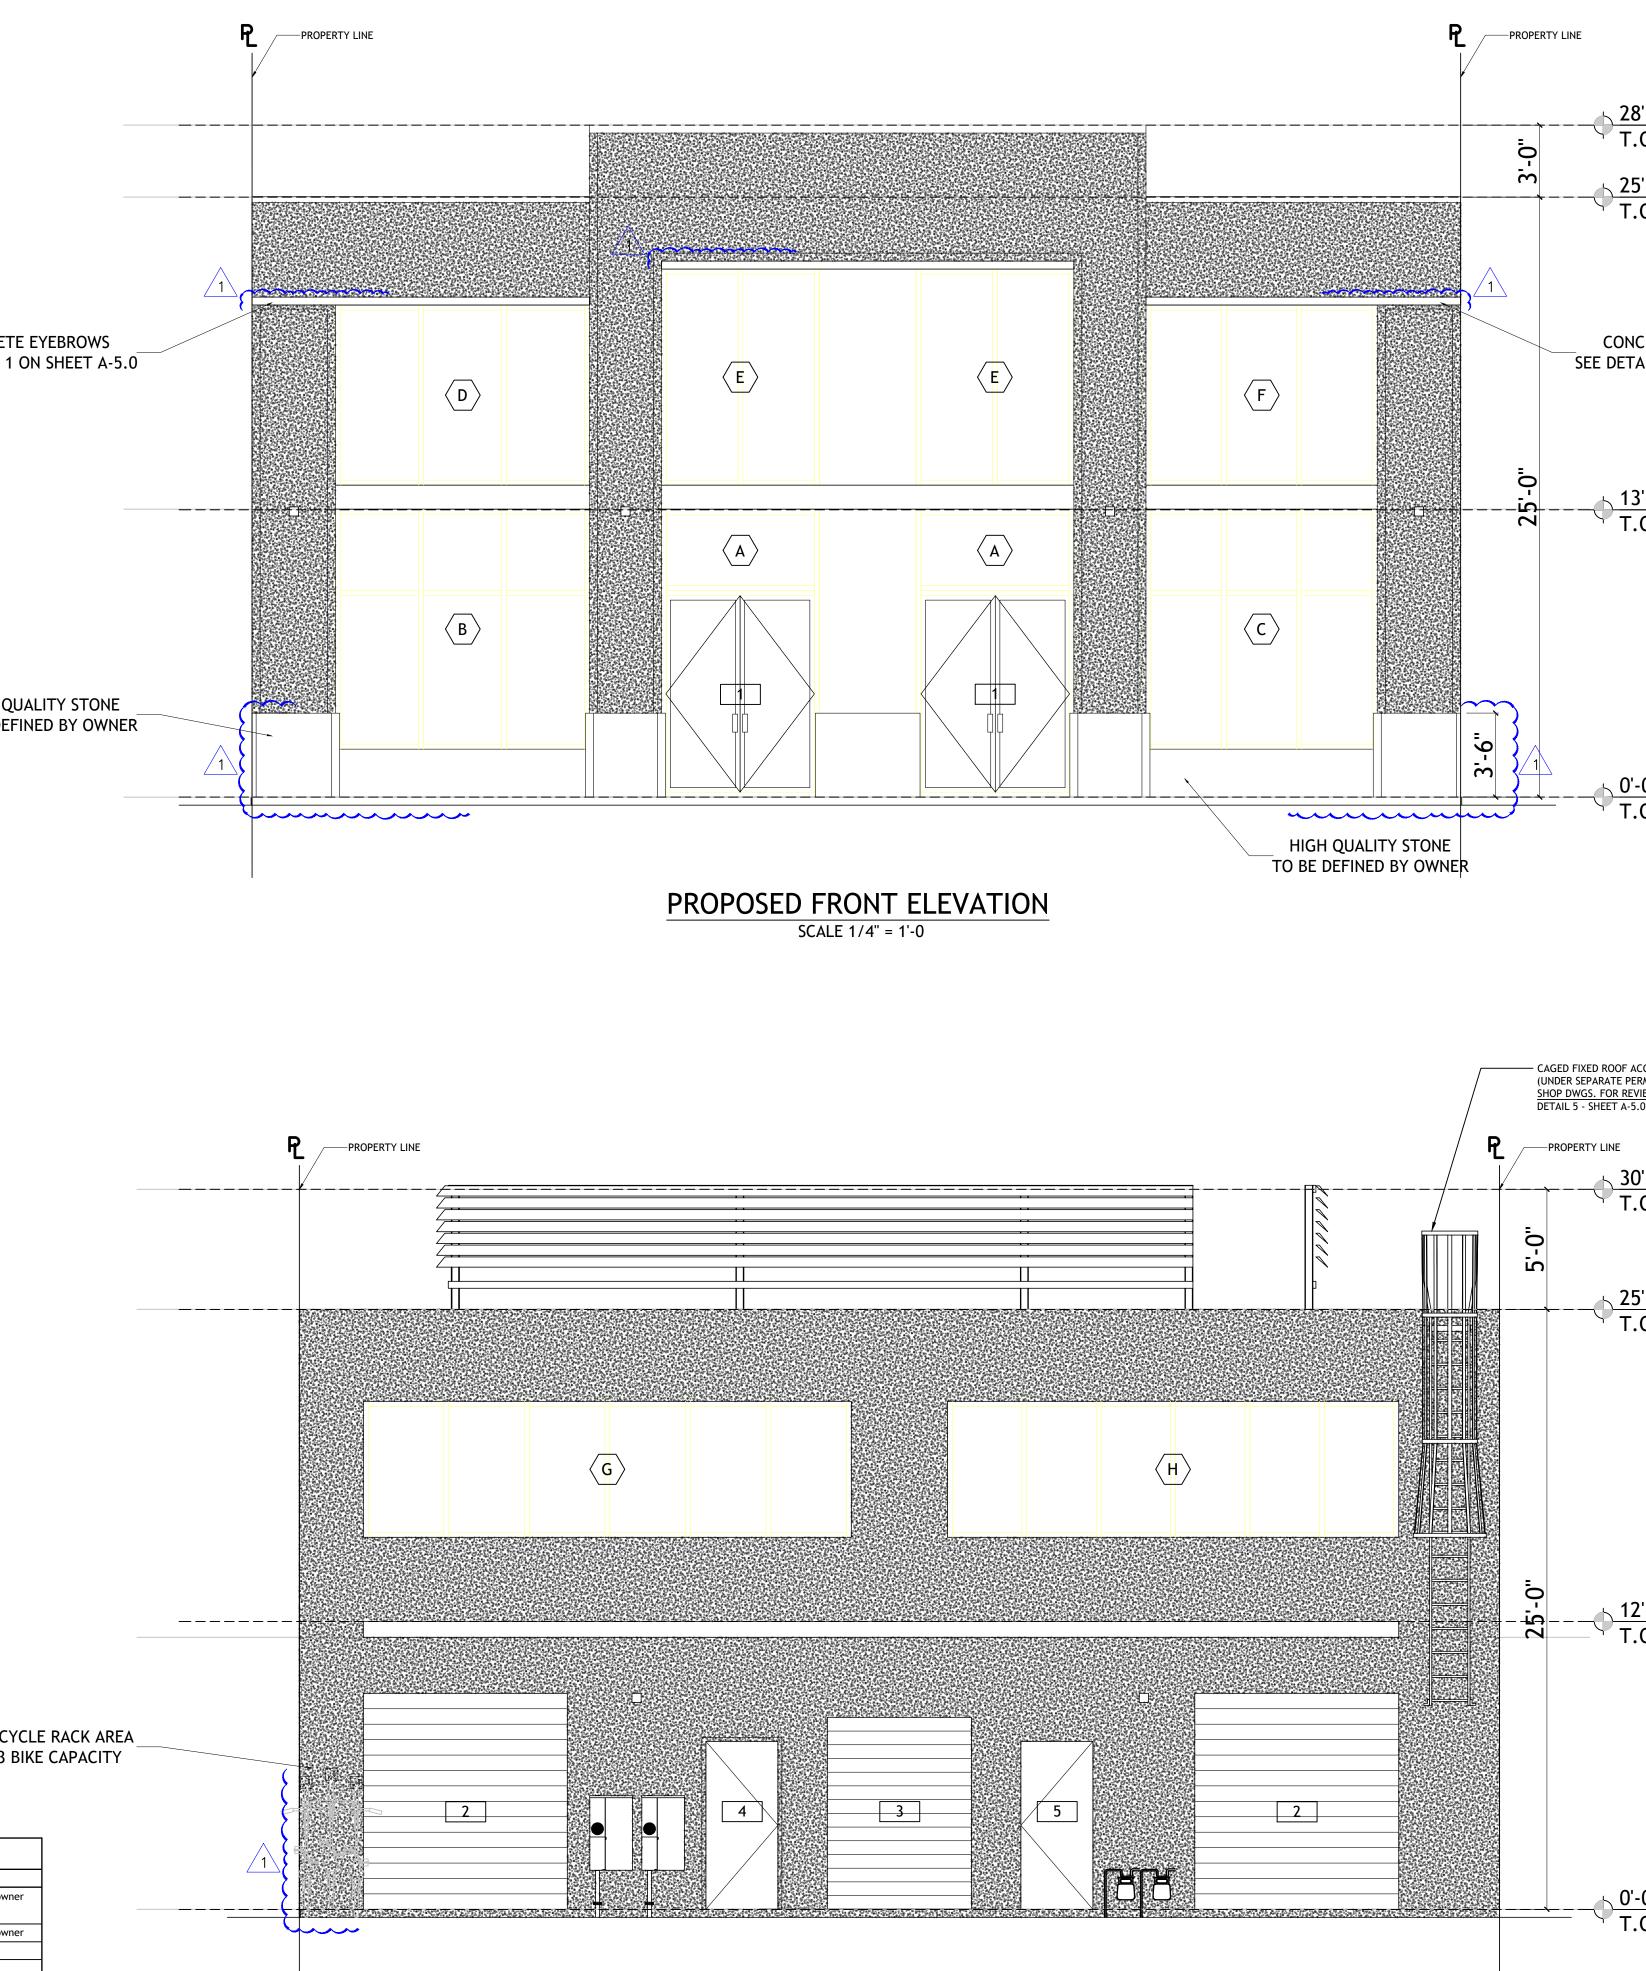

DRY FLOOD-PROOFING NOTE: FLOOD BARRIERS & WATERPROOF COATINGS ARE NOT SHOWN HERE FOR CLARITY. SEE "FLOOD-PROOFING PLAN, NOTES, & DETAILS" SHEET A-1.3 FOR COMPLETE LAYOUT.

EXTERIOR FINIS				
ELEVATION / FACADE	WALLS	DOORS	WINDOWS	NOTES
NORTH (FRONT)	STUCCO (PAINTED)	Storefront (Anodized Alumn.)	Storefront (Anodized Alumn.)	All colors TBD by owner
SOUTH (REAR)	STUCCO (PAINTED)	H.M./Steel (PAINTED)	N/A	All colors TBD by owner
EAST				
WEST				

PROPOSED REAR ELEVATION SCALE 1/4" = 1'-0

<u>28'-0" (+32.72' NGVD)</u> T.O. FRONT PARAPET

<u>25'-0" (+29.72 NGVD)</u> T.O. PARAPET

CONCRETE EYEBROWS SEE DETAIL 1 ON SHEET A-5.0

> <u>13'-0" (+17.73' NGVD)</u> T.O. HEADER

T.O. FINISH FLOOR


<u>30'-0" (+34.72' NGVD)</u> T.O. SCREEN


<u>~ 25'-0" (+29.72' NGVD)</u>  $\checkmark$  T.O. PARAPET


<u>12'-0" (+16.73' NGVD)</u> T.O. STORAGE

<u>0'-0" (+4.73' NGVD)</u> T.O. FINISH FLOOR



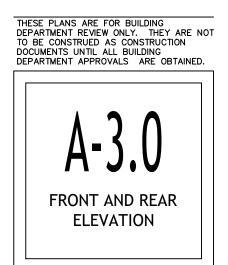

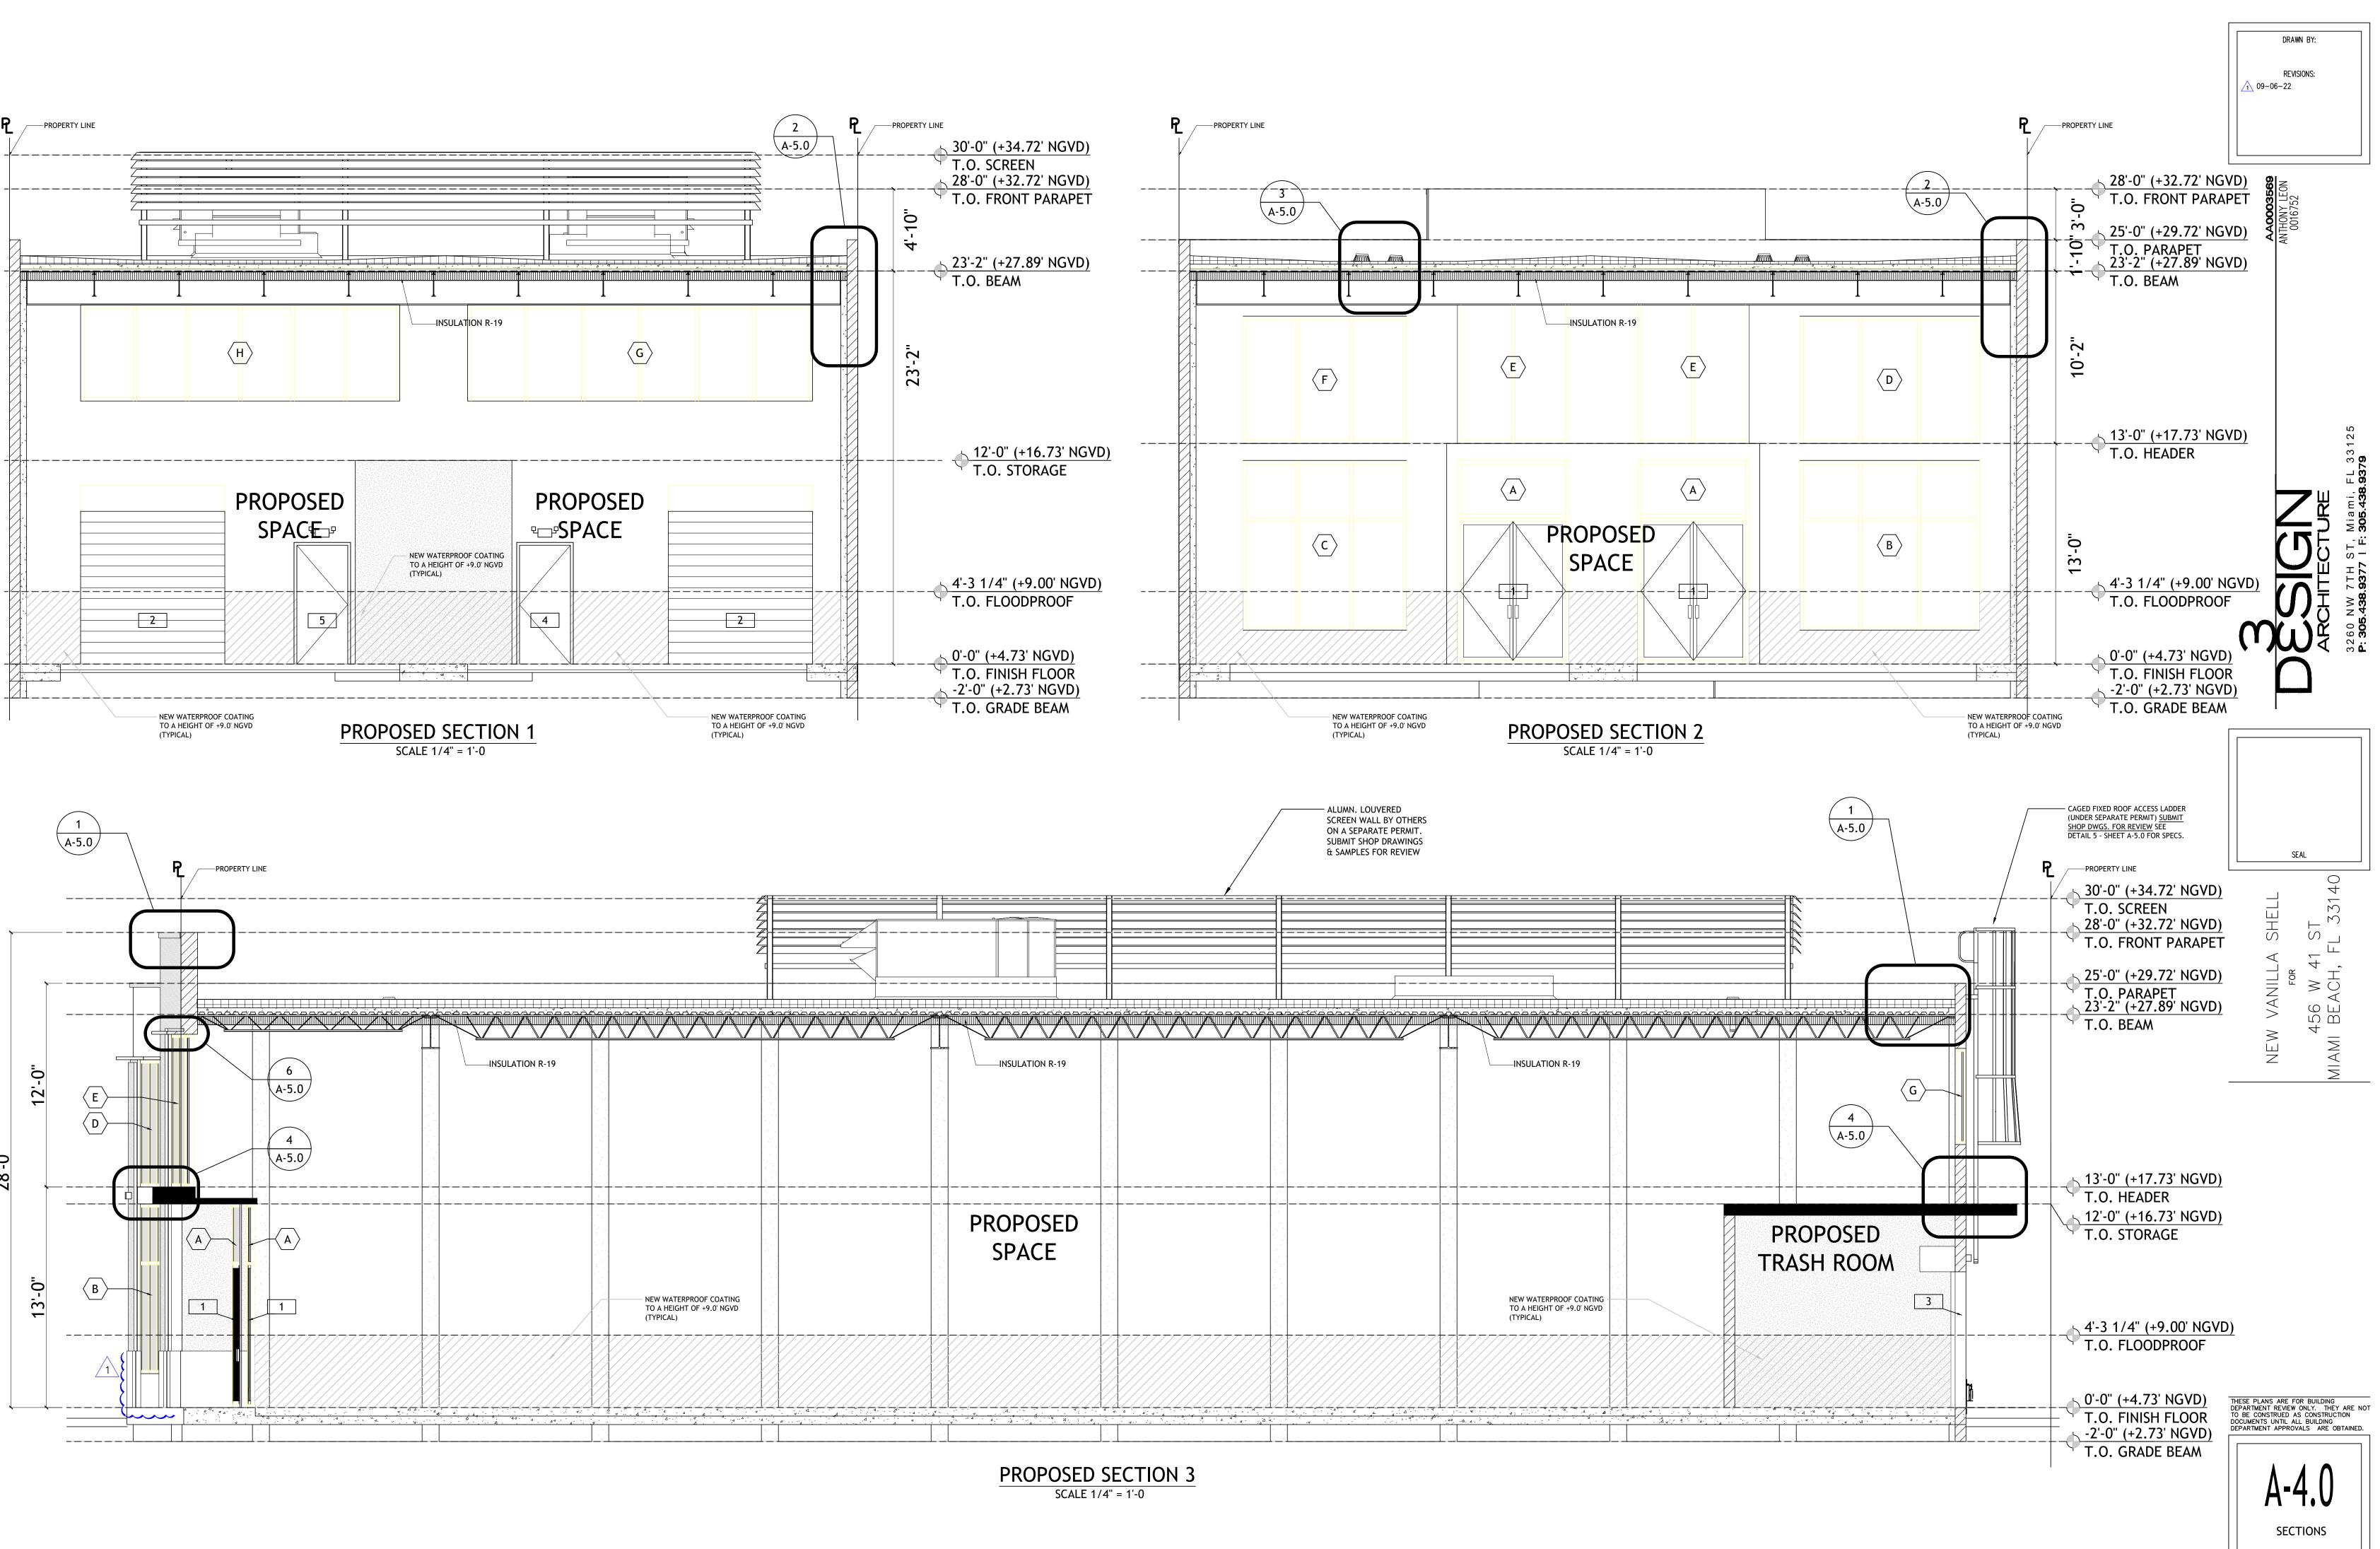

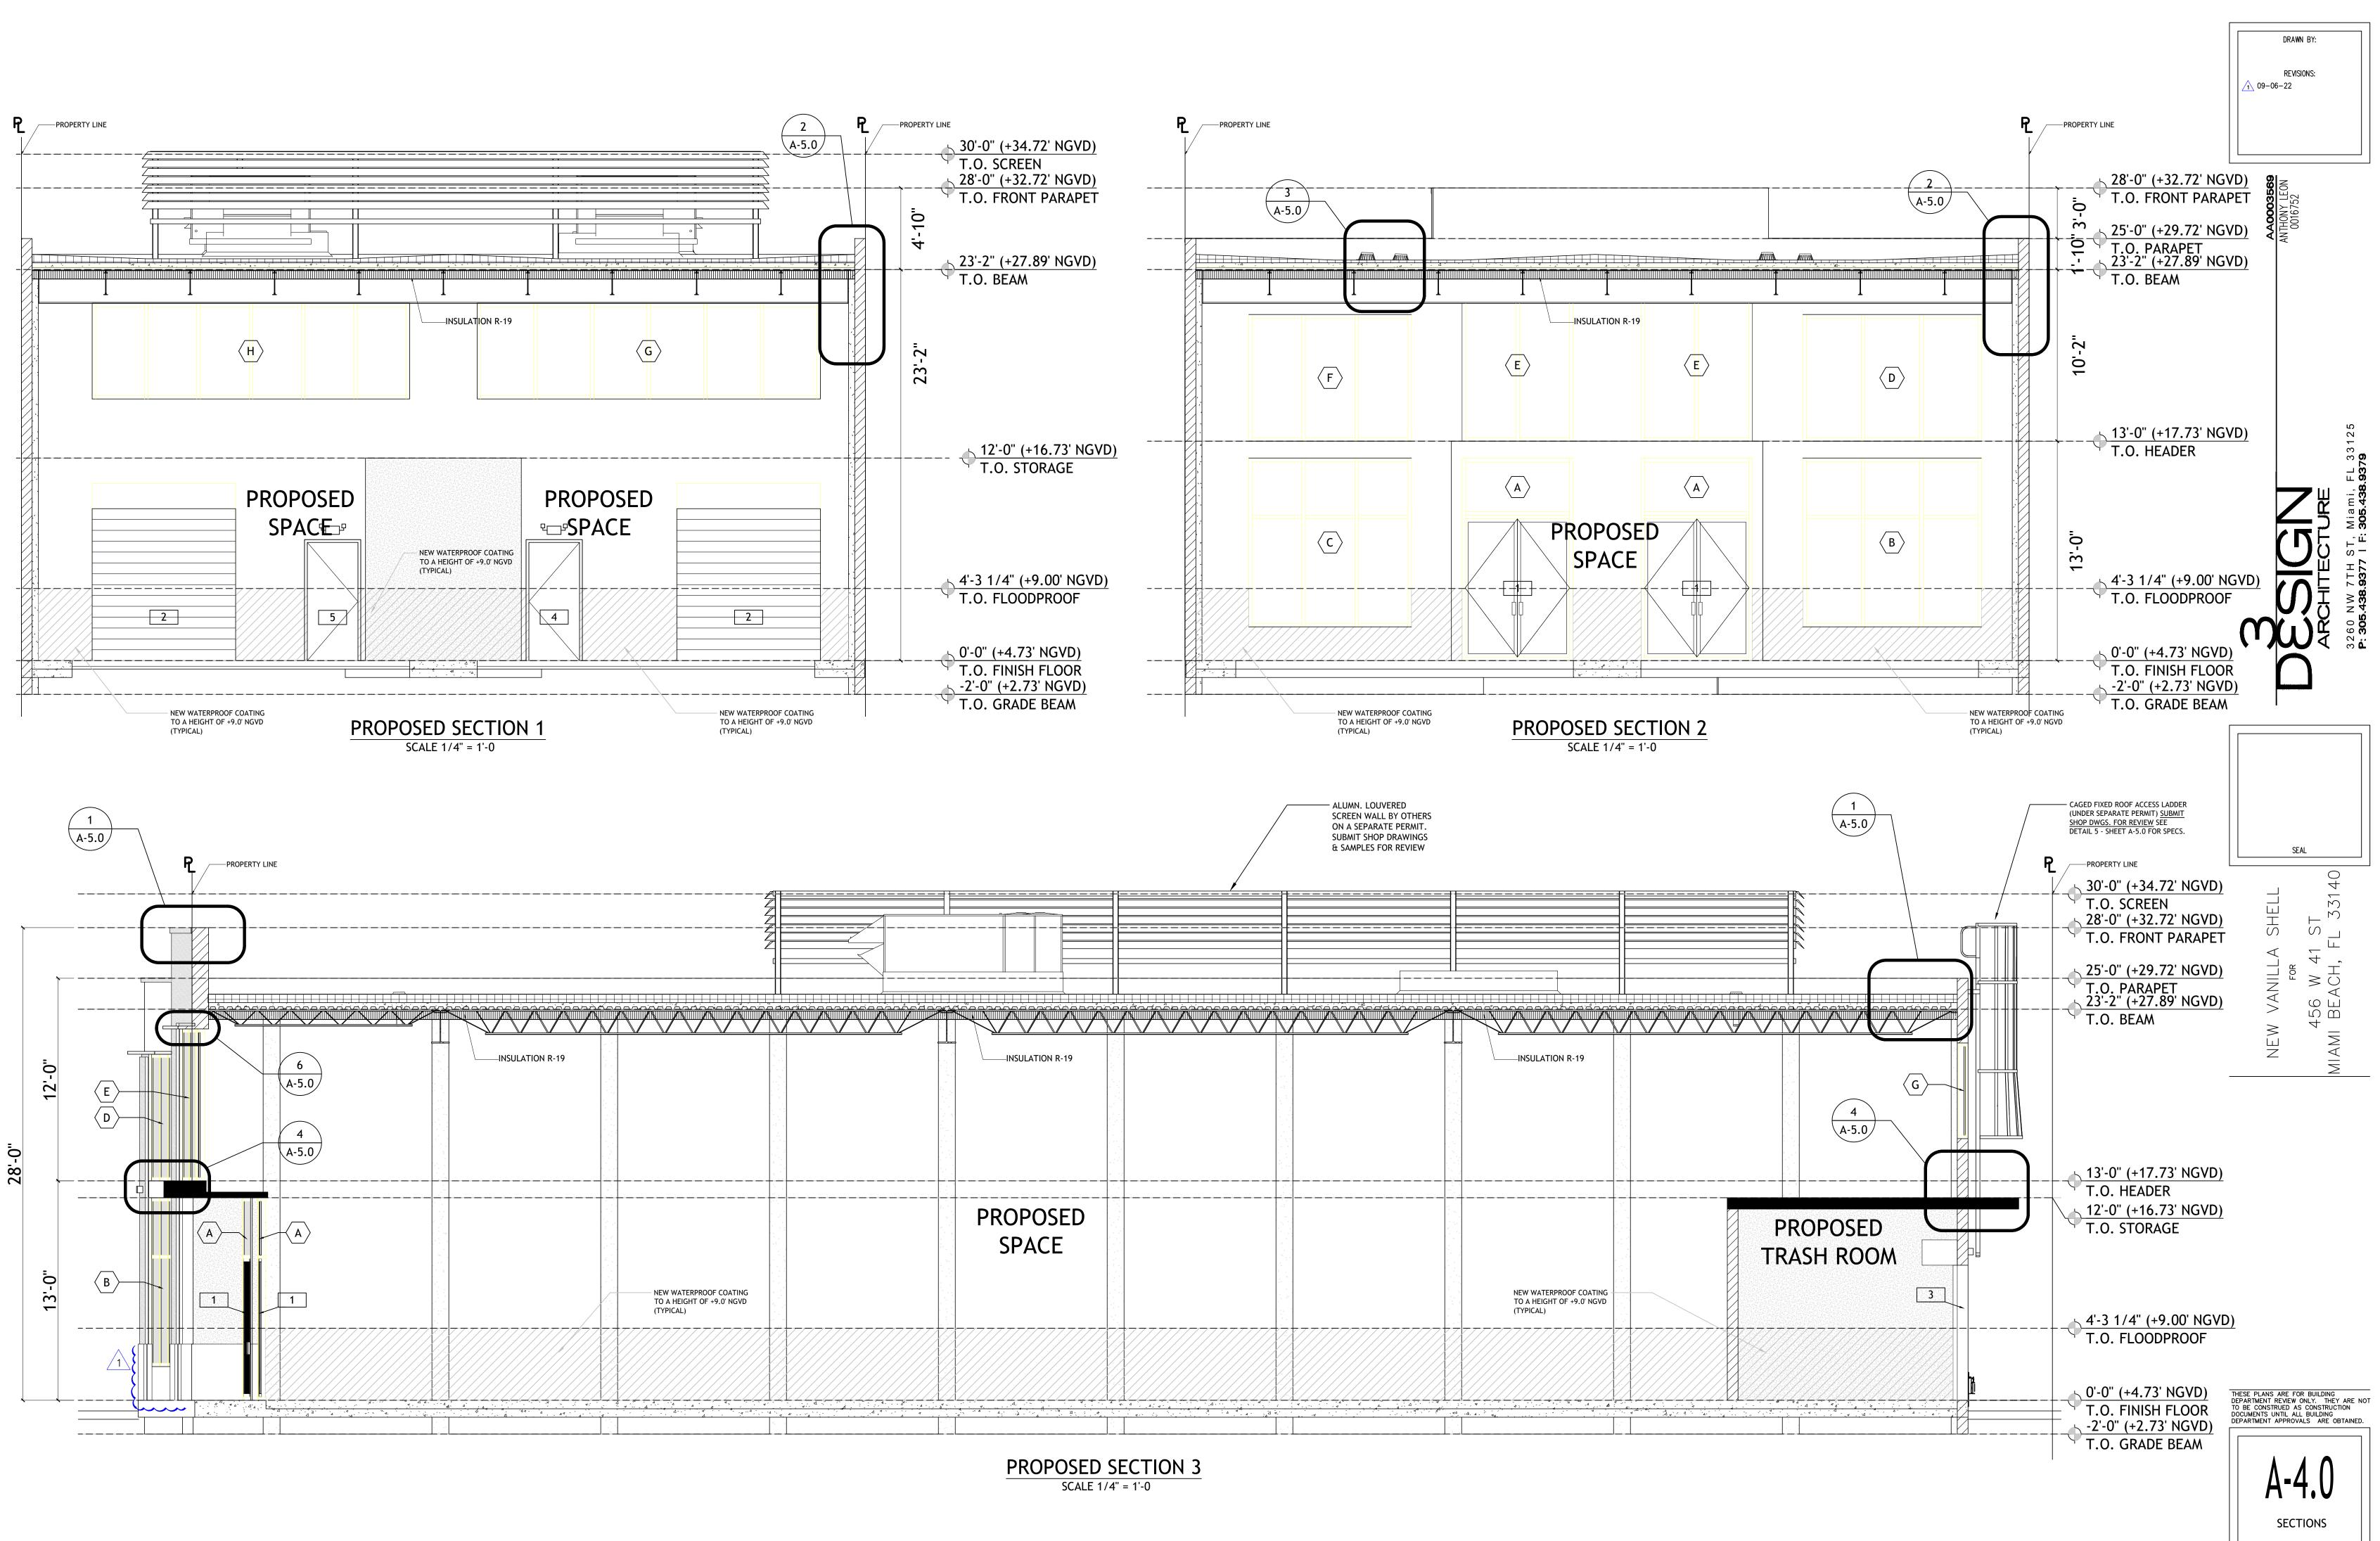





PROPOSED NORTH ELEVATION SCALE N.T.S

## PROPOSED NORTH ELEVATION SCALE N.T.S



**PROPOSED SOUTH ELEVATION** SCALE N.T.S



ARCHITECT'S CONCEPT DRAWINGS FOR ILLUSTRATIVE PURPOSES ONLY. NOT TO BE USED FOR CONSTRUCTION OR SHOP DRAWING PRODUCTION.

