




NOTE: DO NOT SCALE DRAWINGS FOR CONSTRUCTION.

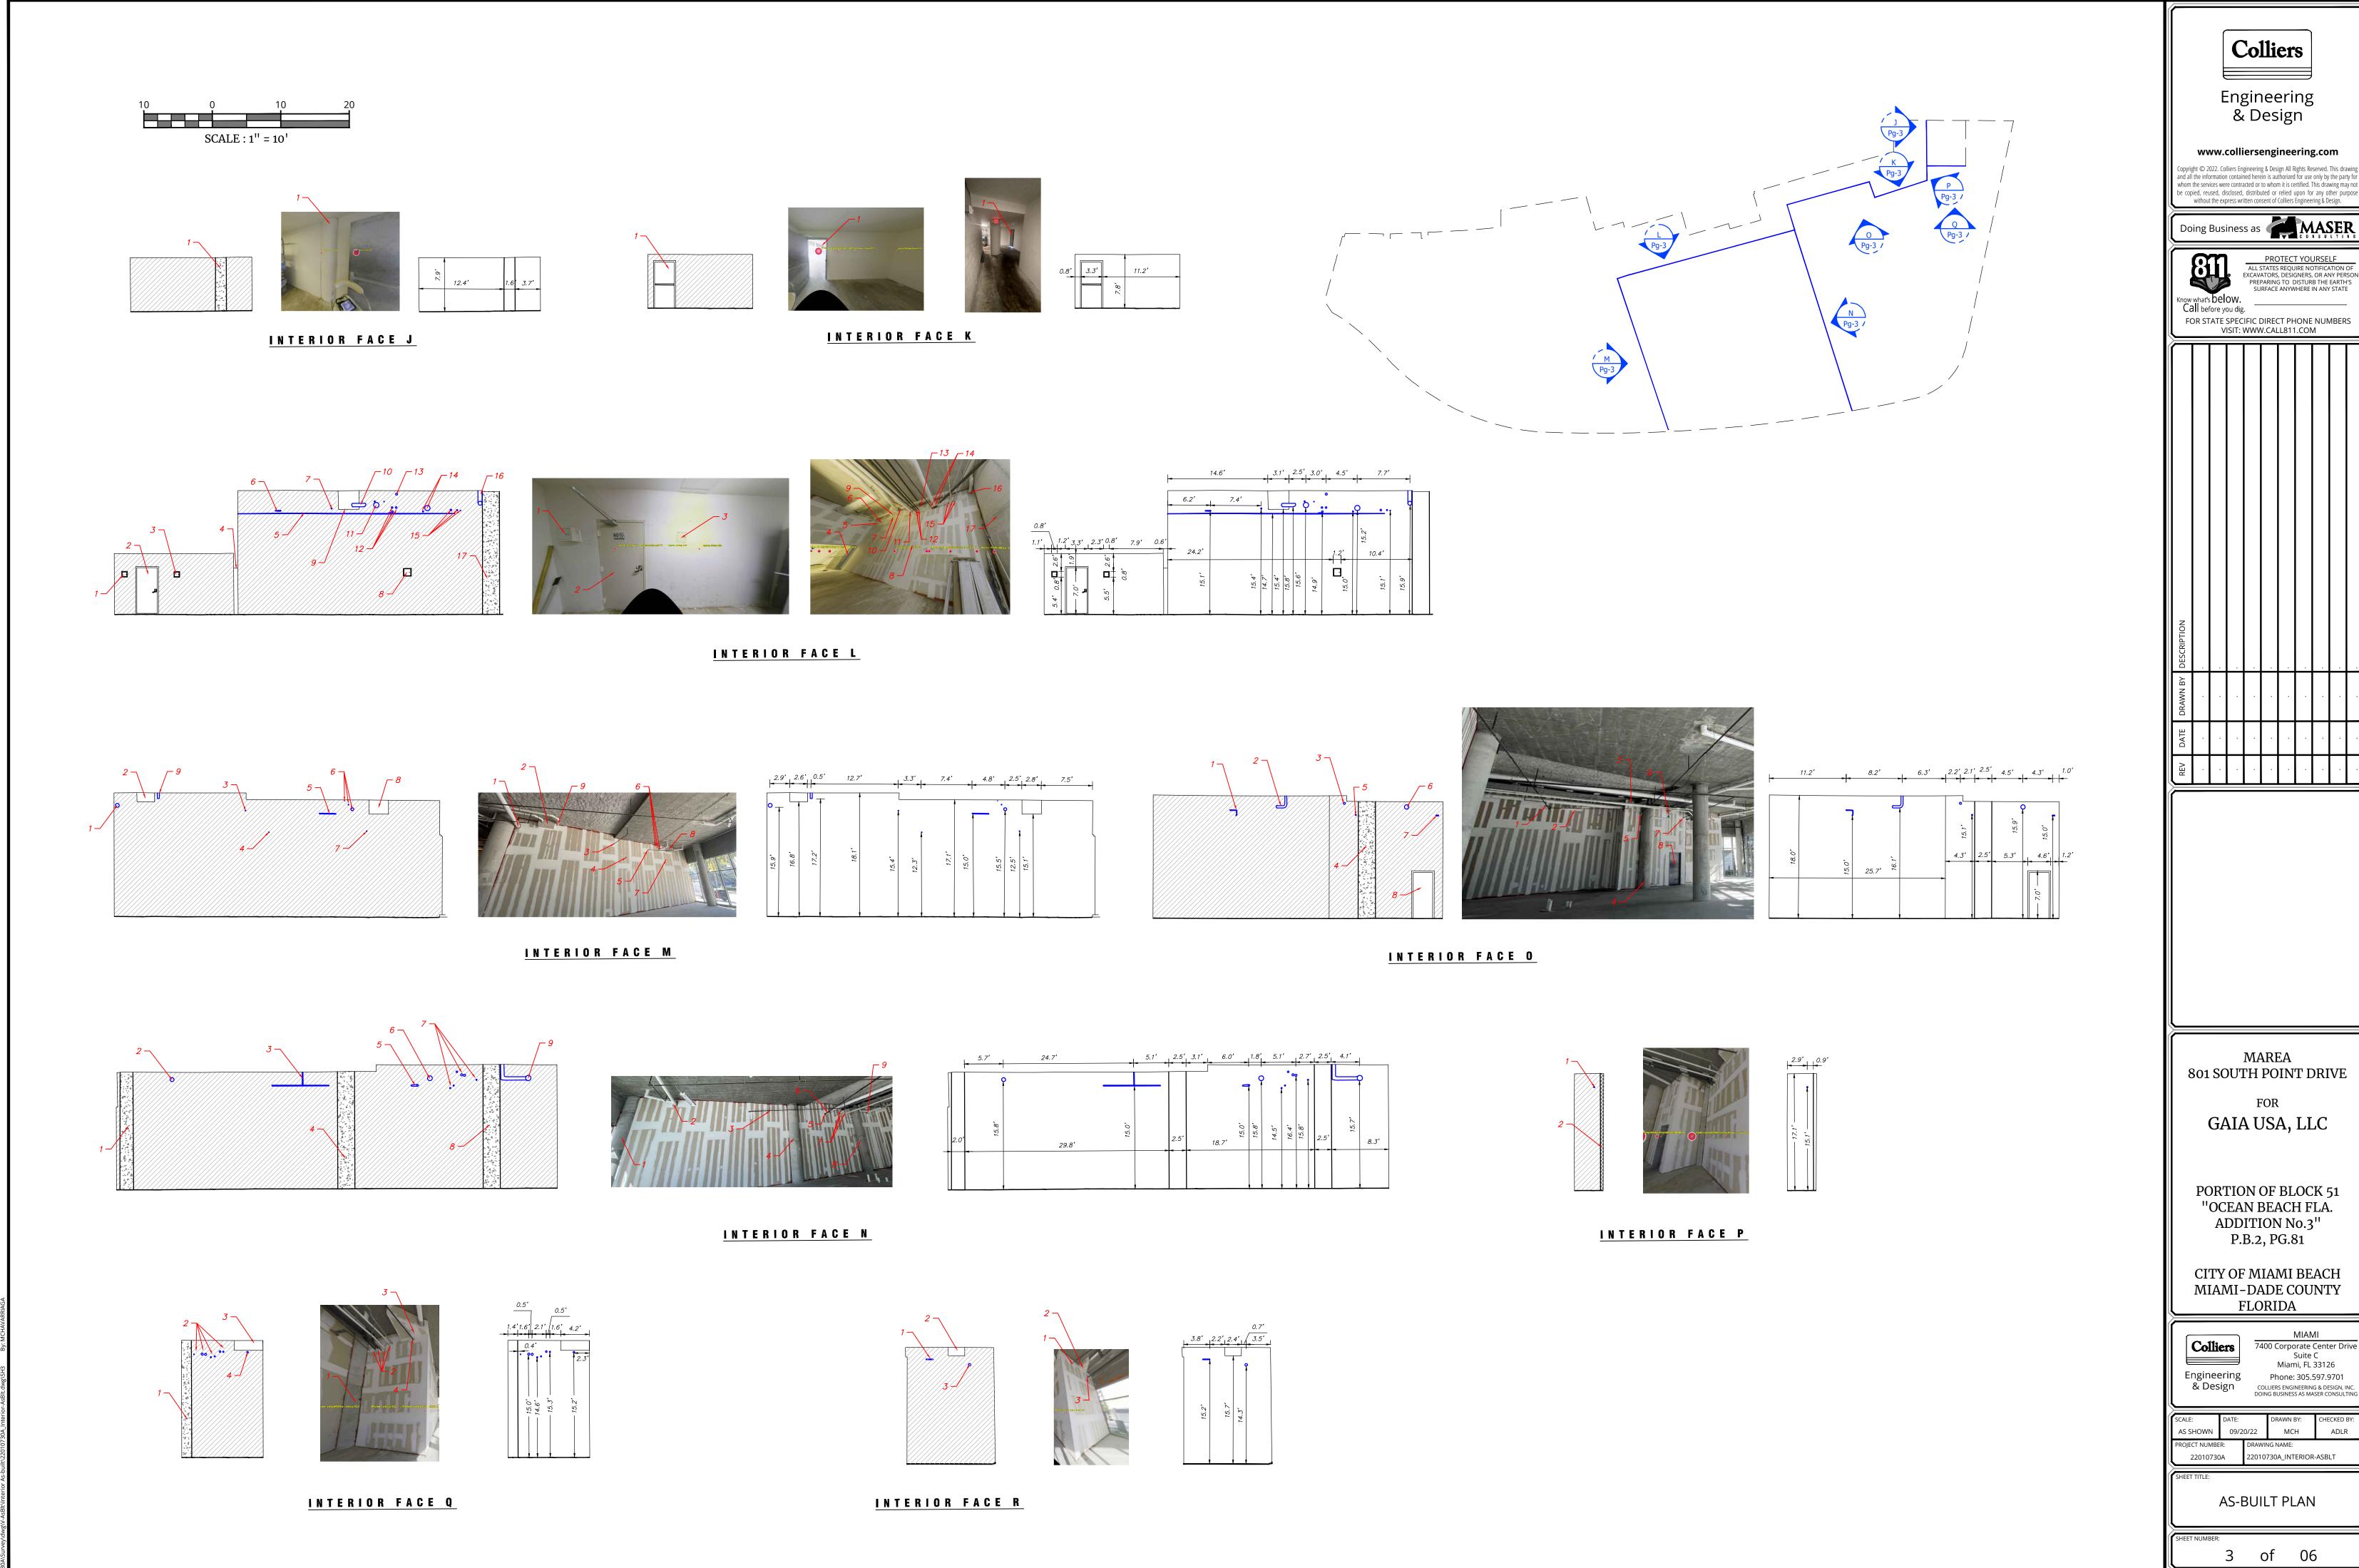


NOTE: DO NOT SCALE DRAWINGS FOR CONSTRUCTION.

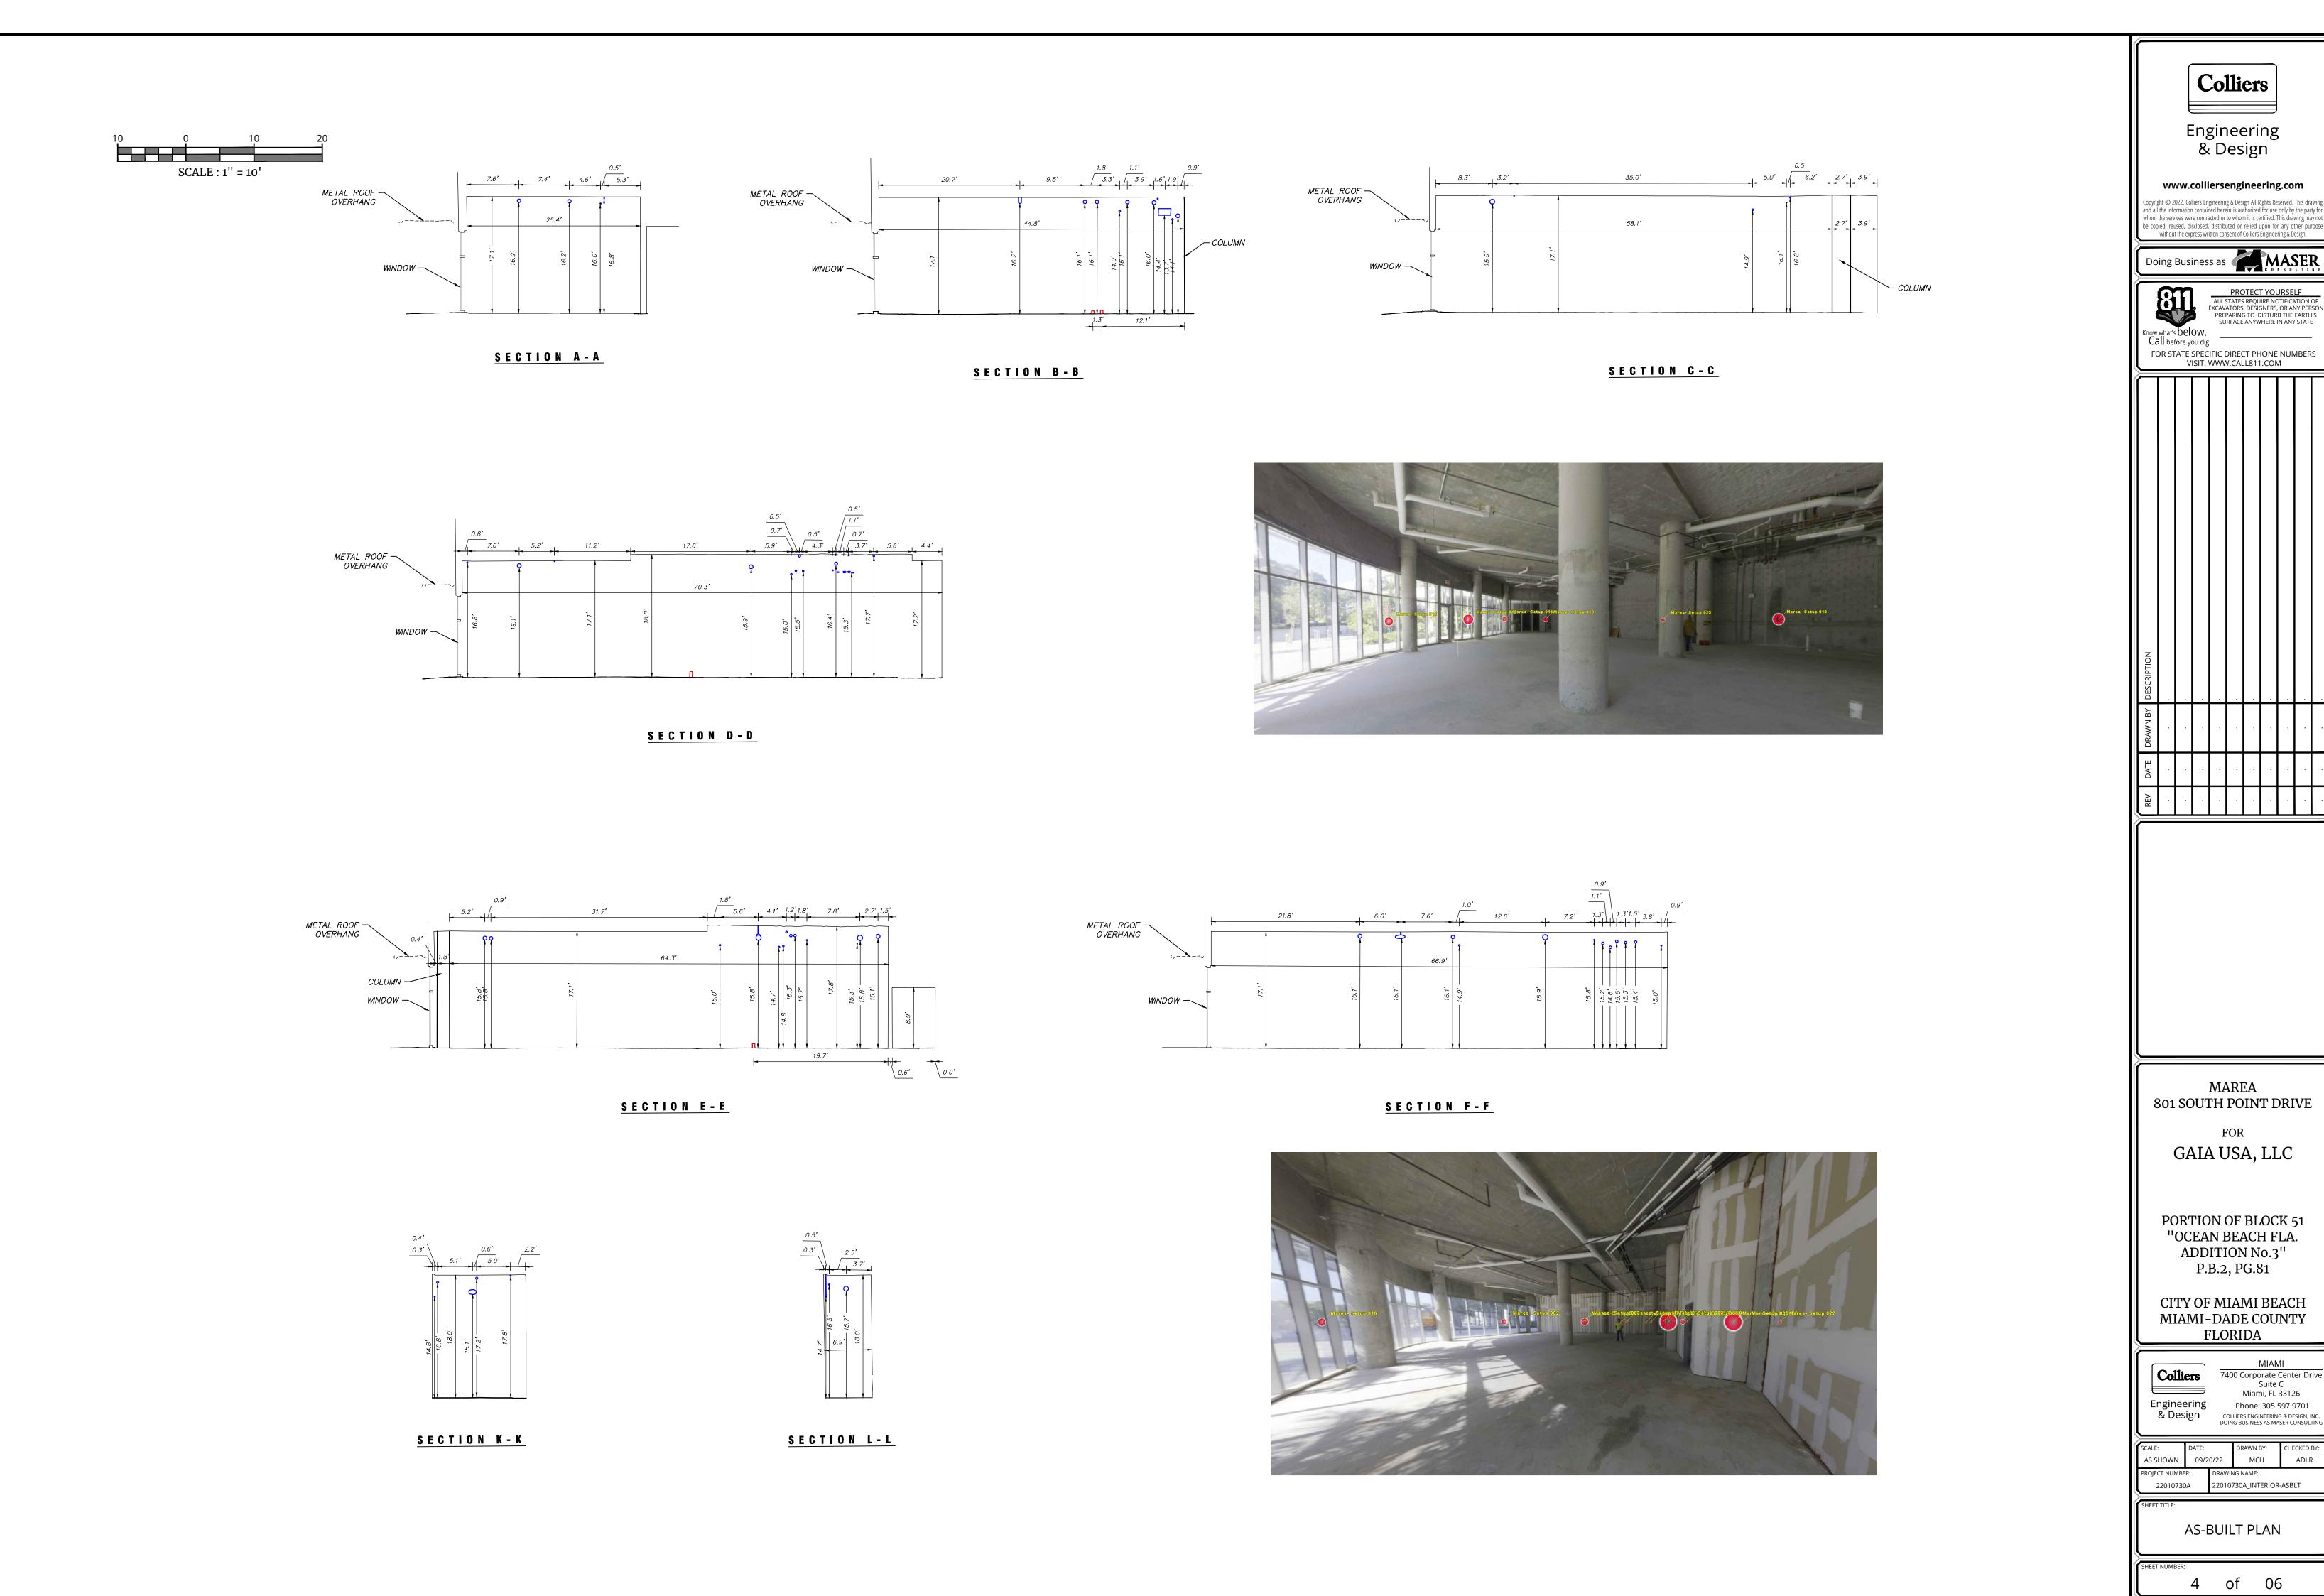


NOTE: DO NOT SCALE DRAWINGS FOR CONSTRUCTION.

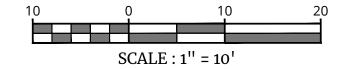


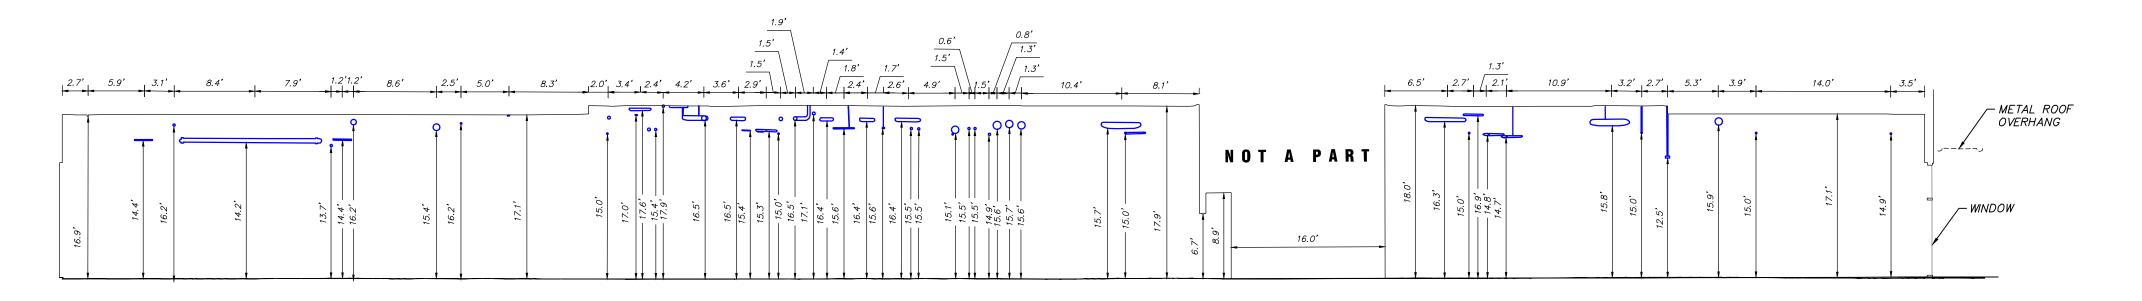

SECTION G-G

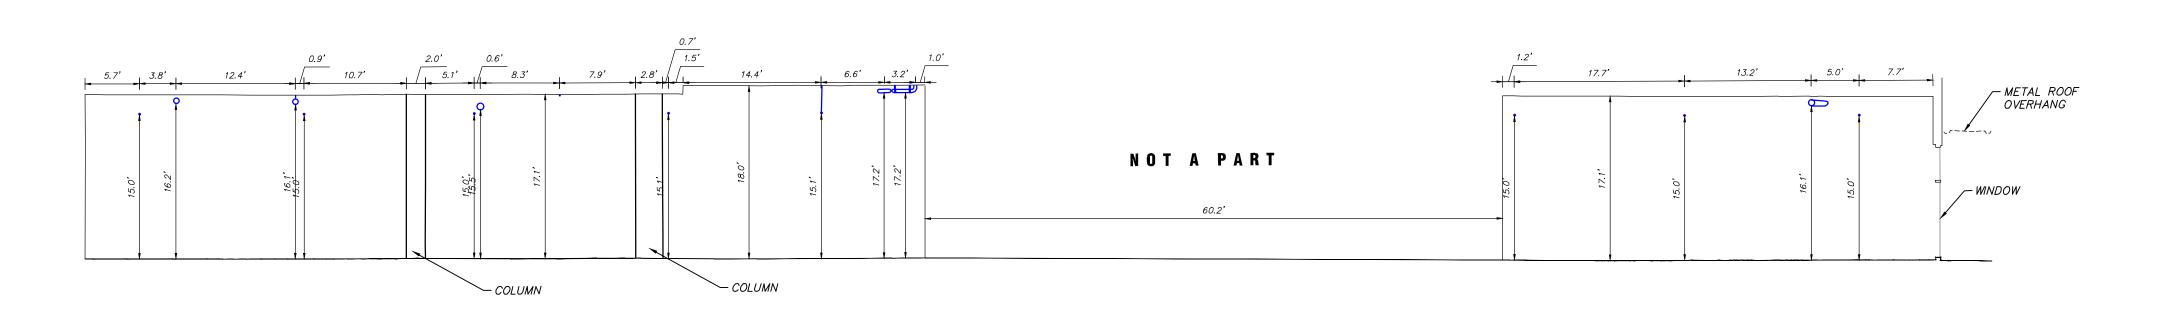

SECTION H-H

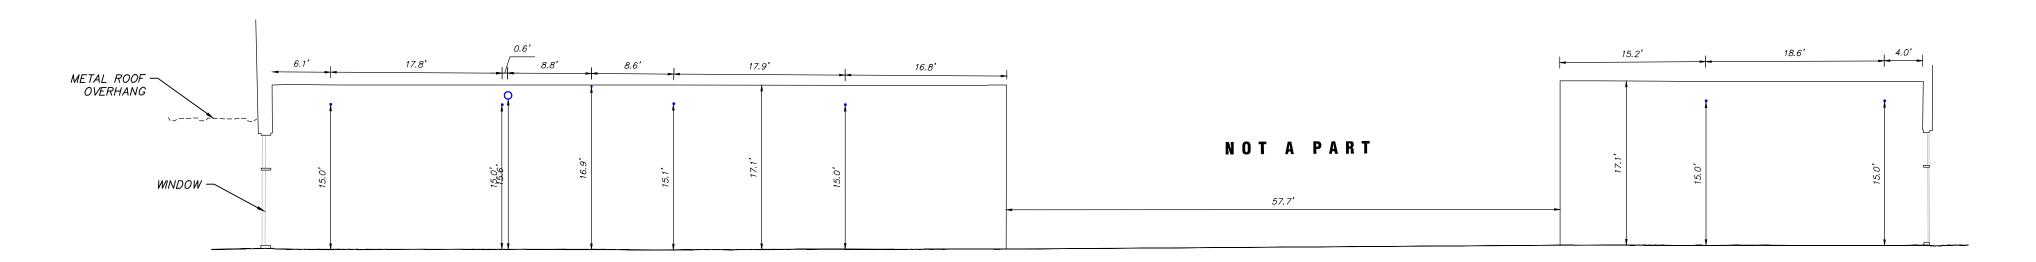

SECTION I-I





Colliers

Engineering & Design

www.colliersengineering.com

Copyright © 2022. Colliers Engineering & Design All Rights Reserved. This drawing and all the information contained herein is authorized for use only by the party for whom the services were contracted or to whom it is certified. This drawing may not be copied, reused, disclosed, distributed or relied upon for any other purpose without the express written consent of Colliers Engineering & Design.

Doing Business as

PROTECT YOURSELF

ALL STATES REQUIRE NOTIFICATION OF EXCAVATORS, DESIGNERS, OR ANY PERSON PREPARING TO DISTURB THE EARTH'S SURFACE ANYWHERE IN ANY STATE

Know what's Delow.

Call before you dig.

FOR STATE SPECIFIC DIRECT PHONE NUMBERS
VISIT: WWW.CALL811.COM

MAREA 801 SOUTH POINT DRIVE

FOR GAIA USA, LLC

PORTION OF BLOCK 51
"OCEAN BEACH FLA.
ADDITION No.3"
P.B.2, PG.81

CITY OF MIAMI BEACH MIAMI-DADE COUNTY FLORIDA

ColliersEngineering

MIAMI
7400 Corporate Center Drive
Suite C
Miami, FL 33126
Phone: 305.597.9701
COLLIERS ENGINEERING & DESIGN, INC.
DOING BUSINESS AS MASER CONSULTING

AS SHOWN 09/20/22 MCH ADLR


PROJECT NUMBER: DRAWING NAME:


22010730A 22010730A_INTERIOR-ASBLT

HEET TITLE:


AS-BUILT PLAN

SHEET NUMBER:

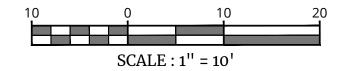


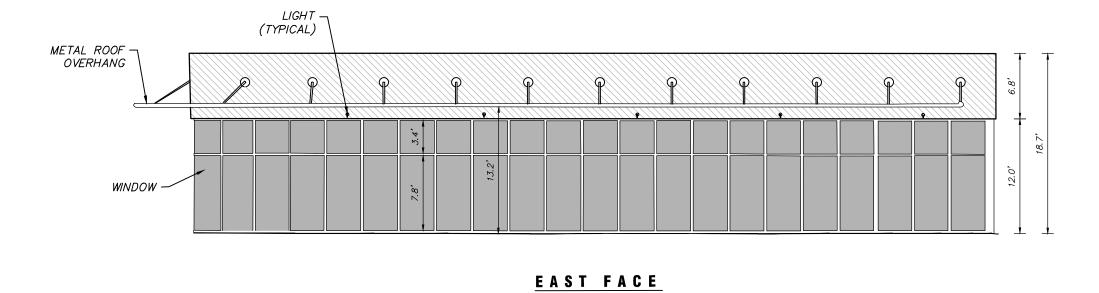



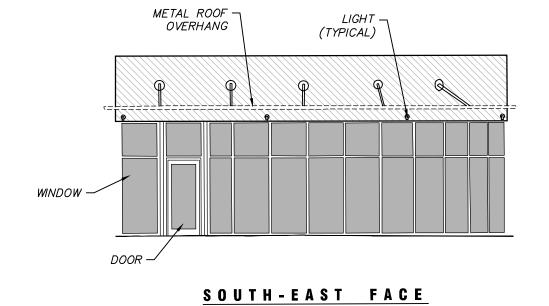



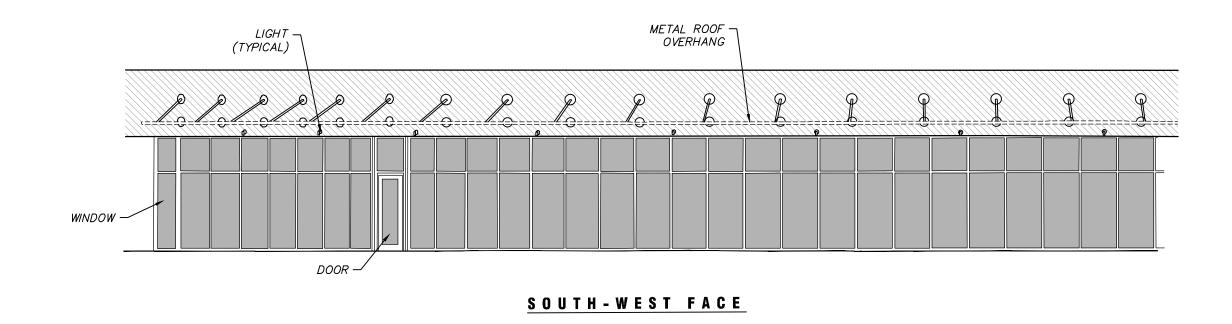



Colliers

Engineering & Design

www.colliersengineering.com

Copyright © 2022. Colliers Engineering & Design All Rights Reserved. This drawing and all the information contained herein is authorized for use only by the party for whom the services were contracted or to whom it is certified. This drawing may not be copied, reused, disclosed, distributed or relied upon for any other purpose without the express written consent of Colliers Engineering & Design.

Doing Business as



Know what's **below.**Call before you dig.

FOR STATE SPECIFIC DIRECT PHONE NUMBERS
VISIT: WWW.CALL811.COM

MAREA 801 SOUTH POINT DRIVE

FOR GAIA USA, LLC

PORTION OF BLOCK 51
"OCEAN BEACH FLA.
ADDITION No.3"
P.B.2, PG.81

CITY OF MIAMI BEACH MIAMI-DADE COUNTY FLORIDA

Engineering Plant & Design COLLEGE DOING BE

7400 Corporate Center Drive
Suite C
Miami, FL 33126
Pring
Phone: 305.597.9701
COLLIERS ENGINEERING & DESIGN, INC.
DOING BUSINESS AS MASER CONSULTING

AS SHOWN 09/20/22 MCH ADL

PROJECT NUMBER: DRAWING NAME:
22010730A 22010730A_INTERIOR-ASBLT

T TITLE:

SHEET NUMBER:

6 01 06

AS-BUILT PLAN