


WATER AND WASTEWATER SYSTEM IMPROVEMENTS FOR CITY OF MIAMI BEACH, FLORIDA

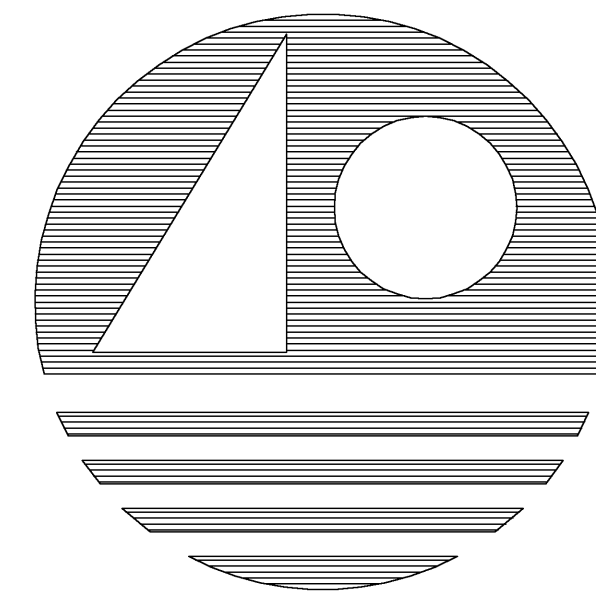


MAYOR
NEISEN KASDIN

CITY COMMISSIONERS

SIMON CRUZ
DAVID DERMER
SUSAN GOTTLIEB
NANCY LIEBMAN
MARTIN SHAPIRO
JOSE SMITH

CITY MANAGER
SERGIO RODRIGUEZ

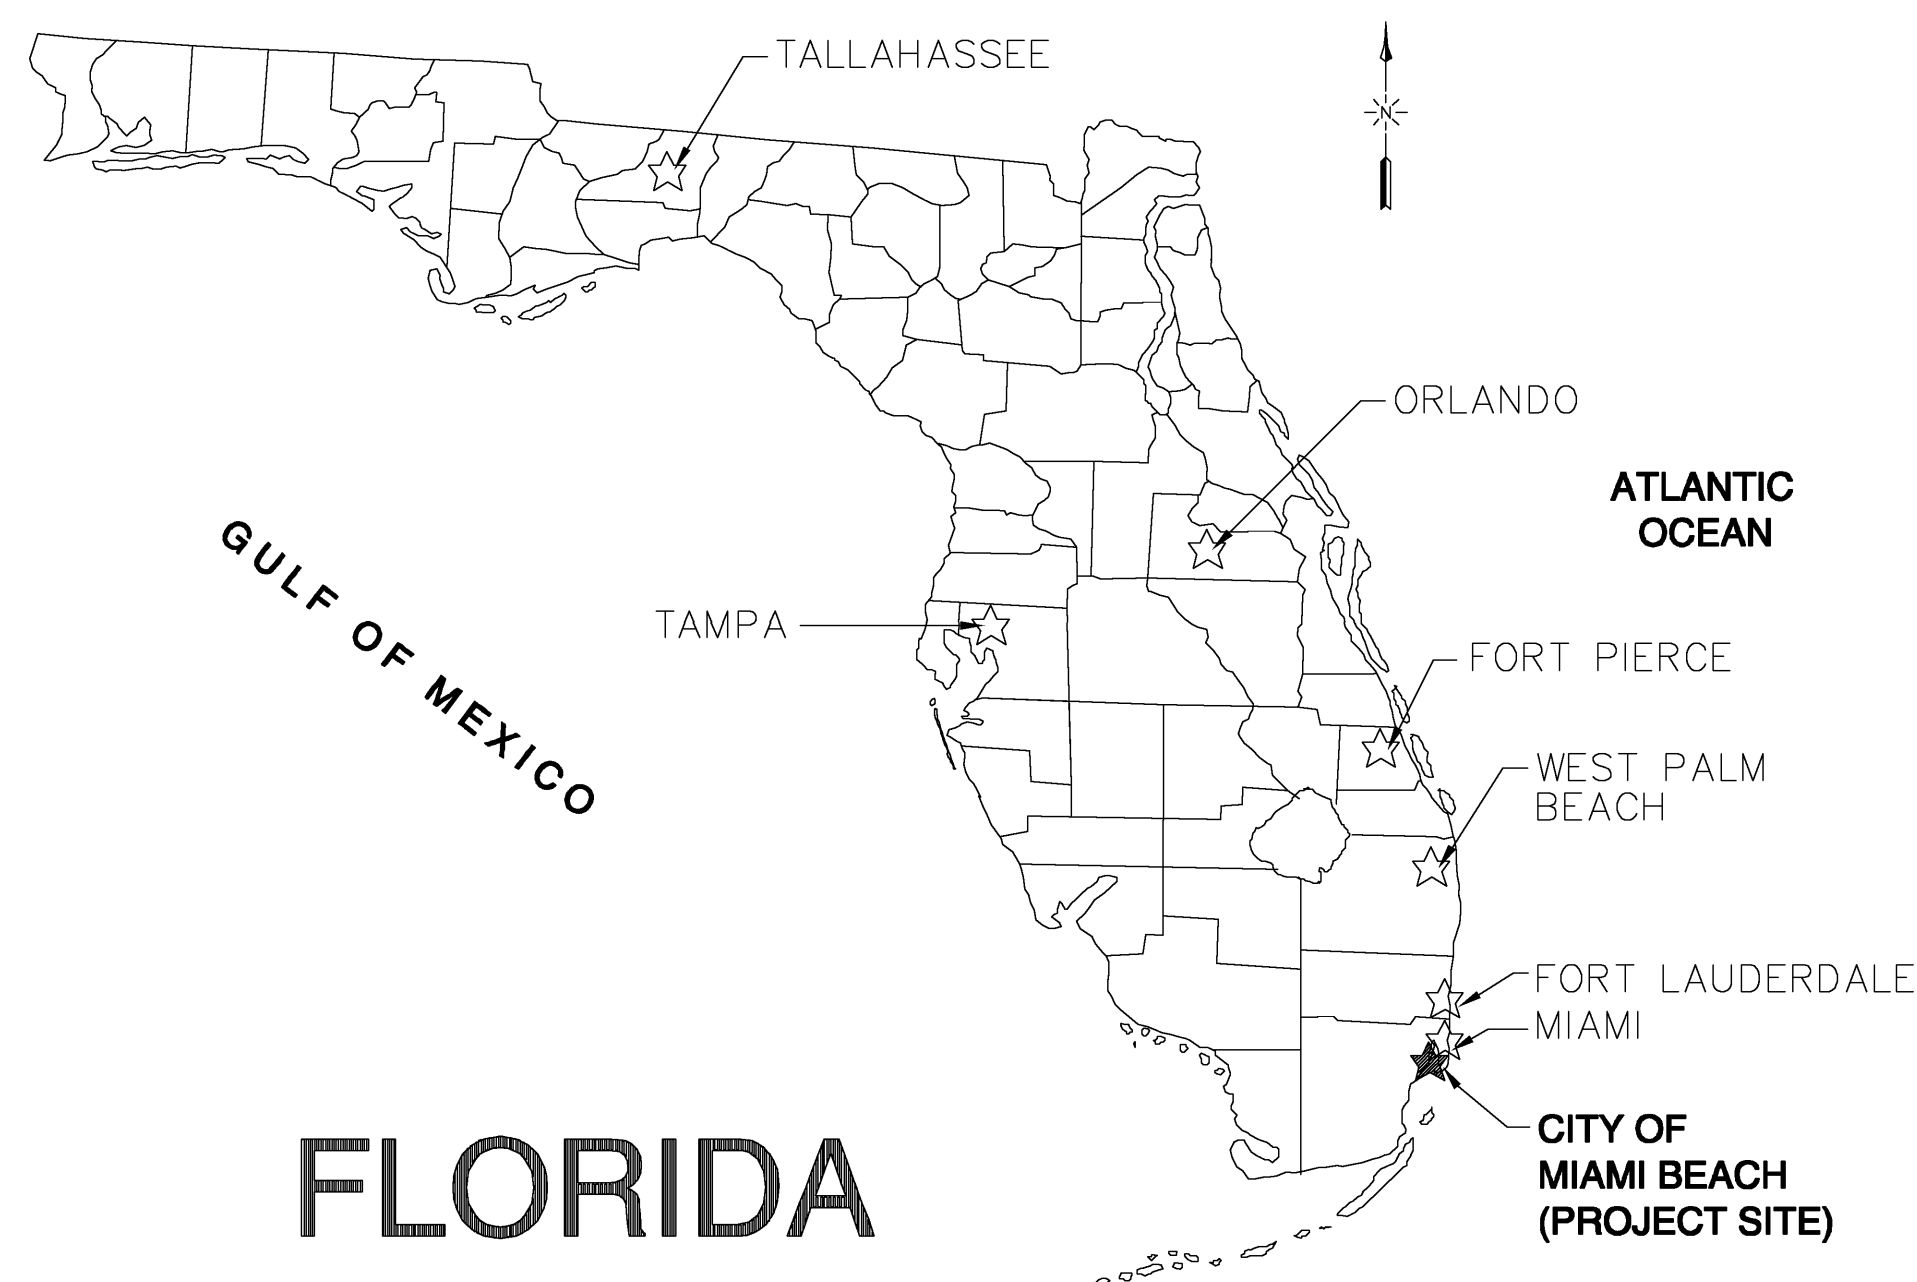

VICINITY PLAN
N.T.S.


WATER AND WASTEWATER PUMP STATIONS UPGRADES

**RECORD DRAWINGS
DECEMBER 2007**

CAMP DRESSER & McKEE INC.

800 BRICKELL AVENUE, SUITE 710
MIAMI, FLORIDA 33131
TEL: 305-372-7171
CERT. OF AUTHORIZATION NO. 20

PROJECT NUMBER: 9381-02R

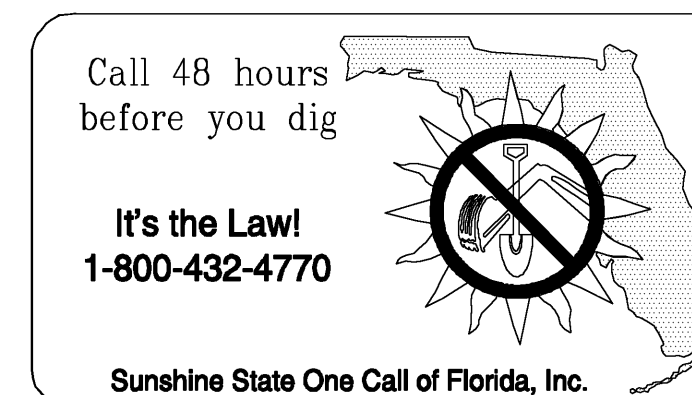

REGISTERED ENGINEERS/ARCHITECTS STATE OF FLORIDA

GENERAL
CIVIL
MECHANICAL

JONATHAN Z. GOLDMAN, P.E.
NO. 48925

ARCHITECTURAL

BERNARD ZYSCOVICH, AIA
NO. AAC001431

STRUCTURAL
(CDM DRAWINGS)

BILGIN EREL, P.E.
NO. 34053

PLUMBING
HVAC

WILLIAM R. HAYGOOD, P.E.
NO. 39503

ELECTRICAL
INSTRUMENTATION

WILLIAM C. NELSON, P.E.
NO. 42017

STRUCTURAL
(ZYSCOVICH DRAWINGS)

PEDRO J. DUGUESNE, P.E.
NO. 22764

RECORD DRAWING

THIS RECORD DRAWING HAVE BEEN PREPARED BASED ON A COMBINATION OF INFORMATION PROVIDED BY OTHERS AND BY CDM. THEREFORE, THE ENGINEER HAS NOT VERIFIED THE ACCURACY OF ALL THE INFORMATION. TO THE BEST OF THE ENGINEER'S BELIEF AND KNOWLEDGE, THE INCLUDED RECORD INFORMATION IS REASONABLY ACCURATE.

By _____ Date December 2007

CDM

*environmental services
offices worldwide*

CDM

#	NUMBER	CL2L	CHLORINE (LIQUID)	EUH	ELECTRIC UNIT HEATER	IA	INSTRUMENT AIR	OA	OUTSIDE AIR	REF	REFERENCE, REFER, ROOF EXHAUST FAN	THD	THREADED
&	AND	CL2S	CHLORINE SOLUTION	EW	EACH WAY	ID	INSIDE DIAMETER	OC	ON CENTER	REG	REGISTER	THK	THICK (NESS)
1/2	DIAMETER	CLF	CURRENT LIMITING FUSE	EWA	EXHAUST AIR	IF	INSIDE FACE	OCCV	OIL CUSHION SWING CHECK VALVE	RENF	REINFORCING	TKD	TANK DRAIN
e	AT	CLG	CEILING	EXH	EXHAUST	IIR	ISOBUTENE ISOPRENE (BUTYL) RUBBER	OE	OVERHEAD ELECTRIC	REM	REMOVE	TM	TELEMEETER OR TIME
		CLR	CLEAR	EXIST	EXISTING	INR	INCH	OF	OUTSIDE FACE	REQ'D	REQUIRED	TOF	TOP OF
		CMP	CORRUGATED METAL PIPE	EXP	EXPANSION	INF	INFLUENT	OG	OZONE OFF-GAS	RES	RESIDUAL	TOB	TOP OF BERM/BANK
A	AIR (COMPRESSED)	CMU	CONCRETE MASONRY UNITS	INS	INSIDE	INSTR	INSTRUMENT (TATION)	OH	OVERHEAD (DOOR)	REV	REVISION	TOC	TOP OF CURB/CONCRETE
A, AMP	AMPERE	CNR	CONDENSATE RETURN	EXTD	EXTENDED	INSUL	INSULATION	OL	OVERLOAD	RF	ROOF FAN	TOS	TOP OF STEEL
A/C	CONDITIONING UNIT	CNS	CONDENSATE SUPPLY	EY	EPOXY	INT	INTERIOR	OPER	OPERATOR	RH	RELATIVE HUMIDITY	TOW	TOP OF WALL
AA	AERATION AIR	COL	CLEAN OUT			INV	INVERT	OPNG	OPENING	RIS	RUBBER IN SHEAR	TOXS	THICKENED OXIDIZED SLUDGE
AB	ANCHOR BOLT	COL	COLUMN			IP	IRON PIPE BOUNDARY	OPP	OPPOSITE	RJ	RESTRAINED JOINT	TP	TURNING POINT
ABDN	ABANDON	COMB	COMBINATION, COMBUSTION	F	FILTRATE OR FARENHEIT	IR	IRON ROD BOUNDARY	OPT	OPTION (AL)	RL	RAIN LEADER	TRRP	THERMOPLASTIC REINFORCED PIPE
AC	AUTOMATIC CONTROL OR ALTERNATING CURRENT	COMP	COMPRESSIBLE	f'c	CONCRETE COMPRESSION STRESS	ISOL	ISOLATOR, ISOLATION	OS	OXIDIZED SLUDGE	RCLI	RUBBER LINED CAST IRON	TPS	THICKENED PRIMARY SLUDGE
ACCY	AUTOMATIC CONTROL CHECK VALVE	CONC	CONCRETE	f'm	MASONRY PRISM STRESS			OT	OVERHEAD TELEPHONE	RLOI	RUBBER LINED DUCTILE IRON	TPY	TEMPORARY
ACP	ASBESTOS CEMENT PIPE	CONCD	CONDUCTIVITY	FAB	FABRICATE (OR, ED)			OTV	OVERHEAD TELEVISION	ROOM	ROOM	TR	TRIANGULATION POINT
ACU	AIR CONDITIONING UNIT	CONN	CONNECTION	FAC	FACILITY OR FLANGED ADAPTOR COUPLING			OZF	OVERFLOW	RMS	ROOT MEAN SQUARE	TRAN	TRANSFER
AD	ACCESS DOOR	CONST	CONSTRUCTION	FB	FLOOR BOX (BUSHING TYPE)	JB	JUNCTION BOX	OZA	OZONATED AIR <th>RND</th> <th>ROUND</th> <th>TRANS</th> <th>TRANSVERSE (ITION), TRANSITION</th>	RND	ROUND	TRANS	TRANSVERSE (ITION), TRANSITION
ADDL	ADDITIONAL	CONT	CONTINUOUS	FBO	FURNISHED BY OTHERS	JCT	JUNCTION	OZE	OZONE EXHAUST <th>RO</th> <th>ROUGH OPENING</th> <th>TS</th> <th>STRUCTURAL TUBING (STEEL UNLESS NOTED)</th>	RO	ROUGH OPENING	TS	STRUCTURAL TUBING (STEEL UNLESS NOTED)
ADJ	ADJUSTBLE	CORR	CORRUGATED	FC	FLEX CONNECTION	JT	JOINT	O/E	OR EQUAL <th>ROT</th> <th>ROTAMETER</th> <th>TSL</th> <th>THICKENED SLUDGE</th>	ROT	ROTAMETER	TSL	THICKENED SLUDGE
ADPT	ADAPTER	CPLG	COUPLING	FD	FLOOR DRAIN			P	PROTECTED <th>RBPB</th> <th>REDUCED PRESSURE BACKFLOW PRECLNTOR<th>TUBV</th><th>TIME UNION BALL VALVE</th></th>	RBPB	REDUCED PRESSURE BACKFLOW PRECLNTOR <th>TUBV</th> <th>TIME UNION BALL VALVE</th>	TUBV	TIME UNION BALL VALVE
AFD	ADJUSTABLE FREQUENCY DRIVE	CPOL	CATIONIC POLYMER	FDMPR	FIRE DAMPER			PA	POLYAMIDE <th>RPM</th> <th>REVOLUTIONS PER MINUTE<th>TURB</th><th>TURBIDITY</th></th>	RPM	REVOLUTIONS PER MINUTE <th>TURB</th> <th>TURBIDITY</th>	TURB	TURBIDITY
AFF	ABOVE FINISHED FLOOR	CPT	CONCRETE PRESSURE PIPE	FDN	FOUNDATION	KO	KNOCKOUT	PAB	PROCESS AERATION BLOWERS <th>RR</th> <th>RAILROAD<th>TV</th><th>TELEVISION</th></th>	RR	RAILROAD <th>TV</th> <th>TELEVISION</th>	TV	TELEVISION
AFG	ABOVE FINISHED GRADE	CPT	CONTROL POWER TRANSFORMER	FE	FLOW METER	KSI	KIPS (1000 POUNDS) PER SQUARE INCH	PAC	PLANT AIR COMPRESSOR <th>RS</th> <th>RAW SEWAGE<th>TWAS</th><th>THICKENED WASTE ACTIVATED SLUDGE</th></th>	RS	RAW SEWAGE <th>TWAS</th> <th>THICKENED WASTE ACTIVATED SLUDGE</th>	TWAS	THICKENED WASTE ACTIVATED SLUDGE
AHU	AIR HANDLING UNIT	CR	CONTROL RELAY	FH	FERRIC CHLORIDE	KTV	KNIFE GATE VALVE	PAG	AIRGAP PROTECTED WATER <th>RSL</th> <th>RAW SLUDGE<th>RT</th><th>RIGHT</th></th>	RSL	RAW SLUDGE <th>RT</th> <th>RIGHT</th>	RT	RIGHT
AI	ANALOG INPUT	CRS	COURSE (S)	FHM5	FLATHEAD MACHINE SCREW			PAVT	PAVEMENT <th>RTU</th> <th>REMOTE TELEMETRY UNIT<th><th></th></th></th>	RTU	REMOTE TELEMETRY UNIT <th><th></th></th>	<th></th>	
ALT	ALTERNATE (ING)	CS	CARBON STEEL OR CONTROL SWITCH	FHWS	FLATHEAD WOOD SCREW	L	LENGTH OR STRUCTURAL ANGLE DESIGNATION	PB	PUSHBUTTON <th><th><th>U</th><th>HEAT TRANSFER COEFFICIENT</th></th></th>	<th><th>U</th><th>HEAT TRANSFER COEFFICIENT</th></th>	<th>U</th> <th>HEAT TRANSFER COEFFICIENT</th>	U	HEAT TRANSFER COEFFICIENT
AL, ALUM	ALUMINUM	CSL	CONDITIONED SLUDGE	F1	FILTER INFLUENT	LA	LIGHTNING ARRESTER	PBAV	PLASTIC BALL VALVE <th><th><th>UD</th><th>UNDERDRAIN</th></th></th>	<th><th>UD</th><th>UNDERDRAIN</th></th>	<th>UD</th> <th>UNDERDRAIN</th>	UD	UNDERDRAIN
ANOD	ANODIZE	CSM	CHLORINE SULPHONILE POLYETHYLENE (HYPALON)	F1G	FIGURE	LAB	LABORATORY	PC	POINT OF CURVE <th>S</th> <th>SIGNAL LINE OR STEEL S-SHAPE DESIGNATION<th>UG</th><th>UNDERGROUND</th></th>	S	SIGNAL LINE OR STEEL S-SHAPE DESIGNATION <th>UG</th> <th>UNDERGROUND</th>	UG	UNDERGROUND
AO	ANALOG OUTPUT	CSTG	CASTING	FIN	FINISH (ED)	LAM	LAMINATED	PCC	POINT OF COMPLEX CURVATURE <th>SA</th> <th>SUPPLY AIR<th>UGTC</th><th>UNDERGROUND TELEPHONE CABLE</th></th>	SA	SUPPLY AIR <th>UGTC</th> <th>UNDERGROUND TELEPHONE CABLE</th>	UGTC	UNDERGROUND TELEPHONE CABLE
AP	ACCESS PANEL	CT	CURRENT TRANSFORMER	FL	FLOOR OR FIRE LINE	LAV	LAVATORY	PCCP	PRESTRESSED CONCRETE CYLINDER PIPE <th>SAN</th> <th>SANITARY<th>UH</th><th>UNIT HEATER</th></th>	SAN	SANITARY <th>UH</th> <th>UNIT HEATER</th>	UH	UNIT HEATER
APPROX	APPROXIMATE (LY)	CTG	COATING	FLD	FUSIBLE LINK DAMPER	LB	POUND	PCF	POUND PER CUBIC FOOT <th>SAN S</th> <th>SANITARY SEWER<th>UL</th><th>UNDERWRITERS LABORATORY</th></th>	SAN S	SANITARY SEWER <th>UL</th> <th>UNDERWRITERS LABORATORY</th>	UL	UNDERWRITERS LABORATORY
AR	ACID RESISTANT	CTJ	CONTROL JOINT	FLG	FLANGE (D)	LBS	POUNDS	PCF	POUND PER CUBIC FOOT <th>SB</th> <th>STONE MONUMENT BOUNDARY<th>UNG</th><th>UNLESS NOTED OTHERWISE</th></th>	SB	STONE MONUMENT BOUNDARY <th>UNG</th> <th>UNLESS NOTED OTHERWISE</th>	UNG	UNLESS NOTED OTHERWISE
ARCH	ARCHITECT (URAL) (URE)	CTR	CENTER (ED)	FLX,FLX	FLEXIBLE	LCP	LOCAL CONTROL PANEL	PCTFE	POLYCHLOROTRIFLUORETHYLENE <th>SCUM</th> <th>SCUM<th>UPVC</th><th>UN-PLASTICISED POLYVINYL CHLORIDE</th></th>	SCUM	SCUM <th>UPVC</th> <th>UN-PLASTICISED POLYVINYL CHLORIDE</th>	UPVC	UN-PLASTICISED POLYVINYL CHLORIDE
ARND	AROUND	CTSK	COUNTERSINK	FLX	FLEXIBLE	LF	LINEAL FEET	PCV	PRESSURE CONTROL VALVE <th>SCH</th> <th>SCHEDULE<th><th></th></th></th>	SCH	SCHEDULE <th><th></th></th>	<th></th>	
ARV	AIR RELEASE VALVE	CTU	CENTRAL TELEMETRY UNIT	FM	FORCE MAIN	LNG	LONG	PD	PUMP DISCHARGE <th>SD</th> <th>SILENT CHECK VALVE<th><th></th></th></th>	SD	SILENT CHECK VALVE <th><th></th></th>	<th></th>	
AS	ACTIVATED SLUDGE	CU	COPPER OR CUBIC	FO	FUEL OIL	LOB	LAG BOLT	PE	PLAIN END <th>SDCV</th> <th>SLANTING DISK CHECK VALVE<th><th></th></th></th>	SDCV	SLANTING DISK CHECK VALVE <th><th></th></th>	<th></th>	
ASPH	ASPHALT	CUH	CABINET UNIT HEATER	FOB	FLAT ON BOTTOM	LIME	LIME, DRY	PEFL	PRIMARY EFFLUENT <th>STM</th> <th>STORM DRAIN<th>V</th><th>VOLTS</th></th>	STM	STORM DRAIN <th>V</th> <th>VOLTS</th>	V	VOLTS
ASSOC	ASSOCIATION	CUP	COPPER PIPE	FOR	FUEL OIL RETURN	LL	LIVE LOAD	PERF	PERFORATED <th>SE</th> <th>SECONDS OR SECONDARY<th>VA</th><th>VENT AIR</th></th>	SE	SECONDS OR SECONDARY <th>VA</th> <th>VENT AIR</th>	VA	VENT AIR
ASTM	AMERICAN SOCIETY FOR TESTING MATERIALS	CV	VALVE FLOW COEFFICIENT	FOS	FUEL OIL SUPPLY	LLH	LONG LEG HORIZONTAL	PF	PHENOL-FORMALDEHYDE <th>SEC</th> <th>SECTION<th>VA-H</th><th>HYDRAULIC VALVE OPERATOR</th></th>	SEC	SECTION <th>VA-H</th> <th>HYDRAULIC VALVE OPERATOR</th>	VA-H	HYDRAULIC VALVE OPERATOR
ATC	AUTOMATIC TEMPERATURE CONTROL	CV-A	CHECK VALVE (AIR CUSHION)	FOT	FLAT ON TOP	LLV	LONG LEG VERTICAL	PFU	POLYMER FEED UNIT <th>SEE</th> <th>SECONDARY EFFLUENT<th>VA-M</th><th>MOTOR VALVE OPERATOR</th></th>	SEE	SECONDARY EFFLUENT <th>VA-M</th> <th>MOTOR VALVE OPERATOR</th>	VA-M	MOTOR VALVE OPERATOR
ATS	AUTOMATIC TRANSFER SWITCH	CV-H	CHECK VALVE (HYDRAULIC CUSHION)	F OV	FUEL OIL VENT	LDNG	LANDING	PGA	PURGE AIR (LIME SILOS) <th>SF</th> <th>SUPPLY FAN<th>VA-P</th><th>PNEUMATIC VALVE OPERATOR</th></th>	SF	SUPPLY FAN <th>VA-P</th> <th>PNEUMATIC VALVE OPERATOR</th>	VA-P	PNEUMATIC VALVE OPERATOR
AUTO	AUTOMATIC	CVR	CONVECTOR	FP	FILTER PRESS	LOC	LOCATION/LOCATED	PH	PHASE <th>SG</th> <th>SLUICE GATE<th>VA-S</th><th>SOLENOID VALVE OPERATOR</th></th>	SG	SLUICE GATE <th>VA-S</th> <th>SOLENOID VALVE OPERATOR</th>	VA-S	SOLENOID VALVE OPERATOR
AUX	AUXILIARY	CW	COLD WATER	FPM	FEET PER MINUTE	LONG	LONGITUDINAL	pH	PHASE <th>SG-C</th> <th>SLUICE GATE - MANUAL CRANK OPERATOR<th>VAC</th><th>VACUUM</th></th>	SG-C	SLUICE GATE - MANUAL CRANK OPERATOR <th>VAC</th> <th>VACUUM</th>	VAC	VACUUM
AVG	AVERAGE	CWO	CLEARWELL OVERFLOW	F.P.L.	FLORIDA POWER AND LIGHT	LP	LOW POINT OR LOW PRESSURE OR LIGHT POLE	PHOS	PHOSPHATE <th>SG-HW</th> <th>SLUICE GATE - HAND WHEEL OPERATOR<th>VAR</th><th>VARIOUS/VARIABLE</th></th>	SG-HW	SLUICE GATE - HAND WHEEL OPERATOR <th>VAR</th> <th>VARIOUS/VARIABLE</th>	VAR	VARIOUS/VARIABLE
AWG	AMERICAN WIRE GAUGE	CWR	COOLING WATER RETURN	FPT	FEMALE PIPE THREAD	LPA	LOW PRESSURE AIR (FROM BLOWERS)	PWH	PROTECTED HOT WATER <th>SG-M</th> <th>SLUICE GATE - MOTOR OPERATOR<th>VAV</th><th>VARIABLE AIR VOLUME</th></th>	SG-M	SLUICE GATE - MOTOR OPERATOR <th>VAV</th> <th>VARIABLE AIR VOLUME</th>	VAV	VARIABLE AIR VOLUME
AWL	AVERAGE WATER LEVEL	CWS	COOLING WATER SUPPLY	FRP	FIBERGLASS REINFORCED PLASTIC	LPNL	LIGHTING PANEL	PI	POINT OF INTERSECTION <th>SHC</th> <th>SODIUM HYPOCHLORITE<th>VB</th><th>VALVE BOX</th></th>	SHC	SODIUM HYPOCHLORITE <th>VB</th> <th>VALVE BOX</th>	VB	VALVE BOX

RECORD DRAWING

THIS RECORD DRAWING HAVE BEEN PREPARED BASED ON A COMBINATION OF INFORMATION PROVIDED BY OTHERS AND BY CDM. THEREFORE, THE ENGINEER HAS NOT VERIFIED THE ACCURACY OF ALL THE INFORMATION. TO THE BEST OF THE ENGINEER'S BELIEF AND KNOWLEDGE, THE INCLUDED RECORD INFORMATION IS REASONABLY ACCURATE.

By _____ Date December 2007

CDM

JONATHAN Z. GOLDMAN
P.E. NO. 48925

DESIGNED BY:	W. SPRIGGS
DRAWN BY:	A. NUNES
SHEET CHK'D BY:	W. SPRIGGS
CROSS CHK'D BY:	E. STURTZ
APPROVED BY:	J. GOLDMAN
DATE:	DECEMBER, 1997

CAMP DRESSER & McKEE INC.

800 Brickwell Avenue, Suite 710
Miami, Florida 33131
Tel: 305-372-7171
Cert. of Authorization No. 20

CDM
environmental engineers, scientists,
planners, & management consultants

CITY OF MIAMI BEACH, FLORIDA

WATER AND WASTEWATER SYSTEM IMPROVEMENTS

PROJECT NO.	9381-002R
SHEET NO.	G-3

DATE: Jan 04, 2008 4:39pm
USER: hursel
RECORD_AJT_C
XREFS: bblxt

1
2
3
4
5

PIPING SYMBOLOGY

DOUBLE LINE SYMBOL	SINGLE LINE SYMBOL	FEATURE
		WELDED JOINT
		FLANGED JOINT SIMPLIFIED REPRESENTATION.
		FLANGED JOINT COMPLEX REPRESENTATION.
		MECHANICAL JOINT SIMPLIFIED REPRESENTATION.
		MECHANICAL JOINT COMPLEX REPRESENTATION.
		MECHANICAL JOINT RESTRAINED
		PUSH ON JOINT OR CAULKED BELL & SPIGOT JOINT SIMPLIFIED REPRESENTATION
		PUSH ON JOINT OR CAULKED BELL & SPIGOT JOINT COMPLEX REPRESENTATION
		PUSH ON JOINT OR CAULKED BELL & SPIGOT JOINT RESTRAINED
		BALL JOINT
		DIRECTION OF FLOW
		PLAIN END x PLAIN END PIPE COUPLING
		PLAIN END x PLAIN END PIPE COUPLING RESTRAINED
		FLANGE x PLAIN END PIPE COUPLING
		FLEXIBLE COUPLING OR EXPANSION JOINT (SLEEVE TYPE)
		FLEXIBLE COUPLING OR EXPANSION JOINT (BELLOWS TYPE)
		COUPLING FOR VICTAULIC JOINTS: (G) GROOVED
		(S) SHOULDERED
		FLANGE GUARD
		FLANGE FILLER
		UNION
		QUICK CONNECT COUPLING
		HOSE COUPLING

PIPE AND FITTING SYMBOL NOTES

- SIMPLIFIED JOINT SYMBOL IS USED FOR ALL SINGLE LINE PIPING SHOWN ON THE INTERIOR AND EXTERIOR PIPING DRAWINGS.
- BOTH SIMPLIFIED AND COMPLEX JOINT REPRESENTATIONS MAY BE SHOWN ON THE DRAWINGS.
- UNLESS MODIFIED BY THE GENERAL PROJECT NOTES OR DETAILED ON THE LAYOUT AND SCHEMATIC DRAWINGS PIPE AND FITTING JOINT REQUIREMENTS FOR THE VARIOUS PIPE MATERIALS ARE DEFINED IN THE SPECIFICATIONS.

VALVE SYMBOLOGY


SYMBOL	FEATURE
	UNCLASSIFIED, TYPE AS SHOWN ON THE DRAWINGS ADJACENT TO SYMBOL
	FLOW METER
	TELESCOPING VALVE
	VALVE WITH HOSE END
	GATE VALVE
	KNIFE GATE VALVE
	GLOBE VALVE
	BALL VALVE
	3-WAY BALL VALVE
	4-WAY BALL VALVE
	CONE VALVE
	NEEDLE VALVE
	PINCH VALVE
	DIAPHRAGM VALVE
	BUTTERFLY VALVE
	PLUG VALVE
	3-WAY PLUG VALVE
	4-WAY PLUG VALVE
	CHECK VALVE, GENERAL SYMBOL
	BALL CHECK VALVE
	DOUBLE DOOR CHECK VALVE
	ANGLE VALVE
	SOLENOID VALVE
	THREE WAY SOLENOID VALVE
	THREE WAY SOLENOID VALVE
	MOTOR OPERATED VALVE
	FLAP VALVE
	SHEAR GATE
	MUD VALVE
	FLOOR DRAIN
	OPEN EQUIPMENT DRAIN
	ECCENTRIC REDUCER OR REDUCING BUSHING
	CONCENTRIC REDUCER OR REDUCING BUSHING
	Y-STRAINER
	CALIBRATION CYLINDER
	AIR RELEASE VALVE

GATE SYMBOLOGY


PLAN	FEATURE
	SLUICE GATE (SG)
	SLIDE GATE (SLG)
	WEIR SLIDE GATE (WSLG)
	SLUICE GATE (SG)
	SLIDE GATE (SLG)
	WEIR SLIDE GATE (WSLG)

SECTION (OPERATOR ONLY)


EXISTING OR FUTURE CONDITION DESIGNATION

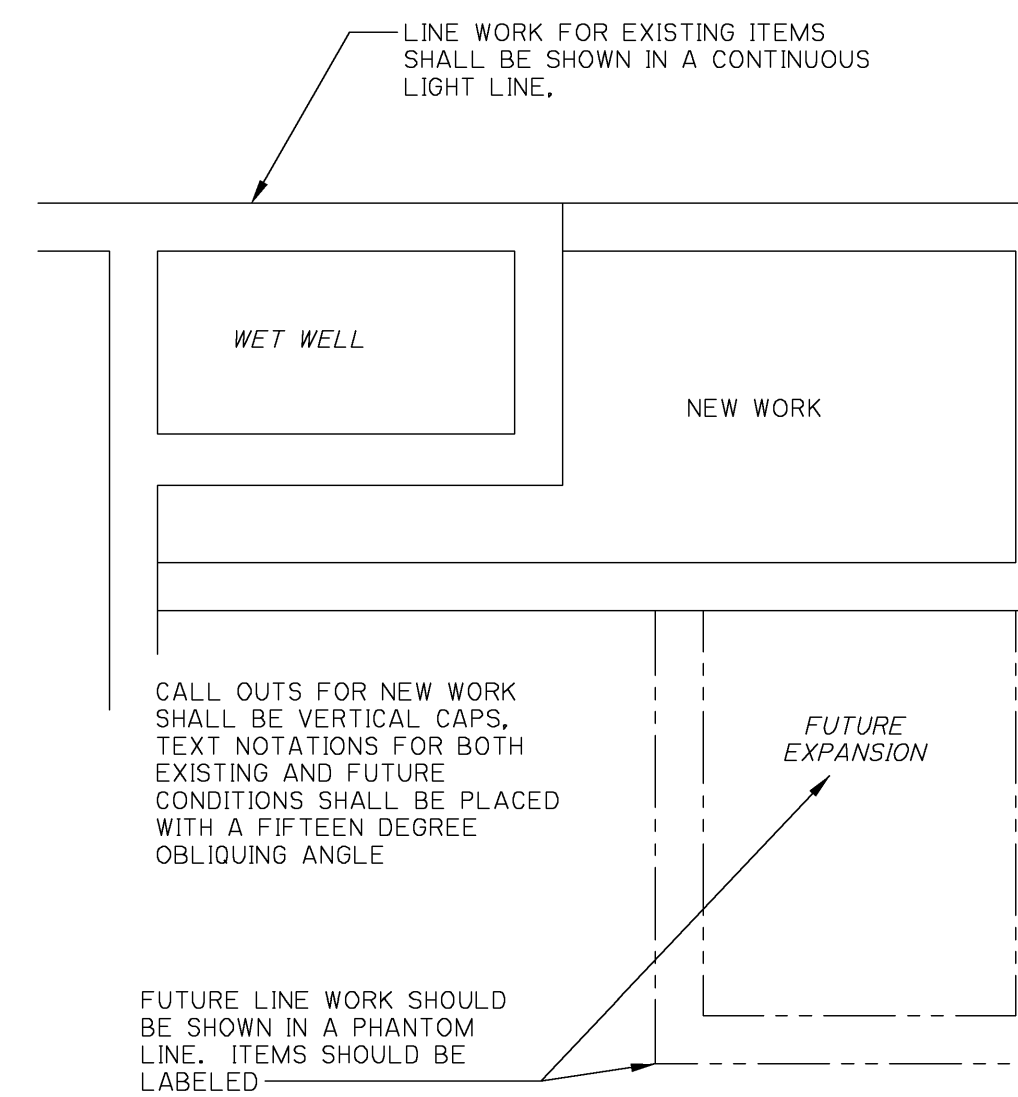

SECTION CUT SYMBOLS

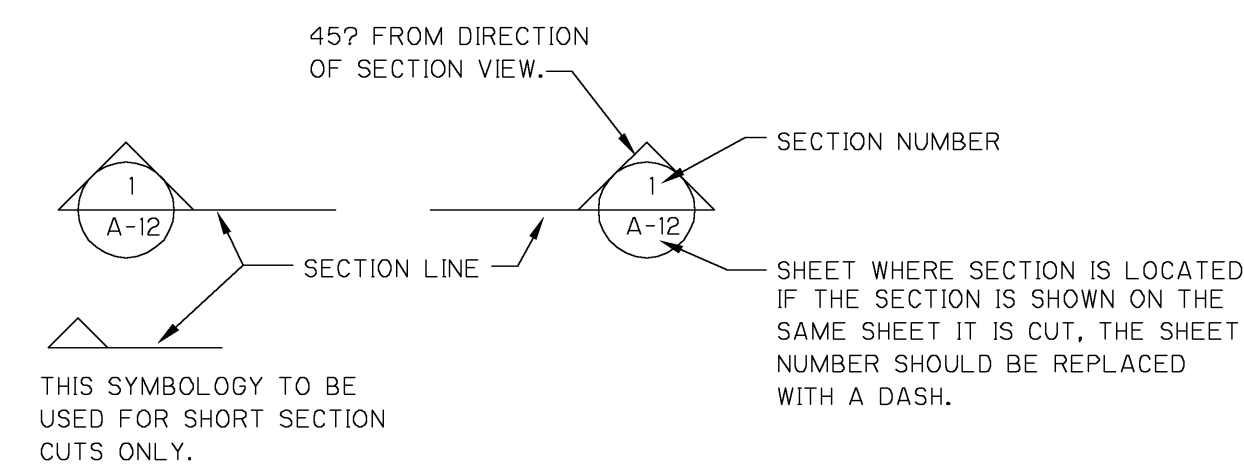


DETAIL CALL OUT SYMBOLS

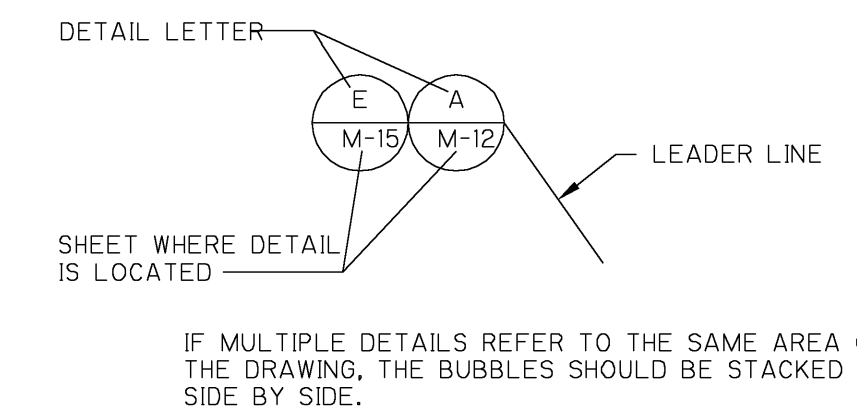

DRAWING, SECTION AND DETAIL TITLES

SUBTITLE OR DESCRIPTION (AS REQ'D)

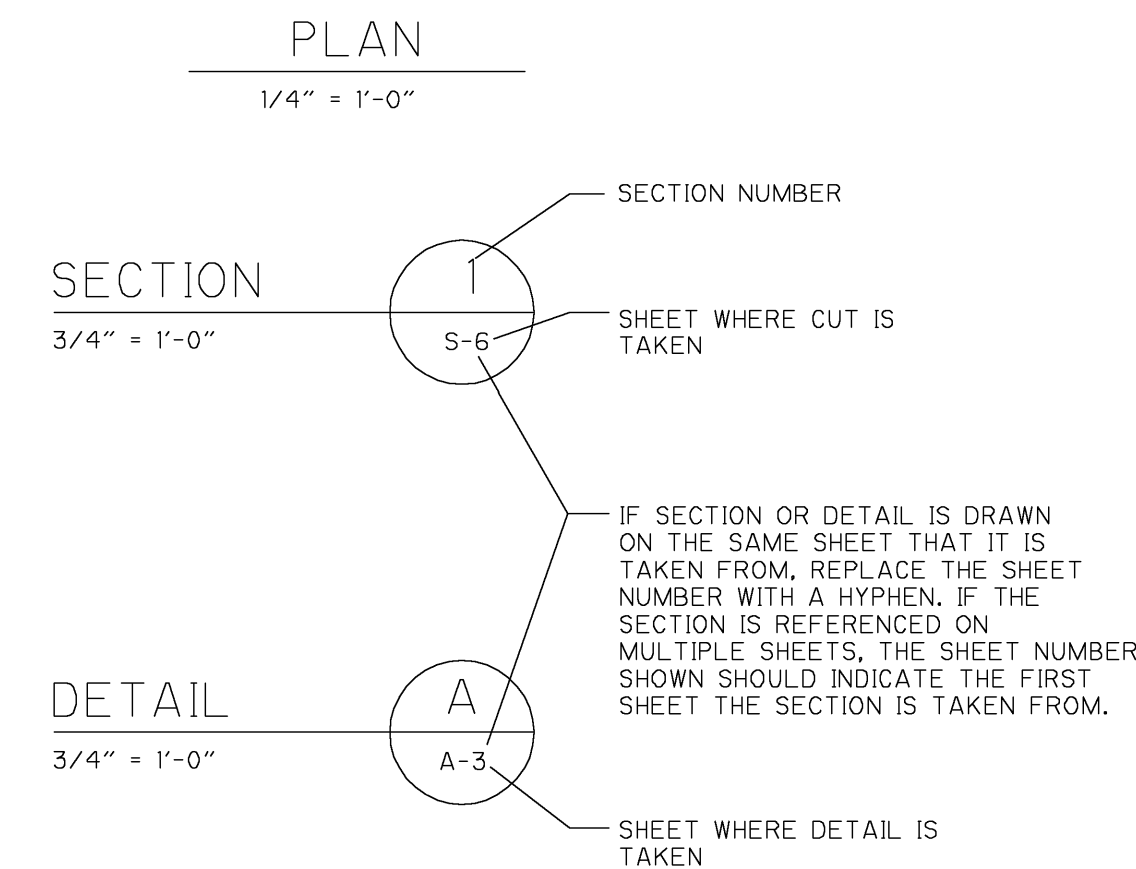

GENERAL

	NEW MAIN THIS PROJECT
	20" WM EXISTING WATER MAIN
	16" RW EXISTING RAW WATER MAIN
	10" SS EXISTING SANITARY SEWER W/ MANHOLE
	10" FM EXISTING FORCE MAIN
	EXISTING BURIED TELEPHONE
	EXISTING POWER DUCTS OR CABLES
	OVERHEAD POWER
	EXISTING CABLE TELEVISION
	EXISTING STORM SEWER W/ CATCH BASIN
	FIRE HYDRANT
	R/W - RIGHT OF WAY
	ℙ - PROPERTY LINE
	NEW MAIN TO BE CONST. UNDER EXISTING UTILITY
	NEW MAIN TO BE CONST. OVER EXISTING UTILITY
	EXISTING POWER POLE
	EXISTING LIGHT POLE
	SOIL BORING
	BENCH MARK
	EXISTING CHAIN LINK FENCE
	NEW CHAIN LINK FENCE
	EXISTING CONTOUR
	NEW CONTOUR
	EXISTING SPOT ELEVATION
	NEW SPOT ELEVATION
	NEW STRUCTURES
	EXISTING STRUCTURES (TO REMAIN)
	EXISTING STRUCTURES (TO BE MODIFIED)
	EXISTING STRUCTURES (TO BE REMOVED)
	NEW CONCRETE SLAB OR SIDEWALKS
	EXISTING STRUCTURES
	NEW STRUCTURES
	SLANTED TEXT
	VERTICAL TEXT

RECORD DRAWING

THIS RECORD DRAWING HAVE BEEN PREPARED BASED ON A COMBINATION OF INFORMATION PROVIDED BY OTHERS AND BY CDM. THEREFORE, THE ENGINEER HAS NOT VERIFIED THE ACCURACY OF ALL THE INFORMATION. TO THE BEST OF THE ENGINEER'S BELIEF AND KNOWLEDGE, THE INCLUDED RECORD INFORMATION IS REASONABLY ACCURATE.

By _____ Date December 2007

CDM

JONATHAN Z. GOLDMAN
P.E. NO. 48925

PROJECT NO.
9381-02R

SHEET NO.

G-4

REV. NO.	DATE	DRWN	CHKD	REMARKS
12/07	ALN	JEC		RECORD DRAWING
3/99	ALN	WMS		CONFORMED DRAWINGS

DESIGNED BY:	W. SPRIGGS
DRAWN BY:	A. NUNES
SHEET CHK'D BY:	W. SPRIGGS
CROSS CHK'D BY:	E. STURTZ
APPROVED BY:	J. GOLDMAN
DATE:	DECEMBER, 1997


CAMP DRESSER & McKEE INC.
800 Brickwell Avenue, Suite 710
Miami, Florida 33131
Tel: 305-372-7171
Cert. of Authorization No. 20

environmental engineers, scientists,
planners, & management consultants
CDM


CITY OF MIAMI BEACH, FLORIDA

WATER AND WASTEWATER SYSTEM IMPROVEMENTS

SYMBOLS

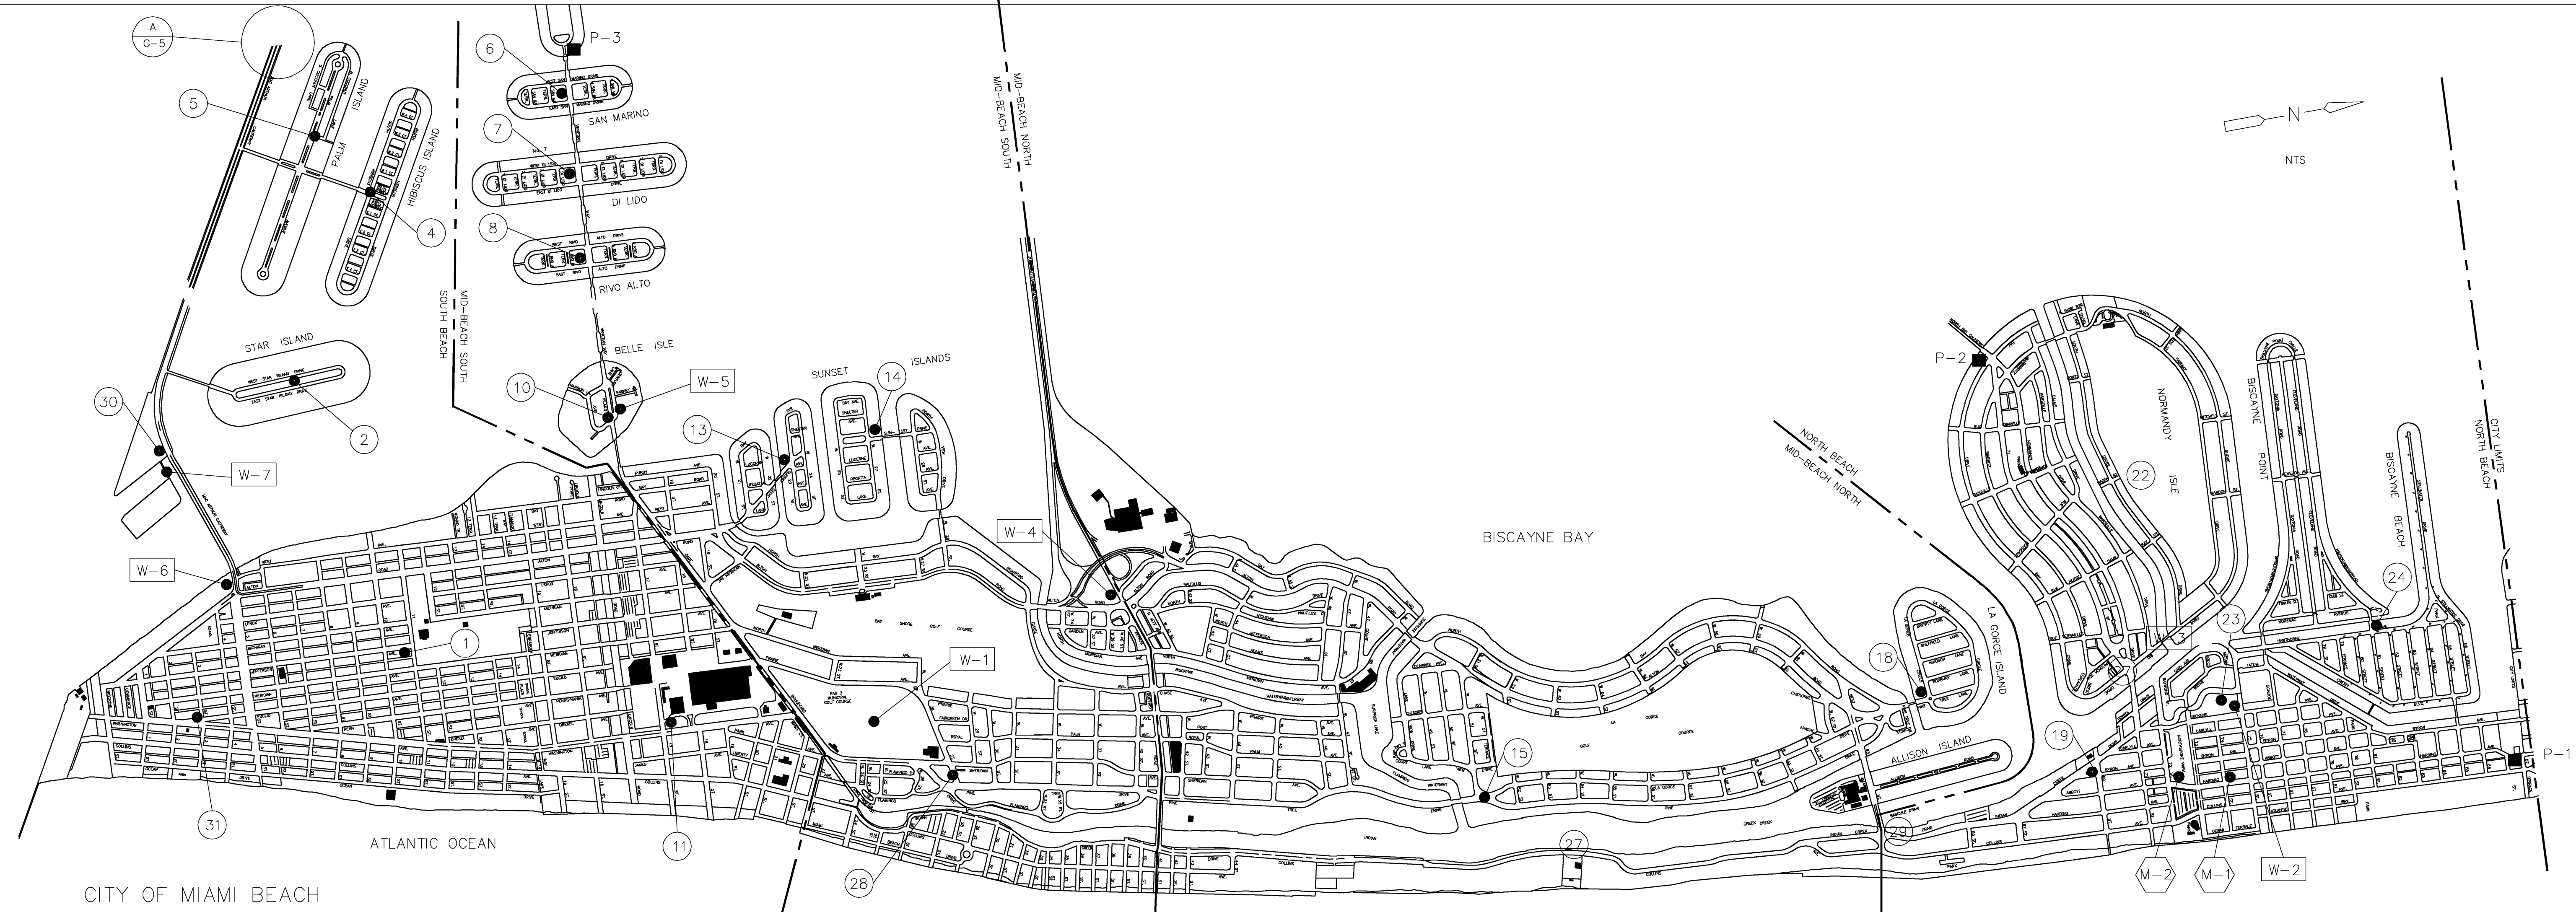

WATER AND WASTEWATER PUMP STATIONS
LOCATION PLAN

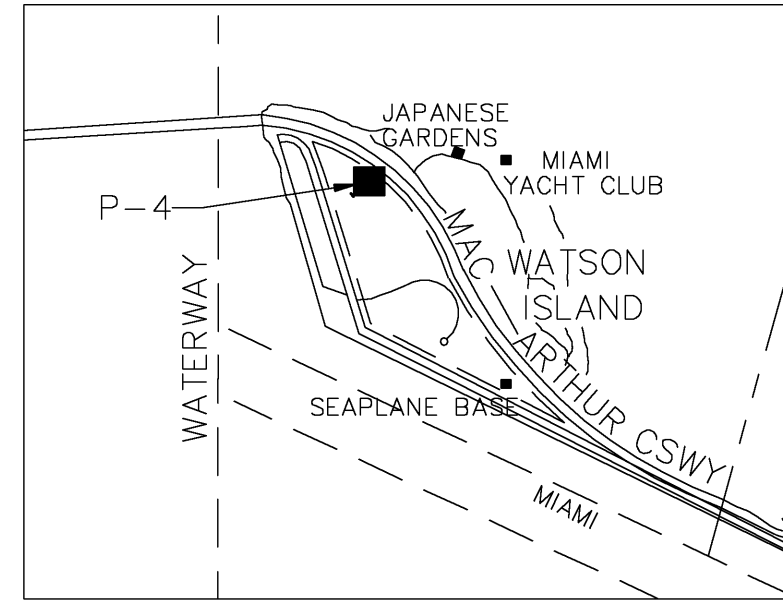

DETAIL
A
G-5
(BY OTHERS)

WASTEWATER PUMPING STATIONS		
STATION I.D.	LOCATION	TYPE
1	11TH STREET AND JEFFERSON AVENUE	DRY PIT PUMP
2	STAR ISLAND	SUBMERSIBLE PUMP
4	HIBISCUS ISLAND	SUBMERSIBLE PUMP
5	PALM ISLAND	SUBMERSIBLE PUMP
6	SAN MARINO ISLAND	SUBMERSIBLE PUMP
7	DI LIDO ISLAND	SUBMERSIBLE PUMP
8	RIVO-ALTO ISLAND	SUBMERSIBLE PUMP
10	ISLAND AVENUE AND VENETIAN WAY	DRY PIT PUMP
11	17TH STREET AND WASHINGTON AVENUE	DRY PIT PUMP
13	SUNSET SOUTH	SUBMERSIBLE PUMP
14	SUNSET NORTH	SUBMERSIBLE PUMP
15	51ST STREET AND PINE TREE DRIVE	DRY PIT PUMP
18	LA GORCE ISLAND	SUBMERSIBLE PUMP
19	69TH STREET AND INDIAN CREEK DRIVE	DRY PIT PUMP
21	71ST STREET	DRY PIT PUMP
22	HAGAN STREET	DRY PIT PUMP
23	75TH STREET	DRY PIT PUMP
24	81TH STREET	DRY PIT PUMP
27	5400 BLOCK COLLINS AVENUE	DRY PIT PUMP
28	28TH STREET AND SHERIDAN AVENUE	DRY PIT PUMP & BOOSTER
29	63RD STREET AND INDIAN CREEK DRIVE	DRY PIT PUMP & BOOSTER
30	TERMINAL ISLAND	SUBMERSIBLE PUMP
31	3RD STREET AND EUCLID	SUBMERSIBLE PUMP

WATER PUMPING STATIONS		
STATION I.D.	LOCATION	TYPE
25TH STREET (W-1)	25TH STREET AND PINE TREE DRIVE	INJECTOR (BY OTHERS)
75TH STREET (W-2)	75TH STREET AND DICKENS AVENUE	INJECTOR
NORMANDY (W-3)	71ST STREET AND RUE VENDOME	IN-LINE BOOSTER
41ST STREET (W-4)	41ST STREET AND ALTON ROAD	IN-LINE BOOSTER
BELLE ISLE (W-5)	ISLAND AVENUE AND VENETIAN WAY	IN-LINE BOOSTER
SHOP (MARINA) (W-6)	430 ALTON ROAD	IN-LINE BOOSTER (OFFLINE) (NIC)
TERMINAL IS. (W-7)	TERMINAL ISLAND	IN-LINE BOOSTER (BY OTHERS)

PRESSURE & FLOW MONITORING STATIONS		
STATION I.D. NO.	LOCATION	TYPE
1A AND 1B (M1)	74TH STREET AND HARDING	WASTEWATER (BY OTHERS)
2 (M2)	72ND STREET AND HARDING	WASTEWATER (BY OTHERS)
87TH STREET (P-1)	87TH STREET AND COLLINS AVENUE	WATER (BY OTHERS)
NORMANDY CAUSEWAY (P-2)	BIARRITZ AND 71ST STREET	WATER (BY OTHERS)
VENETIAN WAY (P-3)	VENETIAN WAY	WATER (BY OTHERS)
MC ARTHUR CAUSEWAY (P-2)	MC ARTHUR CAUSEWAY ON WATSON ISLAND	WATER (BY OTHERS)

RECORD DRAWING
THIS RECORD DRAWING HAVE BEEN PREPARED BASED ON A COMBINATION OF INFORMATION PROVIDED BY OTHERS AND BY CDM. THEREFORE, THE ENGINEER HAS NOT VERIFIED THE ACCURACY OF ALL THE INFORMATION. TO THE BEST OF THE ENGINEER'S BELIEF AND KNOWLEDGE, THE INCLUDED RECORD INFORMATION IS REASONABLY ACCURATE.
By _____ Date December 2007
CDM

JONATHAN Z. GOLDMAN
P.E. NO. 48925
PROJECT NO. 9381-02R
SHEET NO. G-5

REV. NO.	DATE	DRWN	CHKD	REMARKS
12/07	ALN	JEC		RECORD DRAWING
12/02	ALN	JEC		CLARIFIED SCOPE
3/99	ALN	WMS		CONFORMED DRAWINGS
9/98	ALN	WMS		ADDENDUM NO. 3

DESIGNED BY: W. SPRIGGS
DRAWN BY: A. NUNES
SHEET CHK'D BY: W. SPRIGGS
CROSS CHK'D BY: E. STRUTZ
APPROVED BY: J. GOLDMAN
DATE: DECEMBER, 1997



CAMP DRESSER & MCKEE INC.
800 Brickwell Avenue, Suite 710
Miami, Florida 33131
Tel: 305-372-7171
Cert. of Authorization No. 20
CDM
environmental engineers, scientists,
planners, & management consultants

CITY OF MIAMI BEACH, FLORIDA
WATER AND WASTEWATER SYSTEM IMPROVEMENTS

**WATER AND WASTEWATER PUMP STATION
LOCATION PLAN**

GENERAL NOTES

1. ALL APPLICABLE PERMITS MUST BE OBTAINED BY THE CONTRACTOR AT THE CONTRACTOR'S EXPENSE PRIOR TO COMMENCEMENT OF CONSTRUCTION.
2. ALL MATERIALS AND CONSTRUCTION UNDER THIS PROJECT SHALL BE IN STRICT ACCORDANCE WITH THE REQUIREMENTS OF THE ENGINEERING AND CONSTRUCTION MANAGEMENT DEPARTMENT, CITY OF MIAMI BEACH.
3. THE LOCATIONS AND ELEVATIONS OF EXISTING UTILITIES AS SHOWN ON THE APPROVED PLANS ARE TO BE VERIFIED IN THE FIELD BY THE CONTRACTOR. APPROVAL OF DEVELOPMENT PLANS BY THE ENGINEERING AND CONSTRUCTION MANAGEMENT OF THE CITY OF MIAMI BEACH IN NO WAY IMPLIES VERIFICATION OF THE ACCURACY OF THOSE PLANS OR FEATURES DEPICTED THEREON. ALL COST FOR THIS WORK SHALL BE INCLUDED IN THE APPROPRIATE PRICE BID FOR INSTALLING THE PIPE. AFTER THESE DETERMINATIONS HAVE BEEN MADE, CONTRACTOR SHALL WORK AS NEEDED TO AVOID CONFLICT WITH EXISTING UTILITIES. (NO ADDITIONAL COST WILL BE PAID FOR THIS WORK.) EXISTING UTILITIES SHALL BE MAINTAINED IN SERVICE UNLESS OTHERWISE APPROVED BY THE UTILITY OWNER. THE CONTRACTOR SHALL NOTIFY THE CITY ENGINEER OR HIS DESIGNEE OF ANY DISCREPANCY, VARIATION OR CONFLICTS FROM THE APPROVED PLANS.
4. THE CONTRACTOR SHALL BE RESPONSIBLE AT ALL TIMES THROUGHOUT THE DURATION OF CONSTRUCTION FOR THE PROTECTION OF EXISTING AND NEWLY INSTALLED UTILITIES AND IMPROVEMENTS FROM DAMAGE, DISRUPTION OF SERVICE, OR DESTRUCTION. THE CONTRACTOR SHALL BE RESPONSIBLE FOR TAKING SUCH MEASURES AS NECESSARY TO PROTECT THE HEALTH, SAFETY, AND WELFARE OF THOSE PERSONS HAVING ACCESS TO THE WORK SITE.
5. PRIOR TO THE ISSUANCE OF ANY CONSTRUCTION PERMIT, A PRECONSTRUCTION MEETING WILL BE HELD WITH THE ENGINEERING AND CONSTRUCTION MANAGEMENT OF THE CITY. THE CONTRACTOR AND OTHER INTERESTED PARTIES SHALL ATTEND THE MEETING.
6. THE CONTRACTOR SHALL BE RESPONSIBLE FOR THE SCHEDULING OF, AND PAYMENT FOR SUCH TESTS AS MAY BE DEEMED NECESSARY BY THE CITY ENGINEER, AND AS CALLED FOR IN THE PLANS AND SPECIFICATIONS.
7. THE CONTRACTOR SHALL MAINTAIN A CURRENT APPROVED SET OF CONSTRUCTION PLANS ON SITE. THE PLANS ARE TO BE MADE AVAILABLE TO THE ENGINEERING INSPECTOR OF THE CITY OF MIAMI BEACH OR HIS DESIGNEE UPON REQUEST.
8. WHERE SANITARY SEWER MAINS CROSS UNDER WATER MAINS WITH LESS THAN 18 INCHES VERTICAL CLEARANCE, OR WHERE THE SANITARY SEWER CROSSES ABOVE A WATER MAIN, THE SANITARY SEWER SHALL BE OF CLASS 52 DUCTILE IRON PIPE OR AWWA C-900 PVC PRESSURE PIPE FOR A CONTINUOUS LENGTH OF 20 FEET CENTERED AT THE WATER MAIN, PRESSURE TESTED AT THAT LOCATION.
9. THE CONTRACTOR SHALL PROVIDE ACCESS AND ASSISTANCE TO THE CITY ENGINEER OR HIS DESIGNEE TO MAKE INSPECTIONS, AS NECESSARY, DURING CONSTRUCTION.
10. NO DEVIATION FROM APPROVED PLANS SHALL BE PERMITTED WITHOUT THE WRITTEN CONSENT OF THE CITY ENGINEER OR HIS DESIGNEE.
11. ALL WATER MAIN VALVES SHALL BE INSTALLED COMPLETE WITH 10" RISER PIPES AND NO.3 VALVE BOXES. FIRE HYDRANT AND SERVICE VALVES SHALL BE INSTALLED COMPLETE WITH 6" RISER PIPES AND NO. 2 VALVE BOXES.
12. ENGINEERING PERSONNEL WILL INSPECT ALL FACILITIES APPROVED BY THEIR OFFICE. ALL OTHER REQUIREMENTS OF THE PERMITTING AGENCY SHALL BE IN ACCORDANCE WITH THEIR STANDARD REQUIREMENTS.
13. TRENCH EXCAVATIONS IN EXCESS OF 5 FEET DEEP SHALL COMPLY WITH THE TRENCH SAFETY ACT AS PER O.S.H.A. STANDARD 29 CFR S.926.650 SUBPART P IN STATUTES. THE TRENCHES AND DITCHES SHALL BE PROTECTED IN ACCORDANCE WITH RULE 38c-43.02 FAC AND 6A-1,095(2).
14. ERECTION OR INSTALLATION OF APPROPRIATE SAFETY AND WARNING DEVICES WILL BE REQUIRED DURING THE COURSE OF CONSTRUCTION. SAID DEVICES WILL BE IN ACCORDANCE WITH THE REQUIREMENTS OF THE DEPARTMENT OF TRANSPORTATION'S "MANUAL ON TRAFFIC CONTROL AND SAFETY PRACTICES" AND THE DADE COUNTY PUBLIC WORKS MANUAL.
15. PLANS AND SPECIFICATIONS REQUIRE THAT COMPACTED BACKFILL BE PLACED ALONGSIDE OF AND OVER ALL UTILITIES. THE ENGINEER REQUIRES THAT COMPACTION TESTS BE TAKEN TO VERIFY BACKFILL COMPACTION. THE COST OF SUCH COMPACTION TESTS WILL BE BORNE BY THE CITY. THE RETESTING COST, DUE TO FAILURE OF THE COMPACTION TEST, WILL BE PAID BY THE CONTRACTOR.
16. WORK PERFORMED UNDER THIS PROJECT WILL NOT BE CONSIDERED AS COMPLETE UNTIL THE FOLLOWING DOCUMENTS ARE RECEIVED BY THE ENGINEER.
 - A. CONTRACTOR'S, SUBCONTRACTOR'S AND SUPPLIER'S WAIVER AND RELEASE OF LIEN.
 - B. CONTRACTOR'S LETTER OF WARRANTY (I.E. LETTER OF AGREEMENT).
 - C. "AS BUILT" 4 MIL MILARS 24"x36" SHOWING SPECIFIC LOCATIONS, DEPTH, ETC., OF ALL CITY FACILITIES AS LOCATED BY A LICENSED SURVEYOR, ALONG WITH (2) PRINTS OF THE "AS BUILT" WHICH HAVE BEEN SIGNED AND SEALED BY A LAND SURVEYOR REGISTERED IN THE STATE OF FLORIDA. SEE SPECS.
17. PIPE DEFLECTION AT JOINTS SHALL NOT EXCEED 75% OF THE PIPE MANUFACTURERS ALLOWABLE DEFLECTION.
18. ELEVATIONS ARE REFERENCED TO N.G.V.D. ADD 0.78 FEET, TO CONVERT TO CITY OF MIAMI BEACH DATUM.
19. THE CONTRACTOR SHALL REPLACE ALL PAVING, STABILIZED EARTH, CURBS, DRIVEWAYS, SIDEWALKS, ETC... WITH THE SAME TYPE OF MATERIAL THAT WAS REMOVED DURING CONSTRUCTION OR AS DIRECTED BY THE ENGINEER. THIS WORK WILL BE PAID FOR UNDER THE APPROPRIATE BID ITEM.
20. THE INFORMATION PROVIDED IN THESE PLANS IS SOLELY TO ASSIST THE CONTRACTOR IN ASSESSING THE NATURE AND EXTENT OF CONDITIONS WHICH MAY BE ENCOUNTERED DURING THE COURSE OF WORK. ALL PROSPECTIVE BIDDERS ARE DIRECTED, PRIOR TO BIDDING, TO CONDUCT WHATEVER INVESTIGATIONS THEY MAY DEEM NECESSARY TO ARRIVE AT THEIR OWN CONCLUSION REGARDING THE ACTUAL CONDITIONS THAT WILL BE ENCOUNTERED, AND UPON WHICH THEIR BIDS WILL BE BASED.
21. SPECIAL PIPE FOUNDATIONS, IF REQUIRED, SHALL BE DETERMINED IN THE FIELD AND THE TYPE REQUIRED WILL BE AS APPROVED BY THE ENGINEER.
22. ALL PIPE FITTINGS, SPECIALS AND VALVES INCLUDING LINING AND COATINGS, PRESSURE TESTING AND INSTALLATIONS SHALL CONFORM TO THE REQUIREMENTS OF THE CITY OF MIAMI BEACH PUBLIC WORKS DEPARTMENT, AS OUTLINED IN THE SPECIFICATIONS.
23. ALL PRESSURE PIPING AND FITTINGS 4 INCHES IN DIAMETER AND OVER SHALL HAVE RESTRAINED JOINTS IN ACCORDANCE WITH THE SPECIFICATIONS.
24. THE CONTRACTOR SHALL BE RESPONSIBLE FOR ACTUAL TIE-IN CONNECTIONS TO ALL PIPE LINES AND VALVES.
25. MECHANICAL JOINT PIPE SHOWN ON THE PLANS MAY, AT THE CONTRACTOR'S OPTION, BE SUBSTITUTED WITH PUSH-ON JOINT PIPE. ALL RESTRAINTS, THRUST BLOCKS AND SUPPORT BLOCKS AS SPECIFIED OR NOTED ON THE DRAWINGS SHALL STILL APPLY, REGARDLESS OF PIPE JOINTS TYPE USED.
26. ALL FITTINGS FOR PVC/DI SHALL BE DUCTILE IRON, SHORT BODY WITH MECHANICAL (OR PUSH ON) JOINTS, WITH HIGH STRENGTH CORTEN CORROSION RESISTANT ALLOY T-HEAD BOLTS. SUBJECT TO THE APPROVAL OF THE ENGINEER.
27. ALL GATE VALVES, WHERE SPECIFIED, FOR SIZES 4" THROUGH 10" SHALL BE RESILIENT SEATED GATE VALVES AND VALVES 12" AND LARGER SHALL BE BUTTERFLY VALVES IN CONFORMANCE WITH THE SPECIFICATIONS.
28. ALL GRASSING SHALL BE SOLID SOD OF A TYPE CONSISTENT WITH THE SURROUNDING AREA AND IN CONFORMANCE WITH THE SPECIFICATIONS.
29. CONTRACTOR IS RESPONSIBLE FOR PRESSURE TESTING ALL INSTALLED PIPE AND FITTINGS IN ACCORDANCE WITH AWWA STANDARDS.
30. DISINFECTION AND BACTERIOLOGICAL TESTING SHALL BE IN ACCORDANCE WITH AWWA STANDARDS AND F.A.C. 62-555. CONTRACTOR ASSUMES RESPONSIBILITY TO COORDINATE THE TESTING EFFORT.
31. CONTRACTOR TO SUBMIT A TRAFFIC CONTROL PLAN TO OWNER FOR APPROVAL PRIOR TO WORK IN ANY RIGHT OF WAY, AND FOR EACH PUMP STATION SITE.
32. ALL EXISTING MISCELLANEOUS METALS WHICH ARE NOT INDICATED TO BE REPLACED SHALL BE REFURBISHED AS FOLLOWS:
ALU-HYDROBLAST
STEEL-SANDBLAST AND PAINT
CAST/DUCTILE IRON-SANDBLAST AND PAINT
33. ALL INTERIOR AND EXTERIOR SURFACES OF THE PUMP STATIONS TO BE PRESSURE CLEANED, SEAL AND PAINT ALL INTERIOR AND EXTERIOR SUFACES OF STRUCTURE, WALLS, FLOORS, STAIRS, CEILINGS. SEE SPECS.
34. PRIOR TO CLEANING, ALL WALL, FLOOR, AND CEILING ANCHORING WHICH ARE NO LONGER BEING USED ARE TO BE REMOVED AND ALL HOLES FILLED TO MATCH SURFACE.
35. CONTRACTOR TO COORDINATE WITH FPL FOR ALL TRANSFORMER RELOCATIONS, EXACT LOCATIONS FOR PROVIDING NEW TRANSFORMER PADS, INSTALLATION OF POWER CONDUIT AND PROVISION OF TEMPORARY POWER AND NEW POWER TO STATIONS.

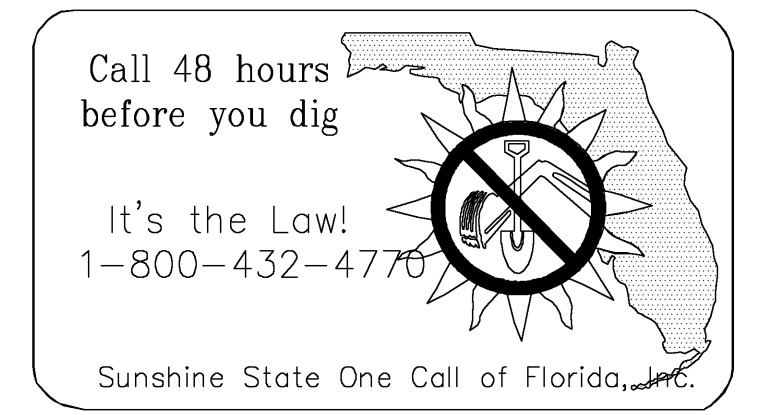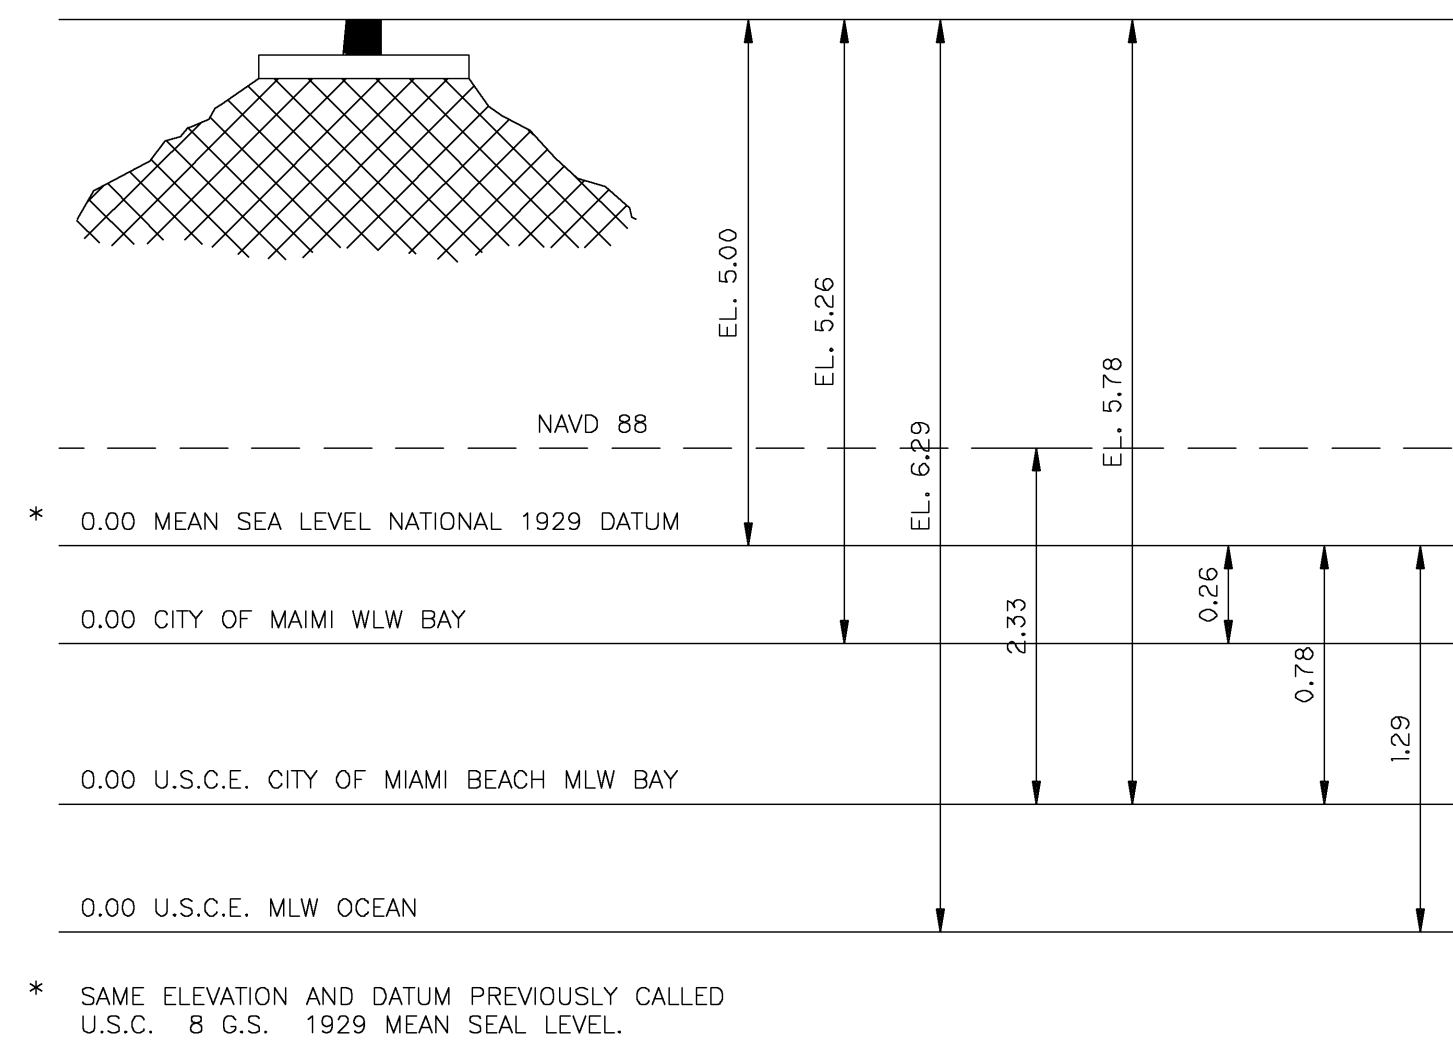

RECORD DRAWING

THIS RECORD DRAWING HAVE BEEN PREPARED BASED ON A COMBINATION OF INFORMATION PROVIDED BY OTHERS AND BY CDM. THEREFORE, THE ENGINEER HAS NOT VERIFIED THE ACCURACY OF ALL THE INFORMATION. TO THE BEST OF THE ENGINEER'S BELIEF AND KNOWLEDGE, THE INCLUDED RECORD INFORMATION IS REASONABLY ACCURATE.

By _____ Date December 2007

CDM

JONATHAN Z. GOLDMAN
P.E. NO. 48925

PROJECT NO.
9381.02R

SHEET NO.
G-6

DWG: L:\9381-02R\RECORD\General\GSP\PL006.DWG
 DATE: Jun 04, 2008 4:40pm
 USER: mrimel
 RECORD_ALT C
 XREFS: lbrkt

REV. NO.	DATE	DRWN	CHKD	REMARKS
12/07	ALN	JEC		RECORD DRAWING
12/02	ALN	JEC		CLARIFIED NOTE NO. 18
3/99	ALN	WMS		CONFORMED DRAWINGS

DESIGNED BY: W. SPRIGGS
 DRAWN BY: A. CHINNERY
 SHEET CHECKED BY: W. SPRIGGS
 CROSS CHECKED BY: E. STURTZ
 APPROVED BY: J. GOLDMAN
 DATE: DECEMBER, 1997


CAMP DRESSER & McKEE INC.
 800 Brickwell Avenue, Suite 710
 Miami, Florida 33131
 Tel: 305-572-7171
 Cert. of Authorization No. 20

CITY OF MIAMI BEACH,
FLORIDA

CDM
environmental engineers, scientists,
planners, & management consultants

WATER AND WASTEWATER SYSTEM IMPROVEMENTS

GENERAL NOTES

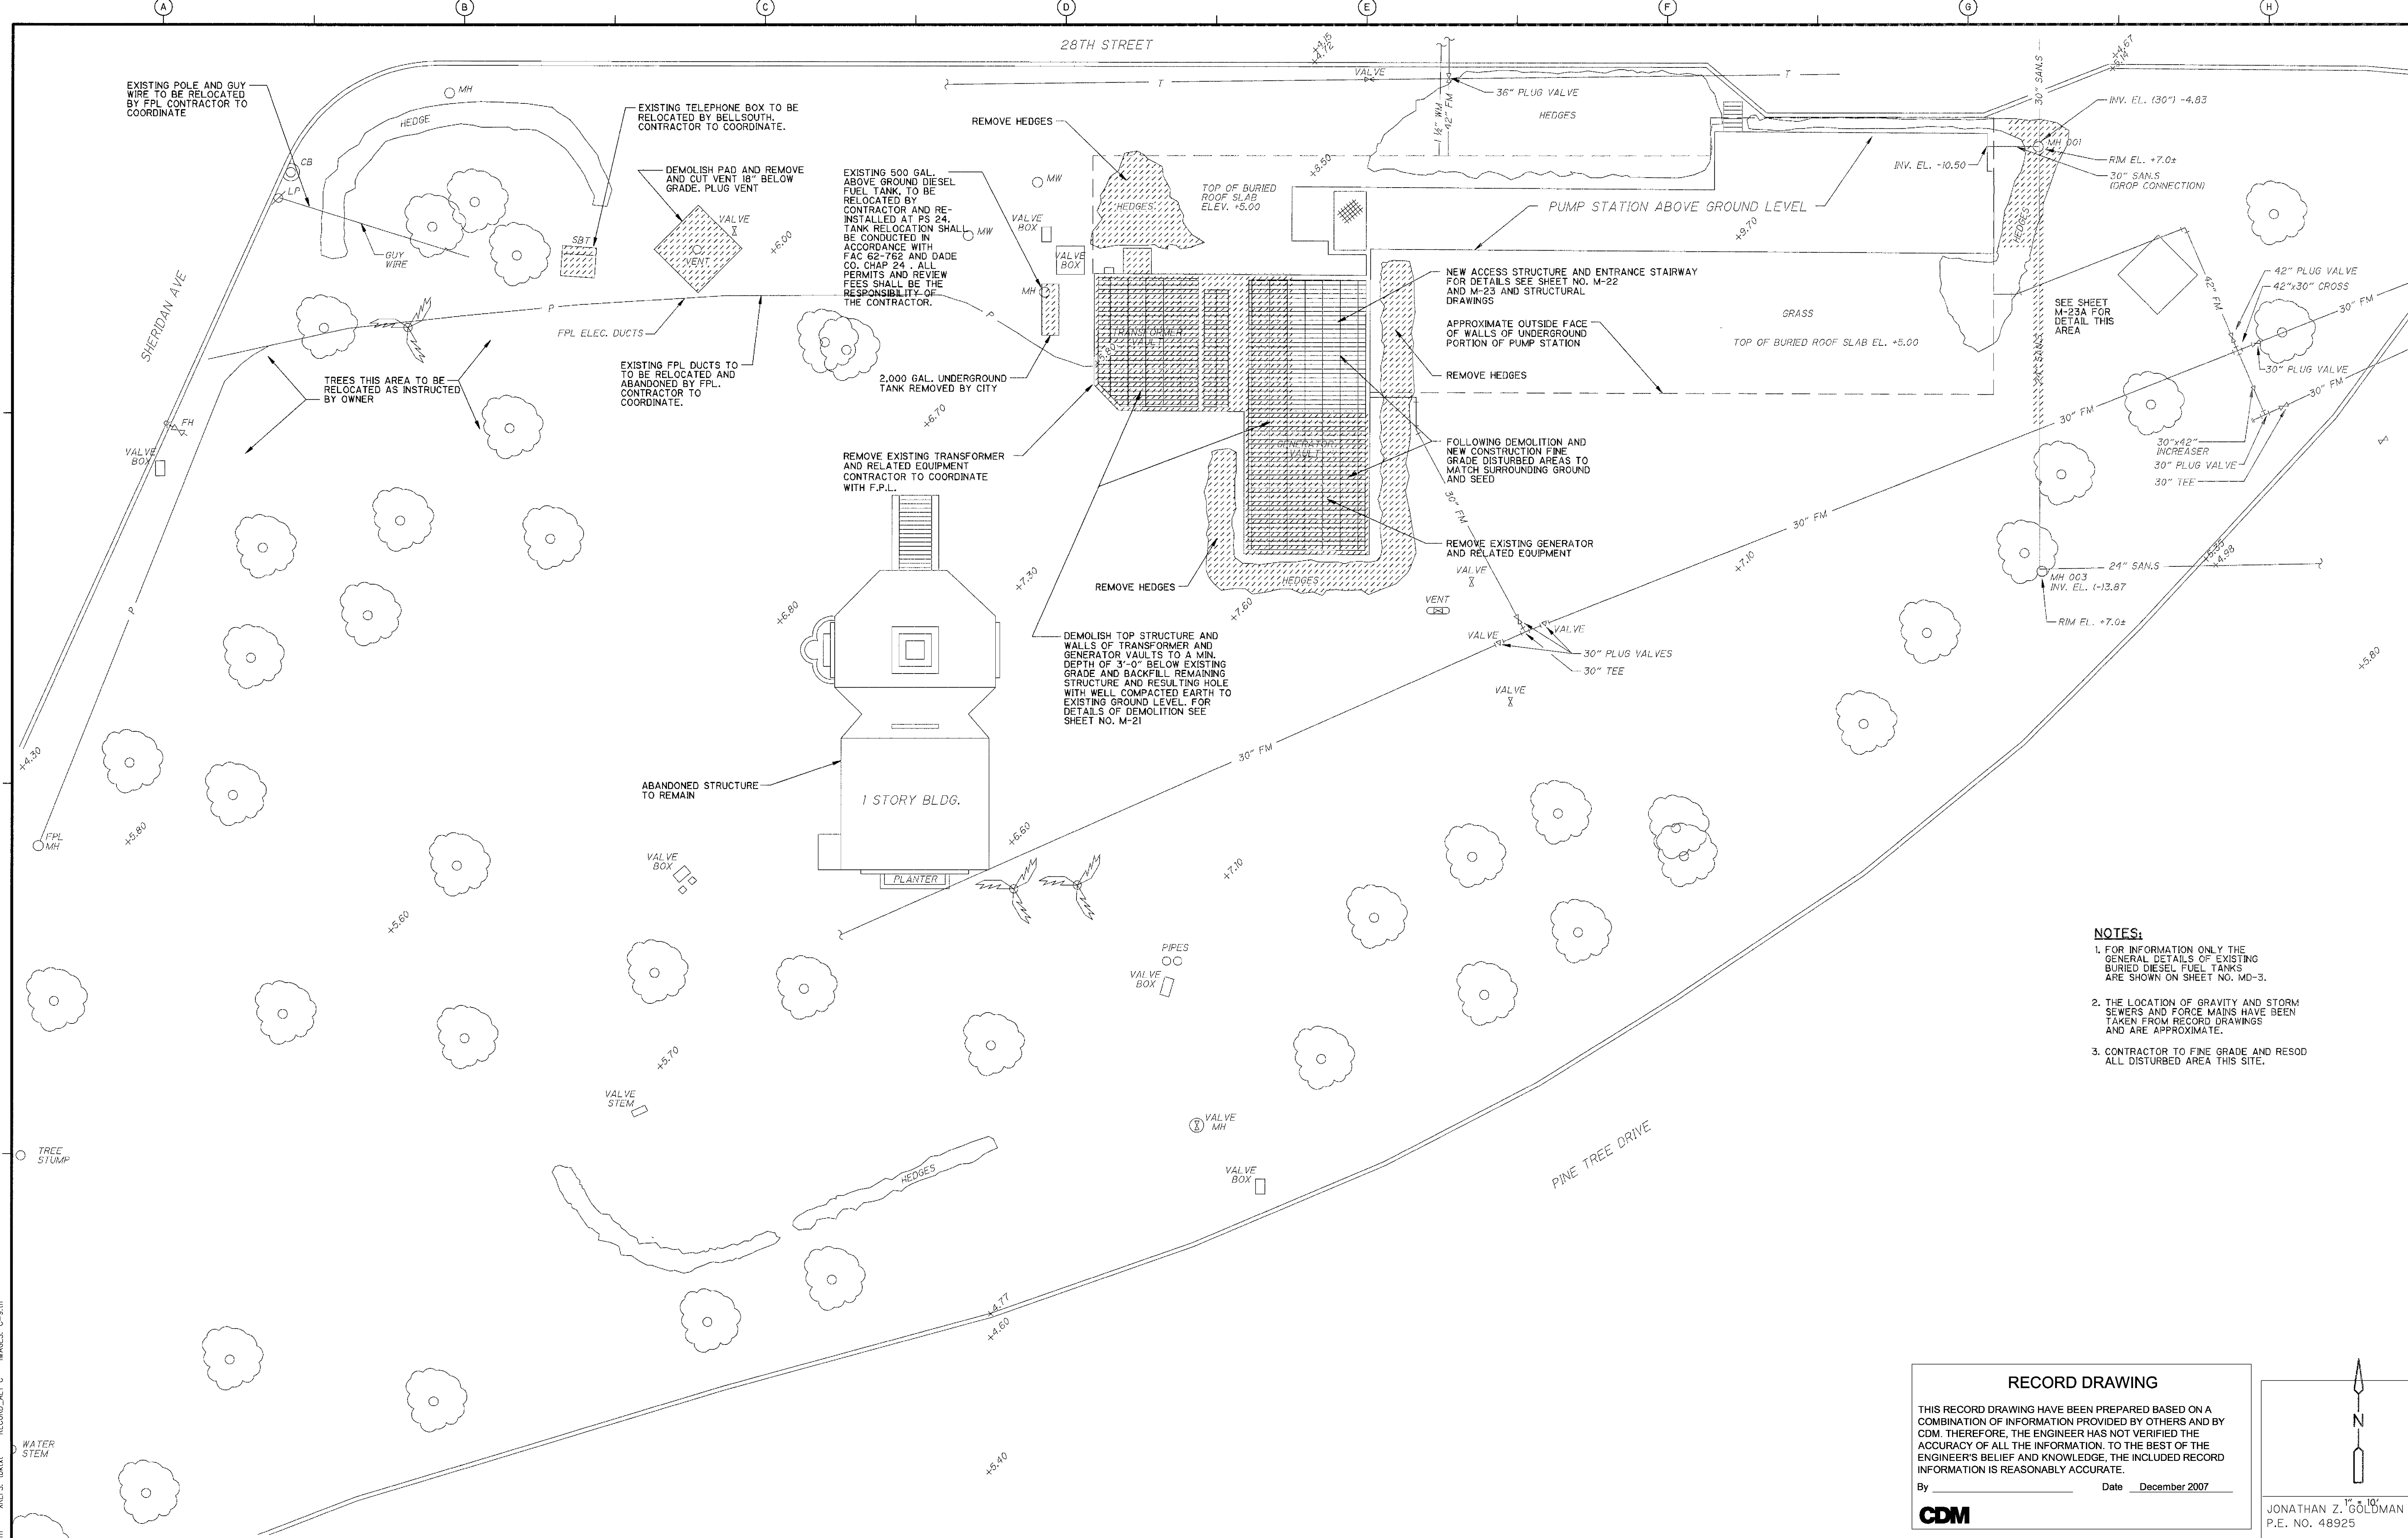

- NOTES:**
1. FOR INFORMATION ONLY THE GENERAL DETAILS OF EXISTING BURIED DIESEL FUEL TANKS ARE SHOWN ON SHEET NO. MD-3.
 2. THE LOCATION OF GRAVITY AND STORM SEWERS AND FORCE MAINS HAVE BEEN TAKEN FROM RECORD DRAWINGS AND ARE APPROXIMATE.
 3. CONTRACTOR TO FINE GRADE AND RESOD ALL DISTURBED AREA THIS SITE.

RECORD DRAWING

THIS RECORD DRAWING HAVE BEEN PREPARED BASED ON A COMBINATION OF INFORMATION PROVIDED BY OTHERS AND BY CDM. THEREFORE, THE ENGINEER HAS NOT VERIFIED THE ACCURACY OF ALL THE INFORMATION. TO THE BEST OF THE ENGINEER'S BELIEF AND KNOWLEDGE, THE INCLUDED RECORD INFORMATION IS REASONABLY ACCURATE.

By _____ Date December 2007

CDM

N

1" = 10'

JONATHAN Z. GOLDMAN
P.E. NO. 48925

REV. NO.	DATE	DRWN	CHKD	REMARKS
12/07	ALN	JEC		RECORD DRAWING
3/99	ALN	WMS		CONFORMED DRAWINGS

DESIGNED BY: W. SPRIGGS
 DRAWN BY: A. NUNES
 SHEET CHK'D BY: W. SPRIGGS
 CROSS CHK'D BY: E. STURTZ
 APPROVED BY: J. GOLDMAN
 DATE: DECEMBER, 1997

CAMP DRESSER & McKEE INC.
 800 Brickwell Avenue, Suite 710
 Miami, Florida 33131
 Tel: 305-372-7111
 Cert. of Authorization No. 20

CDM
*environmental engineers, scientists,
 planners, & management consultants*

CITY OF MIAMI BEACH, FLORIDA

WATER AND WASTEWATER SYSTEM IMPROVEMENTS


**WASTEWATER PUMP STATION NO. 28
 DEMOLITION SITE PLAN**

PROJECT NO.
9381-02R


SHEET NO.
C-9

DWG: L:\9381-02R\RECORD\CDM\STRT\009.DWG
 DATE: Jan 04, 2008 4:46pm
 USER: juneval
 RECORD_ALT_C
 XREFS: bskxt

DWG: L:\9381-02R\record\c0101051P1.DWG USER: ouafid
 DATE: Jul 01, 2008 9:45am XREFS: RECORD_AIT_C IMAGES: C-10A.rif

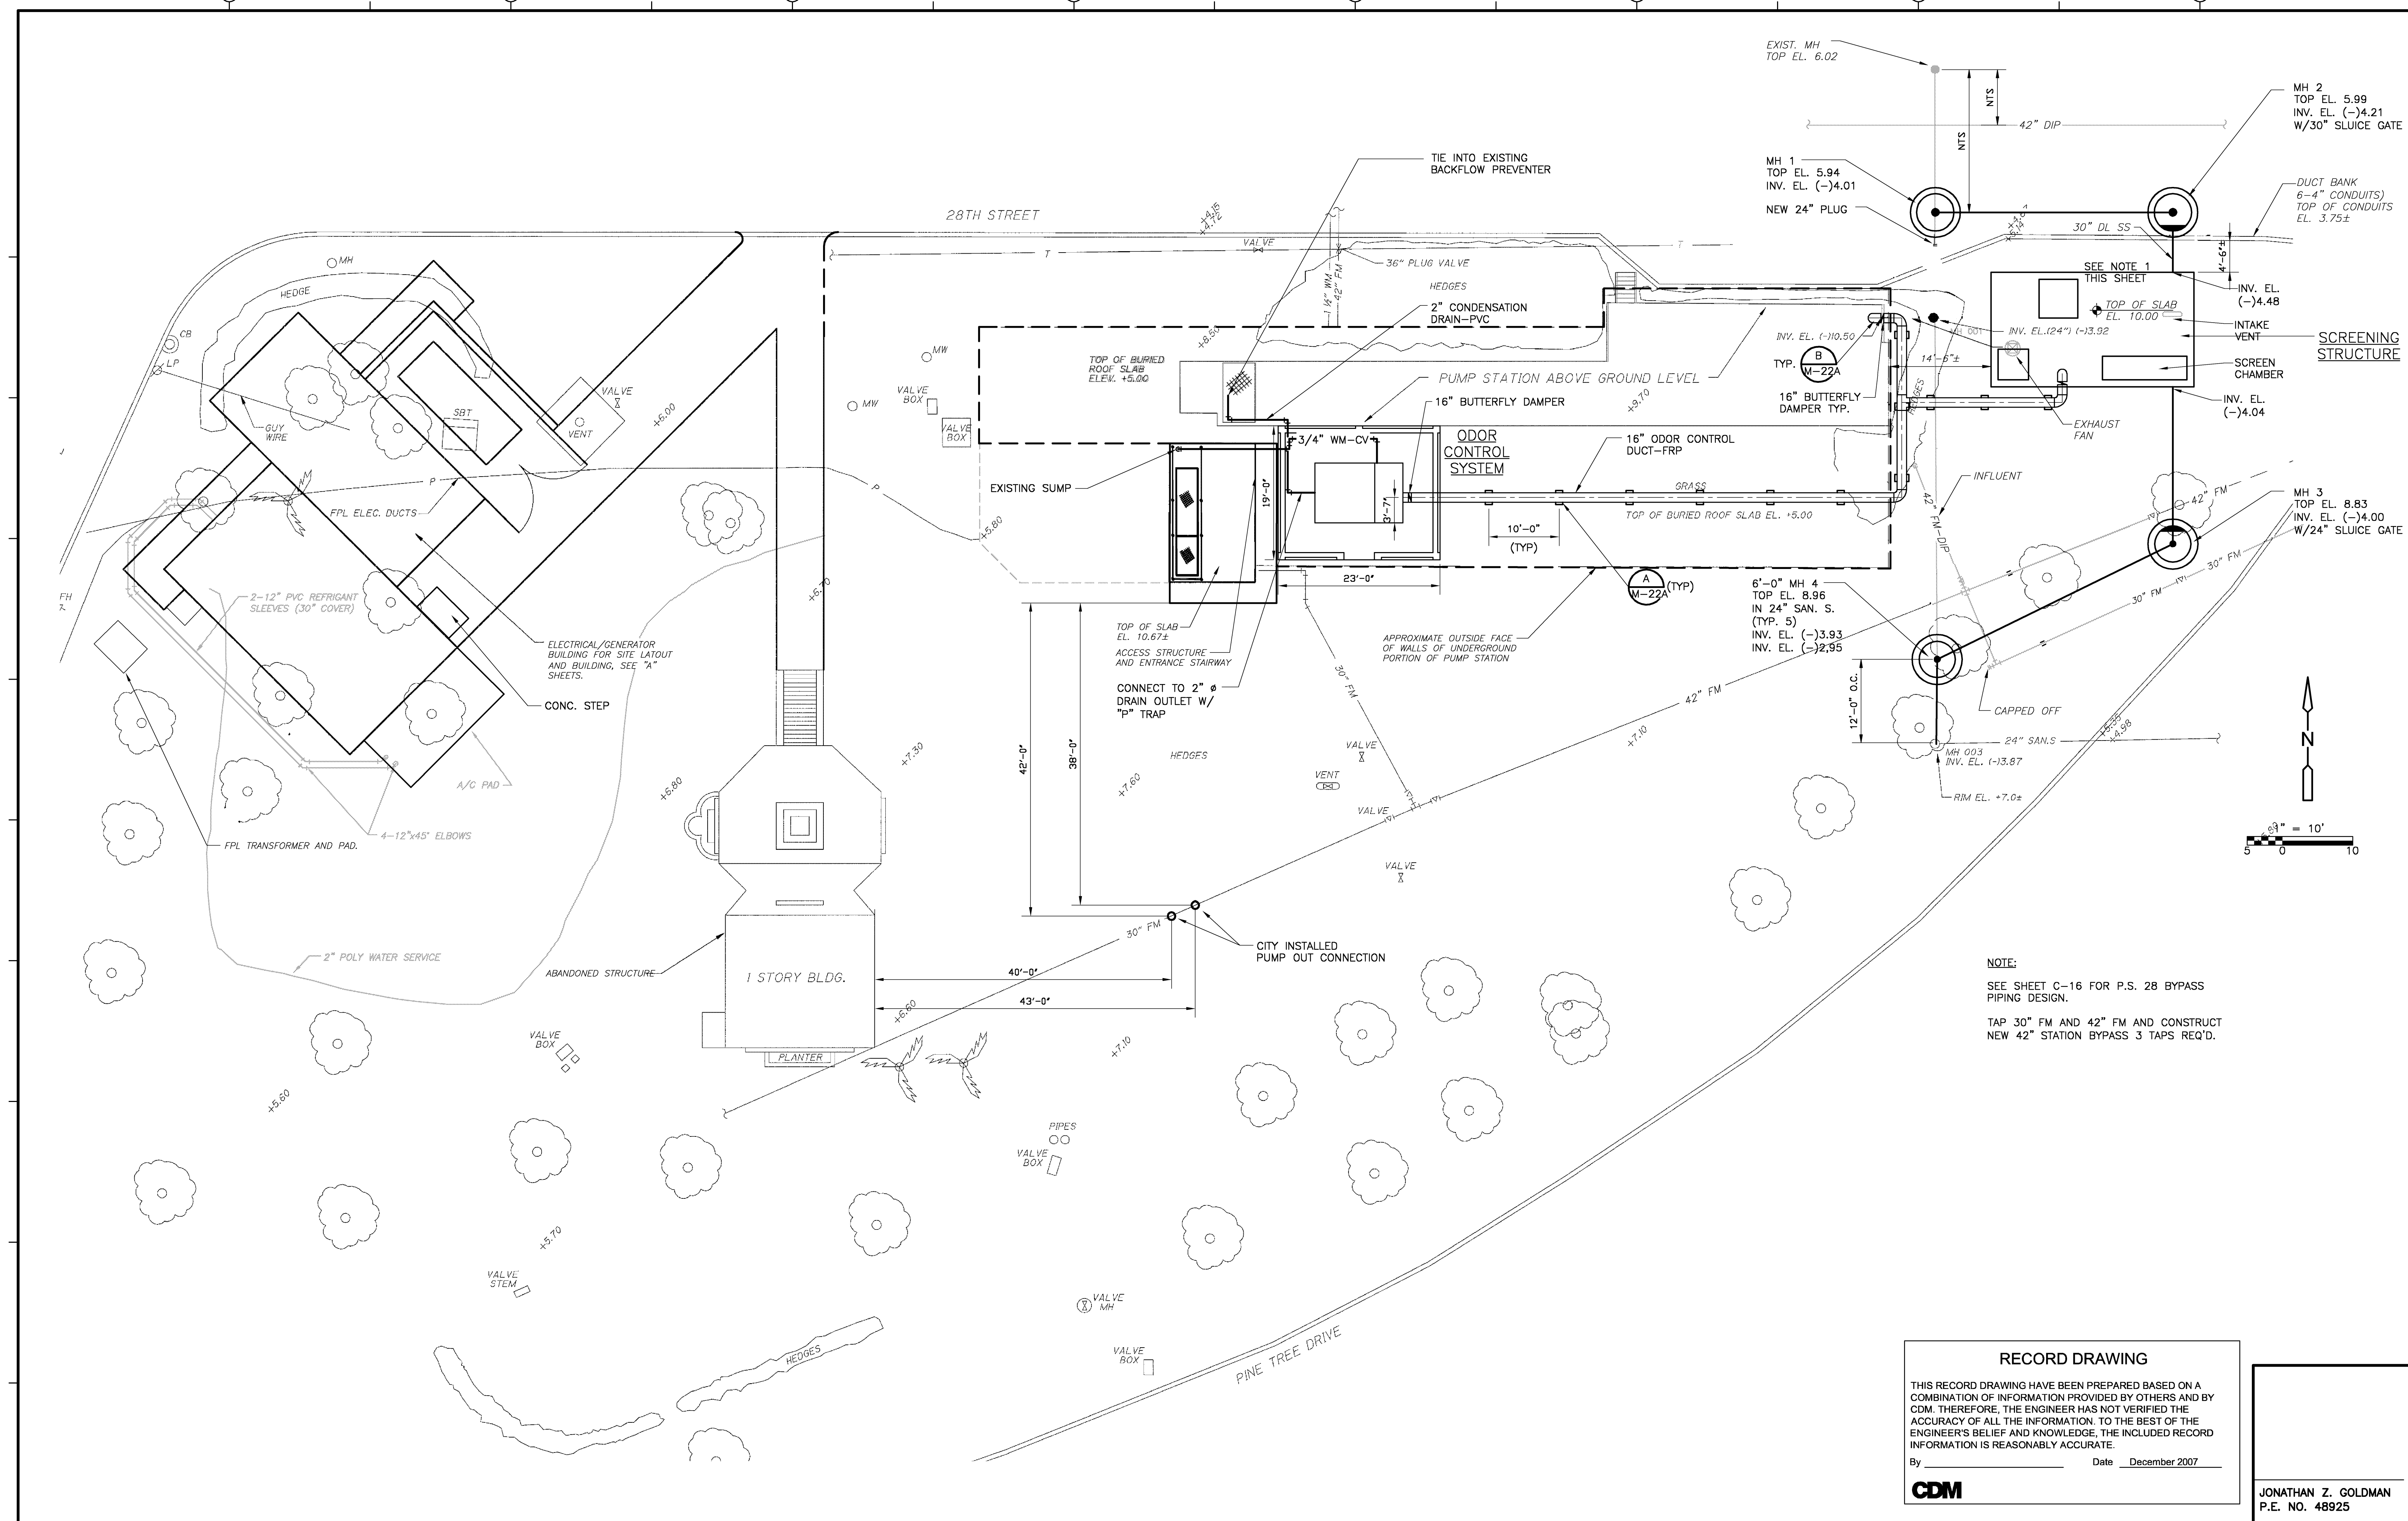

NOTE:
 SEE SHEET C-16 FOR P.S. 28 BYPASS PIPING DESIGN.
 TAP 30" FM AND 42" FM AND CONSTRUCT NEW 42" STATION BYPASS 3 TAPS REQ'D.

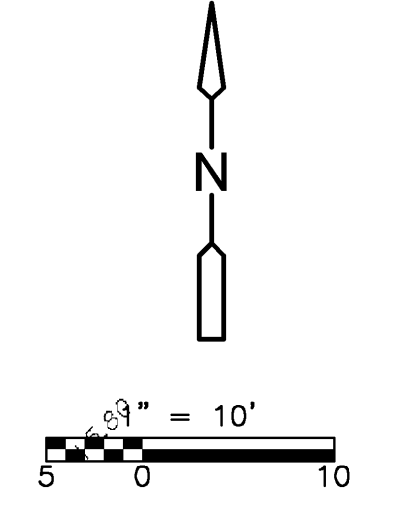

RECORD DRAWING

THIS RECORD DRAWING HAS BEEN PREPARED BASED ON A COMBINATION OF INFORMATION PROVIDED BY OTHERS AND BY CDM. THEREFORE, THE ENGINEER HAS NOT VERIFIED THE ACCURACY OF ALL THE INFORMATION. TO THE BEST OF THE ENGINEER'S BELIEF AND KNOWLEDGE, THE INCLUDED RECORD INFORMATION IS REASONABLY ACCURATE.

By _____ Date December 2007

CDM

JONATHAN Z. GOLDMAN
 P.E. NO. 48925

REV. NO.	DATE	DRWN	CHKD	REMARKS
12/07	ALN	JEC		RECORD DRAWING
6/07	LRB	WMS		RELOCATE ODOR CONTROL SYSTEM
2/07	JDA	WMS		SHEET ISSUED FOR CHANGE ORDER NO. 6

DESIGNED BY: G. LAWRENCE
 DRAWN BY: D. AUST
 SHEET CHK'D BY: W. SPRIGGS
 CROSS CHK'D BY: G. LAWRENCE
 APPROVED BY: S. MARTIN
 DATE: DECEMBER, 1997

CAMP DRESSER & MCKEE INC.
 800 Brickwell Avenue, Suite 710
 Miami, Florida 33131
 Tel: 305-372-7171
 Cert. of Authorization No. 20

CDM
environmental engineers, scientists,
planners, & management consultants


CITY OF MIAMI BEACH, FLORIDA

WATER AND WASTEWATER SYSTEM IMPROVEMENTS

WASTEWATER PUMP STATION NO. 28
SITE PLAN


PROJECT NO.
 9381-02R C01051P10

SHEET NO.
C-10

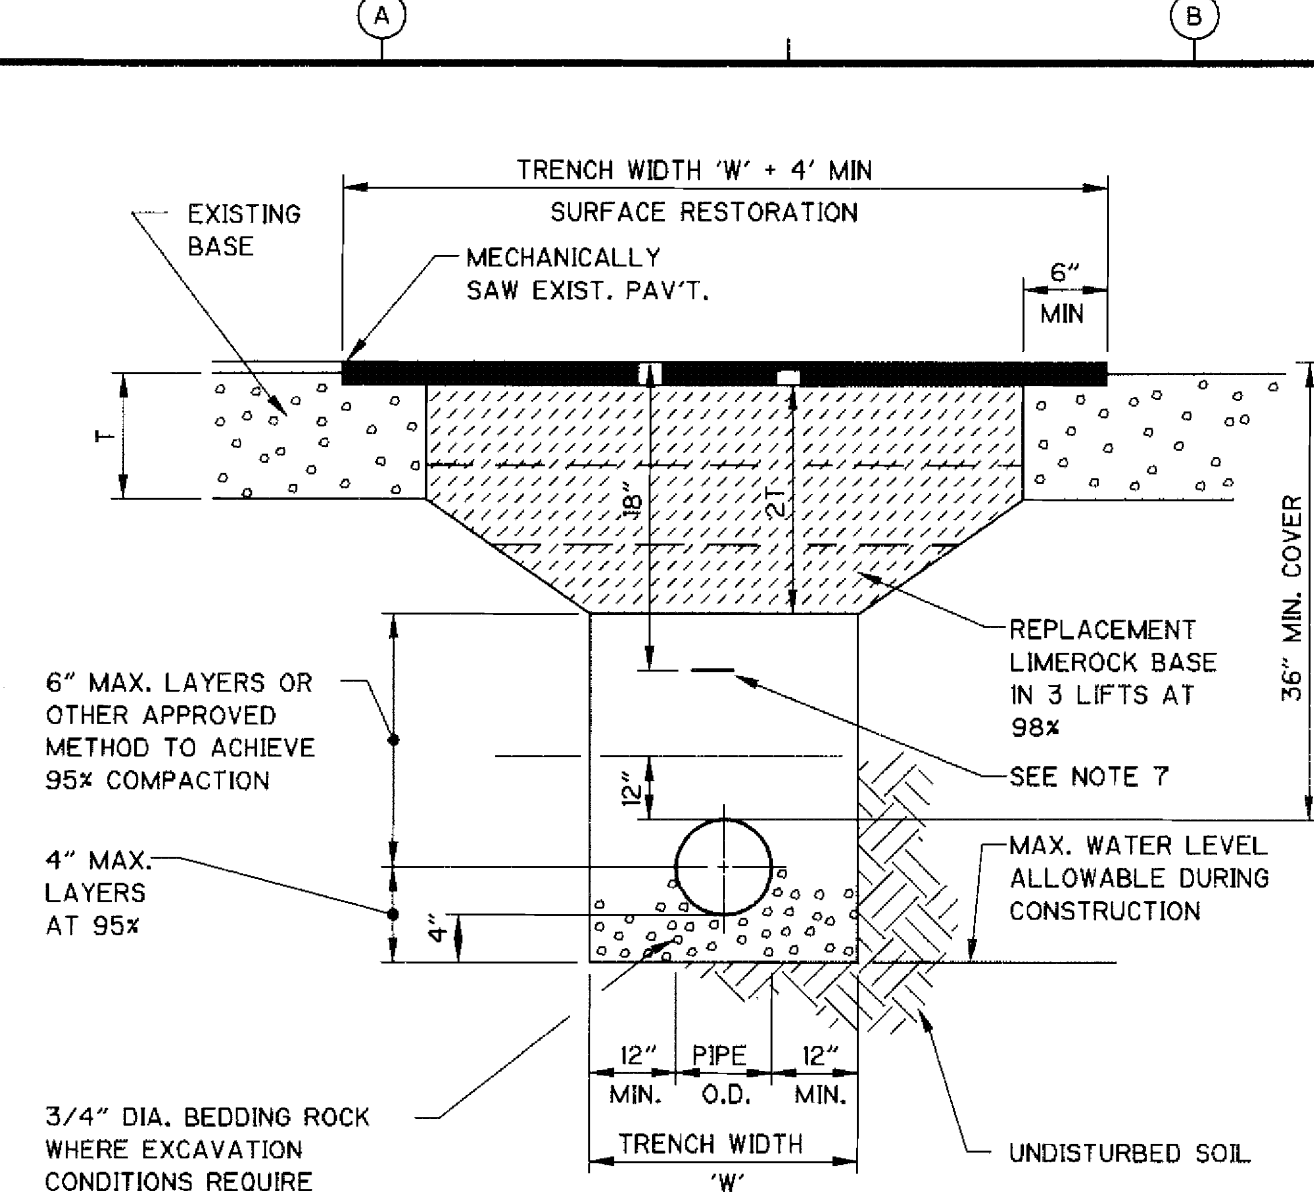


- NOTES:**
- WHERE SOIL CONDITIONS CAN NOT BE MAINTAINED AS SHOWN ABOVE, PROVIDE APPROVED METHOD OF CONSTRUCTION.
 - SHEETING WILL BE REQUIRED AS DETERMINED IN THE FIELD.
 - NEW SURFACING MATERIALS SHALL BE CONSISTENT WITH EXISTING AND SHALL HAVE LAPPED AND FEATHERED JOINTS (1 1/2" MIN. THK.)
 - COMPACTION PERCENTAGES SHOWN REFER TO A.A.S.H.T.O. T-180.
 - FOR PVC PIPE ONLY - INSTALL METALLIC TAPE OVER FULL LENGTH OF PIPE. SEE SPECIFICATIONS.

(PAVED AREAS)
TRENCH DETAIL
NTS

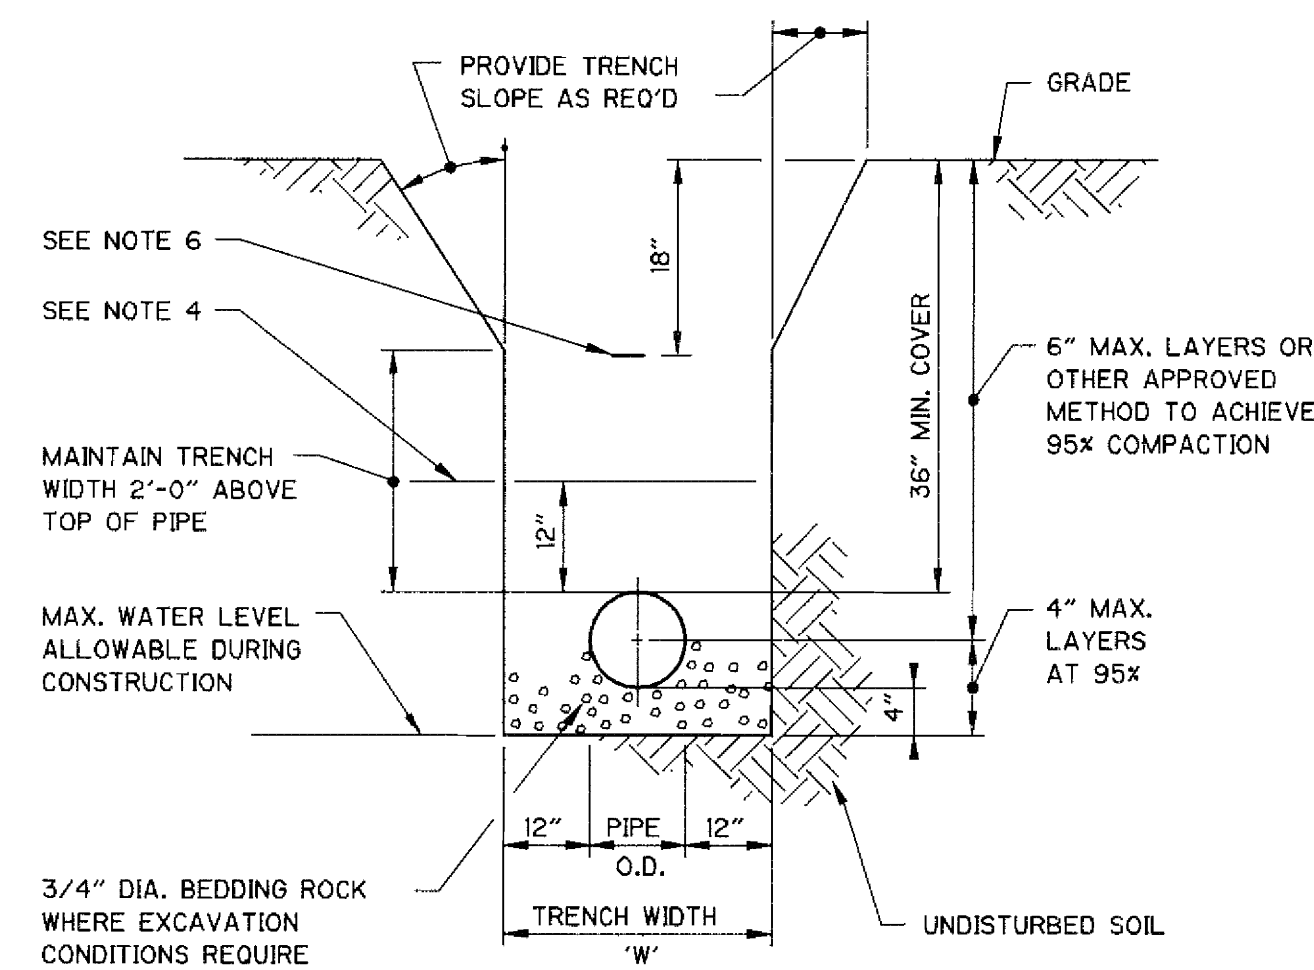


- NOTES:**
- WHERE SOIL CONDITIONS CAN NOT BE MAINTAINED AS SHOWN ABOVE, PROVIDE APPROVED METHOD OF CONSTRUCTION.
 - SHEETING WILL BE REQUIRED AS DETERMINED IN THE FIELD.
 - COMPACTION PERCENTAGES SHOWN REFER TO A.A.S.H.T.O. T-180.
 - MECHANICAL COMPACTION NOT ALLOWED BELOW THIS LEVEL.
 - PVC PIPE TO HAVE ROCK BACKFILL TO ϕ OF PIPE.
 - FOR PVC PIPE ONLY - INSTALL METALLIC TAPE OVER FULL LENGTH OF PIPE. SEE SPECIFICATIONS.

(UNPAVED AREAS)
TRENCH DETAIL
NTS

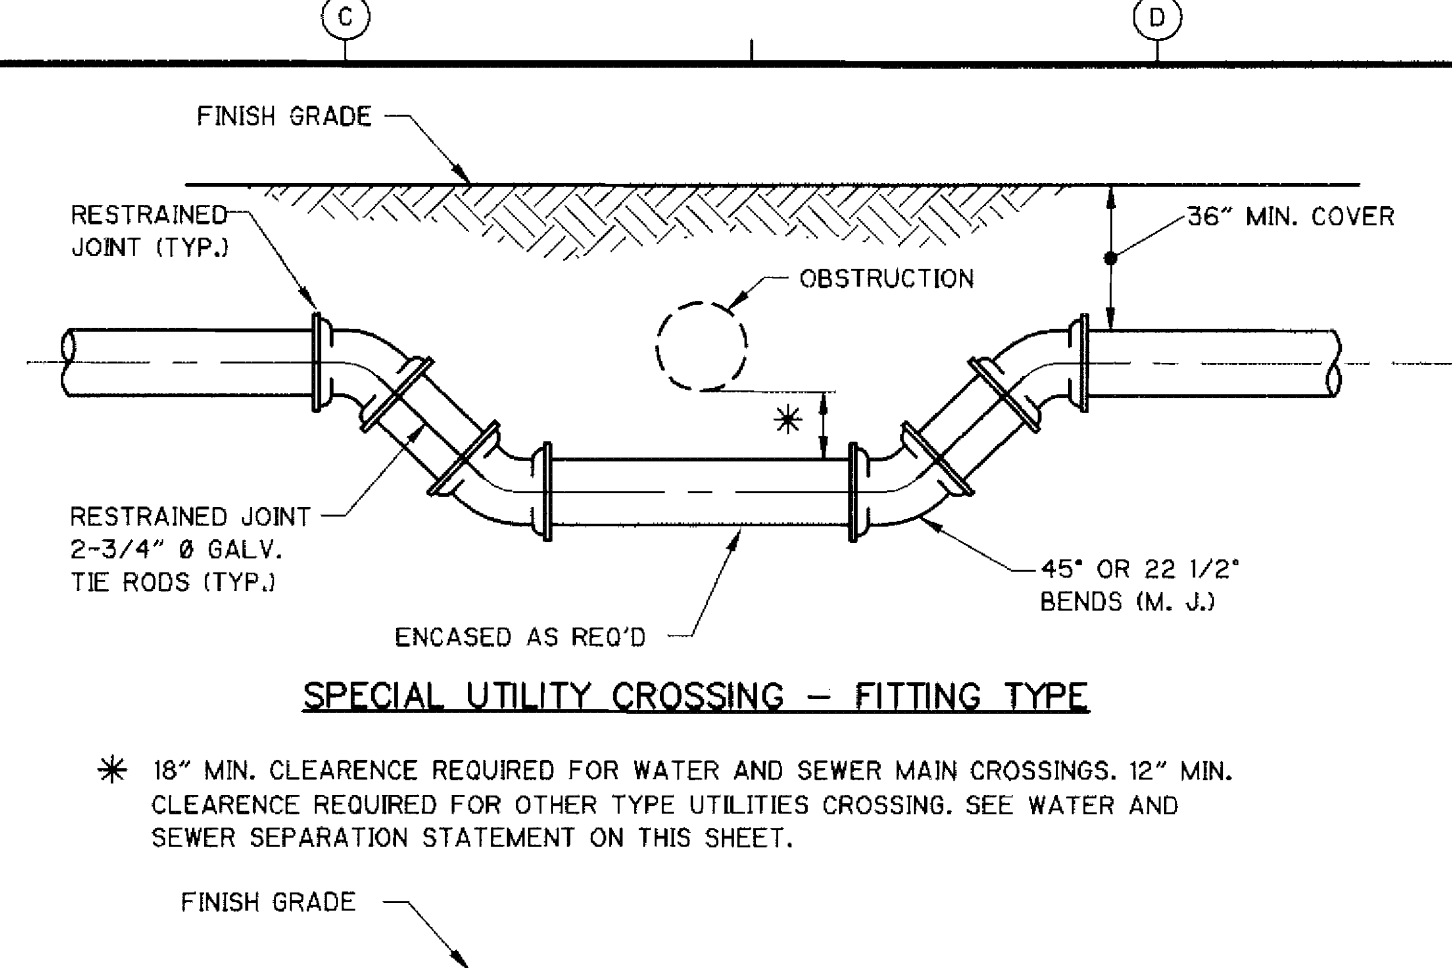

SPECIAL UTILITY CROSSING - FITTING TYPE

- * 18" MIN. CLEARANCE REQUIRED FOR WATER AND SEWER MAIN CROSSINGS. 12" MIN. CLEARANCE REQUIRED FOR OTHER TYPE UTILITIES CROSSING. SEE WATER AND SEWER SEPARATION STATEMENT ON THIS SHEET.

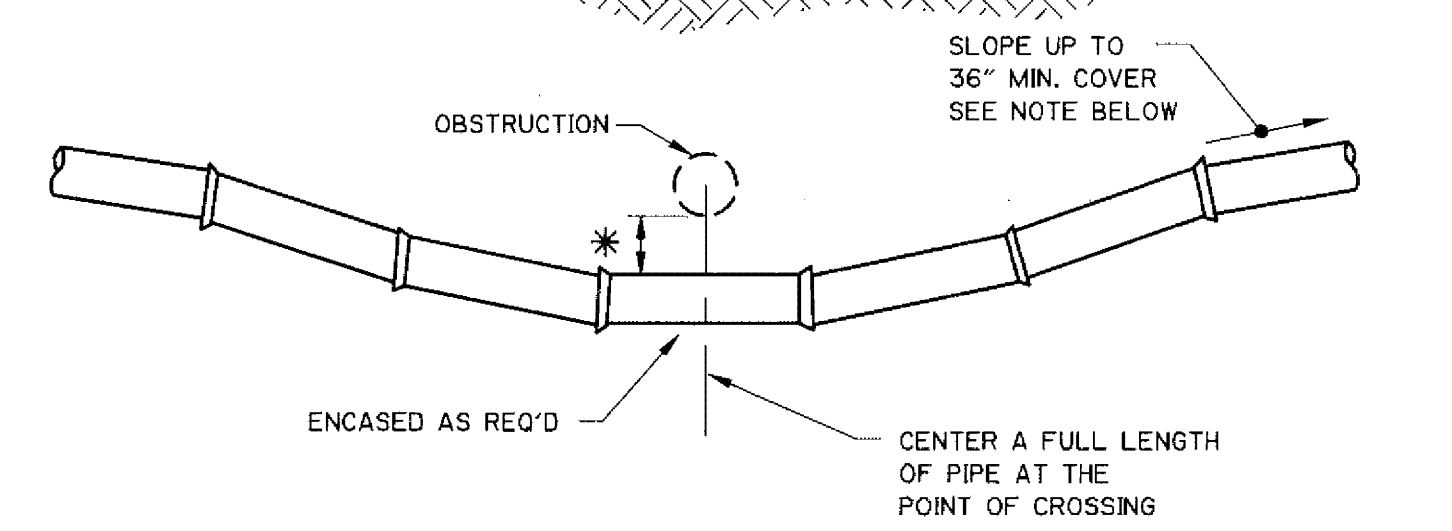


STANDARD UTILITY CROSSING - DEFLECTION TYPE

- NOTE:**
- THE DEFLECTION TYPE CROSSING SHALL BE USED WHERE EVER POSSIBLE. ONLY UNDER SPECIFIC ORDERS BY THE ENGINEER SHALL THE FITTING TYPE CROSSING BE ALLOWED.
 - CONSTRUCT STANDARD CROSSING USING 75% OF MANUFACTURERS MAXIMUM JOINT DEFLECTION (MAX.)
 - COAT TIE RODS WITH A COAL TAR ENAMEL AFTER ASSEMBLY. (2 COATS MIN.)
 - TIE RODS MAY BE OMITTED WHEN OTHER APPROVED METHODS OF RESTRAINING ARE UTILIZED.


UTILITY CROSSING
NTS

STANDARD WATER AND SEWER SEPARATION STATEMENT


- STORM AND SANITARY SEWERS CROSSING UNDER WATER MAINS SHALL BE LAID TO PROVIDE A MINIMUM VERTICAL DISTANCE OF EIGHTEEN (18) INCHES BETWEEN THE INVERT OF THE UPPER PIPE AND THE CROWN OF THE LOWER PIPE. WHERE THIS MINIMUM SEPARATION CANNOT BE MAINTAINED, THE CROSSING SHALL BE ARRANGED SO THAT THE SEWER PIPE JOINTS AND WATER MAIN JOINTS ARE EQUIDISTANT FROM THE POINT OF CROSSING WITH NO LESS THAN TEN (10) FEET BETWEEN ANY TWO JOINTS AND BOTH PIPES SHALL BE D.I.P. WHERE THERE IS NOT ALTERNATIVE TO SEWER PIPES CROSSING OVER A WATER MAIN, THE CRITERIA FOR MINIMUM SEPARATION BETWEEN LINES AND JOINTS IN THE ABOVE, SHALL BE REQUIRED AND BOTH PIPES SHALL BE D.I.P. IRRESPECTIVE OF SEPARATION. D.I.P. IS NOT REQUIRED FOR STORM SEWERS.
- MAINTAIN TEN (10) FEET HORIZONTAL DISTANCE BETWEEN WATER MAIN AND STORM OR SANITARY SEWER MAIN, AS A MINIMUM.
- FORCE MAIN CROSSING WATER MAIN SHALL BE LAID TO PROVIDE A MINIMUM VERTICAL DISTANCE OF EIGHTEEN (18) INCHES BETWEEN THE OUTSIDE OF THE FORCE MAIN AND OUTSIDE OF THE WATER MAIN WITH WATER CROSSING OVER THE FORCE MAIN.

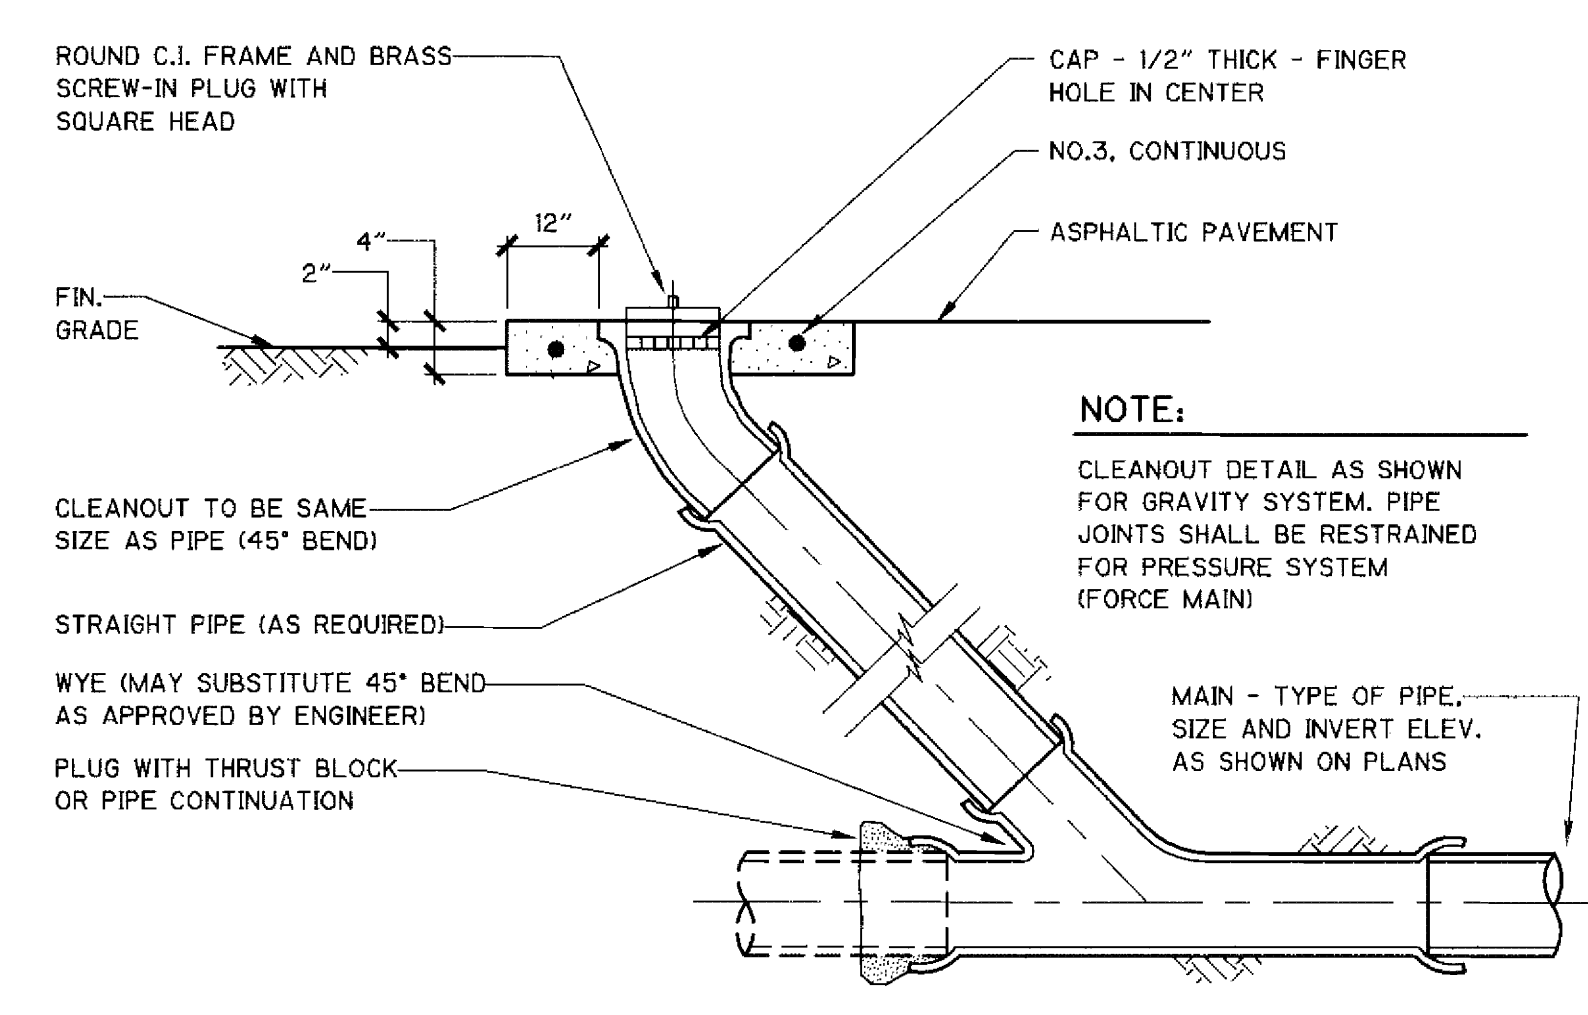


GRAVITY LINE CLEANOUT DETAIL
NTS

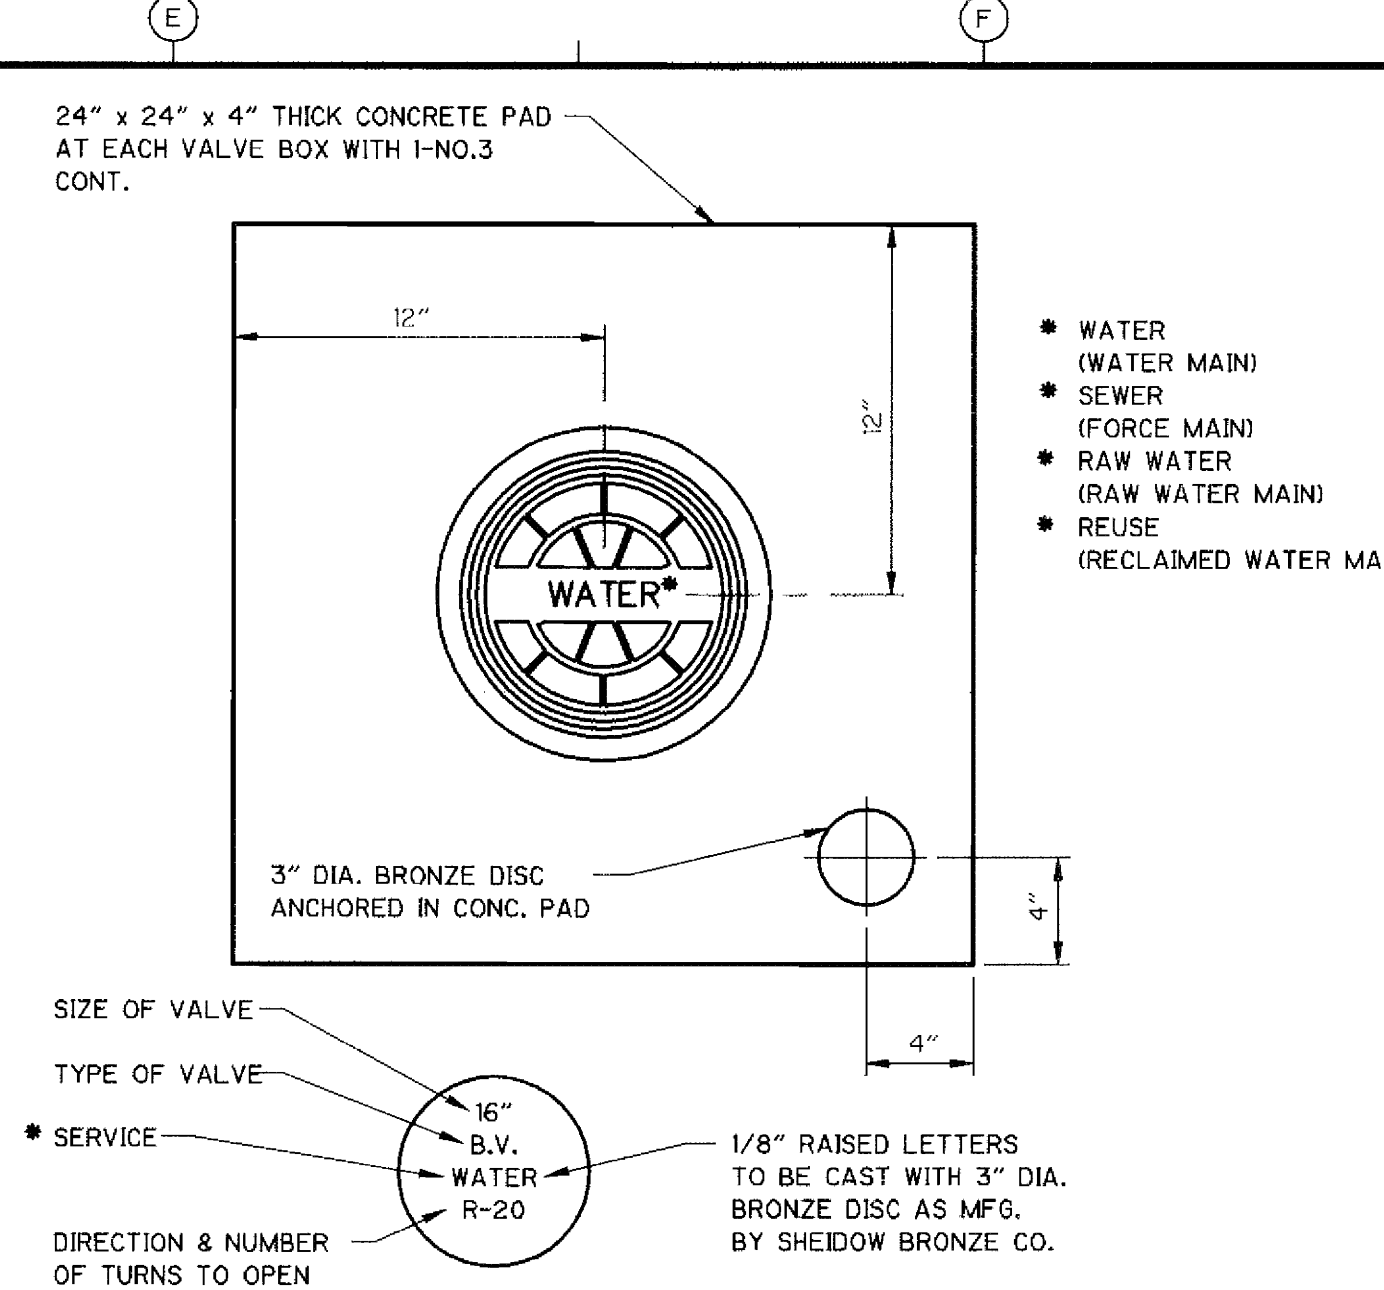


CONCRETE VALVE PAD/IDENT. DISC.
NTS

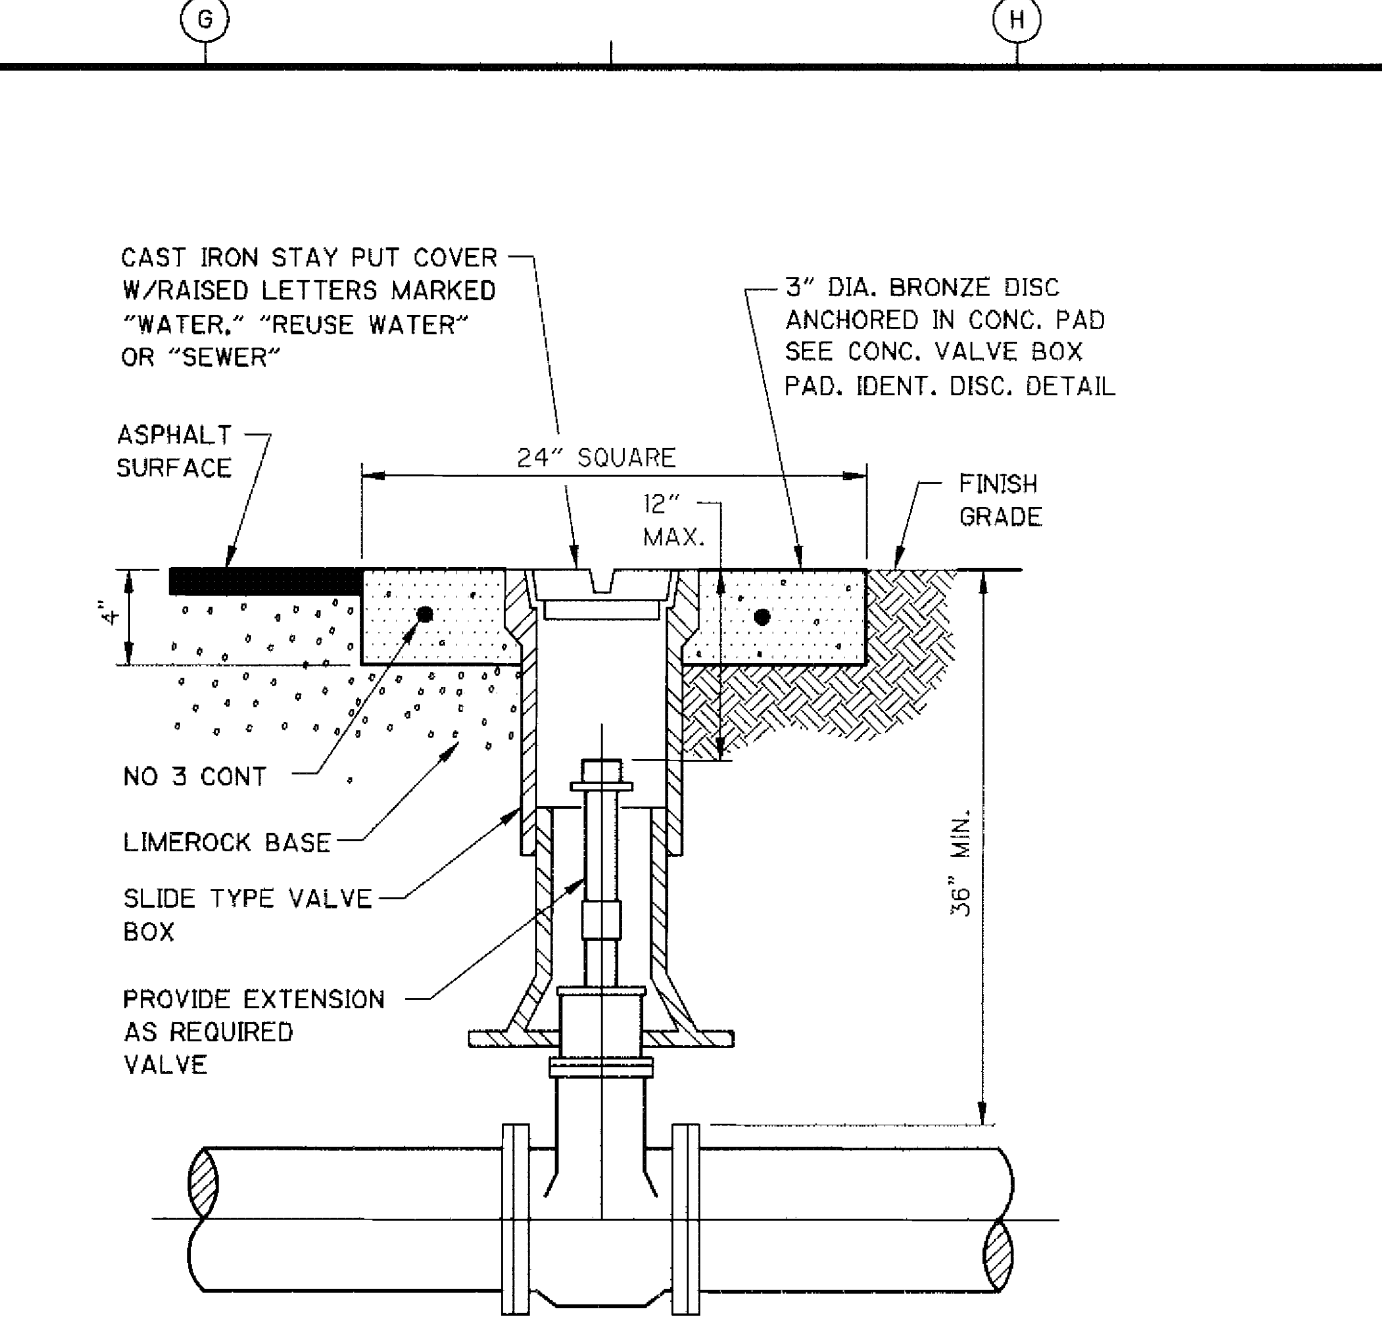


VALVE AND BOX
NTS

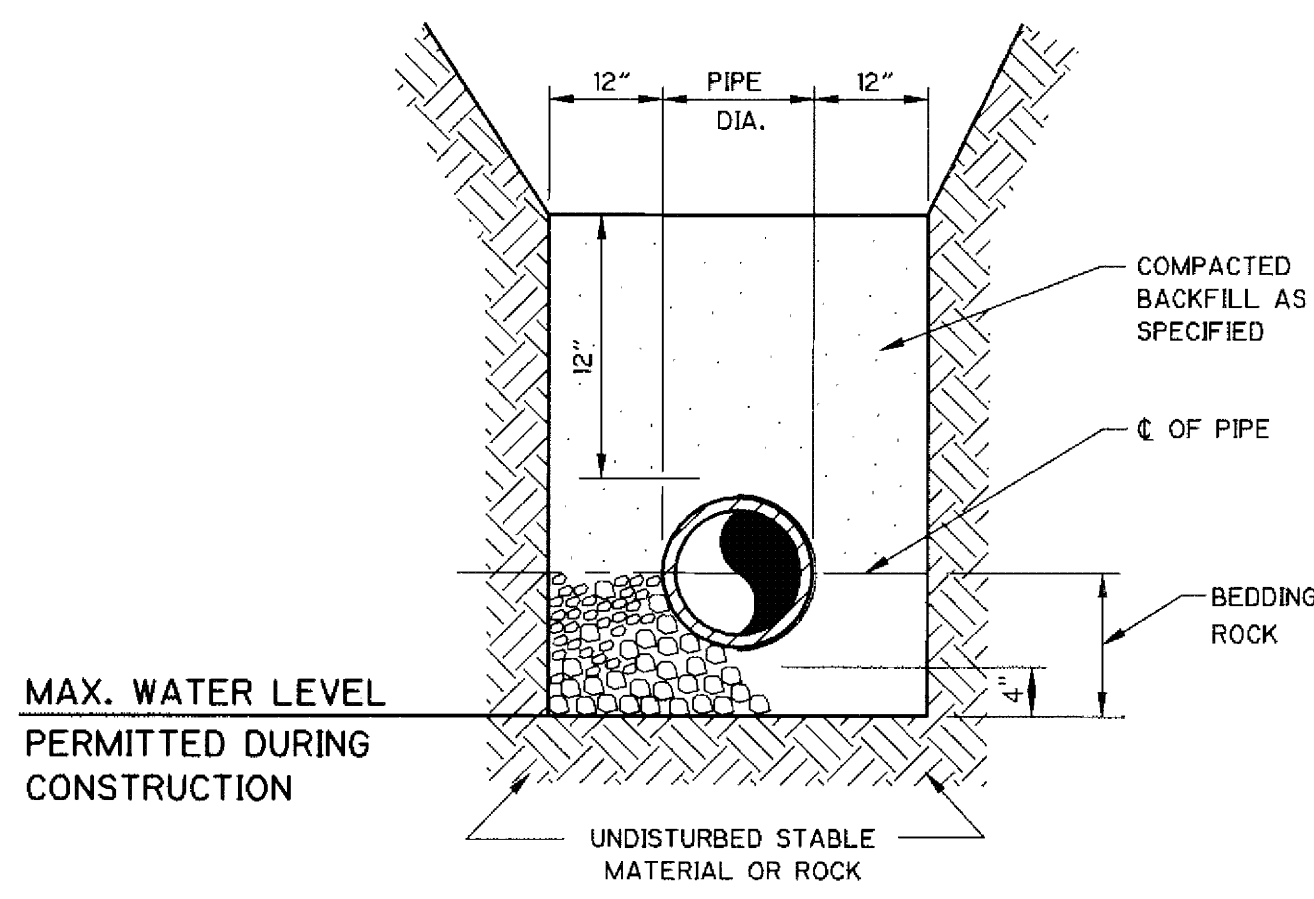


SPECIAL BEDDING
NTS

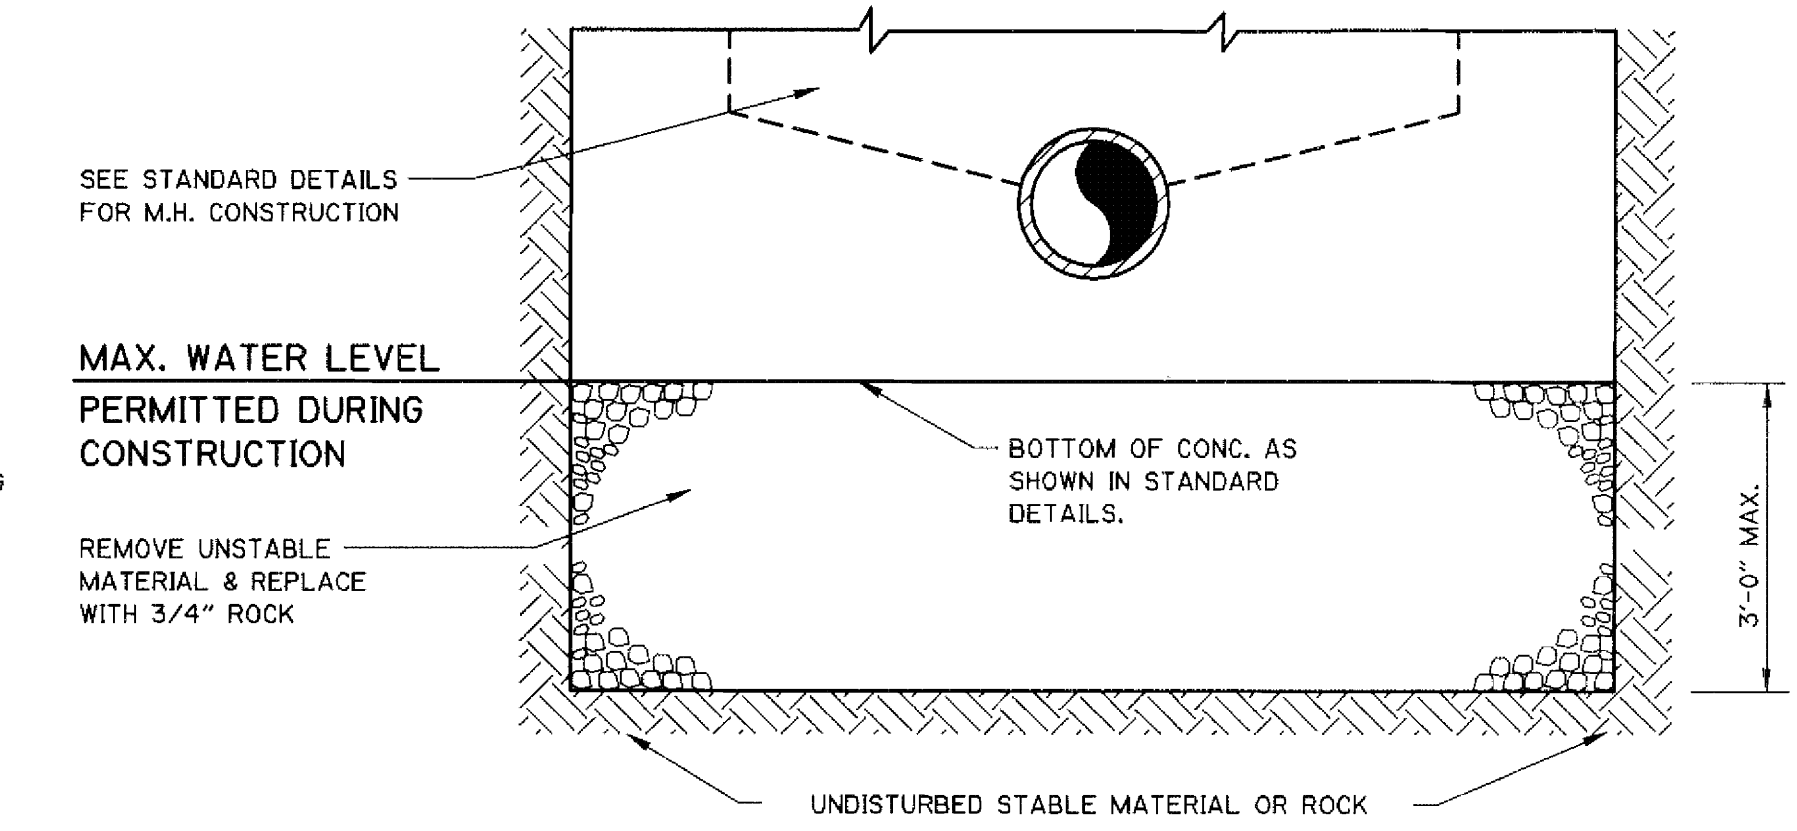

TYPE 2 MANHOLE FOUNDATION
NTS

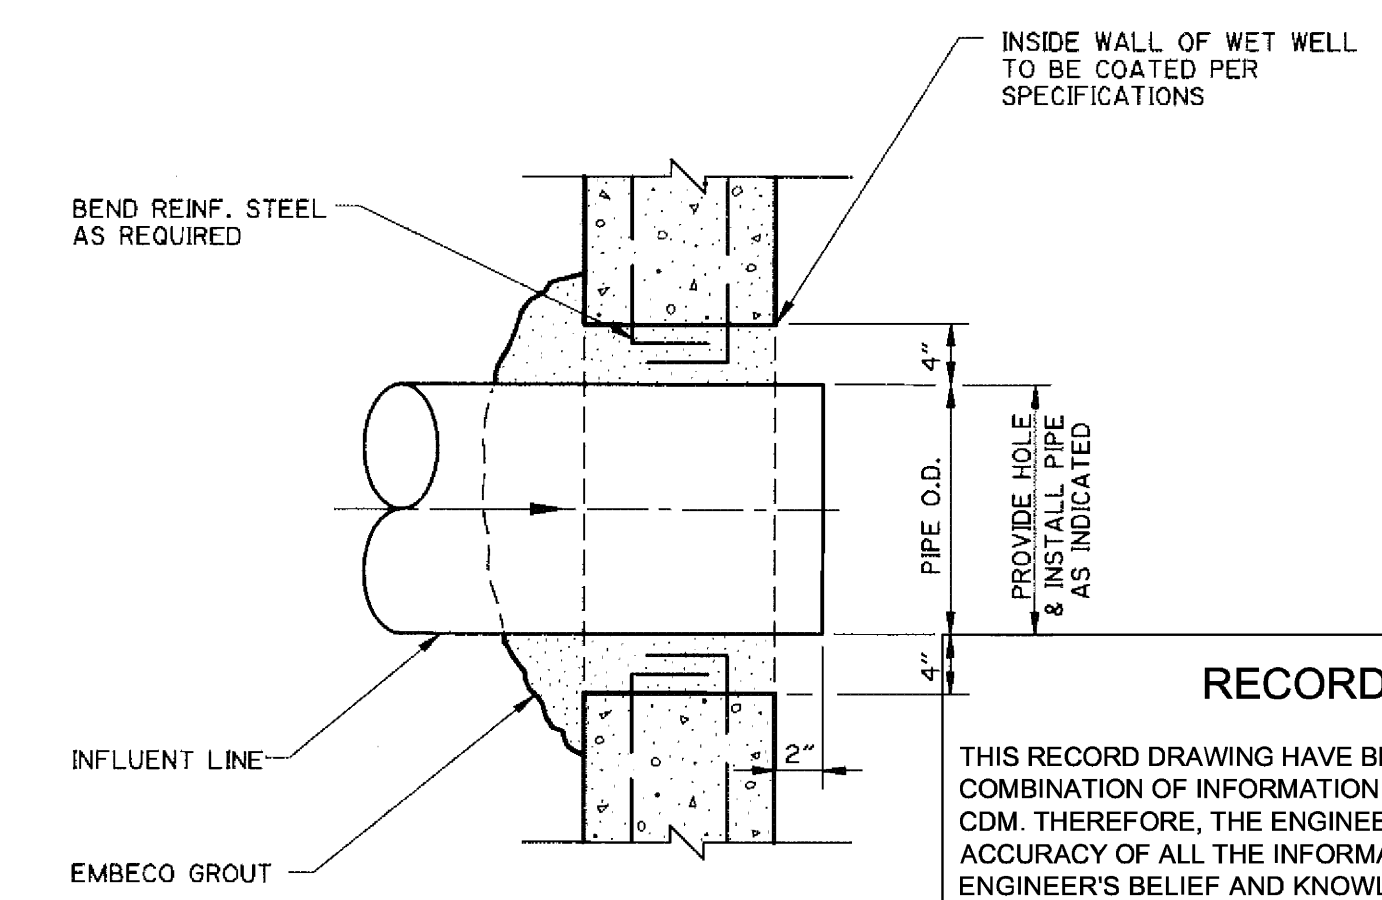

DETAIL B
NTS

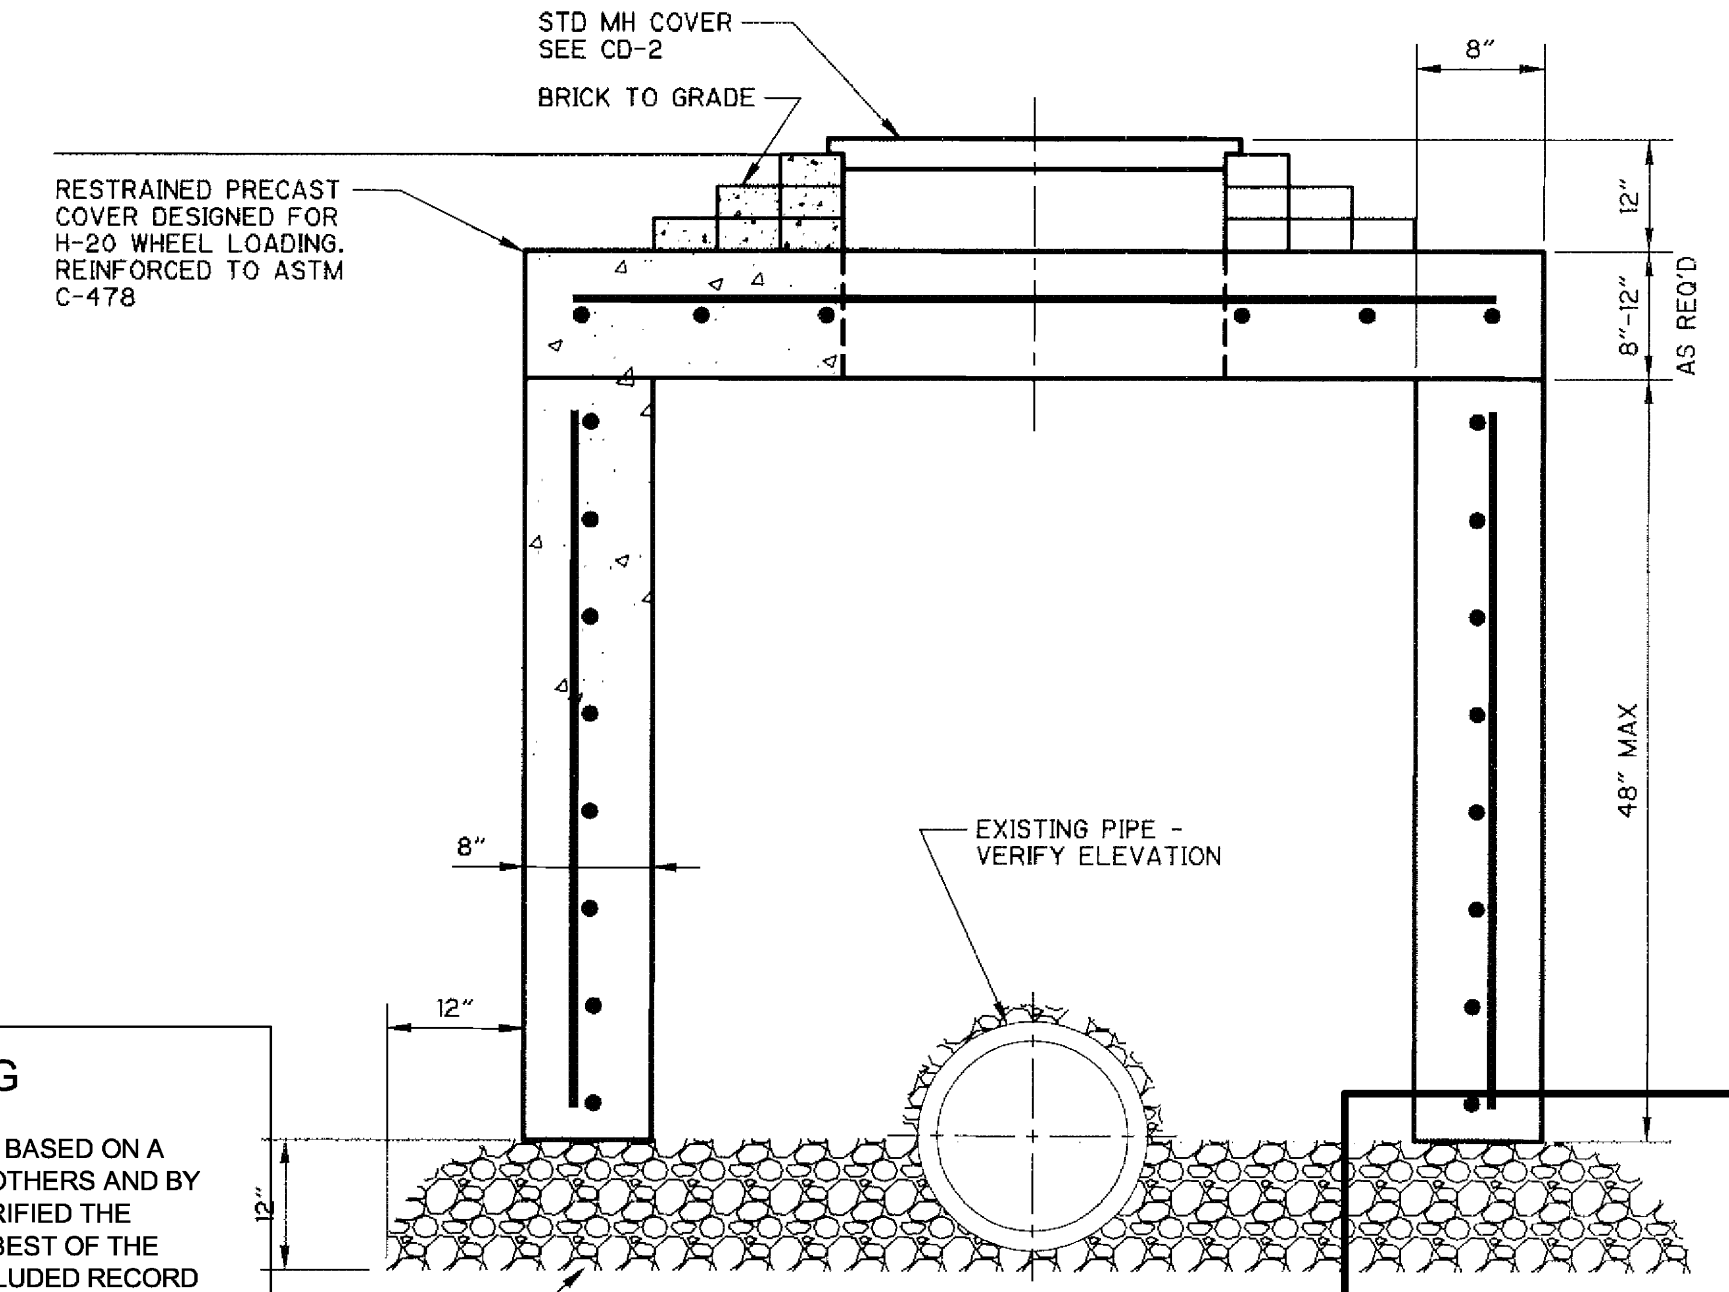

STANDARD SHALLOW MANHOLE
NTS

RECORD DRAWING

THIS RECORD DRAWING HAVE BEEN PREPARED BASED ON A COMBINATION OF INFORMATION PROVIDED BY OTHERS AND BY CDM. THEREFORE, THE ENGINEER HAS NOT VERIFIED THE ACCURACY OF ALL THE INFORMATION. TO THE BEST OF THE ENGINEER'S BELIEF AND KNOWLEDGE, THE INCLUDED RECORD INFORMATION IS REASONABLY ACCURATE.

By _____ Date December 2007

CDM

DWG: L:\9381-02R\9381-02R\CDM\DETAILS\CDM\CDM\RECORD_A1T_C
 USER: eadid
 DATE: Jun 05, 2008 10:03am
 XREFS: lbaak

REV. NO.	DATE	DRWN	CHKD	REMARKS
12/07	ALN	JEC		RECORD DRAWING
3/99	ALN	WMS		CONFORMED DRAWINGS

DESIGNED BY: W. SPRIGGS
 DRAWN BY: A. NUNES
 SHEET CHK'D BY: W. SPRIGGS
 CROSS CHK'D BY: E. STURTZ
 APPROVED BY: J. GOLDMAN
 DATE: DECEMBER, 1997

CAMP DRESSER & MCKEE INC.
 800 Brickwell Avenue, Suite 710
 Miami, Florida 33131
 Tel: 305-372-7171
 Cert. of Authorization No. 20

CDM
 environmental engineers, scientists,
 planners, & management consultants









CITY OF MIAMI BEACH,
 FLORIDA

WATER AND WASTEWATER SYSTEM IMPROVEMENTS

CIVIL DETAILS


PROJECT NO. 9381-02R
 SHEET NO. CD-1

JONATHAN Z. GOLDMAN
 P.E. NO. 48925

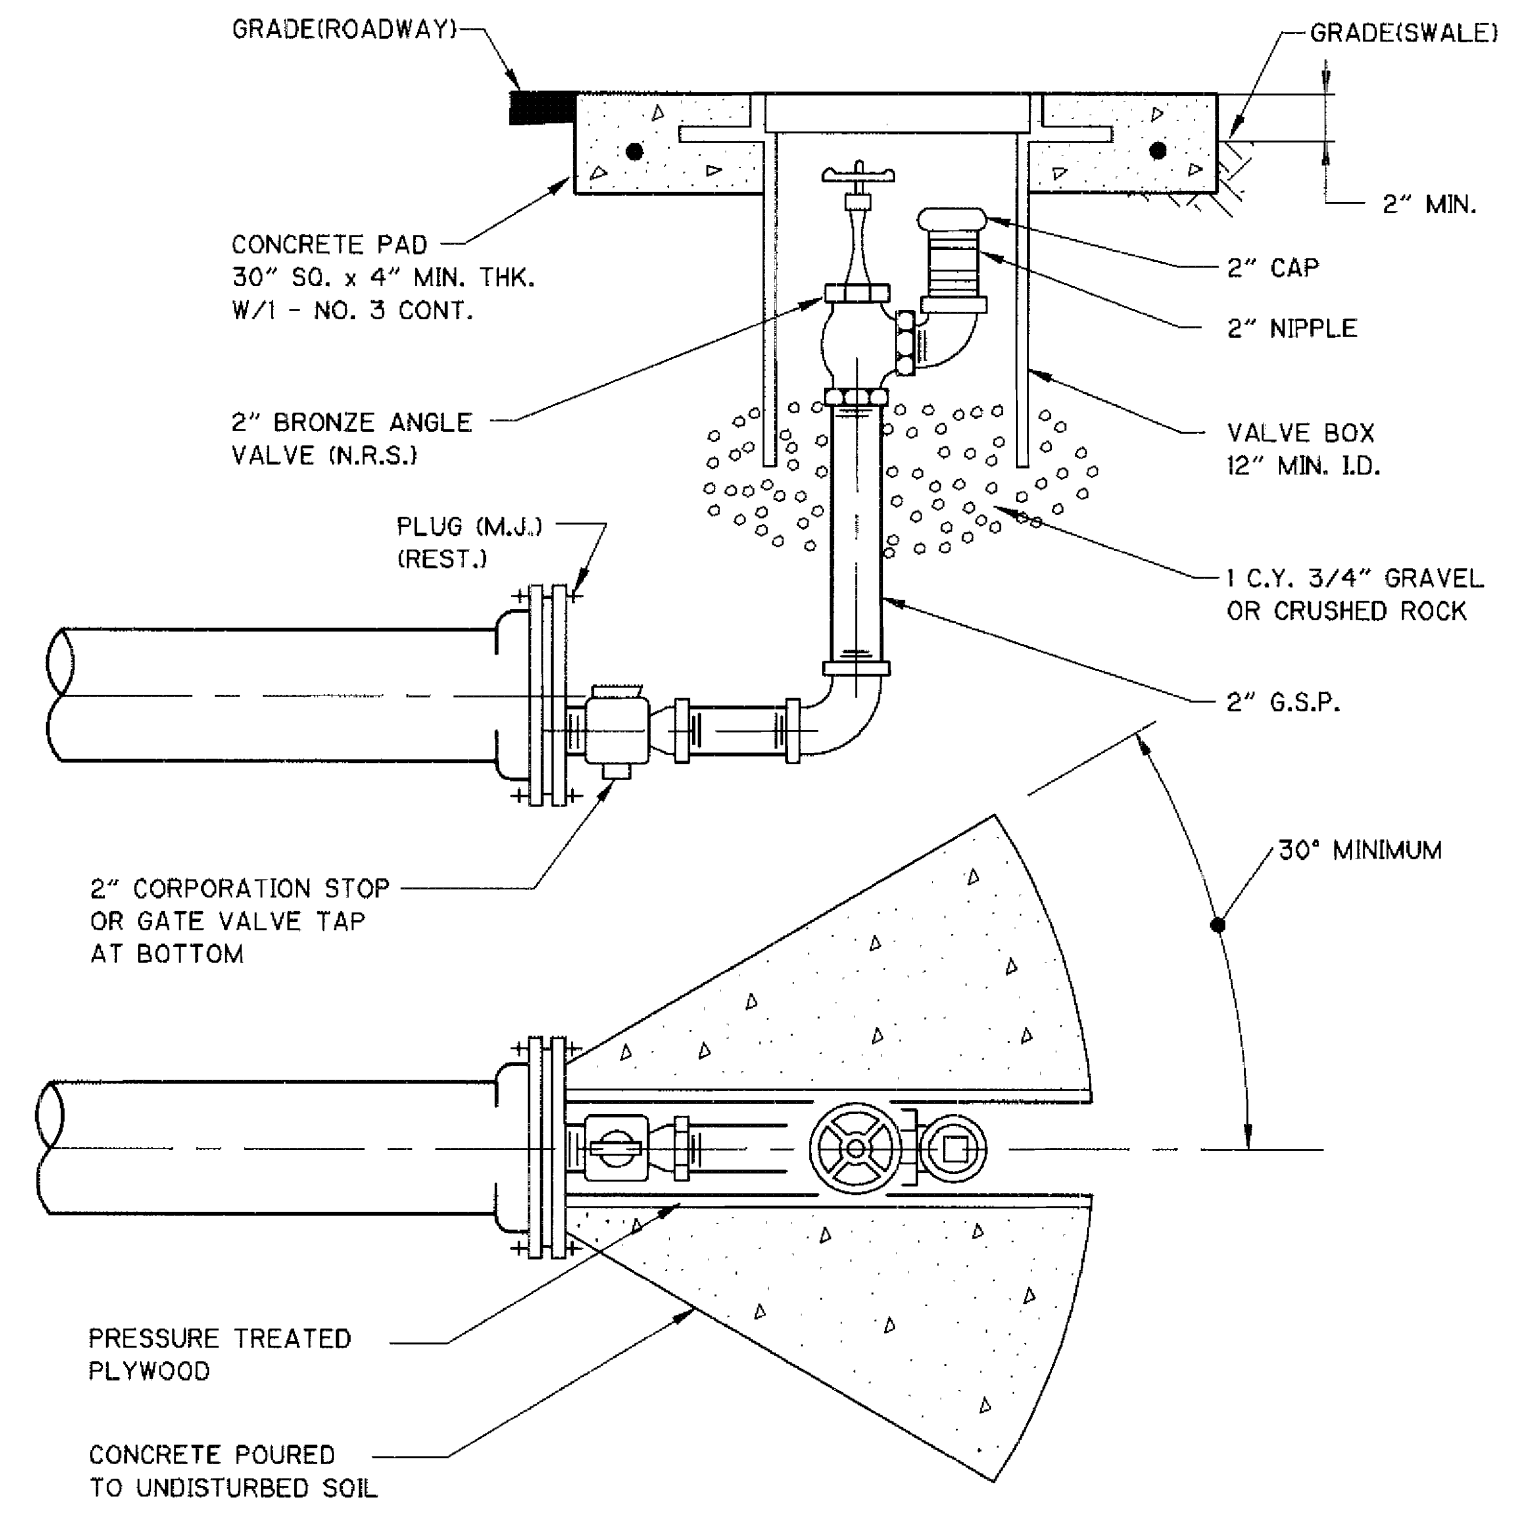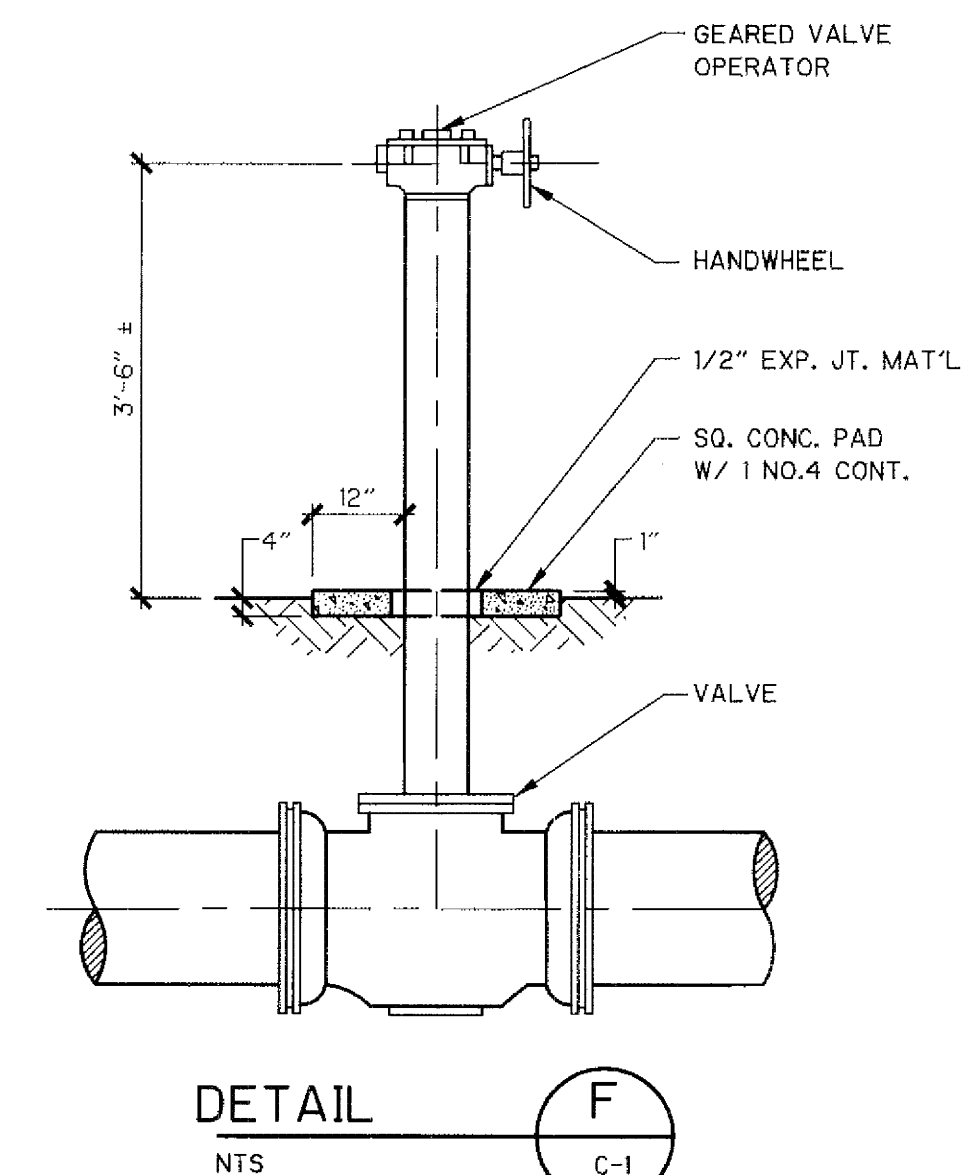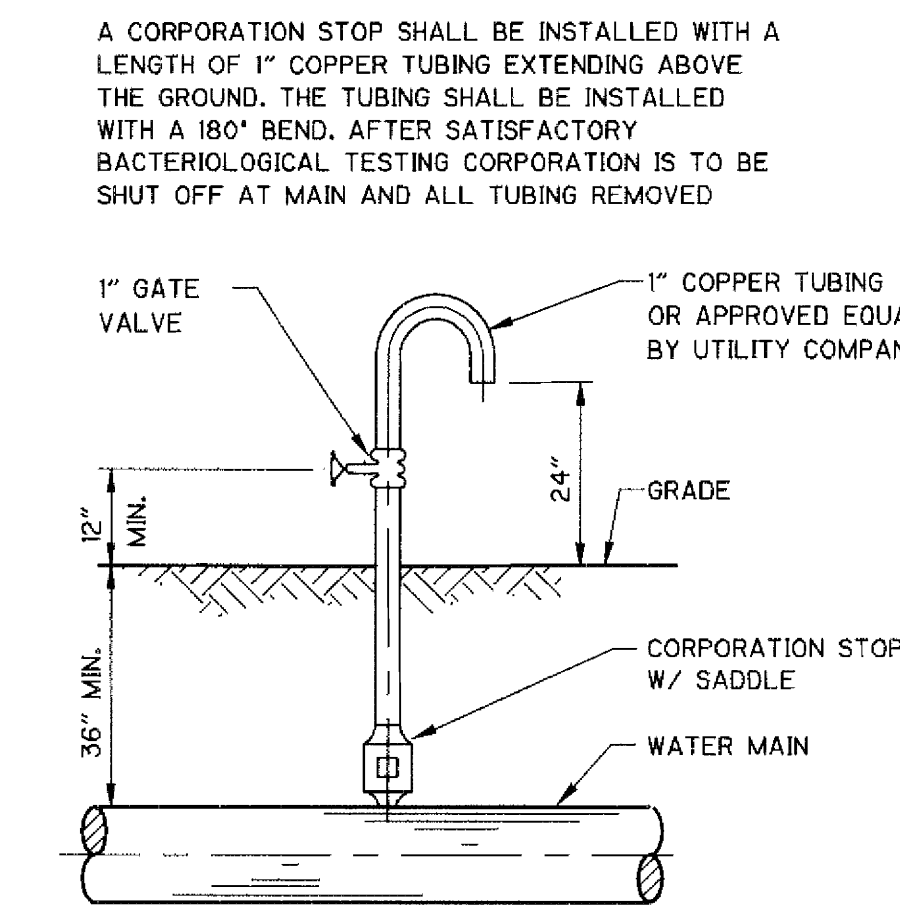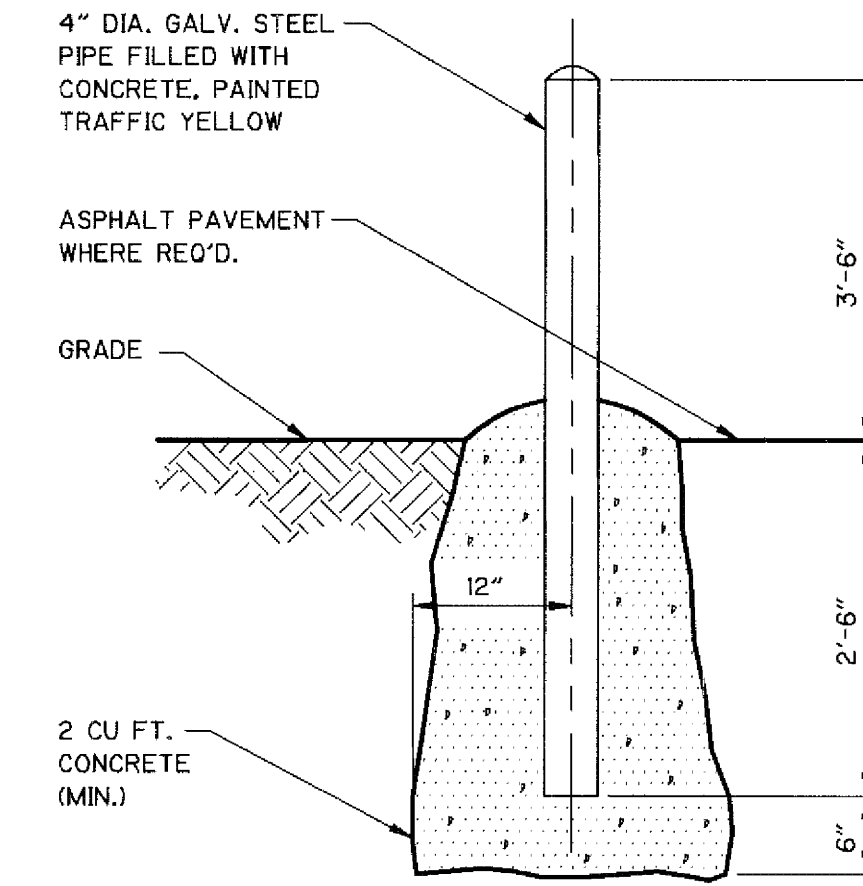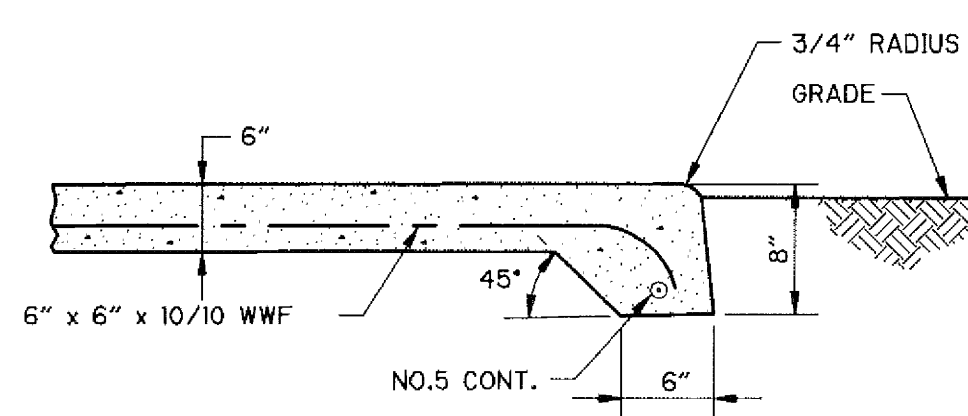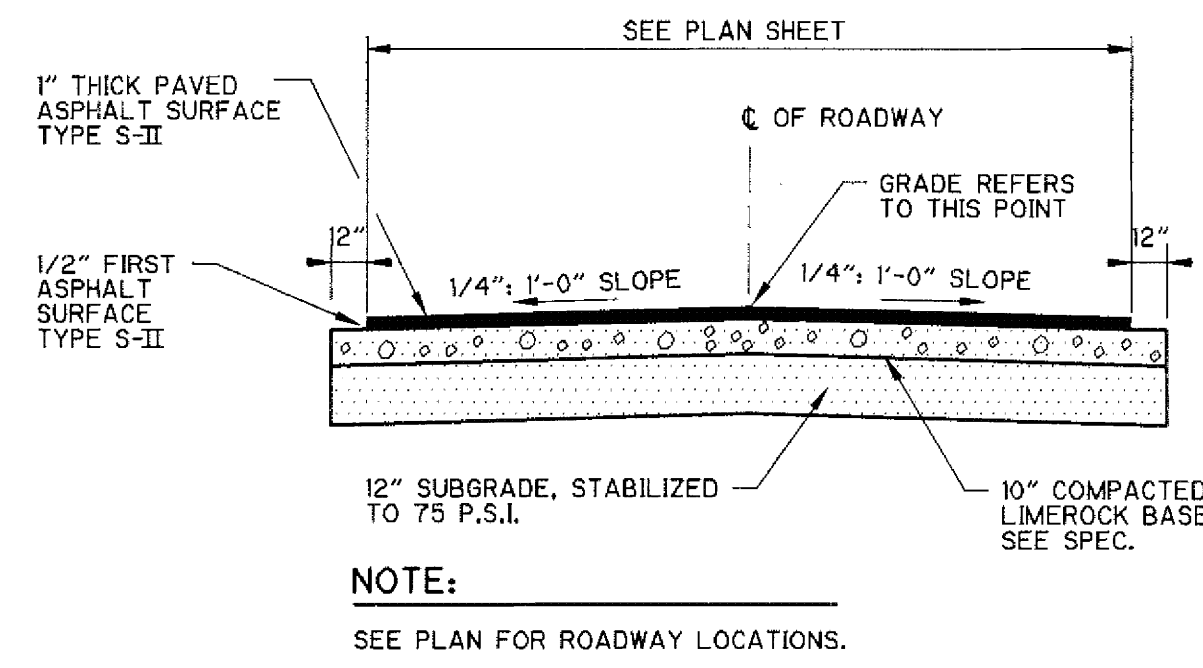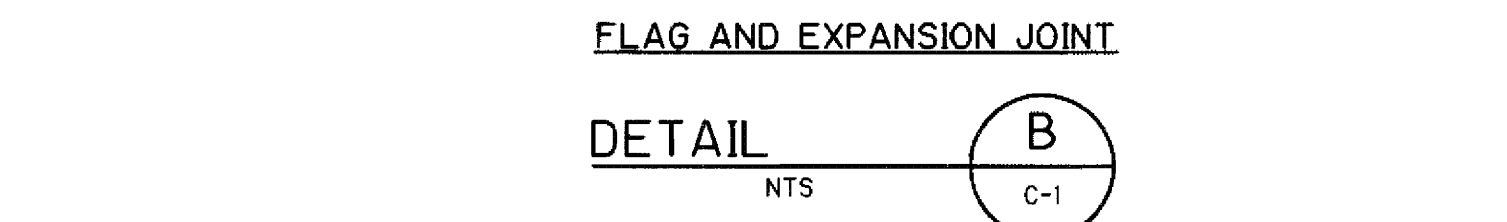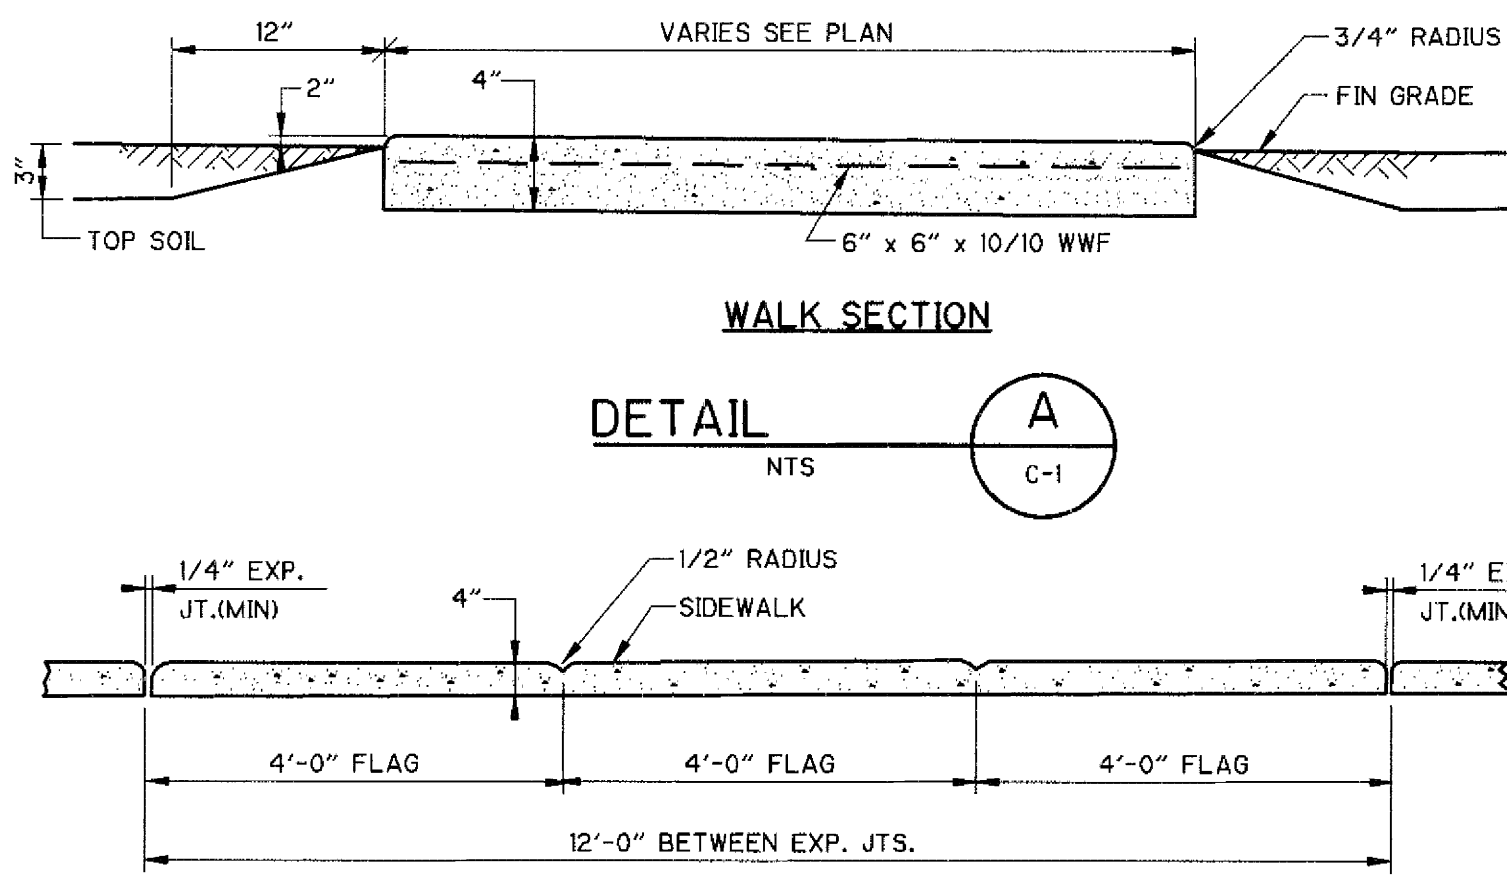


NOTE:
1. COAT ALL EXPOSED THREADS WITH COAL TAR ENAMEL BEFORE BACKFILL.
2. THRUST BLOCK HEIGHT EQUAL TO PIPE DIAMETER.


- NOTES:**
1. REMOVE TEMPORARY CONNECTION AT CORPORATION STOPS ON NEW MAIN AFTER FILLING AND FLUSHING HAS BEEN COMPLETED.
 2. DO NOT REMOVE TEMPORARY CONNECTION AT CORPORATION STOP ON NEW MAIN UNTIL ALL TESTING HAS BEEN COMPLETED.
 3. COMPLY WITH ALL DADE COUNTY HEALTH DEPT. AND DERM REGULATIONS.
 4. PROVIDE ALL NECESSARY THRUST BLOCKS OR OTHER RESTRAINTS.

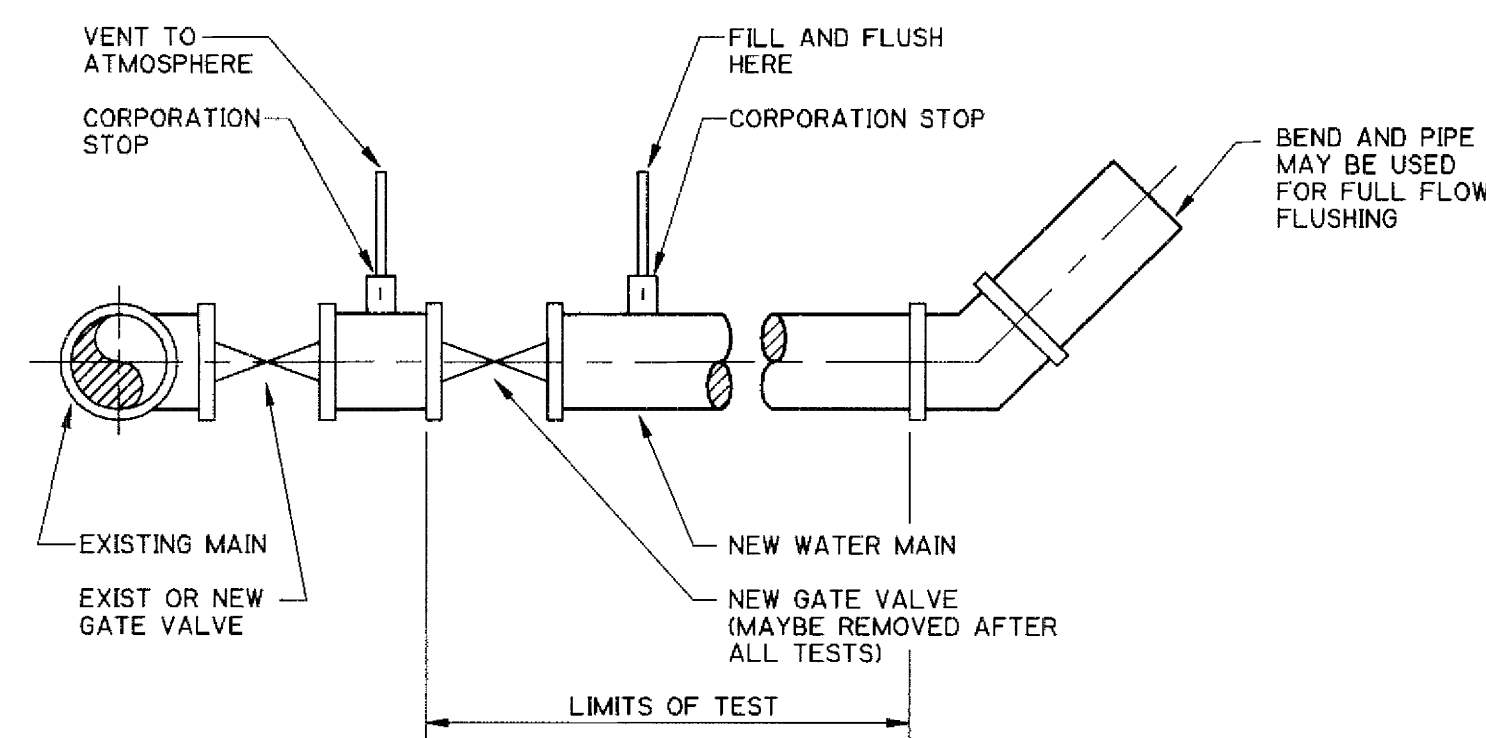


OTHER METHODS FOR FLUSHING MUST RECEIVE APPROVAL FROM THE UTILITY COMPANY.

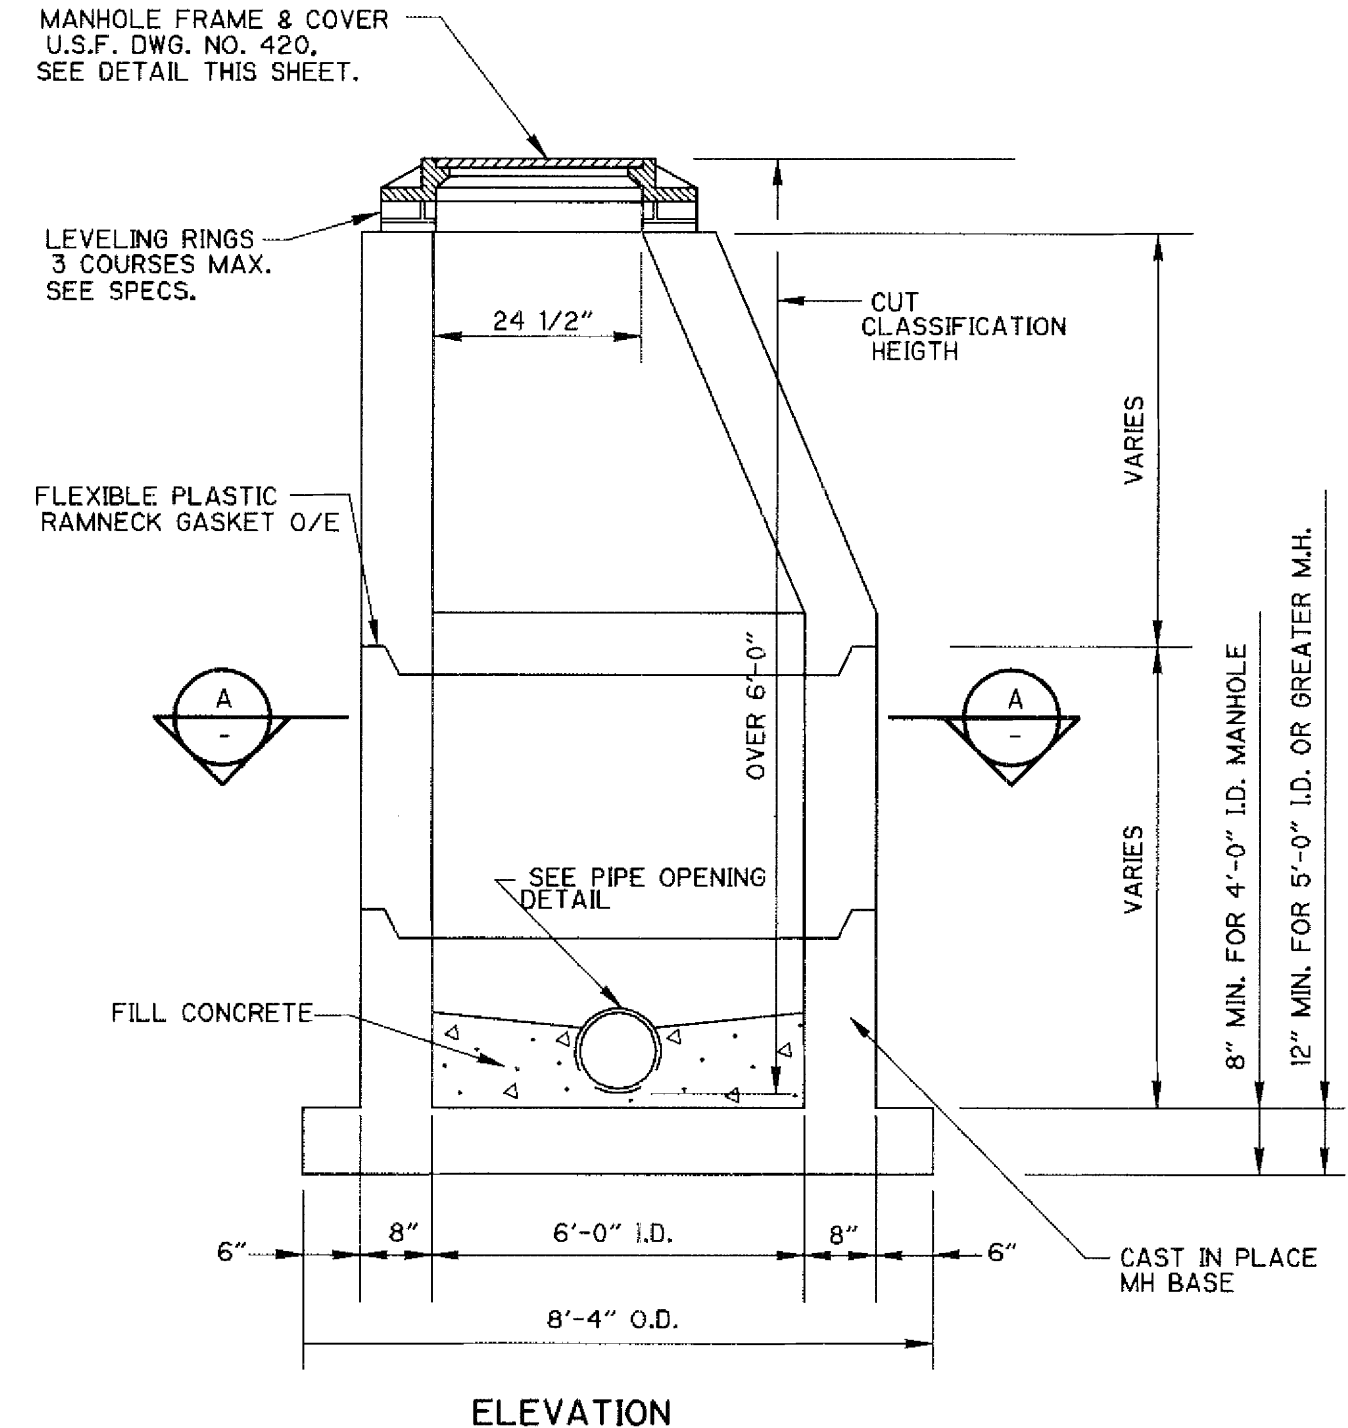


TO BE USED WHEN CUT CLASSIFICATION IS OVER 6'-0"
STANDARD DEEP TYPE MANHOLE
NTS

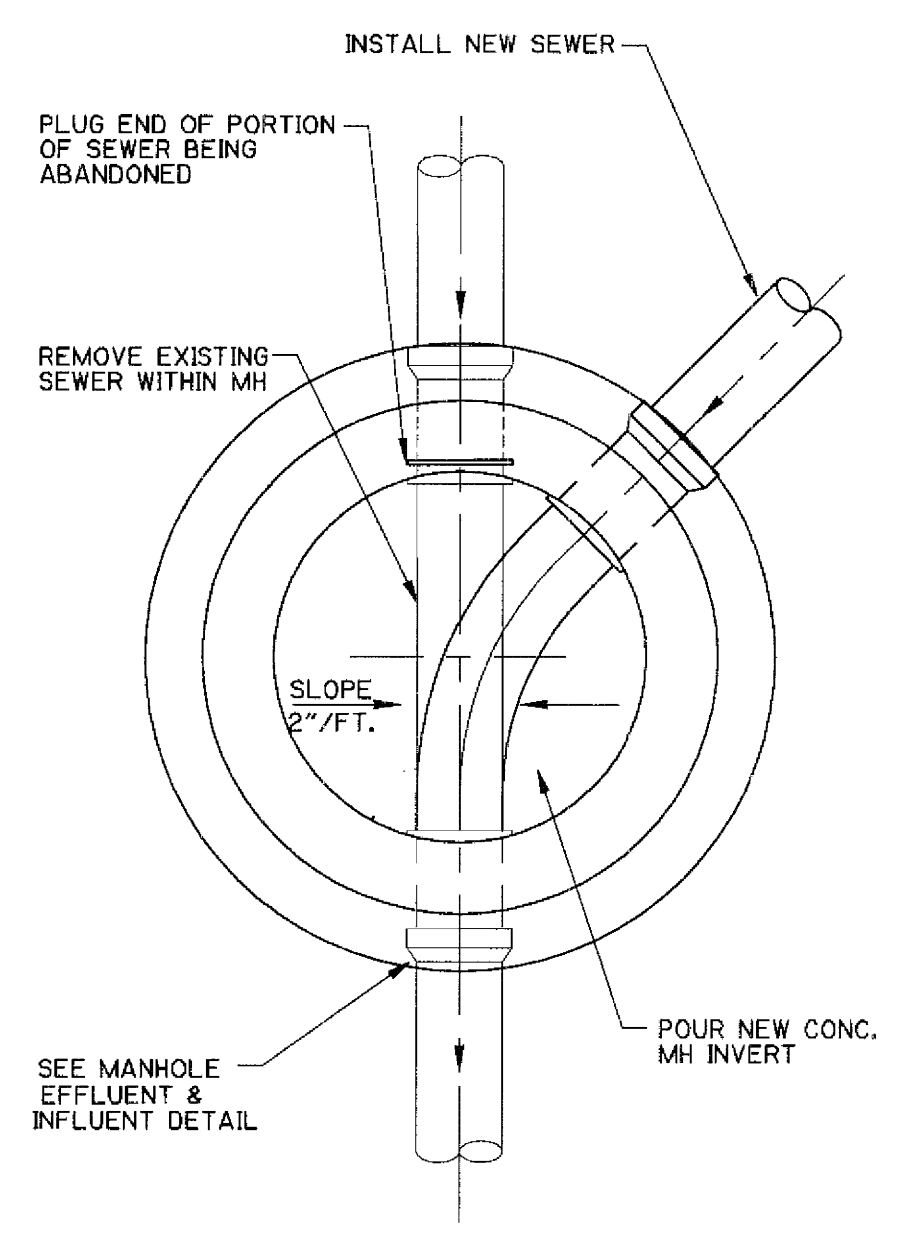

- STRUCTURAL NOTES:**
1. REINFORCING AREA OF 0.20 SQ. IN./FT. FOR WALL SECTION, MIN. TO MEET OR EXCEED ASTM A 185.
 2. ALL CEMENT TO BE TYPE II/ACID RESISTANT.
 3. ALL CONCRETE FOR PRECAST MANHOLES TO BE 4,000 P.S.I. TO MEET OR EXCEED ASTM C 478.
 4. BOTTOMS & CHANNELS OF ALL MANHOLES TO BE OF 2,500 P.S.I. FILL CONCRETE FINISHED SMOOTH WITH STEEL TROWEL.
 5. CONCRETE MANHOLES TO HAVE A MIN. WALL THICKNESS OF 8".
 6. INSIDE OF MANHOLE SHALL BE COATED WITH TWO COATS OF COAL TAR EPOXY AND ONE COAT OUTSIDE.
 7. CHANNELS TO BE FORMED IN ALL MANHOLES TO ACCEPT T.V. CAMERA.
 8. WHEN DIRECTIONAL CHANGES EXCEEDING 45° OCCUR, AN EXTRA FLOW LINE ELEVATION DROP OF (.05 FEET) ACROSS MANHOLE WILL BE PROVIDED.
 9. ORIENT ECCENTRIC CONE AS REQUIRED BY ENGINEER IN FIELD.
 10. BOTTOM SECTION TO BE MONOLITHIC POUR EXCEPT WHERE DROP CONNECTION IS REQUIRED.

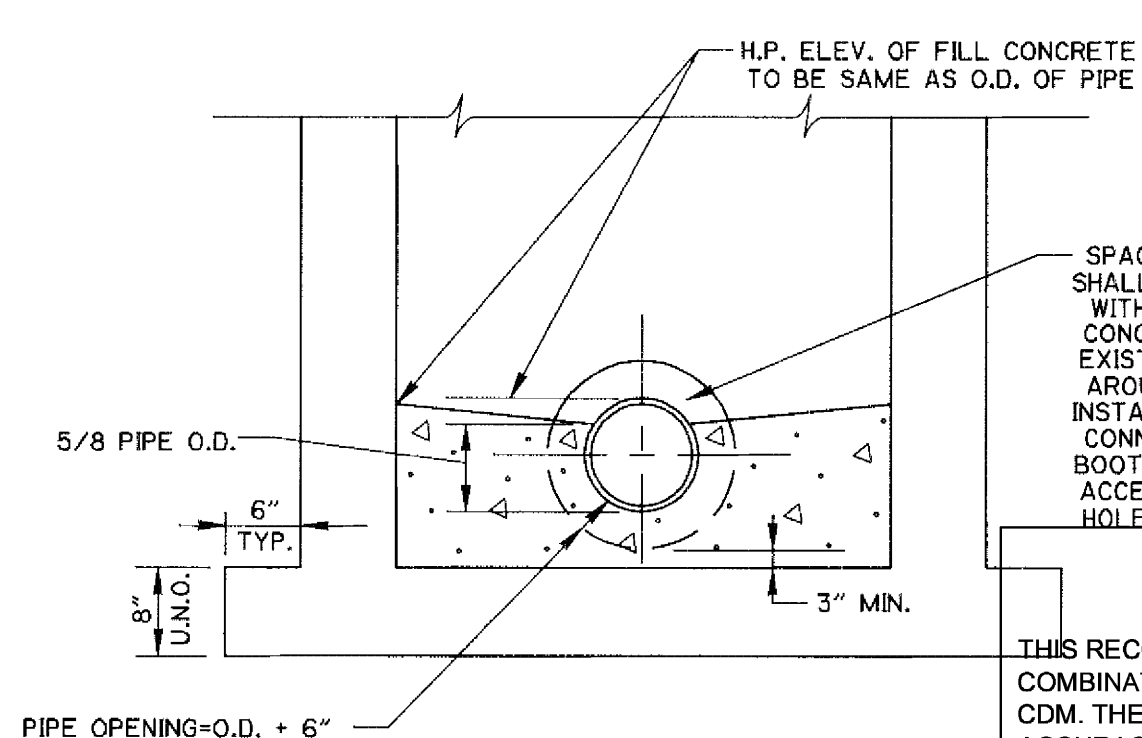

RECORD DRAWING
THIS RECORD DRAWING HAVE BEEN PREPARED BASED ON A COMBINATION OF INFORMATION PROVIDED BY OTHERS AND BY CDM. THEREFORE, THE ENGINEER HAS NOT VERIFIED THE ACCURACY OF ALL THE INFORMATION. TO THE BEST OF THE ENGINEER'S BELIEF AND KNOWLEDGE, THE INCLUDED RECORD INFORMATION IS REASONABLY ACCURATE.
By _____ Date December 2007

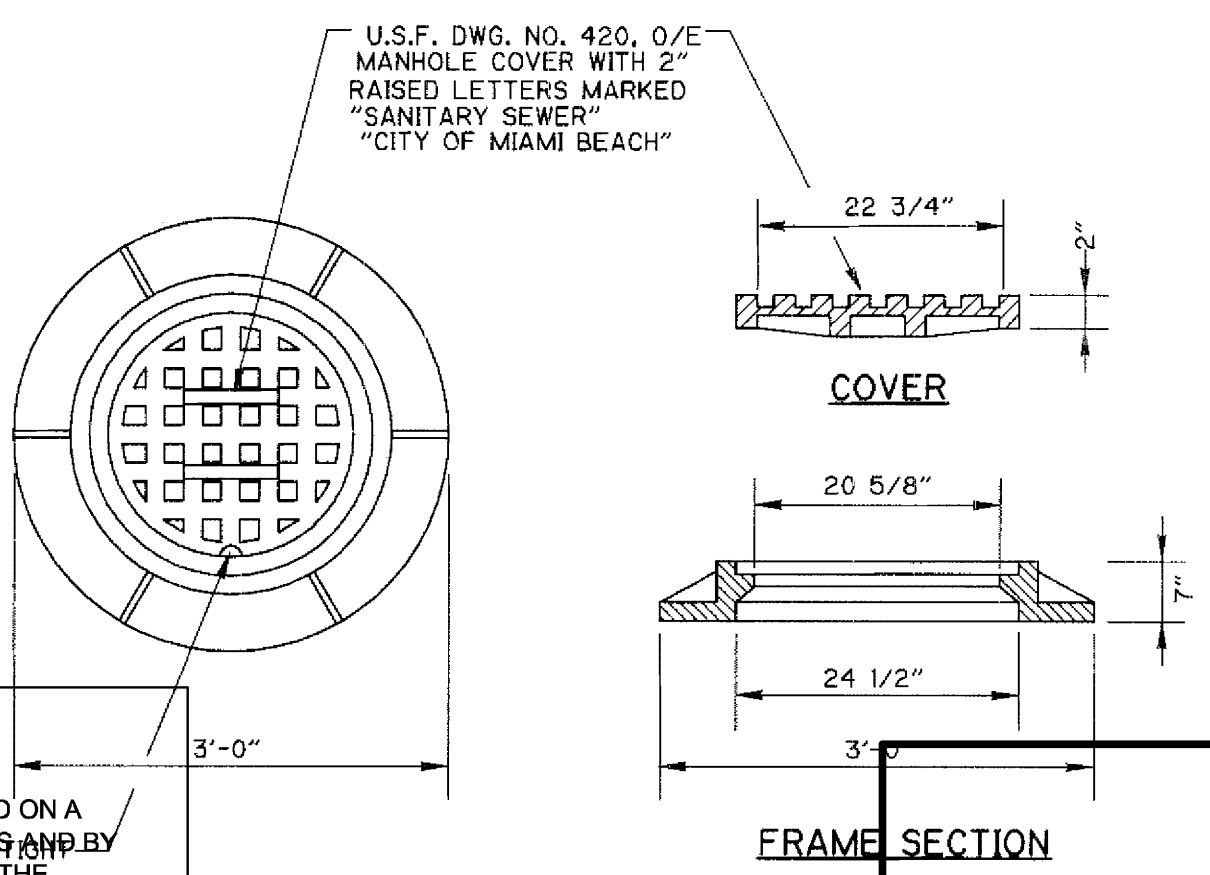

L:\3181 - CD-1\1000\CD-1\DETAILS\CONCRETE\DWG RECORD_CD-1.dwg
 USER: jgoldm
 DATE: Jun 05, 2008 10:24am
 PLOT: 10/24/08
 IMAGES: CD-1.dwg

REV. NO.	DATE	DRWN	CHKD	REMARKS
12/07	ALN	JEC		RECORD DRAWING
3/99	ALN	WMS		CONFORMED DRAWINGS




DESIGNED BY: W. SPRIGGS
 DRAWN BY: J. WALLER
 SHEET CHK'D BY: W. SPRIGGS
 CROSS CHK'D BY: E. STURTZ
 APPROVED BY: J. GOLDMAN
 DATE: DECEMBER, 1997

CAMP DRESSER & MCKEE INC.
 800 Brickwell Avenue, Suite 710
 Miami, Florida 33131
 Tel: 305-372-7171
 Cert. of Authorization No. 20
CDM
 environmental engineers, scientists,
 planners, & management consultants

CITY OF MIAMI BEACH,
 FLORIDA
WATER AND WASTEWATER SYSTEM IMPROVEMENTS

CIVIL DETAILS
 PROJECT NO. 9381-02R
 SHEET NO. CD-2


JONATHAN Z. GOLDMAN
 P.E. NO. 48925

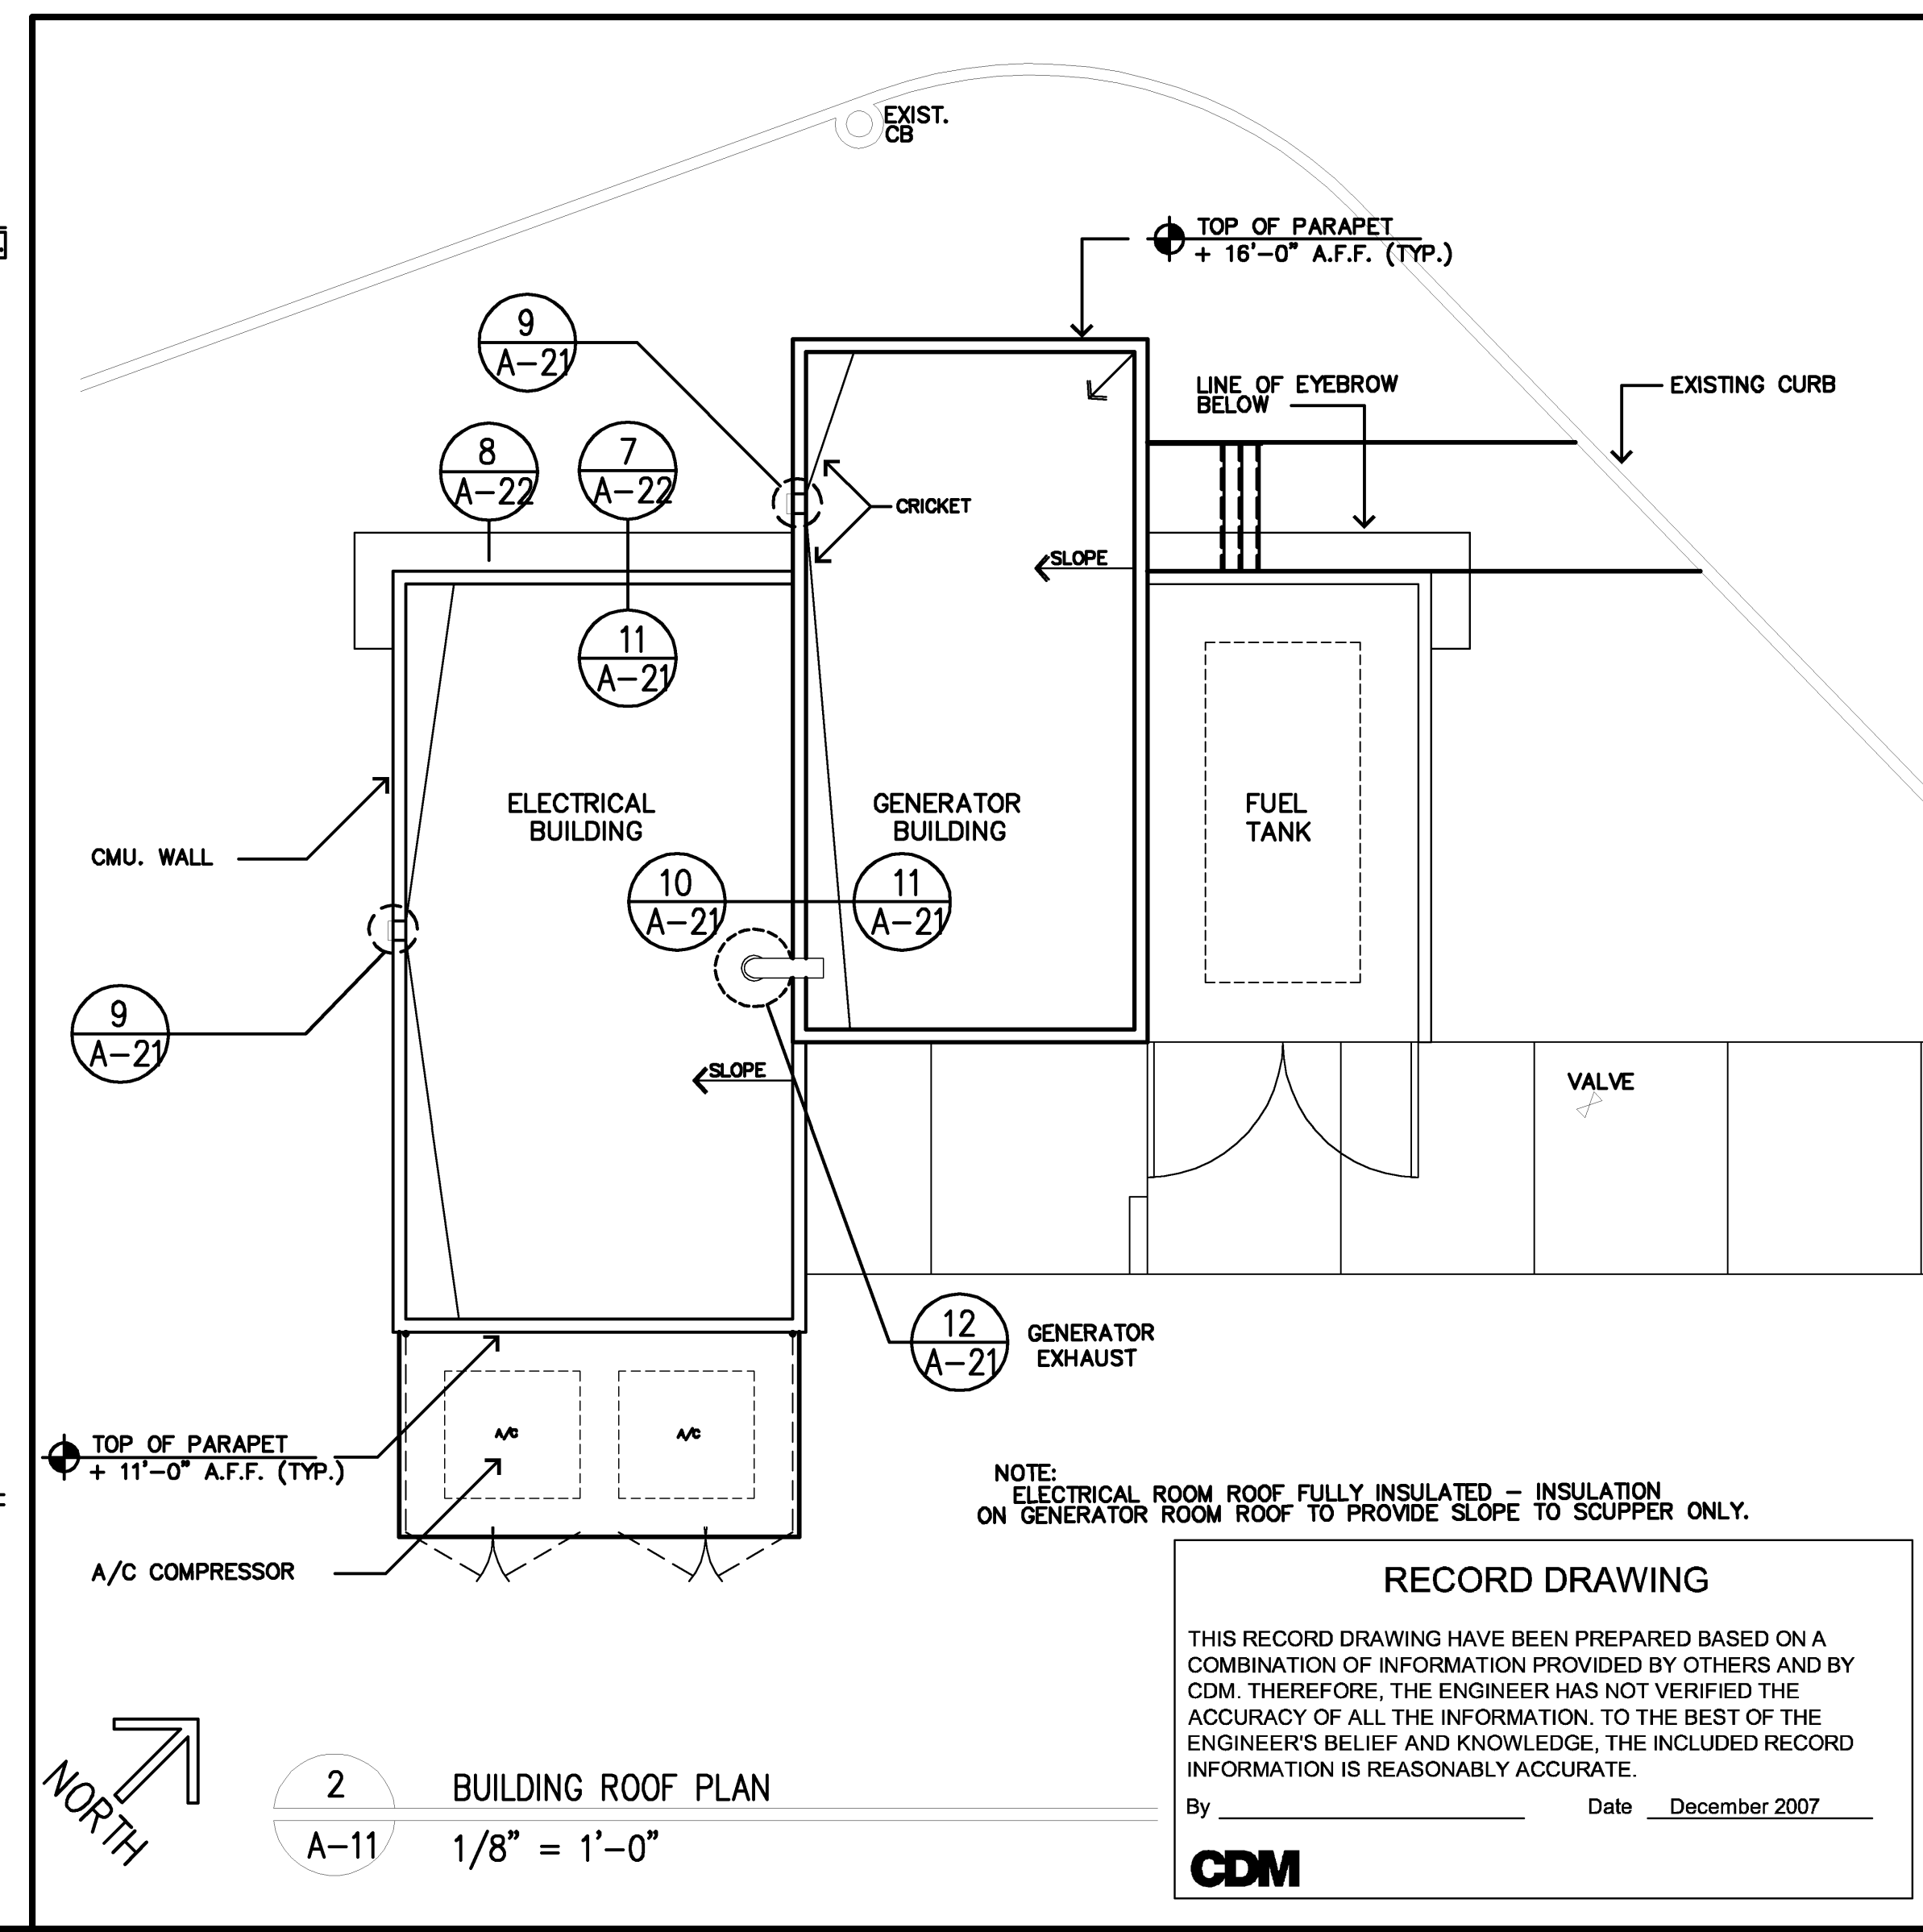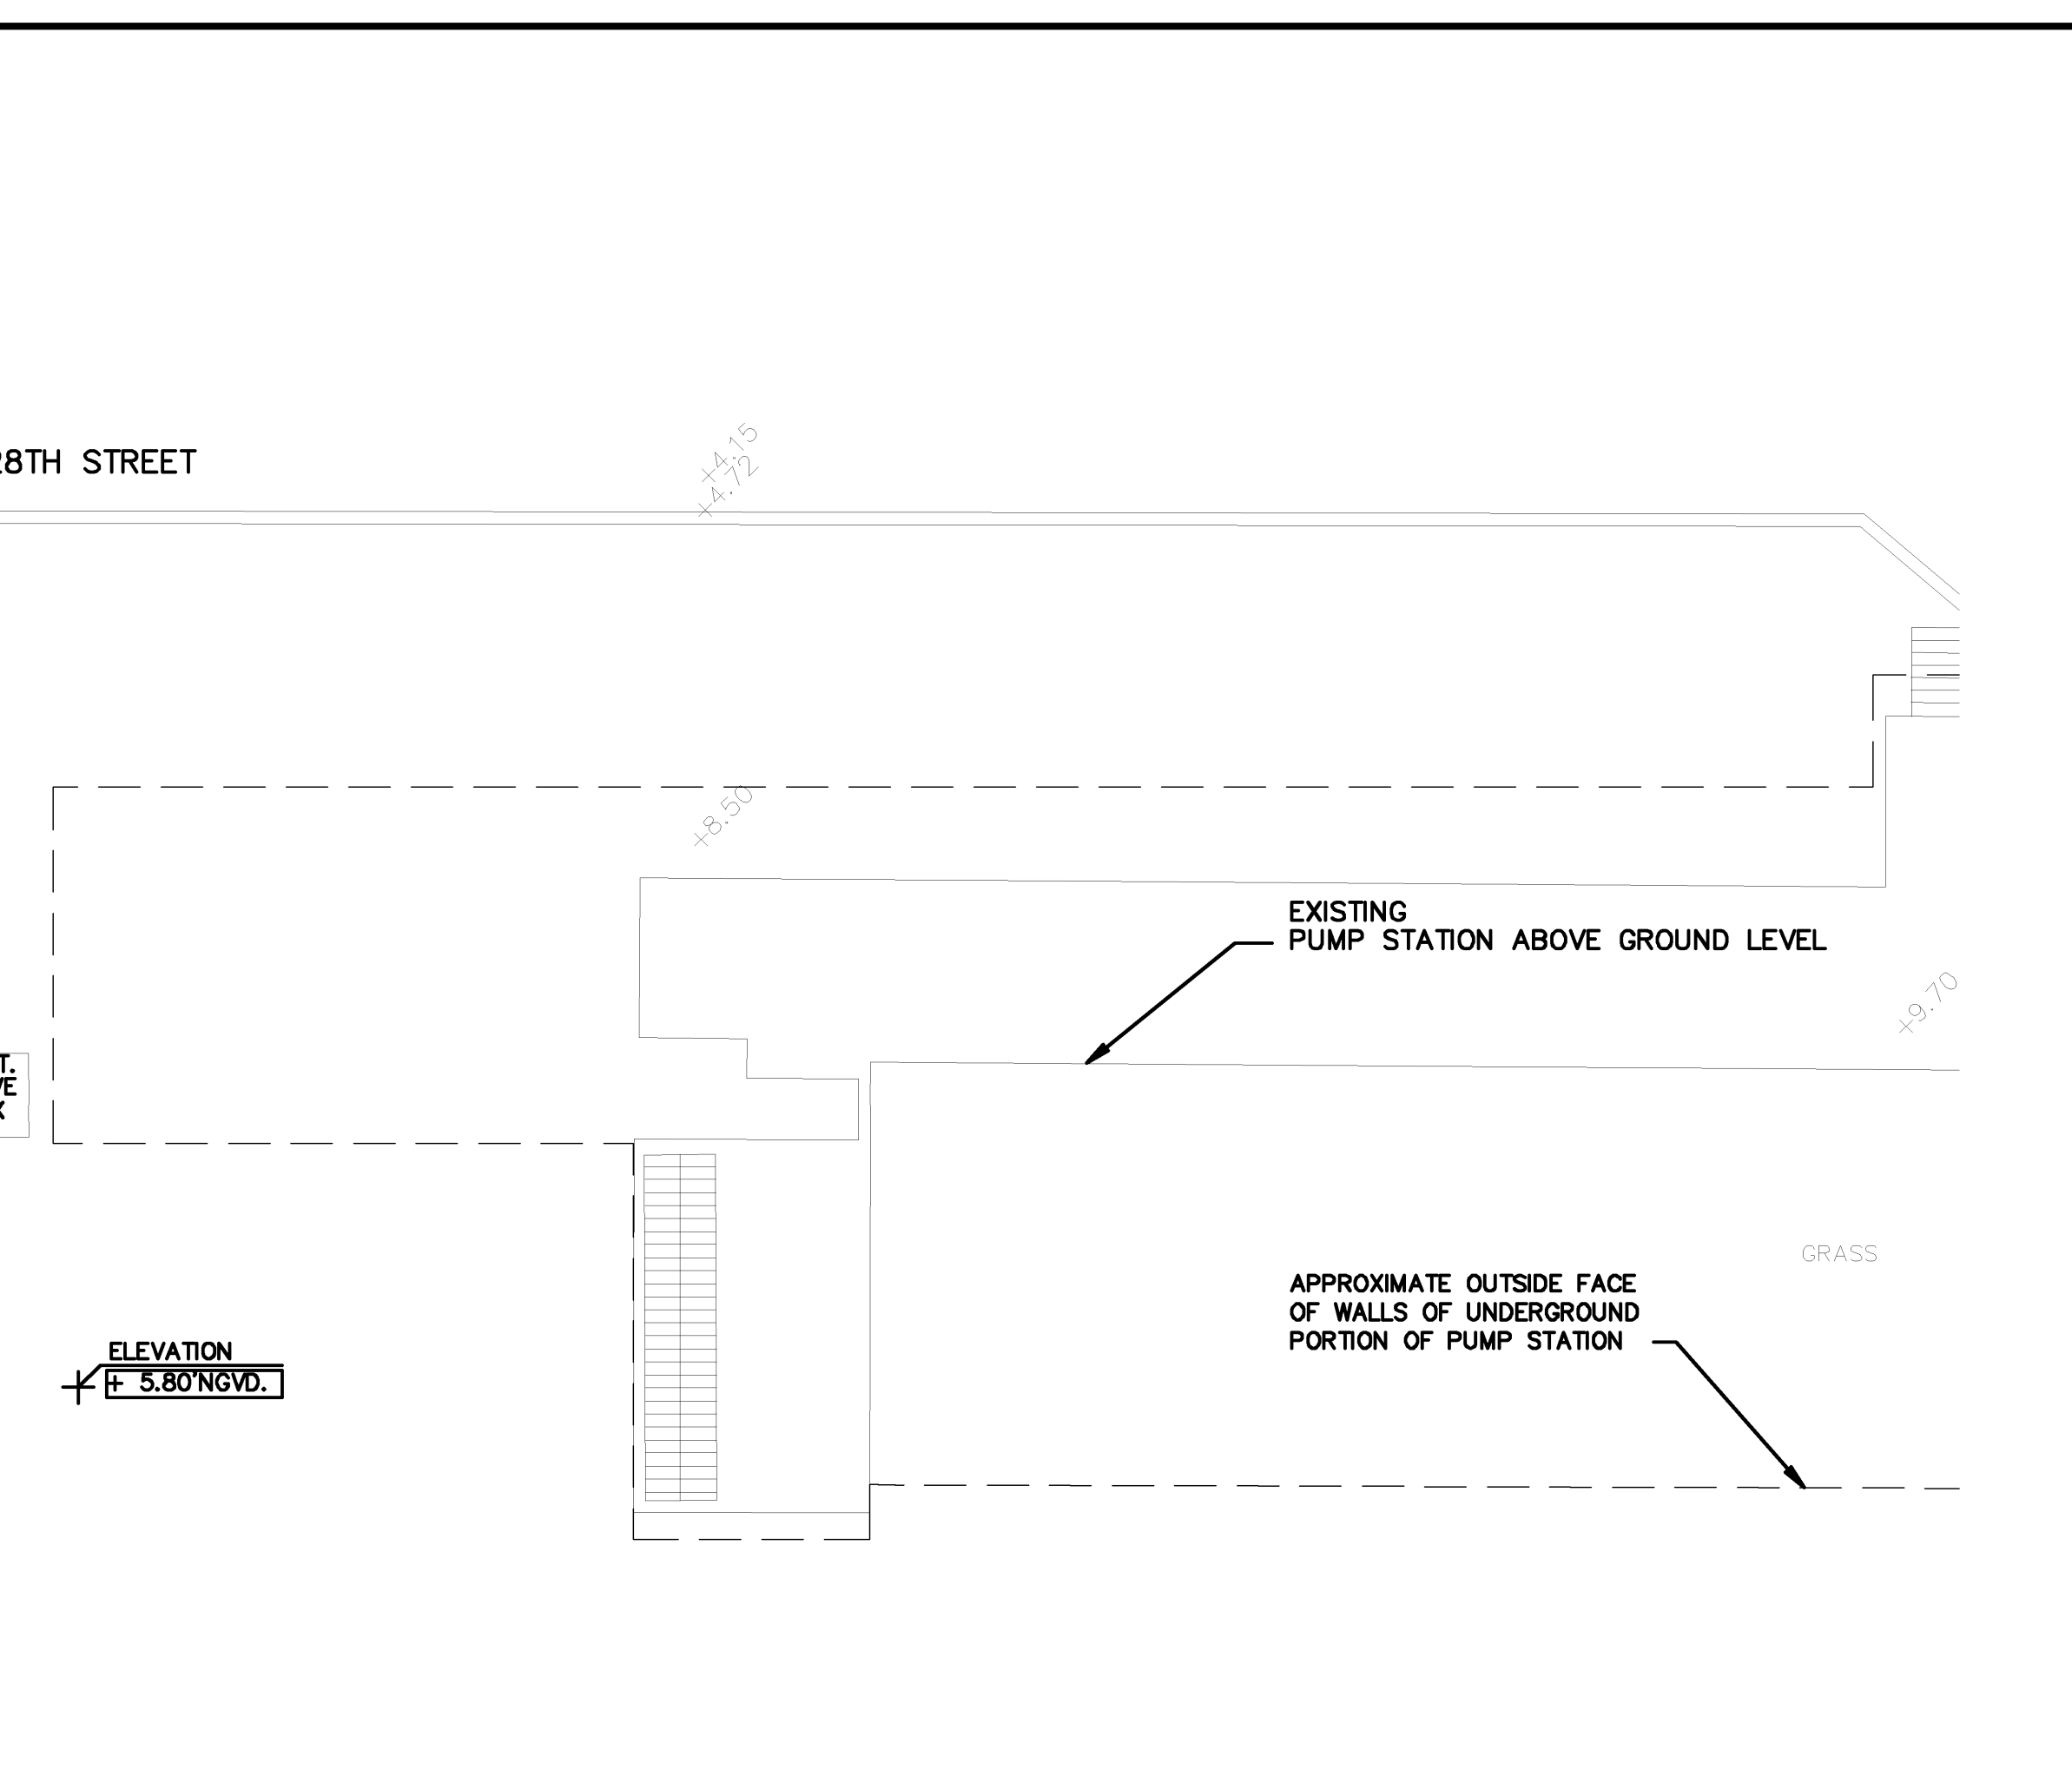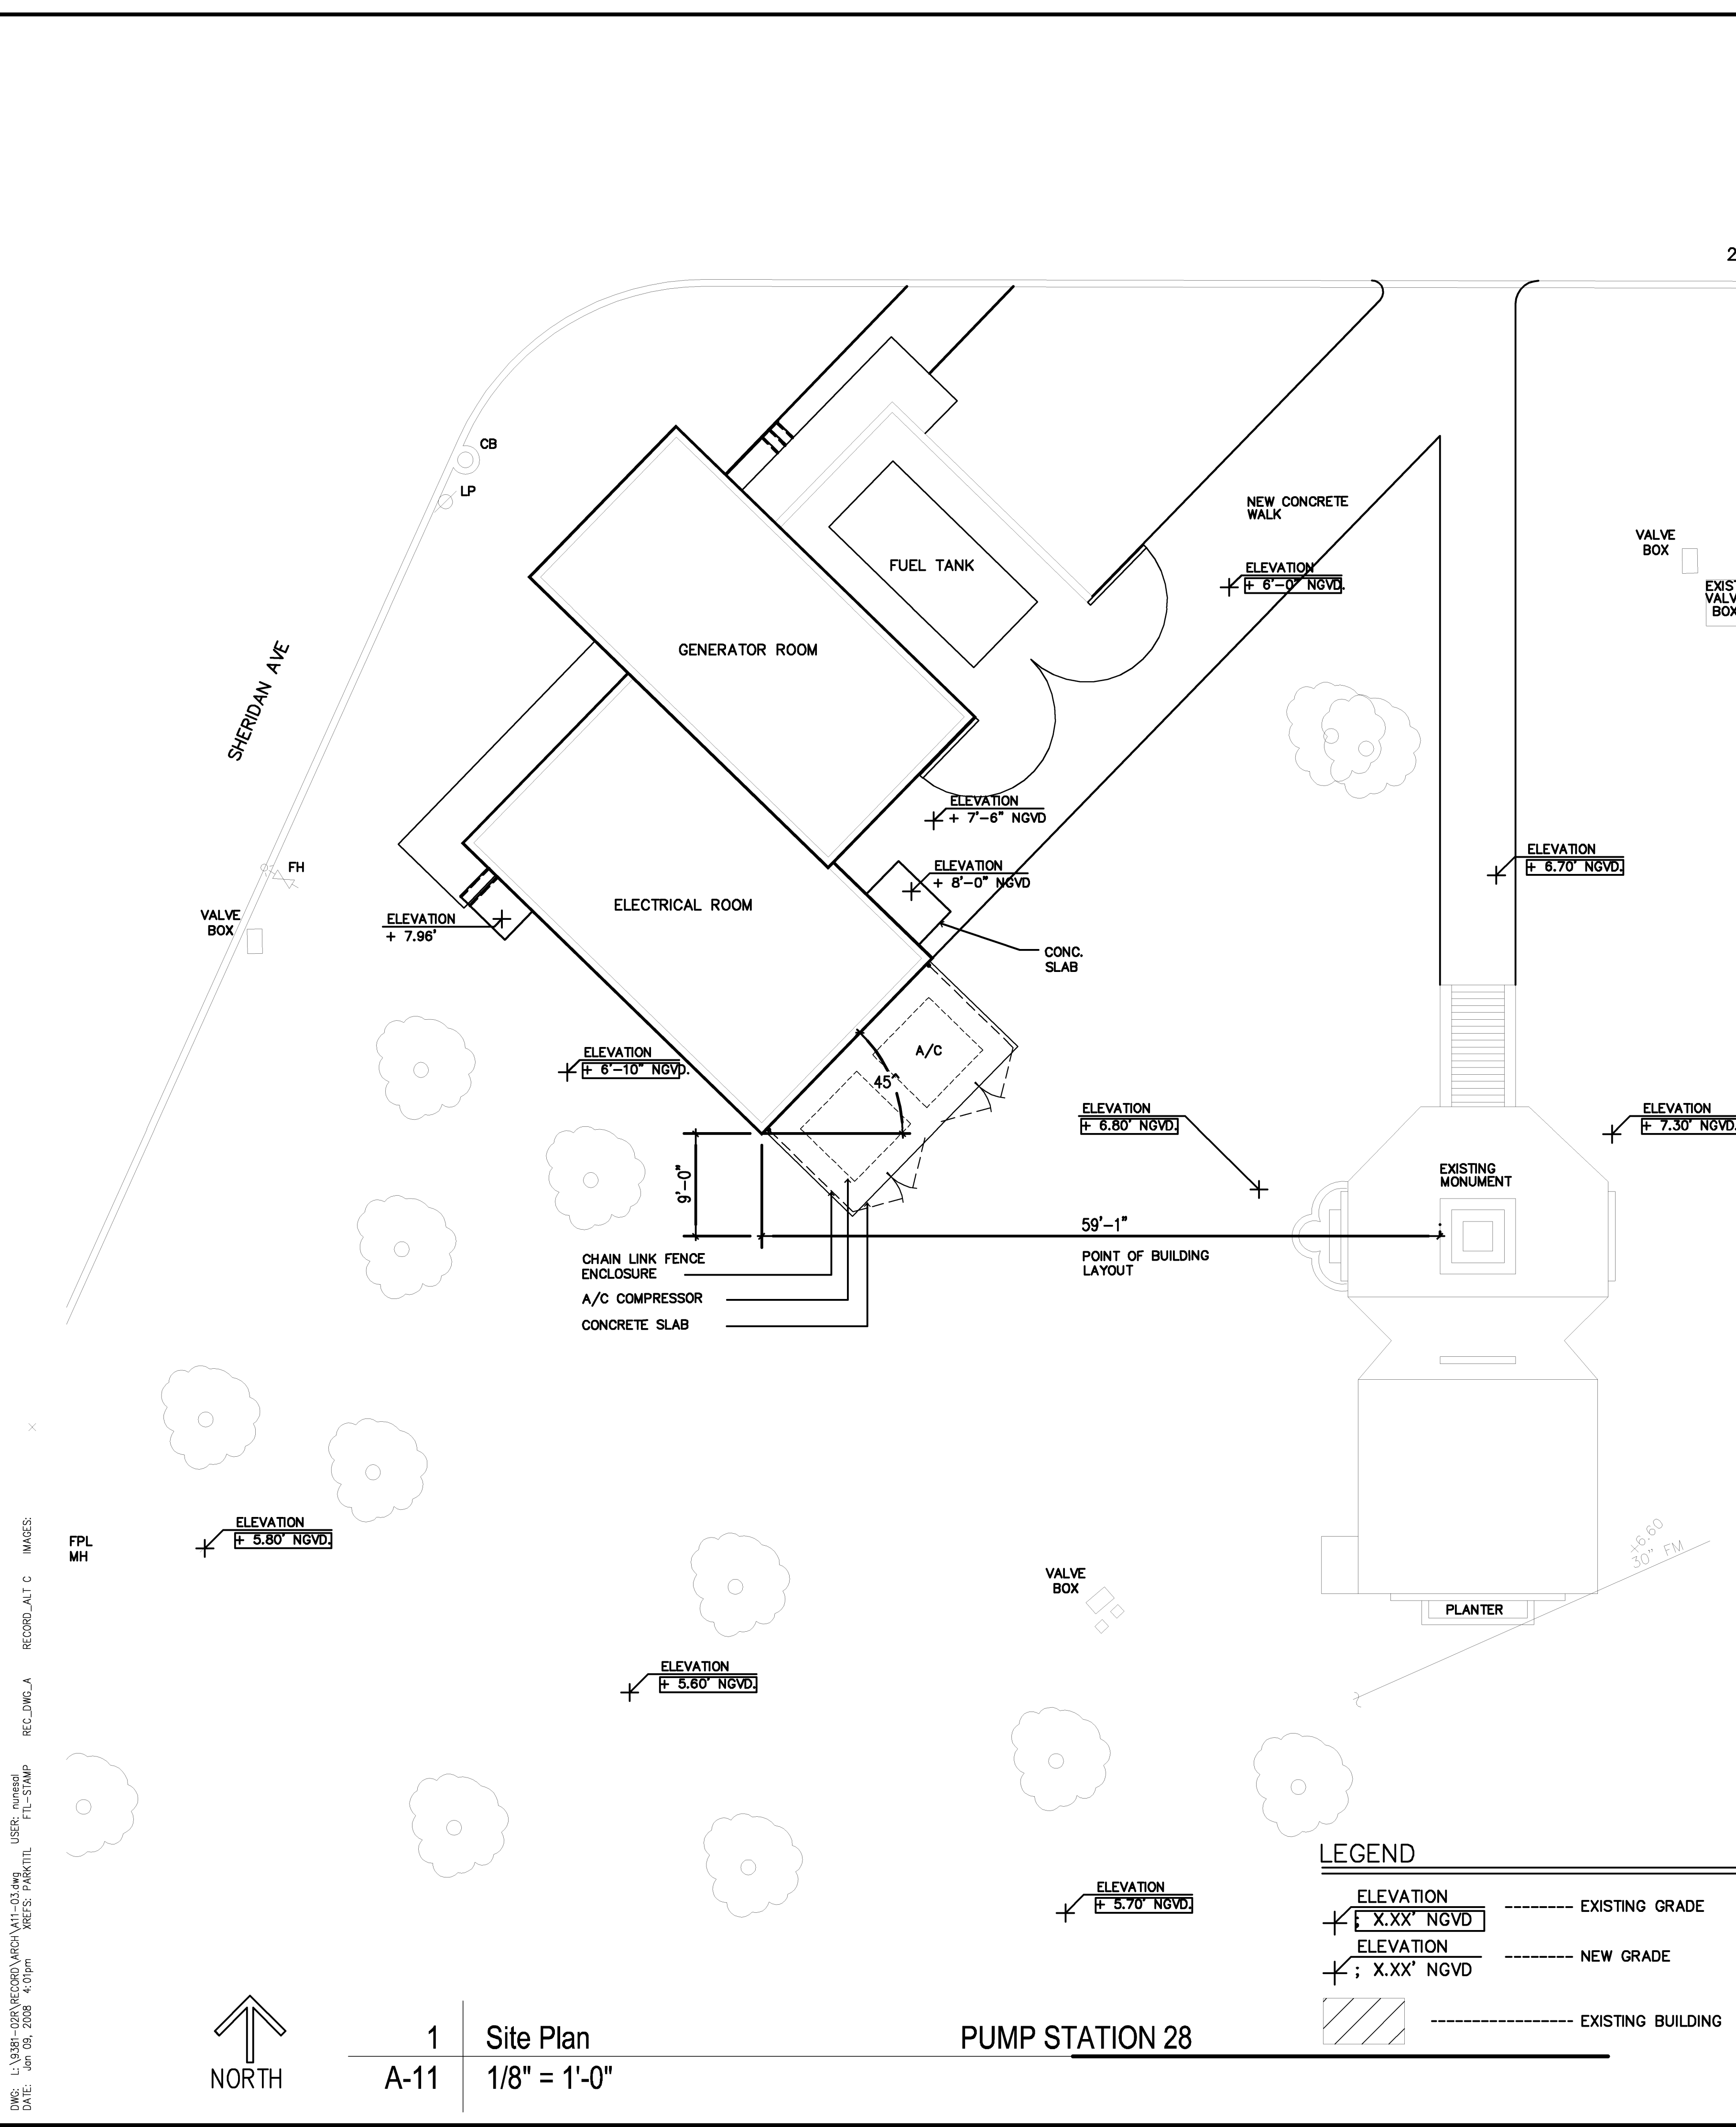

LEGEND

ELEVATION	-----	EXISTING GRADE
+ X.XX' NGVD		
ELEVATION	-----	NEW GRADE
+ X.XX' NGVD		
[Hatched Box]	-----	EXISTING BUILDING

DWS: L:\9881-02R\RECORD\ARCH\A11-03.dwg USER: nuread DATE: Jan 09, 2008 4:07pm PLOT: P:\PARKITL REC_DWG-A RECORD_A11-C IMAGES: FPL MH

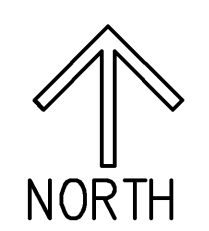

1 Site Plan
A-11 1/8" = 1'-0"

PUMP STATION 28

2 BUILDING ROOF PLAN
A-11 1/8" = 1'-0"

RECORD DRAWING

THIS RECORD DRAWING HAVE BEEN PREPARED BASED ON A COMBINATION OF INFORMATION PROVIDED BY OTHERS AND BY CDM. THEREFORE, THE ENGINEER HAS NOT VERIFIED THE ACCURACY OF ALL THE INFORMATION. TO THE BEST OF THE ENGINEER'S BELIEF AND KNOWLEDGE, THE INCLUDED RECORD INFORMATION IS REASONABLY ACCURATE.

By _____ Date December 2007

CDM

DONNELL, DUQUESNE & ALBAISA, P.A.
CONSULTING ENGINEERS
RAMON R. DONNELL P.E. 0011860
PEDRO J. DUQUESNE P.E. 0022764
AIDA M. ALBAISA P.E. 0045150
4025 S.W. 74th CT. MIAMI, FLORIDA 33155
(305) 666-0711

CDM
CAMP DRESSER & MCKEE INC.
800 Brickell Avenue, Suite 710
Miami, Florida 33131
305 372-7171, Fax: 305 372-9167

City of Miami Beach
zyscovich
100 N BISCAYNE BLVD. SUITE 1400 MIAMI FL 33132
T 305 372-5222 F 305 577-4521
CS 1327, 2250

ELECTRIC GENERATOR
28th Street and Sheridan Avenue, Miami Beach
STATION No 28

COPYRIGHT © 1995 ZYSCOVICH, INC. ALL RIGHTS RESERVED. THESE DRAWINGS AND SPECIFICATIONS ARE INSTRUMENTS OF SERVICE AND SHALL REMAIN THE PROPERTY OF ZYSCOVICH, INC. WHETHER THE PROJECT FOR WHICH THEY WERE PREPARED IS EXECUTED OR NOT. THEY ARE NOT TO BE USED IN ANY MANNER ON OTHER PROJECTS OR EXTENSIONS TO THIS PROJECT EXCEPT BY AGREEMENT IN WRITING AND WITH THE APPROPRIATE COMPENSATION TO ZYSCOVICH, INC. REPRODUCTIONS OF SPECIFICATIONS WITHOUT THE WRITTEN CONSENT OF ZYSCOVICH, INC. IS PROHIBITED.


Seal:

CONFORMED FEB 99
REG. NO. C001431
Site & Roof Plans
RECORD DRAWINGS

Revised: _____
Revised: _____
Revised: REPROCUREMENT JAN. 2003
Revised: RECORD DRAWING 12/07
Revised: _____

05/22/98
9507PUMP

A 11

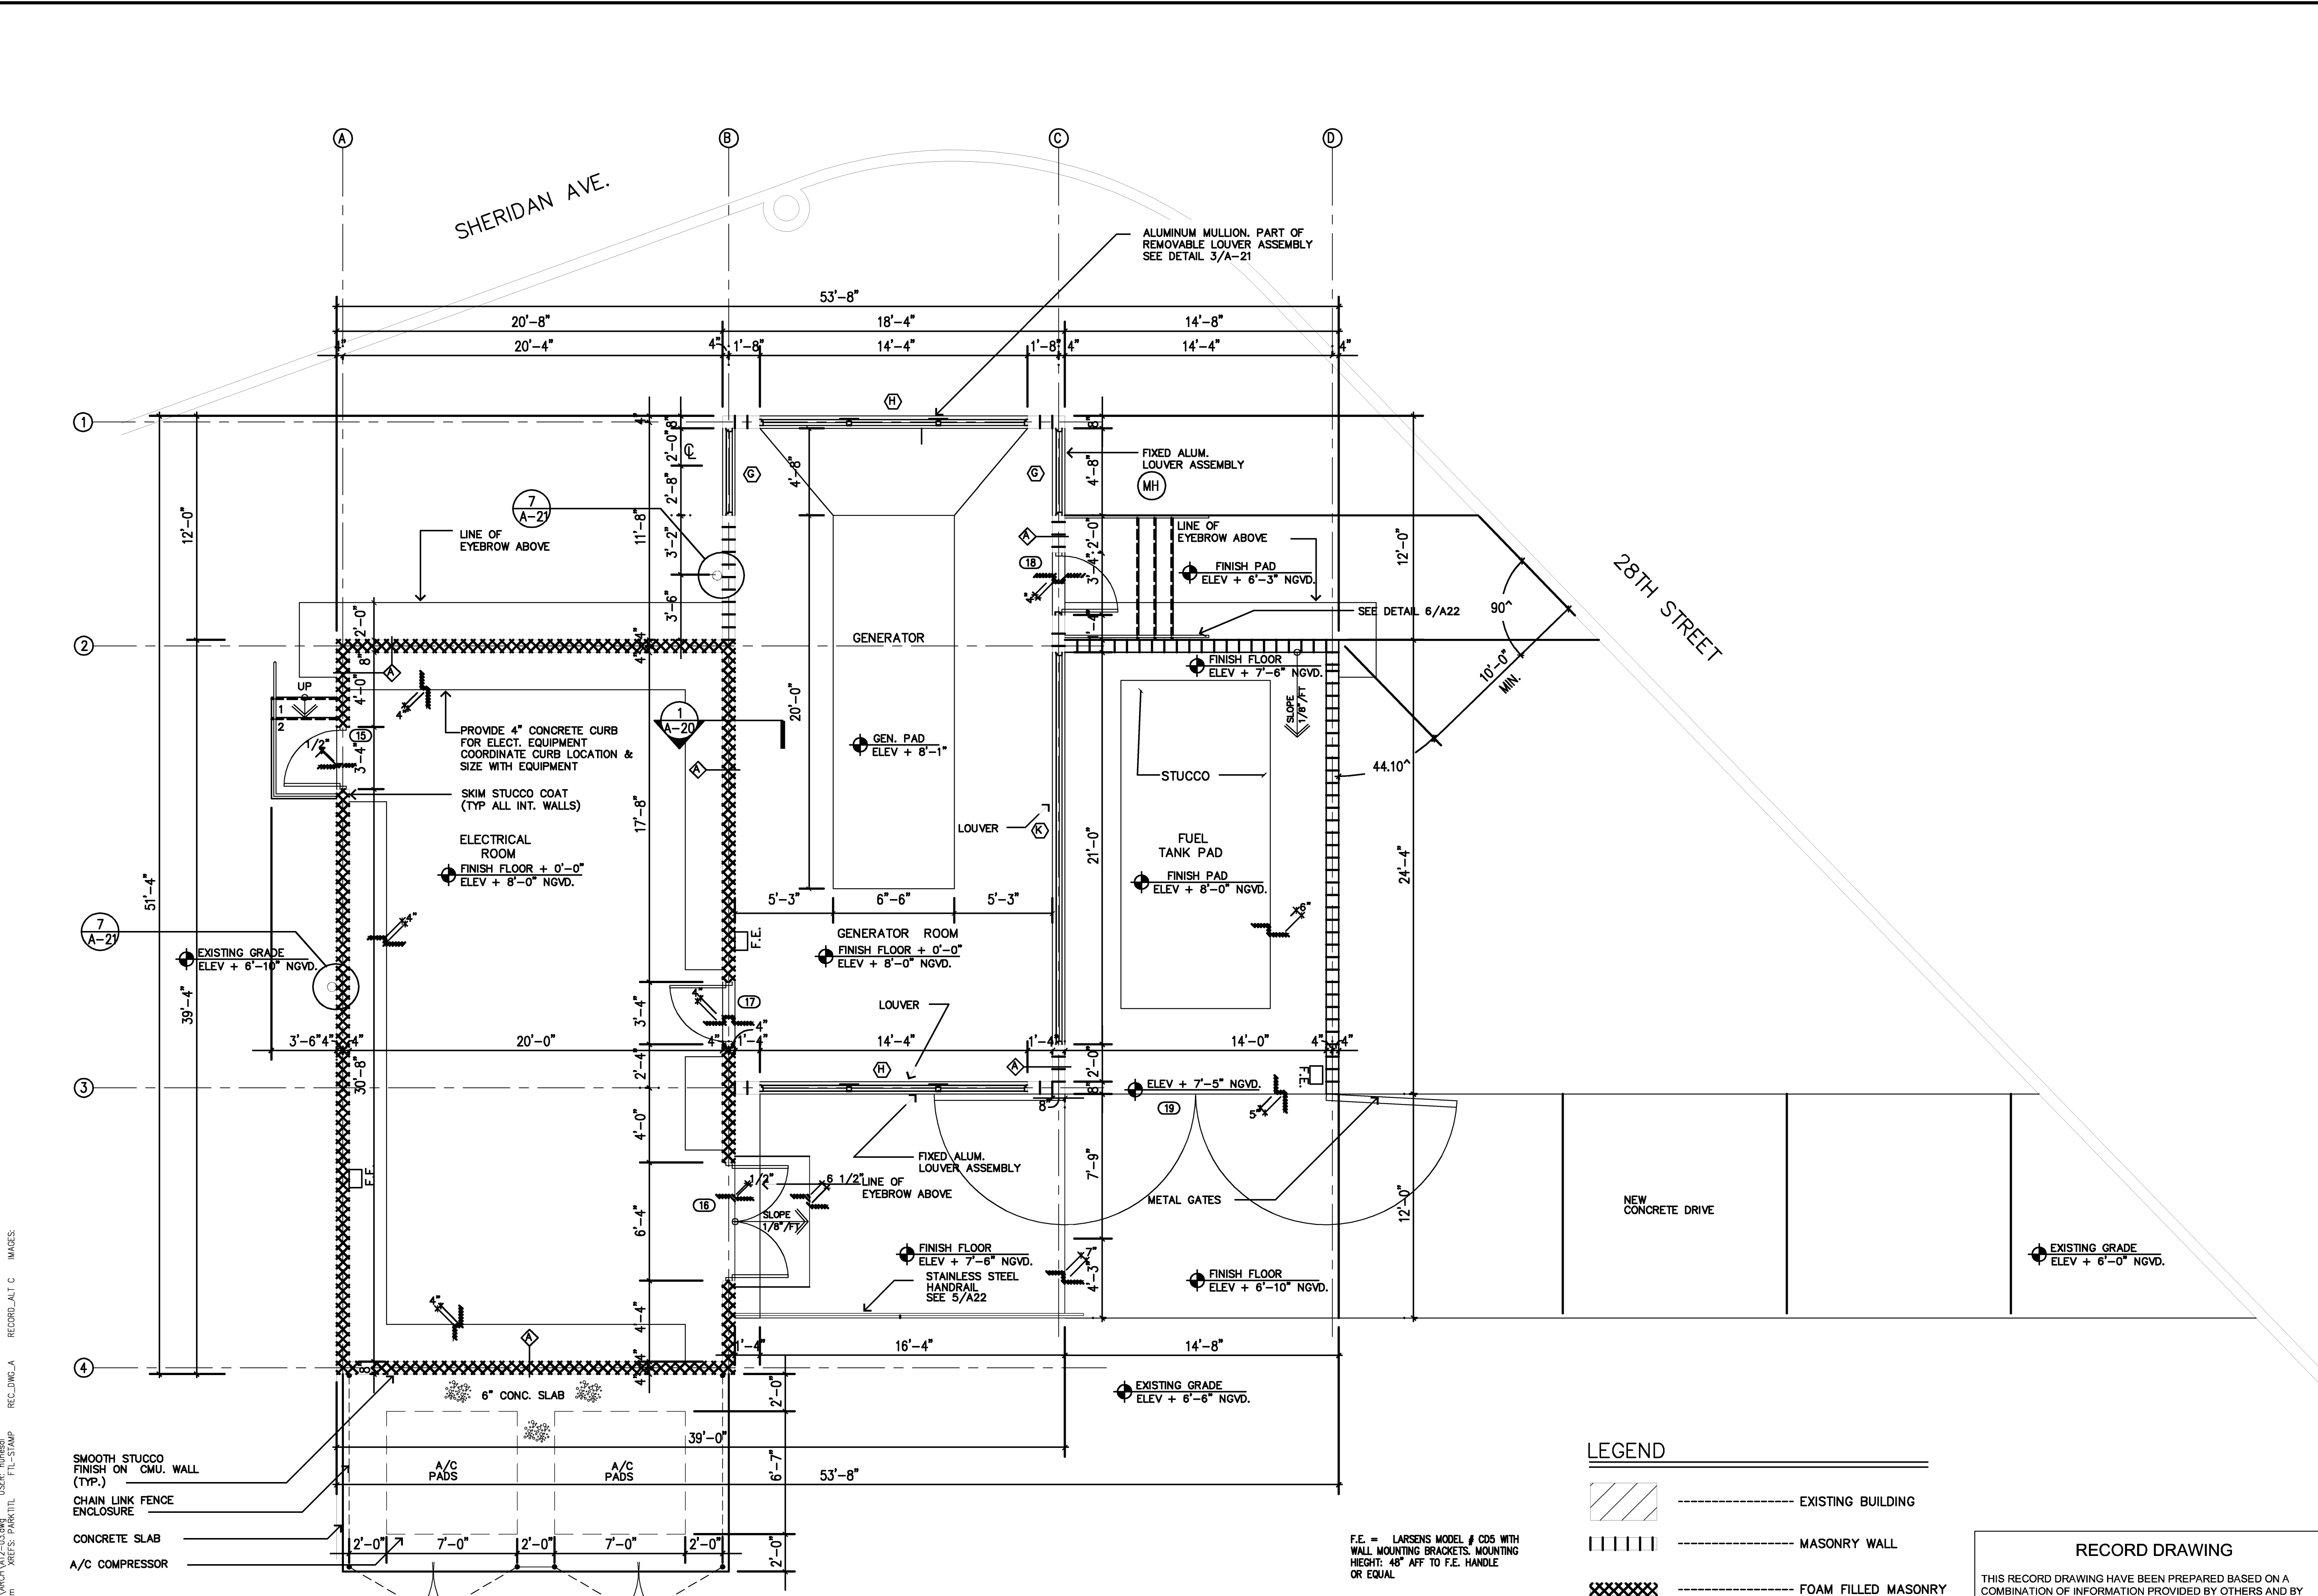

FINISH NOTES:
 INTERIOR FINISHES (ALL INTERIOR ROOMS)
 WALLS: SKIM COAT STUCCO / PAINT
 FLOOR: CONCRETE SEALER
 CEILING: PAINTED (EXCEPT ELECTRICAL ROOMS WHICH SHALL RECEIVE A LAY-IN ACOUSTICAL CEILING. COORDINATE WITH ELECTRICAL)

DONNELL, DUQUESNE & ALBAISA, P.A.
 CONSULTING ENGINEERS
 RAMON R. DONNELL P.E. 0011860
 PEDRO J. DUQUESNE P.E. 0022764
 AIDA M. ALBAISA P.E. 0045130
 4095 S.W. 74th CT MIAMI, FLORIDA 33155
 (305) 660-0711 FAX: 305 660-2558

CDM
 CAMP DRESSER & MCKEE INC.
 800 Brickell Avenue, Suite 710
 Miami, Florida 33131
 305 372-7171, Fax: 305 372-9167

City of Miami Beach
zyscovich
 100 N. BISCAYNE BLVD. SUITE 1400 MIAMI FL 33132
 T 305 372-5222 F 305 577-4521
 CS 13027, 2250

ELECTRIC GENERATOR
 28th Street and Sheridan Avenue, Miami Beach
 STATION No 28

COPYRIGHT ©1995 ZYSCOVICH, INC. ALL RIGHTS RESERVED. THESE DRAWINGS AND SPECIFICATIONS ARE INSTRUMENTS OF SERVICE AND SHALL REMAIN THE PROPERTY OF ZYSCOVICH, INC. WHETHER THE PROJECT FOR WHICH THEY WERE PREPARED IS EXECUTED OR NOT. THEY ARE NOT TO BE USED IN ANY MANNER ON OTHER PROJECTS OR EXTENSIONS TO THIS PROJECT EXCEPT BY AGREEMENT IN WRITING AND WITH THE APPROPRIATE COMPENSATION TO ZYSCOVICH, INC. REPRODUCTIONS OF SPECIFICATIONS WITHOUT THE WRITTEN CONSENT OF ZYSCOVICH, INC. IS PROHIBITED.

Seal:
 CONFORMED FEB 99
 REG. NO. C001431

FLOOR PLAN
 RECORD DRAWINGS

Revised:
 Revised:
 Revised:
 Revised: REPROCUREMENT JAN. 2003
 Revised: RECORD DRAWING 12/07


RECORD DRAWING
 THIS RECORD DRAWING HAVE BEEN PREPARED BASED ON A COMBINATION OF INFORMATION PROVIDED BY OTHERS AND BY CDM. THEREFORE, THE ENGINEER HAS NOT VERIFIED THE ACCURACY OF ALL THE INFORMATION. TO THE BEST OF THE ENGINEER'S BELIEF AND KNOWLEDGE, THE INCLUDED RECORD INFORMATION IS REASONABLY ACCURATE.
 By _____ Date December 2007
CDM

04/20/98
 9507PUMP
A 12

DWG: L:\0301-00P\RECORD\ARCH\A12-03.dwg
 DATE: 04-09-2008 14:25pm
 USER: rnarval
 XREFS: PARKITIL
 REC_DRAWING_A
 REC_DRAWING_C IMAGES
 REC_DRAWING_A
 FILE-STAMP

1 Floor Plan
 A 12 1/4" = 1'-0"

PUMP STATION NO. 28

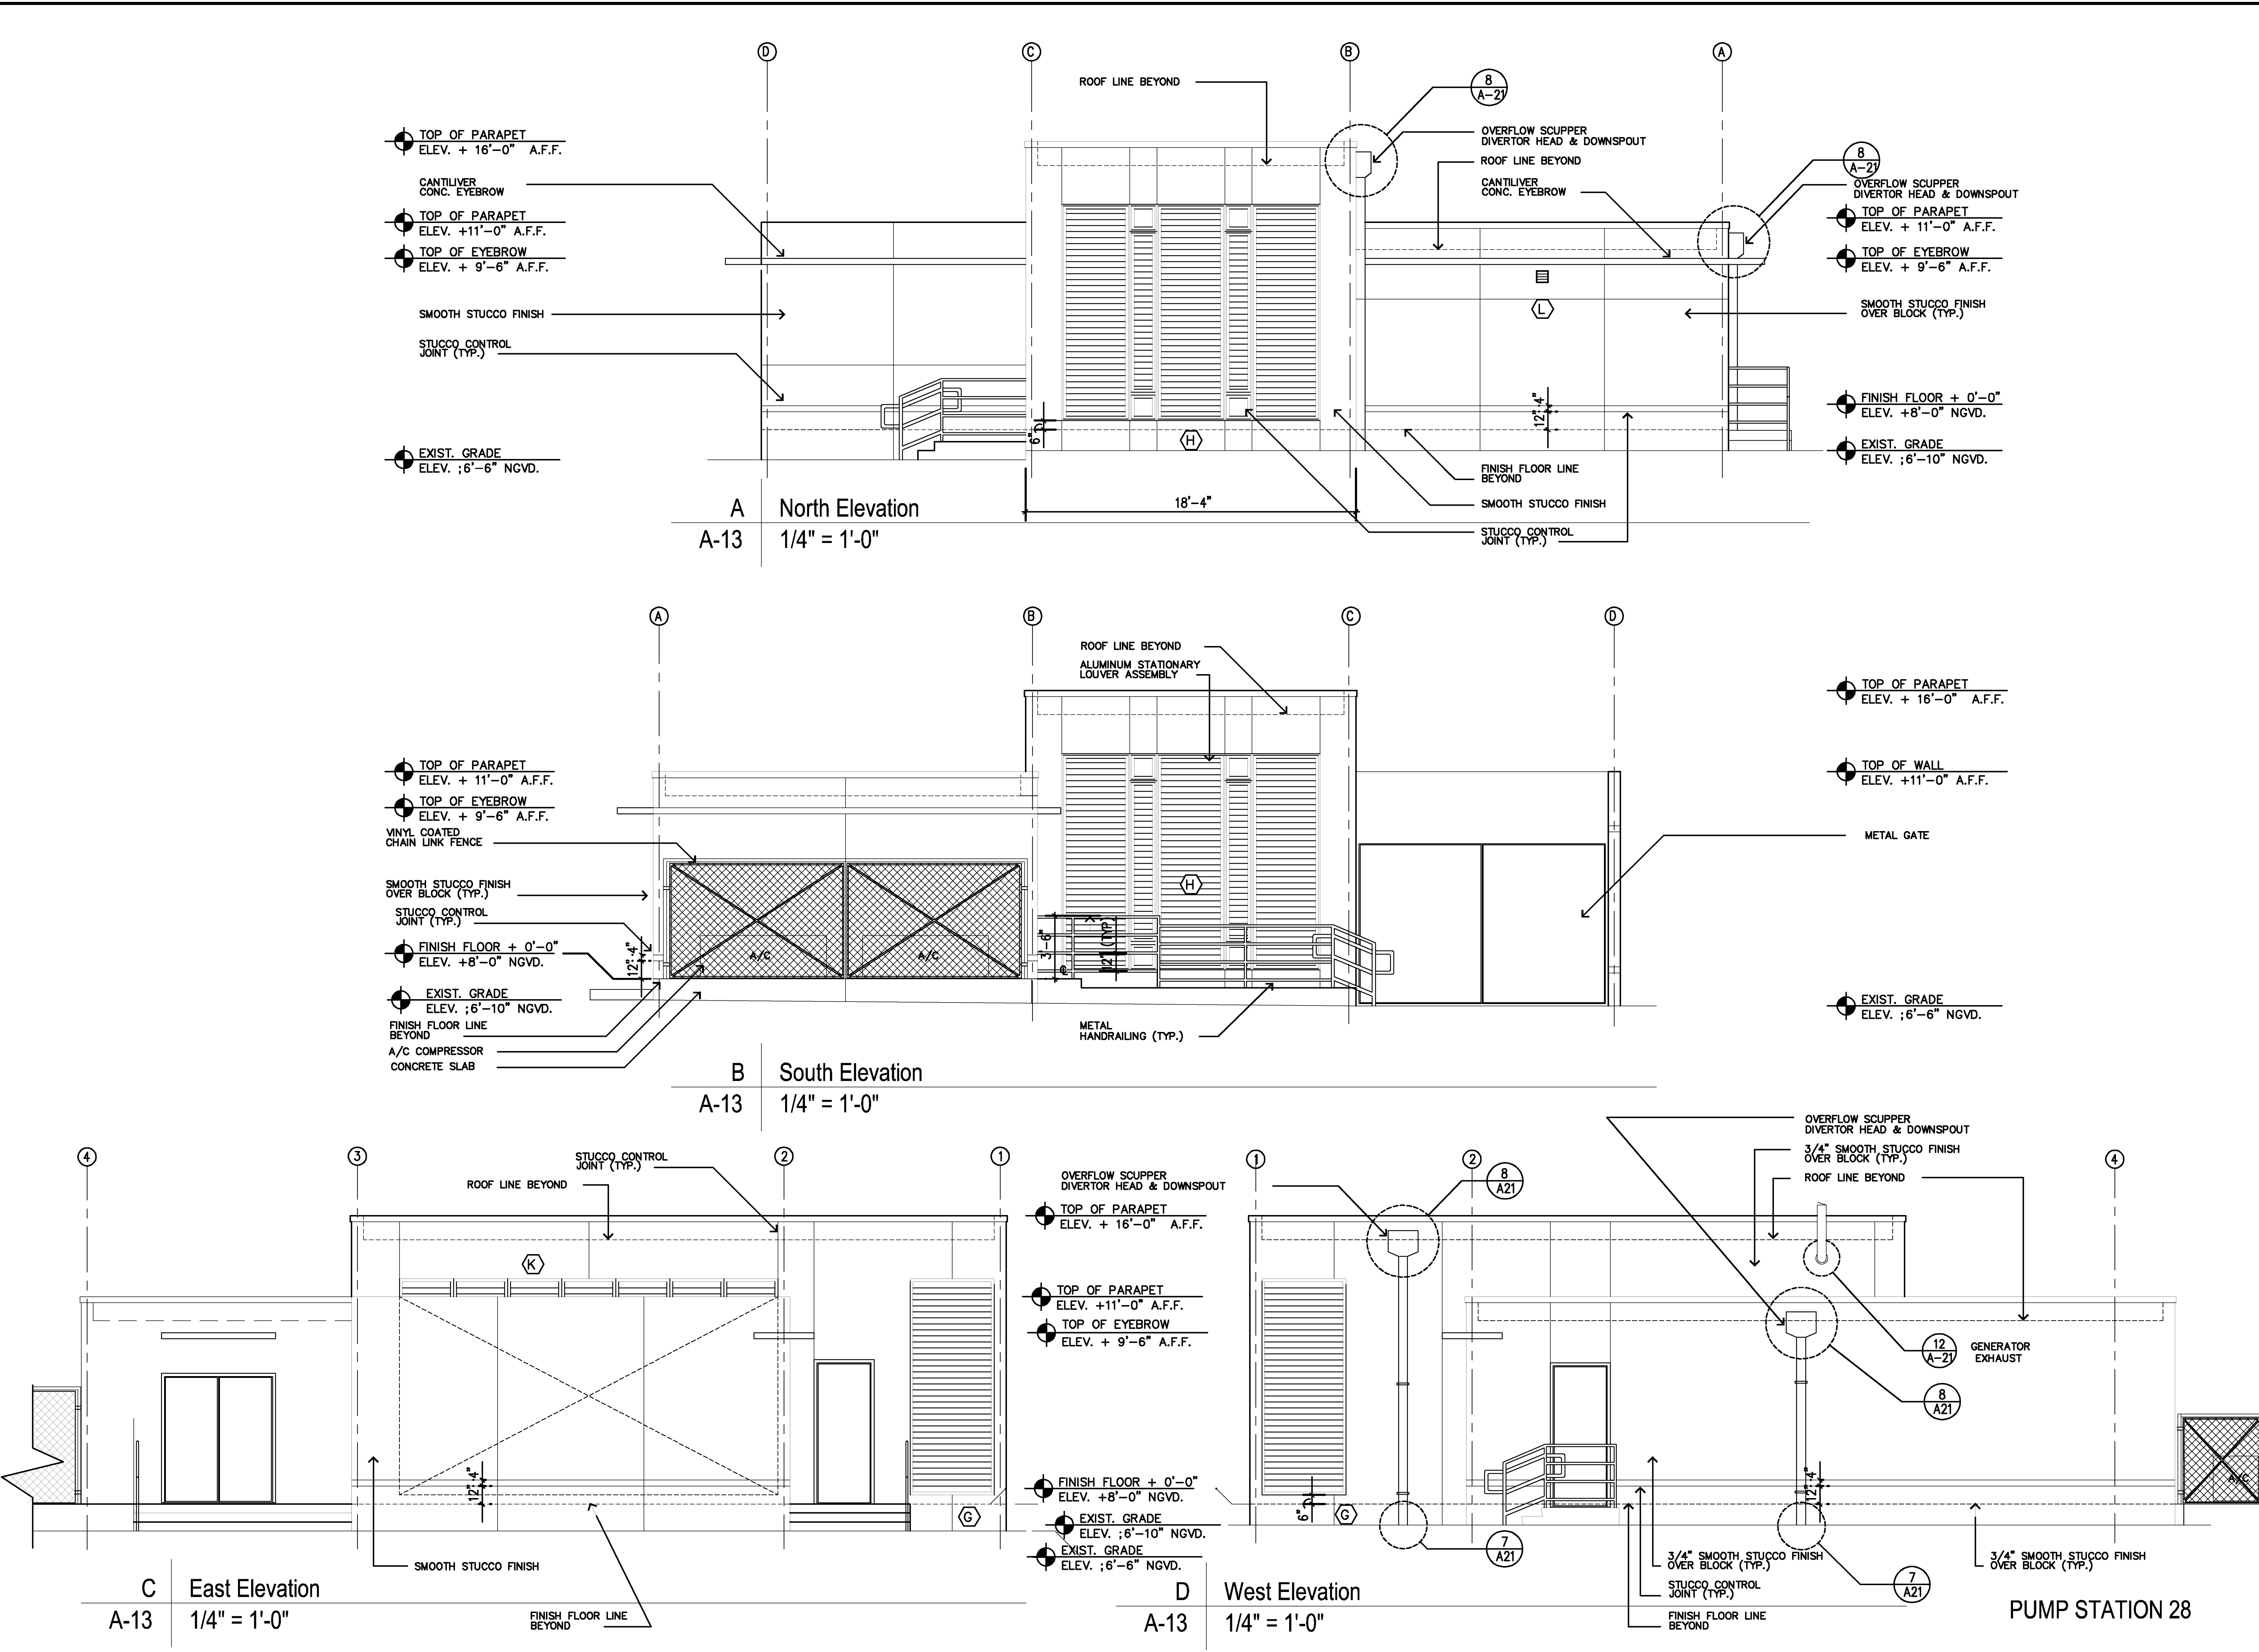

RECORD DRAWING

THIS RECORD DRAWING HAS BEEN PREPARED BASED ON A COMBINATION OF INFORMATION PROVIDED BY OTHERS AND BY THE ENGINEER'S BELIEF AND KNOWLEDGE. THE ENGINEER'S BELIEF AND KNOWLEDGE IS LIMITED TO THE INFORMATION PROVIDED TO THE ENGINEER. THE ENGINEER'S BELIEF AND KNOWLEDGE IS LIMITED TO THE INFORMATION PROVIDED TO THE ENGINEER. THE ENGINEER'S BELIEF AND KNOWLEDGE IS LIMITED TO THE INFORMATION PROVIDED TO THE ENGINEER.

By _____ Date December 2007

CDM

DONNELL, DUQUESNE & ALBAISA, P.A.
CONSULTING ENGINEERS

RAMON R. DONNELL P.E. 0011890
PEDRO J. DUQUESNE P.E. 0022764
AIDA M. ALBAISA P.E. 0048130

4930 S.W. 74th CT. MIAMI, FLORIDA 33155
(305) 486-0111

CDM

CAMP DRESSER & MCKEE INC.
800 Brickell Avenue, Suite 710
Miami, Florida 33131
305 372-7171, Fax: 305 372-9167

City of Miami Beach

zyscovich

100 N. BISCAYNE BLVD., SUITE 1400 MIAMI FL 33132
T 305 372 5222 F 305 577 4521
CBS 73527, 2250

ELECTRIC GENERATOR

28th Street and Sheridan Avenue, Miami Beach
STATION No 28

COPYRIGHT ©1995 ZYSCOVICH, INC. ALL RIGHTS RESERVED. THESE DRAWINGS AND SPECIFICATIONS ARE INSTRUMENTS OF SERVICE AND SHALL REMAIN THE PROPERTY OF ZYSCOVICH, INC. WHETHER THE PROJECT FOR WHICH THEY WERE PREPARED IS EXECUTED OR NOT. THEY ARE NOT TO BE USED IN ANY MANNER ON OTHER PROJECTS OR EXTENSIONS TO THIS PROJECT EXCEPT BY AGREEMENT IN WRITING AND WITH THE APPROPRIATE COMPENSATION TO ZYSCOVICH, INC. REPRODUCTIONS OF SPECIFICATIONS WITHOUT THE WRITTEN CONSENT OF ZYSCOVICH, INC. IS PROHIBITED.

Seal:

CONFORMED FEB 99
REG. NO. C001431


Elevations

RECORD DRAWINGS


Revised:	
Revised:	
Revised:	
Revised:	REPRODUCTION JAN. 2003
Revised:	RECORD DRAWING 12/07

SCHEME A	04/20/98
	9507PUMP


A 13

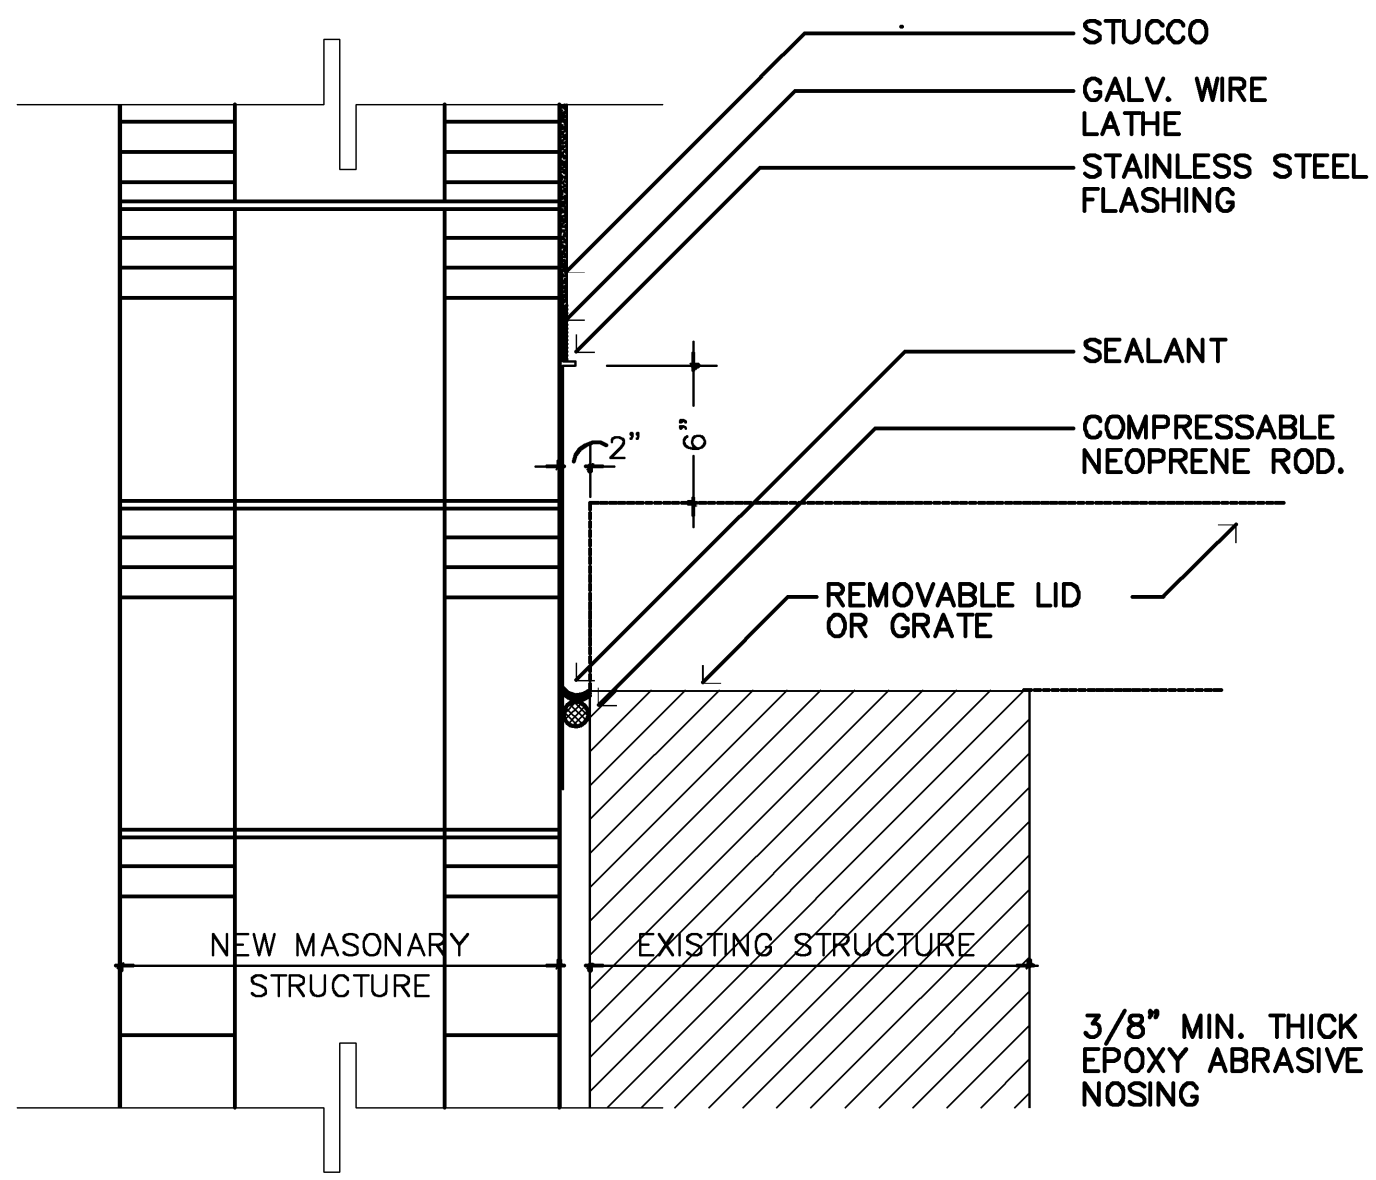


1 DETAIL @ WALL INTERSECTION
A21 N.T.S.

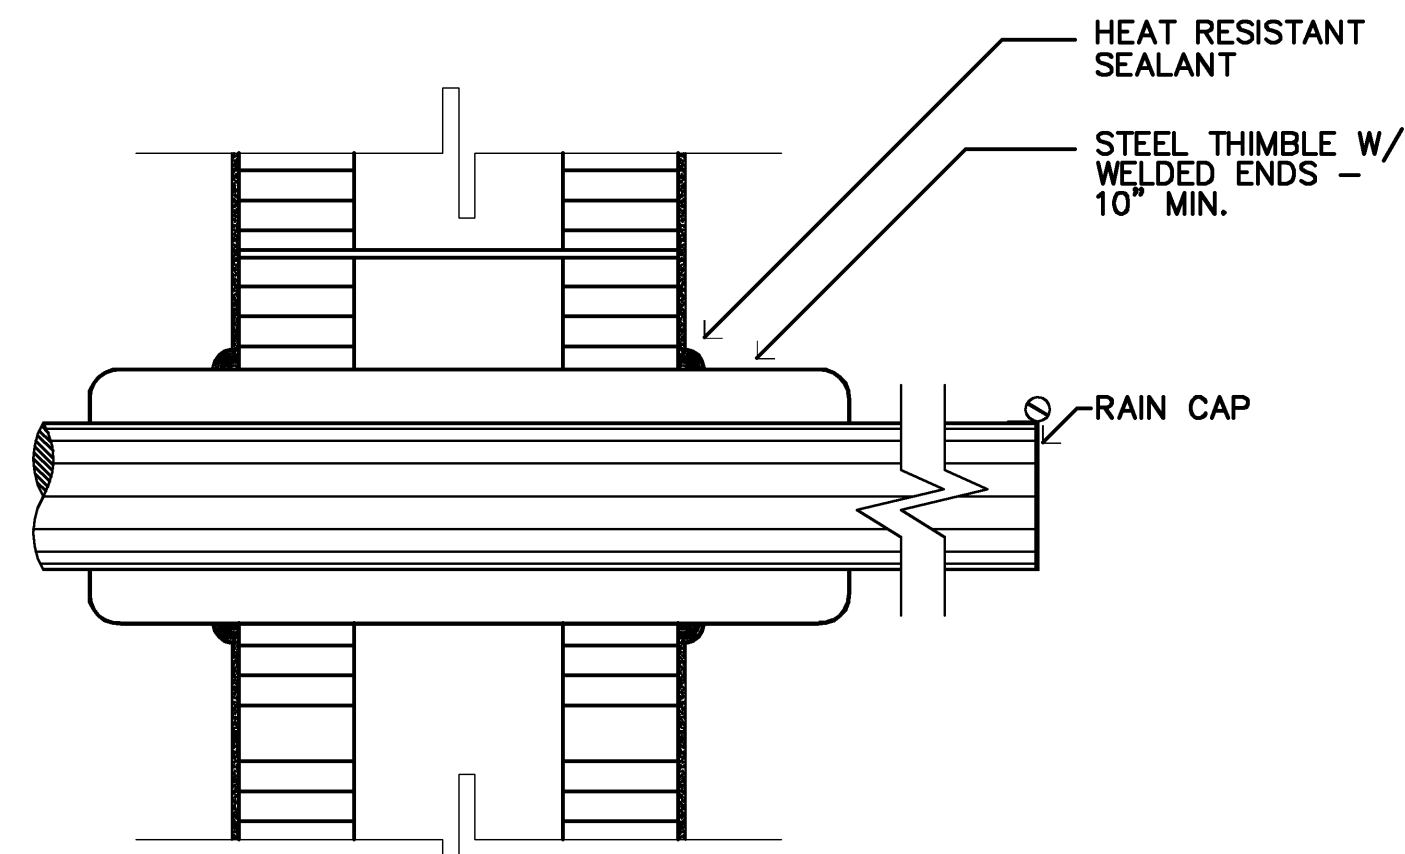


2 GENERATOR EXHAUST
A21 N.T.S.

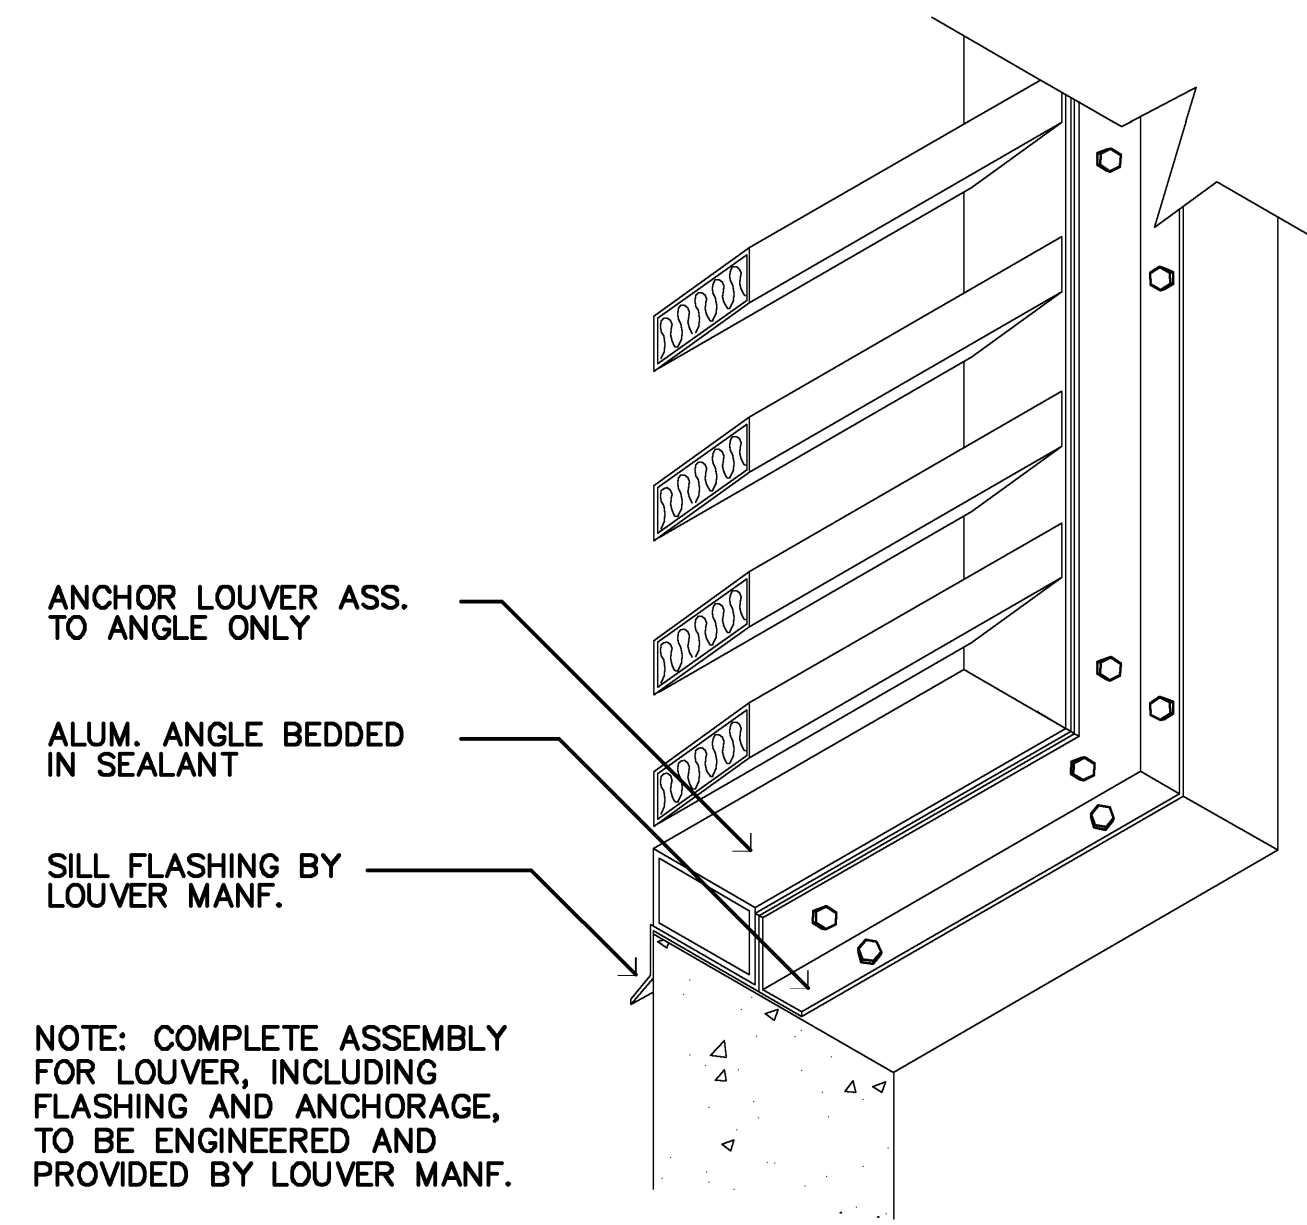


3 REMOVABLE LOUVER
A21 N.T.S.

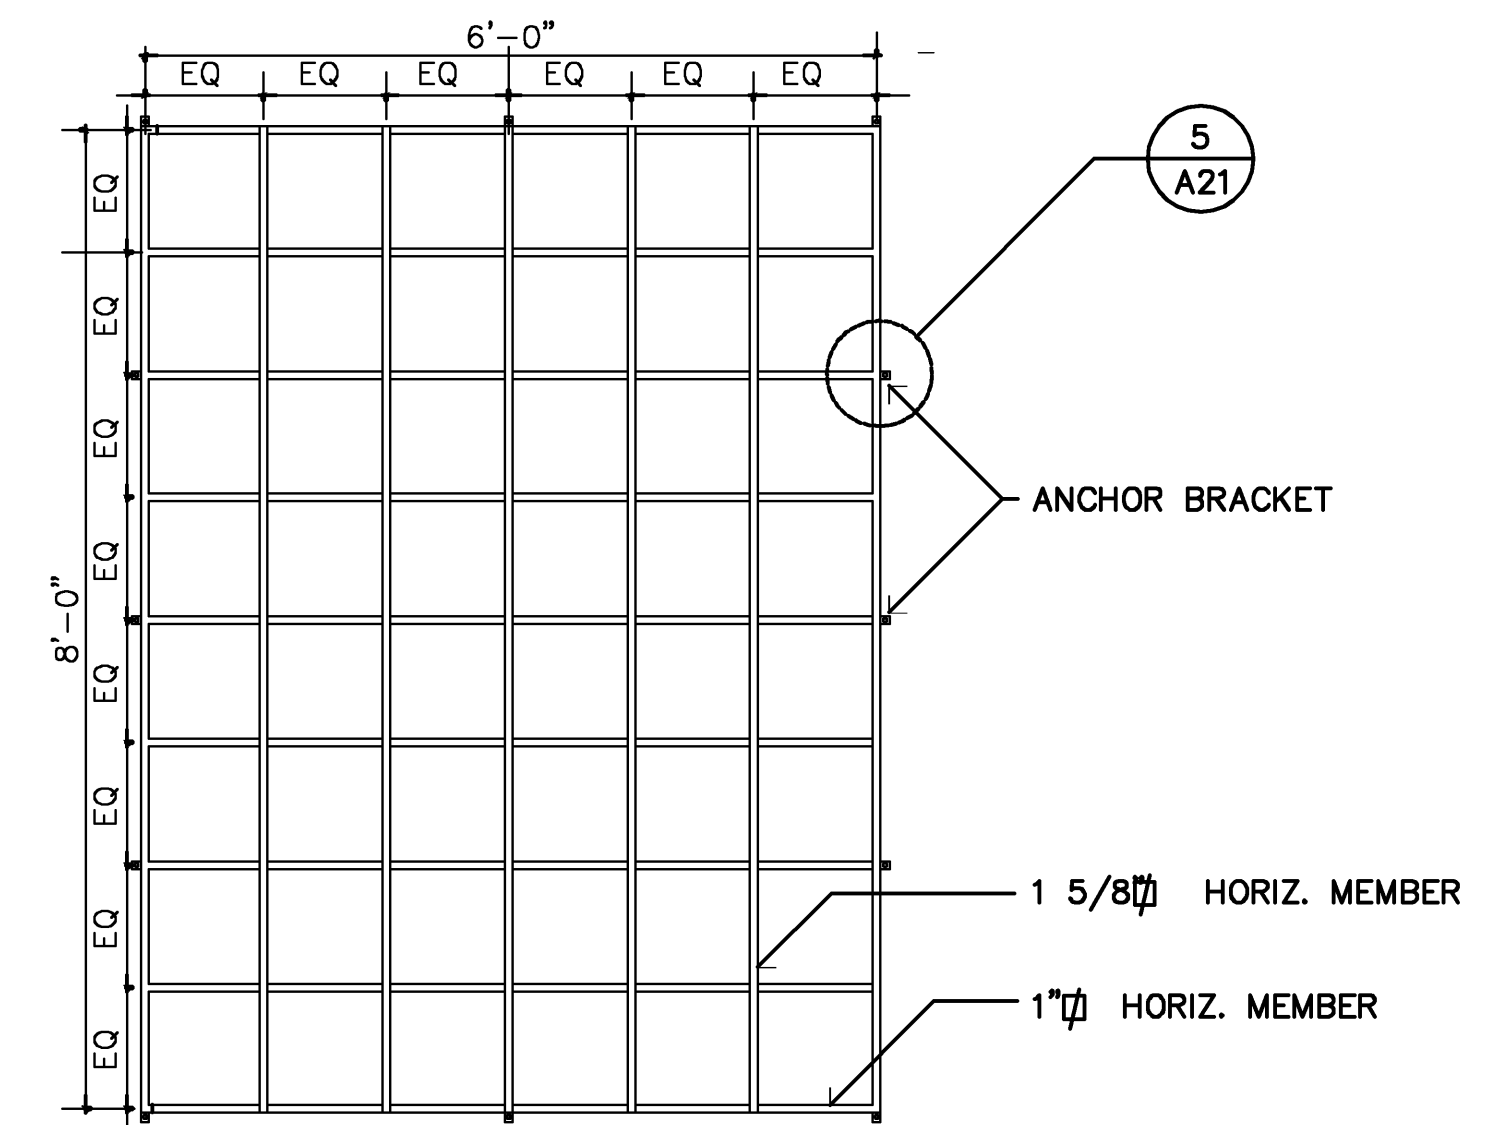


4 TRELLIS ELEVATION
A21 N.T.S.

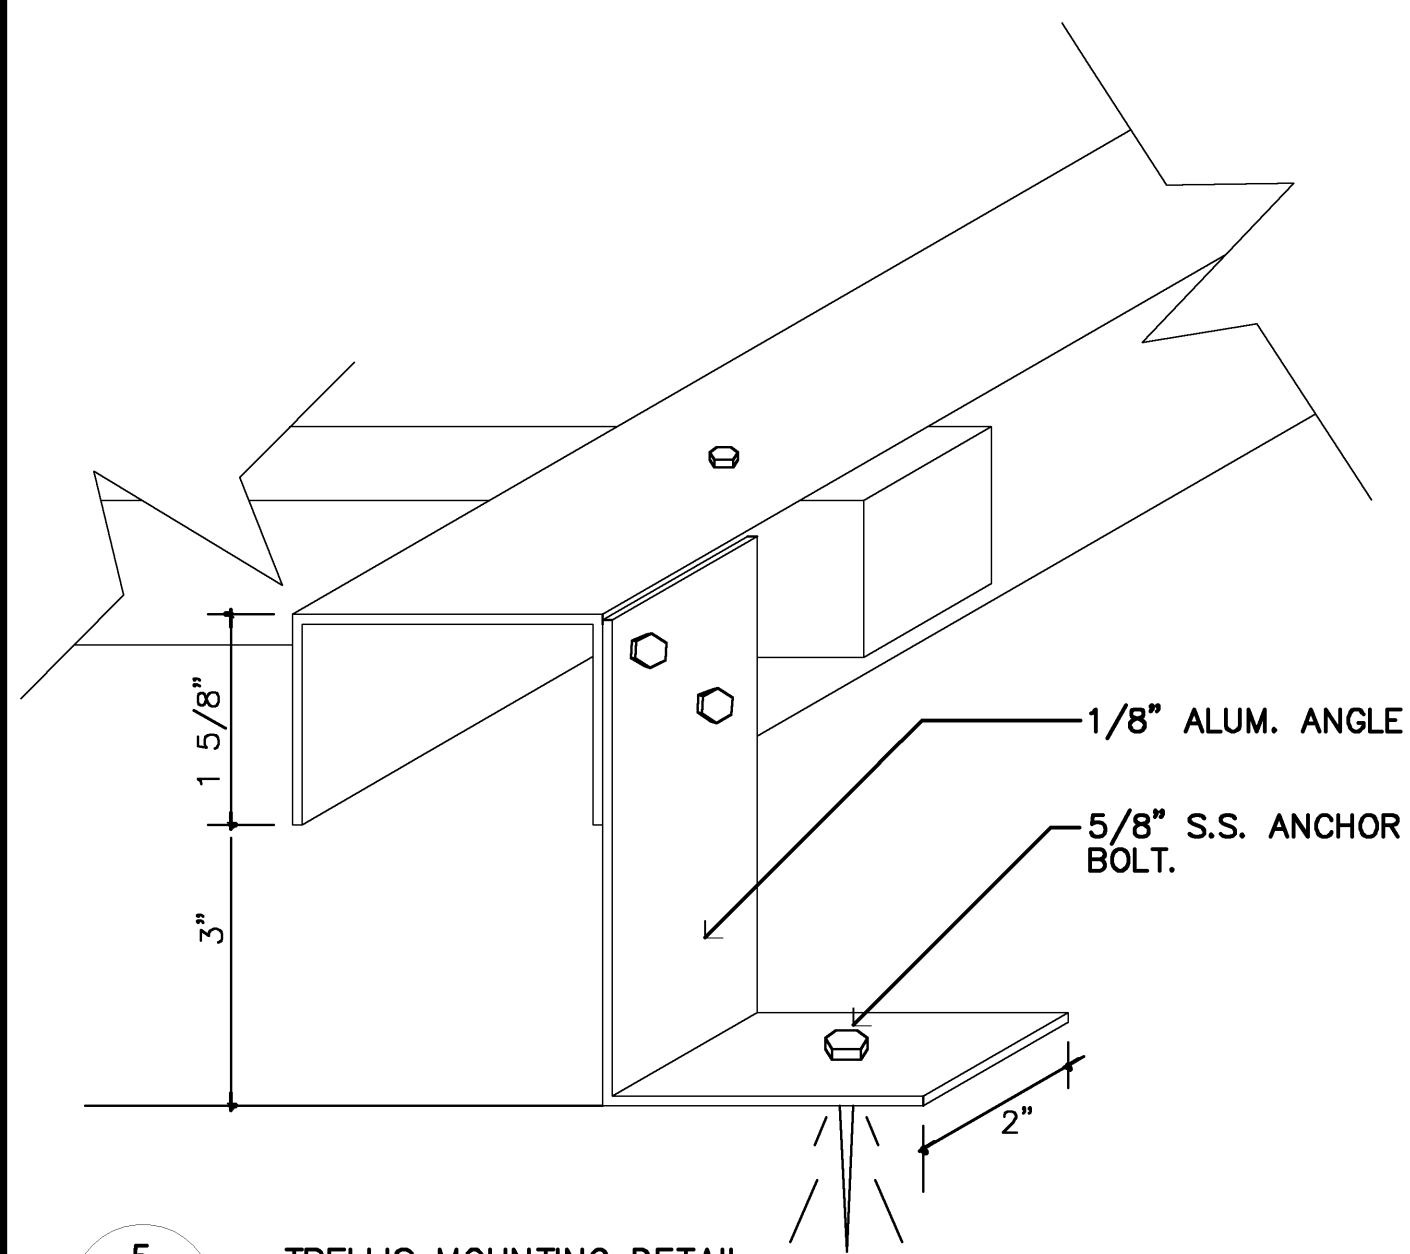


5 TRELLIS MOUNTING DETAIL
A21 N.T.S.

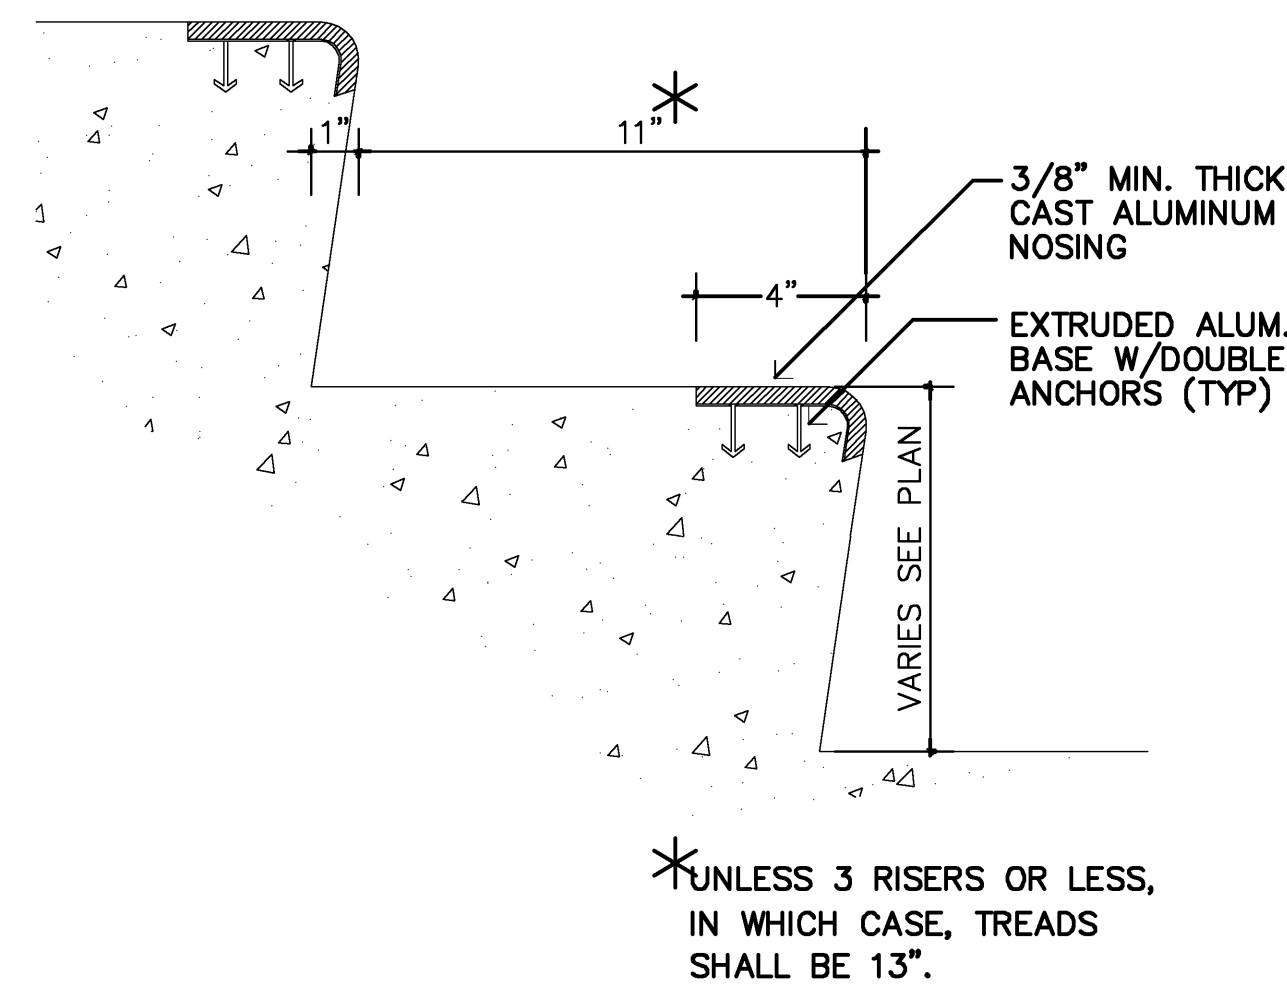


6 TYPICAL NOSING DETAIL
A21 N.T.S.

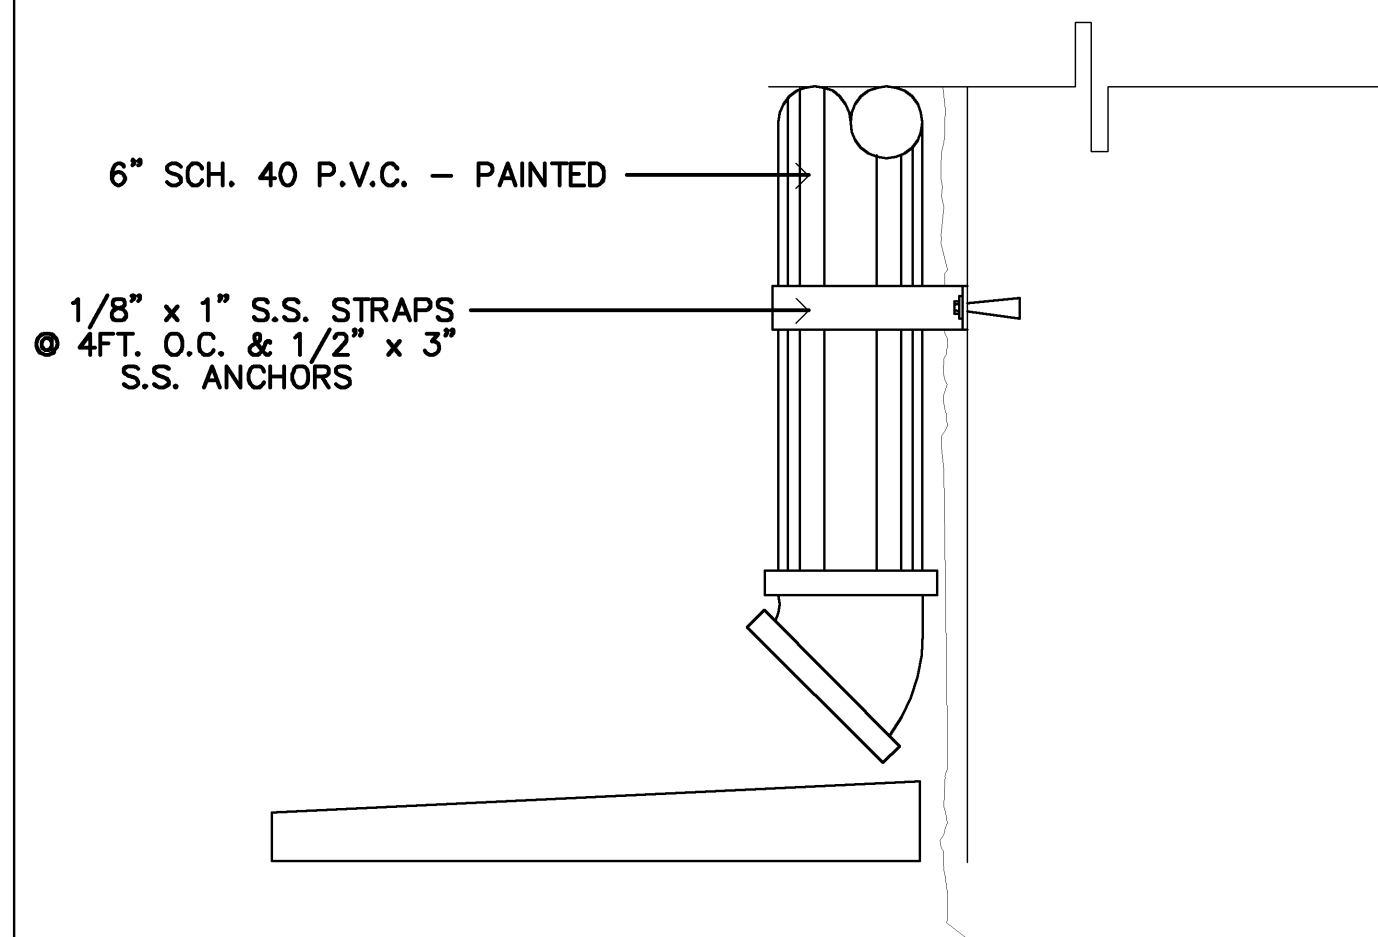


7 PVC DOWN SPOUT/STORM SEWER DETAIL
A21 1"=1'-0"

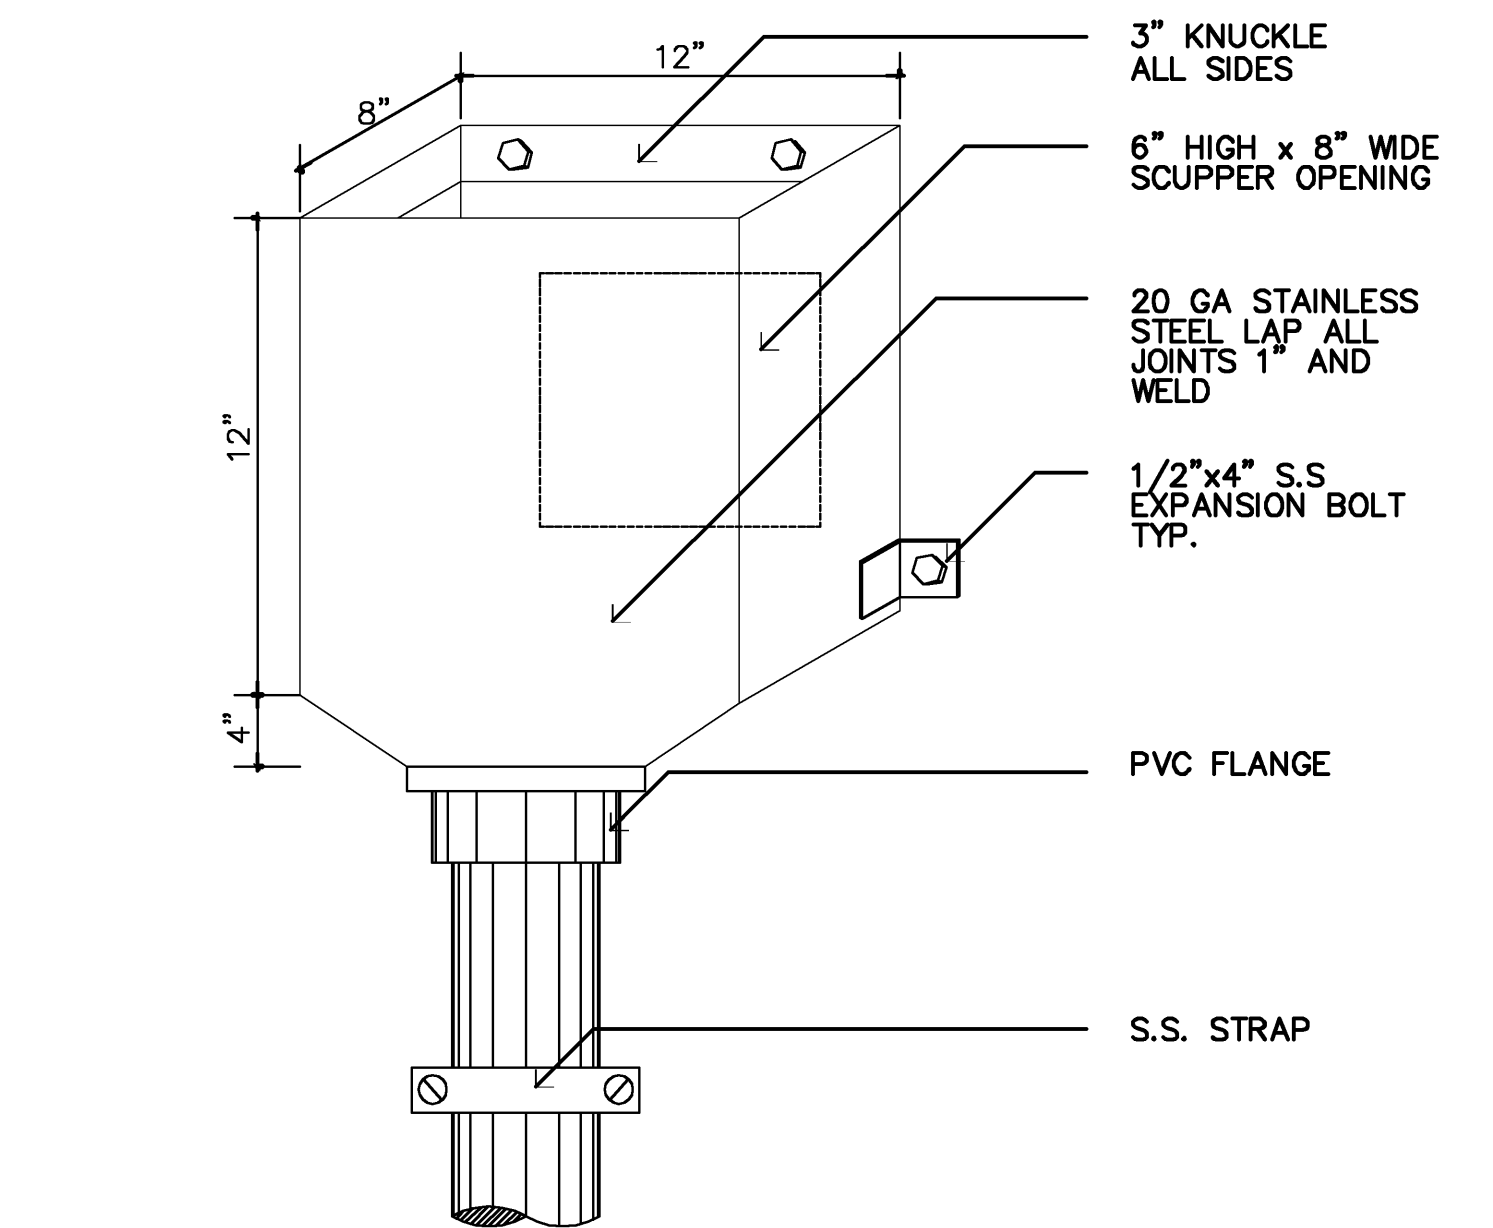


8 CONDUCTOR HEAD
A21 N.T.S.

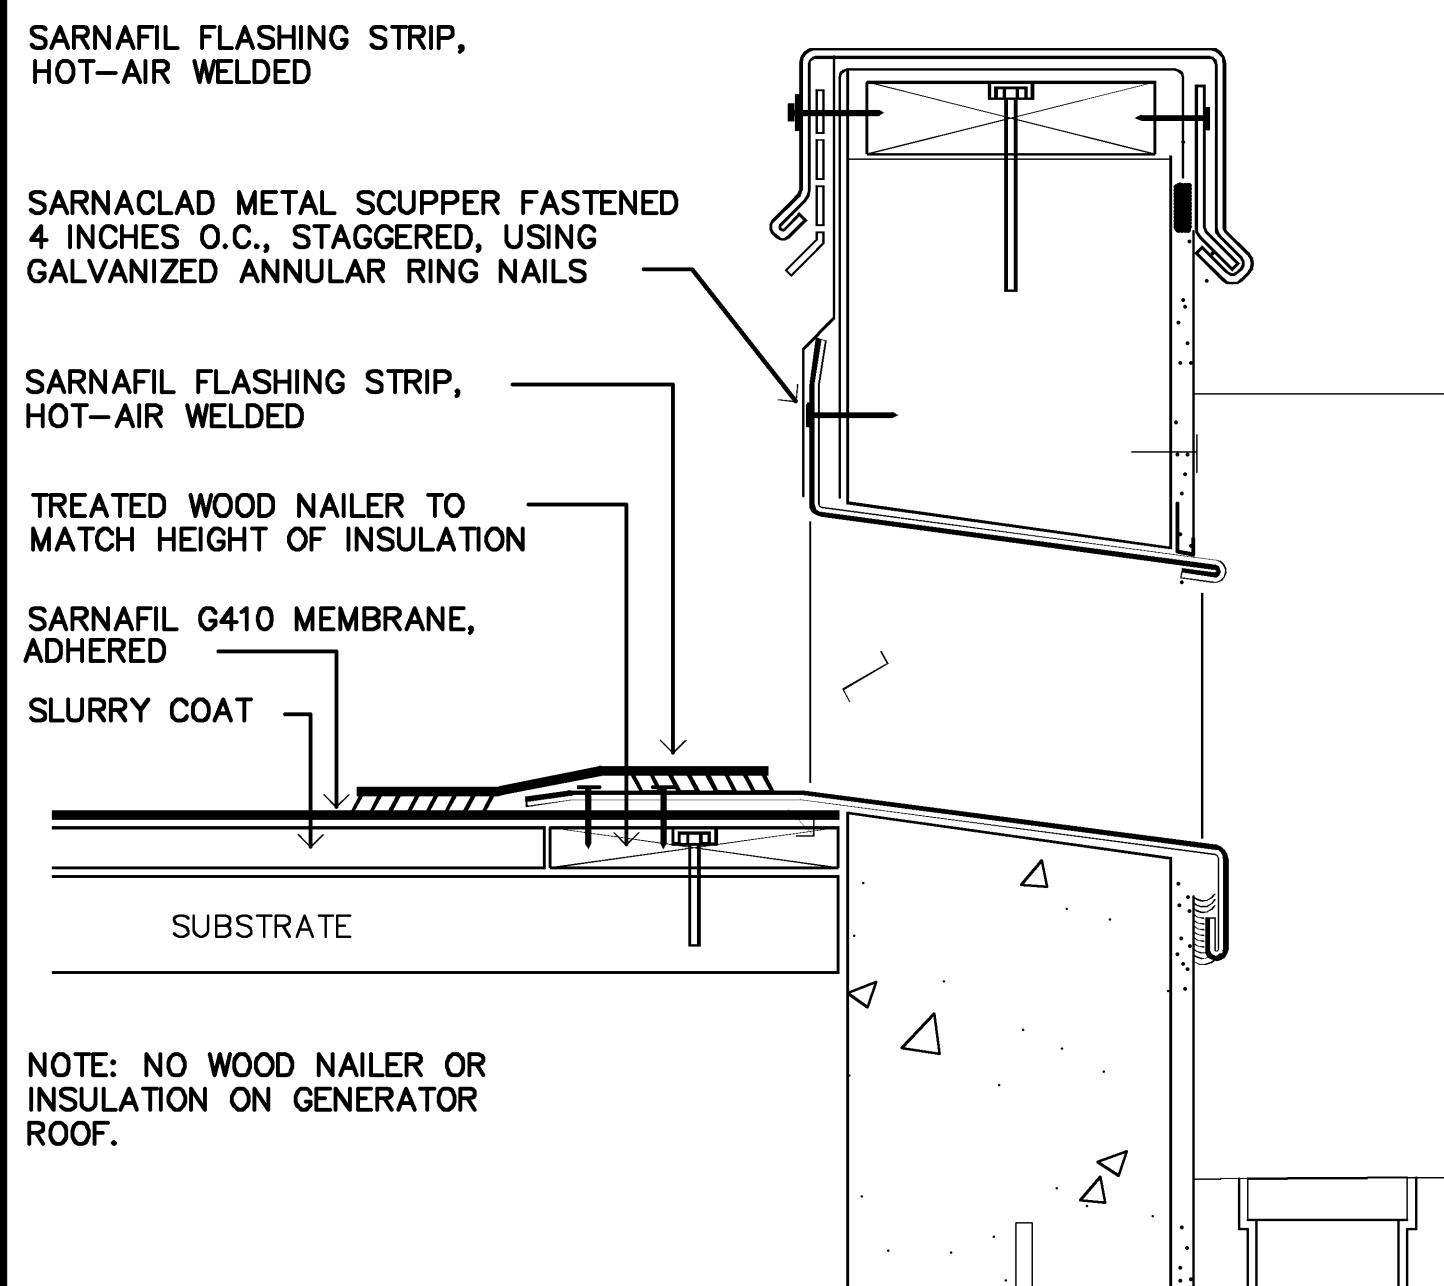


9 THRU - WALL SCUPER
A21 3"=1'-0"

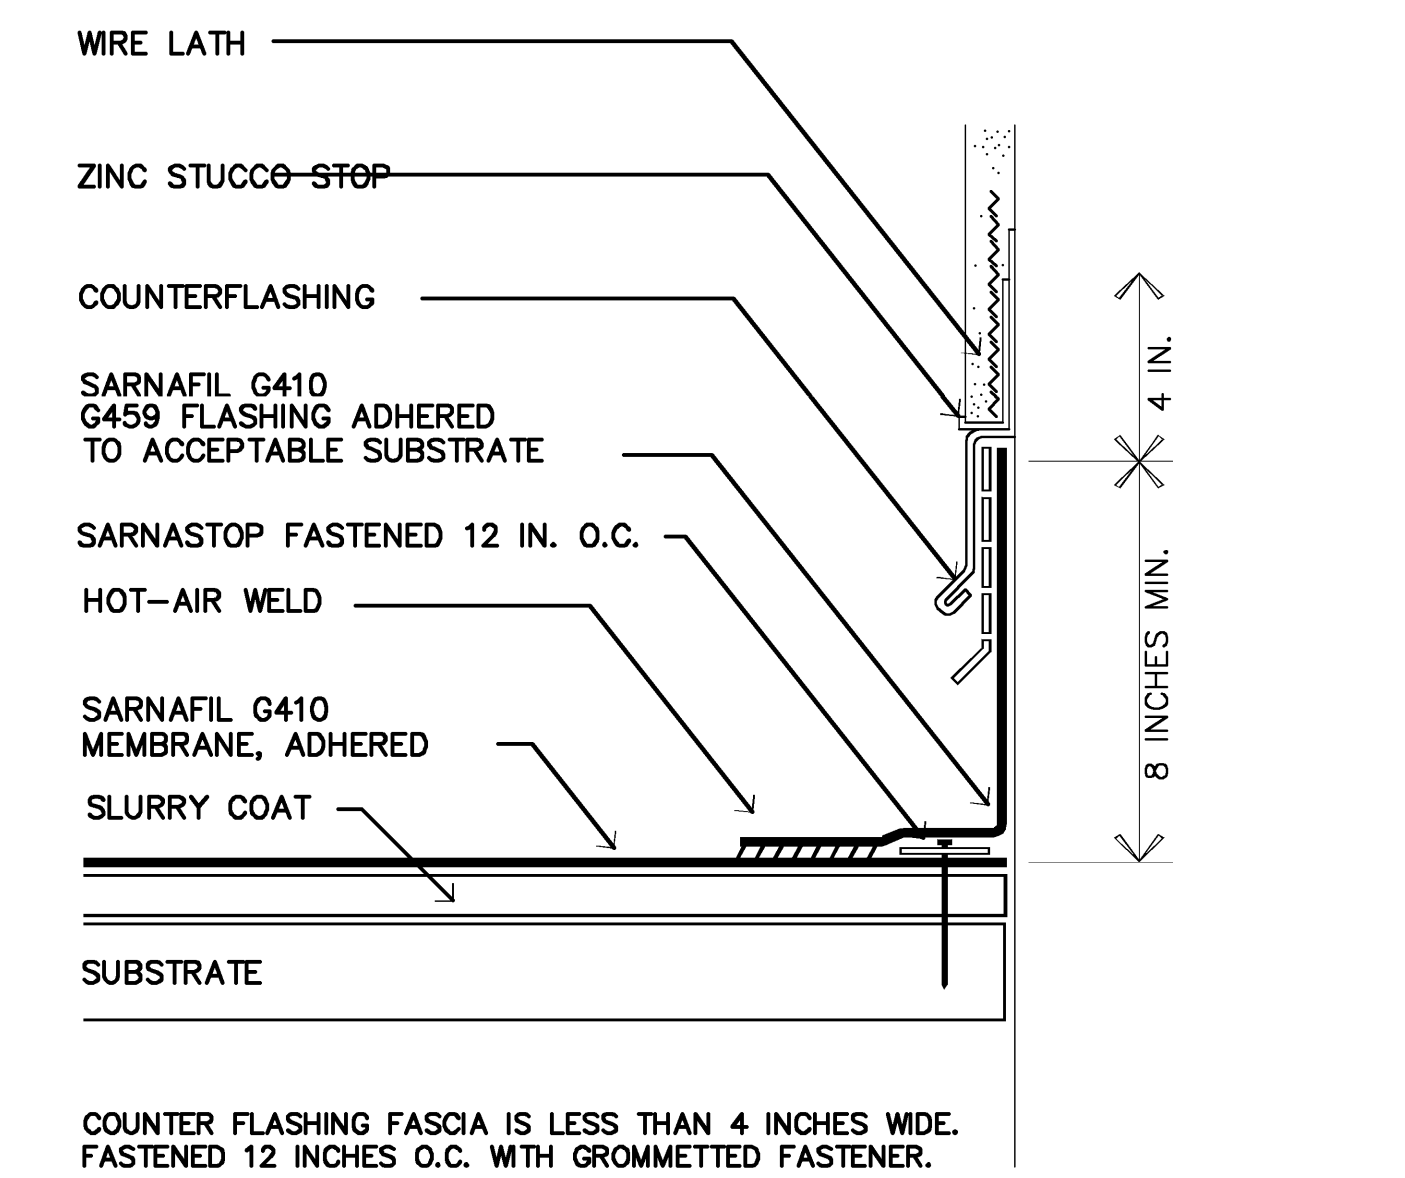

10 CUT-IN REGLET
A21 3"=1'-0"

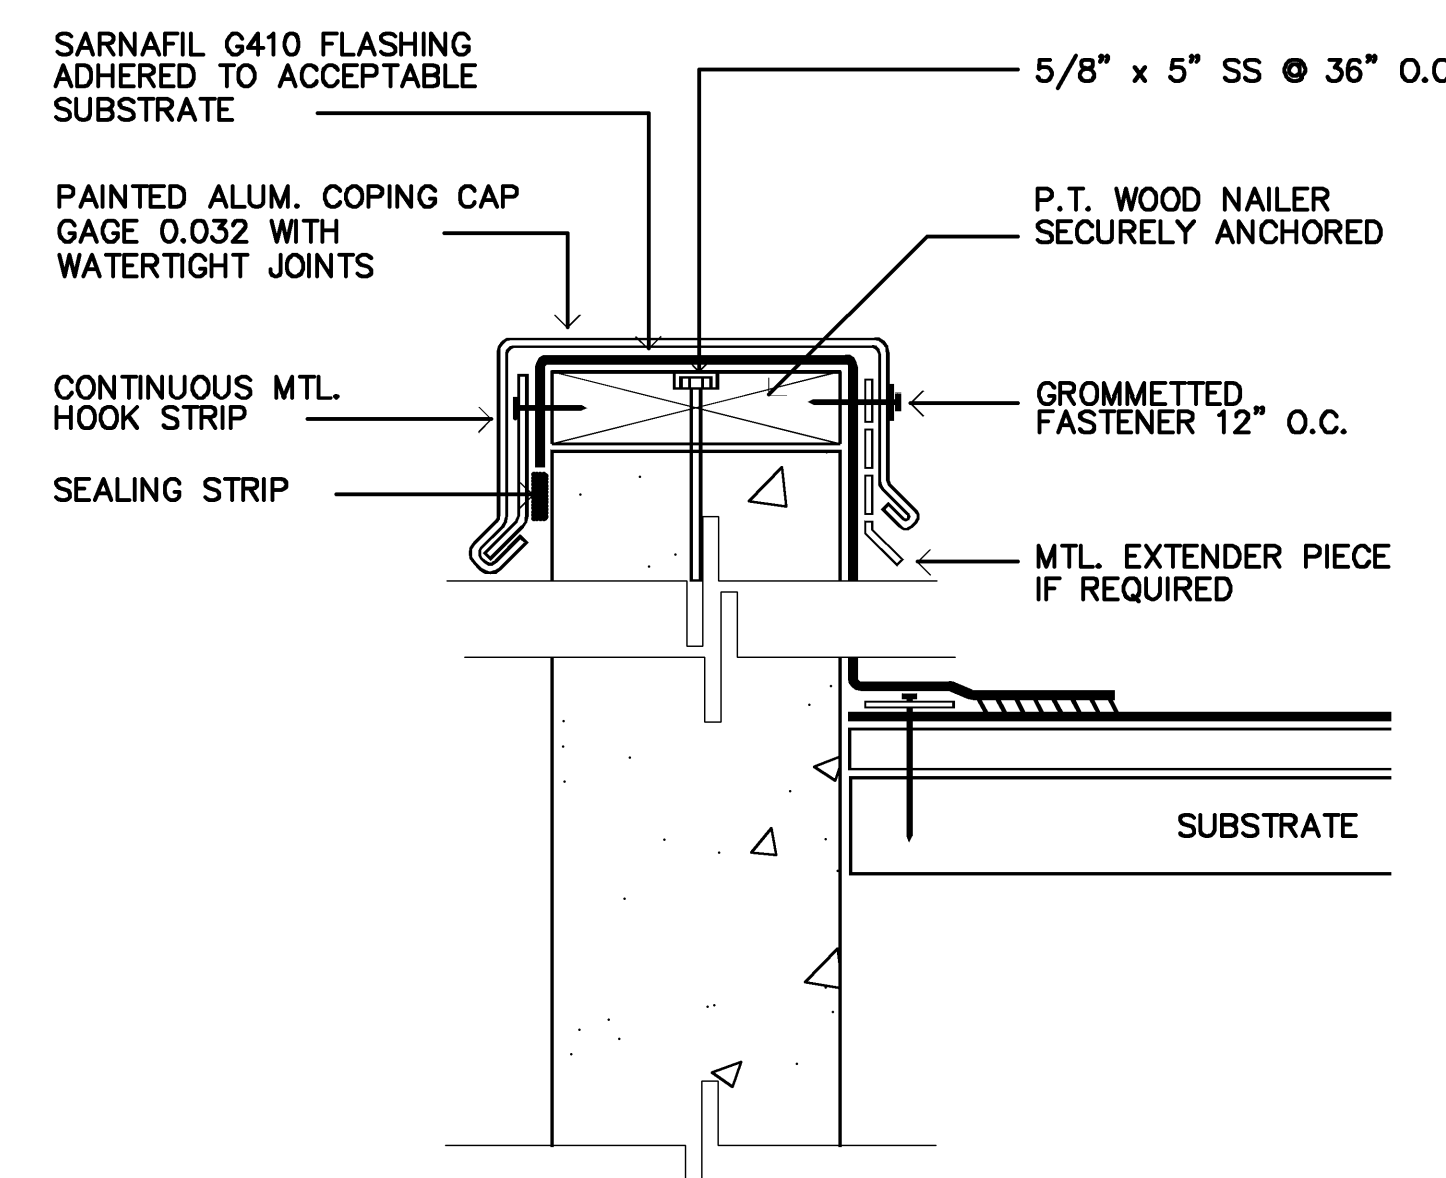

11 PARAPET WALL W / COPING CAP
A21 3"=1'-0"

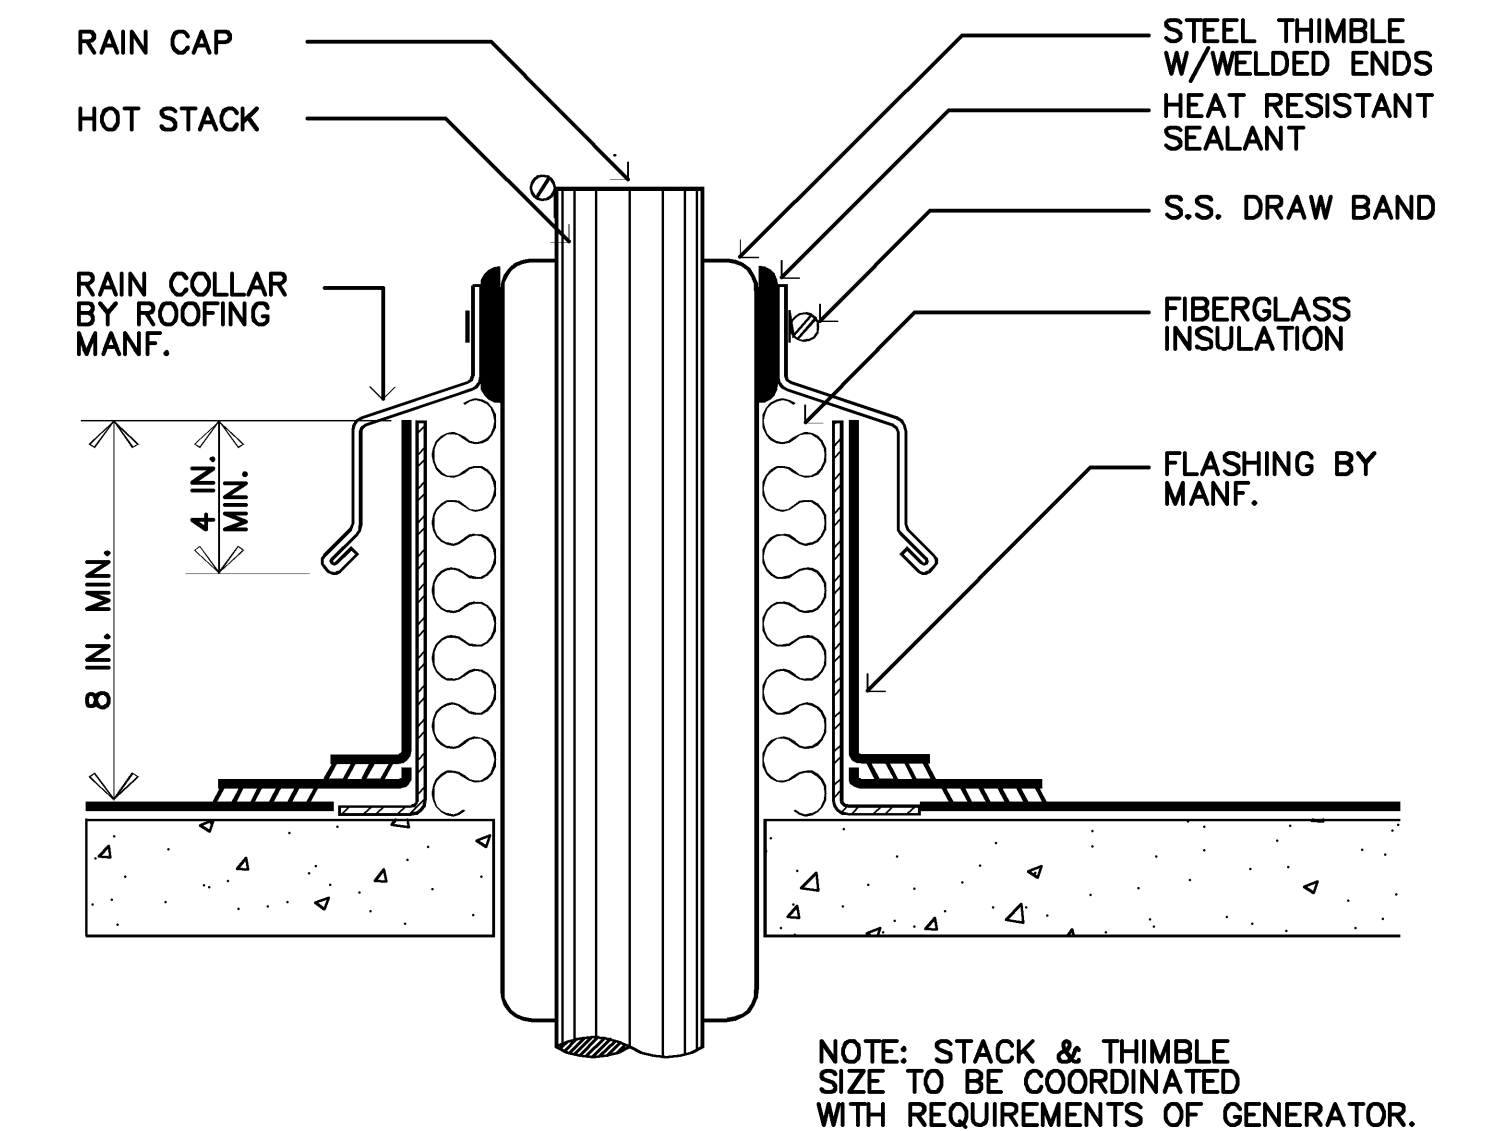

12 GENERATOR EXHAUST
A21 N.T.S.

RECORD DRAWING
THIS RECORD DRAWING HAS BEEN PREPARED BASED ON A COMBINATION OF INFORMATION PROVIDED BY OTHERS AND BY CDM. THEREFORE, THE ENGINEER HAS NOT VERIFIED THE ACCURACY OF ALL THE INFORMATION. TO THE BEST OF THE ENGINEER'S BELIEF AND KNOWLEDGE, THE INCLUDED RECORD INFORMATION IS REASONABLY ACCURATE.
By _____ Date December 2007
CDM

DONNELL, DUQUESNE & ALBAISA, P.A.
CONSULTING ENGINEERS
RAMON R. DONNELL P.E. 0011990
PEDRO J. DUQUESNE P.E. 0022764
AIDA M. ALBAISA P.E. 0045130
4090 S.W. 74th CT. MIAMI, FLORIDA 33159
(305) 666-0711 FAX 954-625-1299

CDM
CAMP DRESSER & McKEE INC.
800 Brickell Avenue, Suite 710
Miami, Florida 33131
305 372-7171, Fax: 305 372-9167

City of Miami Beach

zyscovich
100 N BISCAYNE BLVD., SUITE 1400 MIAMI FL 33132
T 305 372 5222 F 305 577 4521
CIS 73827, 2290

ELECTRIC / GENERATOR
City of Miami Beach

COPYRIGHT ©1995 ZYSCOVICH, INC. ALL RIGHTS RESERVED. THESE DRAWINGS AND SPECIFICATIONS ARE INSTRUMENTS OF SERVICE AND SHALL REMAIN THE PROPERTY OF ZYSCOVICH, INC. WHETHER THE PROJECT FOR WHICH THEY WERE PREPARED IS EXECUTED OR NOT. THEY ARE NOT TO BE USED IN ANY MANNER ON OTHER PROJECTS OR EXTENSIONS TO THIS PROJECT EXCEPT BY AGREEMENT IN WRITING AND WITH THE APPROPRIATE COMPENSATION TO ZYSCOVICH, INC. REPRODUCTIONS OR SPECIFICATIONS WITHOUT THE WRITTEN CONSENT OF ZYSCOVICH, INC. IS PROHIBITED.


Seal:
CONFORMED FEB 99
REG. NO. C001431

DETAILS
RECORD DRAWINGS
Revised:
Revised:
Revised: REPROCUREMENT JAN. 2003
Revised: RECORD DRAWING 12/07
Revised:


04/20/98
9507PUMP

A 21


DWG: L:\9381-02\RECORD\MARCH\A21-03.dwg USER: nunesol
 DATE: Jan 11, 2008 10:55am XREFS: Pump01.rvt
 REC: DWG_A RECORD_A11 C IMAGES: Zyscovich_LC.jpg
 REC: DWG_A RECORD_A11 C

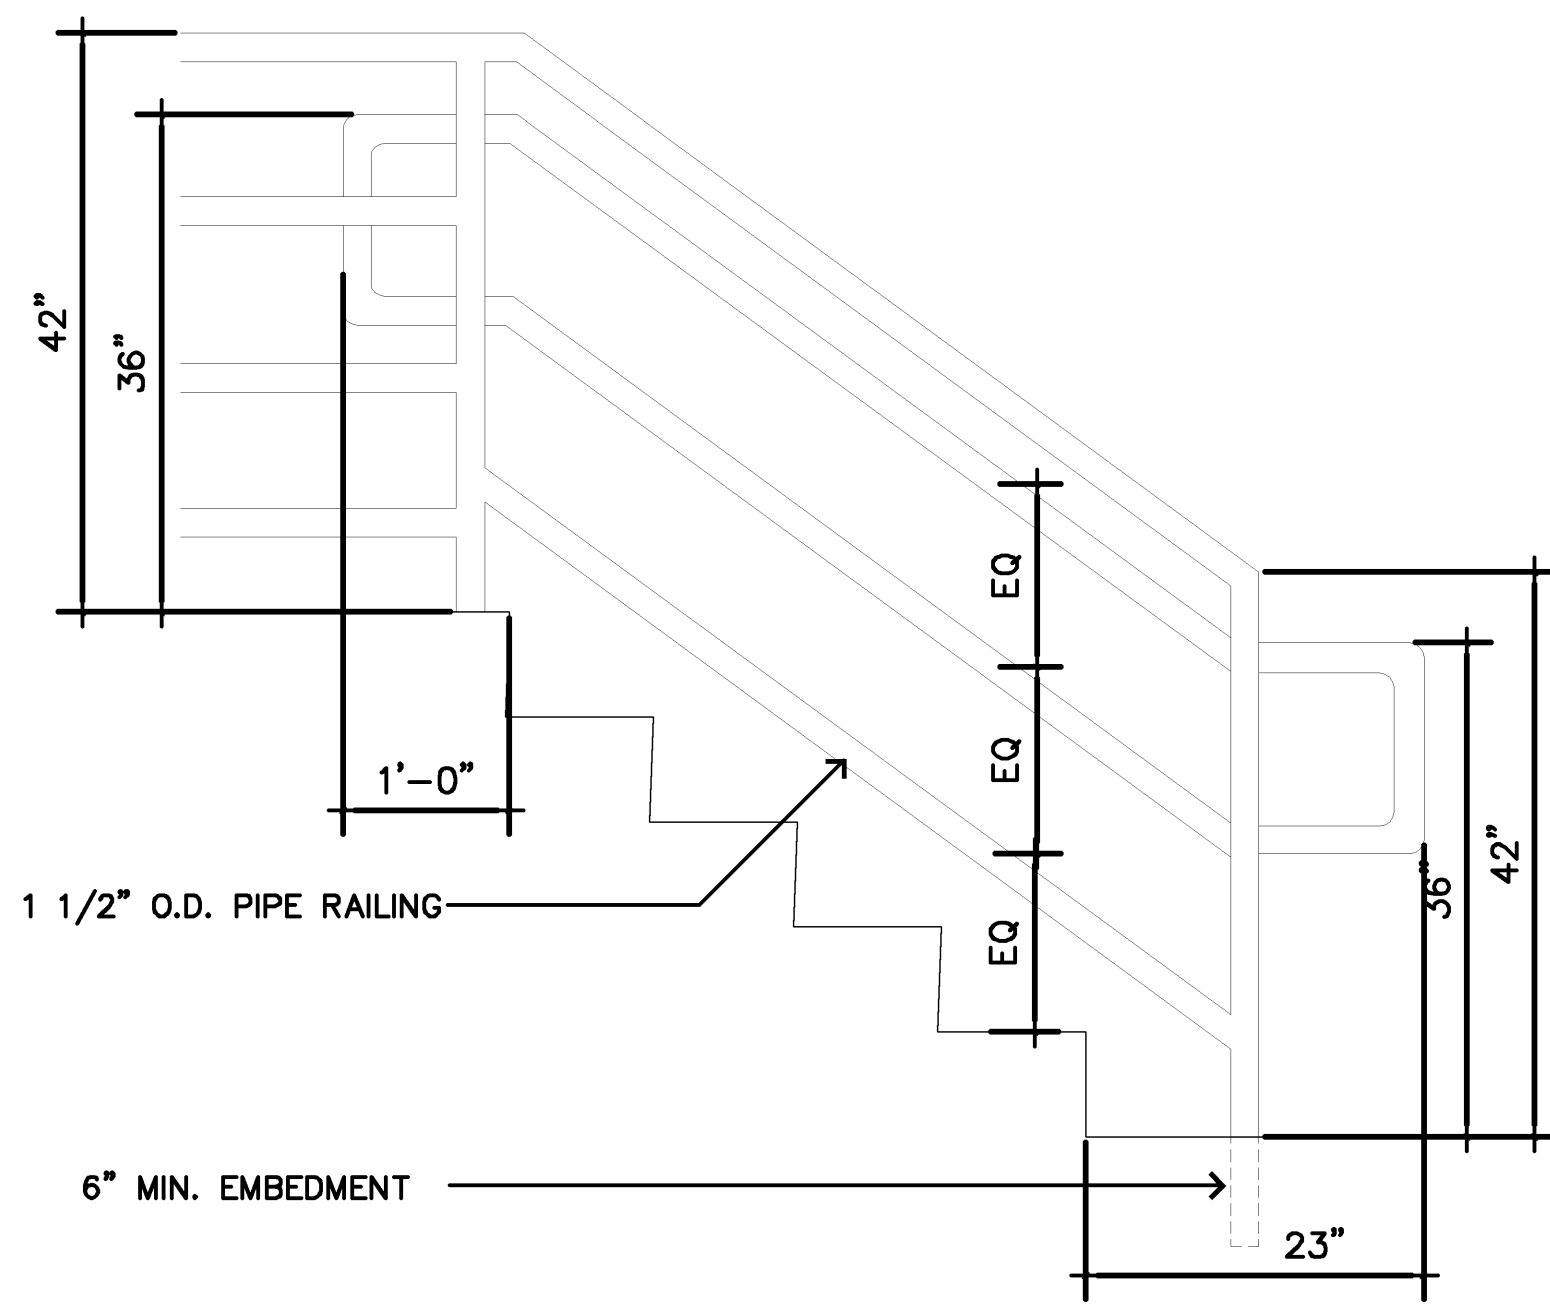


4A STAIR HANDRAIL- SIDE ELEVATION
A22 N.T.S.

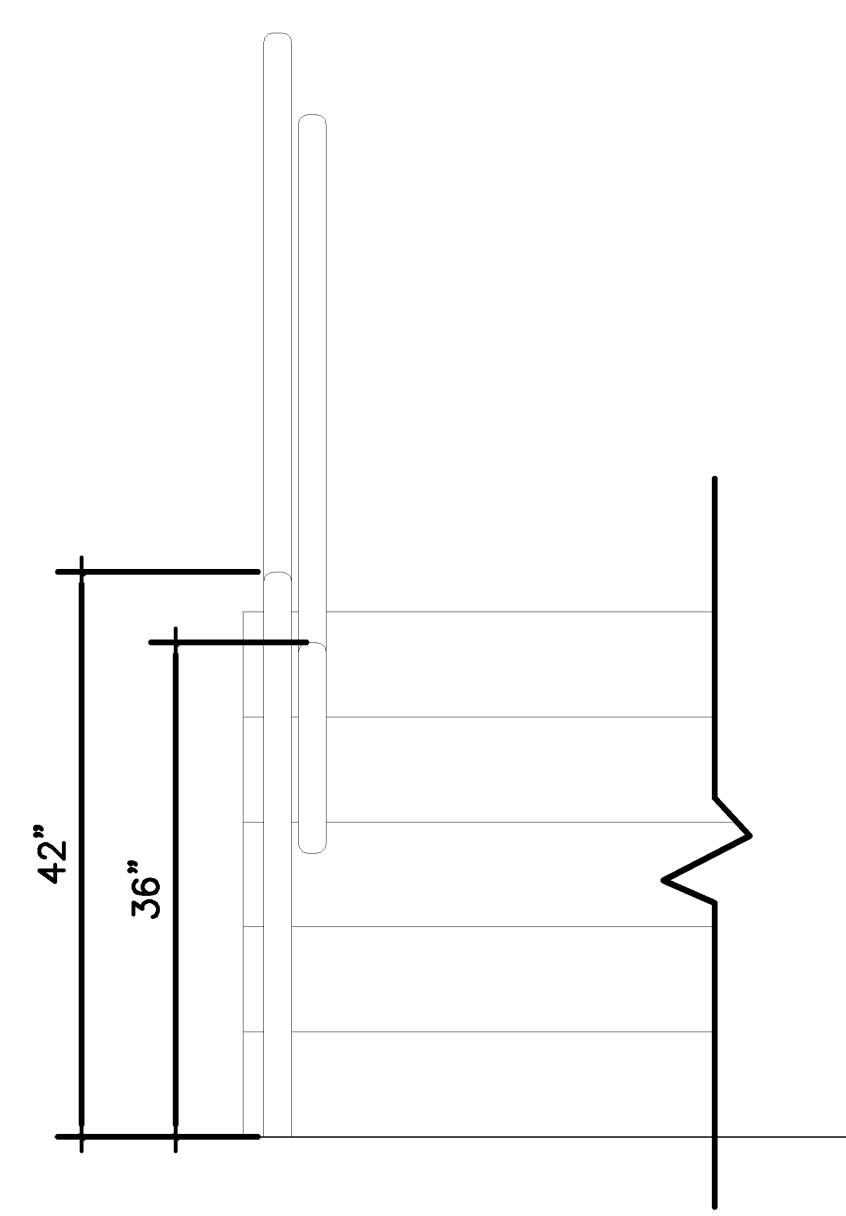


4B STAIR HANDRAIL- FRONT ELEV.
A22 N.T.S.

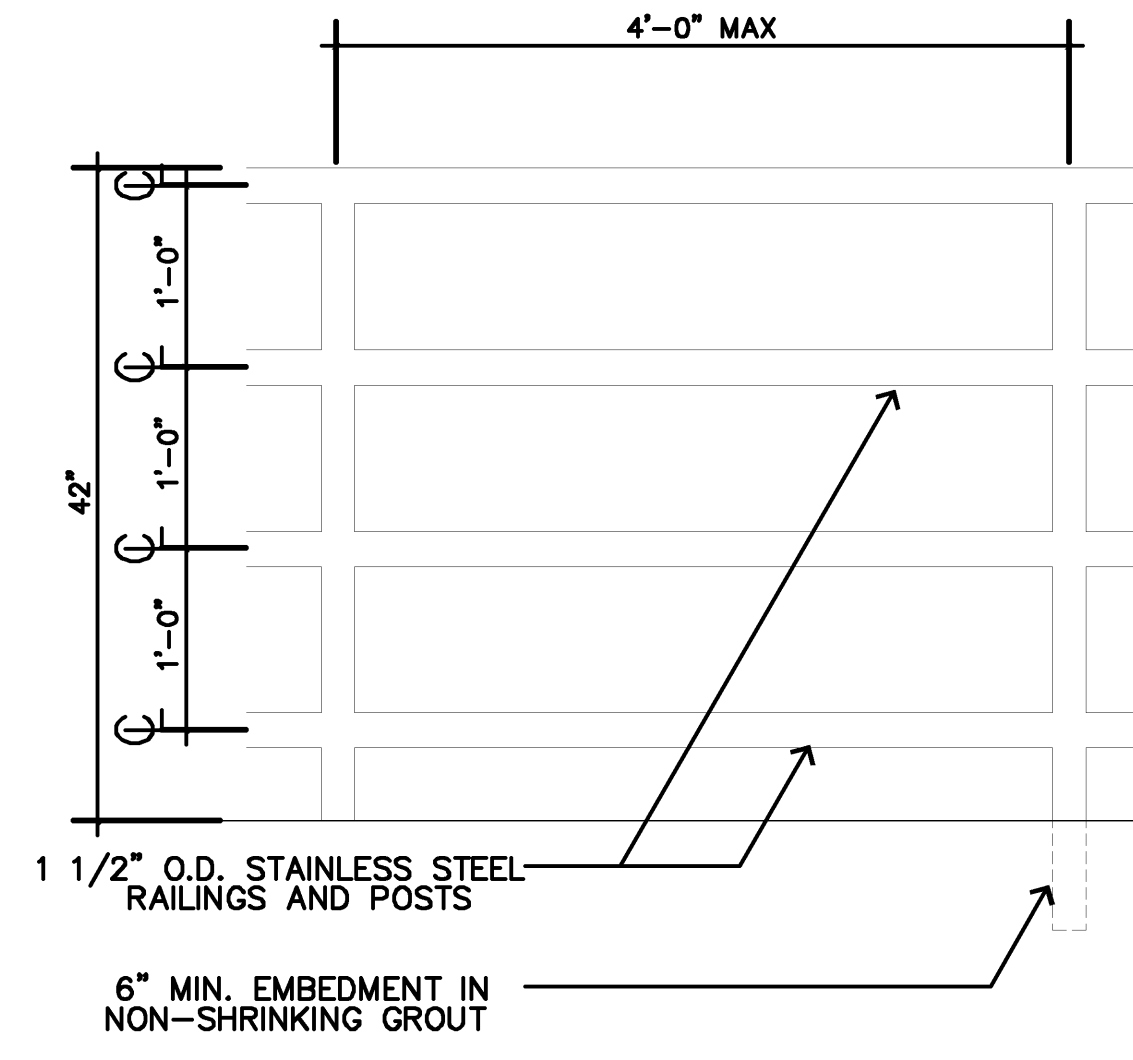


5 RAILING @ PLATFORM
A22 N.T.S.

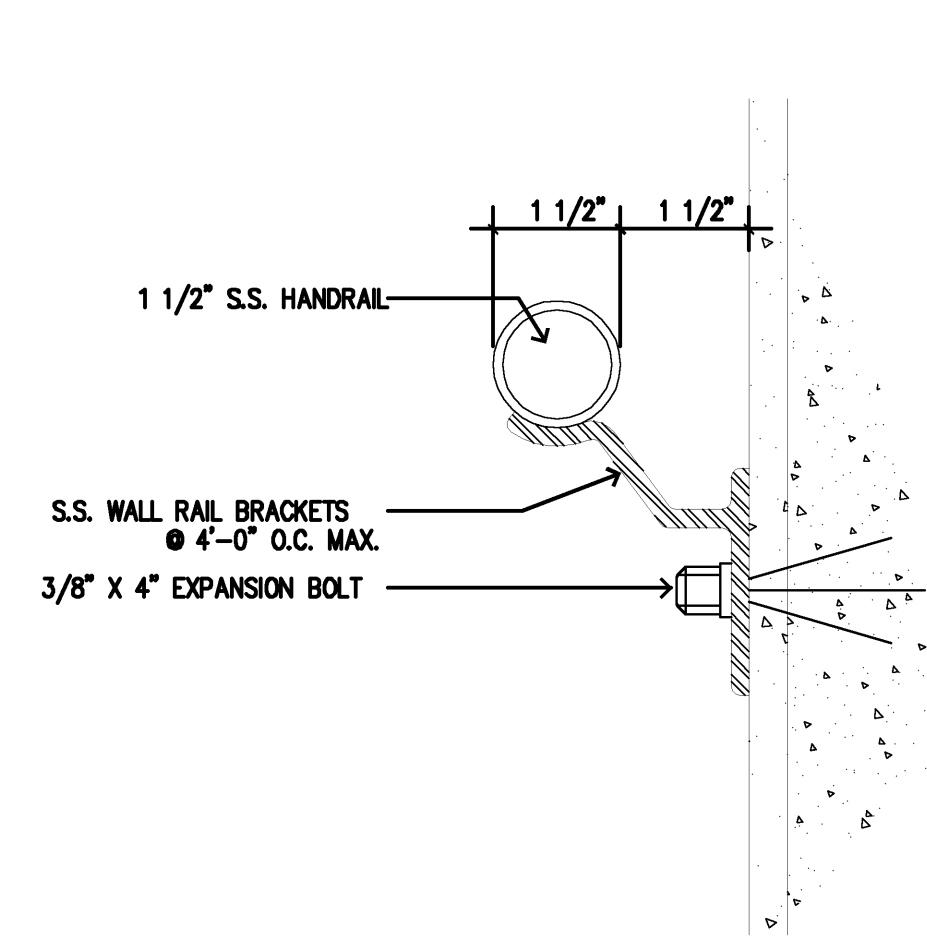


6 HANDRAIL MOUNTING ON WALL
A22 N.T.S.

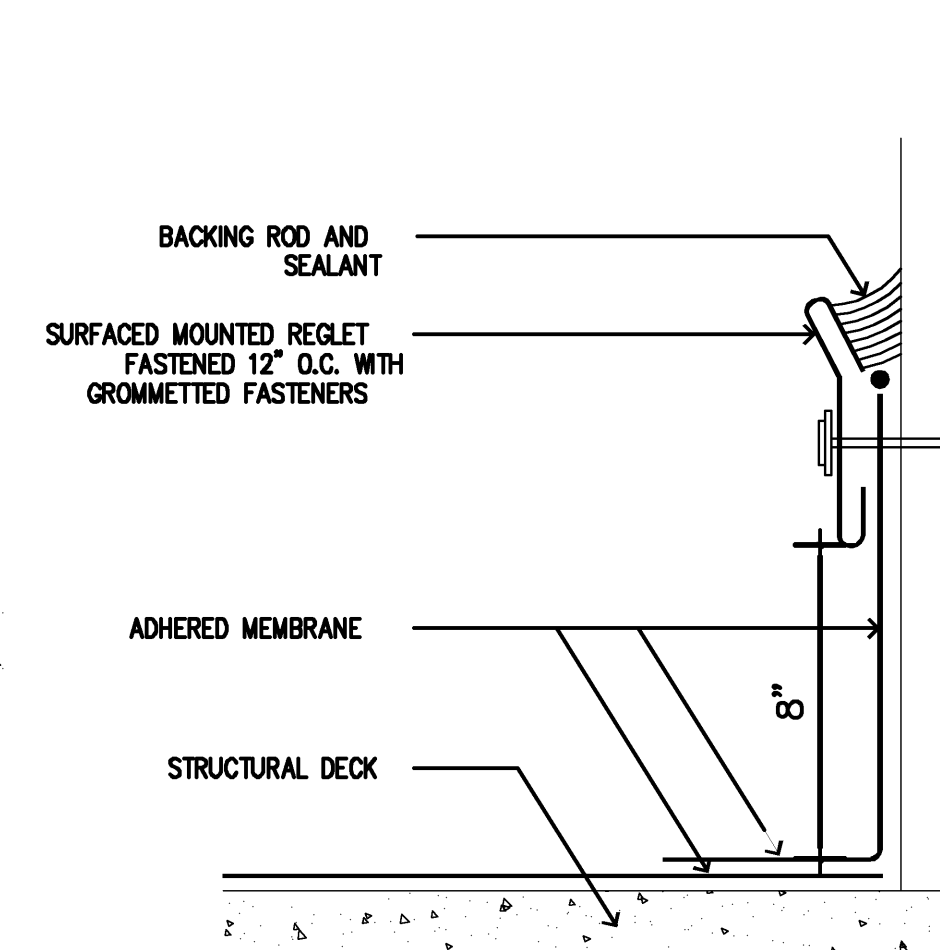


7 FLASHING EDGE
A22 N.T.S.

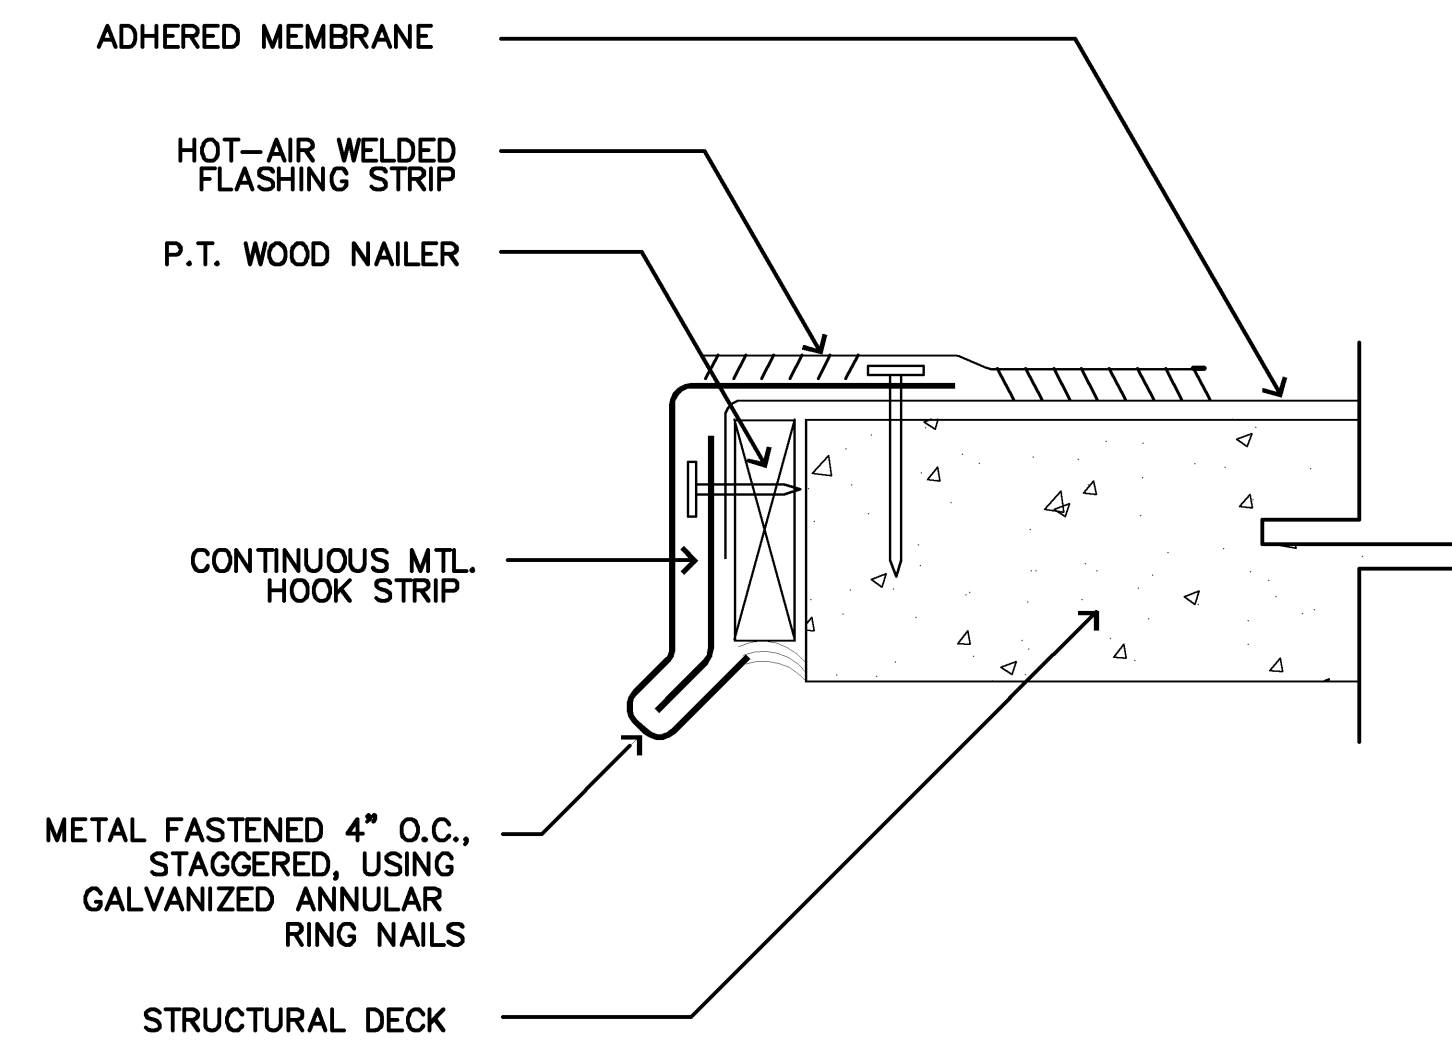


8 EDGE FLASHING
A22 N.T.S.

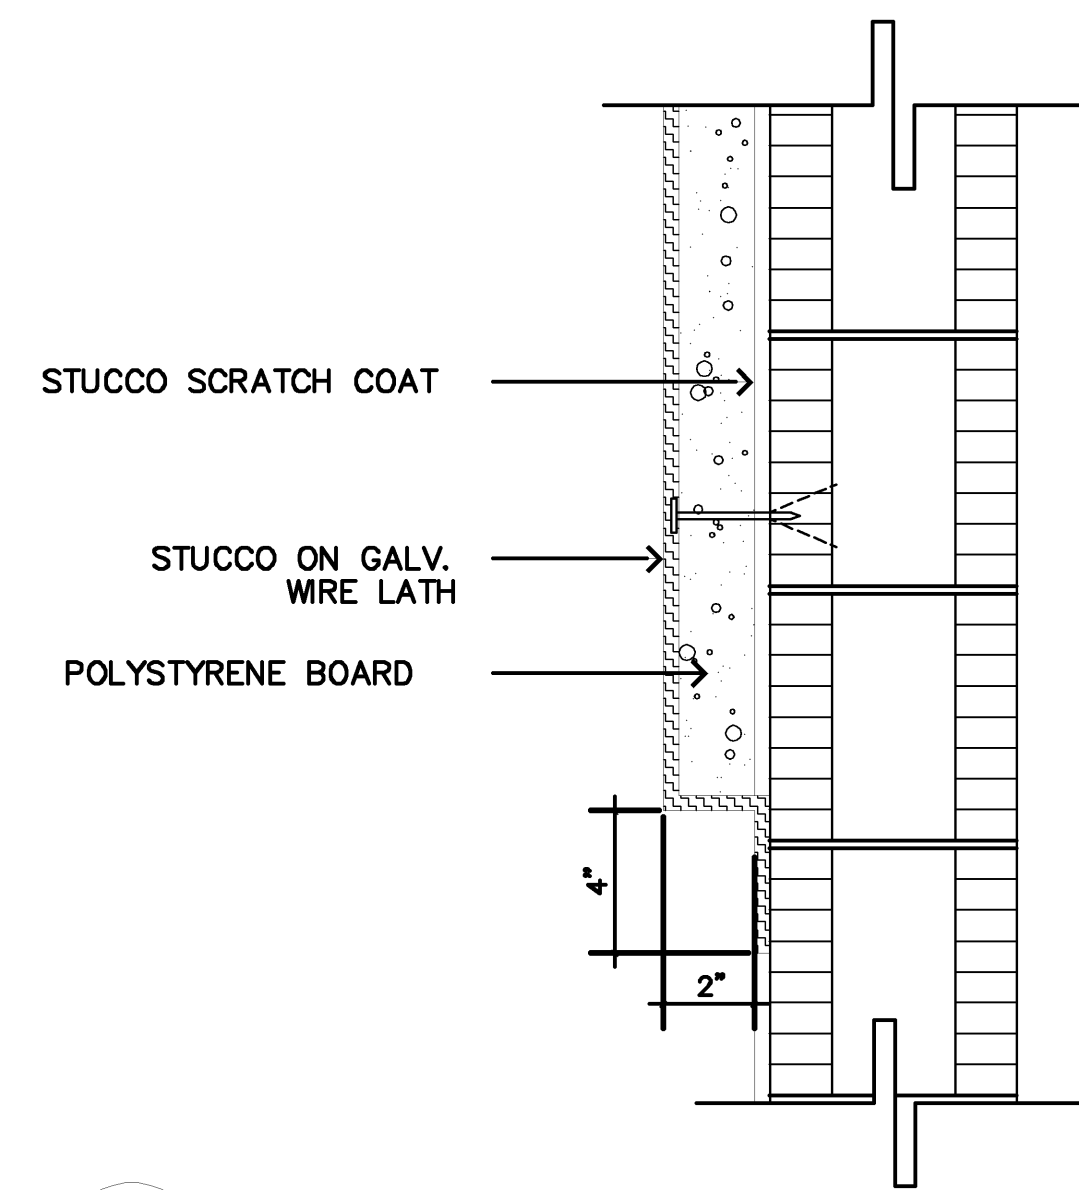

9 RAISED PANEL DETAIL
A22 N.T.S.

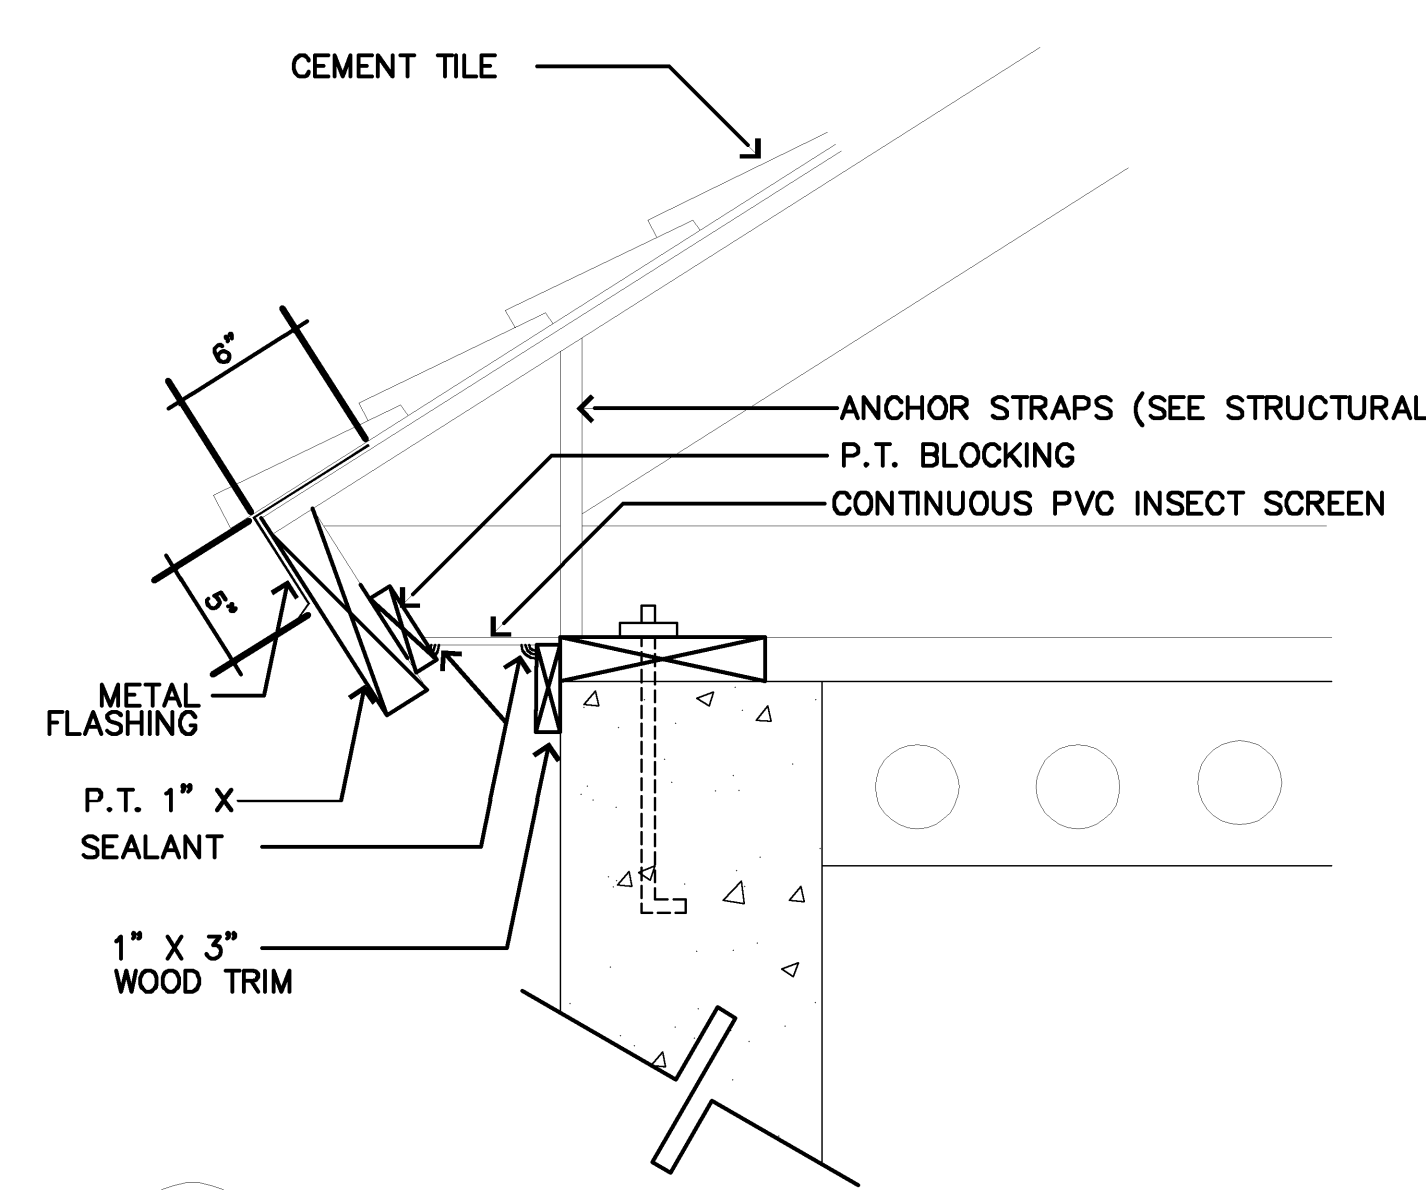


10 SOFFIT
A22 N.T.S.

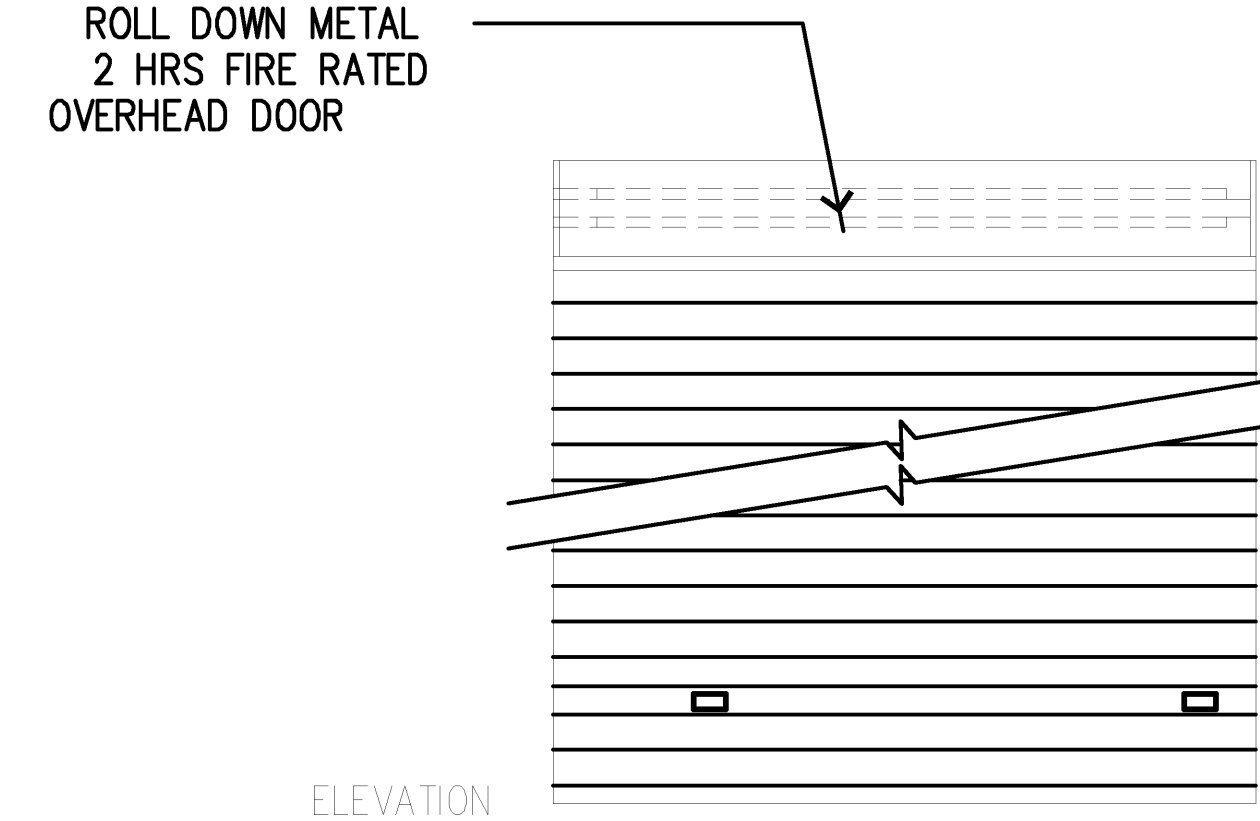


11 ROLL-UP OVERHEAD DOOR
A22 N.T.S.

DOOR SCHEDULE										
NO.	LOCATION	TYPE	MAT	WIDTH	HEIGHT	THICK	FIRE RATED	FRAME SIZE	HRDWR GRP	REMARKS
1	PS10	FF	HM	3'-0"	7'-10"	1'-3/4"		3'-4"x8'-0"x5-3/4"	1	180 DEGREE SWINGING
2	PS10	A	ALUM	10'-0"	8'-0"	1'-3/4"		6'-4"x8'-2"x5-3/4"	2	ALUM. GATE
3	PS10	FF	HM	(2)3'-0"	7'-10"	1'-3/4"		6'-4"x8'-0"x5-3/4"	3	180 DEGREE SWINGING
4	PS10	FF	HM	3'-0"	7'-6"	1'-3/4"	1 HOUR	3'-4"x7'-8"x5-3/4"	4	180 DEGREE SWINGING
5	PS10	FF	HM	3'-0"	7'-0"	1'-3/4"		3'-4"x7'-2"x5-3/4"	5	180 DEGREE SWINGING
6	PS29	FF	HM	3'-0"	7'-10"	1'-3/4"		3'-4"x8'-0"x5-3/4"	1	180 DEGREE SWINGING
7	PS29	FF	HM	(2)3'-0"	7'-10"	1'-3/4"		6'-4"x8'-0"x5-3/4"	3	180 DEGREE SWINGING
8	PS29	FF	HM	3'-0"	7'-6"	1'-3/4"	1 HOUR	3'-4"x7'-8"x5-3/4"	4	180 DEGREE SWINGING
9	PS29	FF	HM	3'-0"	7'-6"	1'-3/4"		3'-4"x7'-8"x5-3/4"	1	180 DEGREE SWINGING
10	PS29	B	AL	12'-8"	8'-0"			N.A.	2	ALUM. GATE
11	41st. ST.	FF	HM	3'-0"	7'-0"	1'-3/4"		3'-4"x7'-2"x5-3/4"	5	180 DEGREE SWINGING
12	41st. ST.	FF	HM	3'-0"	8'-0"	1'-3/4"	1 HOUR	3'-4"x8'-2"x5-3/4"	4	180 DEGREE SWINGING
13	41st. ST.	FF	HM	3'-0"	8'-0"	1'-3/4"		3'-4"x8'-2"x5-3/4"	1	180 DEGREE SWINGING
14	41st. ST.	FF	HM	(2)3'-0"	7'-0"	1'-3/4"		6'-4"x7'-2"x5-3/4"	3	180 DEGREE SWINGING
15	PS28	FF	HM	3'-0"	7'-10"	1'-3/4"		3'-4"x8'-0"x5-3/4"	1	180 DEGREE SWINGING
16	PS28	FF	HM	(2)3'-0"	8'-0"	1'-3/4"		6'-4"x8'-2"x5-3/4"	3	180 DEGREE SWINGING
17	PS28	FF	HM	3'-0"	7'-8"	1'-3/4"	1 HOUR	3'-4"x7'-10"x5-3/4"	4	180 DEGREE SWINGING
18	PS28	FF	HM	3'-0"	8'-0"	1'-3/4"		3'-4"x8'-2"x5-3/4"	1	180 DEGREE SWINGING
19	PS28	A	AL	14'-0"	8'-0"			N.A.	2	ALUM. GATE
20	75th. ST.	FF	HM	3'-0"	8'-0"	1'-3/4"		3'-4"x8'-2"x5-3/4"	1	180 DEGREE SWINGING
21	75th. ST.	FF	HM	3'-0"	7'-8"	1'-3/4"	1 HOUR	3'-4"x7'-10"x5-3/4"	4	180 DEGREE SWINGING
22	75th. ST.	FF	HM	3'-0"	6'-10"	1'-3/4"		3'-4"x7'-0"x5-3/4"	5	180 DEGREE SWINGING
23	75th. ST.	FF	HM	(2)3'-0"	7'-0"	1'-3/4"		6'-4"x7'-2"x5-3/4"	3	180 DEGREE SWINGING
24	NI	FF	HM	(2)3'-0"	7'-10"	1'-3/4"		6'-4"x8'-0"x5-3/4"	3	180 DEGREE SWINGING
25	NI	FF	HM	3'-0"	7'-10"	1'-3/4"		6'-4"x8'-0"x5-3/4"	1	180 DEGREE SWINGING
26	NI	FF	HM	3'-0"	7'-6"	1'-3/4"		3'-4"x7'-8"x5-3/4"	1	180 DEGREE SWINGING
26A	NI	FF	HM	3'-0"	7'-6"	1'-3/4"	1 HOUR	3'-4"x7'-8"x5-3/4"	4	180 DEGREE SWINGING
27	MBCC	FF	HM	(2)3'-0"	8'-0"	1'-3/4"	1 HOUR	6'-4"x8'-2"x5-3/4"	DOOR CLOSER	180 DEGREE SWINGING
28	MBCC	FF	HM	(2)3'-0"	8'-0"	1'-3/4"	1 HOUR	6'-4"x8'-2"x5-3/4"	DOOR CLOSER	180 DEGREE SWINGING
29	MBCC	FF	HM	3'-0"	8'-0"	1'-3/4"	1 HOUR	3'-4"x8'-2"x5-3/4"	4	180 DEGREE SWINGING
29A	MBCC	FF	HM	3'-0"	8'-0"	1'-3/4"		3'-4"x8'-2"x5-3/4"	1	180 DEGREE SWINGING

NOTE: PROVIDE 180° SWING WHERE POSSIBLE

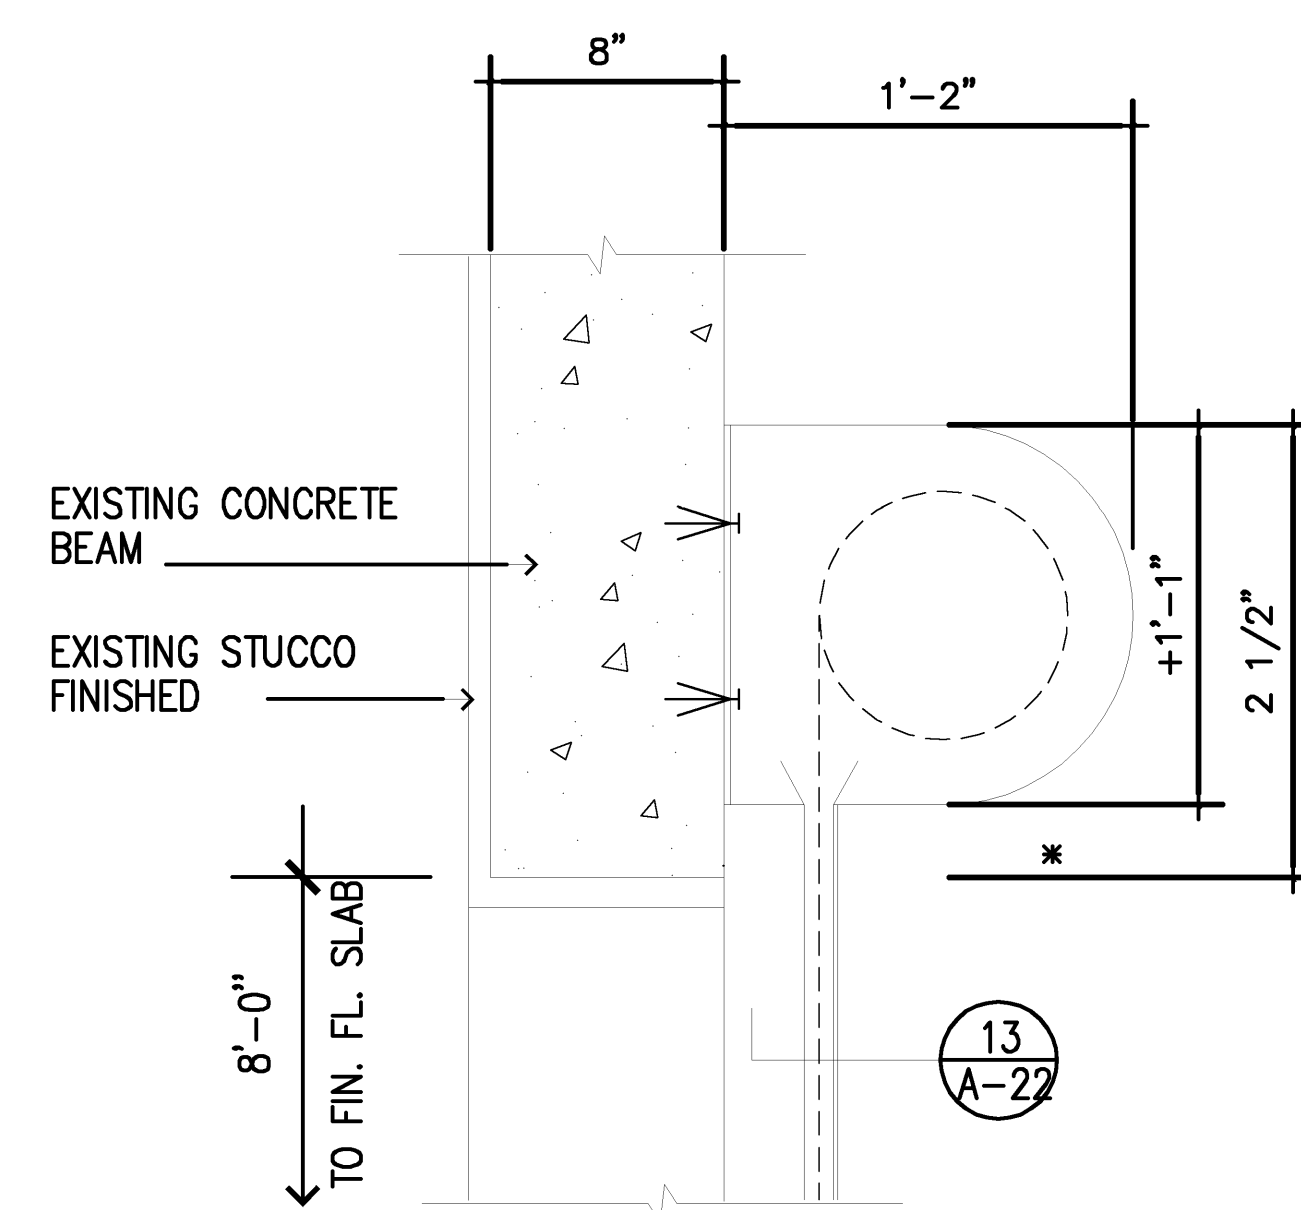

12 ROLL-UP OVERHEAD DOOR
A22 N.T.S.

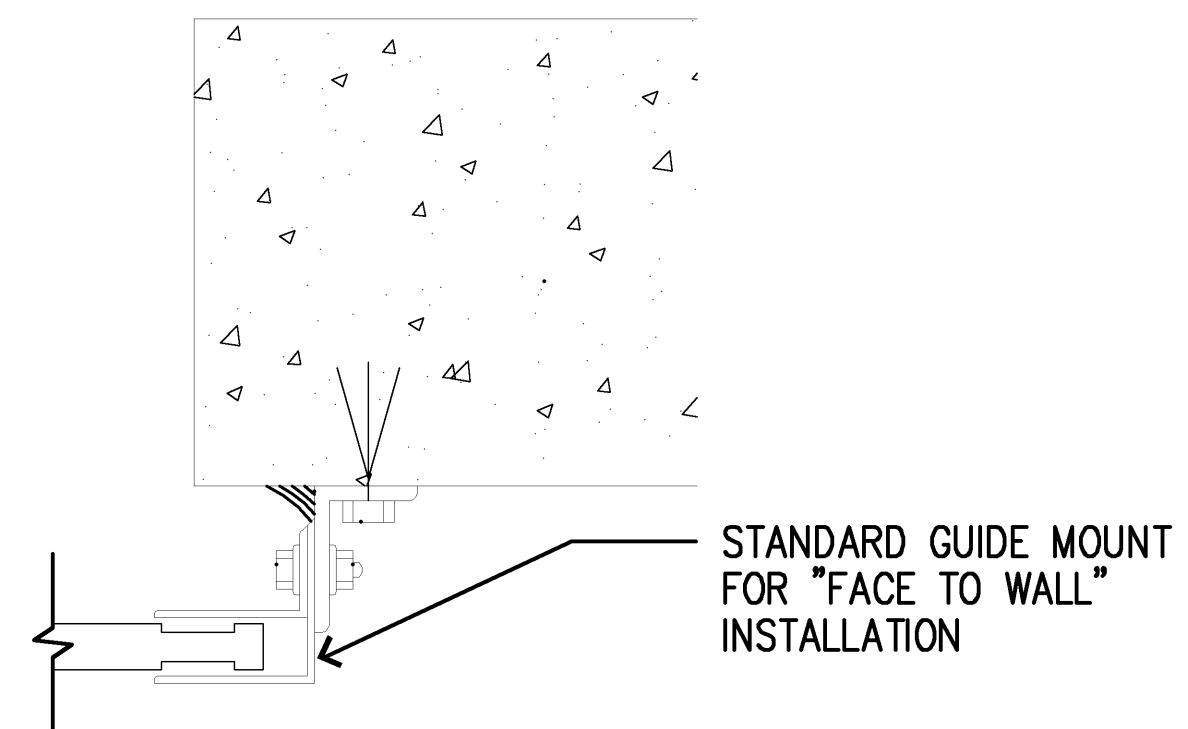

13 ROLL-UP DOOR GUIDE DETAIL
A22 N.T.S.

* AUTO CLOSERS: PROVIDE CLOSER, ACCEPTABLE MANUFACTURER
SARGENT 1230 SERIES, LCN 1460 SERIES X FULL COVER, NORTON 8501 SERIES
OR APPROVED MANUFACTURER

RECORD DRAWING
THIS RECORD DRAWING HAS BEEN PREPARED BASED ON A COMBINATION OF INFORMATION PROVIDED BY OTHERS AND BY CDM. THEREFORE, THE ENGINEER HAS NOT VERIFIED THE ACCURACY OF ALL THE INFORMATION. TO THE BEST OF THE ENGINEER'S BELIEF AND KNOWLEDGE, THE INCLUDED RECORD INFORMATION IS REASONABLY ACCURATE.
By _____ Date December 2007
CDM

DONNELL, DUQUESNE & ALBAISA, P.A.
CONSULTING ENGINEERS
RAMON R. DONNELL P.E. 0011890
PEDRO J. DUQUESNE P.E. 0022764
AIDA M. ALBAISA P.E. 0045130
4800 S.W. 74th CT. MIAMI, FLORIDA 33156
(305) 862-0111

CDM
CAMP DRESSER & MCKEE INC.
800 Brickell Avenue, Suite 710
Miami, Florida 33131
305 372-7171, Fax: 305 372-9167

City of Miami Beach


zysovcovich
100 N. BISCAYNE BLVD., SUITE 1400 MIAMI FL 33132
T 305 372 9222 F 305 577 4521
CBS 73327, 2299

ELECTRIC / GENERATOR
City of Miami Beach


COPYRIGHT © 1995 ZYSCOVICH, INC. ALL RIGHTS RESERVED.
THESE DRAWINGS AND SPECIFICATIONS ARE INSTRUMENTS OF SERVICE AND SHALL REMAIN THE PROPERTY OF ZYSCOVICH, INC. WHETHER THE PROJECT FOR WHICH THEY WERE PREPARED IS EXECUTED OR NOT. THEY ARE NOT TO BE USED IN ANY MANNER ON OTHER PROJECTS OR EXTENSIONS TO THIS PROJECT EXCEPT BY AGREEMENT IN WRITING AND WITH THE APPROPRIATE COMPENSATION TO ZYSCOVICH, INC. REPRODUCTION OF SPECIFICATIONS WITHOUT THE WRITTEN CONSENT OF ZYSCOVICH, INC. IS PROHIBITED.

Seal: _____
CONFORMED FEB 99
REG. NO. C001431
DETAILS
RECORD DRAWINGS
Revised: _____
Revised: _____
Revised: _____
Revised: REPROCUREMENT JAN. 2003
Revised: RECORD DRAWING 12/07

ZYS 9507PUMP
A 22












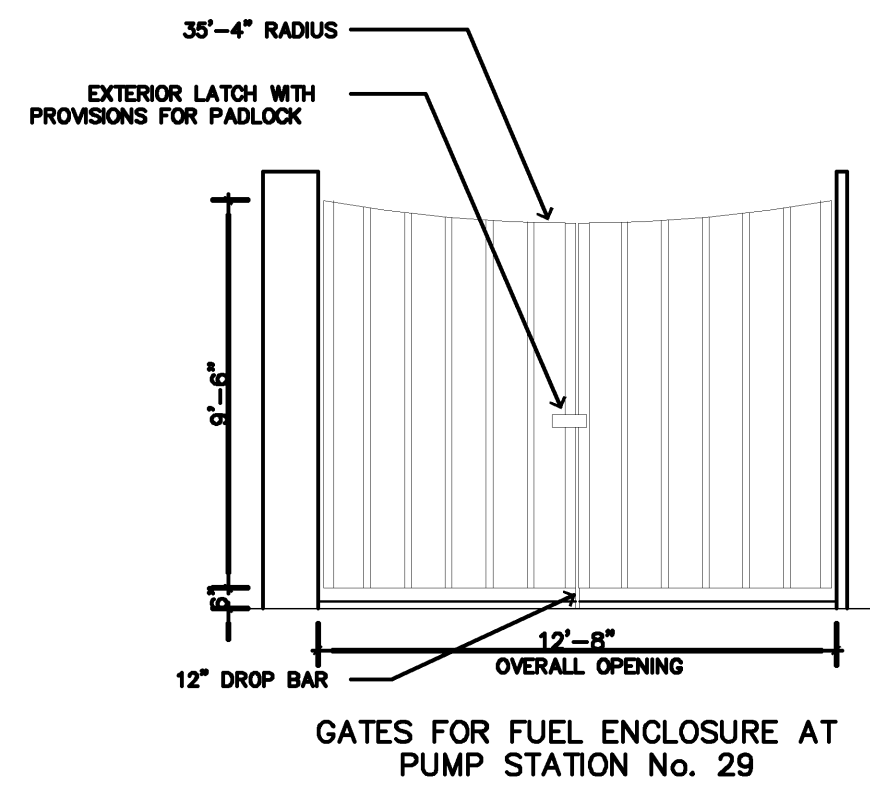


GATE TYPES

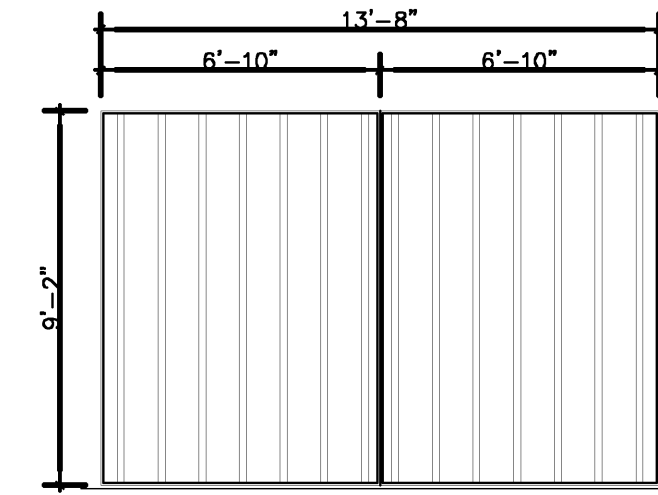


NOTE:
SWING 180° SEE PLANS

LOUVER TYPES

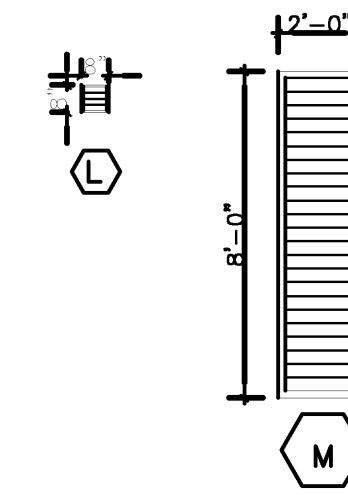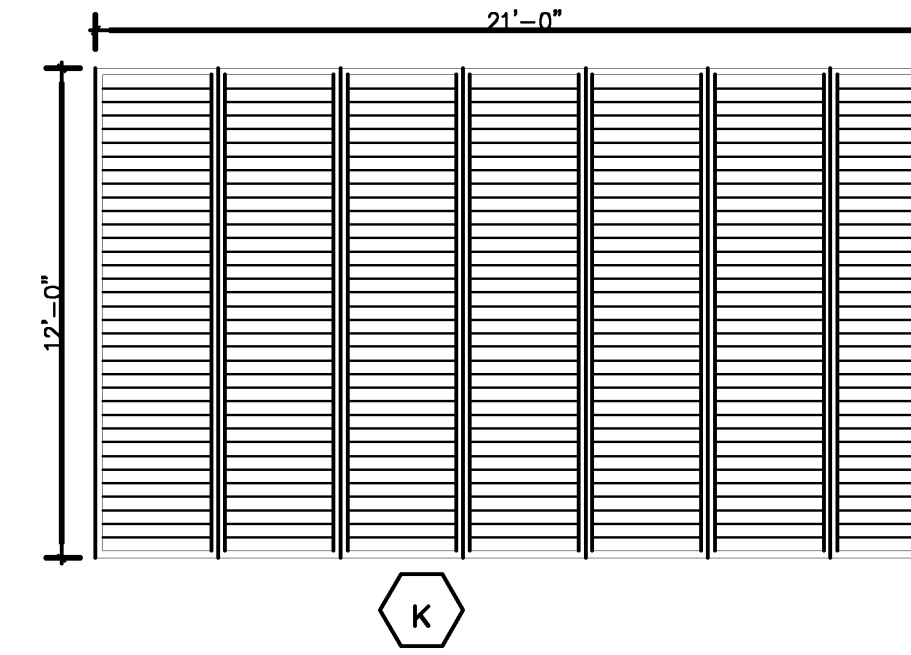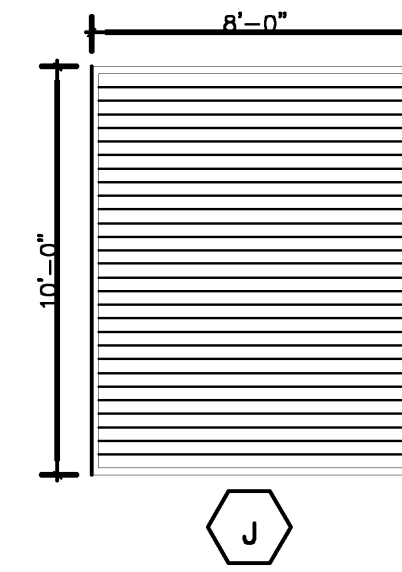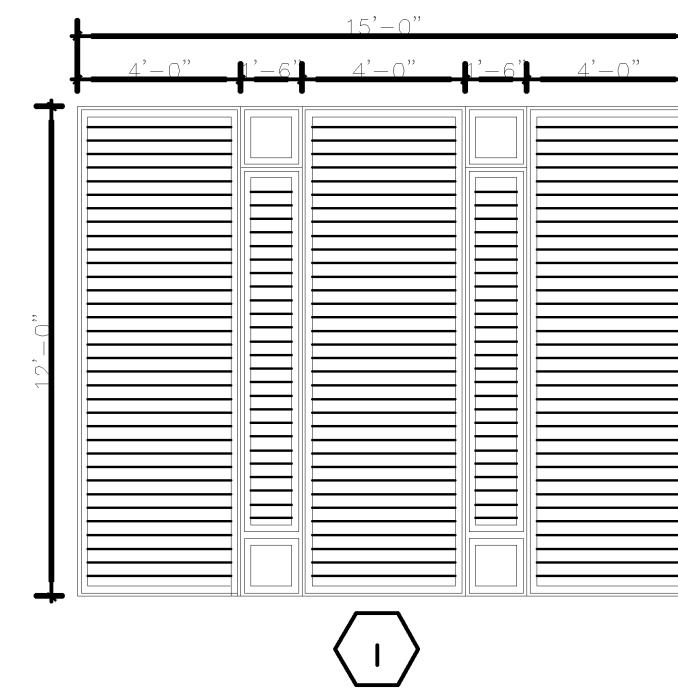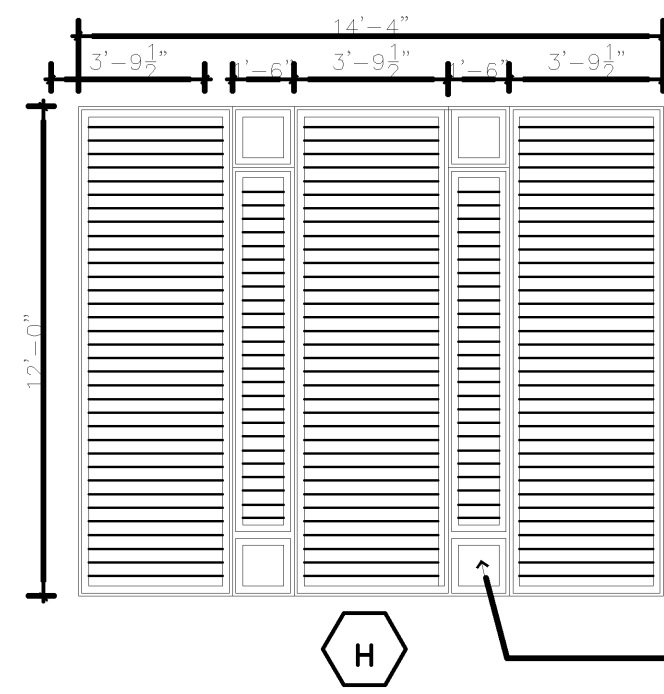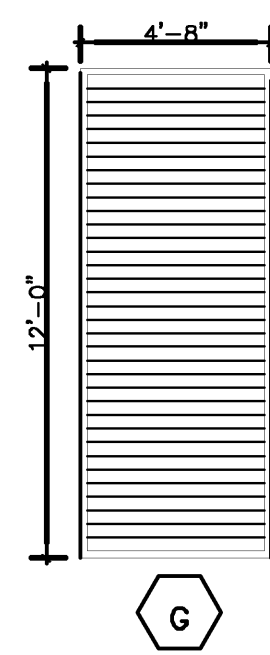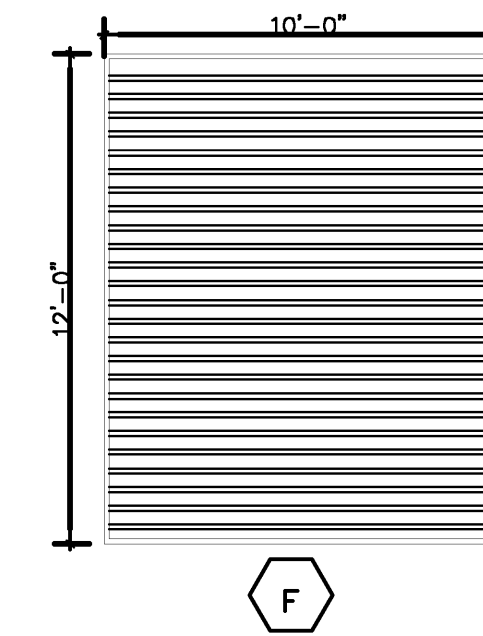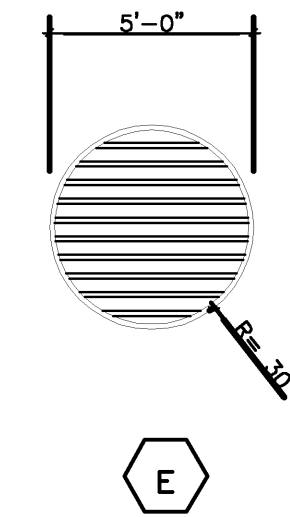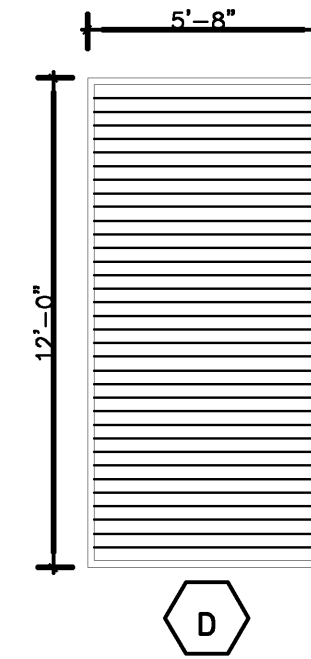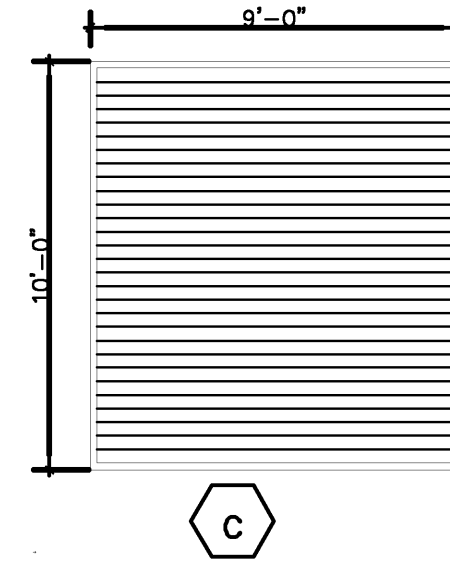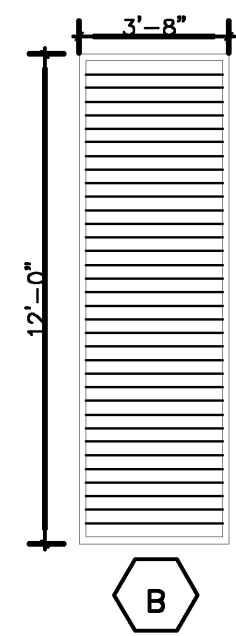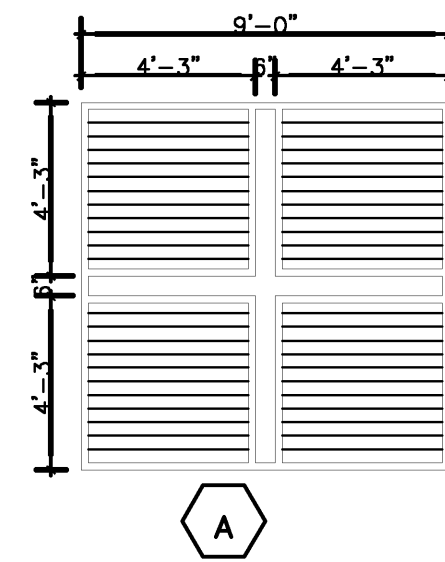


NOTE: COORDINATE ALL LOUVERS AT GENERATOR ROOMS WITH GENERATOR REQUIREMENTS


NOTE: LOUVERS WITH SUFFIX "1" ARE STATIONARY AND NOT REMOVABLE, BUT HAVE SAME PROFILE & ELEVATION AS REMOVABLE LOUVERS WHICH ARE NOTED WITHOUT THE "1". SEE PLANS FOR LOCATIONS.

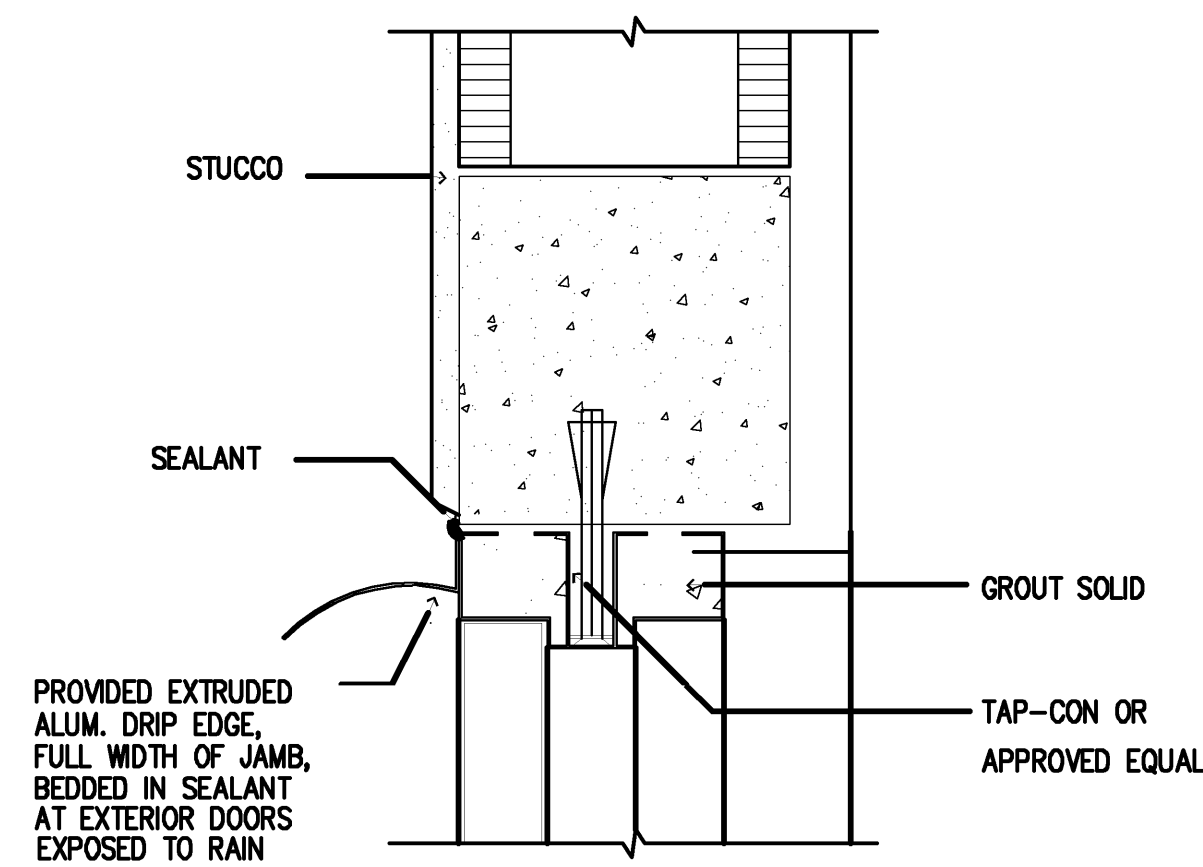


1 TYPICAL DOOR HEAD DETAIL FOR EXTERIOR DOORS
A23 N.T.S.

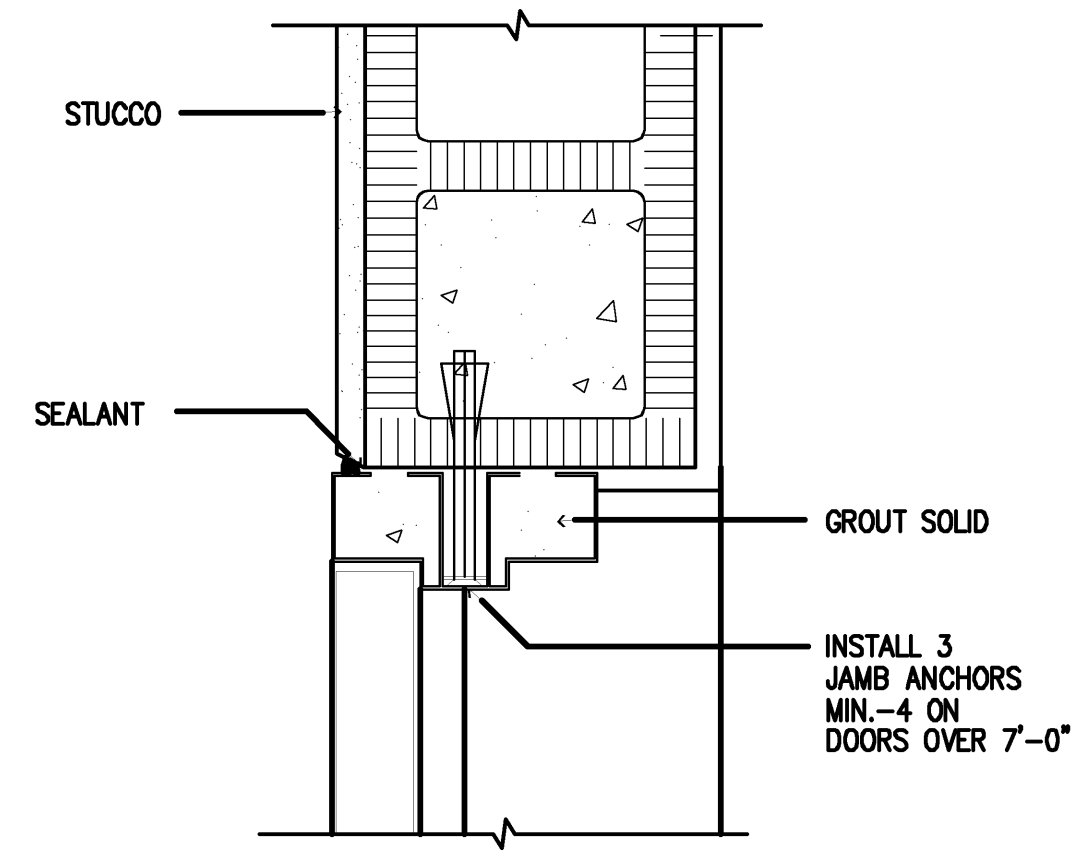

2 TYPICAL DOOR JAMB DETAIL FOR EXTERIOR DOORS
A23 N.T.S.

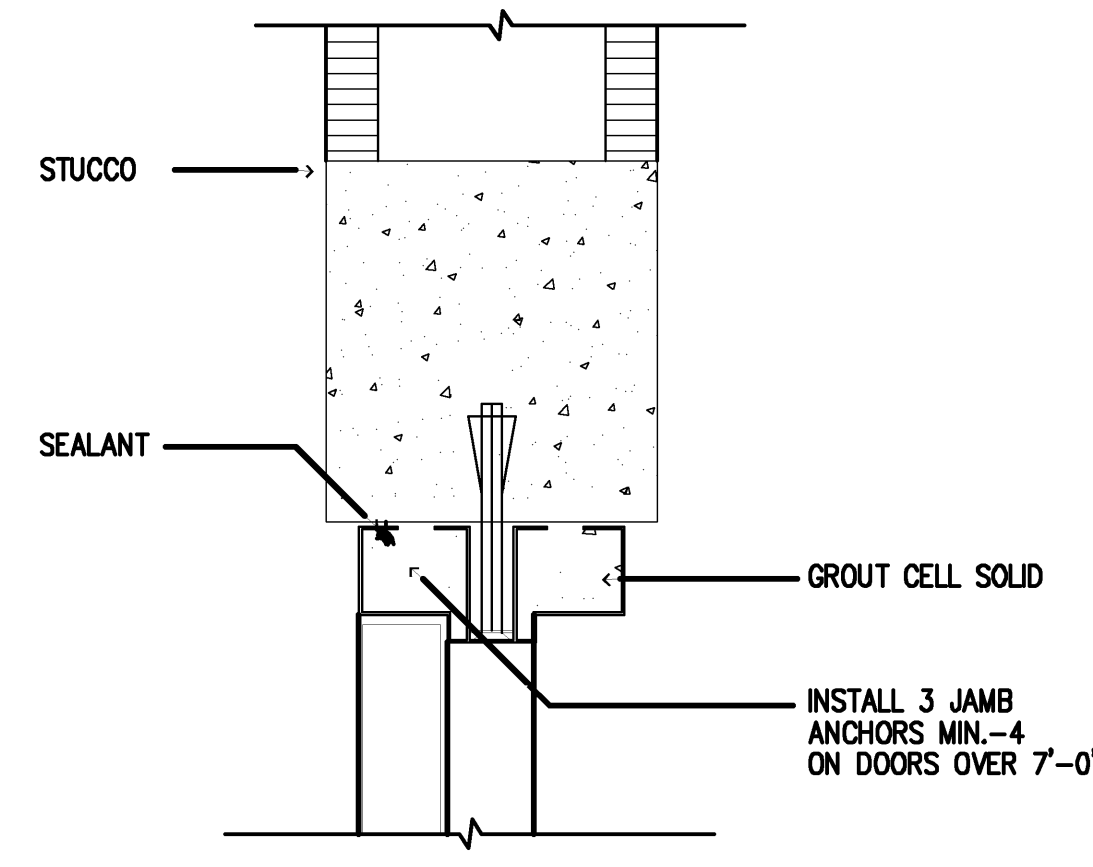

3 TYPICAL DOOR HEAD DETAIL FOR INTERIOR DOORS
A23 N.T.S.

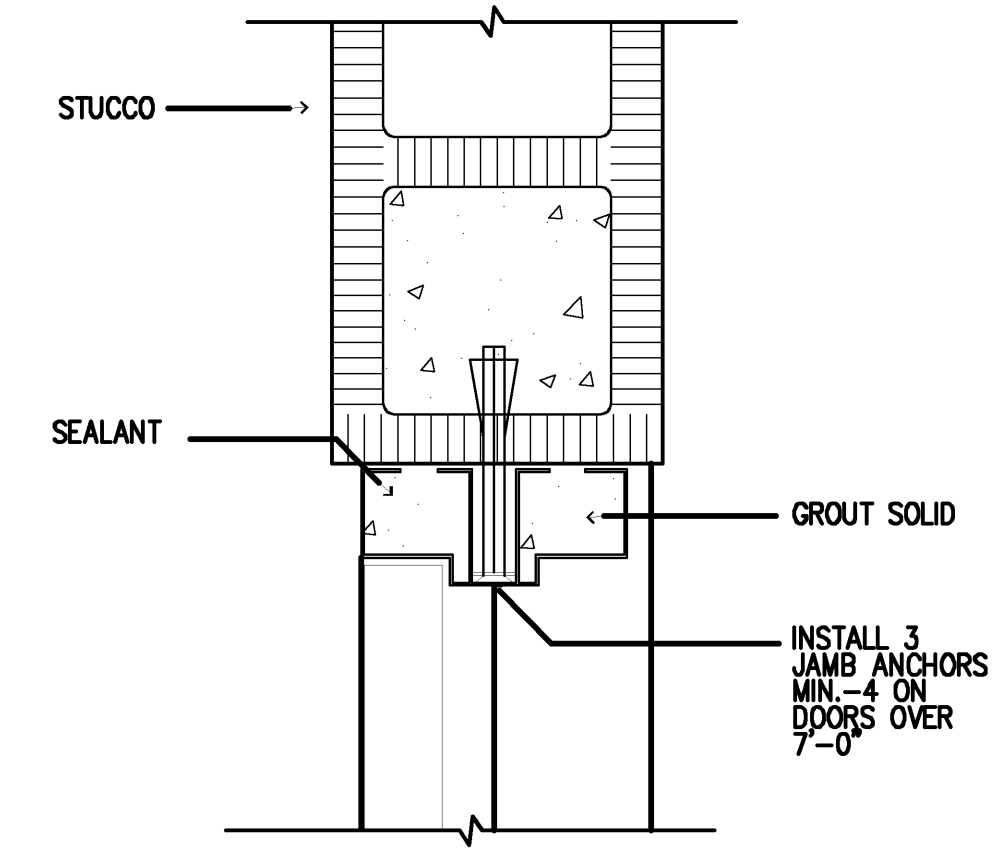


4 TYPICAL DOOR JAMB DETAIL FOR INTERIOR DOORS
A23 N.T.S.

RECORD DRAWING

THIS RECORD DRAWING HAVE BEEN PREPARED BASED ON A COMBINATION OF INFORMATION PROVIDED BY OTHERS AND BY CDM. THEREFORE, THE ENGINEER HAS NOT VERIFIED THE ACCURACY OF ALL THE INFORMATION. TO THE BEST OF THE ENGINEER'S BELIEF AND KNOWLEDGE, THE INCLUDED RECORD INFORMATION IS REASONABLY ACCURATE.

By _____ Date December 2007

CDM

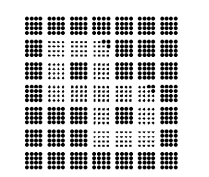
DONNELL, DUQUESNE & ALBAISA, P.A.
 CONSULTING ENGINEERS
 RAMON R. DONNELL P.E. 001890
 P.E. 002764
 PEDRO J. DUQUESNE P.E. 002764
 CIVIL/STRUCTURAL
 AIDA M. ALBAISA P.E. 0045190
 CIVIL/STRUCTURAL
 4800 S.W. 74th CT. MIAMI, FLORIDA 33155
 (305) 666-0111 FAX: 666-0508

CDM

CAMP DRESSER & McKEE INC.
 800 Brickell Avenue, Suite 710
 Miami, Florida 33131
 305 372-7171, Fax: 305 372-9167

City of Miami Beach


zyscovich
 100 N. BISCAYNE BLVD., SUITE 1400 MIAMI FL 33132
 T 305 372 5222 F 305 577 4521
 CB 73527, 2250

ELECTRIC / GENERATOR

City of Miami Beach

COPYRIGHT © 1995 ZYSCOVICH, INC. ALL RIGHTS RESERVED.
 THESE DRAWINGS AND SPECIFICATIONS ARE INSTRUMENTS OF SERVICE AND SHALL REMAIN THE PROPERTY OF ZYSCOVICH, INC. WHETHER THE PROJECT FOR WHICH THEY WERE PREPARED IS EXECUTED OR NOT. THEY ARE NOT TO BE USED IN ANY MANNER ON OTHER PROJECTS OR EXTENSIONS TO THIS PROJECT EXCEPT BY AGREEMENT IN WRITING AND WITH THE APPROPRIATE COMPENSATION TO ZYSCOVICH, INC. REPRODUCTIONS OF SPECIFICATIONS WITHOUT THE WRITTEN CONSENT OF ZYSCOVICH, INC. IS PROHIBITED.

Seal:

CONFORMED FEB 99

REG. NO. C001431

Door & Louver Types

RECORD DRAWINGS

Revised:

Revised:

Revised: REPROCUREMENT JAN. 2003

Revised: RECORD DRAWING 12/07

Revised:


05/22/98

9507 PUMP

A 23

DWS: L:\A\B1-028\RECORD\ARCH\A23-03.dwg USER: nurasad
 DATE: Jan 11, 2008 11:09am PLOT: P:\Pump\A23-03.dwg
 REC_DWG_A RECORD_ALT C IMAGES: Zyscovich-1C.Bg
 REC_DWG_A RECORD_ALT C

DWG: L:\381-029\RECORDS\STRU\28-5-1.DWG
 DATE: Jan 14, 2008 11:22am
 USER: numerical
 REC: DWG-LA
 IMAGES: TS-28-5-1.TIF
 RECORD: AIT C

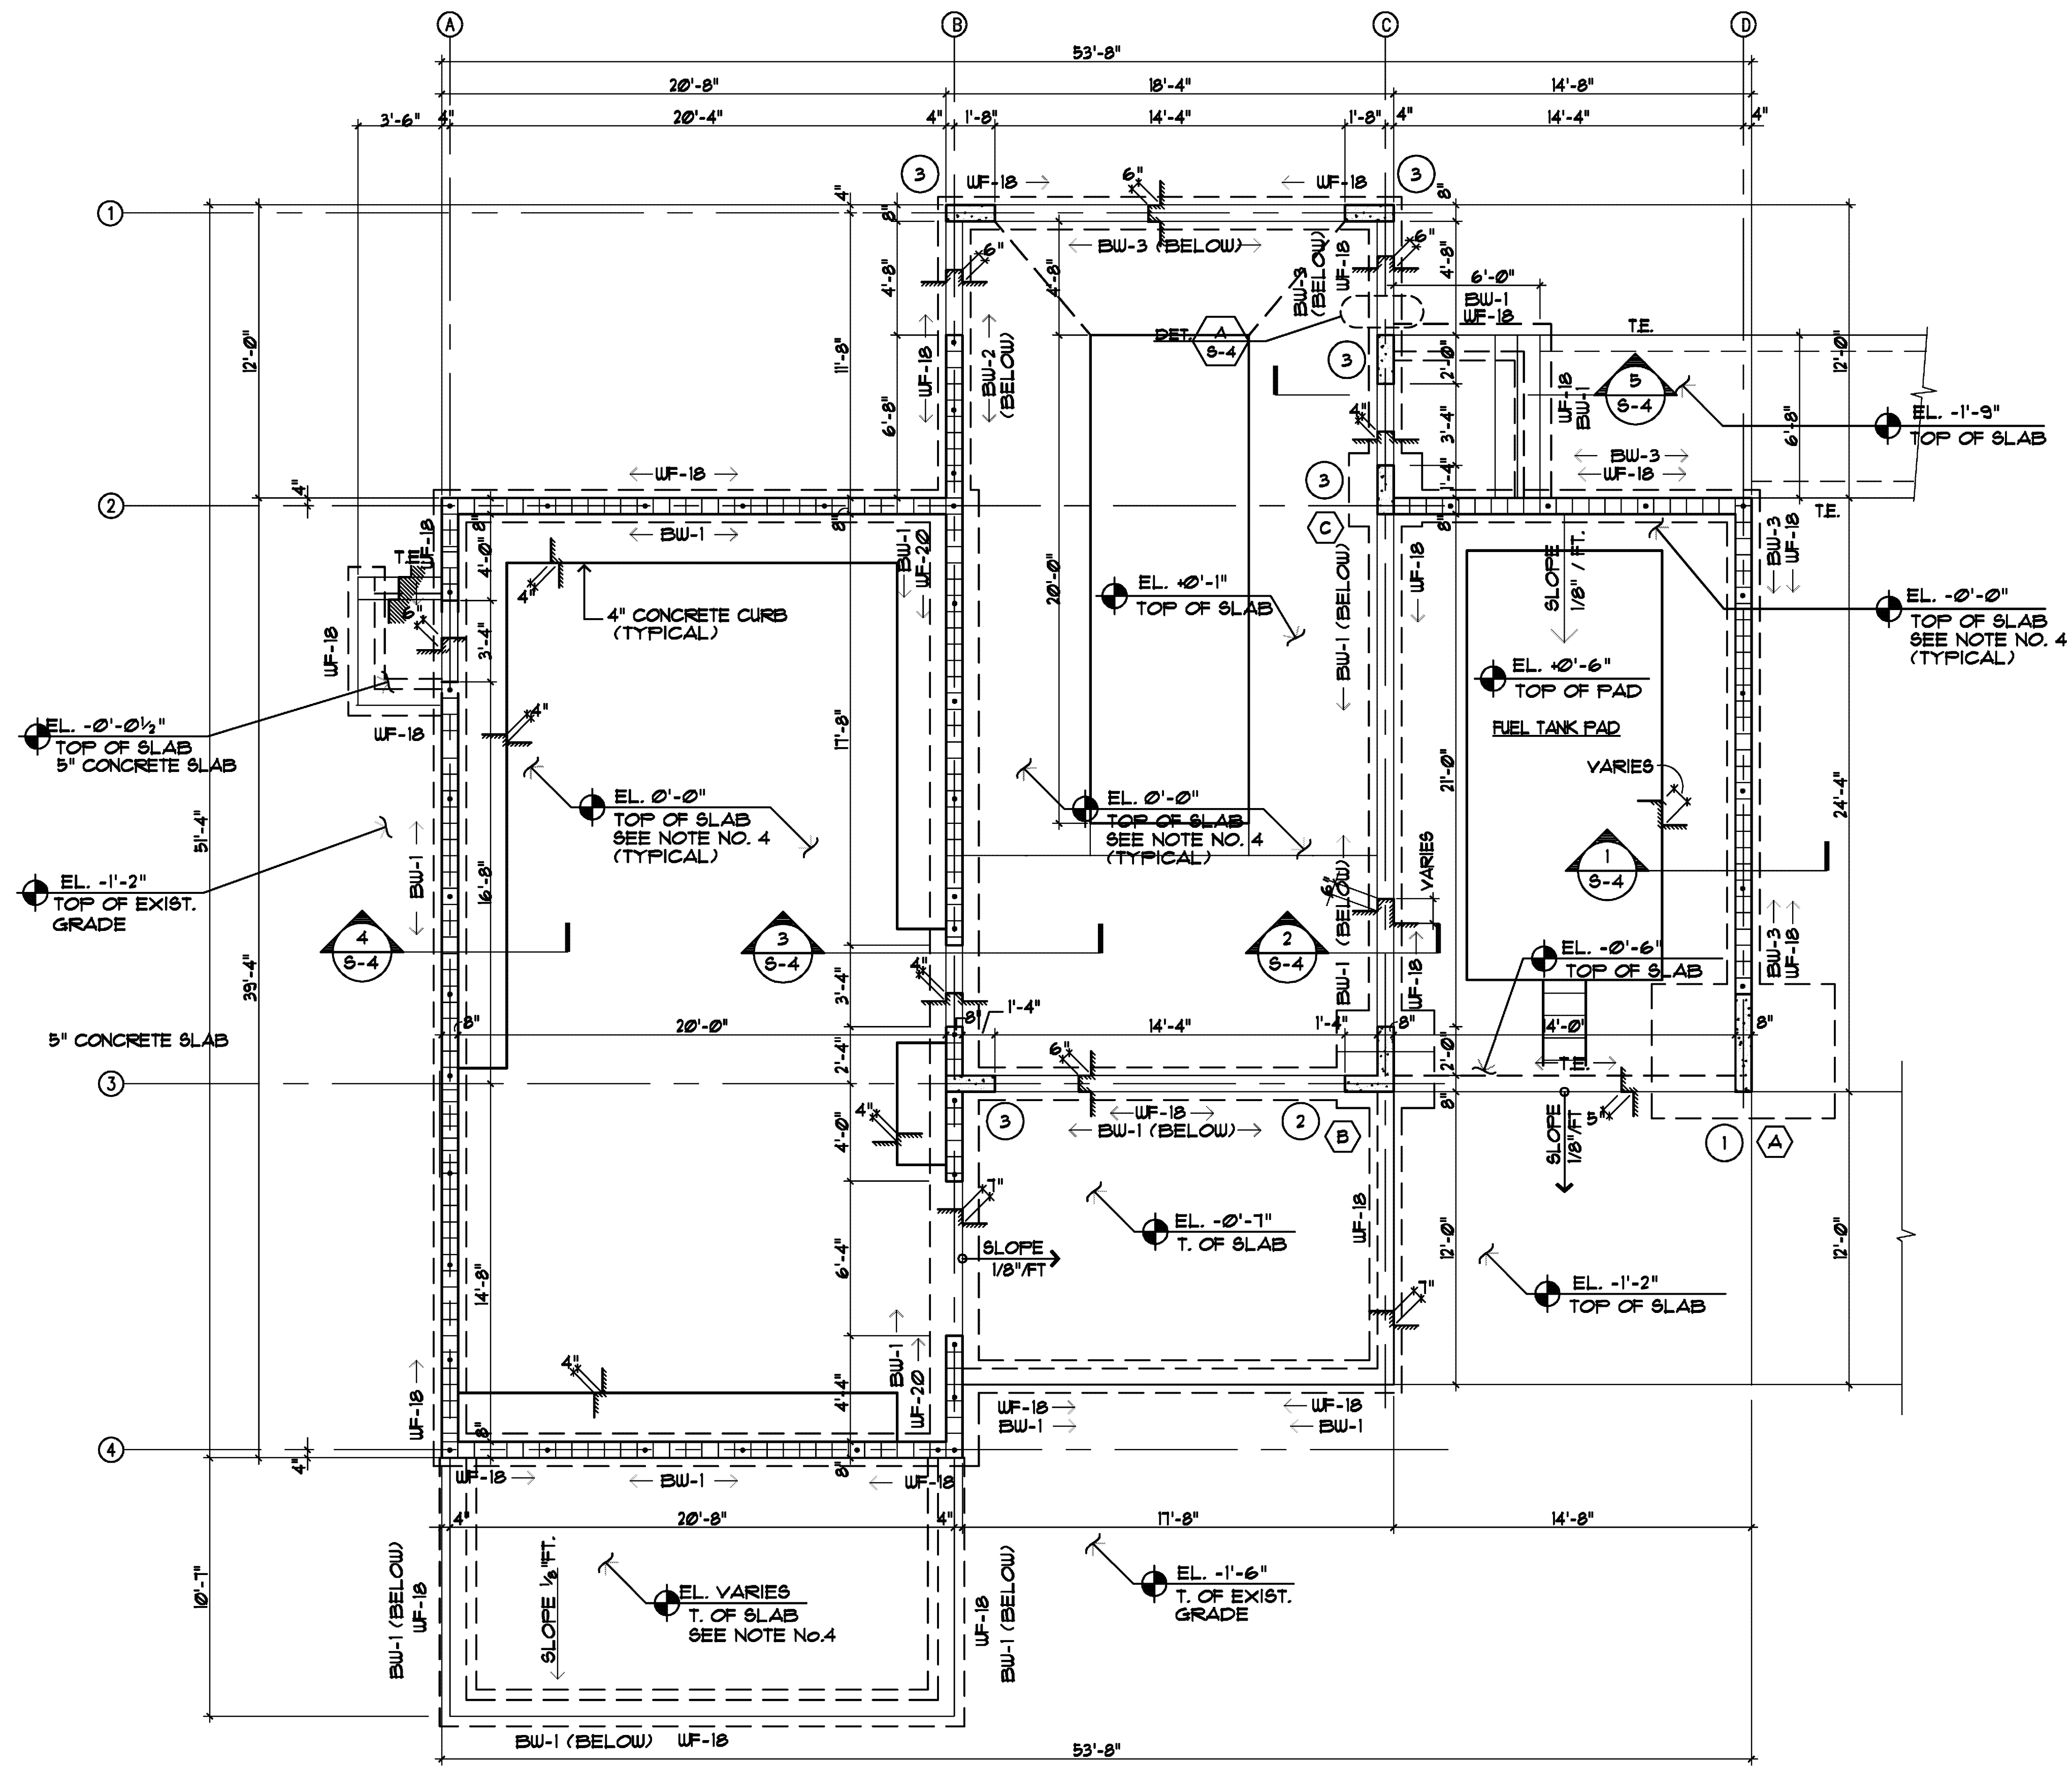

FOUNDATION AND GROUND FLOOR PLAN

SCALE: 1/4"=1'-0" PUMP STATION No. 28

- PLAN NOTES: FOUNDATION PLAN**
- TOP OF SLAB ELEVATION 0'-0" = +8.00 N.V.G.D. TYPICAL UNLESS OTHERWISE NOTED.
 - TOP OF FOOTING ELEVATION = -2'-6", TYPICAL UNLESS OTHERWISE NOTED AS THIS.
 - TOP OF SLAB ELEVATION AS SHOWN THIS EL. TYPICAL UNLESS NOTED.
 - SLAB NOTE: 5" CONCRETE SLAB ON VAPOR BARRIER OVER COMPACTED FILL, REINFORCED W/ 6x6 - W2.9 x W2.9 WELDED WIRE FABRIC, TYPICAL UNLESS NOTED.

- COORDINATE ALL SLAB OPENINGS AND DEPRESSIONS WITH ARCHITECTURAL AND MECHANICAL DRAWINGS.
- T.E. DENOTES 8"x12" THICKENED CONCRETE SLAB EDGE REINFORCED W/2-#5 SLAB EDGE REINFORCED W/2-#5 BOTTOM CONT.
- FOR GENERAL STRUCTURAL NOTES, SEE SHEET S-3
- FOR FOOTING SCHEDULE, SEE SHEET S-3
- FOR WALL SCHEDULE, SEE SHEET S-3
- DENOTES AN 8" MASONRY REINFORCED BLOCK WALL TYPE BW-1, TYPICAL UNLESS OTHERWISE NOTED.

- GROUT ALL FIRST CELLS OF CMU AND PROVIDE ONE CONTINUOUS #5 BAR VERTICAL AT ALL JAMBS, FOR ALL BEARING AND NON-BEARING BLOCK WALLS, TYPICAL UNLESS NOTED.
- IT IS THE RESPONSIBILITY OF THE CONTRACTOR TO VERIFY ALL DIMENSIONS.

CONCRETE PAD NOTES:
ELECTRICAL EQUIP. CONC. CURBS:
 4" CONC. SLAB (SECOND FOUR) W/ 6x6-W1.4xW1.4 MID. DEPTH TO BE POURED OVER 5" CONC. SLAB. ROUGHEN 5" SLAB SURFACE PRIOR TO POURING

FUEL TANK PAD:
 6"± MIN. CONC. SLAB (SECOND FOUR) W/ #4@12" C/C EA. WAY MID. DEPTH TO BE POURED OVER 5" CONC. SLAB. ROUGHEN 5" SLAB SURFACE PRIOR TO POURING

SOIL PREPARATION STATEMENT

- SITE PREPARATION:**
 SITE AREA SHALL BE CLEARED AND GRUBBED TO REMOVE AND DISPOSE OF ALL VEGETATION AND DEBRIS UP TO FIVE (5) FEET BEYOND PERIMETER OF BUILDING.
- FILL AND COMPACTION:**
 - PLACING FILL:**
 FILL SHALL BE PLACED IN LIFTS NOT GREATER THAN 12 INCHES LOOSE THICKNESS FOR MATERIAL COMPACTED BY HEAVY COMPACTION EQUIPMENT, AND NOT MORE THAN 6 INCHES LOOSE THICKNESS FOR MATERIAL COMPACTED BY HAND-OPERATED TAMPERS.
 FILL MATERIAL TO BE A CLEAN SELECT MATERIAL, CONTAINING NO MORE THAN 5% BY WEIGHT ORGANIC MATTER AND NO MAN-MADE DEBRIS OF ANY DESCRIPTION AS PER ASTM D-2487 UNIFIED CLASSIFICATIONS GW, GP, GP-GM OR SW.
 ALL BACKFILL AND FILL MATERIALS SHALL BE FREE OF ROCK OR GRAVEL LARGER THAN 3 INCHES OR 50% OF THE COMPACTED LAYER THICKNESS, WHICHEVER IS THE LESSER.
 - COMPACTION:**
 THE CLEARED SURFACE AND EACH FILL LIFT SHALL BE COMPACTED TO A MINIMUM RELATIVE COMPACTION OF 95%.
 RELATIVE COMPACTION IS DETERMINED IN THE FIELD BY ASTM D-2922 (NUCLEAR METHOD) WITH A PROBE DEPTH OF 12 INCHES AND DETERMINED IN THE LABORATORY BY ASTM D-1557 (MODIFIED PROCTOR). COMPACTION SHALL BE VERIFIED BY THE GEOTECHNICAL INSPECTOR TO CONFIRM THAT THE FILL MATERIAL BEING PLACED IS THE SAME MATERIAL AS TESTED IN THE LABORATORY. CANDIDATE FILL MATERIAL SHOULD BE SUPPLIED TO THE GEOTECHNICAL INSPECTOR A MINIMUM OF 12 HOURS PRIOR TO PLACING MATERIAL.
 COMPACTION OF FILL TO BE ACHIEVED BY THE USE OF VIBRATORY ROLLERS WHEN SPACE ALLOWS. FOR SMALL RESTRICTED AREAS, USE MECHANICAL HAND-OPERATED TAMPERS. PRIOR TO COMMENCING COMPACTION, THE MOISTURE CONTENT OF THE FILL MATERIAL SHALL BE ADJUSTED TO WITHIN PLUS/MINUS 2% OF THE OPTIMUM MOISTURE AS PER ASTM D-1557. ATTEMPTING COMPACTION OF FILL MATERIAL WHICH IS MORE THAN 5% BELOW OR 3% ABOVE OPTIMUM MOISTURE SHALL BE REGARDED AS UNSATISFACTORY.
 A MINIMUM OF ONE IN-PLACE FIELD DENSITY TEST SHALL BE PERFORMED FOR EACH 2500 SQUARE FEET, OR FRACTION THEREOF, FOR EACH LIFT OF COMPACTED SOIL FOR BUILDING PAD OR SLAB AREA.

RECORD DRAWING
 THIS RECORD DRAWING HAS BEEN PREPARED BASED ON A COMBINATION OF INFORMATION PROVIDED BY OTHERS AND BY CDM. THEREFORE, THE ENGINEER HAS NOT VERIFIED THE ACCURACY OF ALL THE INFORMATION. TO THE BEST OF THE ENGINEER'S BELIEF AND KNOWLEDGE, THE INCLUDED RECORD INFORMATION IS REASONABLY ACCURATE.
 By: _____ Date: December 2007
CDM

DONNELL DUQUESNE & ALBAISA, P.A.
 CONSULTING ENGINEERS
 RAMON R. DONNELL P.E. 0311890
 PEDRO J. DUQUESNE P.E. 0022764
 AIDA M. ALBAISA P.E. 0048130
 6830 S.W. 74th CT. MIAMI, FLORIDA 33156
 3050 686-0711 FAX 305-358-5288

City of Miami Beach
zyscovich
 100 N. BISCAYNE BLVD., SUITE 1400 MIAMI FL 33132
 T 305 372 8222 F 305 577 4521
 CIS 73527, 2250

Pump Station No. 28
 28th Street and Sheridan Avenue, Miami Beach

COPYRIGHT 1996 ZYSCOVICH, INC. ALL RIGHTS RESERVED. THESE DRAWINGS AND SPECIFICATIONS ARE INSTRUMENTS OF SERVICE AND SHALL REMAIN THE PROPERTY OF ZYSCOVICH, INC. WHETHER THE PROJECT FOR WHICH THEY WERE PREPARED IS EXECUTED OR NOT. THEY ARE NOT TO BE USED IN ANY MANNER ON OTHER PROJECTS OR EXTENSIONS TO THE PROJECT EXCEPT BY AGREEMENT IN WRITING AND WITH THE APPROPRIATE COMPENSATION TO ZYSCOVICH, INC. REPRODUCTIONS OF SPECIFICATIONS WITHOUT THE WRITTEN CONSENT OF ZYSCOVICH, INC. IS PROHIBITED.


CONFORMED FEB 99

Foundation Plan


RECORD DRAWINGS
 Revised: ADDENDUM No 2 AS APPLICABLE
 Revised: ADDENDUM No 3, CONFORMED
 Revised: REPROCUREMENT JAN. 03
 Revised: RECORD DRAWING 12/07

P28-FDN.DWG	10-18-96
DDA	9610-B


S 1
 STATION No. 28

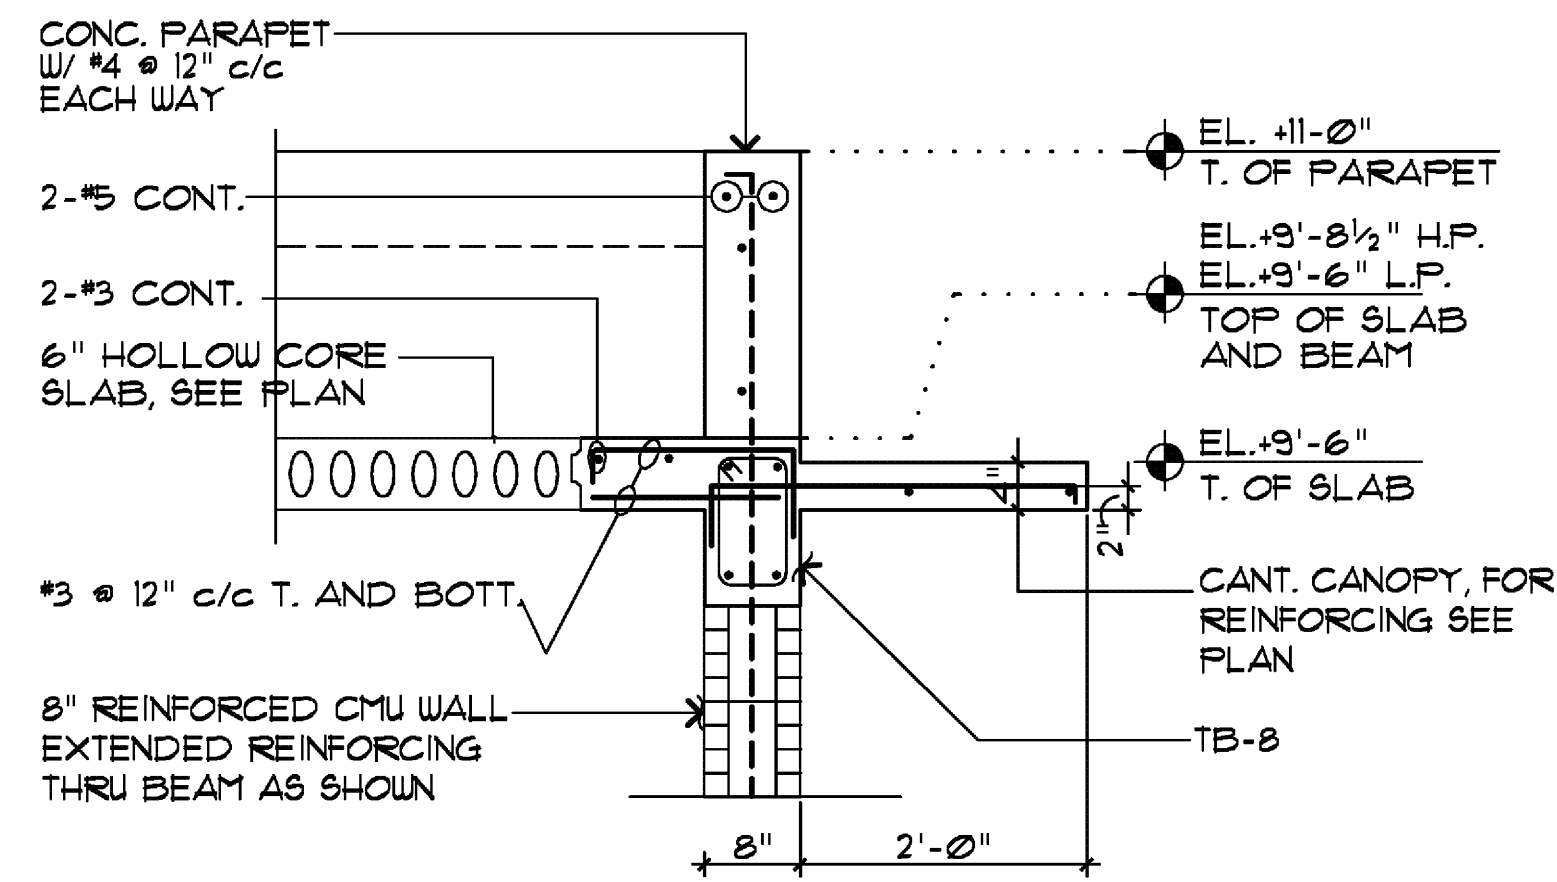


DETAIL A
SCALE: 3/4"=1'-0"

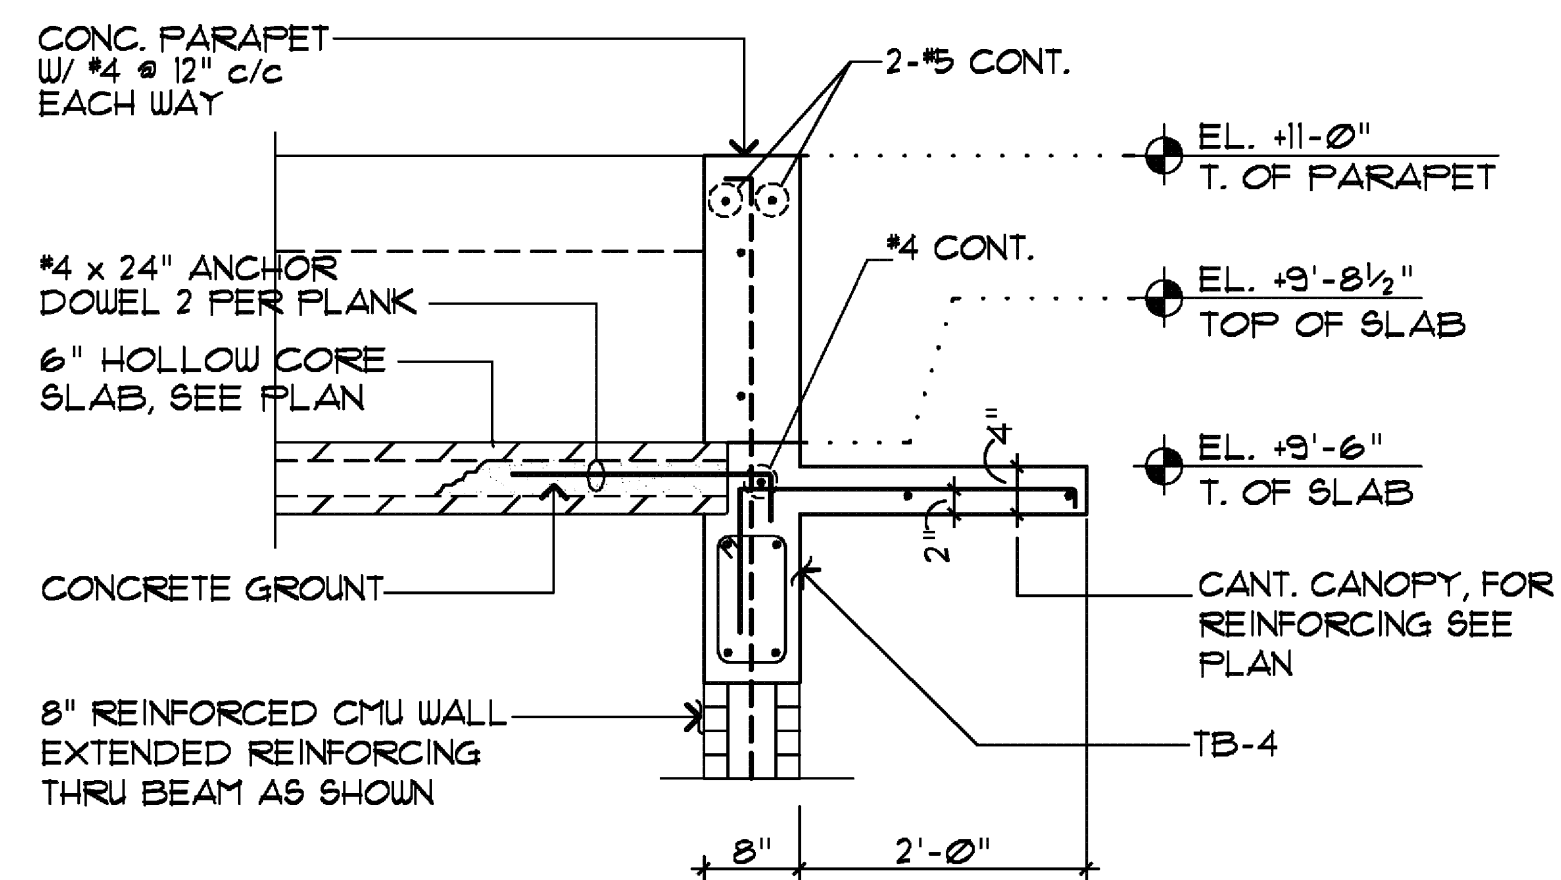

DETAIL B
SCALE: 3/4"=1'-0"

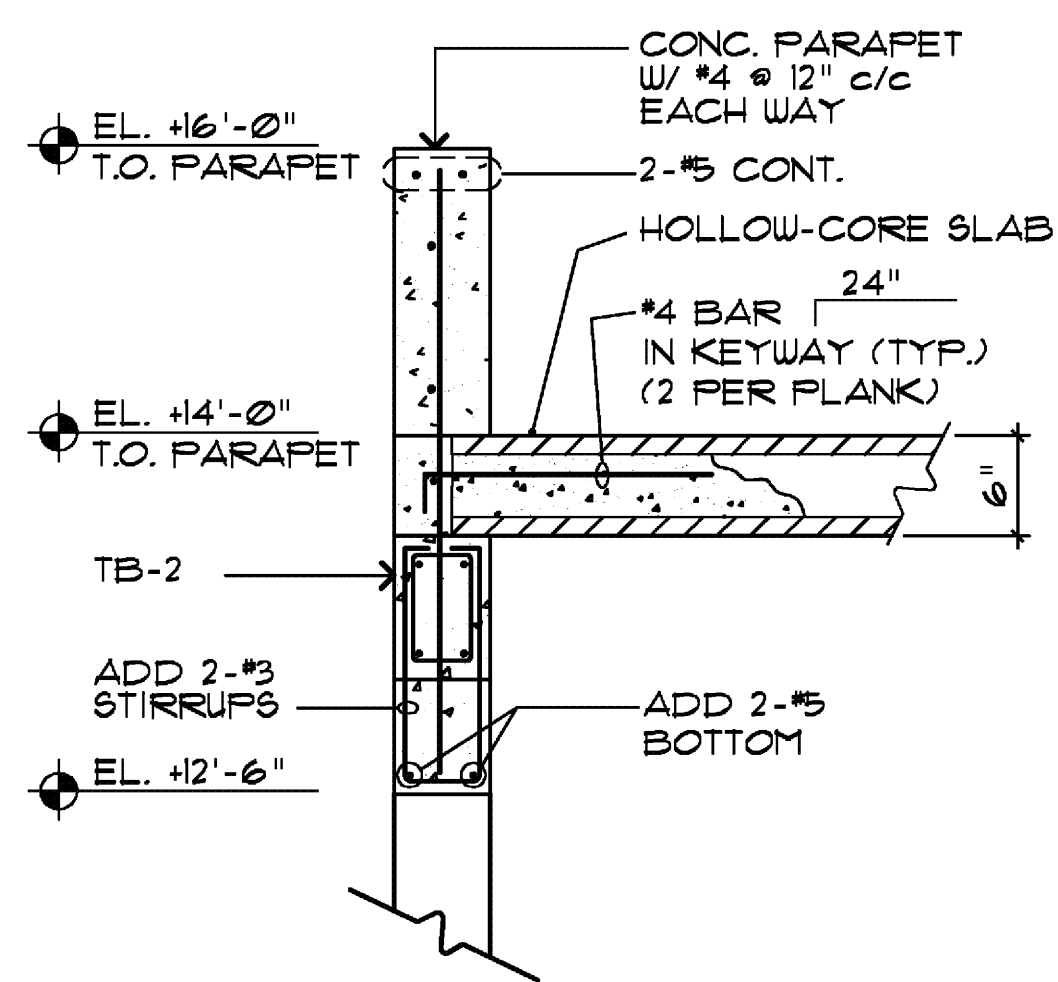

DETAIL C
SCALE: 3/4"=1'-0"

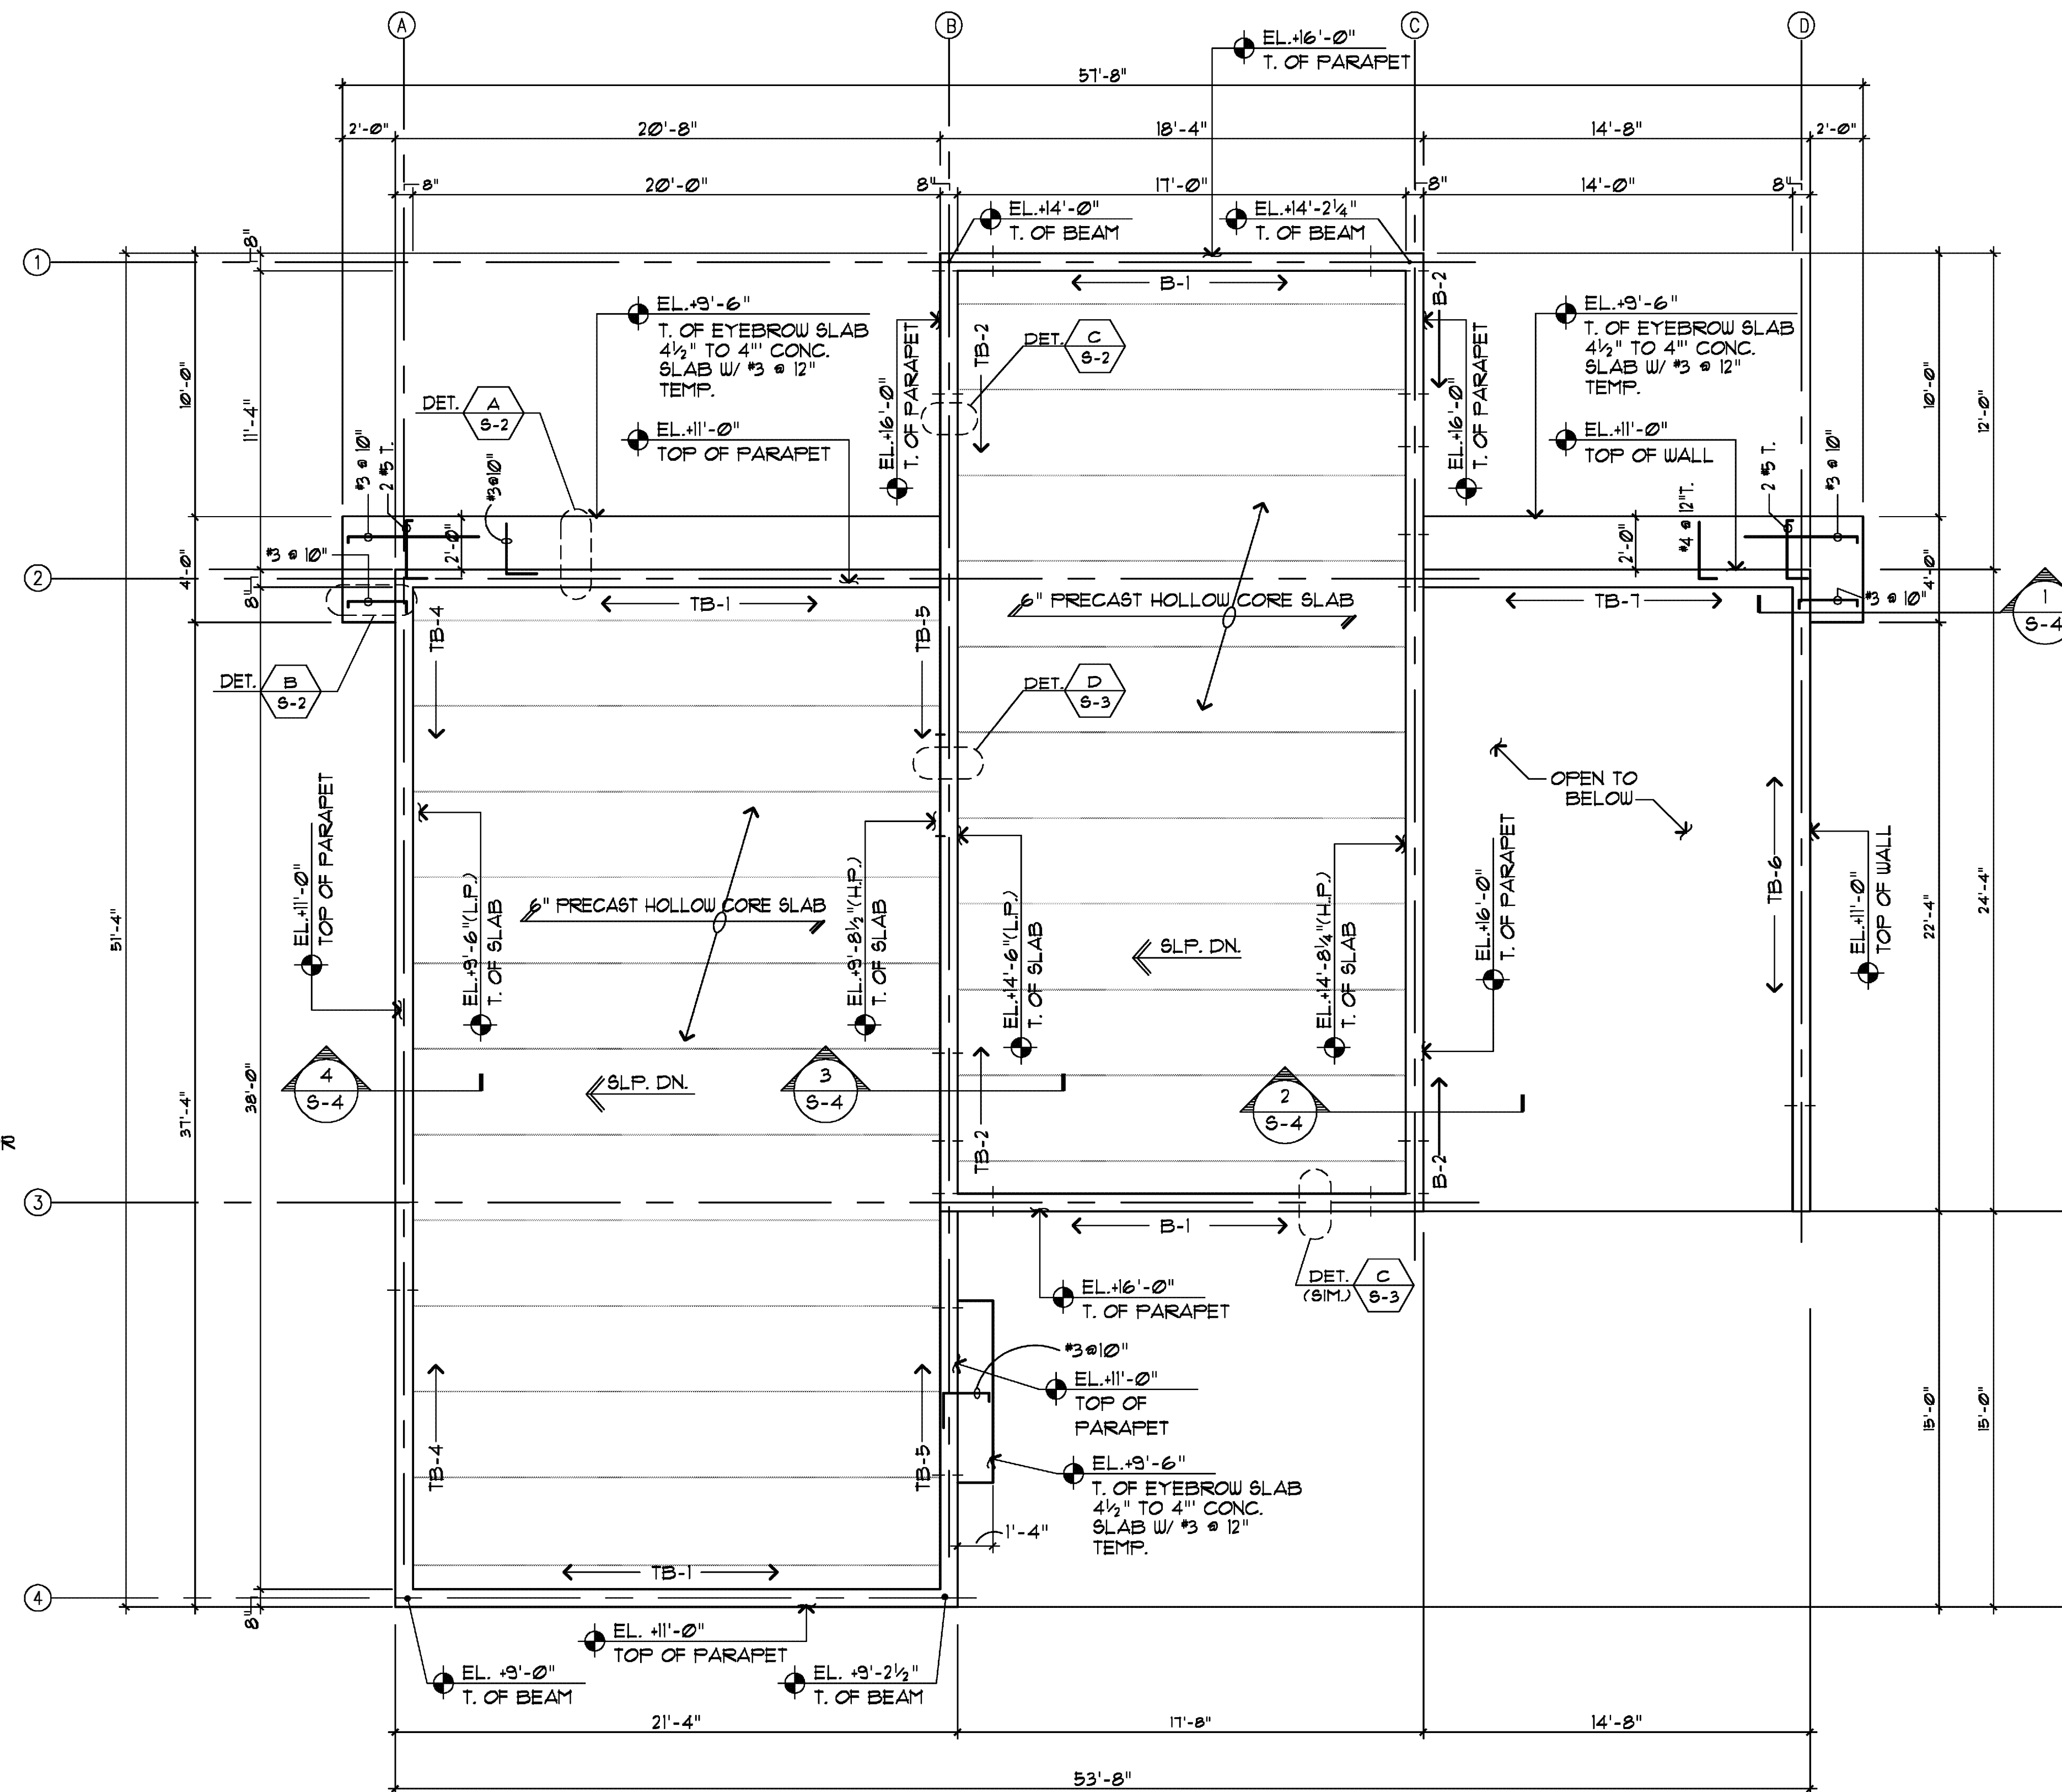

ROOF FRAMING PLAN

SCALE: 1/4"=1'-0" PUMP STATION No. 28

PLAN NOTES: ROOF LEVEL

- 1.- TOP OF SLAB/ HOLLOW CORE ELEVATION AS SHOWN. THUS, EL. _____
- 2.- HOLLOW CORE SLAB NOTE:
6" P.C. P.S. PLANKS BY CORESLAB OR APPROVED EQUAL
ALL JOINTS BETWEEN PLANKS AND PLANKS/WALLS SHALL BE FULLY PACKED WITH STIFF GROUT.
- 3.- FOR GENERAL STRUCTURAL NOTES, SEE SHEET S-3.
- 4.- FOR BEAM SCHEDULE, SEE SHEET S-3.

RECORD DRAWING
THIS RECORD DRAWING HAS BEEN PREPARED BASED ON A COMBINATION OF INFORMATION PROVIDED BY OTHERS AND BY CDM. THEREFORE, THE ENGINEER HAS NOT VERIFIED THE ACCURACY OF ALL THE INFORMATION. TO THE BEST OF THE ENGINEER'S BELIEF AND KNOWLEDGE, THE INCLUDED RECORD INFORMATION IS REASONABLY ACCURATE.
By: _____ Date: December 2007

zyscovich
DONNELL DUQUESNE & ALBAISA, P.A.
CONSULTING ENGINEERS
RAMON R. DONNELL P.E. 0011890
CIVIL/STRUCTURAL
PEDRO J. DUQUESNE P.E. 0022764
CIVIL/STRUCTURAL
AIDA M. ALBAISA P.E. 0045130
CIVIL/STRUCTURAL
4930 S.W. 74th CT. MIAMI, FLORIDA 33155
(305) 666-0111 FAX 666-5259

City of Miami Beach
zyscovich
100 N. BISCAYNE BLVD., SUITE 1400 MIAMI FL 33132
T 305 372 5222 F 305 577 4521
CS 73527, 2250

Pump Station No. 28
28th Street and Sheridan Avenue, Miami Beach

COPYRIGHT © 1996 ZYSKOVICH, INC. ALL RIGHTS RESERVED. THESE DRAWINGS AND SPECIFICATIONS ARE INSTRUMENTS OF SERVICE AND SHALL REMAIN THE PROPERTY OF ZYSKOVICH, INC. HEREIN THE PROJECT FOR WHICH THEY WERE PREPARED IS EXECUTED OR NOT, THEY ARE NOT TO BE USED IN ANY MANNER ON OTHER PROJECTS OR EXTENDING TO THE PROJECT EXCEPT BY AGREEMENT IN WRITING AND WITH THE APPROPRIATE CONSENT OF ZYSKOVICH, INC. VIOLATIONS OF SPECIFICATIONS WITHOUT THE WRITTEN CONSENT OF ZYSKOVICH, INC. IS PROHIBITED.

CONFORMED FEB 99

Roof Plan
RECORD DRAWINGS

Revised: ADDENDUM No 2 AS APPLICABLE
Revised: ADDENDUM No 3, CONFORMED
Revised: REPROCUREMENT JAN. 03
Revised: RECORD DRAWING 12/07

P28-RF.DWG	10-18-96
DDA	9610-B

S 2
STATION No. 28

DWG: L:\381-02\Record\TRM\28RF-S-2.DWG USER: nunal DATE: Jan 14, 2008 1:16pm REC: DWG-A RECORD: JLT C IMAGES: T528-S-2.TIF

GENERAL STRUCTURAL NOTES

1. **LOAD CRITERIA:**
 DESIGN FOR EFFECT OF WIND LOADS BASED ON "MINIMUM DESIGN LOADS FOR BUILDINGS AND OTHER STRUCTURES", ASCE - 7, USING:
 BASIC WIND SPEED 110 MPH
 IMPORTANCE FACTOR 1.1
 EXPOSURE "D"
 FOR ROOF WIND NET UPLIFT, SEE ROOF PLANS
SUPERIMPOSED LOADS:

ROOF	DEAD	LIVE
FLOOR	--	125

2. **FOUNDATIONS:**
 BASED ON SOIL BORINGS AND RECOMMENDATIONS MADE BY WINGERTER LAB. INC. THE FOUNDATIONS HAVE BEEN DESIGNED FOR AN ALLOWABLE SOIL BEARING PRESSURE OF 2500 PSF.

TESTING AND SAMPLING MUST BE DONE BY A LICENSED TESTING LABORATORY AT A RATE OF ONE FOR EVERY 50 FEET OF CONTINUOUS FOOTING AND ONE FOR EVERY 2500 SQUARE FEET OF COMPACTED INDIVIDUAL LIFT OF SLAB ON GRADE. FIELD DENSITIES EQUIVALENT TO AT LEAST 95% OF THE MODIFIED PROCTOR MAXIMUM DRY DENSITY (ASTM D-1557) SHOULD BE ACHIEVED.

3. **CONCRETE:**
 ALL CONCRETE TO ATTAIN A MINIMUM ULTIMATE COMPRESSIVE STRENGTH IN 28 DAYS AS SHOWN BELOW. AGGREGATES TO BE CLEAN AND WELL GRADED, MAXIMUM SIZE 1". CONCRETE SLUMP 3" MINIMUM TO 5" MAXIMUM. VERTICAL CONCRETE DROP NOT TO EXCEED 6".

STRUCTURAL CONCRETE	3000
PS HOLLOW CORE	5000
LT. WT. INSULATION CONCRETE (INSULCEL)	200

4. **CONCRETE COVER:**
 TO BE AS FOLLOWS:

	BOTTOM	TOP	SIDES
FOOTINGS	3"	2"	2"
BEAMS	1-1/2"	1-1/2"	1-1/2"
GRADE BEAMS	3"	2"	2"
COLUMNS	---	---	1-1/2"
SLABS	3"	3/4"	1"
WALLS	1-1/2"	1-1/2"	1-1/2"

5. **PRECAST HOLLOW CORE SLABS (SHOP DRAWINGS REQUIRED)**
 SHALL BE DESIGNED, DETAILED AND FABRICATED IN ACCORDANCE WITH ACI 308 AND SOUTH FLORIDA BUILDING CODE. THE CONNECTIONS AS SHOWN IN THESE DRAWINGS ARE "SUGGESTED CONNECTIONS". THE PC MANUFACTURER MUST SUBMIT OTHER SYSTEMS FOR APPROVAL BY A/E. SHOP DRAWINGS AND STRUCTURAL CALCULATIONS SHALL BE SIGNED AND SEALED BY A FLORIDA REGISTERED PROFESSIONAL ENGINEER AND SHALL INCLUDE SERVICE LOADS, TEMPORARY BRACING AND ERECTION LOADS. THE GENERAL CONTRACTOR IS TO COORDINATE THE ERECTION SEQUENCE AND THE LOCATION OF PENETRATIONS, EMBEDMENTS, ETC.

6. **STRUCTURAL SLAB:**
 FILL AND BACKFILL TO BE COMPACTED FOR FORMING PURPOSES ONLY. COMPACTION LAYERS NOT TO EXCEED 8". FILL MATERIAL TO BRING EXISTING GRADE TO FINISHED FLOOR ELEVATION SHALL BE WELL GRADED, CLEAN, FREE OF ORGANIC MATERIALS, ROOTS, MAN MADE MATERIALS ETC. SEE SOILS REPORT FOR ACCEPTABLE FILL MATERIAL.

7. **REINFORCING STEEL (SHOP DRAWINGS REQUIRED):**
 TO BE NEW HIGH STRENGTH BILLET STEEL DEFORMED AS PER ASTM A-305, AND CONFORMING TO ASTM A-615, GRADE 60. LAP CONTINUOUS BARS 30 BAR DIAMETERS MINIMUM (LONG). HOOK DISCONTINUOUS ENDS OF ALL TOP BARS. ALL REINFORCING STEEL TO BE DETAILED AND FABRICATED IN ACCORDANCE WITH "MANUAL OF STANDARD PRACTICE OF DETAILING REINFORCED CONCRETE STRUCTURES", AND THE ACI BUILDING CODE 318-95 AND 98/BC 1994. SUBMIT SHOP DRAWINGS FOR APPROVAL BY ENGINEER BEFORE FABRICATION.

8. **MASONRY NOTES:**
 A. ALL CONCRETE BLOCK MASONRY WALLS, TO COMPLY WITH "BUILDING CODE REQUIREMENTS FOR MASONRY STRUCTURES" (ACI 530-95/ASCE 5-95/TMS 402-95) AND "SPECIFICATION FOR MASONRY STRUCTURES" (ACI 530.1-95/ASCE 6-95/TMS 602-95) OR LATER REVISIONS.


B. THE CONCRETE BLOCK UNITS, TO BE TYPE II-NONMOISTURE CONTROLLED, CONFORMING TO ASTM C-90, WITH A MINIMUM NET AREA COMPRESSIVE STRENGTH OF 1900 PSI (AVERAGE OF THREE). TESTING AND SAMPLING OF MASONRY UNITS MUST BE DONE BY A LICENSED TESTING LABORATORY AT A RATE OF EVERY 1000 SQUARE FEET OF WALLS ERECTED, AND SHALL COMPLY WITH ASTM C-140, ASTM E-441 AND ACI 530.1, AND ASTM E-441-92b FOR STANDARD TEST METHODS FOR COMPRESSIVE STRENGTH OF MASONRY FRISM.

C. THE MORTAR SHALL COMPLY WITH ASTM C-270, AND SHALL BE TYPE "M" WITH MINIMUM COMPRESSIVE STRENGTH OF 2500 PSI, AT 28 DAYS. THE MORTAR MUST BE TESTED BY A LICENSED LABORATORY, ACCORDING TO ASTM C-100, AT A RATE OF EVERY 1000 SQUARE FEET OF WALLS ERECTED. PROVIDE FULL BED OF MORTAR FOR ALL REINFORCED MASONRY WALLS.

D. MASONRY WALLS SHALL BE REINFORCED HORIZONTALLY AT EVERY OTHER COURSE, WITH DEFORMED GALVANIZED PREFABRICATED STEEL, "LADDER TYPE" DUR-O-WALL OR EQUAL AS FOLLOWS:
 No. 3 GAUGE INTERIOR WALLS AT EVERY OTHER COURSE
 No. 8 GAUGE EXTERIOR WALLS AT EVERY COURSE

E. ALL INTERIOR NON-BEARING BLOCK WALLS, MUST HAVE AT THE TOP AN 8"x12" TIE-BEAM WITH FOUR #5 CONT. AND #3 TIES AT 48" C/C. TIE BEAMS MUST BE DOWELED INTO WALLS AT EACH END AND INTERSECTIONS. AT ALL CORNER ENDS AND INTERSECTIONS ADD #3 TIES AT 12" C/C AND PROVIDE 2 #5 x 5'-0" CORNER BARS BENT 30° ON EACH DIRECTION.

F. **ADDITIONAL NOTES FOR REINFORCED MASONRY WALLS:**
 1. FILL THE CELLS WITH GROUT ACCORDING TO THE CONTRACT DOCUMENTS. THE GROUTING SHALL COMPLY WITH ACI-ASCE 530-95 AND ASTM C-416, AND SHALL HAVE A MINIMUM COMPRESSIVE STRENGTH OF 3000 PSI, AT 28 DAYS, WITH 8-10 INCHES SLUMP, AND SHALL BE SAMPLED AND TESTED BY A LICENSED LABORATORY ACCORDING TO ASTM C-1019. PROVIDE CLEANOUT HOLES IN REINFORCING CHU CELLS AT THE BOTTOM CELL OF EACH FOUR INCLUDING THE CELL DIRECTLY ABOVE THE FOOTING (STEM WALLS). CLEAN CELLS FREE OF BROKEN BLOCK PIECES AND MORTAR DROPPING. MAXIMUM VERTICAL DROP FOR GROUTING NOT TO EXCEED 8'-0".
 2. FOR VERTICAL REINFORCEMENT REFER TO THE STRUCTURAL DRAWINGS, LAP SPICING SHALL BE MINIMUM OF 48 BAR DIAMETERS.
 3. WHEN USING DOVE-TAILS THE FIRST BLOCK CELL ADJACENT TO CONCRETE, MUST BE FILLED AND REINFORCED WITH 1-#5 REBAR, UNLESS OTHERWISE NOTED.
 4. BOTH SIDES OF ALL OPENINGS WITH NO TIE COLUMNS MUST HAVE A FILLED CELL REINFORCED WITH 1 #5, UNLESS OTHERWISE NOTED.
 5. NO PRECAST LINTEL IS ALLOWED UNLESS APPROVED BY THE ENGINEER FOR SPECIFIC LOCATIONS.


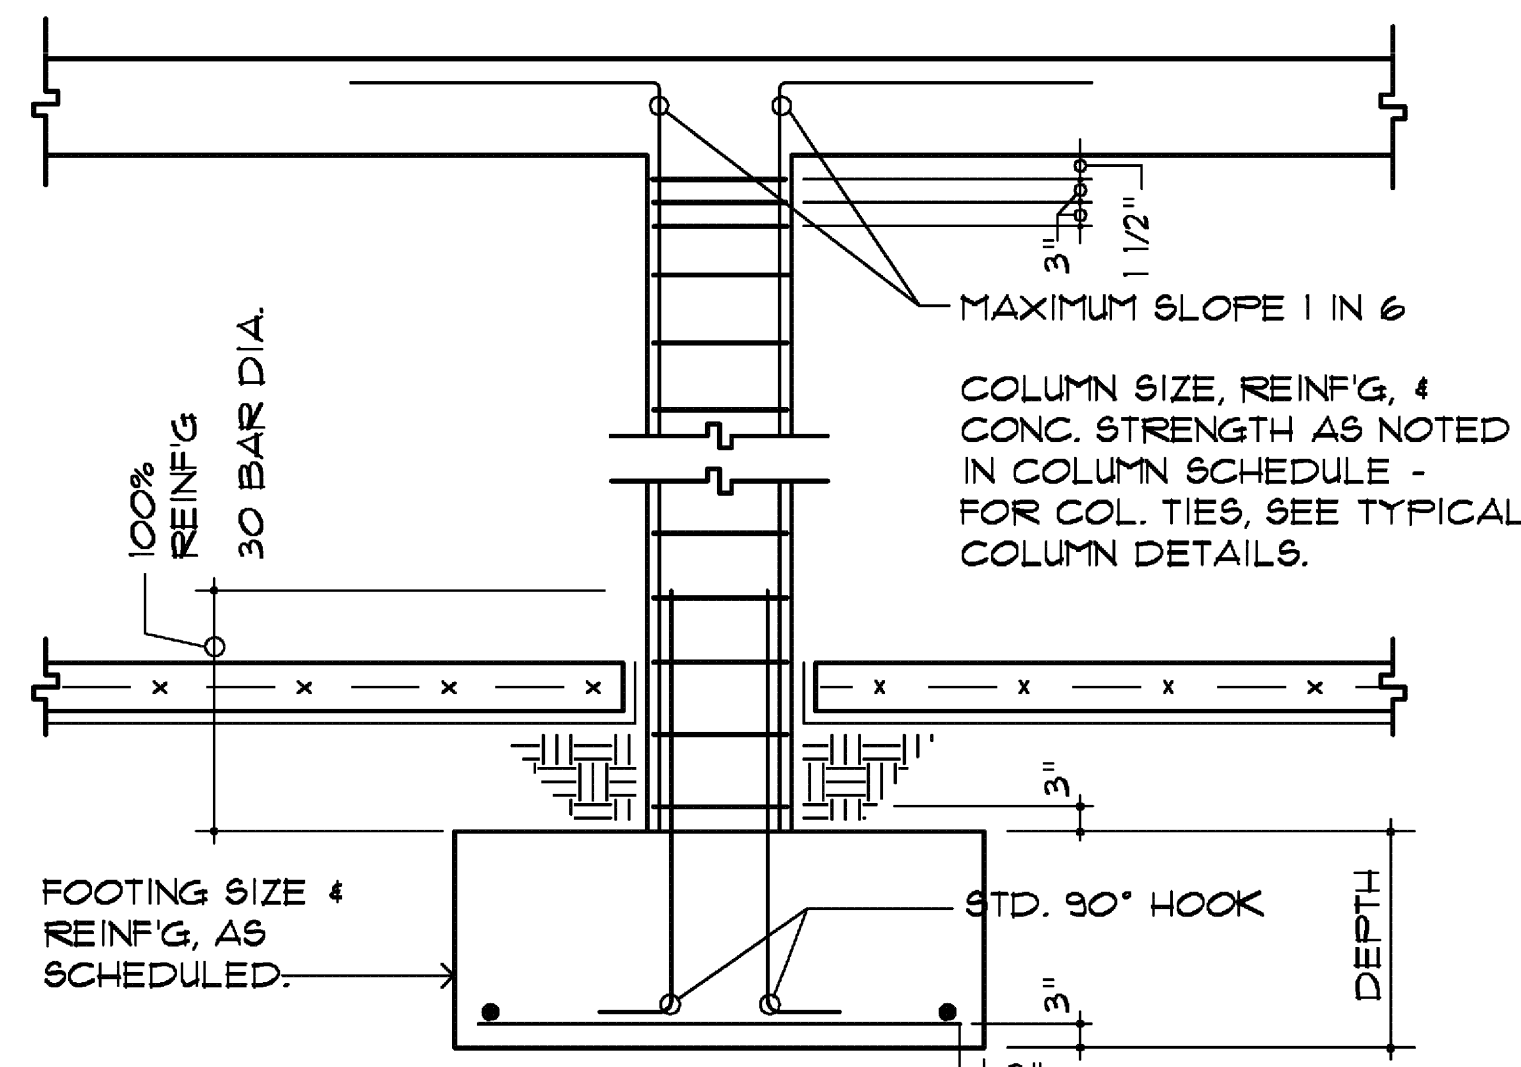


TYPICAL CONCRETE COLUMN AND FOOTING DETAIL
N.T.S.


FOOTING SCHEDULE			
MARK	SIZE	REINFORCEMENT	REMARKS
WF-1B	18" x 12"	2 #5 LONGITUDINAL	
WF-20	20" x 12"	2 #5 LONGITUDINAL	
A	5'-6" x 7'-6" x 1'-6"	6-#6 L.W. TOP & BOTT. (*) 8-#5 S.W. TOP & BOTT.	(*) OUTER LAYER
B	4'-0" x 4'-0" x 1'-0"	4-#5 EACH WAY BOTT.	
C	3'-0" x 3'-0" x 1'-0"	4-#5 EACH WAY BOTT.	

COLUMN SCHEDULE				
MARK	SIZE	REINFORCING		REMARKS
		VERTICAL	TIES	
1	8 x 48	10-#8	#3 @ 8" c/c	
2	8 x 32 x 24	7-#1	#3 @ 8" c/c	
3	8 x 24	4-#1	#3 @ 8" c/c	


COLUMN ARRANGEMENT DETAIL

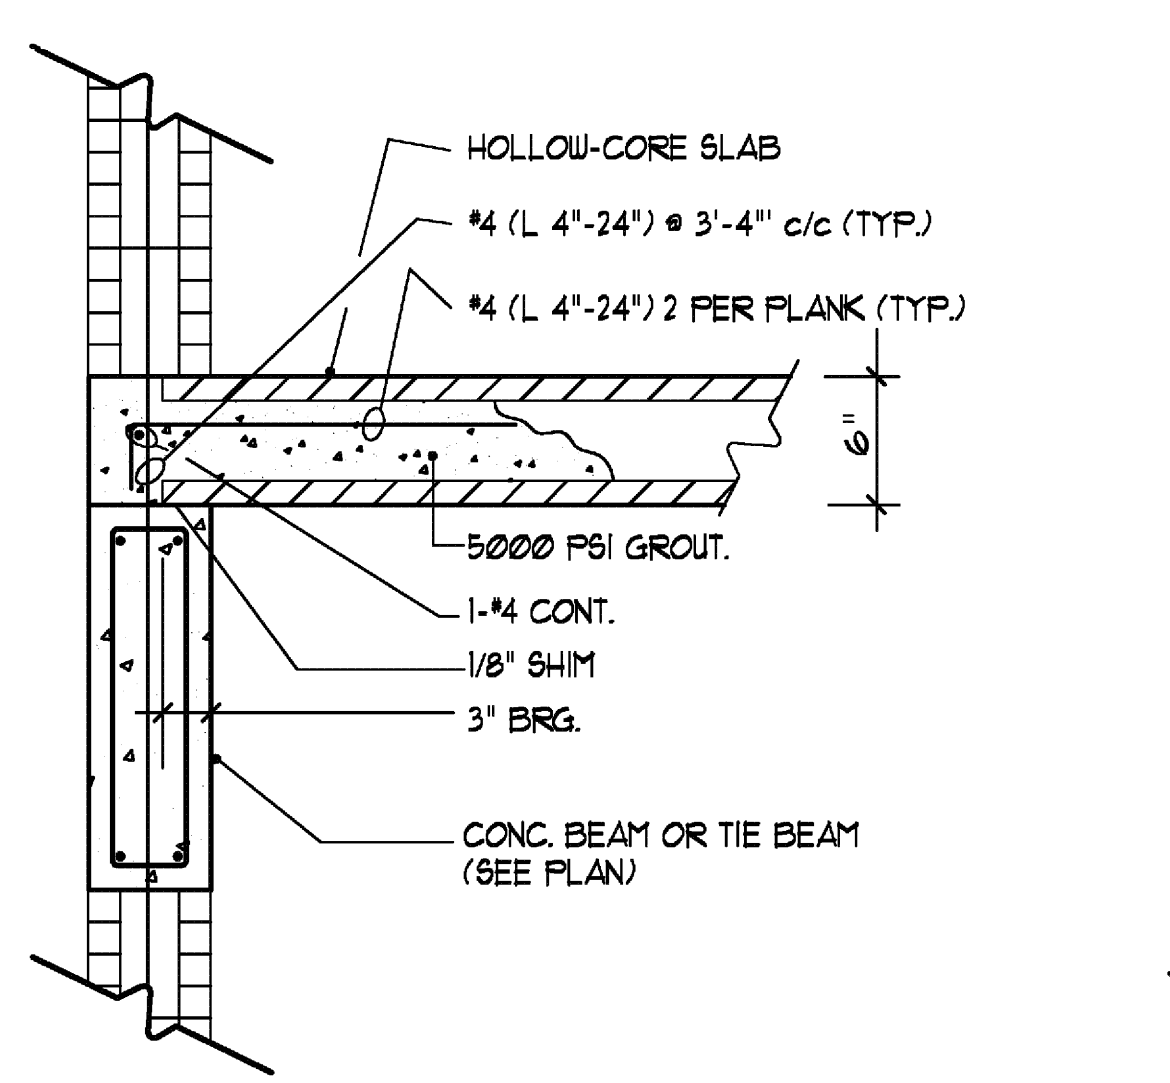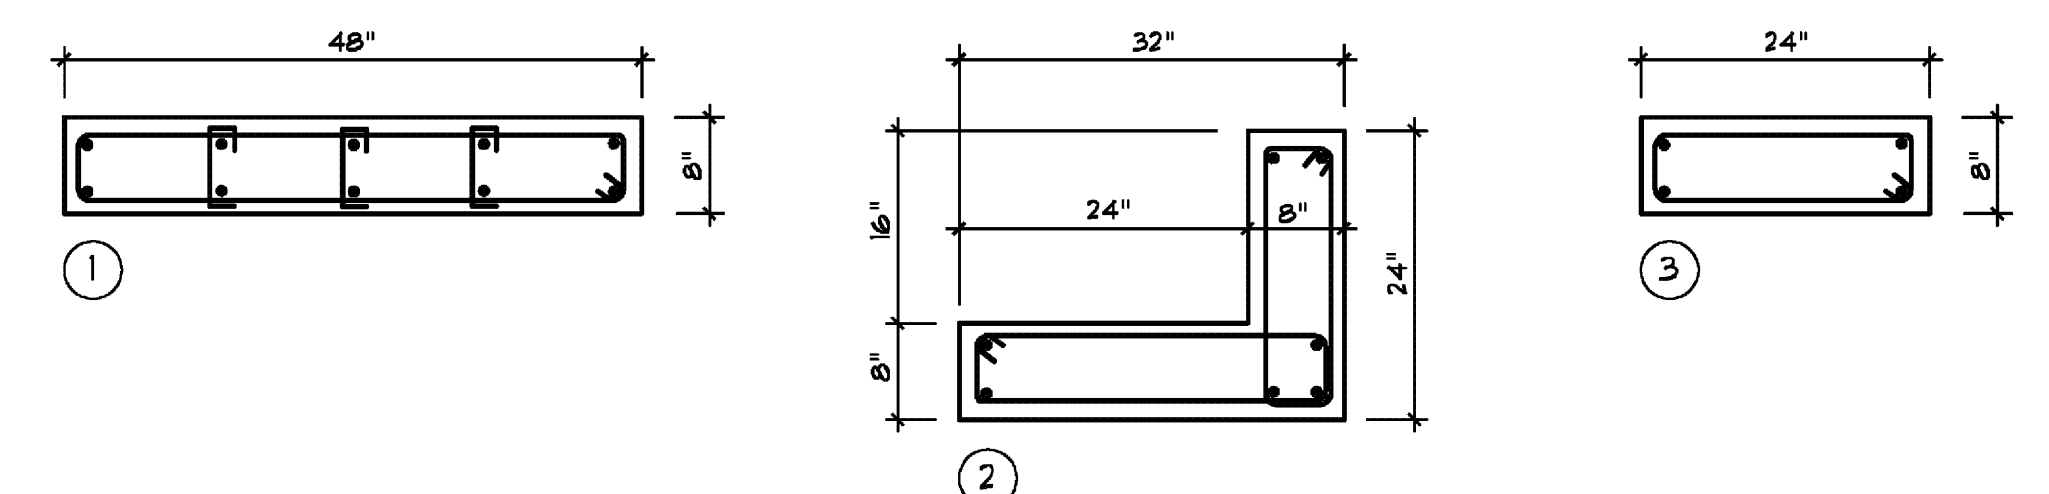

D DETAIL
SCALE: 3/4" = 1'-0"

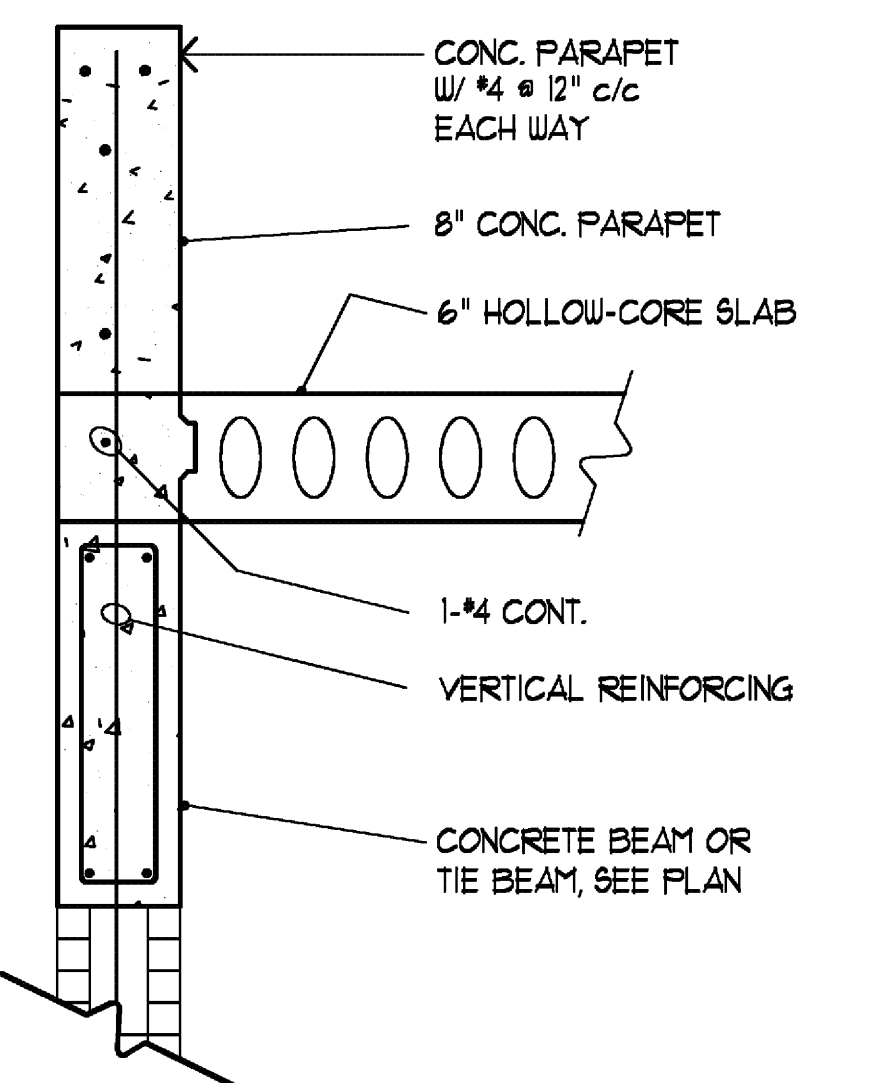

C DETAIL
SCALE: 3/4" = 1'-0"

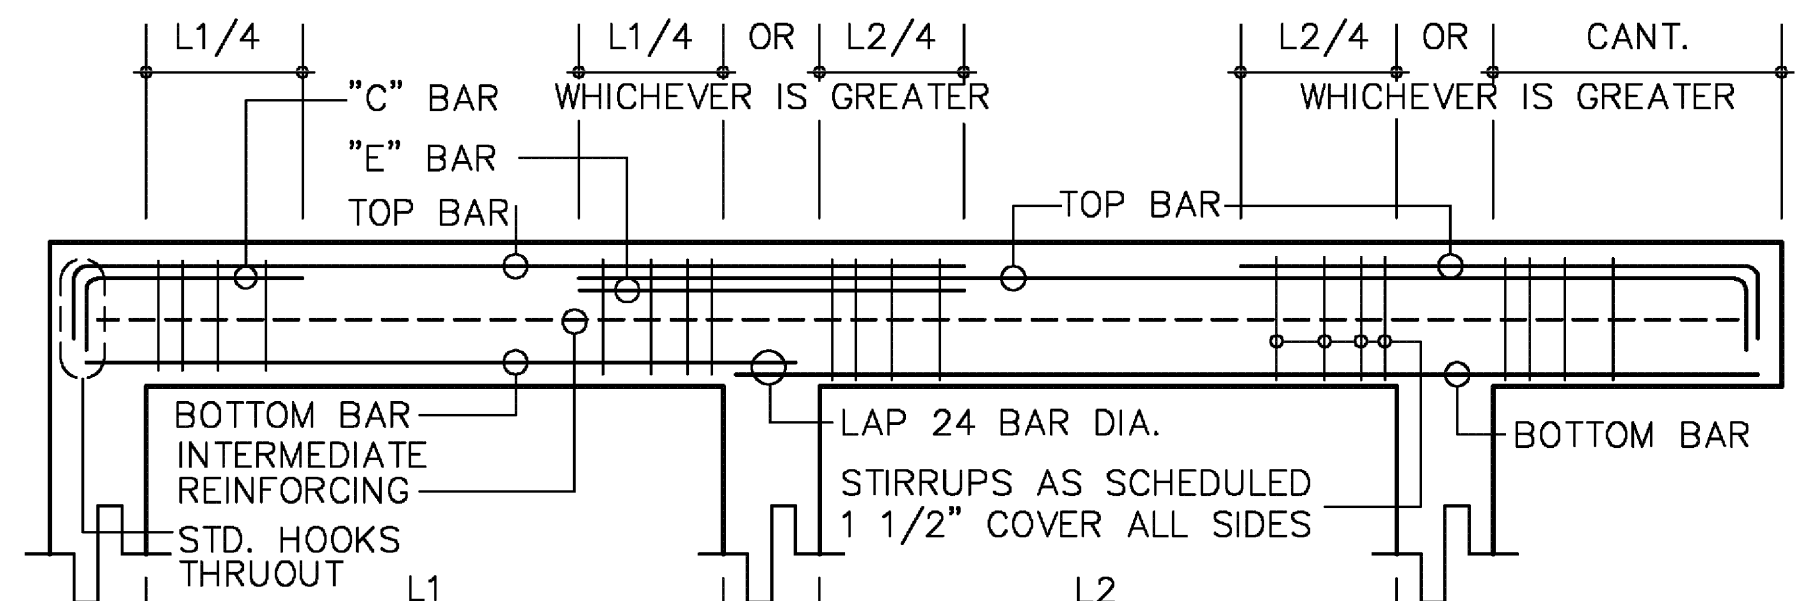


TYPICAL BEAM DIAGRAM

- NOTES:
- "C" BARS ARE TOP BARS AT NON-CONTINUOUS ENDS.
 - "E" BARS ARE TOP BARS OVER RIGHT INTERIOR SUPPORTS.
 - TOP BARS CALLED FOR AS CONTINUOUS, WHEN SPLICED, SHALL BE SPLICED IN THE MIDDLE THIRD OF THE SPAN.
 - REFER TO INTERMEDIATE BEAM REINFORCING FOR ADDITIONAL REINFORCING.
 - PROVIDE AT ALL NON-BEARING BLOCK WALLS, A TIE-BEAM 8"x12" (MIN.) WITH 2-#5 TOP AND BOTTOM CONT., #3 TIES, 4 AT 12" c/c EACH END, BAL. AT 48" c/c TIE-BEAMS MUST BE DOWELED INTO WALLS AT EACH END, AT INTERSECTIONS, AT INTERMEDIATE POINTS.
 - PROVIDE 2-#5 CORNER BARS (EXTEND 30" IN EACH DIRECTION FROM CORNER) AT ALL NON-BEARING BLOCK WALLS.

BEAM SCHEDULE									
MARK	TOP OF BEAM ELEV	SIZE (IN.)	REINFORCING				STIRRUPS		REMARKS
			B	T	C	E	NO.	SPACING	
TB-1	+8'-8 1/2" H.P. +9'-6" L.P.	8"x12"(MIN.)	2 #5	2 #5			3 #	4 #12" c/c EE. BAL. @ 36" c/c.	(*) CONT.
TB-2	+14'-0"	8"x12"(MIN.)	2 #5	2 #5			3 #	4 #12" c/c EE. BAL. @ 36" c/c.	(*) CONT.
TB-3	NOT USED								
TB-4	+9'-0"	8"x12"(MIN.)	2 #5	2 #5			3 #	4 #12" c/c EE. BAL. @ 36" c/c.	(*) CONT.
TB-5	+9'-2 1/2"	8"x12"(MIN.)	2 #5	2 #5			3 #	4 #12" c/c EE. BAL. @ 36" c/c.	(*) CONT.
TB-6	+11'-6"	8"x 34"	2 #7	2 #7			3 #	4 #12" c/c EE. BAL. @ 18" c/c.	(*) ADD 2-#5 AT MID HT.
TB-7	+11'-6"	8"x 34"	2 #5	2 #5			3 #	4 #12" c/c EE. BAL. @ 18" c/c.	(*) ADD 2-#5 AT MID HT.
B-1	VARIABLE SEE PLAN	8"x18"(MIN.)	2 #5	2 #5			3 #	@ 8" c/c.	(*) CONT. (**) SET BOTTOM EL. AT +12'-6"
B-2	+14'-2 1/4"	8"-20 1/4"	2 #8	2 #8			3 #	@ 8" c/c.	(*) CONT.

WALL SCHEDULE				
MARK	THICK	VERT. REINF.	HORZ. REINF.	REMARKS
BW-1	8"	#5 @ 48" c/c	#3 DUR-O-WALL @ 16" c/c	
BW-2	8"	#5 @ 16" c/c	#3 DUR-O-WALL @ 16" c/c	
BW-3	8"	#5 @ 24" c/c	#3 DUR-O-WALL @ 16" c/c	

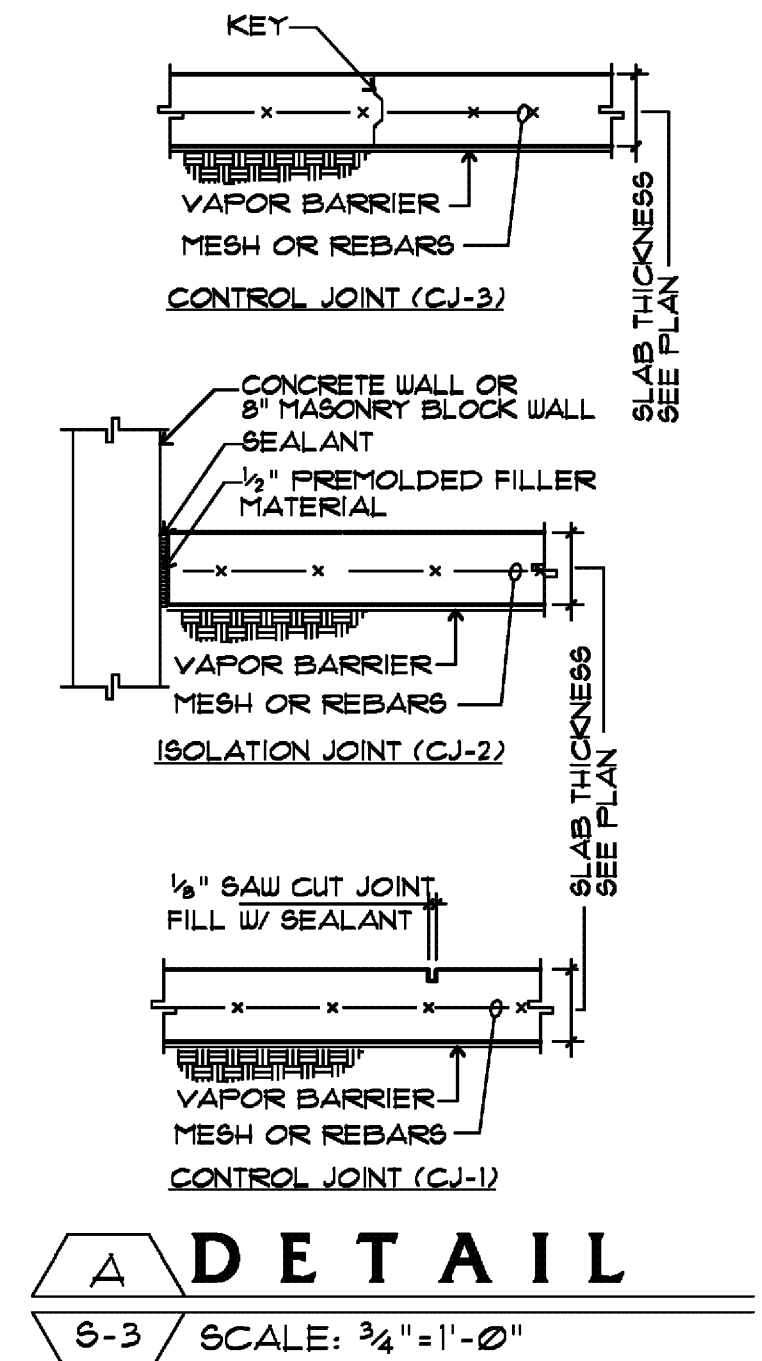

A DETAIL
SCALE: 3/4" = 1'-0"

RECORD DRAWING
 THIS RECORD DRAWING HAS BEEN PREPARED BASED ON A COMBINATION OF INFORMATION PROVIDED BY OTHERS AND BY CDM. THEREFORE, THE ENGINEER HAS NOT VERIFIED THE ACCURACY OF ALL THE INFORMATION. TO THE BEST OF THE ENGINEER'S BELIEF AND KNOWLEDGE, THE INCLUDED RECORD INFORMATION IS REASONABLY ACCURATE.
 Date: December 2007
 By: CDM

DONNELL DUQUESNE & ALBAISA, P.A.
 CONSULTING ENGINEERS
 RAMON R. DONNELL P.E. 0311593
 CIVIL/STRUCTURAL
 PEDRO J. DUQUESNE P.E. 0322754
 CIVIL/STRUCTURAL
 AIDA M. ALBAISA P.E. 0045130
 CIVIL/STRUCTURAL
 4830 SW 74th CT, MIAMI, FL 33155
 (305) 686-0711 FAX 866-5289

City of Miami Beach
zyscovich
 100 N. BISCAYNE BLVD., SUITE 1400 MIAMI FL 33132
 T 305 372 3222 F 305 577 4521
 CIS 73527, 2250

Pump Station No. 28
 28th Street and Sheridan Avenue, Miami Beach
 COPYRIGHT © 1996 ZYSOVICH, INC. ALL RIGHTS RESERVED.
 THESE DRAWINGS AND SPECIFICATIONS ARE INSTRUMENTS OF SERVICE AND SHALL REMAIN THE PROPERTY OF ZYSOVICH, INC. WHETHER THE PROJECT FOR WHICH THEY WERE PREPARED IS EXECUTED OR NOT. THEY ARE NOT TO BE USED IN ANY MANNER ON OTHER PROJECTS OR EXTENDED TO THE PROJECT EXCEPT BY AGREEMENT IN WRITING AND WITH THE APPROPRIATE CONSENT OF ZYSOVICH, INC. REPRODUCTIONS OF SPECIFICATIONS WITHOUT THE WRITTEN CONSENT OF ZYSOVICH, INC. IS PROHIBITED.

CONFORMED FEB 99
Schedule Plan
RECORD DRAWINGS
 Revised: ADDENDUM No 2 AS APPLICABLE
 Revised: ADDENDUM No 3, CONFORMED
 Revised: REPROCUREMENT JAN. 03
 Revised: RECORD DRAWING 12/07

P28-SCH.DWG	10-18-96
DDA	9610-B
S	3
STATION No. 28	


DWG: L:\381-cjrr\RECORDS\STRU\28-5-2.DWG USER: numerical
 DATE: Jan 14, 2008 2:19pm REC.DWG.LA RECORD.JAT.C IMAGES: T328-5-3.TIF

RECORD DRAWING


THIS RECORD DRAWING HAS BEEN PREPARED BASED ON A COMBINATION OF INFORMATION PROVIDED BY OTHERS AND BY CDM. THEREFORE, THE ENGINEER HAS NOT VERIFIED THE ACCURACY OF ALL THE INFORMATION. TO THE BEST OF THE ENGINEER'S BELIEF AND KNOWLEDGE, THE INCLUDED RECORD INFORMATION IS REASONABLY ACCURATE.

By _____ Date December 2007


CDM

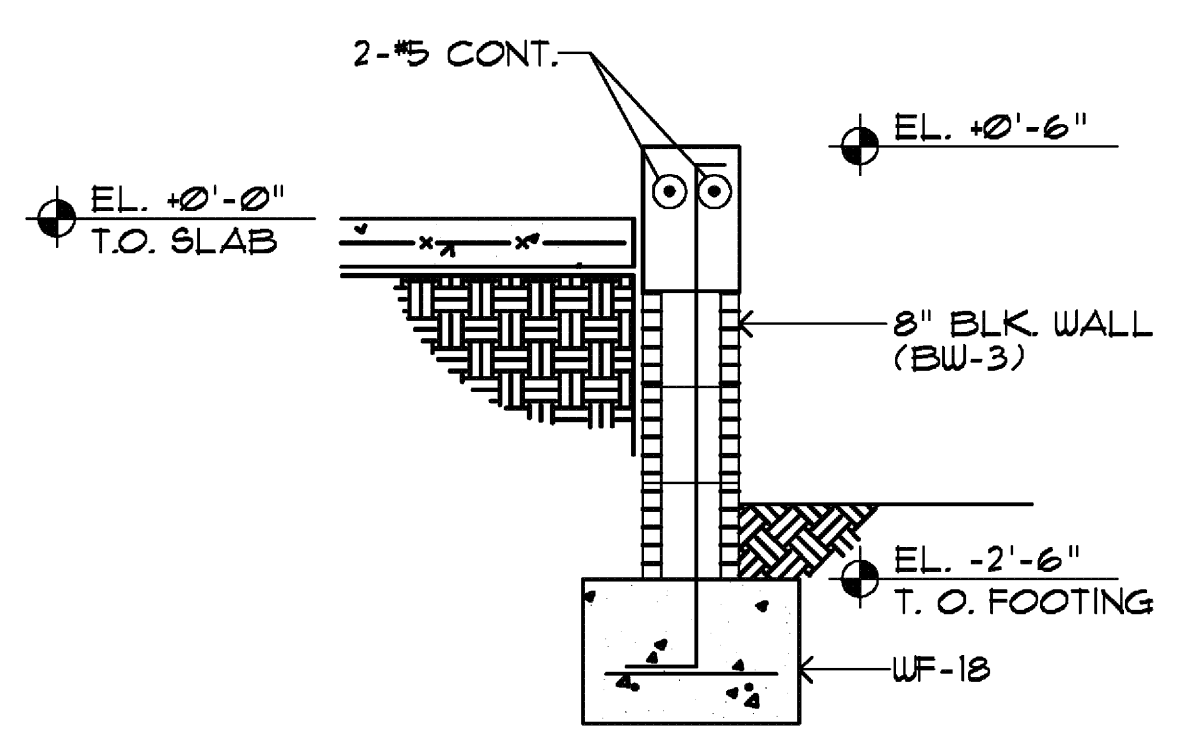

A DETAIL
S-4 SCALE: 3/4" = 1'-0"

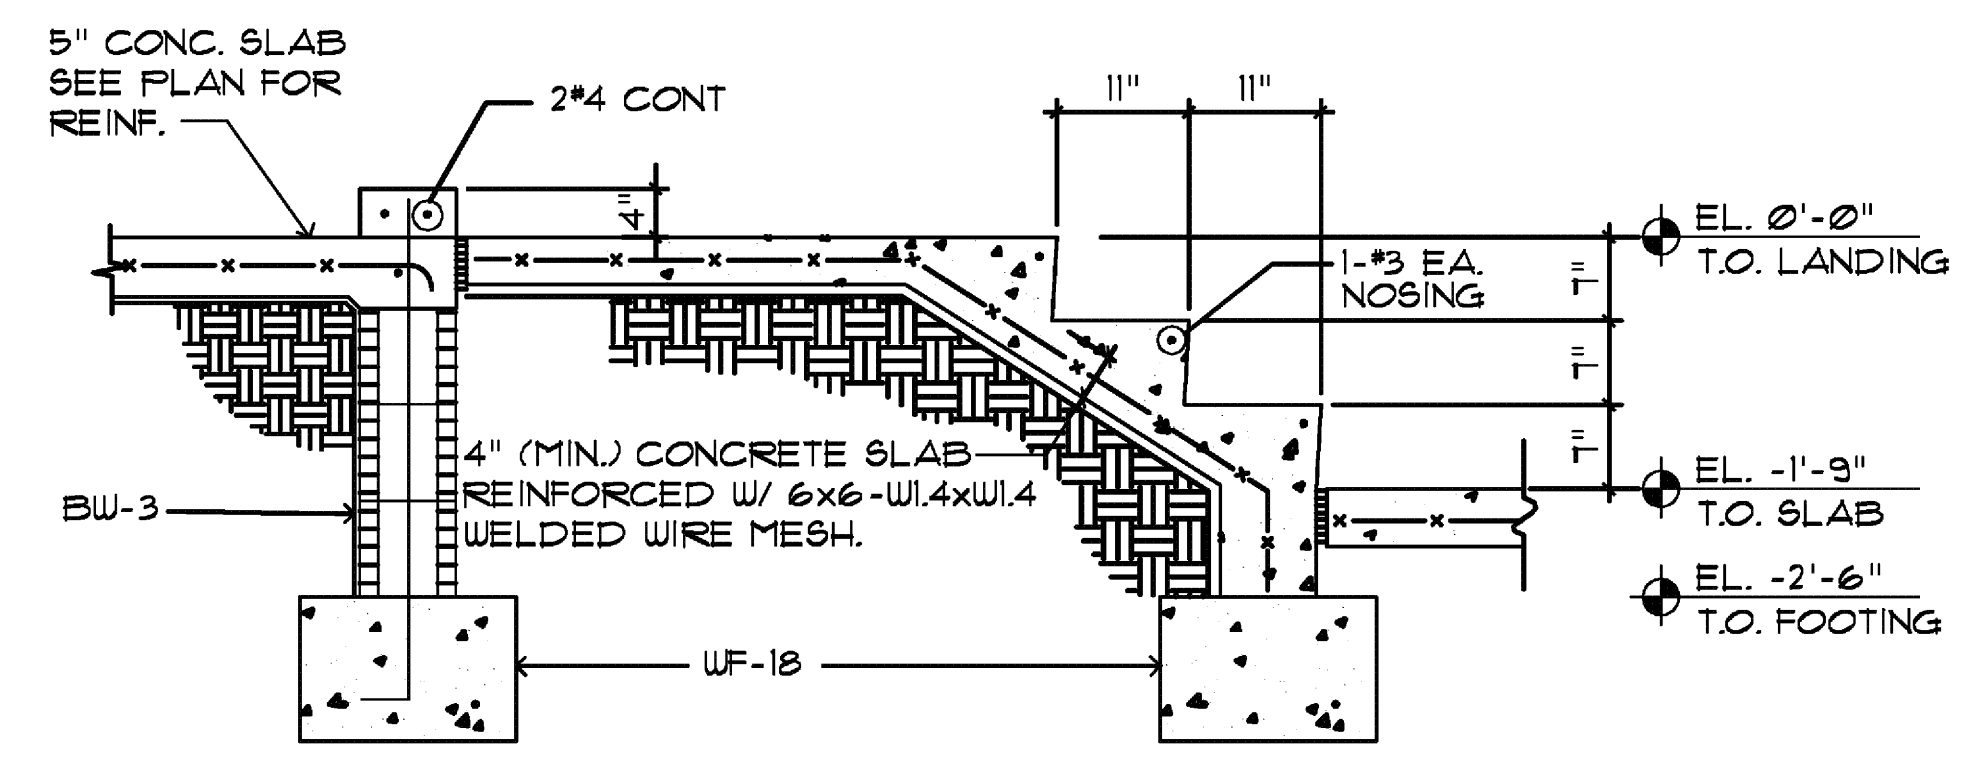

5 SECTION
S-4 SCALE: 3/4" = 1'-0"

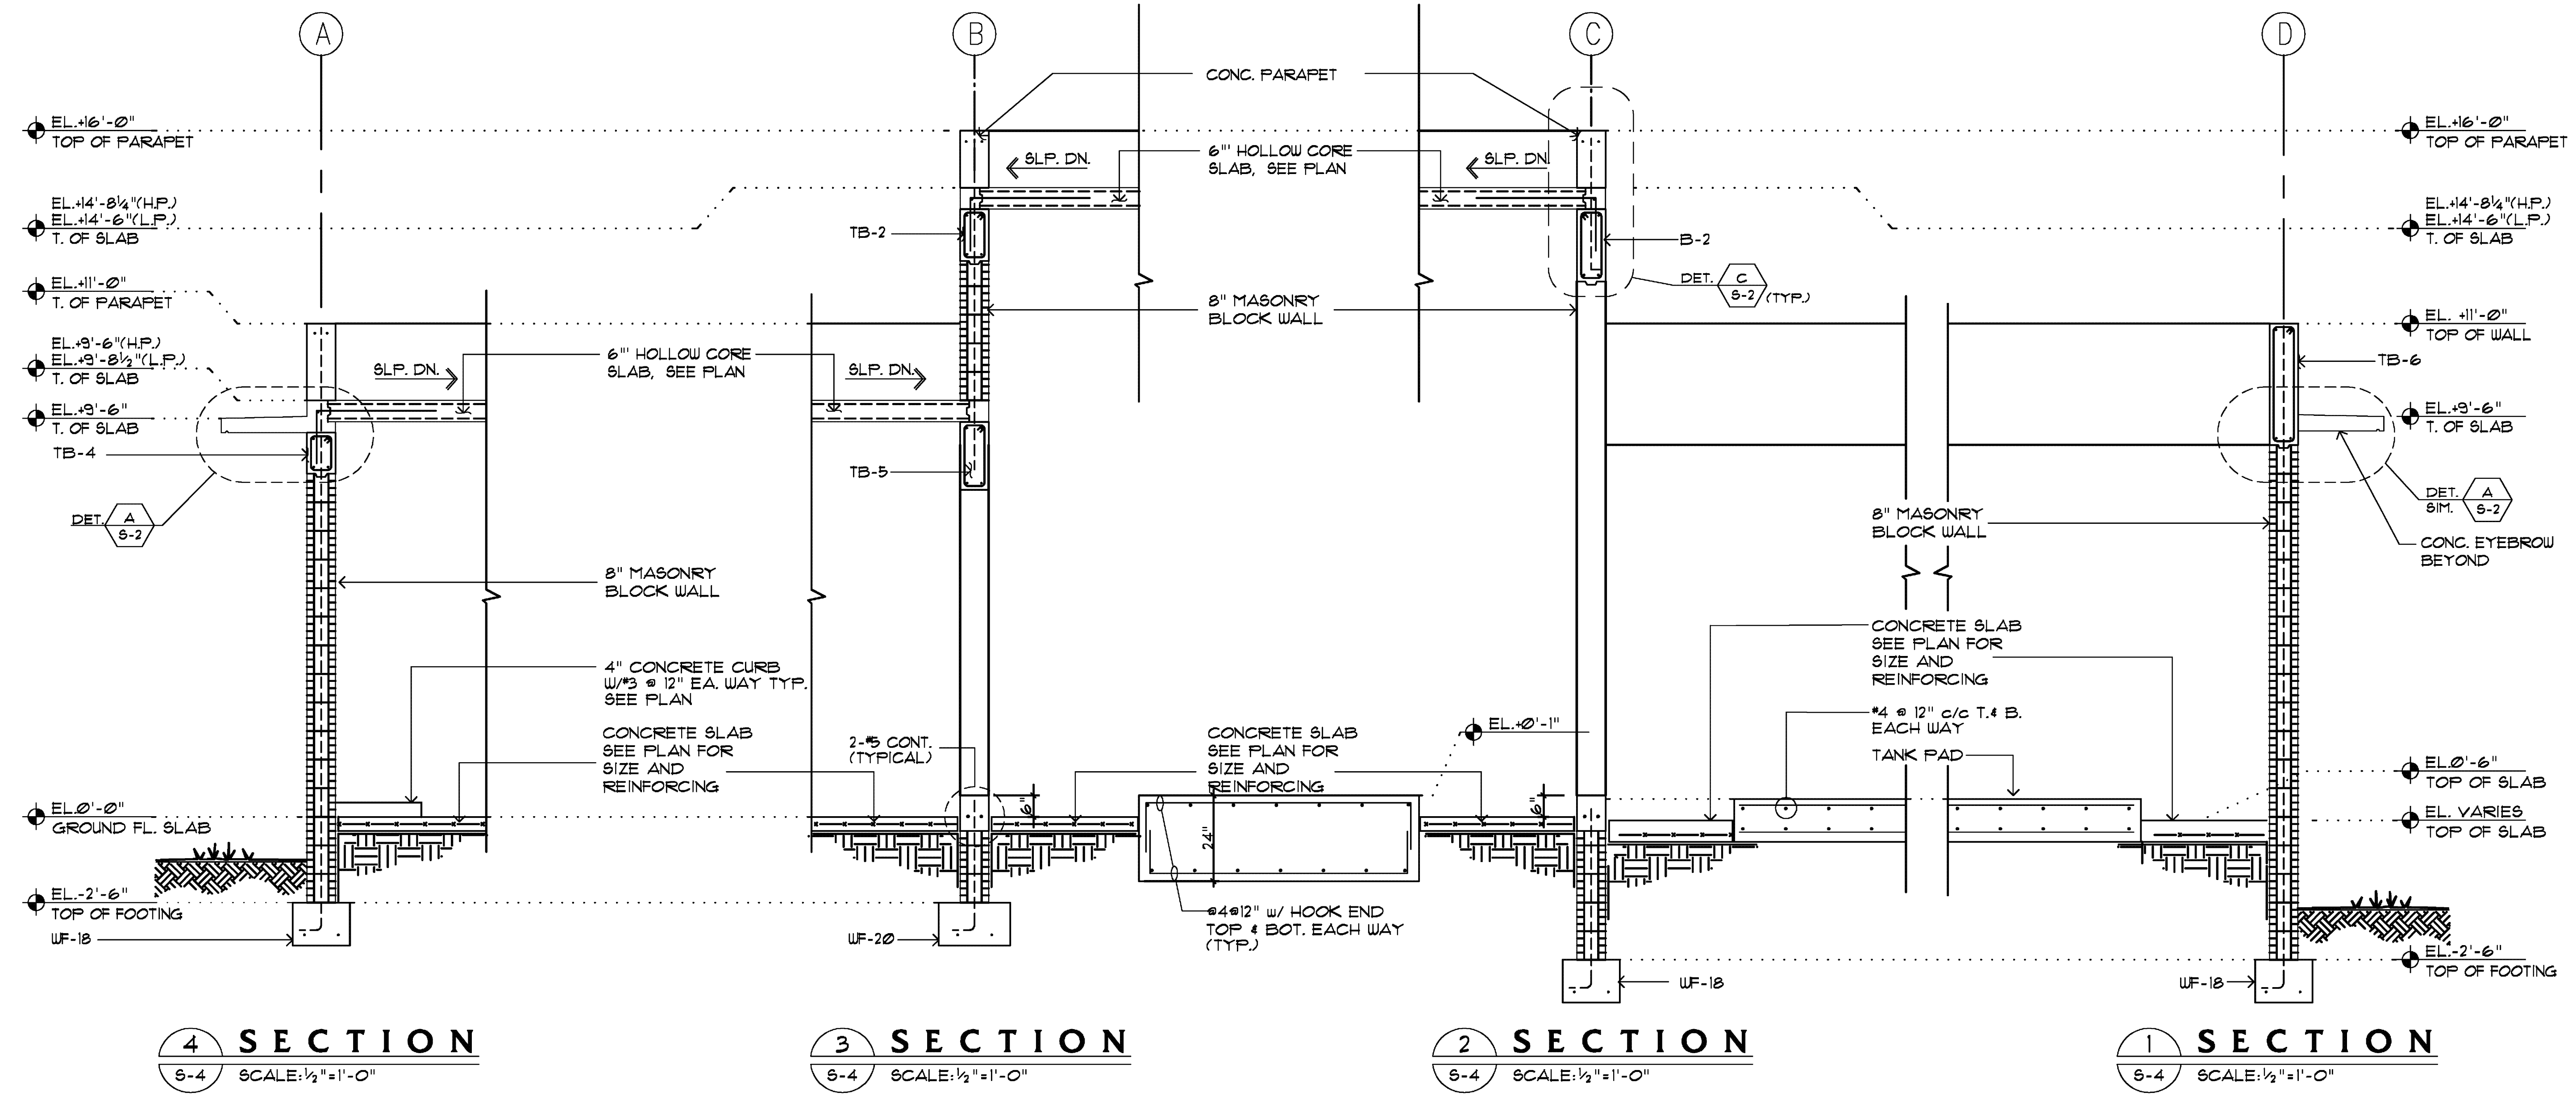

4 SECTION
S-4 SCALE: 1/2" = 1'-0"

3 SECTION
S-4 SCALE: 1/2" = 1'-0"

2 SECTION
S-4 SCALE: 1/2" = 1'-0"

1 SECTION
S-4 SCALE: 1/2" = 1'-0"

DONNELL DUQUESNE & ALBAISA, P.A.
CONSULTING ENGINEERS
RAMON R. DONNELL P.E. 0011890
PEDRO J. DUQUESNE P.E. 0022764
AIDA M. ALBAISA P.E. 0045130
4830 S.W. 74th CT. MIAMI, FLORIDA 33155
(305) 666-0711

City of Miami Beach

zyscovich
100 N. BISCAYNE BLVD., SUITE 1400 MIAMI FL 33132
T 305 372 8222 F 305 577 4521
CS 73527, 2250

Pump Station
No. 28
28th Street and Sheridan Avenue, Miami Beach

COPYRIGHT 1996 ZYSKOVICH, INC. ALL RIGHTS RESERVED. THESE DRAWINGS AND SPECIFICATIONS ARE HEREBY PROVIDED TO YOU AS THE PROPERTY OF ZYSKOVICH, INC. NEITHER THE PRODUCT NOR ANY PART THEREOF IS TO BE REPRODUCED OR TRANSMITTED IN ANY FORM OR BY ANY MEANS, ELECTRONIC OR MECHANICAL, INCLUDING PHOTOCOPYING, RECORDING, OR BY ANY INFORMATION STORAGE AND RETRIEVAL SYSTEM, WITHOUT THE WRITTEN CONSENT OF ZYSKOVICH, INC. IS FORWARDED.

CONFORMED FEB 99

Section Plan
RECORD DRAWINGS

Revised: ADDENDUM No 2 AS APPLICABLE
Revised: ADDENDUM No 3, CONFORMED
Revised: REPROCUREMENT JAN. 03
Revised: RECORD DRAWING 12/07

P28-SEC.DWG	10-18-96
DDA	9610-B

S 4
STATION No. 28

DWG: L:\381-039\RECORD\STRU\28-5-4.dwg USER: rursesi REC.DWG.LA
 DATE: Jan 14, 2008 2:41pm XREFS: FIL-51.dwg
 IMAGES: T528-S-4.TIF RECORD_A1.T.C

GENERAL NOTES

DESIGN CRITERIA CODES:

- SOUTH FLORIDA BUILDING CODE (LATEST EDITION)
- SANITARY STRUCTURES: ACI 350R "CONCRETE SANITARY ENGINEERING STRUCTURES"
- OTHER STRUCTURES: ACI 318 "BUILDING CODE REQUIREMENTS FOR REINFORCED CONCRETE"
- AISC MANUAL OF STEEL CONSTRUCTION, NINTH EDITION

DESIGN LIVE LOADS:

- PROCESS RELATED STRUCTURES:

STAIRWAYS	150	PSF
PROCESS SLABS	200	PSF
STORAGE AREAS	300	PSF

SUPERIMPOSED DEADLOADS

- ROOFS AS NOTED
- FLOORS AS NOTED

WINDLOADS

- BASIC WIND SPEED 110 MPH
- DESIGN PRESSURES: PER SBCI SECTION 1205 REQUIREMENTS

EARTHQUAKE N.A.

CONCRETE 28-DAY STRENGTH

- COLUMNS, BEAMS, SLABS, WALLS, FOOTINGS 4000 PSI
- MASONRY FILLED CELL GROUT 3000 PSI

REINFORCING STEEL

- ALL BARS ASTM A615, GRADE 60
- WELDED WIRE FABRIC ASTM A185

STRUCTURAL STEEL

- ALL STRUCTURAL AND MISC. STEEL UNLESS NOTED: A36
- SHOP AND FIELD WELD: E70XX ELECTRODES

FOUNDATIONS

- ALLOWABLE BEARING PRESSURE FOR SPREAD FOOTINGS OVER SUBSURFACE PREPARED AS PER SPECIFICATIONS: 1500 PSF

GENERAL CONDITIONS

ALL STRUCTURAL DRAWINGS SHALL BE USED IN CONJUNCTION WITH THE MECHANICAL, CIVIL, ELECTRICAL, AND SHOP DRAWINGS AND SPECIFICATIONS.

THE CONTRACTOR SHALL REVIEW AND VERIFY DIMENSIONS SHOWN IN ALL PLANS AND REVIEW ALL FIELD CONDITIONS THAT MAY AFFECT THE INSTALLATION OF THE FACILITY. SHOULD DISCREPANCIES APPEAR, THE CONTRACTOR SHALL NOTIFY THE ENGINEER IN WRITING TO OBTAIN ENGINEER'S CLARIFICATION BEFORE COMMENCING WITH THE WORK.

FOR ALL ITEMS EMBEDDED IN OR PASSED THROUGH CONCRETE, THE CONTRACTOR SHALL INITIALLY REFER TO MECHANICAL, HEATING, AND VENTILATION DRAWINGS FOR TYPE, SIZE, LOCATION, AND SPECIAL INSTALLATION REQUIREMENTS FOR THESE ITEMS.

THE CONTRACTOR SHALL TAKE ANY AND ALL NECESSARY MEASURES TO PROTECT EXISTING STRUCTURES FROM DAMAGE WHEN WORKING IN AND AROUND EXISTING STRUCTURES PERFORMING WORK SUCH AS DEMOLITION, FOUNDATION EXCAVATION, AND OTHERS.

SIZE AND LOCATION OF EQUIPMENT PADS AND ANCHOR BOLTS SHALL BE PER EQUIPMENT MANUFACTURERS REQUIREMENTS.

ANY EQUIPMENT THAT MAY INDUCE VIBRATION TO THE STRUCTURE SHALL BE ADEQUATELY ISOLATED FROM THE STRUCTURES.

ALL DETAILS AND SECTIONS SHOWN ON THE DRAWINGS ARE INTENDED TO BE TYPICAL AND SHALL BE CONSTRUCTED TO APPLY TO ANY SIMILAR SITUATION ELSEWHERE ON THE PROJECT, EXCEPT WHERE A DIFFERENT DETAIL IS SHOWN.

STANDARD DETAILS (SHOWN ON SD-1) APPLY TO ALL SIMILAR SITUATIONS ON THE PROJECT, EXCEPT WHERE A DIFFERENT DETAIL IS SHOWN.

CONCRETE

ALL MATERIALS AND METHODS OF CONSTRUCTION SHALL BE IN ACCORDANCE WITH ACI 318 REQUIREMENTS.

ALL CONCRETE SHALL BE AIR-ENTRAINED WITH 4000 PSI COMPRESSIVE STRENGTH AT 28 DAYS.

WATER REDUCING AGENT SHALL BE IN ACCORDANCE WITH ASTM C494.

ALL CONCRETE SURFACES EXPOSED TO AIR, UNLESS OTHERWISE NOTED IN SPECIFICATIONS, SHALL BE TREATED WITH AN APPROPRIATE CURING COMPOUND AS SOON AS CEMENT FINISHING IS COMPLETED OR FORMS ARE REMOVED.

ALL EXPOSED CORNERS OF CONCRETE SHALL HAVE A MINIMUM CHAMFER OF 3/4" UNLESS OTHERWISE NOTED.

THE CONTRACTOR SHALL OBTAIN ENGINEER'S APPROVAL FOR THE LOCATION OF CONSTRUCTION JOINTS THAT ARE NOT SHOWN ON THE DRAWINGS.

REINFORCING STEEL

REINFORCEMENT SHALL CONFORM TO ASTM A615, GRADE 60 REQUIREMENTS. ALL ACCESSORIES SHALL BE IN CONFORMANCE WITH ACI 315 REQUIREMENTS. REINFORCING STEEL SHALL HAVE THE FOLLOWING CLEAR COVER UNLESS OTHERWISE NOTED:

- CONCRETE CAST AGAINST EARTH 3"
- FORMED SURFACES IN CONTACT WITH SOIL, SEWAGE, WATER OR EXPOSED TO WEATHER 2"
- FORMED SURFACES NOT EXPOSED TO WEATHER OR IN CONTACT WITH SOIL:
 - SLABS, WALLS, AND JOISTS 3/4"
 - BEAMS AND COLUMNS 1 1/2"

LAP SPLICES SHALL BE AS SHOWN ON THE DRAWINGS. FOR LAP SPLICES NOT SHOWN ON THE DRAWINGS, THE CONTRACTOR SHALL OBTAIN ENGINEERS APPROVAL.

THE CONTRACTOR SHALL PREPARE PLACING DRAWINGS AND SCHEDULES IN CONFORMANCE WITH ACI 315 REQUIREMENTS.

REINFORCED CONCRETE MASONRY UNIT CONSTRUCTION

DESIGN CRITERIA:

- DESIGN COMPRESSIVE STRENGTH OF MASONRY AT 28 DAYS $f_m = 1500$ PSI
- ALLOWABLE STEEL STRESS $f_s = 24,000$ PSI

CONTINUOUS INSPECTION IS REQUIRED FOR ALL MASONRY WORK

ALL MATERIALS AND METHODS OF CONSTRUCTION SHALL BE IN ACCORDANCE WITH DRAWINGS AND SPECIFICATIONS AND:

- THE NATIONAL CONCRETE MASONRY ASSOCIATION "SPECIFICATIONS FOR DESIGN AND CONSTRUCTION OF LOAD BEARING STRUCTURES."
- ACI 531 "BUILDING CODE REQUIREMENTS FOR REINFORCED MASONRY STRUCTURES."

MATERIALS:

- BLOCK: CONFORM TO ASTM C90 - GRADE N, TYPE II TWO-CELL, 8"x8"x16" (COMPRESSIVE STRENGTH, GROSS AREA 1000 PSI)

- MORTAR: CONFORM TO ASTM C270, TYPE S. MINIMUM COMPRESSIVE STRENGTH AT 28 DAYS - 1800 PSI UTILIZE TYPE II CEMENT AND TYPE S LIME. MASONRY CEMENT WILL NOT BE CONSIDERED.

- GROUT: CONFORM TO C476, COARSE GROUT. MINIMUM COMPRESSIVE STRENGTH AT 28 DAYS - 2500 PSI

- STEEL: DUR-O-WAL OR EQUAL JOINT REINFORCEMENT AT EVERY THIRD COURSE (24" O.C.) BOND BEAM AND FILLED CELL REINFORCEMENT AS PER DRAWINGS (ASTM A615, GRADE 60).

CONSTRUCTION

- ALL FILLED CELLS AND COLUMNS SHALL BE POURED AT LEAST TWO (2) HOURS PRIOR TO POURING LINTEL BLOCK OR TIE BEAMS.

- MAX. CONSTRUCTION HEIGHT OF MASONRY WALLS WITHOUT FILLED CELL OR COLUMN JOINTS IS TO BE 8'-0". THE CONCRETE FOR FILLED CELLS SHALL BE RODDED OR Puddled DURING PLACEMENT TO INSURE COMPLETE FILLING TO THE BLOCK CORE.

- SEE STANDARD DETAILS AND ARCHITECTURAL DRAWINGS FOR LINTEL REQUIREMENTS OVER OPENINGS.

- PROVIDE CLEAN OUT AND INSPECTION BLOCK OUTS IN CELLS CONTAINING REINF.


FLOTATION CONSIDERATION:

STRUCTURES WERE DESIGNED TO BE NON-BUOYANT AFTER THE STRUCTURE IS PLACED INTO SERVICE. THEREFORE, THE STRUCTURE MAY BE BUOYANT DURING CONSTRUCTION. GENERAL CONTRACTOR SHALL PROTECT ALL STRUCTURES (NEW AND EXISTING) FROM FLOTATION DURING CONSTRUCTION, REGARDLESS OF GROUND WATER LEVELS, UNTIL STRUCTURES ARE PLACED IN OPERATION.

ABBREVIATIONS:


ALUM	ALUMINUM	MAT'L	MATERIAL
BLDG	BUILDING	MAX	MAXIMUM
BOT	BOTTOM	MIN	MINIMUM
CJ	CONTROL JOINT	MISC	MISCELLANEOUS
CMU	CONCRETE MASONRY UNIT	NF	NEAR FACE
CONC	CONCRETE	NTS	NOT TO SCALE
CONST JT	CONSTRUCTION JOINT	OC	ON CENTER
CONT	CONTINUOUS	PLF	POUNDS PER LINEAR FOOT
DIA	DIAMETER	PROJ	PROJECTION
DWG	DRAWING	PSF	POUNDS PER SQUARE FOOT
EJ	EACH FACE	PSI	POUNDS PER SQUARE INCH
EF	EXPANSION JOINT	SPECS	SPECIFICATIONS
EL	ELEVATION	SS	STAINLESS STEEL
EW	EACH WAY	STD	STANDARD
FF	FAR FACE	REINF	REINFORCEMENT
FTG	FOOTING	T&B	TOP AND BOTTOM
HORIZ	HORIZONTAL	T/STRUCTURE	TOP OF STRUCTURE
HP	HIGH POINT	TYP	TYPICAL
ID	INSIDE DIAMETER	UN	UNLESS NOTED
LP	LOW POINT	VERT	VERTICAL
		WWF	WELDED WIRE FABRIC

NOTE: THESE ABBREVIATIONS ARE FOR USE ON STRUCTURAL DRAWINGS ONLY

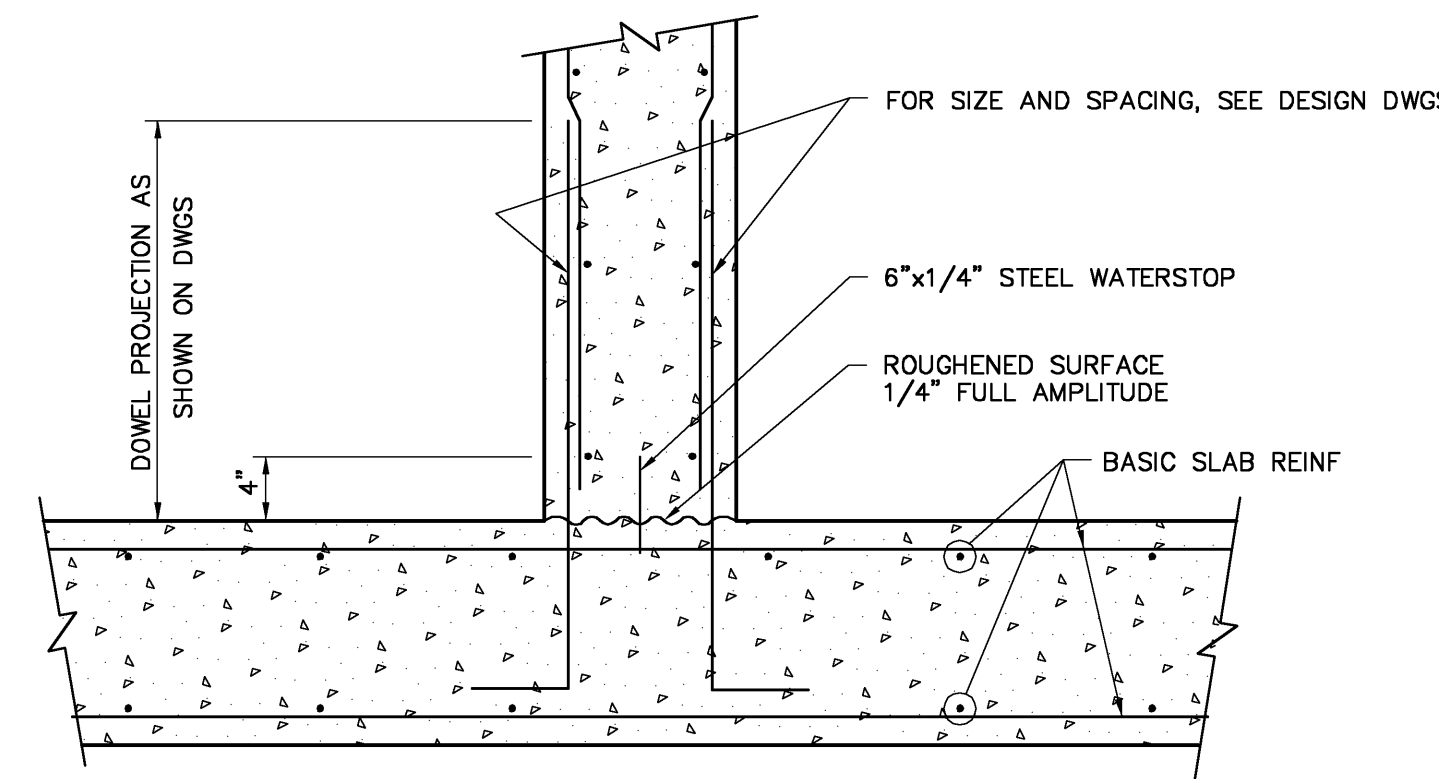


WALL BASE CONSTRUCTION JOINT

DETAIL A
NTS

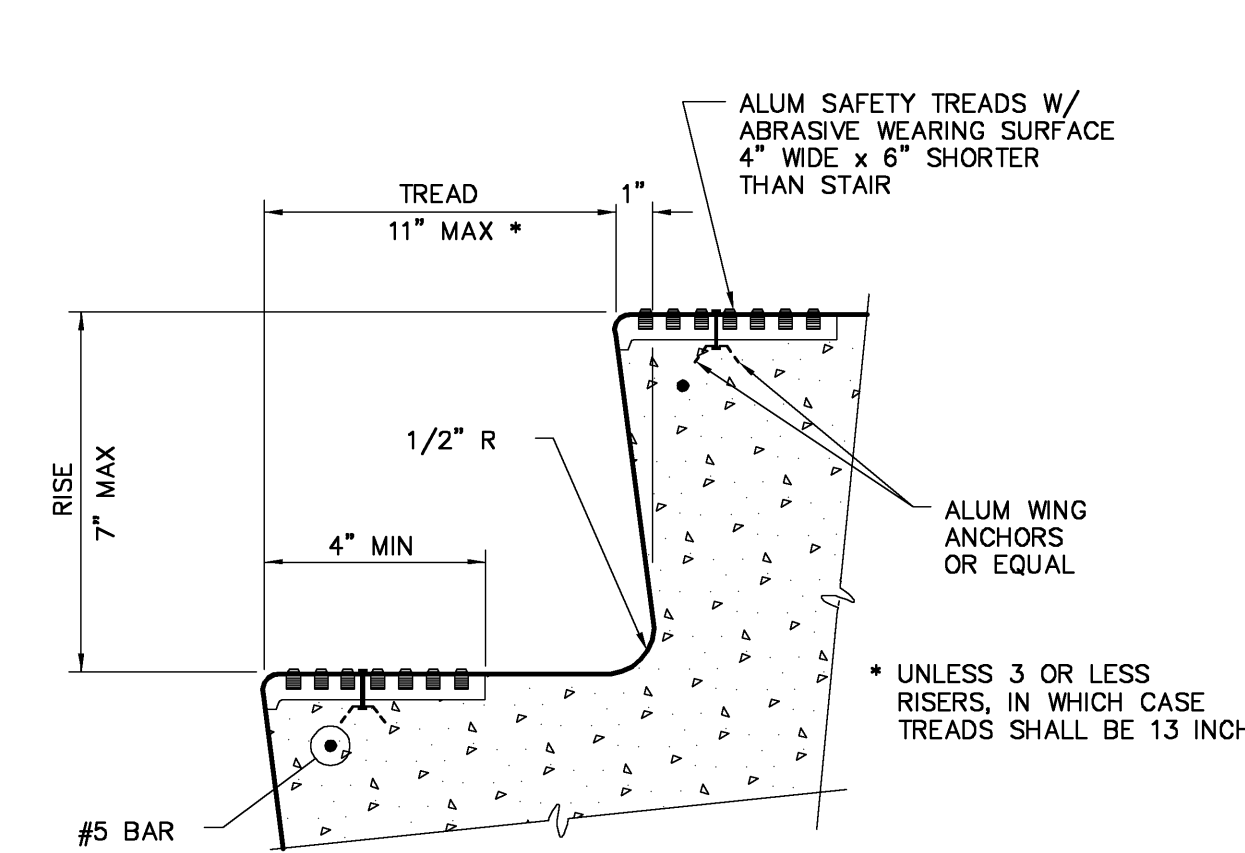


EMBEDDED SAFETY TREAD

DETAIL B
NTS

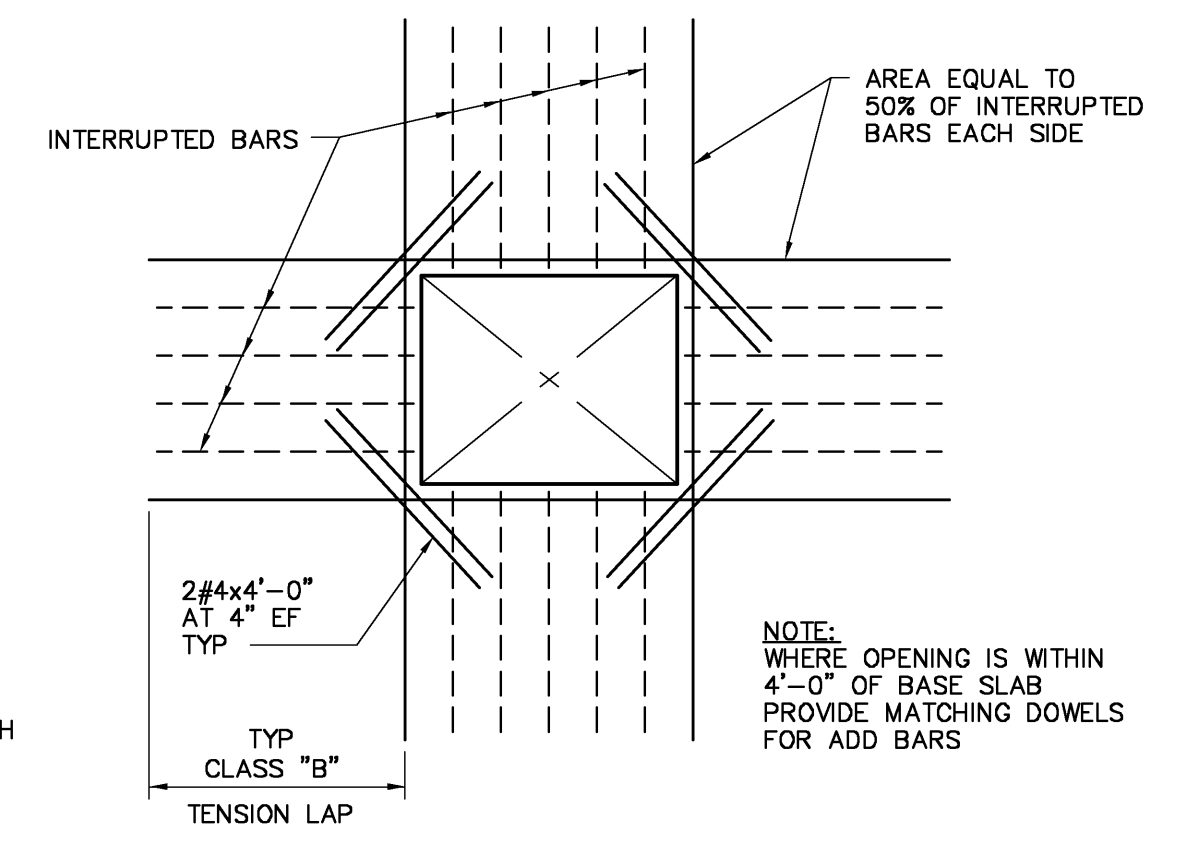


REIN AT RECTANGULAR OPENINGS GREATER THAN 12"

DETAIL C
NTS

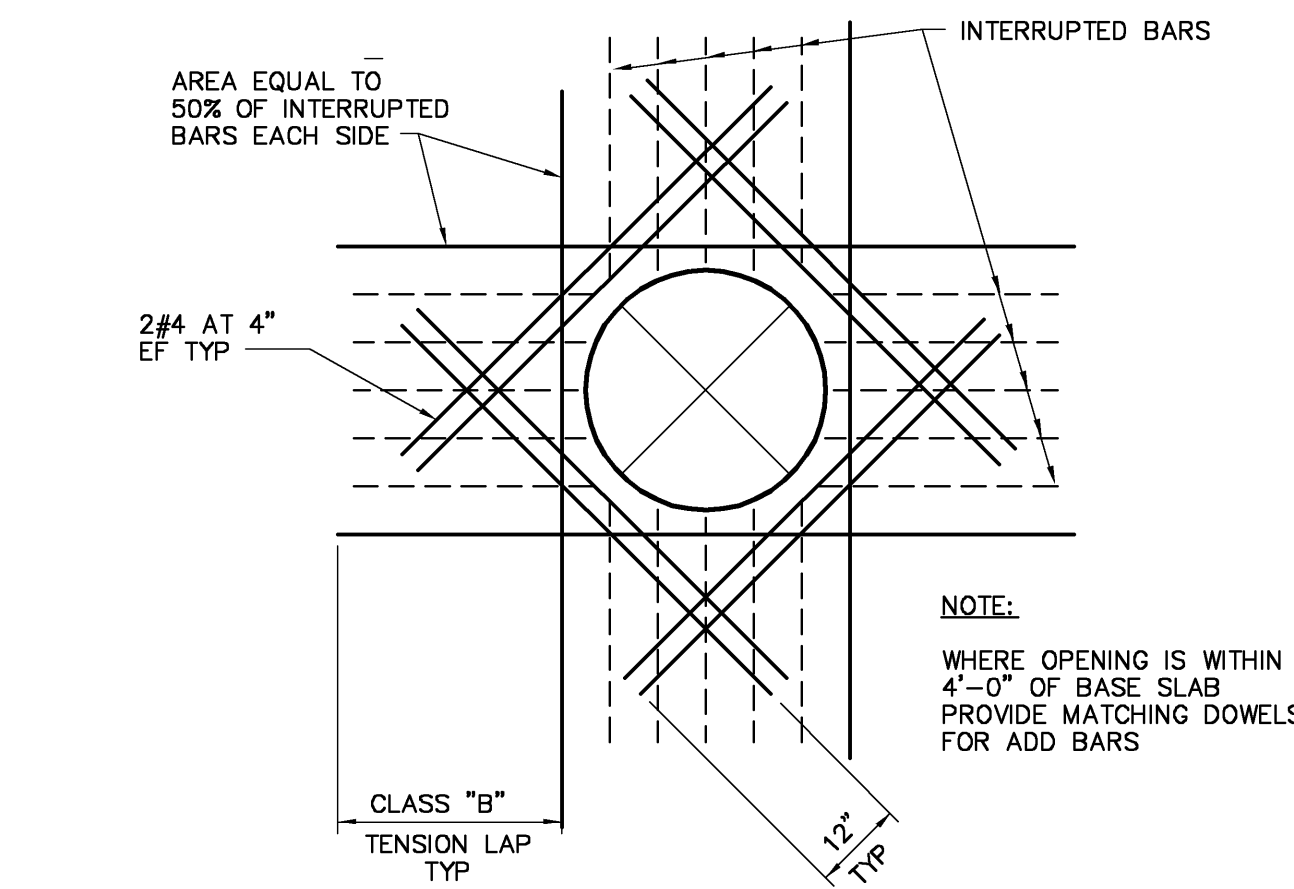


REINFORCING AT CIRCULAR OPENINGS GREATER THAN 12"

DETAIL D
NTS

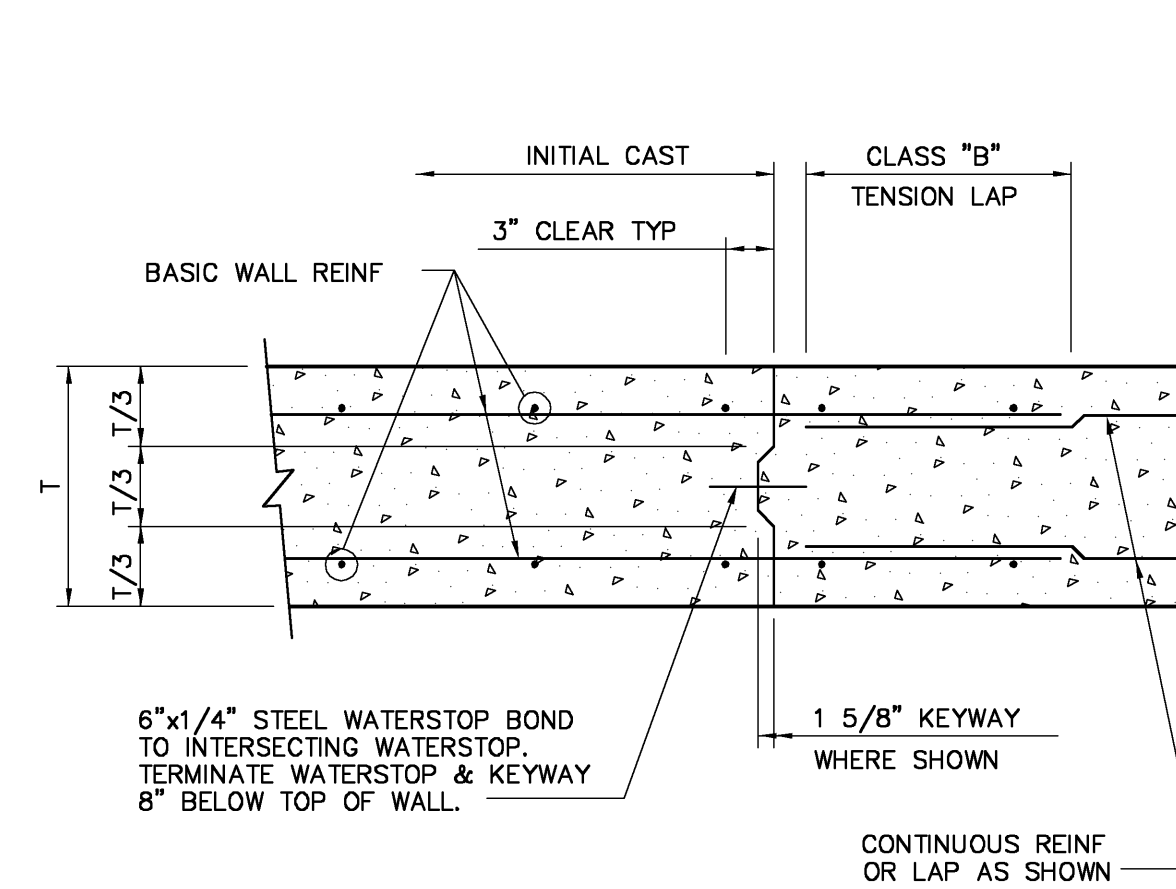


WALL CONSTRUCTION JOINT

DETAIL E
NTS

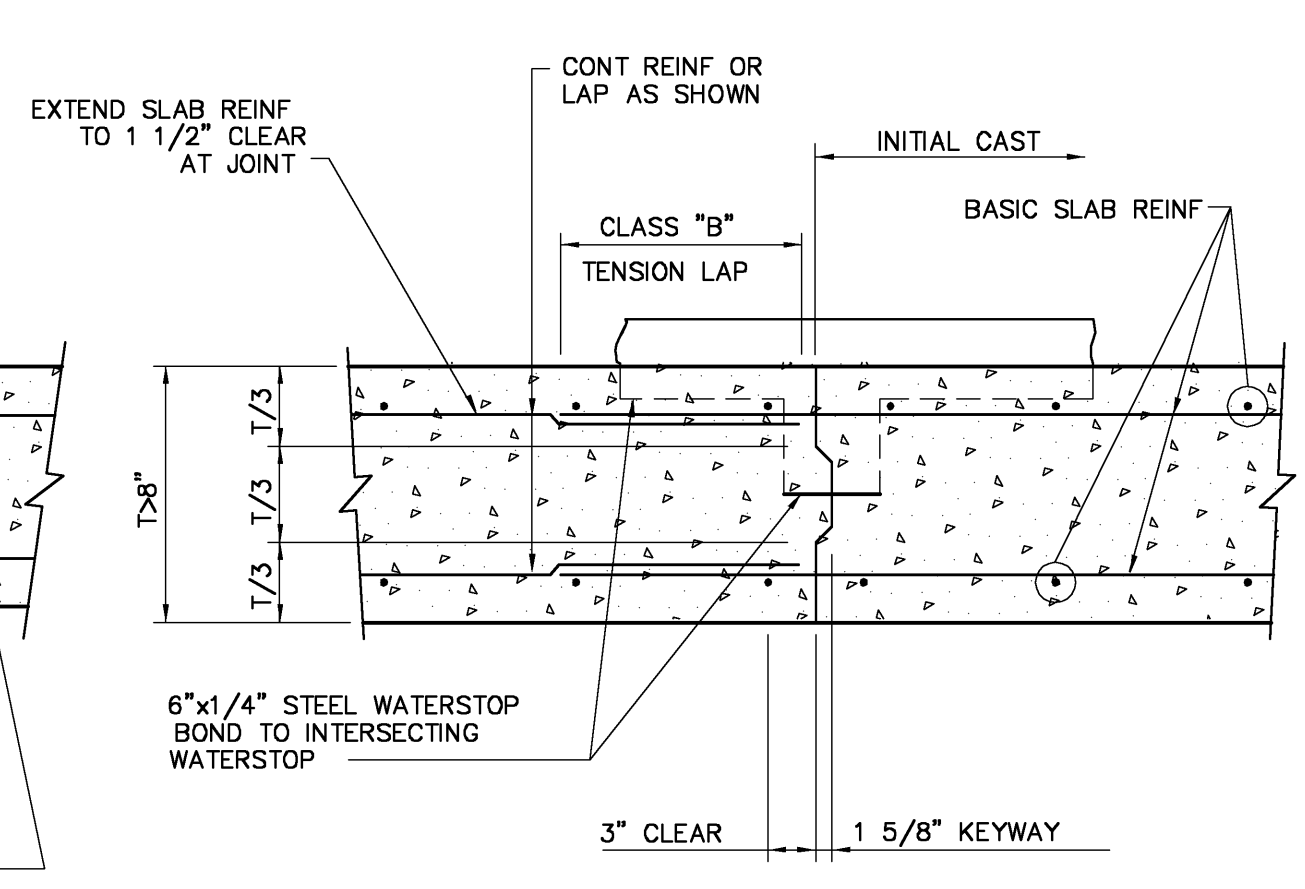


BASE/ELEVATED SLAB CONSTRUCTION JOINT

DETAIL F
NTS

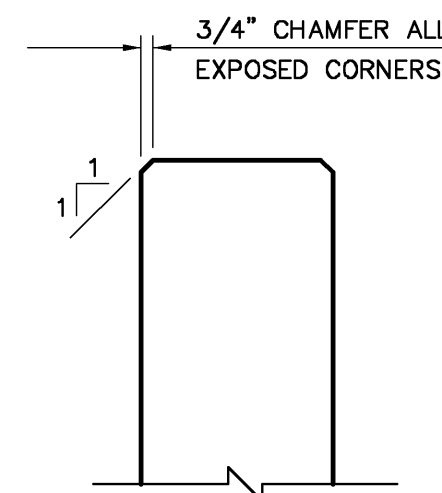


CHAMFER

DETAIL G
NTS

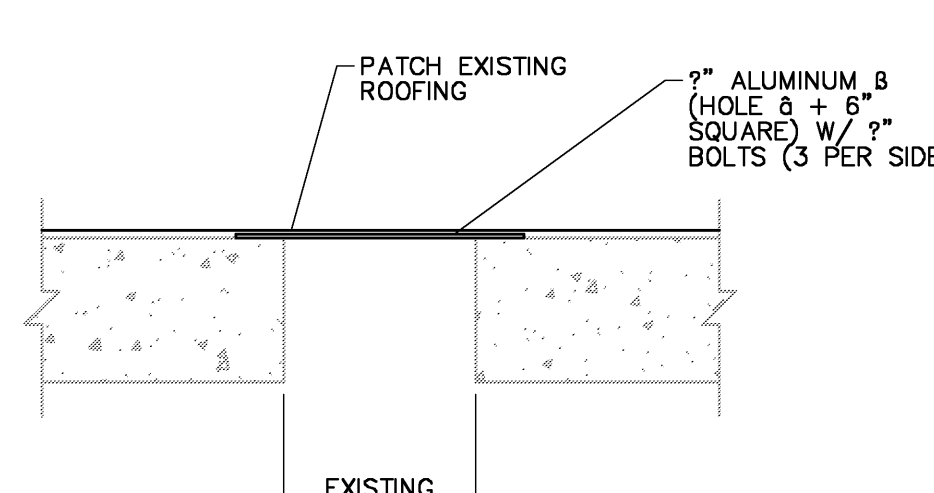


HOLE REPAIR

DETAIL H
NTS

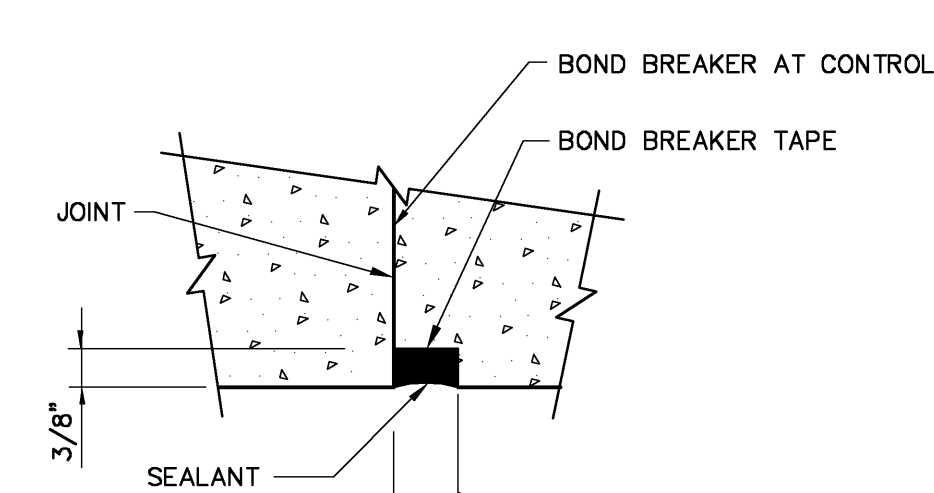

JOINT SEALANT

DETAIL I
NTS

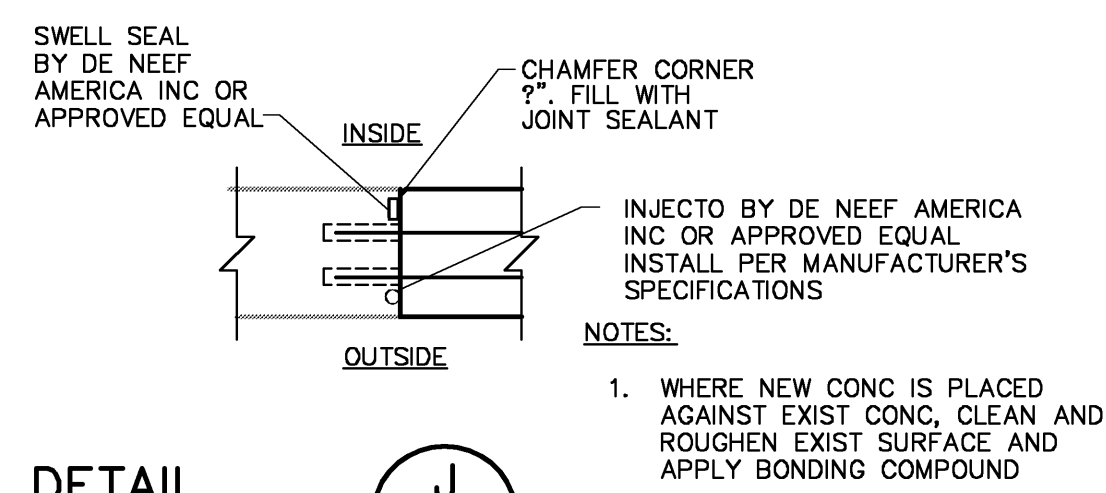

DETAIL J
NTS

RECORD DRAWING

THIS RECORD DRAWING HAVE BEEN PREPARED BASED ON A COMBINATION OF INFORMATION PROVIDED BY OTHERS AND BY CDM. THEREFORE, THE ENGINEER HAS NOT VERIFIED THE ACCURACY OF ALL THE INFORMATION. TO THE BEST OF THE ENGINEER'S BELIEF AND KNOWLEDGE, THE INCLUDED RECORD INFORMATION IS REASONABLY ACCURATE.

By _____ Date December 2007



TIMOTHY A. VERWEY, P.E.
NO. 50947

DESIGNED BY: D. PANDELIN	CAMP DRESSER & MCKEE INC.
DRAWN BY: D. PANDELIN	800 Brickell Avenue, Suite 710
SHEET CHK'D BY: B. EREL	Miami, Florida 33131
CROSS CHK'D BY: J. GOLDMAN	Tel: 305-372-7171
APPROVED BY:	FI COA No. EB-0000020
DATE: MAY 1998	




12/07	PCS	TAV	RECORD DRAWINGS
12/02	RAP	TAV	REVISED DETAIL "B"
3/99	RAP	TAV	CONFORMED

CITY OF MIAMI BEACH, FLORIDA
WATER AND WASTEWATER SYSTEM IMPROVEMENTS


PROJECT NO. 9381-002R
SHEET NO. SD-1
SHEET 86 OF 311



environmental engineers, scientists, planners, & management consultants

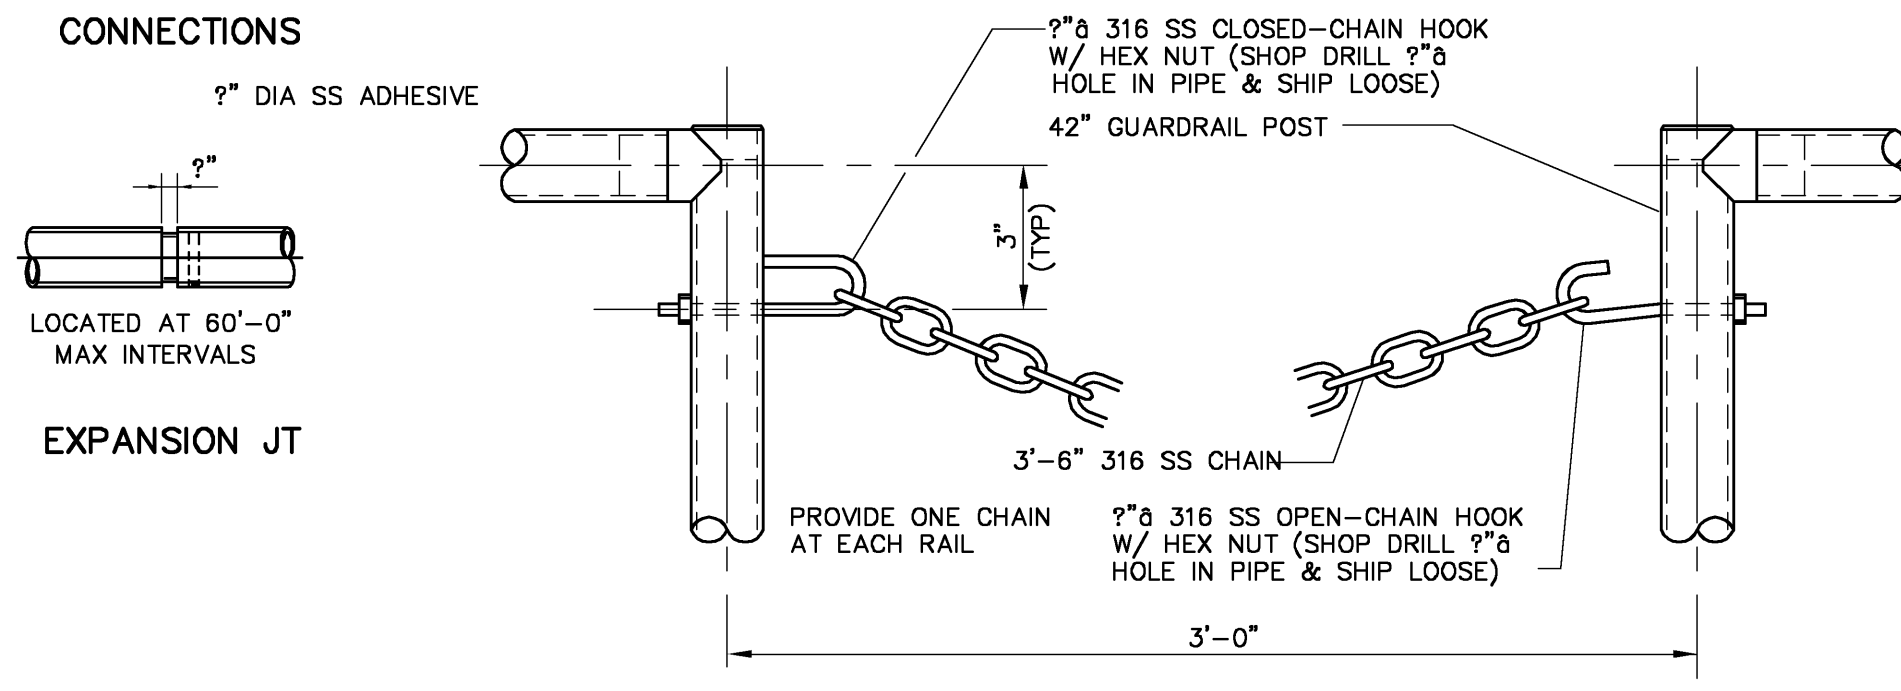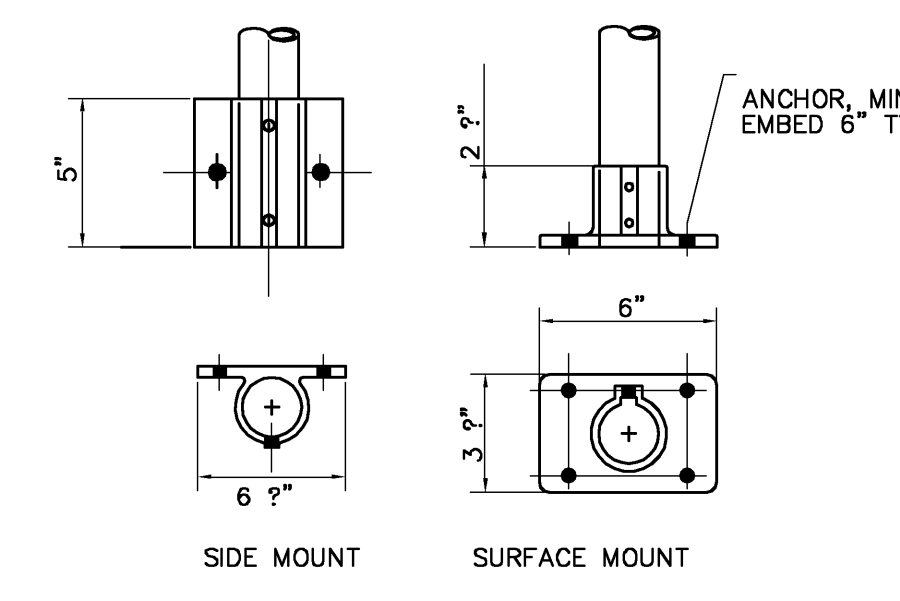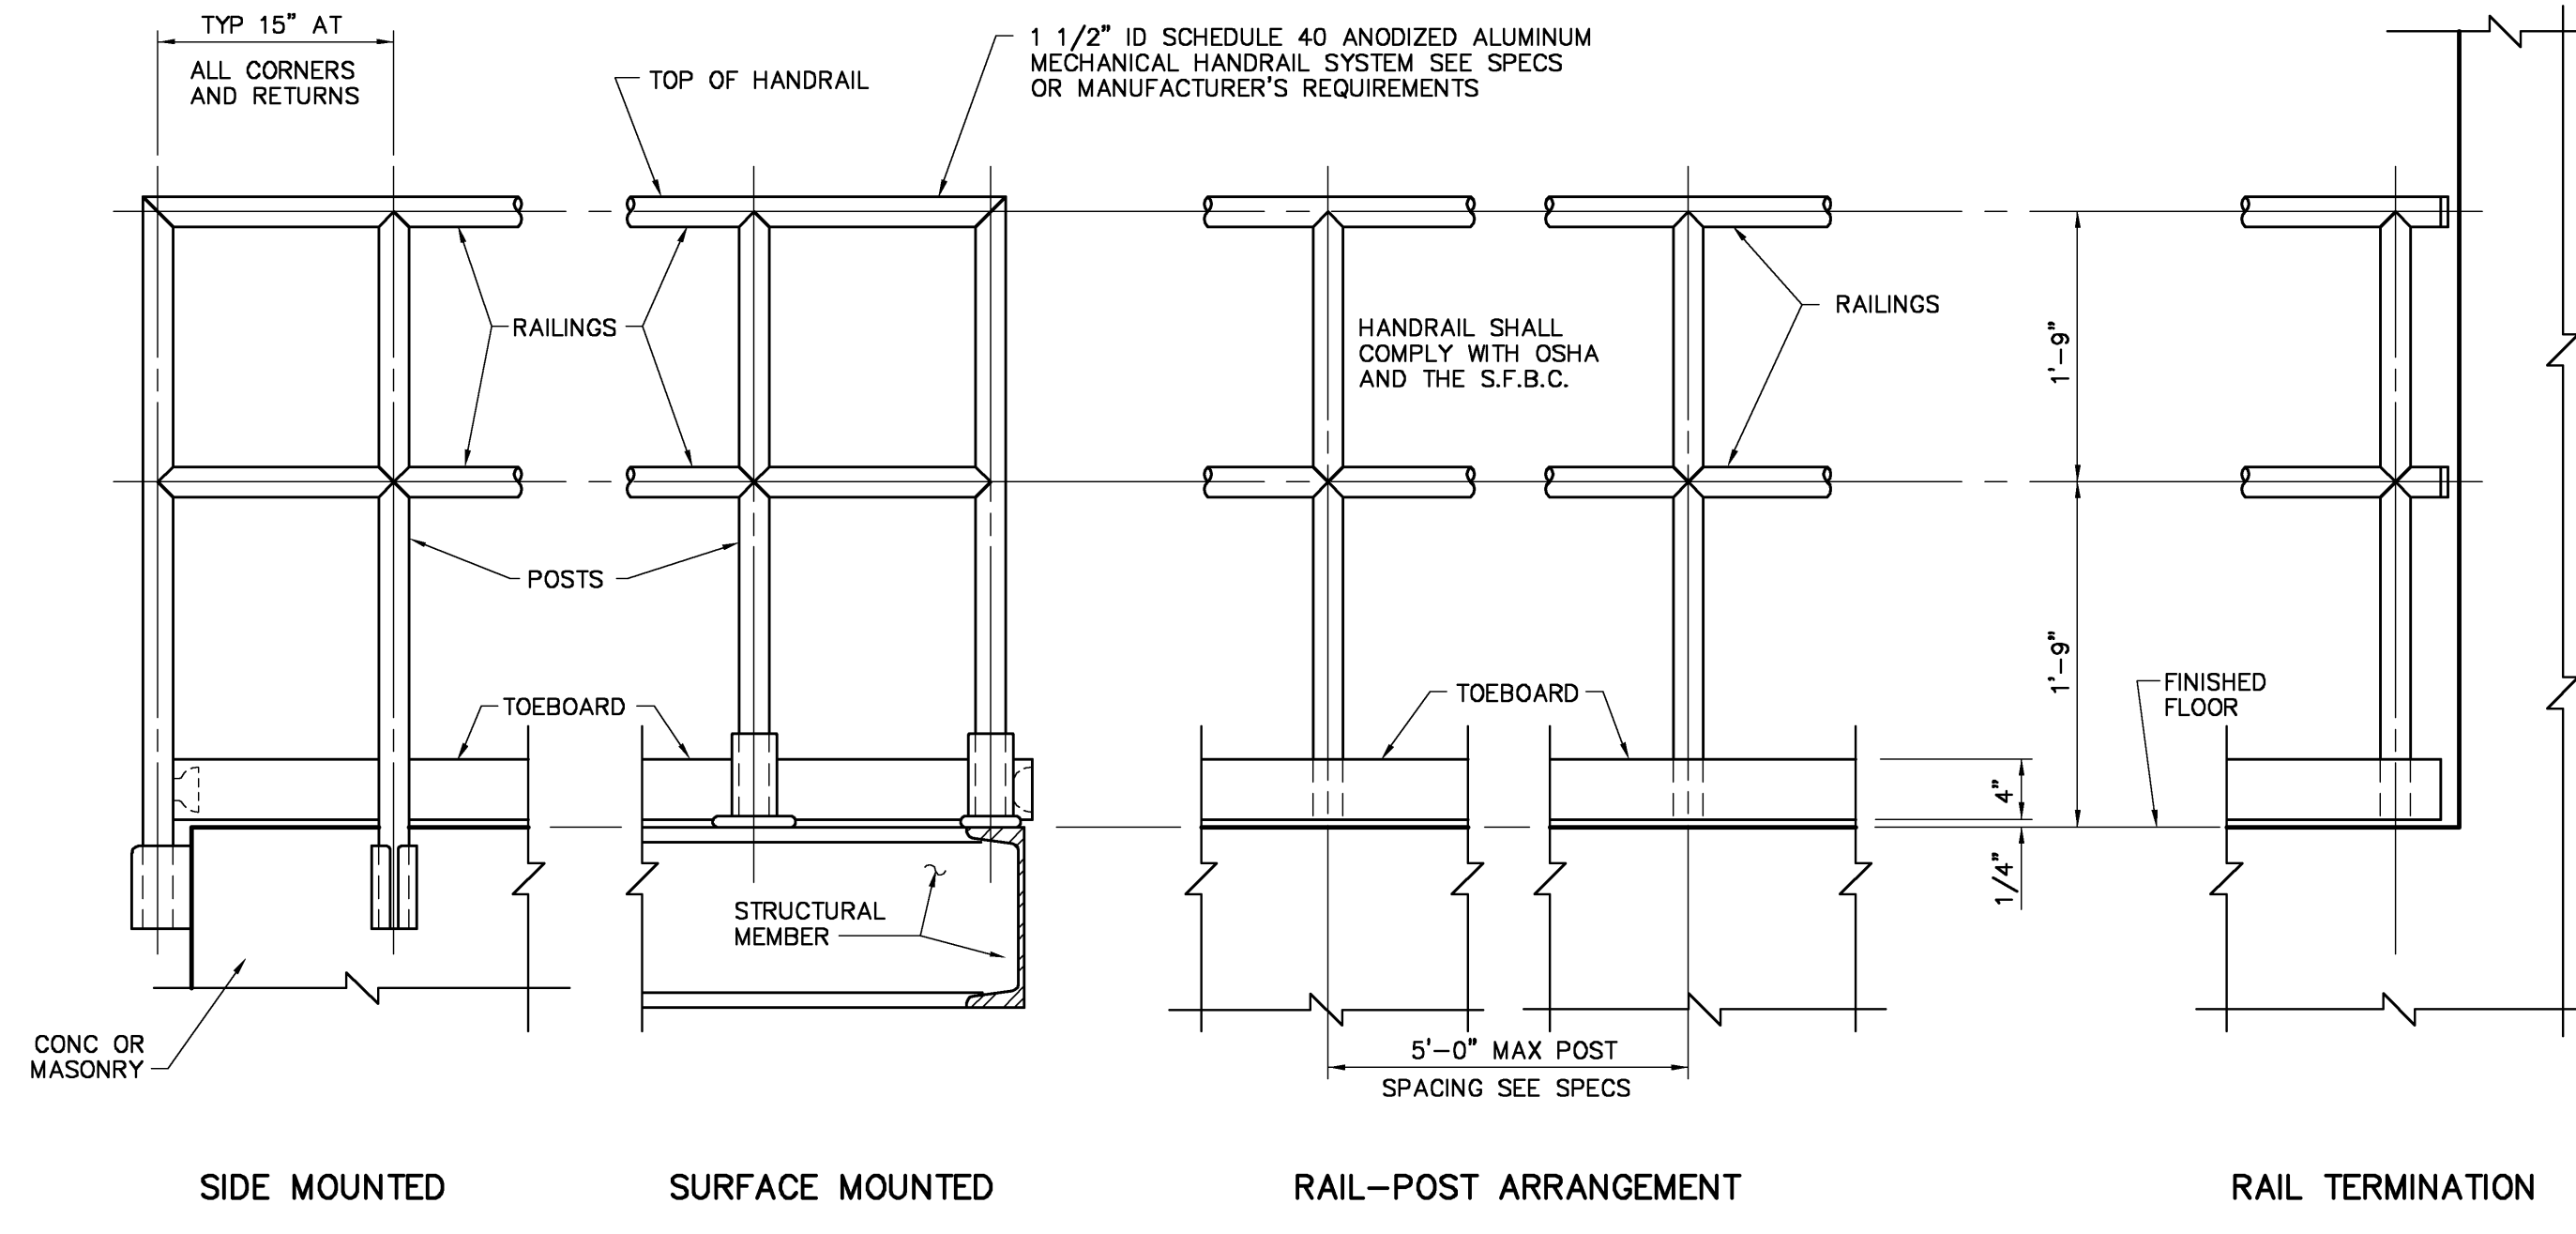

- NOTES**
- ALUMINUM EMBEDDED IN CONCRETE MUST BE PAINTED WITH ONE SHOP COAT OF HEAVY BITUMASTIC.
 - ALUMINUM SHAPES IN CONTACT WITH CONCRETE MUST BE SEPARATED BY A 1/32" NEOPRENE GASKET OR ANY CASE WHERE TWO DIFFERENT METALS ARE TO BE IN CONTACT. A NEOPRENE GASKET MUST BE PROVIDED.
 - HANDRAILS, GUARDRAILS, POSTS, BRACKETS AND MOUNTINGS SHALL MEET THE SOUTH FLORIDA BUILDING CODE (S.F.B.C.) AND OCCUPATIONAL SAFETY AND HEALTH ADMINISTRATION (OSHA) LOADING REQUIREMENTS.
 - TOP OF ALL GUARDRAILS SHOULD BE 42" HIGH ABOVE THE FINISH FLOOR OR WALKWAY, THE INTERMEDIATE RAILS SHALL BE EQUALLY SPACED BETWEEN THE TOP RAIL AND THE TOEBOARD.
 - ALL WALKWAYS SHALL USE GRATING UNLESS CHECKERED PLATE IS SHOWN ELSEWHERE ON THE DRAWINGS.

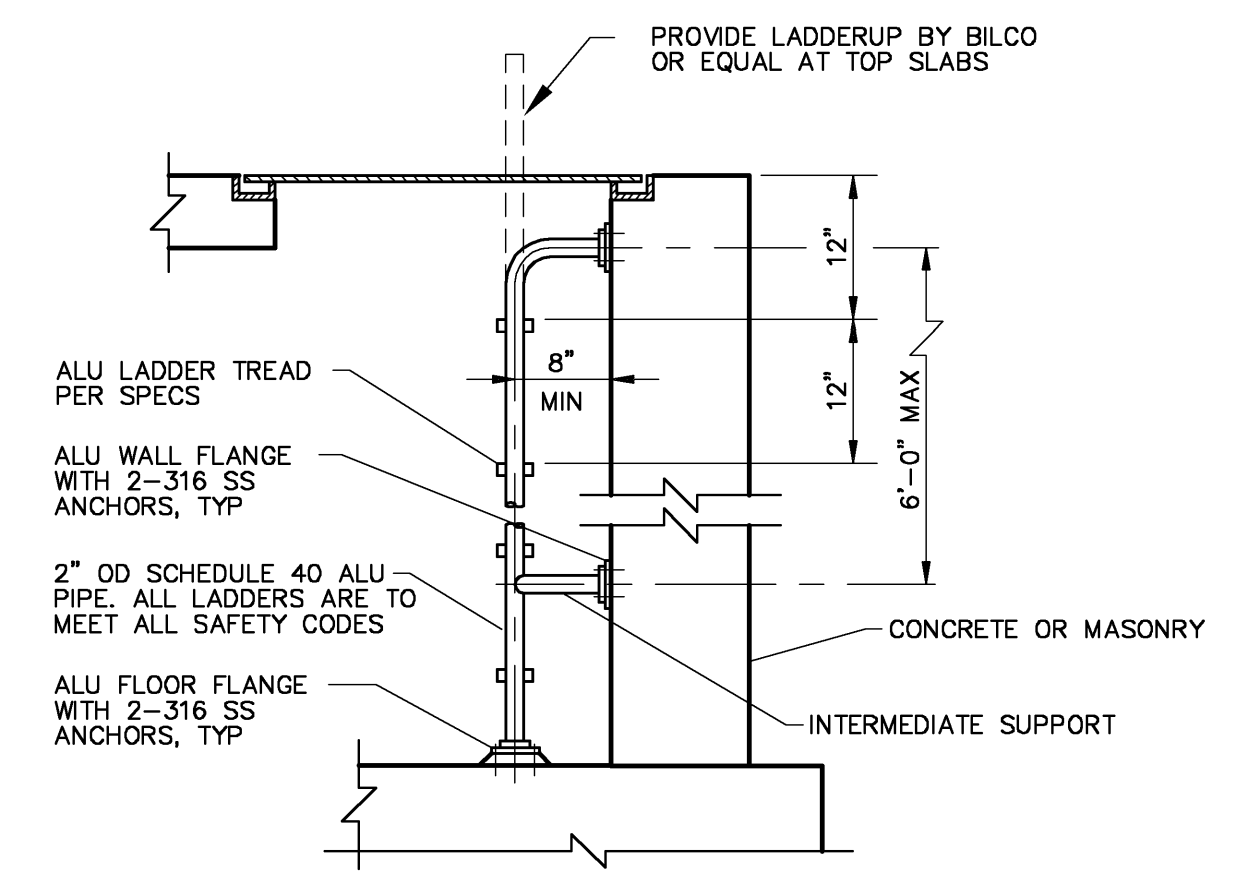


TYPICAL HANDRAIL & GUARDRAIL APPLICATIONS

DETAIL A
NTS


NOTE:
INTERIOR OF PUMP STATIONS ONLY. SEE SHEET A-22 FOR EXTERIOR HANDRAILS.

CHAIN OPENING HOOK
DETAIL B
NTS


ALUMINUM LADDER
DETAIL C
NTS

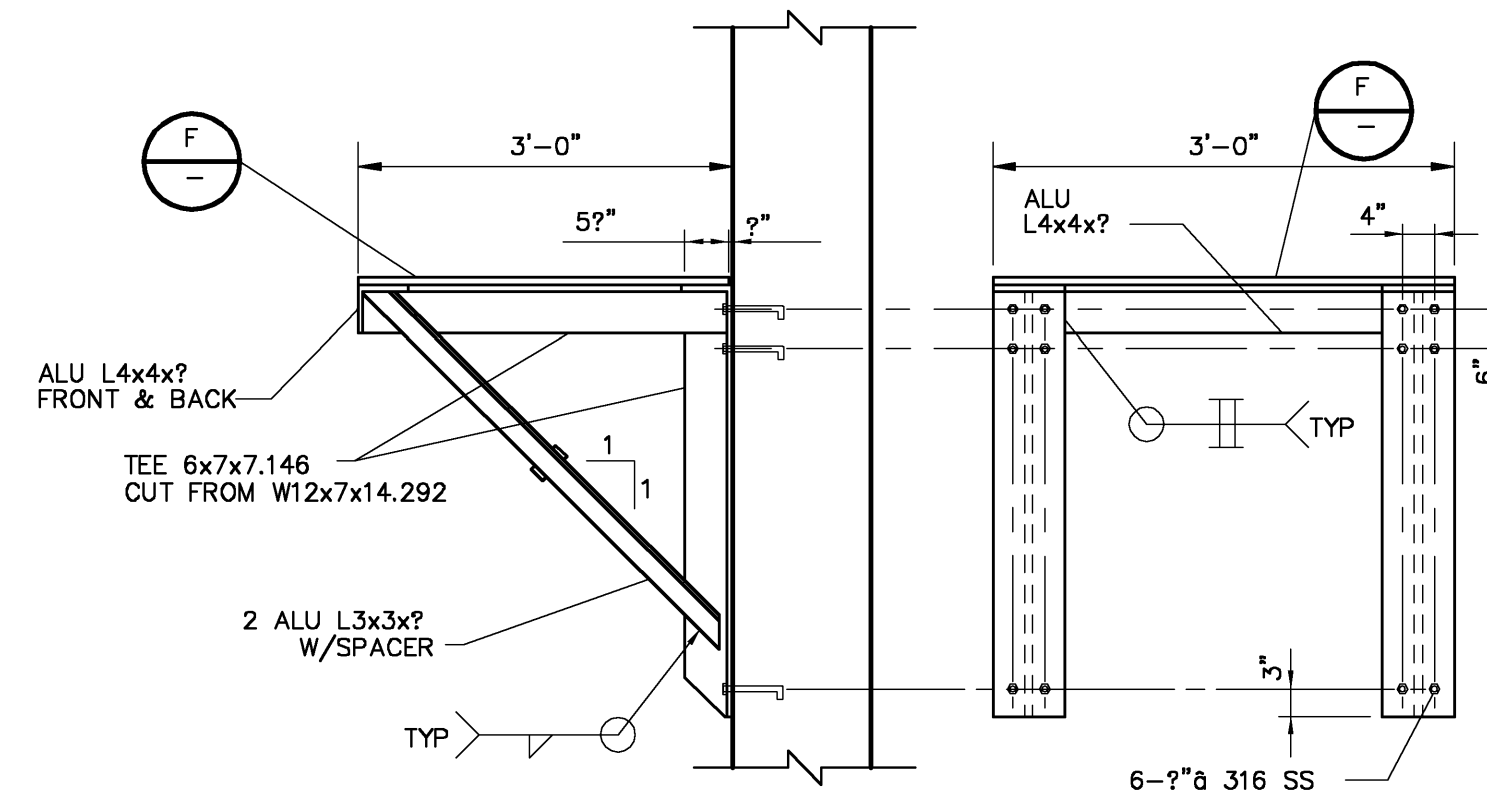

LADDER LANDING PLATFORM
DETAIL D
NTS

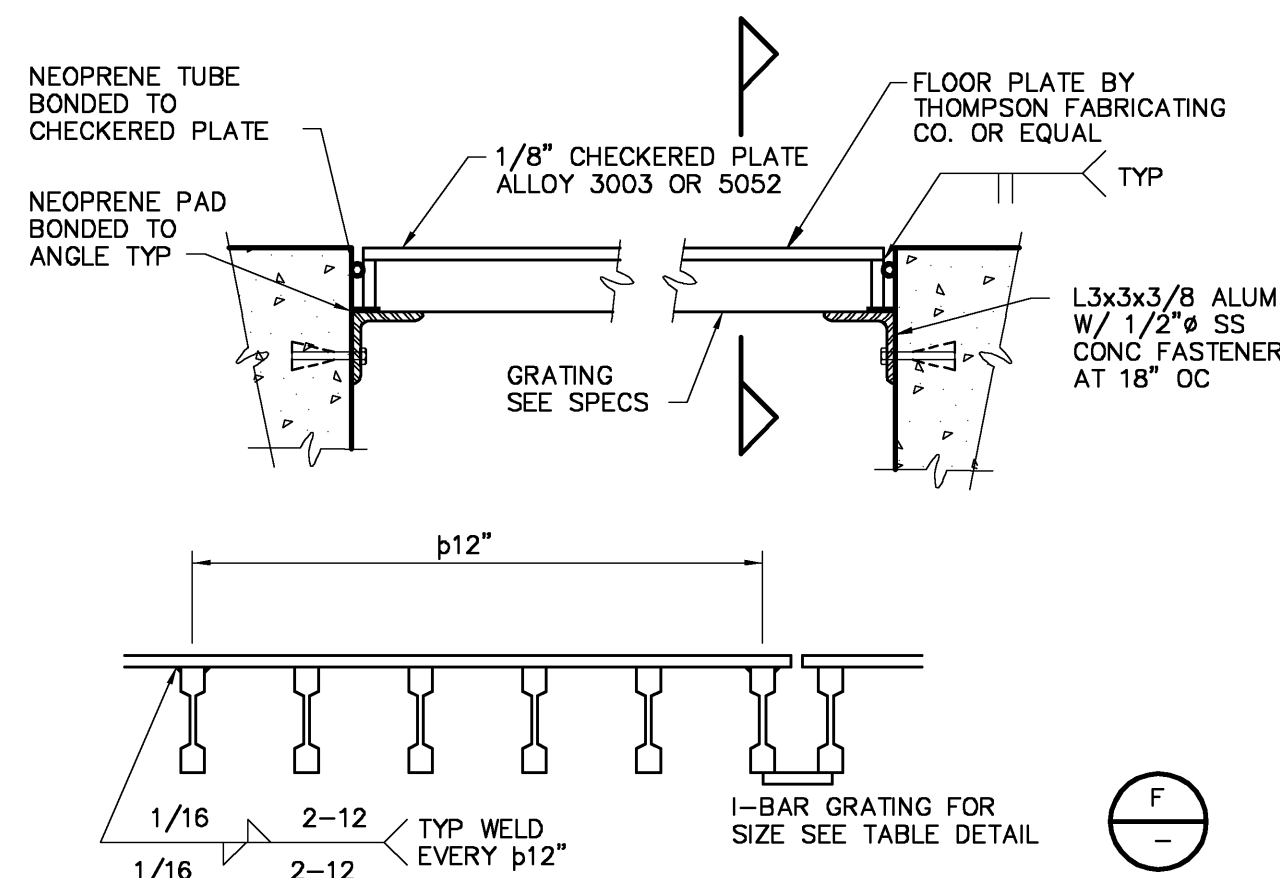


CHECKERED PLATE
DETAIL E
NTS

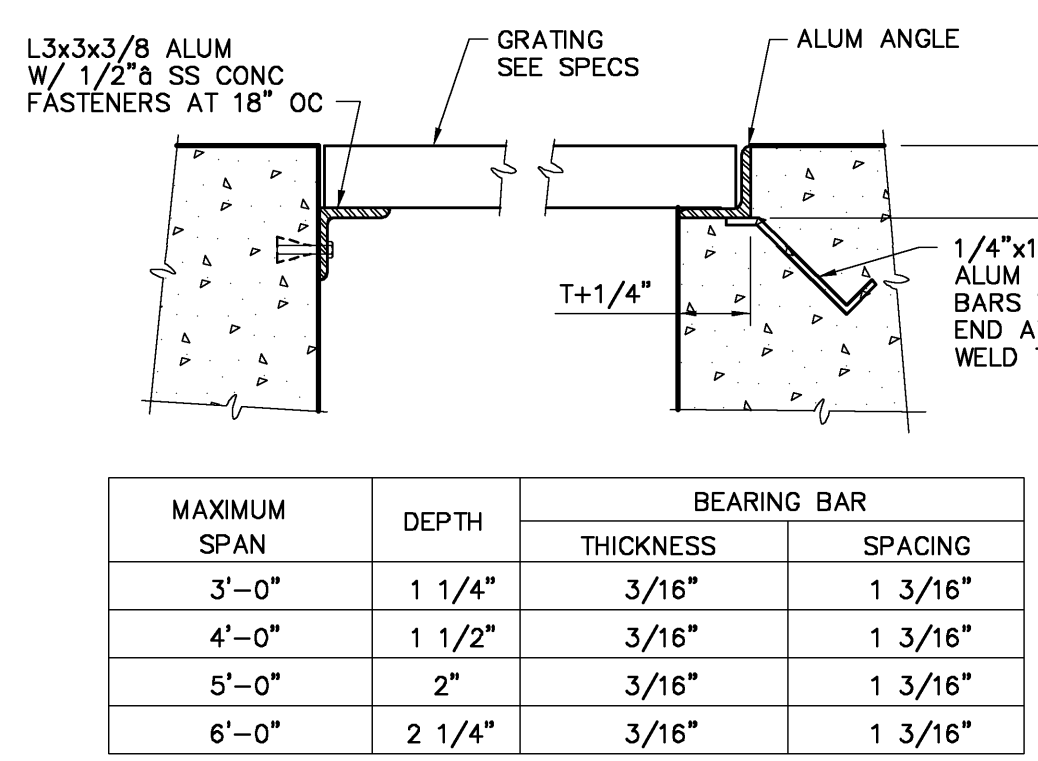

GRATING AND GRATING SUPPORT
DETAIL F
NTS


MAXIMUM SPAN	DEPTH	BEARING BAR	
		THICKNESS	SPACING
3'-0"	1 1/4"	3/16"	1 3/16"
4'-0"	1 1/2"	3/16"	1 3/16"
5'-0"	2"	3/16"	1 3/16"
6'-0"	2 1/4"	3/16"	1 3/16"

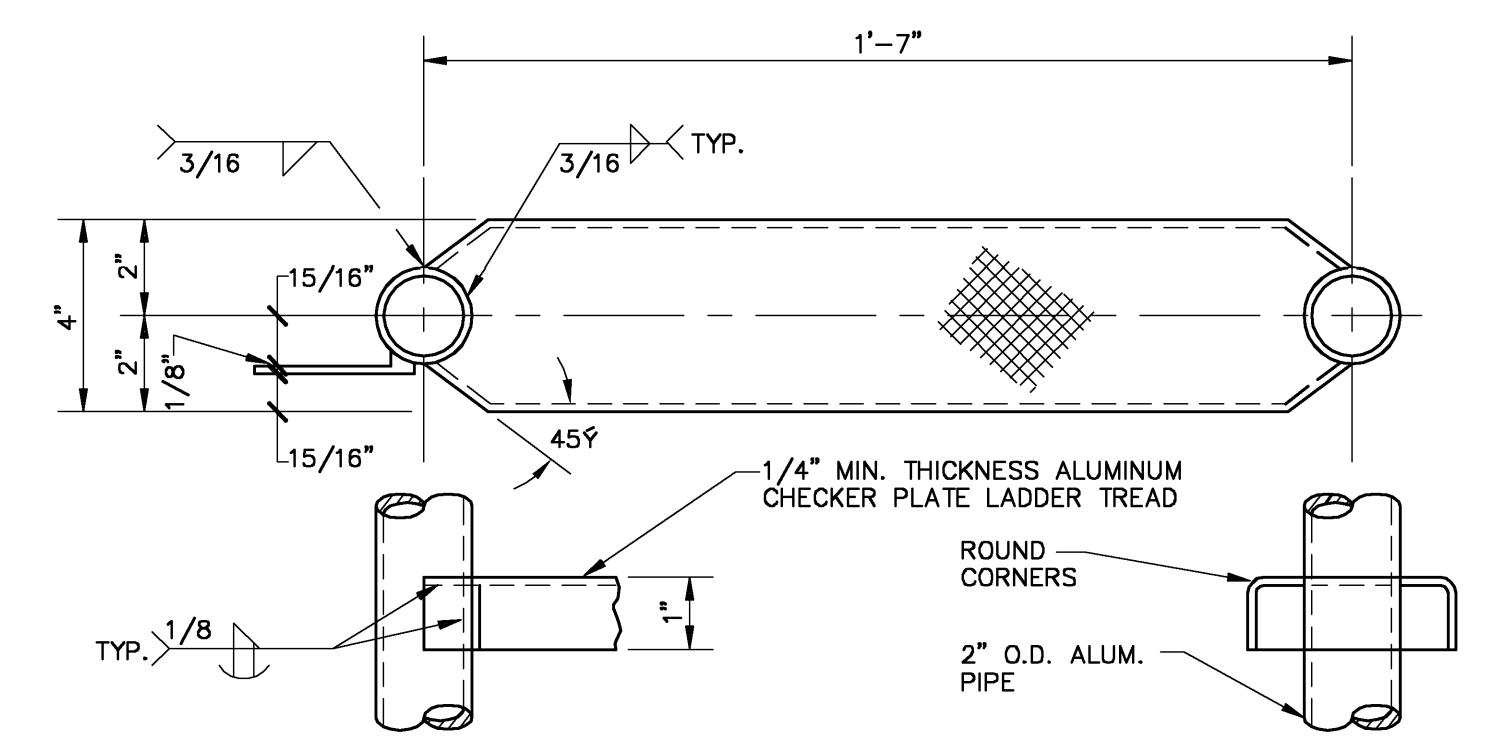


ALUMINUM LADDER TREAD
DETAIL G
N.T.S.

NOMINAL BEAM DEPTH, INCHES	ROWS OF BOLTS	LENGTH (3) OF ANGLE
36	7	1'-8 1/2"
30-33	6	1'-5 1/2"
24-27	5	1'-2 1/2"
16-21	4	11 1/2"
12-15	3	8 1/2"
8-10	2	5 1/2"
6	1	3"


- NOTES:**
- NUMBER OF ROWS IS EQUAL TO NUMBER OF BOLTS TO ENCLOSED WEB.
 - ALL FRAMING CONNECTIONS SHALL CONFORM TO SCHEDULE UNLESS DETAILED OTHERWISE ON FRAMING DRAWINGS.
 - ADD 1 1/2" TO ANGLE LENGTH FOR STAGGERED BOLT CONNECTIONS.
 - USE SS BOLTS FOR ALL ALUM FRAMING.

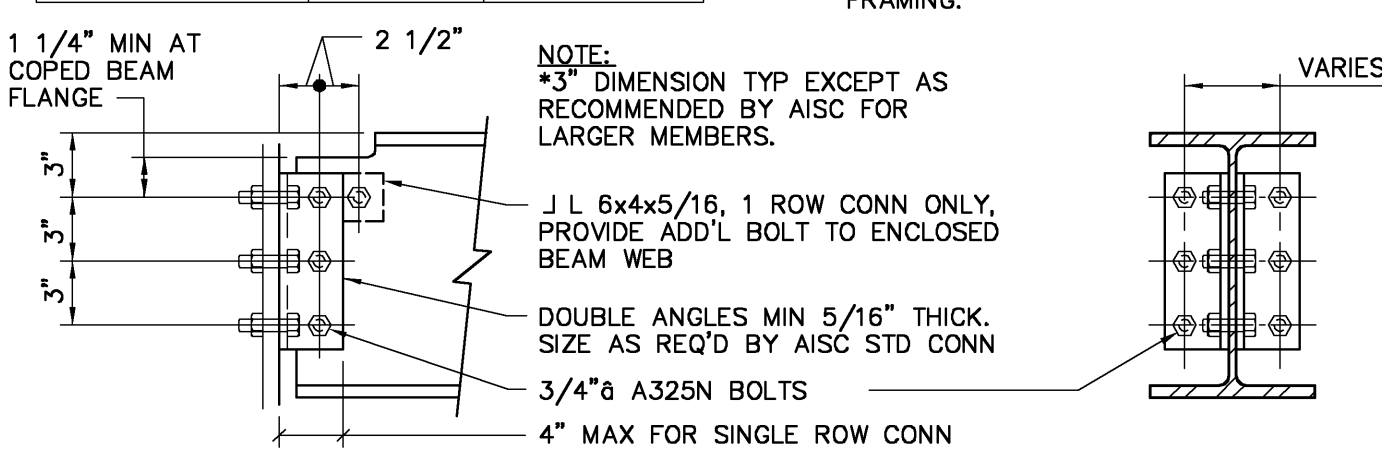


TYPICAL FRAMING CONNECTION
DETAIL H
NTS

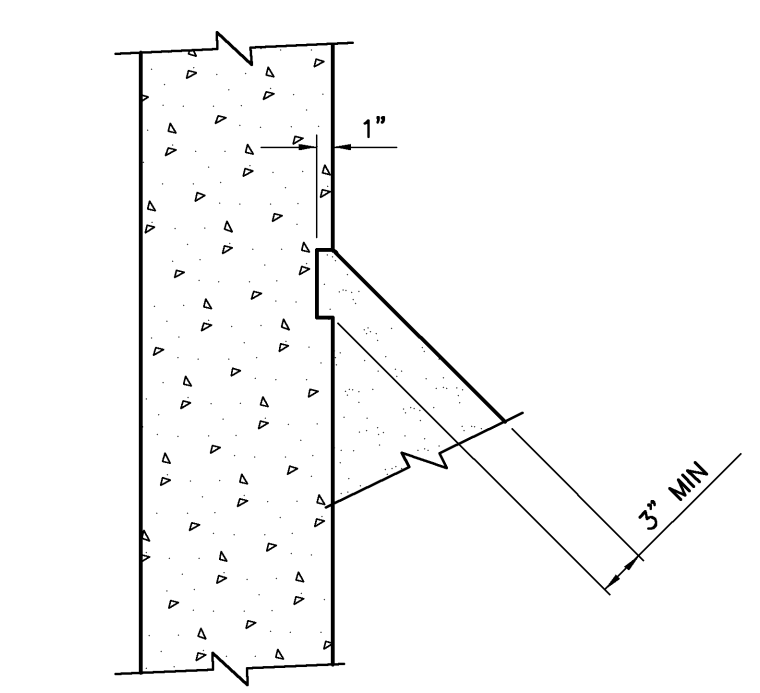


GROUT FILLET
DETAIL I
NTS

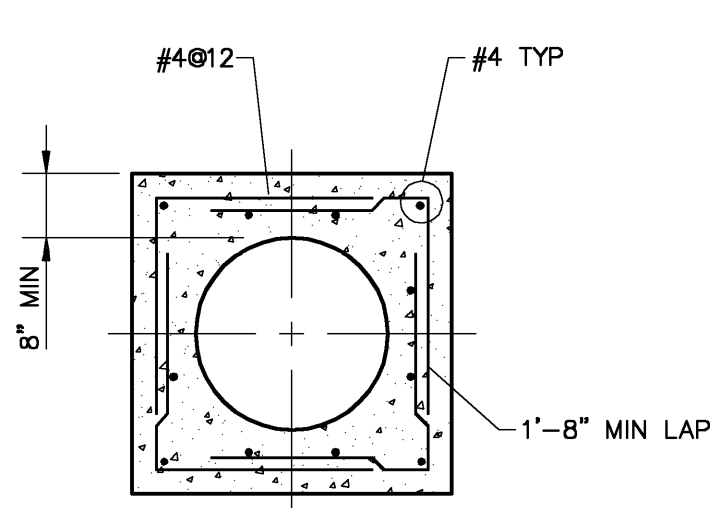

PIPE ENCASEMENT
DETAIL J
NTS

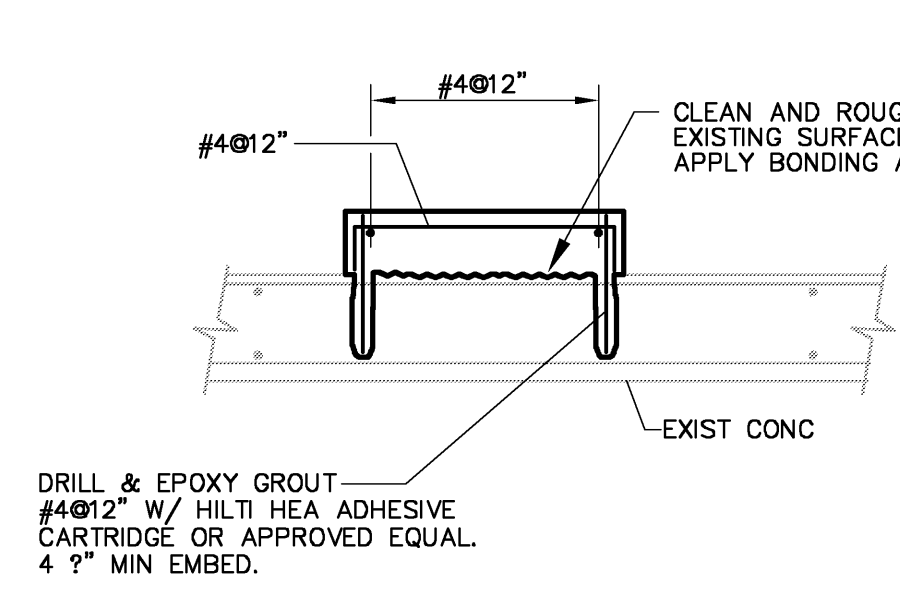

NEW EQUIPMENT PAD ON EXIST SLAB
DETAIL K
NTS

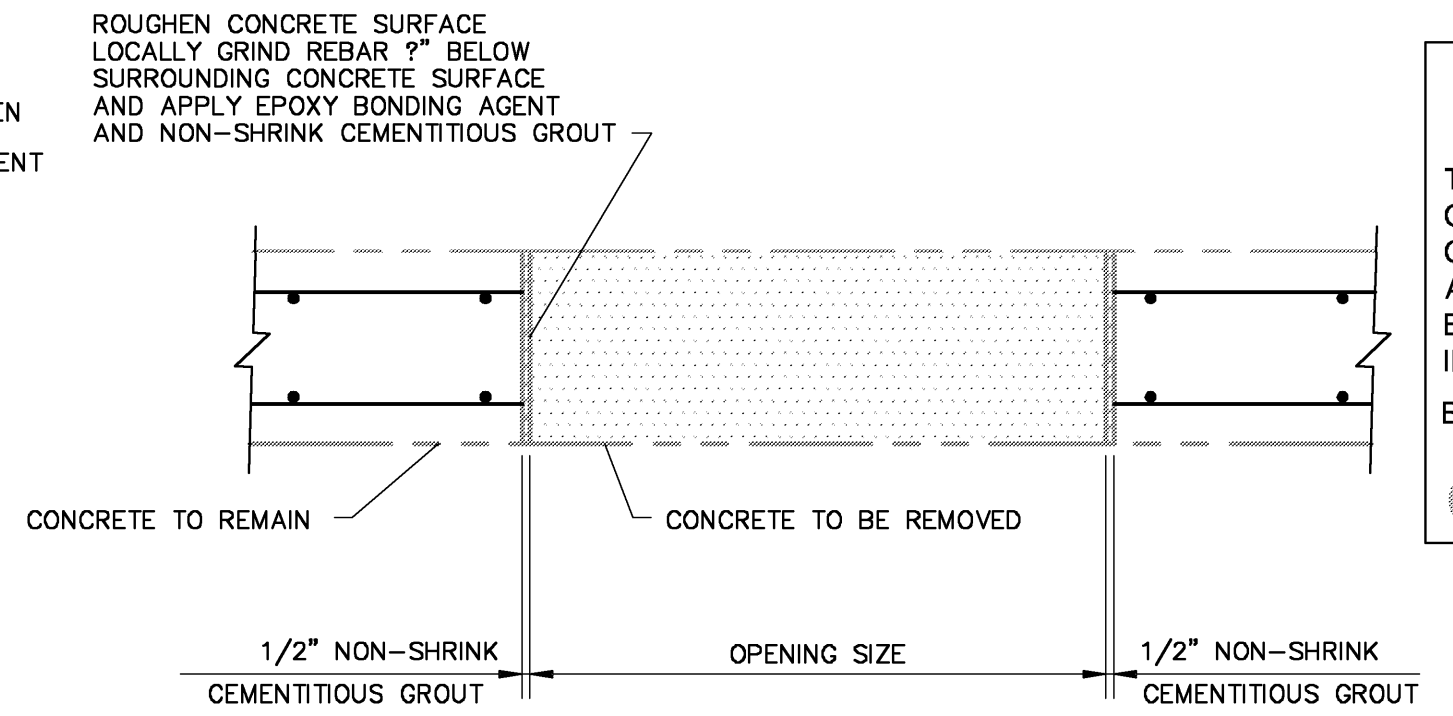

DEMOLITION PLAN
DETAIL L
NTS

RECORD DRAWING

THIS RECORD DRAWING HAVE BEEN PREPARED BASED ON A COMBINATION OF INFORMATION PROVIDED BY OTHERS AND BY CDM. THEREFORE, THE ENGINEER HAS NOT VERIFIED THE ACCURACY OF ALL THE INFORMATION. TO THE BEST OF THE ENGINEER'S BELIEF AND KNOWLEDGE, THE INCLUDED RECORD INFORMATION IS REASONABLY ACCURATE.

By _____ Date December 2007

CDM

TIMOTHY A. VERWEY, P.E.
NO. 50947

Remains
 2/10/18
 01/05/03 15:41:12
 D:\Stu Temp Folders\3381_002\ 58-2-R

REV. NO.	DATE	DRWN	CHKD	REMARKS
12/07	PCS	TAV		RECORD DRAWINGS
12/02	RAP	TAV		CLARIFIED HANDRAIL DETAIL
3/99	RAP	TAV		CONFORMED

DESIGNED BY: **B. EREL**
 DRAWN BY: **T. VERWEY**
 SHEET CHK'D BY: **B. EREL**
 CROSS CHK'D BY: **J. GOLDMAN**
 APPROVED BY: _____
 DATE: **MAY 1998**

CAMP DRESSER & MCKEE INC.
 800 Brickell Avenue, Suite 710
 Miami, Florida 33131
 Tel: 305-372-7171
 FI COA No. EB-0000020

CDM

environmental engineers, scientists
planners, & management consultants

CITY OF MIAMI BEACH, FLORIDA

WASTEWATER SYSTEM IMPROVEMENTS

PROJECT NO.
9381-002R

SHEET NO.
SD-2

SHEET 87 OF 311