

IMPORTANT NOTE:
 AS PER CITY OF MIAMI BEACH ELECTRICAL CHIEF DIRECTIVE:
 ALL ELECTRICAL EXPOSED TO SLAT WATER AIR TO BE RATED A MINIMUM
 OF NEMA-3X INCLUDING PANELS. AS PER NEC 110.28, 2011. ALL A/C
 DISCONNECTS SHALL BE AS PER:
 NEC-1-110.28 CORROSIVE AGENTS. (BUILDING DEPARTMENTS)
 CITY OF MIAMI BEACH ELECTRICAL DIVISION REQUIREMENTS)
 ALL OUTDOOR ELECTRICAL EQUIPMENTS, DISCONNECTS PANELS).


IMPORTANT NOTE:
 - REFER TO FIRE ALARM DRAWINGS FOR SMOKE DETECTOR LOCATION
 AND COMPLIANCE.

ELECTRICAL GROUND FLOOR PLAN

SCALE: 1/4" = 1'-0"

PROJECT:
1330 Building
 1330 15th Street, Miami Beach, FL 33139
 PROJECT OWNER:
 NOTUS, LLC
 435 21st Street, Miami Beach, FL 33139
 ARCHITECT OF RECORD:

RD Architects
 1800 SW 1st Avenue, Suite 607, Miami, Florida 33129
 P: 786.762.2679 F: 305.831.8079 C: 305.282.0005
 Email: rda@rda-archint.com / AA26002510
 CONSULTANT ENGINEER:

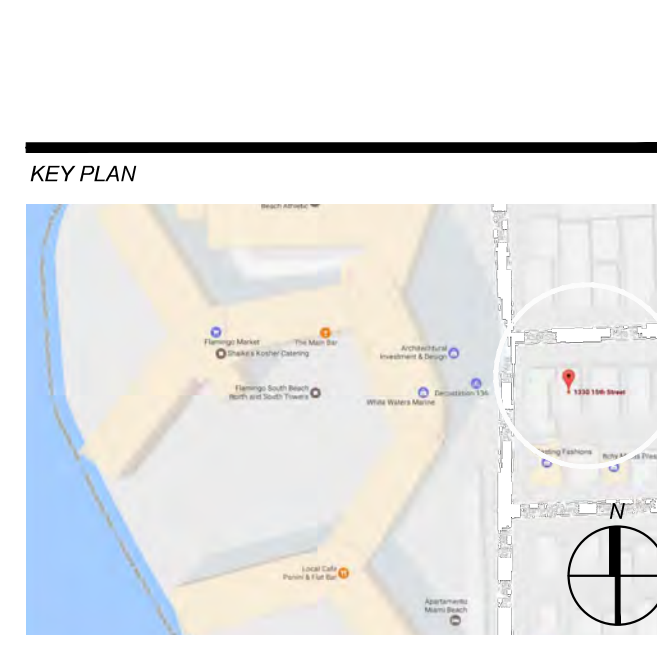

SIGNATURE / DATE / SEAL
 NOT VALID IF MISSING SIGNATURE

 Victor H. Rodriguez,
 Registered Architect
 State of Florida # AR0094965
 305.282.0005 vh.rodriguez@rda-archint.com

PERMIT SET

Issue	Issue Date / For
	05.06.2017 / Reviewer Comments
	08.07.2017 / Reviewer Comments
	12.17.2017 / Fire Dept. Comments
	04.20.2018 / Reviewer Comments

DDCI Project #: 1628.00
 Drawn by: VHR
 Approved by: VHR
 SHEET INDEX
 4 - Electrical Plan
 Ground Level

SCALE:
 SHEET NO.
E-2
 © 2016 RDA

THE DESIGNS INDICATED IN THESE DRAWINGS ARE PROPERTY OF RD Architects. ALL COPYRIGHTS RESERVED © 2016

THE DESIGNS INDICATED IN THESE DRAWINGS ARE PROPERTY OF RD Architects. ALL COPYRIGHTS RESERVED © 2016


PROJECT:

1330 Building

1330 15th Street, Miami Beach, FL 33139

PROJECT OWNER:
NOTUS, LLC
435 21st Street, Miami Beach, FL 33139

ARCHITECT OF RECORD:




RD Architects
1800 SW 1st Avenue, Suite 607, Miami, Florida 33129
P: 786.762.2679 F: 305.831.8079 C: 305.282.0005
Email: rda@rda-archint.com
www.rda@rda-archint.com / AA26002510

CONSULTANT ENGINEER:



SIGNATURE / DATE / SEAL

NOT VALID IF MISSING SIGNATURE

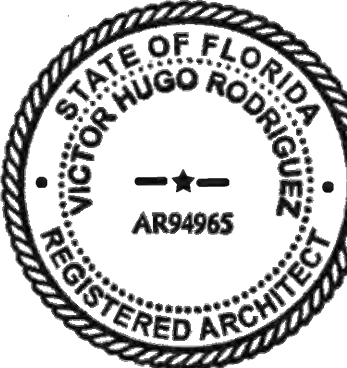

Victor H. Rodriguez,
Registered Architect
State of Florida # AR0094965
305.282.0005 vh.rodriguez@rda-archint.com

PERMIT SET

Issue	Issue Date / For
	12.05.2016 / Owner Revisions
	05.05.2017 / Reviewer Comments
	08.07.2017 / Reviewer Comments
	12.17.2017 / Fire Dept. Comments

DDCI Project #: 1628.00
Drawn by: VHR
Approved by: VHR


SHEET INDEX

4 - **Electrical Plan**
Second Level

SCALE:
SHEET NO.


E-3

ELECTRICAL SYMBOLS	
SYMBOL	DESCRIPTION
	CEILING MTD./WALL MTD. SELECTED BY OWNER LETTERS - DENOTE PANEL, NUMBER - DENOTES CIRCUIT NUMBER
	G.F.I. RECEPTACLE 15/20 AMP/120 VOLT -VERIFY MOUNTING HEIGHT
	DUPLEX RECEPTACLE 15/20 AMP/120 VOLT -VERIFY MOUNTING HEIGHT
	20A, 125V, 3 WIRES GROUNDING TYPE DUPLEX RECEPTACLE FLOOR MOUNTED GFI - GND FAULT INTERRUPTER,
	20A, 125V, 3 WIRES GROUNDING TYPE DUPLEX RECEPTACLE MOUNTED AT (18") A.F.F. GFI - GND FAULT INTERRUPTER, WP-WEATHERPROOF
	15A OR 20A,125V, 3 WIRES GROUNDING TYPE SINGLE RECEPTACLE (18") A.F.F.
	15 A, 125 VOLTS SINGLE POLE TOGGLE SWITCH (4"-0") A.F.F. LETTER - DENOTES LIGHTS SWITCHED
	15A, 125 VOLTS THREE WAY SWITCH (4"-0") A.F.F.
	15A, 125 VOLTS FOUR WAY SWITCH (4"-0") A.F.F.
	DIMMER SWITCH, TYPE AND SIZE AS INDICATED
	MANUAL MOTOR STARTER SWITCH WITH OVERLOAD PROTECTION
	WALL MOUNTED/ABOVE HUNG CEILING - JUNCTION BOX
	JUNCTION BOX AND DIRECT CONNECTION TO EQUIPMENT AS INDICATED ON PLANS
	DISCONNECT SWITCH: 2 - NUMBER OF POLES 60 - SWITCH SIZE, * * - FUSE SIZE PER MANUFACTURER OF EQUIPMENT RECOMMENDATIONS
	MAGNETIC MOTOR STARTER FURNISHED BY OTHER SECTION OF SPECIFICATIONS, INSTALLED BY ELECTRICAL CONTRACTOR
	EXHAUST FAN - CEILING MOUNTED
	PULL BOX
	ENCLOSED CIRCUIT BREAKER (5"-0") A.F.F. SIZE AND RATING AS INDICATED ON PLANS
	ELECTRICAL SERVICE METER, SURFACE MOUNTED.
	LIGHTING AND POWER LOADCENTER
	SPECIAL OUTLET, SIZE AS SHOWN IN PLANS, NUMBER - DENOTES SIZE.
	HOMERUN TO PANEL (U.O.N. 12 AWG IN (1/2") CONDUIT. MARKS DENOTE - NUMBER OF WIRES (HOT OR SWITCH LEGS) LONG MARK - NEUTRAL, NO MARK - NEUTRAL & ONE HOT WIRE DARK CIRCLE SYMBOL - GREEN GROUND
	BRANCH CIRCUIT OR FEEDER EXPOSED
	BRANCH CIRCUIT OR FEEDER CONCEALED IN CLG. WALL OR SLAB
	FLEXIBLE CONDUIT - NO LONGER THAN 1.8m (6'-0").
	CONDUIT STUB-UP
	CONDUIT STUB-DOWN
	BRANCH CIRCUIT OR FEEDER UNDERGROUND
	SMOKE DETECTOR
	CABLE TV OUTLET - MOUNTED AT (18") A.F.F.
	TELEPHONE OUTLET - MOUNTED AT (18") A.F.F.
	AUTOMATIC SINGLE STATION SMOKE DETECTOR (120V) WITH BATTERY BACKUP SEE DETAIL. A.F.F. - ABOVE FINISHED FLOOR. A.F.G. - ABOVE FINISHED GROUND.
	CO DETECTOR
	SPEAKER
	RECESSED LIGHT 40 WATTS (BY OWNER)
	DOWNLIGHT PENDANT OR SURFACE MOUNTED FIXTURE, TO BE SELECTED BY OWNER
	FLUORESCENT FIXTURE, LENGTH TO SCALE WITH PLANS
	WALL MOUNTED LIGHT FIXTURE, 40 WATTS
	OUTDOOR FLOOD LIGHTS, 100 WATT PAR38 LAMPS
	EXIT LIGHTS AHEAD OF SWITCH LEG ON EACH AREA LIGHTING CIRCUIT, W/ BATTERY BACK-UP 90 MIN - SURE LITES, MODEL APX SERIES (5W)
	EMERGENCY LIGHT COOPER LIGHTING - SURE-LITES, MODEL APEL - DC VOLTAGE 3.6V EMERGENCY LIGHTS AHEAD OF SW LEG ON EACH AREA LIGHTING CIRCUIT, W/ BATTERY BACK-UP 90 MIN (5 W)
	COMBINATION EXIT SIGN AND WALL MOUNT EMERGENCY LIGHTING UNIT. W/BATTERY BACK-UP 90 MIN

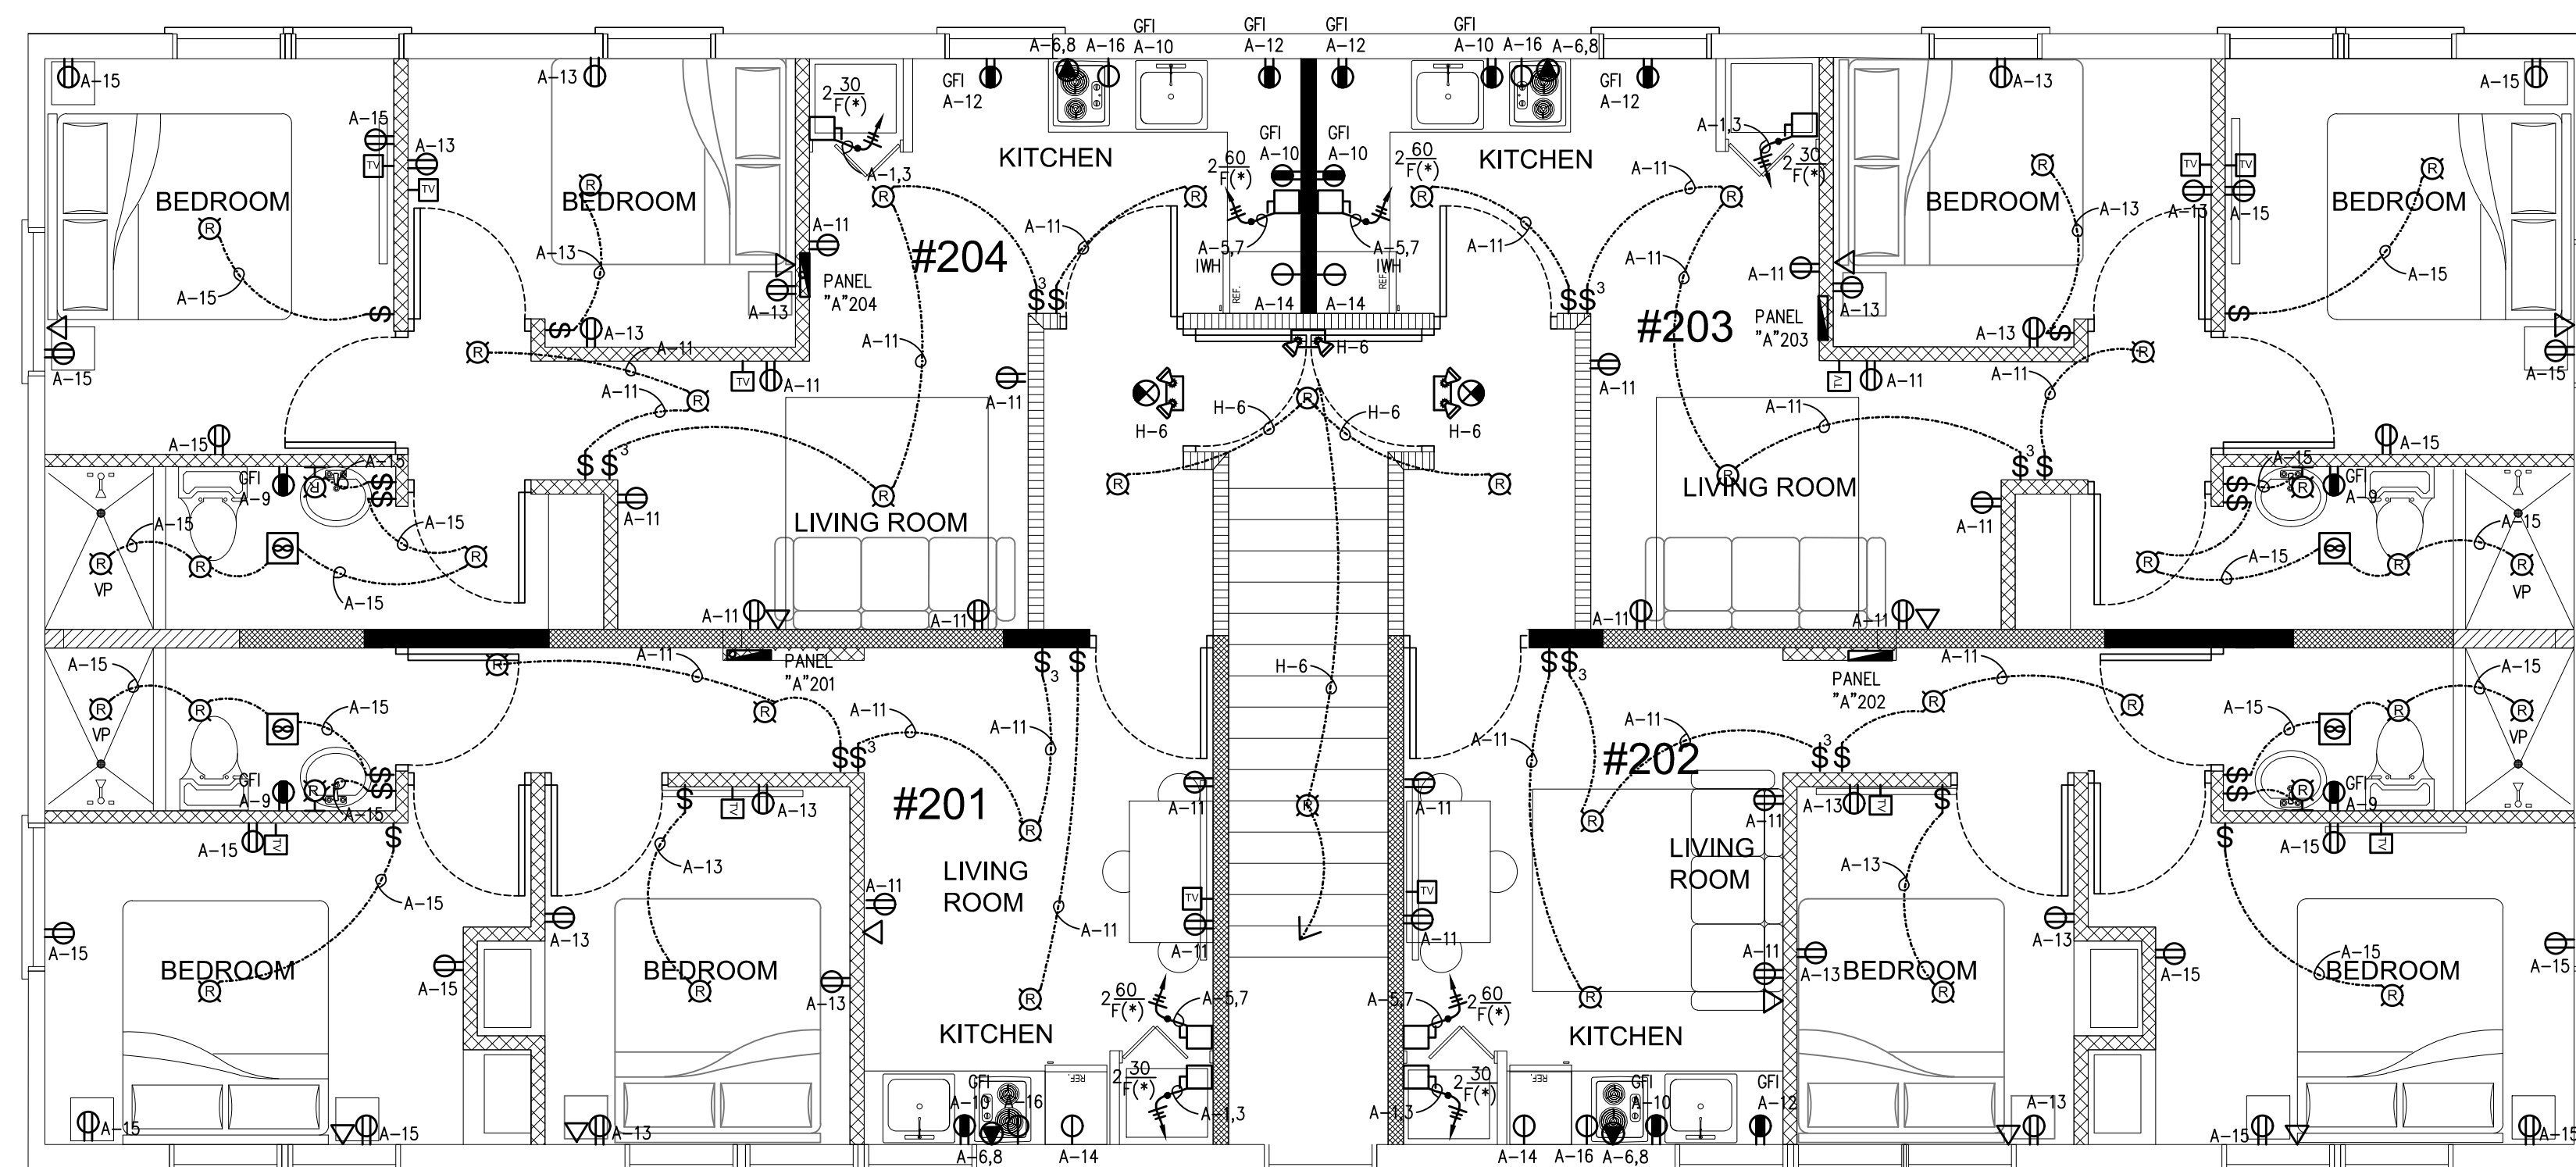

ELECTRICAL SECOND FLOOR PLAN

SCALE: 1/4" = 1'-0"

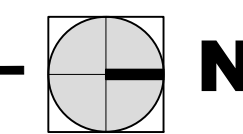

4 IMPORTANT NOTE:
- REFER TO FIRE ALARM DRAWINGS FOR SMOKE DETECTOR LOCATION
AND COMPLIANCE.


1330 Building

1330 15th Street, Miami Beach, FL 33139

PROJECT OWNER:

NOTUS, LLC
435 21st Street, Miami Beach, FL 33139

ARCHITECT OF RECORD:

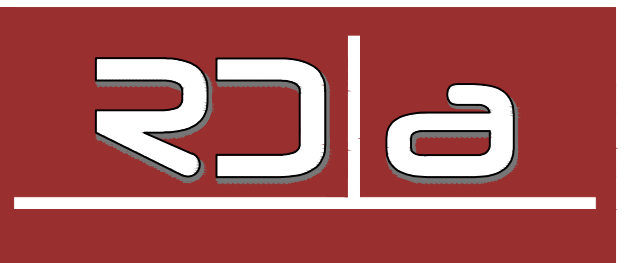


RD Architects
1800 SW 1st Avenue, Suite 607, Miami, Florida 33129
P: 786.762.2679 F: 305.831.8079 C: 305.282.0005
Email: rda@rda-archint.com
www.rda@rda-archint.com / AA26002510

CONSULTANT ENGINEER:

KEY PLAN



SIGNATURE / DATE / SEAL

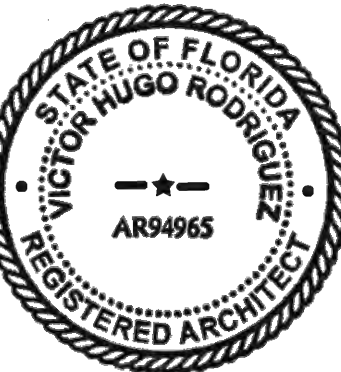

NOT VALID IF MISSING SIGNATURE

Victor H. Rodriguez,
Registered Architect
State of Florida # AR0094965
305.282.0005 vhr.rodriguez@rda-archint.com

PERMIT SET

Issue: Issue Date / For

09.12.2016 / Change of Architect

05.05.2017 / Reviewer Comments

04.20.2018 / Reviewer Comments

DDCI Project #: 1628.00

Drawn by: VHR

Approved by: VHR

SHEET INDEX

- Electrical Notes
- Riser Diagram
- Electrical Panel

SCALE:

SHEET NO.

E

D

C

B

A

GENERAL ELECTRICAL NOTES

- ALL WORK SHALL BE IN ACCORDANCE WITH NATIONAL ELECTRICAL CODE, FLORIDA BUILDING CODE FBC 2014 (5TH EDITION), NEC 2011 AND OTHER APPLICABLE CODES AND STANDARDS.
- a) THE DRAWINGS ARE DIAGRAMMATIC AND DO NOT SHOW ALL OFFSETS, BENDS AND BOXES REQUIRED TO MAKE A COMPLETE NEAT INSTALLATION IN ACCORDANCE WITH N.E.C.
b) WHEN CONFLICTS ARISE IN LOCATIONS WIRING DEVICES, ELECTRICAL EQUIPMENT, DISCONNECTS, PANEL BOARDS, ETC. DUE TO FIELD CONDITION OR IMPROPER FIELD COORDINATION CONTRACTOR SHALL BRING IT TO THE A / E'S ATTENTION AND AT NO EXTRA COST RELOCATE, AND OR EXTEND WITHIN A REASONABLE DISTANCE SUCH ITEM WHICH IS IN CONFLICT. THE CONTRACTOR IS RESPONSIBLE FOR COORDINATING LOCATION OF ALL COMPONENT PRIOR TO ROUGH IN WITH ALL TRADES NO EXTRAS WILL BE ALLOWED FOR FAILURE TO DO SO.
- THE CONTRACTOR IS RESPONSIBLE FOR EVALUATING FIELD CONDITIONS BY VISITING THE SITE PRIOR TO COMMENCING / BIDDING WORK.
- THE CONTRACTOR SHALL SATISFACTORILY REPAIR EQUIPMENT OR PART OF STRUCTURE DAMAGED AS A RESULT OF HIS WORK. SURFACES AND FINISHED AREAS SHALL BE RESTORED TO MATCH ADJACENT AREAS.
- APPROVAL SHALL BE OBTAINED FROM AN STRUCTURAL ENGINEER PRIOR TO CUTTING OR DRILLING ANY STRUCTURAL SUPPORT MEMBER.
- ALL CONDUITS SHALL BE INSTALLED CONCEALED IN FINISHED AREAS AS POSSIBLE WIRING DEVICES SHALL BE INSTALLED SQUARED AND FLUSH
- ALL CONDUCTOR SHALL BE COPPER.
- ALL CONDUCTORS SHALL BE IN COMPLIANCE WITH NEC 2011 & FBC 2014
- ALL MATERIALS SHALL BE U.L. APPROVED.
- NEW TYPE WRITTEN PANEL TALLY SHALL BE FURNISHED AFTER JOB IN COMPLETED REFLECTING ALL CHANGES AND ADDITIONS.
- ALL BRANCH CIRCUITS SHALL BE PROPERLY PHASE BALANCED.
- ALL BRANCH CIRCUITS TO HAVE A GREEN EQUIPMENT GROUNDING CONDUCTOR SIZED AS PER N.E.C. 250.122.
- RISERS ARE DIAGRAMMATIC ONLY. THEY DO NOT SHOW EVERY BEND REQUIRED FOR THE INSTALLATION.
- THIS DRAWING IS A GUIDE FOR THE ELECTRICAL INSTALLATION. THE ELECTRICAL CONTRACTOR IS RESPONSIBLE TO PROVIDE A FUNCTIONING SYSTEM.
- SPLICES ARE NOT ALLOWED UNLESS UL LISTED APPROVED BY OWNER
- ALL PULL AND JUNCTION BOXES SHALL BE ACCESSIBLE AT ALL TIMES.
- EXACT POINT AND METHODS OF CONNECTION SHALL BE DETERMINED IN FIELD.
- ALL WORK SHALL BE DONE IN A NEAT AND WORKMANLIKE MANNER.
- BRANCH CIRCUIT BREAKERS SHALL BE OF THE BUILT-IN TYPE. PLUG IN CIRCUIT BREAKERS WILL NOT BE ACCEPTED.
- ALL RACEWAY ROUTED, INSULATED CONDUCTORS SYSTEM SHALL BE COLOR CODED
- ALL ROUGH IN DIMENSION ARE TO CENTER LINE OF DEVICE UNLESS OTHERWISE NOTED.
- CONTRACTOR IS ALLOWED TO REARRANGE THE DISTRIBUTION OF THE ELECTRICAL LOADS CONNECTED TO BRANCH CIRCUITS IN FIELD AS LONG AS LOAD BALANCE & INDEPENDENT CIRCUIT LOADING IS IN COMPLIANCE WITH NEC.
- FLEXIBLE CONDUIT SHALL BE USED FOR CONNECTION TO ALL VIBRATING EQUIPMENT SUCH AS MOTORS.
- UNITS RECEIPT. OUTLETS TO BE TAMPER-RESISTANT AS PER NEC A-406.12, 2011.
- RECEPT. OUTLETS LOCATED IN DAMP/WET LOCATIONS TO BE GFCI-WP-WATER RESISTANCE TYPE AS PER NEC A-406.9 A/B, 2012

GENERAL LIGHTING NOTES

- ALL FLUORESCENT FIXTURES SHALL HAVE EACH BALLAST FUSED.
ALL FIXTURES SHALL BE PROPERLY SECURED TO CEILING GRID SYSTEM.
- VERIFY ALL DIMENSIONS AND LOCATIONS WITH TENANT PRIOR TO ROUGH-IN.
- ALL WORK SHALL BE IN ACCORDANCE WITH THE NATIONAL ELECTRICAL CODE AND OTHER APPLICABLE CODES AND STANDARDS.
- THE CONTRACTOR IS RESPONSIBLE FOR EVALUATING FIELD CONDITIONS BY VISITING THE SITE PRIOR TO COMMENCING/BIDDING WORK. FLOOR PHOTOMETRY BY ARCHITECT
- THE CONTRACTOR SHALL SATISFACTORILY REPAIR/REPLACE EQUIPMENT OR PART OF STRUCTURE DAMAGED AS A RESULT OF HIS WORK. SURFACES AND FINISHED AREAS SHALL BE RESTORED TO MATCH ADJACENT AREAS.
- APPROVAL SHALL BE OBTAINED FROM THE ENGINEER PRIOR TO CUTTING OR DRILLING ANY STRUCTURAL SUPPORT MEMBER.
- ALL CONDUCTORS SHALL BE COPPER.
- ALL MATERIALS SHALL BE U.L. APPROVED.
- ALL LUMINAIRES SHALL BE PROPERLY SUPPORTED IN ACCORDANCE WITH THE CEILING SYSTEM MANUFACTURER RECOMMENDATIONS AND LOCAL CODE REQUIREMENTS.
- ALL LIGHTING CIRCUITS WHICH CONTROL AND/OR OPERATE LIGHTING FIXTURES WITH ELECTRONIC BALLAST SHALL BE PROVIDED WITH A SEPARATE NEUTRAL WIRE PER EACH PHASE.
- ALL BRANCH CIRCUITS SHALL BE SIZED IN ACCORDANCE WITH N.E.C. 210-19 REGARDLESS OF SIZES SHOWN ON PLANS OR PANEL SCHEDULES.


ILLUMINATION NOTES:

- REFER TO ARCHITECTURAL REFLECTED CEILING PLANS FOR EXACT LOCATION OF LUMINAIRES (LIGHT FIXTURES).
- ALL BRANCH CIRCUITS SHALL BE SIZED IN ACCORDANCE WITH N.E.C. 210-19 REGARDLESS OF SIZES SHOWN ON PLANS OR PANEL SCHEDULES.
- ALL EXIT SIGN AND EMERGENCY LIGHTING SHALL BE PROVIDED WITH RECHARGEABLE BATTERY BACKUP AND CONNECTED AHEAD OF THE LOCAL LIGHTING SWITCH. COMPLY WITH NFPA-101.7.9 & NEC-700-12 (E)
- MANUFACTURER AND CONTRACTOR SHALL BE RESPONSIBLE FOR PROPER VENTILATION AND TEMPERATURE CONDITIONS OF LUMINAIRES (LIGHT FIXTURES).
- FIXTURES SHALL BE SUPPORTED IN ACCORDANCE WITH NEC-410.16 (C).
- PRIOR TO ROUGH-IN OF ELECTRICAL DEVICES COORDINATE EXACT LOCATION AND MOUNTING HEIGHTS.
- PRIOR TO ROUGH-IN OF ELECTRICAL DEVICES COORDINATE EXACT LOCATION AND MOUNTING HEIGHTS.
- ALL LIGHTING FIXTURES INSTALLATION AND CONTROLS SHALL BE INSTALLED PER MANUFACTURER RECOMMENDATIONS BY LTG SUPPLIER SELECTED BY OWNER AND EC.
- CONTRACTOR SHALL VERIFY CEILING CONSTRUCTION FOR EACH LUMINAIRE (LIGHT FIXTURE) TYPE AND LOCATION.
- MANUFACTURER AND CONTRACTOR SHALL BE RESPONSIBLE FOR PROPER VENTILATION AND TEMPERATURE CONDITIONS OF LUMINAIRES (LIGHT FIXTURES).
- ALL FLUORESCENT LUMINAIRES (LIGHT FIXTURE) WITH DOUBLE-ENDED LAMPS AND BALLAST SHALL HAVE AN INTERNAL FACTORY INSTALLED DISCONNECTING MEANS IN COMPLIANCE WITH NEC 2011 LAST EDITIONS
- INSTALL "NIGHT LIGHT" LUMINAIRES (LIGHT FIXTURES) AHEAD OF LIGHT SWITCH.
- ALL NEW AND RELOCATED LIGHTING SHALL COMPLY WITH FLA ENERGY CODE 2014/5TH EDITION
- LIGHTING FIXTURES SHALL COMPLY WITH FBC 2014 5TH EDITION AND ENERGY CODE 2014
- A MINIMUM OF 75 PERCENT OF THE LAMPS LIGHTING FIXTURES SHALL BE HIGH-EFFICIENT PER ENERGY CODE
- PROVIDE 1 FC MINIMUM EGRESS ILLUMINATION TO COMPLY WITH FBC 2014 5TH EDITION
- STAIRS MINIMUM 1 FOOT CANDLE ILLUMINATION INSIDE AND OUTSIDE AS PER FBC R303.7

VERY IMPORTANT NOTE:

ALL JOBS SHALL BE IN COMPLIANCE WITH NEC 2011 AND FBC-2014 5TH EDITION.

IMPORTANT NOTE:
REFER TO FIRE ALARM DRAWINGS FOR SMOKE DETECTOR LOCATION AND COMPLIANCE.

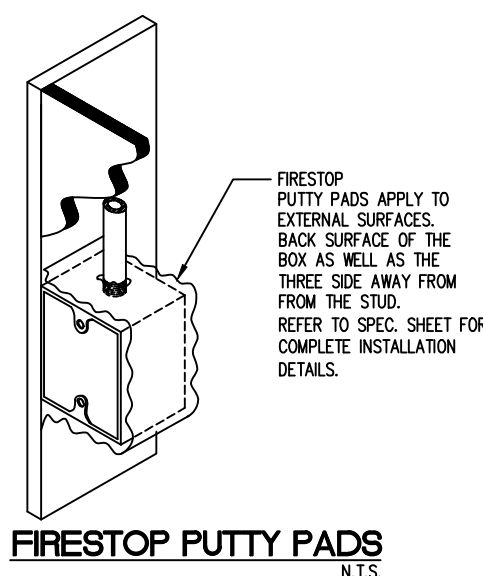

- FIRESTOP PUTTY PADS**
N.T.S.
- PUTTY PADS ARE DESIGNED TO BE APPLIED TO EXTERNAL SURFACES OF METALLIC NON METALLIC SWITCH AND RECEPTACLE BOXES IN SOME RATED WALL CONDITIONS.
 - ALSO, IT CAN BE USED IN SYSTEMS FOR THROUGH-PENETRATION FIRESTOP DESIGN.
 - FIRESTOP PUTTY PAD HAVE NFPA AND UL APPROVED. REFER SPEC. SHEETS

NEW PANEL "H" (HOUSE PANEL)				NEW SURFACE SEE DWG SEE RISER				MANS AMPS: TYPE MAINS: VOLTS: AC:		125A / 2P M.L.O. 120/240 V, 1PH, 3W. 22,000				
NO.	POLE	KVA	DESCRIPTION	WIRE, C	NO.	POLE	KVA	DESCRIPTION	WIRE, C	NO.	POLE	KVA	DESCRIPTION	WIRE, C
1	2/30		DRYER	4-#10, 3/4"	2	2/30		TANKLESS INSTA WATER HEATER (WH-1)	3-#10, 3/4"					
3		5.0			4		3.5							
5	1/20	1.5	WASHER	2-#12, 1/2"	6	1/20	0.6	CORRIDOR LIGHTING	2-#12, 1/2"					
7	1/20	0.72	EXTERIOR RECEPTACLE_GFI	2-#12, 1/2"	8	1/20	0.6	LAUNDRY LIGHTING	2-#12, 1/2"					
9	1/20	0.18	LAUNDRY/ELEC. ROOM RECEPTACLE_GFI	2-#12, 1/2"	10	1/20	0.6	FIRE ALARM PANEL	2-#12, 1/2"					
11					12			SPACE						
13	1/20	0.02	EXIT/EMERGENCY LIGHTING	2-#12, 1/2"	14			SPACE						
15	1/20	0.2	EXTERIOR LOW VOLTAGE LIGHTING	2-#12, 1/2"	16			SPACE						
17			SPACE		18			SPACE						
19			SPACE		20			SPACE						

DEMAND: SEE LOAD VA CALCULATION AMPS (*) PART OF OTHER LOAD 3 VA /SQ FT SEE LOAD CALCULATION

- CONTRACTOR TO PROVIDE COMBINATION AFO TYPE BREAKERS IN ALL DWELLING PER NEC-210.12.
- CONTRACTOR TO PROVIDE HVAC TYPE BREAKER FOR ALL AHU'S "H"

NEW PANEL "A" (TYP FOR UNIT 101, 102, 103, 104, 201, 202, 203 & 204)				NEW SURFACE SEE DWG SEE RISER				MANS AMPS: TYPE MAINS: VOLTS: AC:		125A / 2P M.L.O. 120/240 V, 1PH, 3W. 22,000				
NO.	POLE	KVA	DESCRIPTION	WIRE, C	NO.	POLE	KVA	DESCRIPTION	WIRE, C	NO.	POLE	KVA	DESCRIPTION	WIRE, C
1	2/30		AHU-1	3-#10, 3/4"	2	2/25		CU-1	3-#12, 1/2"					
3		5.0	(5.0 KW HTR)		4		*							
5	2/60		TANKLESS INSTA WATER HEATER (WH-1)	3-#6, 1"	6	2/50		RANGE	3-#6, 1"					
7		11.2			8		8.0							
9	1/20	*	RECEPTACLE BATHROOM (GFI)	2-#12, 1/2"	10	1/20	1.5	SMALL APPLIANCES _ GFI	2-#12, 1/2"					
11	1/20	*	GENERAL LIGHTING	2-#12, 1/2"	12	1/20	1.5	SMALL APPLIANCES _ GFI	2-#12, 1/2"					
13	1/20	*	GENERAL LIGHTING	2-#12, 1/2"	14	1/20	1.2	REFRIGERATOR	2-#12, 1/2"					
15			SPACE		16	1/20	1.5	MICROWAVE	2-#12, 1/2"					
17			SPACE		18			SPACE						
19			SPACE		20			SPACE						

DEMAND: SEE LOAD VA CALCULATION AMPS (*) PART OF OTHER LOAD 3 VA /SQ FT SEE LOAD CALCULATION


- CONTRACTOR TO PROVIDE COMBINATION AFO TYPE BREAKERS IN ALL DWELLING PER NEC-210.12.
- CONTRACTOR TO PROVIDE HVAC TYPE BREAKER FOR ALL AHU'S "H"

SERVICE LOAD ANALYSIS 120/240		
GENERAL LT & APPL LOADS 8 APT (100% LOAD)		251,080 VA
NEC 220-84 DEMAND FACTOR	0.43	DF
TOTAL GENERAL DEMAND LOADS		107,965 VA
HOUSE PANEL "H"		13,275 VA
		505.2 AMPS

NEUTRAL LOAD CALCULATIONS		
GENERAL LT & APPL LOADS 8 APT + PNL "H"		284,355 VA
INSTA-WATER HEATER (240V) 11,200 X (8 UNITS)		- 89,600 VA
INSTA-WATER HEATER (240V) 3,500		- 3,500 VA
RANGE LOAD AT 30% (240V) 8,000 X (8 UNITS)		- 19,200 VA
DRYER (240V) 5,000		- 5,000 VA
HVAC (240V) 5,000 X (8 UNIT)		- 40,000 VA
TOTAL LOAD		107,055 VA
NEC 220-84 DEMAND FACTOR	0.43	DF
TOTAL NEUTRAL LOAD		46,034 VA
		191.81 AMPS

(*) - E. CONTRACTOR TO VERIFY AND PROVIDE EQUIPMENT GROUNDING CONDUCTOR AS PER NEC 250-122

- PROVIDE GROUNDING BONDING AND CONNECTIONS AS PER NEC 250-32.
- PROVIDE DISCONNECT IDENTIFICATION PLAQUES AS PER NEC 225-37
- METER CENTER STACKS SHALL COMPLY W/ NEC 408.36

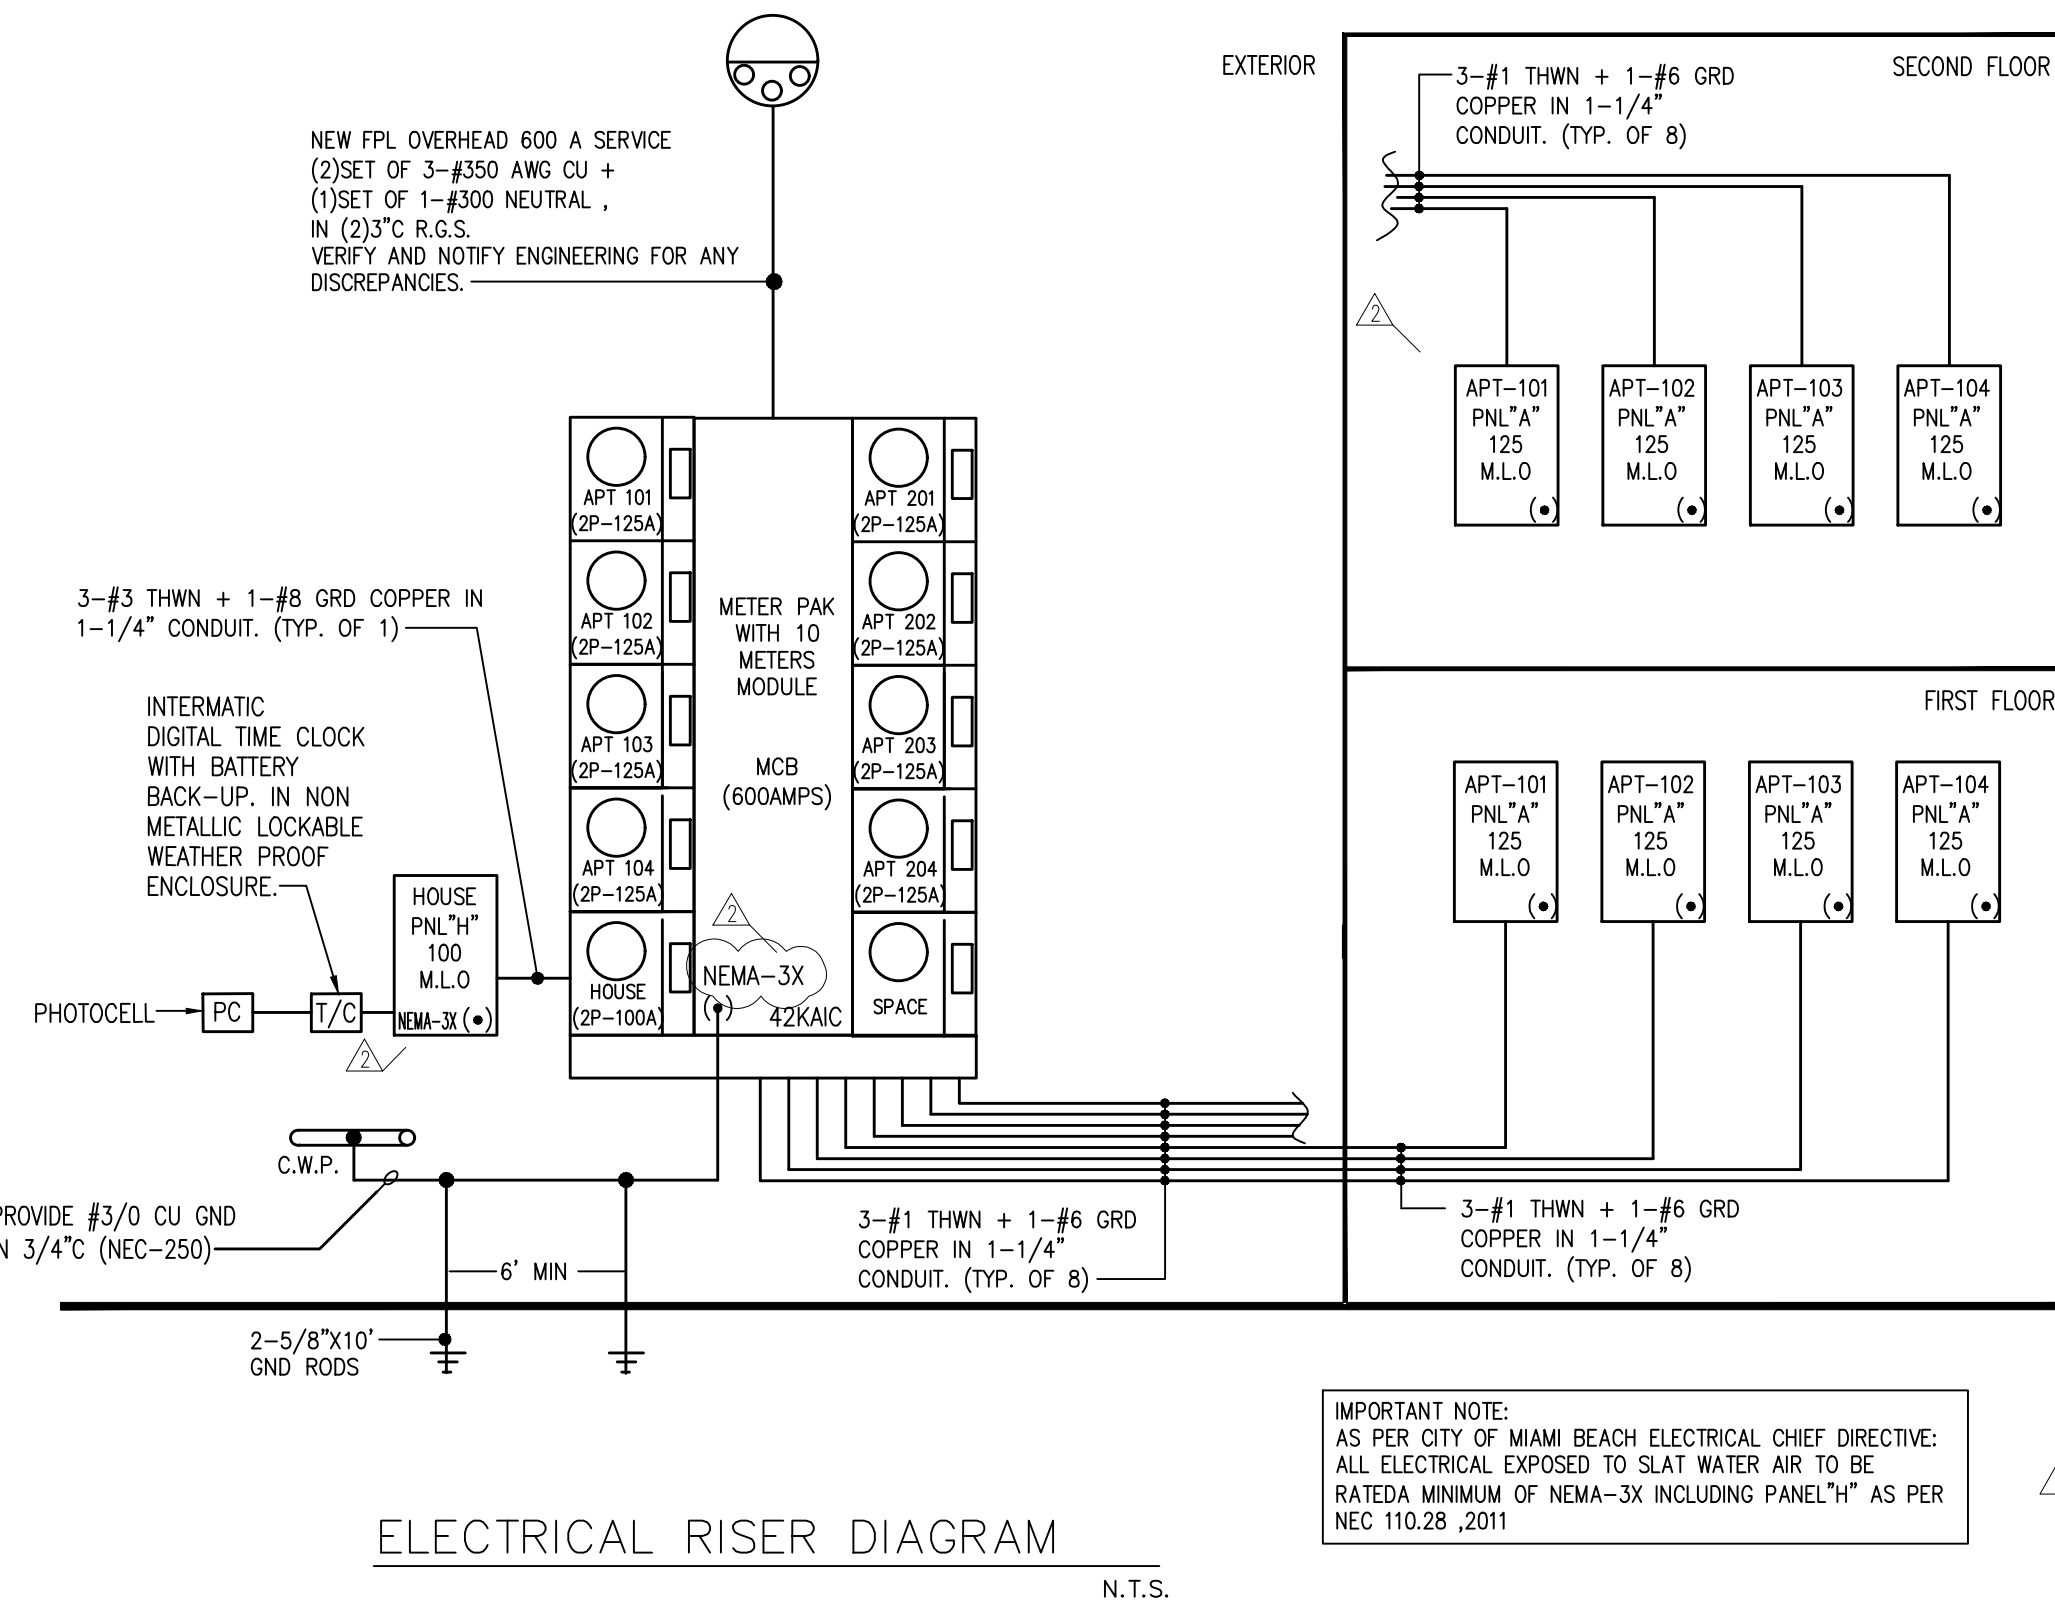

ELECTRICAL RISER DIAGRAM





N.T.S.

PENETRATIONS THROUGH FIRE RATED FLOORS, WALLS AND PARTITIONS FIRE RATED SHALL BE FIRE STOPPED TO COMPLY WITH THE APPLICABLE EDITION, INCLUDING REVISIONS, OF THE UBC AND LOCAL FIRE MARSHALL REQUIREMENTS. FIRE STOP SYSTEM USED SHALL BE UL LISTED AND SHALL BE SUITABLE FOR THE PENETRATING AND PENETRATED MATERIALS. THE WORK SHALL BE INSPECTED AND CERTIFIED BY THE MANUFACTURER'S AUTHORIZED REPRESENTATIVE.


IMPORTANT NOTE:
AS PER CITY OF MIAMI BEACH ELECTRICAL CHIEF DIRECTIVE:
ALL ELECTRICAL EXPOSED TO SLAT WATER AIR TO BE RATED A MINIMUM OF NEMA-3X INCLUDING PANEL "H" AS PER NEC 110.28, 2011.




1

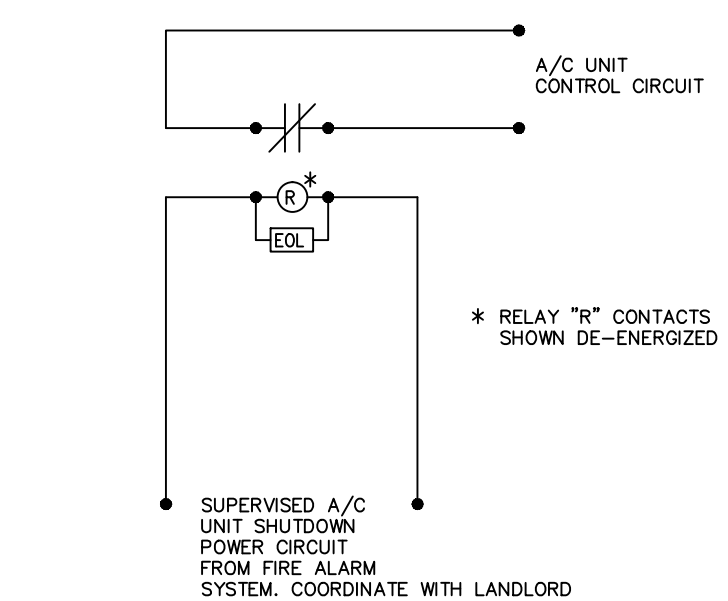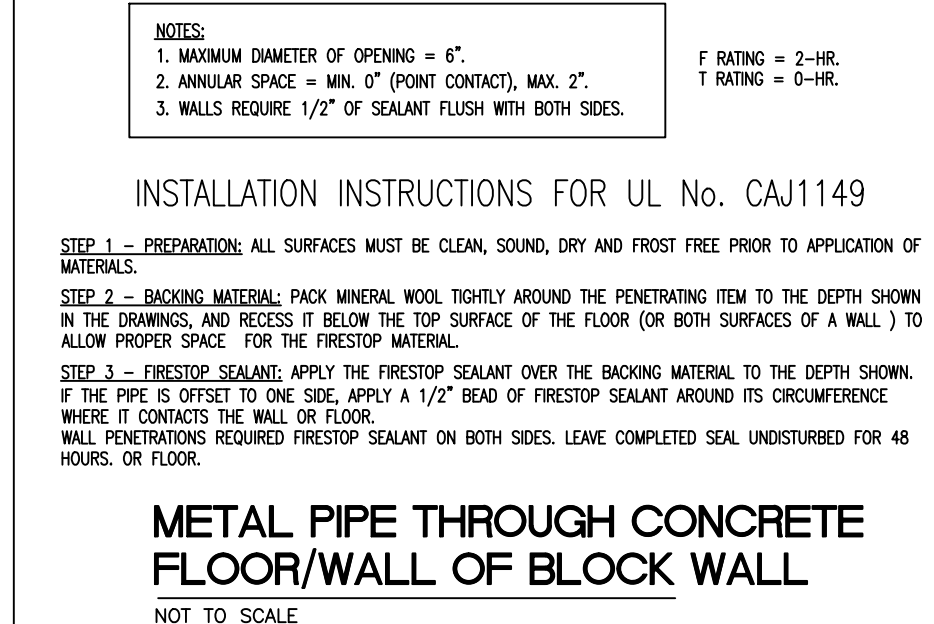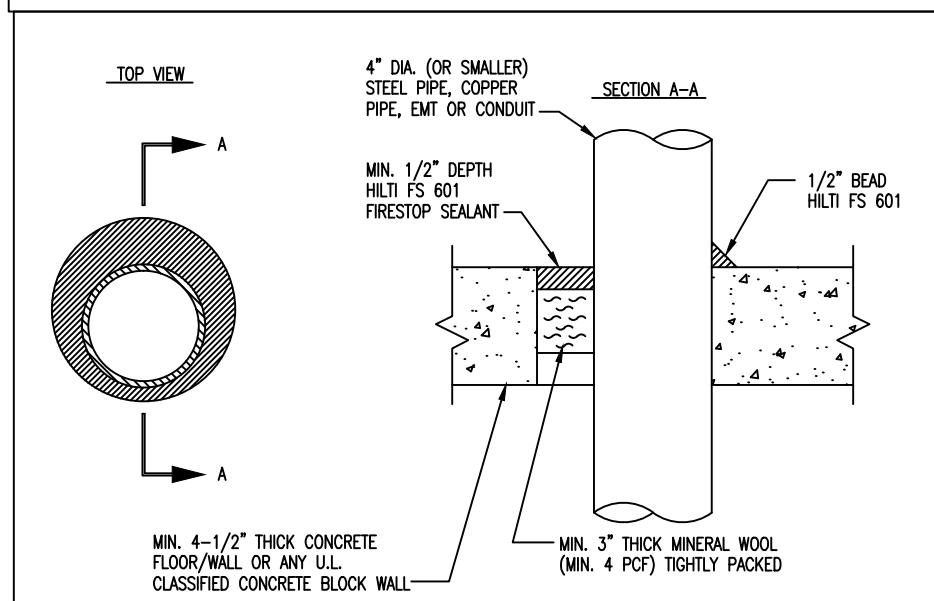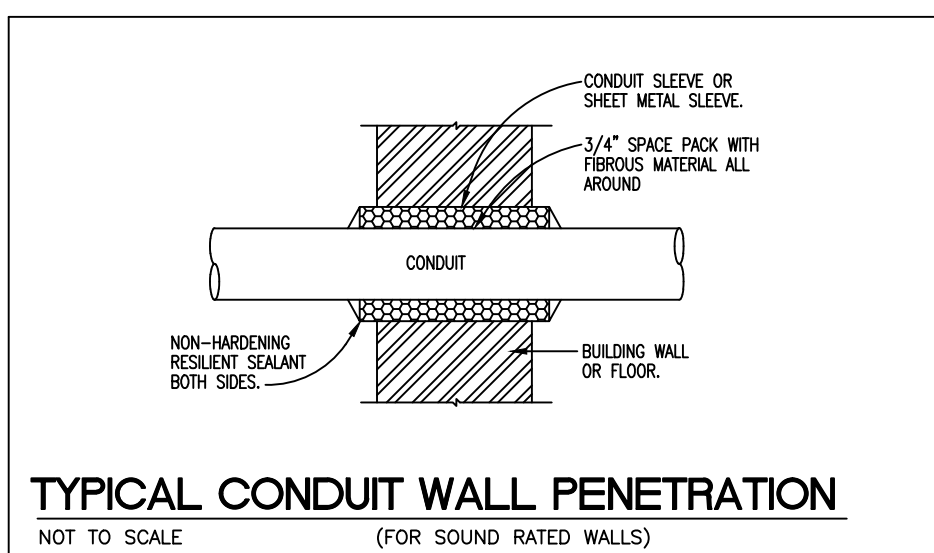

TYP. A/C UNIT SHUNT DOWN DIAGRAM NOT TO SCALE

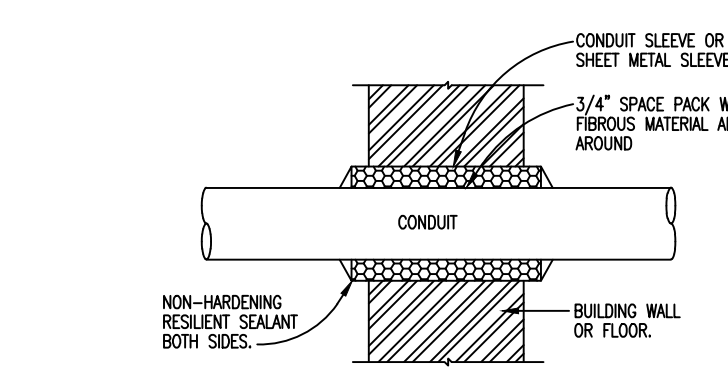


TYPICAL CONDUIT WALL PENETRATION (FOR SOUND RATED WALLS) NOT TO SCALE

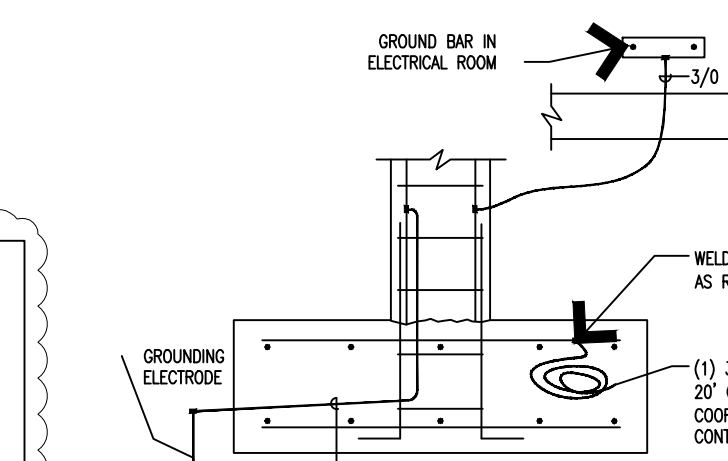


TYPICAL UNDER GROUND IN FOOTING AND COLUMN NOT TO SCALE

TYPICAL UNDER GROUND IN FOOTING AND COLUMN NOT TO SCALE

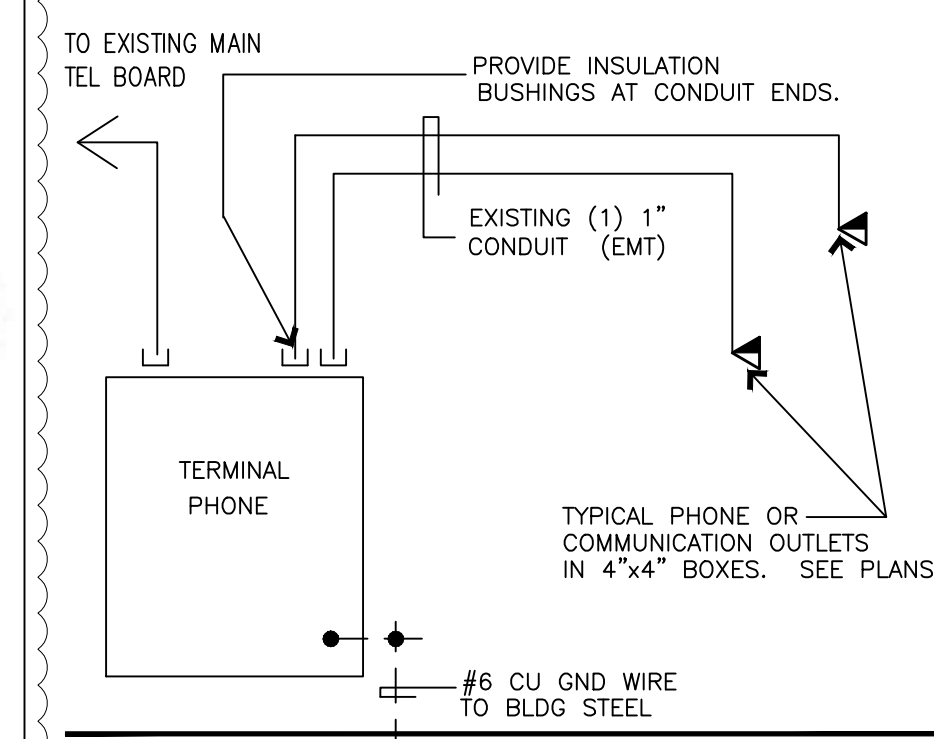


EXISTING TELEPHONE RISER DIAGRAM N.T.S.

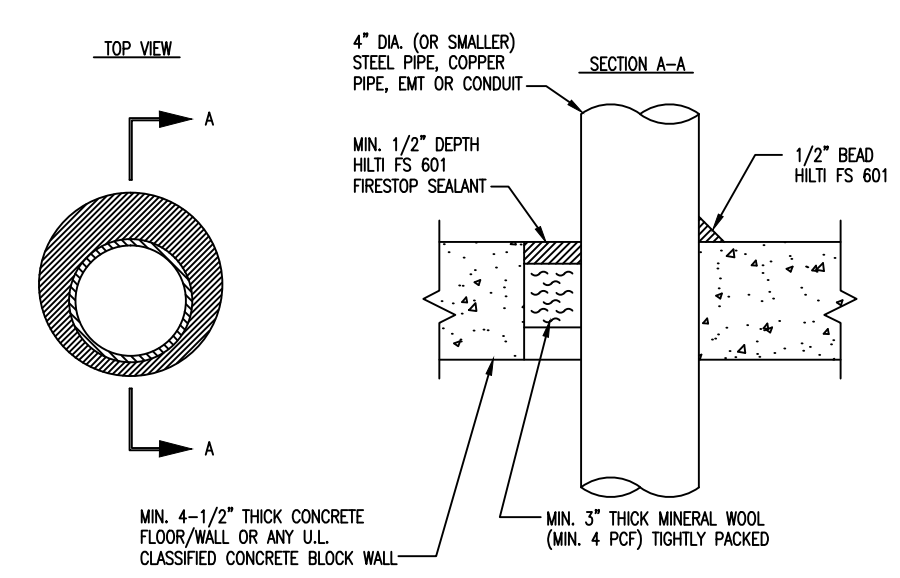


METAL PIPE THROUGH CONCRETE FLOOR/WALL OF BLOCK WALL NOT TO SCALE

INSTALLATION INSTRUCTIONS FOR UL No. CAJ1149
STEP 1 - PREPARATION: ALL SURFACES MUST BE CLEAN, SOUND, DRY AND FROST FREE PRIOR TO APPLICATION OF MATERIALS.
STEP 2 - BACKING MATERIAL: PACK MINERAL WOOL TIGHTLY AROUND THE PENETRATING ITEM TO THE DEPTH SHOWN IN THE DRAWINGS, AND RECESS IT BELOW THE TOP SURFACE OF THE FLOOR (OR BOTH SURFACES OF A WALL) TO ALLOW PROPER SPACE FOR THE FIRESTOP MATERIAL.
STEP 3 - FIRESTOP SEALANT: APPLY THE FIRESTOP SEALANT OVER THE BACKING MATERIAL TO THE DEPTH SHOWN. IF THE PIPE IS OFFSET TO ONE SIDE, APPLY A 1/2" BEAD OF FIRESTOP SEALANT AROUND ITS CIRCUMFERENCE WHERE IT CONTACTS THE WALL OR FLOOR. WALL PENETRATIONS REQUIRED FIRESTOP SEALANT ON BOTH SIDES. LEAVE COMPLETED SEAL UNDISTURBED FOR 48 HOURS, OR FLOOR.


METAL PIPE THROUGH CONCRETE FLOOR/WALL OF BLOCK WALL NOT TO SCALE

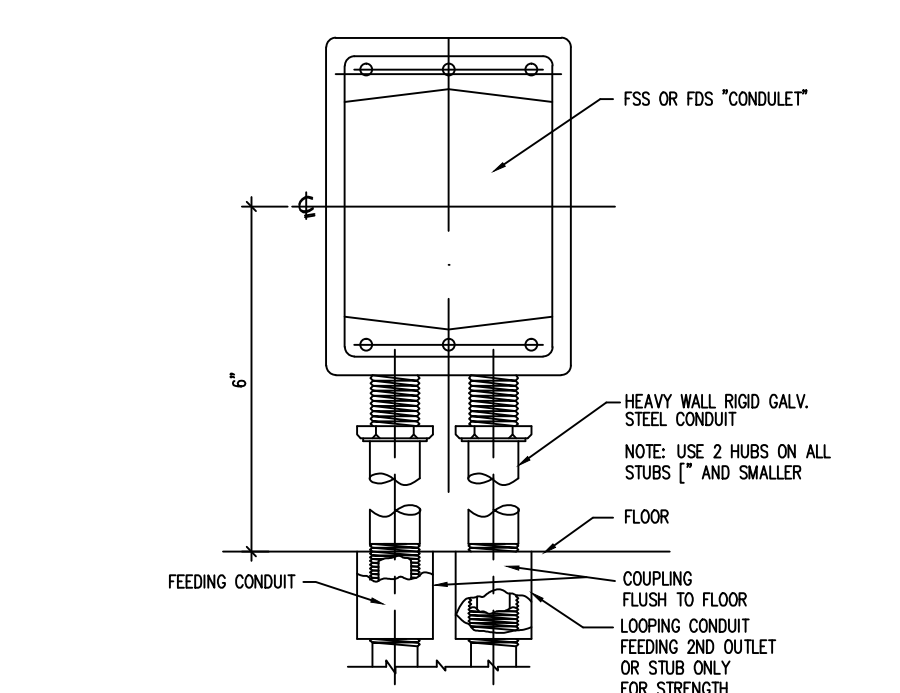


OUTLET STUB UP DETAIL NOT TO SCALE

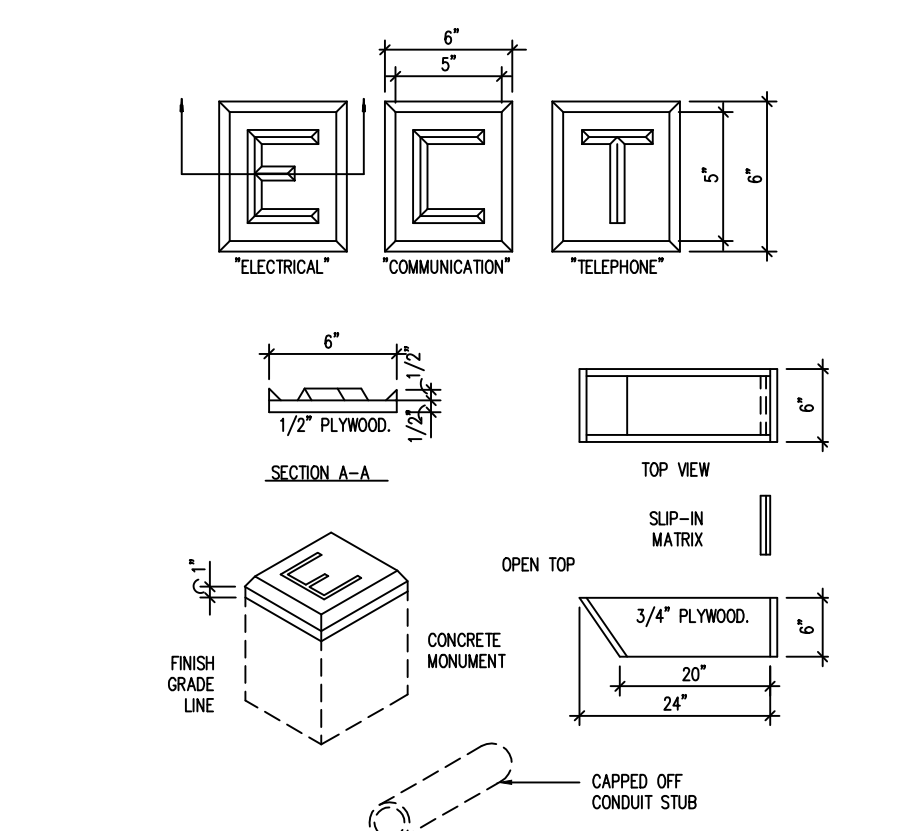


MARKER MONUMENT NOT TO SCALE

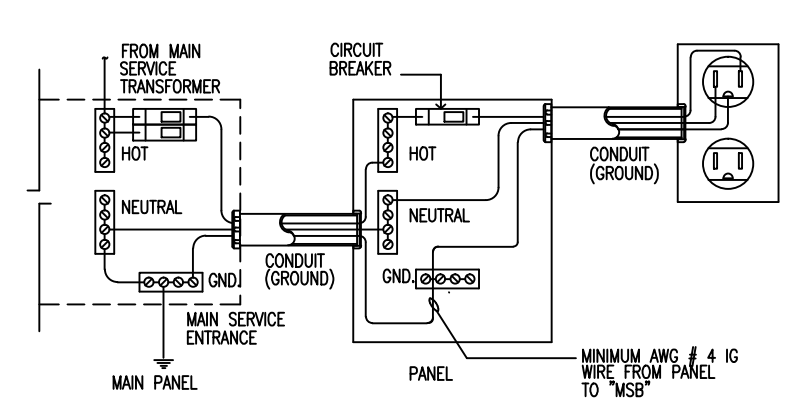


CONDUIT GROUND SCHEMATIC NOT TO SCALE

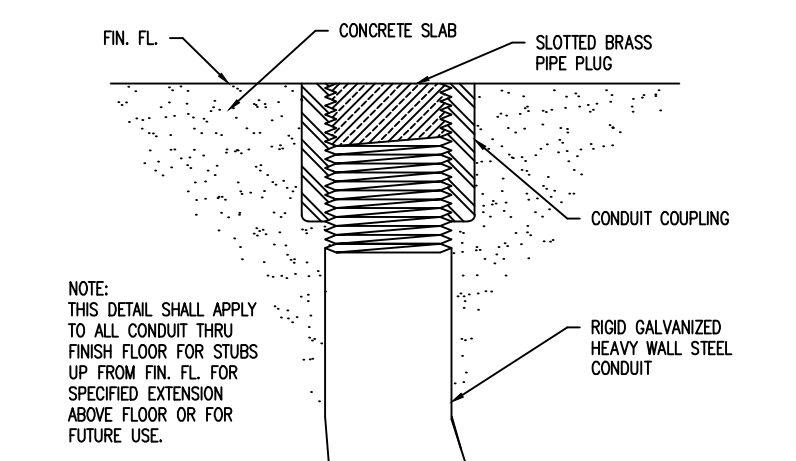


CONDUIT TERMINATION AT FINISH FLOOR NOT TO SCALE

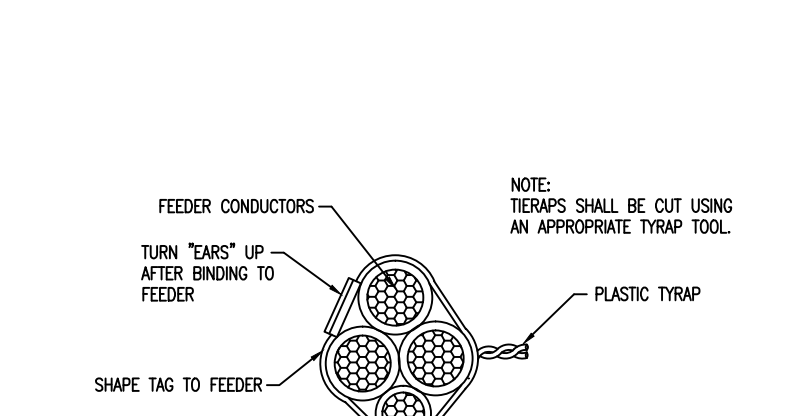

CABLE TAG DETAIL NOT TO SCALE

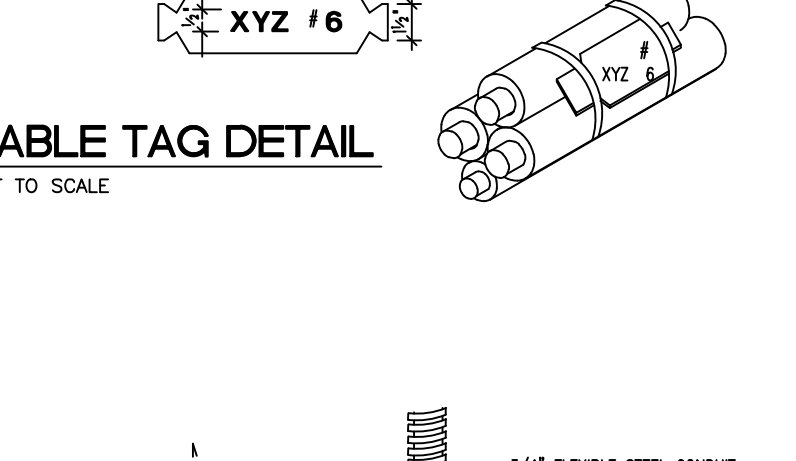


PLUGMOLD ON BACK SPLASH OF DESK NOT TO SCALE

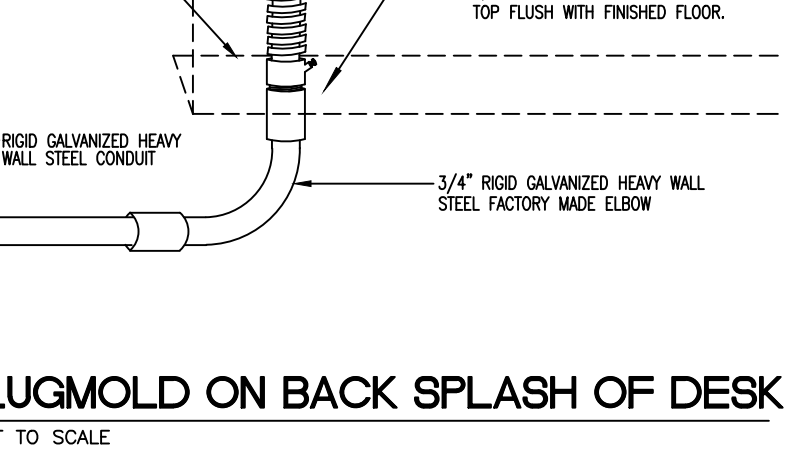


BUSHING SUPPORT DETAIL N.T.S.




FEEDER CONDUIT SLEEVE DETAIL N.T.S.

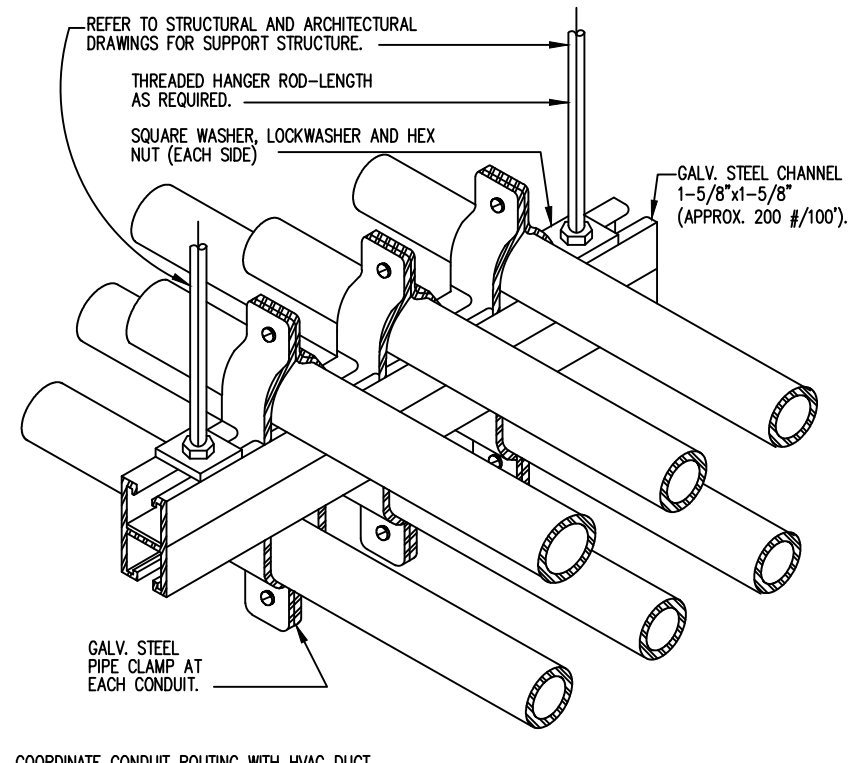


CEILING CONDUIT SUPPORT DETAIL NOT TO SCALE

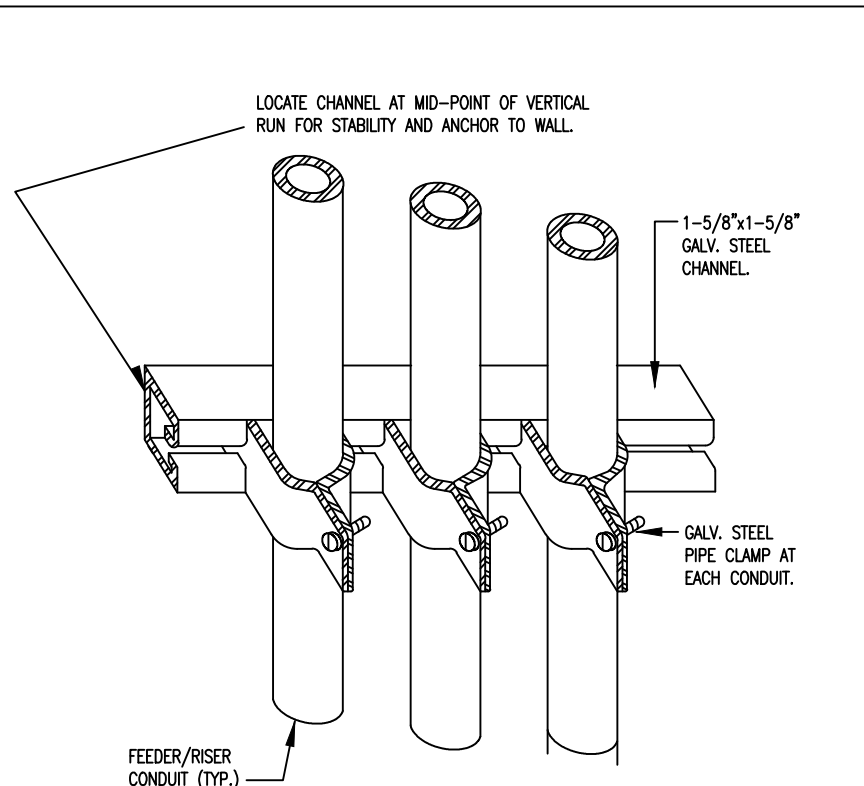

WALL CONDUIT SUPPORT DETAIL NOT TO SCALE

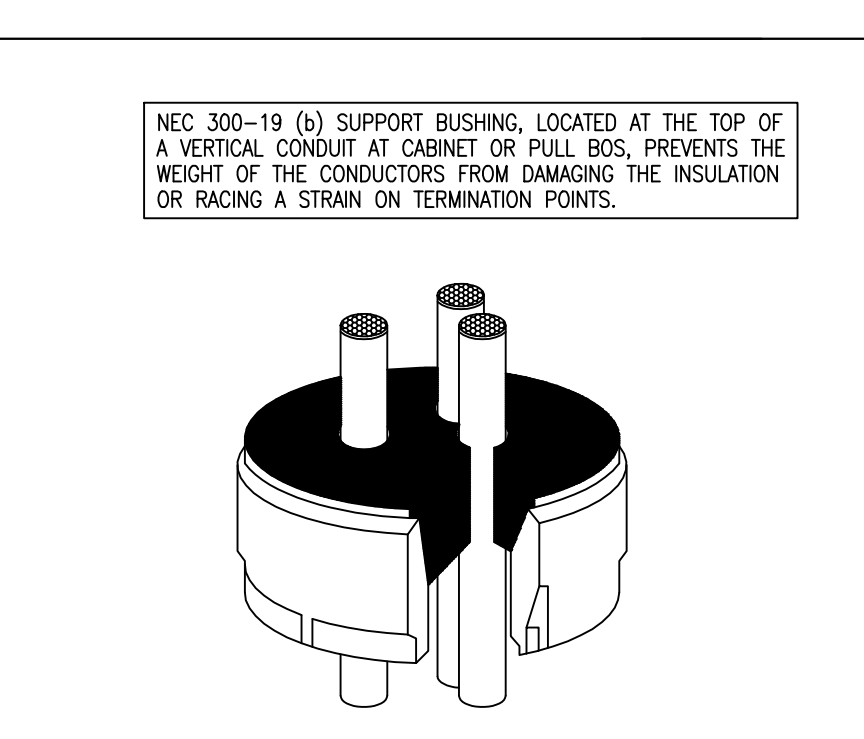

BUSHING SUPPORT DETAIL N.T.S.

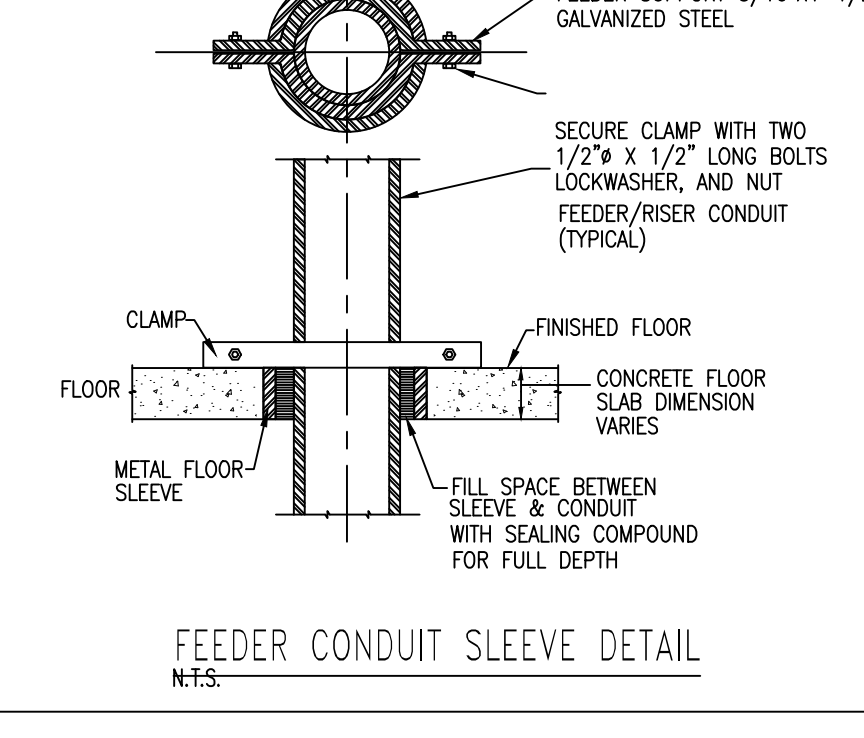

FEEDER CONDUIT SLEEVE DETAIL N.T.S.

2

1

2



SIGNATURE / DATE / SEAL

3

Victor H. Rodriguez,
Registered Architect
State of Florida # AR0094965
305.282.0005 vhr@rda-archint.com

PERMIT SET

Issue: 12.05.2016 / Owner Revisions

05.05.2017 / Reviewer Comments

DDCI Project #: 1628.00

Drawn by: VHR

Approved by: VHR

SHEET INDEX

4 - Details

SCALE:

SHEET NO.

THE DESIGNS INDICATED IN THESE DRAWINGS ARE PROPERTY OF RD Architects. ALL COPYRIGHTS RESERVED © 2016



September 29, 2014
Suntech Development, INC.
305.799.5678 Cel
305.328.9640 Fax
luis@suntechdevelopment.com

Re: Available Fault Current for 1330 15TH ST

Dear: Luis Leon

Thank you for contacting FPL about the available fault current at 1330 15th St Miami Beach, FL 33139. Based on the plans you have provided dated n/a, the maximum available fault current at the transformer secondary terminals is estimated to be 53,205 symmetrical amperes at 120/240 volts. The protective device on the line side of the transformer currently in place or to be installed and serving your property located at the subject location is a 25 amp type "K5" fuse. The primary service voltage is 13.2kV L-L. This calculated symmetrical fault current is not intended for use as the basis for motor starting calculations and does not include:

- Consideration for any motor contribution or
- Fault current asymmetry.

The FPL equipment currently serving or planned to serve your facility may change over time as a result of any number of factors, including but not limited to transformer replacements due to load growth, electrical grid changes or emergencies. As a result, although we are providing you with this information for the sole purpose of assisting you in the completion of your study, you and your client should not design, install or operate your system in reliance upon any expectation that the specific size and type of equipment currently in place will remain so. If and when the size and type of the equipment changes, our employees are not always in a position to immediately notify customers.

As the construction project progresses, any questions or information you may need can be communicated through me. I have enclosed my business card for easy reference and look forward to hearing from you in the near future.




Sincerely,

Joel R Garcia

Joel R.Garcia
Engineer II

PROJECT: **1330 Building**
 1330 15th Street, Miami Beach, FL 33139
 PROJECT OWNER:
 NOTUS, LLC
 435 21st Street, Miami Beach, FL 33139
 ARCHITECT OF RECORD:


RD Architects
 1800 SW 1st Avenue, Suite 607, Miami, Florida 33129
 P: 786.762.2679 F: 305.831.8079 C: 305.282.0005
 Email: rda@rda-archint.com
 www.rda@rda-archint.com / AA26002510

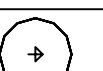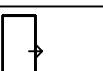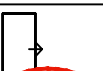
Luminaire Schedule								
Project: 1330 15TH STREET, MIAMI BEACH - SITE - REV2 --- MAR - 6 - 2018								
Symbol	Qty	Label	Description	LLD	LDD	LLF	Lum. Watts	Total Watts
	9	B	SISTEMALUX S.5317N-UNV BOLLARD	0.900	0.900	0.810	10	90
	2	W2	HE WILLIAMS VVPH-L60-740-TFT-CGL-EM_10W	0.900	0.900	0.810	68.8	137.6
	3	W3	HE WILLIAMS VVPH-L30-730-T3-CGL-EM_10W	0.900	0.900	0.810	35.7	107.1


Calculation Summary					
Project: 1330 15TH STREET, MIAMI BEACH - SITE - REV2 --- MAR - 6 - 2018					
Label	Avg	Max	Min	Avg/Min	Max/Min
BLDG PERIMETER	2.88	6.3	1.0	2.88	6.30
PROPERTY LINE ADJ TO RESIDENTIAL	0.48	0.9	0.2	2.40	4.50

7 6

1
2
3
4

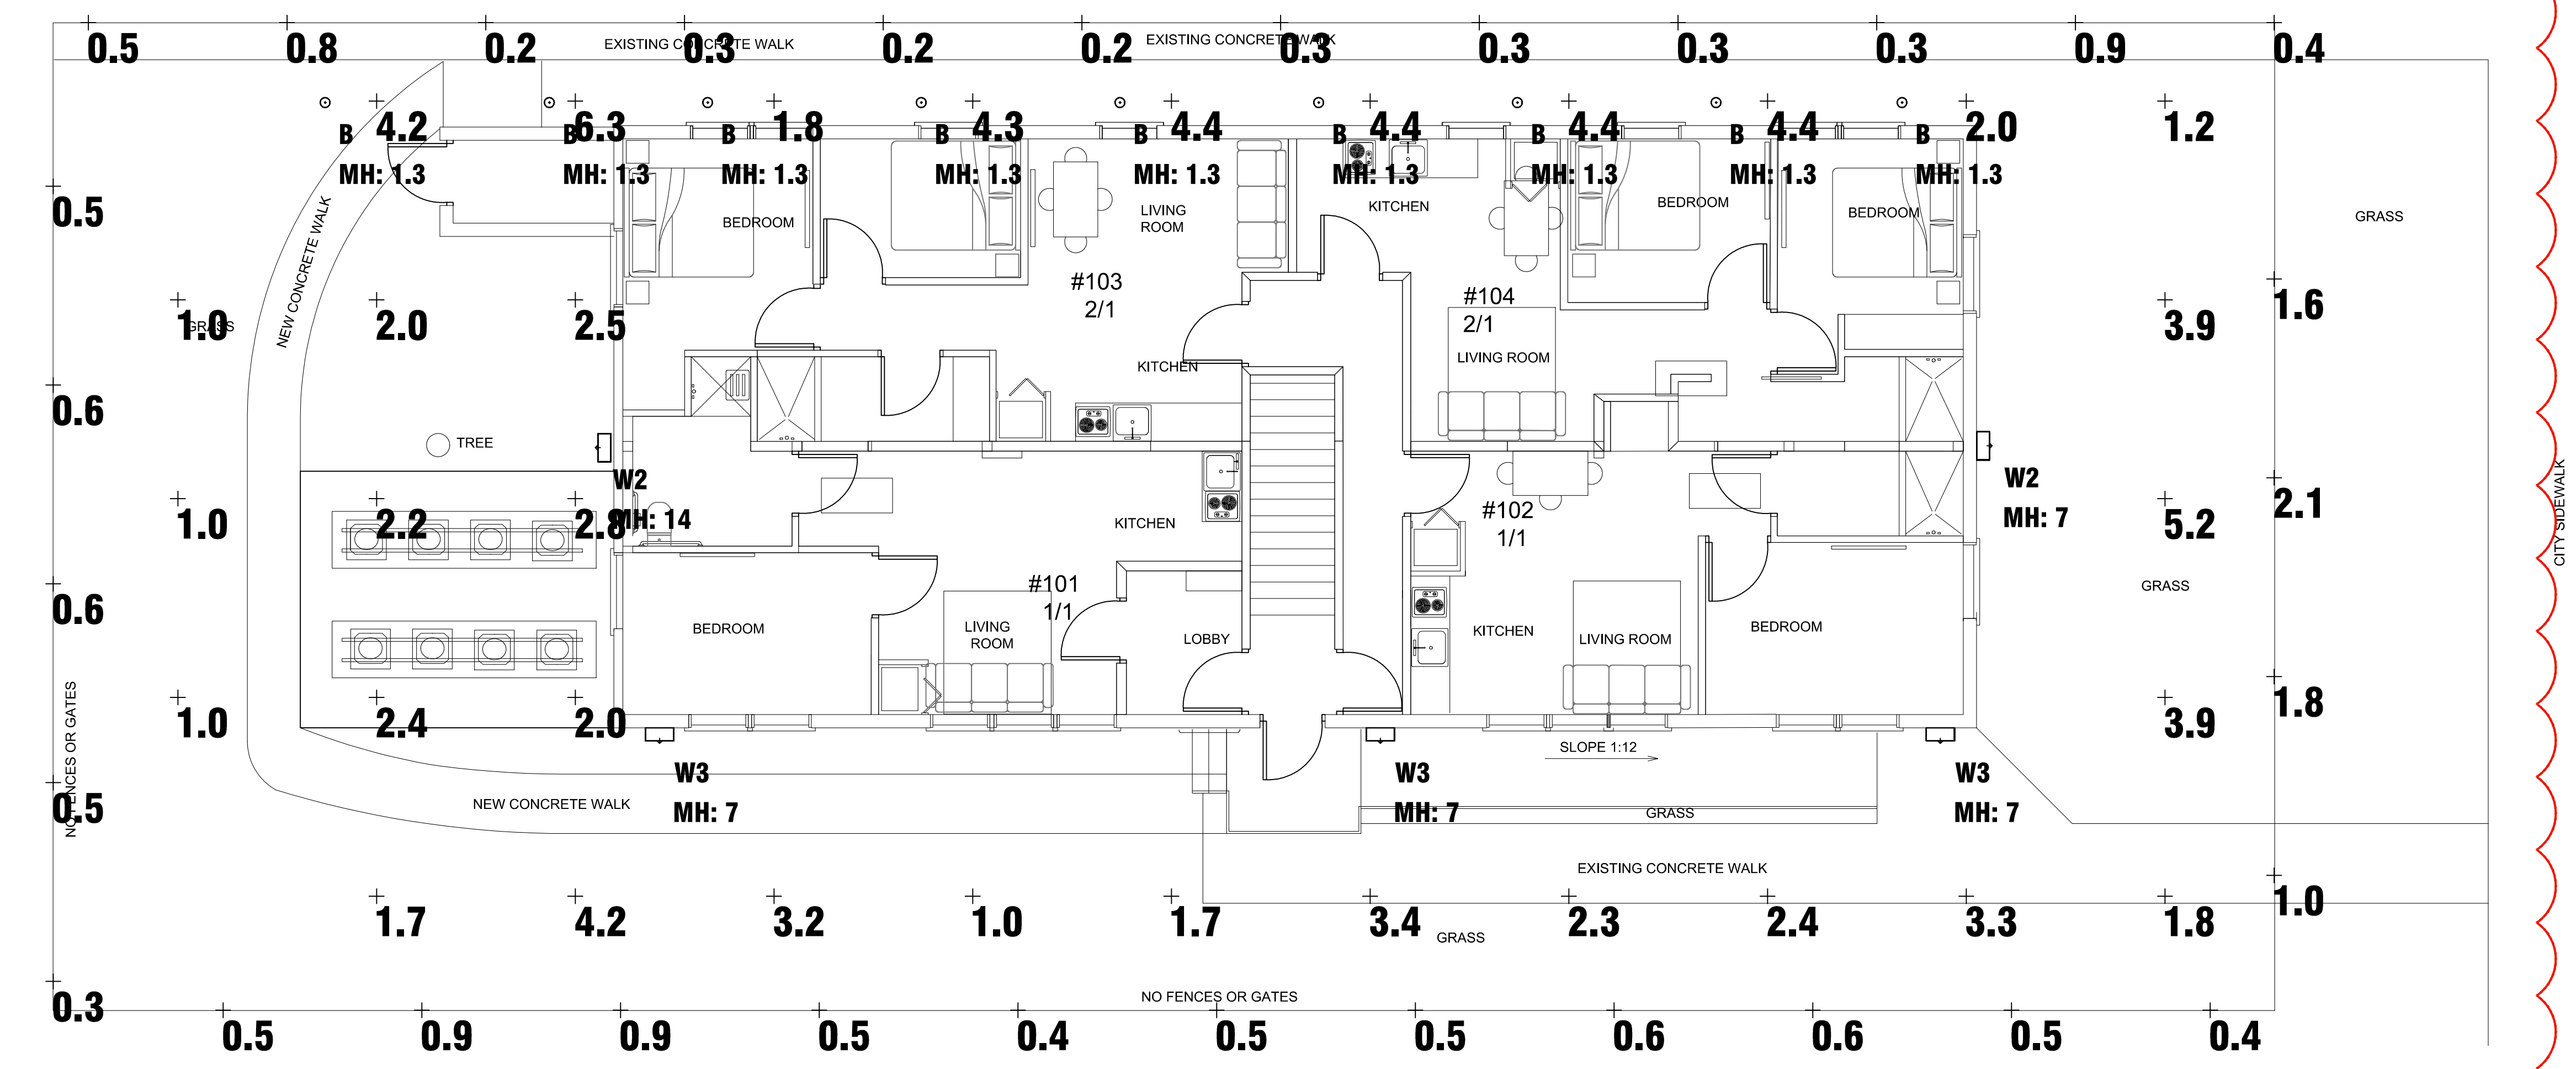


CONSULTANT ENGINEER:
 KEY PLAN

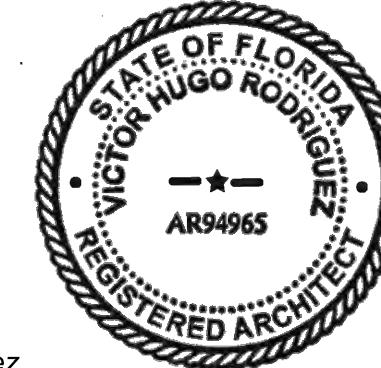
SIGNATURE / DATE / SEAL
 NOT VALID IF MISSING SIGNATURE

 Victor H. Rodriguez,
 Registered Architect
 State of Florida # AR0094965
 305.282.0005 vh.rodriguez@rda-archint.com

PERMIT SET

Issue	Issue Date / For
(1)	09.12.2016 / Change of Architect
(2)	12.17.2017 / Fire Dept. Comments
(3)	02.19.2018 / City Comments
(4)	04.20.2018 / Reviewer Comments

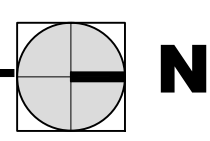PHOTOMETRICS SITE PLAN

SCALE: 3/16" = 1'-0" 

THE DESIGNS INDICATED IN THESE DRAWINGS ARE PROPERTY OF RD Architects. ALL COPYRIGHTS RESERVED © 2016


DDCI Project #: 1628.00
 Drawn by: VHR
 Approved by: VHR
 SHEET INDEX
- Photometric Site Plan
 SCALE:
 SHEET NO.

E-6

Luminaire Schedule			
Symbol	Qty	Label	Description
⊕	9	B	SISTEMALUX S.S317H-UVV OPERATING FROM INVERTER
⊞	2	W2	HE WILLIAMS VWPH-L60-740-TFT-CGL-EM_10W BATTERY BACKUP
⊞	3	W3	HE WILLIAMS VWPH-L30-730-T3-CGL-EM_10W BATTERY BACKUP

Calculation Summary					
Project: 1330 15TH STREET, MIAMI BEACH - SITE - EM MODE - REV2 --- MAR - 6 - 2018					
Label	Avg	Max	Min	Avg/Min	Max/Min
BLDG PERIMETER	1.58	6.3	0.2	7.90	31.50

7 6

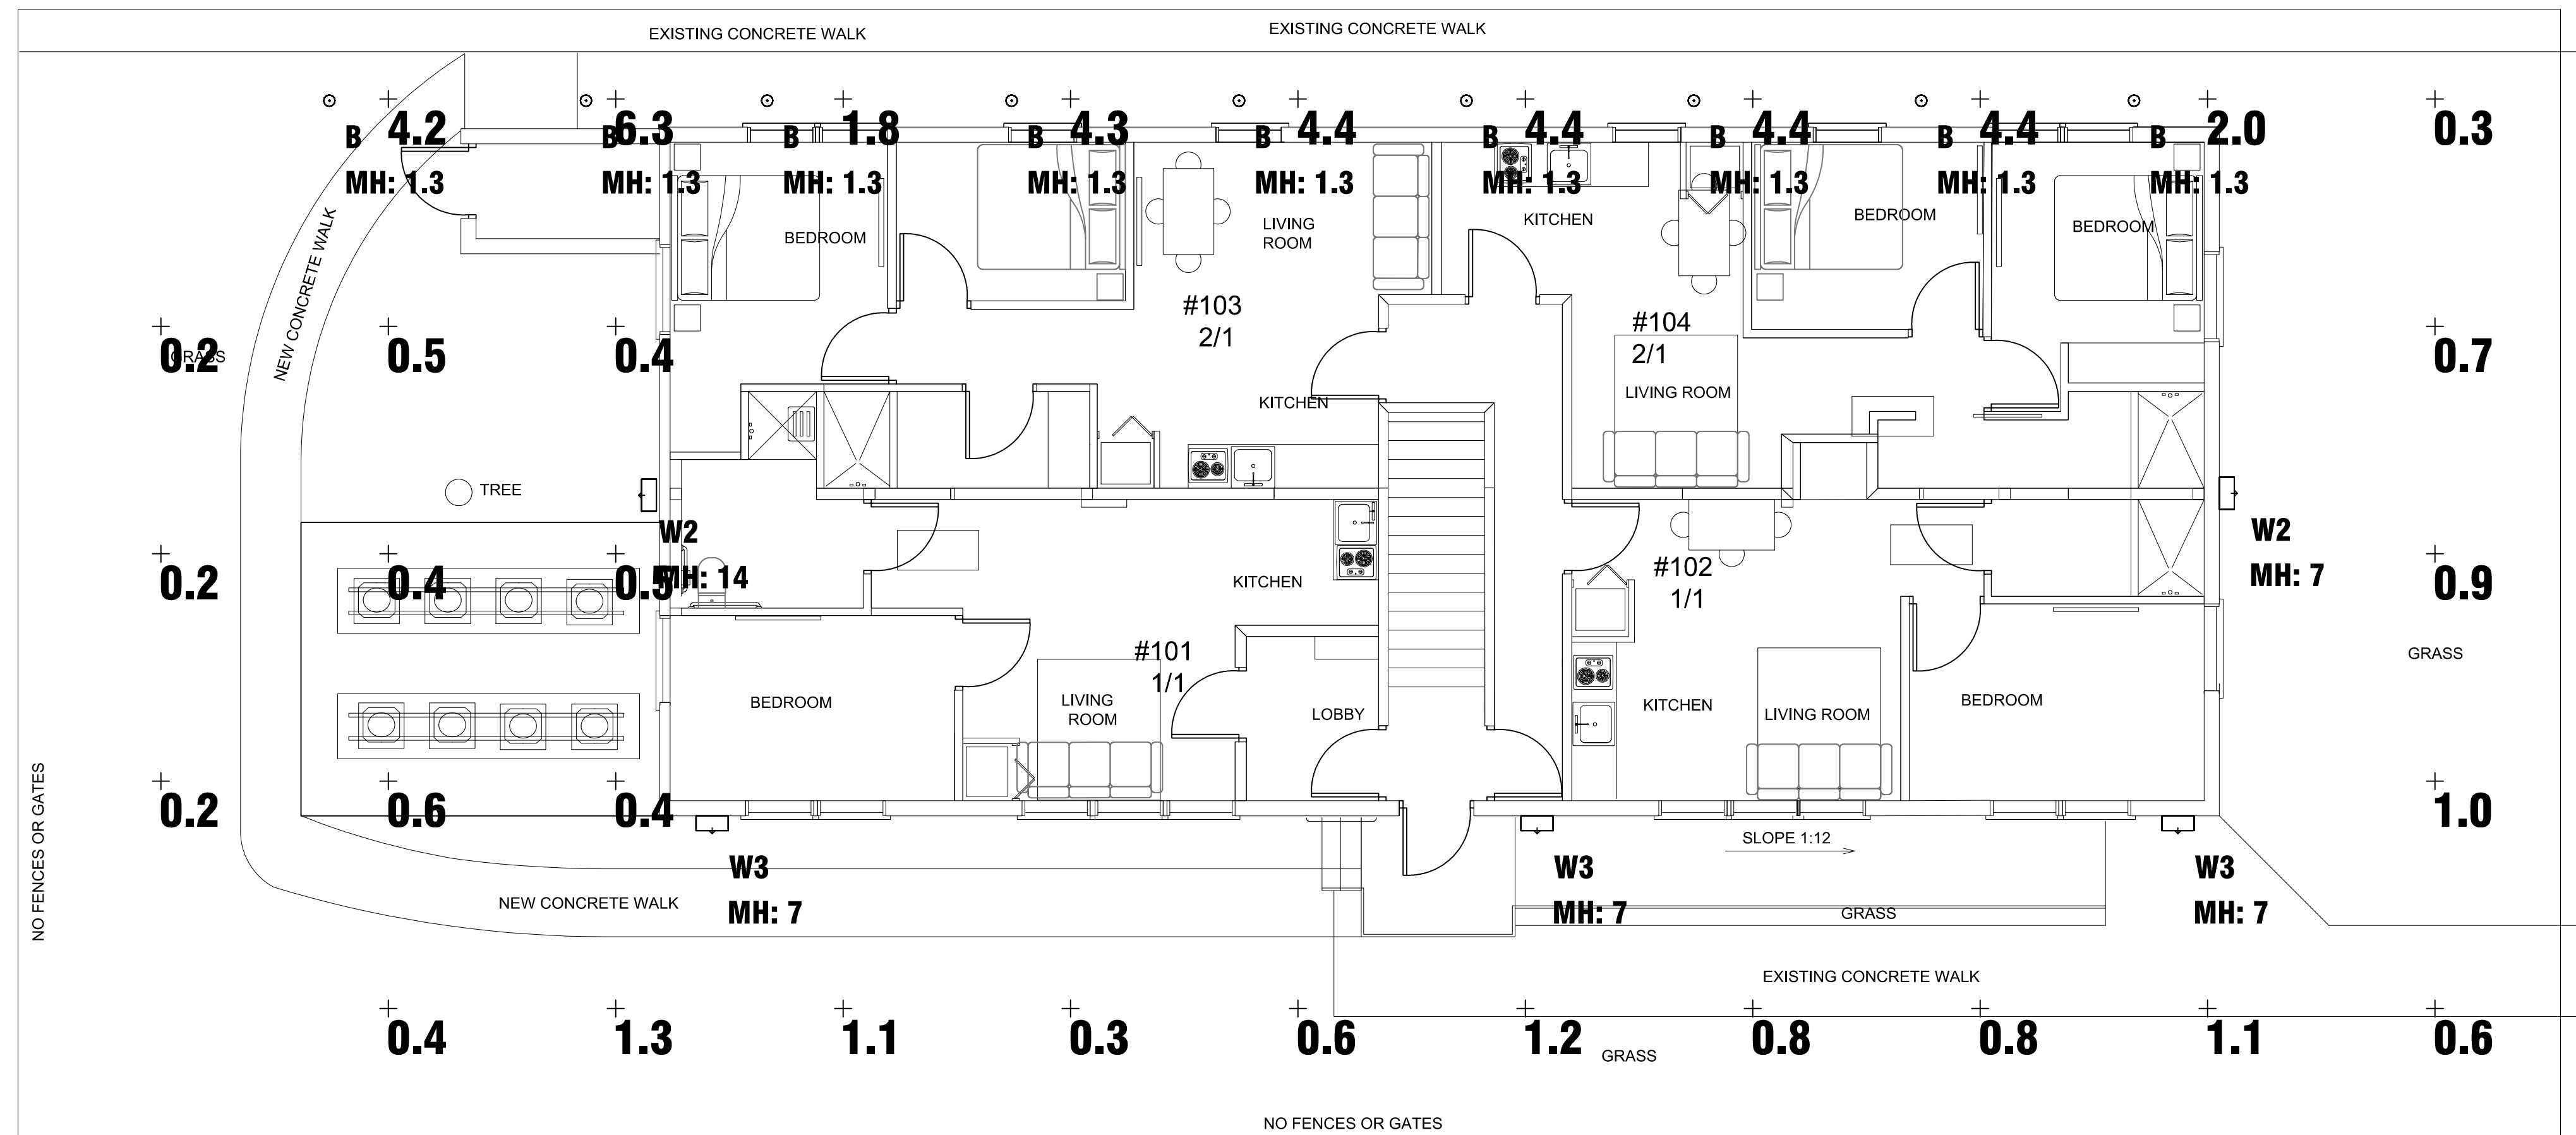

PHOTOMETRICS SITE PLAN - EMERGENCY
 SCALE: 3/16" = 1'-0" N

PROJECT: **1330 Building**
 1330 15th Street, Miami Beach, FL 33139
 PROJECT OWNER: NOTUS, LLC
 435 21st Street, Miami Beach, FL 33139
 ARCHITECT OF RECORD:
RD Architects
 1800 SW 1st Avenue, Suite 607, Miami, Florida 33129
 P: 786.762.2679 F: 305.831.8079 C: 305.282.0005
 Email: rda@rda-archint.com
 www.rda@rda-archint.com / AA26002510

CONSULTANT ENGINEER:
 KEY PLAN:


SIGNATURE / DATE / SEAL
 NOT VALID IF MISSING SIGNATURE

 Victor H. Rodriguez,
 Registered Architect
 State of Florida # AR0094965
 305.282.0005 vh.rodriguez@rda-archint.com

PERMIT SET
 Issue: Issue Date / For
 (1) 09.12.2016 / Change of Architect
 (2) 12.17.2017 / Fire Dept. Comments
 (3) 02.19.2018 / City Comments
 (4) 04.20.2018 / Reviewer Comments


DDCI Project #: 1628.00
 Drawn by: VHR
 Approved by: VHR
 SHEET INDEX
**- Site Plan Photometrics
 Emergency Mode**

SCALE:
 SHEET NO.
E-7

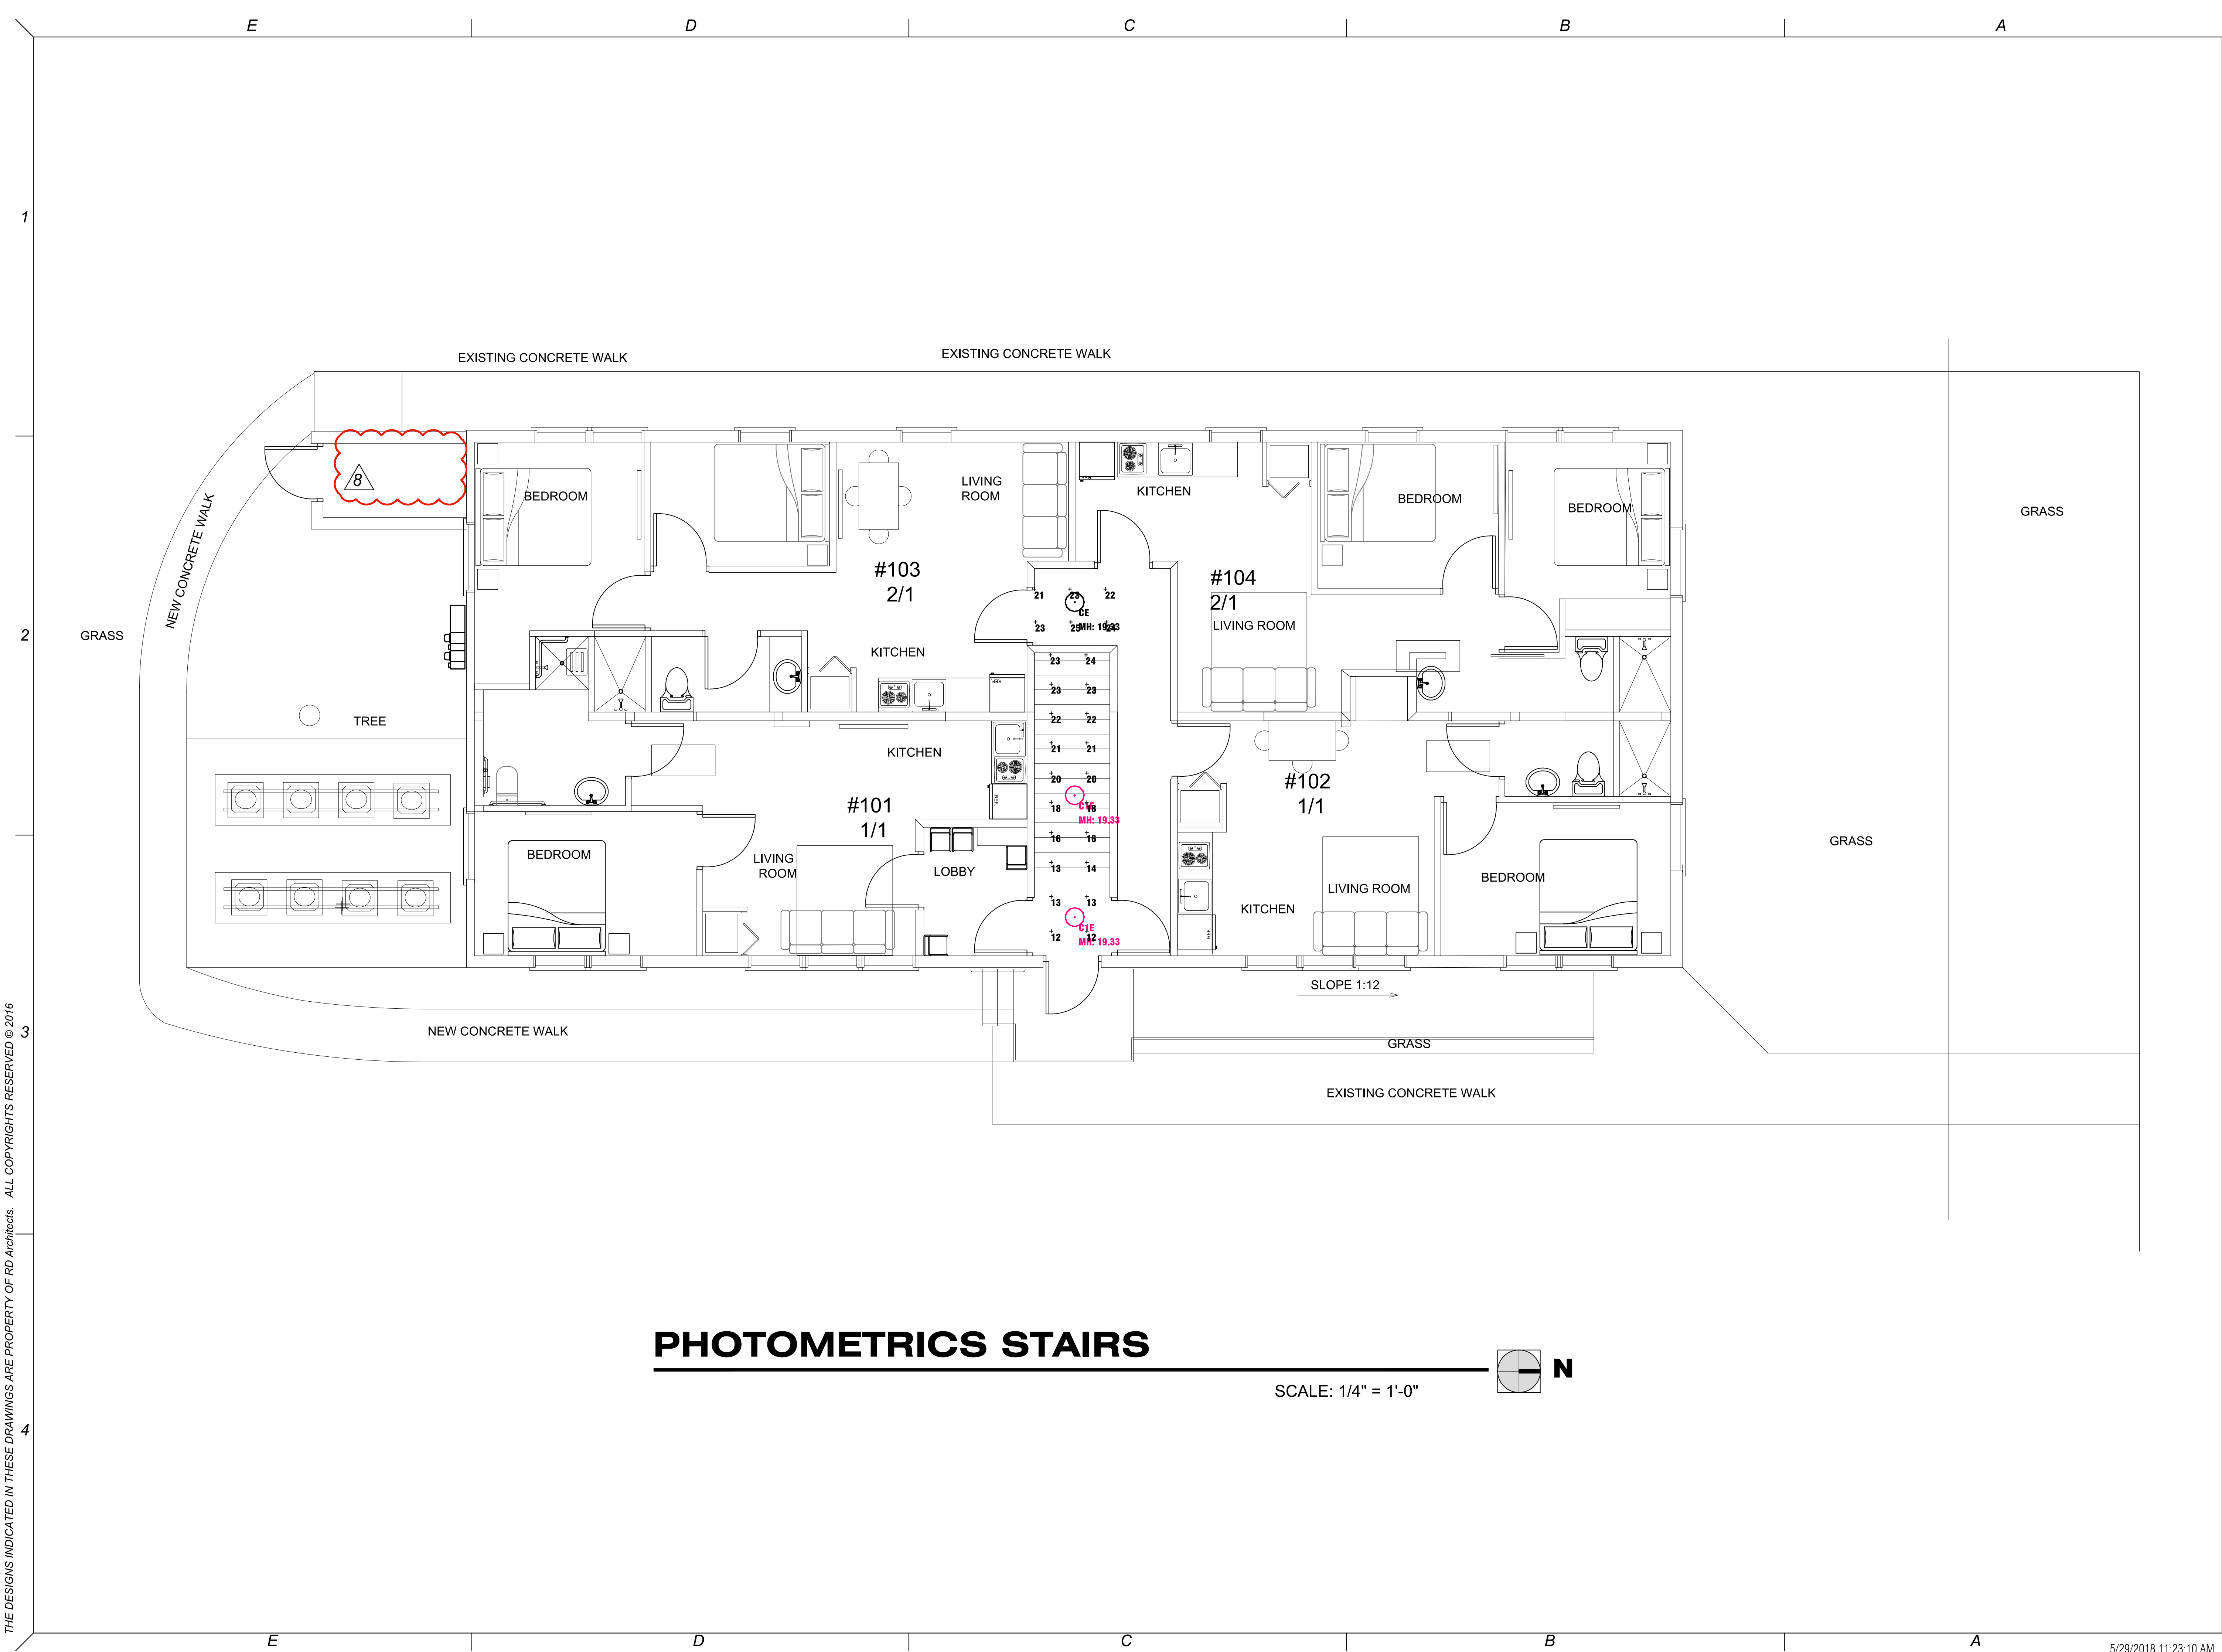


PHOTOMETRICS STAIRS


SCALE: 1/4" = 1'-0"

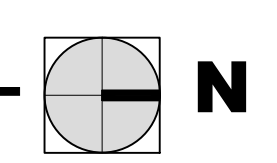

PROJECT: **1330 Building**
 1330 15th Street, Miami Beach, FL 33139
 PROJECT OWNER:
 NOTUS, LLC
 435 21st Street, Miami Beach, FL 33139
 ARCHITECT OF RECORD:

RD Architects
 1800 SW 1st Avenue, Suite 607, Miami, Florida 33129
 P: 786.762.2679 F: 305.831.8079 C: 305.282.0005
 Email: rda@rda-archint.com / www.rda@rda-archint.com / AA26002510

CONSULTANT ENGINEER:
 KEY PLAN

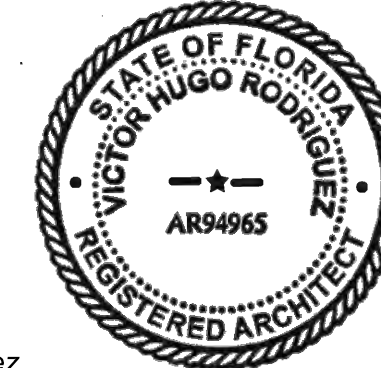
SIGNATURE / DATE / SEAL
 NOT VALID IF MISSING SIGNATURE

 Victor H. Rodriguez,
 Registered Architect
 State of Florida # AR0094965
 305.282.0005 vh.rodriguez@rda-archint.com

PERMIT SET

Issue	Issue Date / For
①	09.12.2016 / Change of Architect
△	12.17.2017 / Fire Dept. Comments
△	02.19.2018 / City Comments
△	04.20.2018 / Reviewer Comments
△	05.29.2018 / Reviewer Comments

DDCI Project #: 1628.00
 Drawn by: VHR
 Approved by: VHR
 SHEET INDEX
4 - Photometrics at Stairs

SCALE:
 SHEET NO.
E-8

THE DESIGNS INDICATED IN THESE DRAWINGS ARE PROPERTY OF RD Architects. ALL COPYRIGHTS RESERVED © 2016

1

2

3

4

THE DESIGNS INDICATED IN THESE DRAWINGS ARE PROPERTY OF RD Architects. ALL COPYRIGHTS RESERVED © 2016

PROJECT:

1330 Building

1330 15th Street, Miami Beach, FL 33139

PROJECT OWNER:

NOTUS, LLC
435 21st Street, Miami Beach, FL 33139

ARCHITECT OF RECORD:




RD Architects
1800 SW 1st Avenue, Suite 607, Miami, Florida 33129
P: 786.762.2679 F: 305.831.8079 C: 305.282.0005
Email: rda@rda-archint.com
www.rda@rda-archint.com / AA26002510

CONSULTANT ENGINEER:

Luminaire Schedule								
Project: 1330 15TH STREET, MIAMI BEACH - INTERIOR STAIR & CORRIDORS --- JAN - 17 - 2018								
Symbol	Qty	Label	Description	LLD	LDD	LLF	Lum. Watts	Total Watts
	2	C	LUMINAIRE ARV13-25W-4000K-120_277-CP	0.900	0.900	0.810	27.5	55
	2	C1E	LUMINAIRE ARV13HO-50W-4000K-120_277-CP-EMB310	0.900	0.900	0.810	55.5	111
	5	CE	LUMINAIRE ARV13-25W-4000K-120_277-CP-EMB310	0.900	0.900	0.810	27.5	137.5

Calculation Summary					
Project: 1330 15TH STREET, MIAMI BEACH - INTERIOR STAIR & CORRIDORS --- JAN - 17 - 2018					
Label	Avg	Max	Min	Avg/Min	Max/Min
1ST FLR CORRIDOR_Floor	26.50	31	18	1.47	1.72
2ND FLR CORRIDOR_1_Floor	16.13	18	15	1.08	1.20
2ND FLR CORRIDOR_Floor	16.25	18	15	1.08	1.20
STAIRS	19.31	25.0	12.0	1.61	2.08

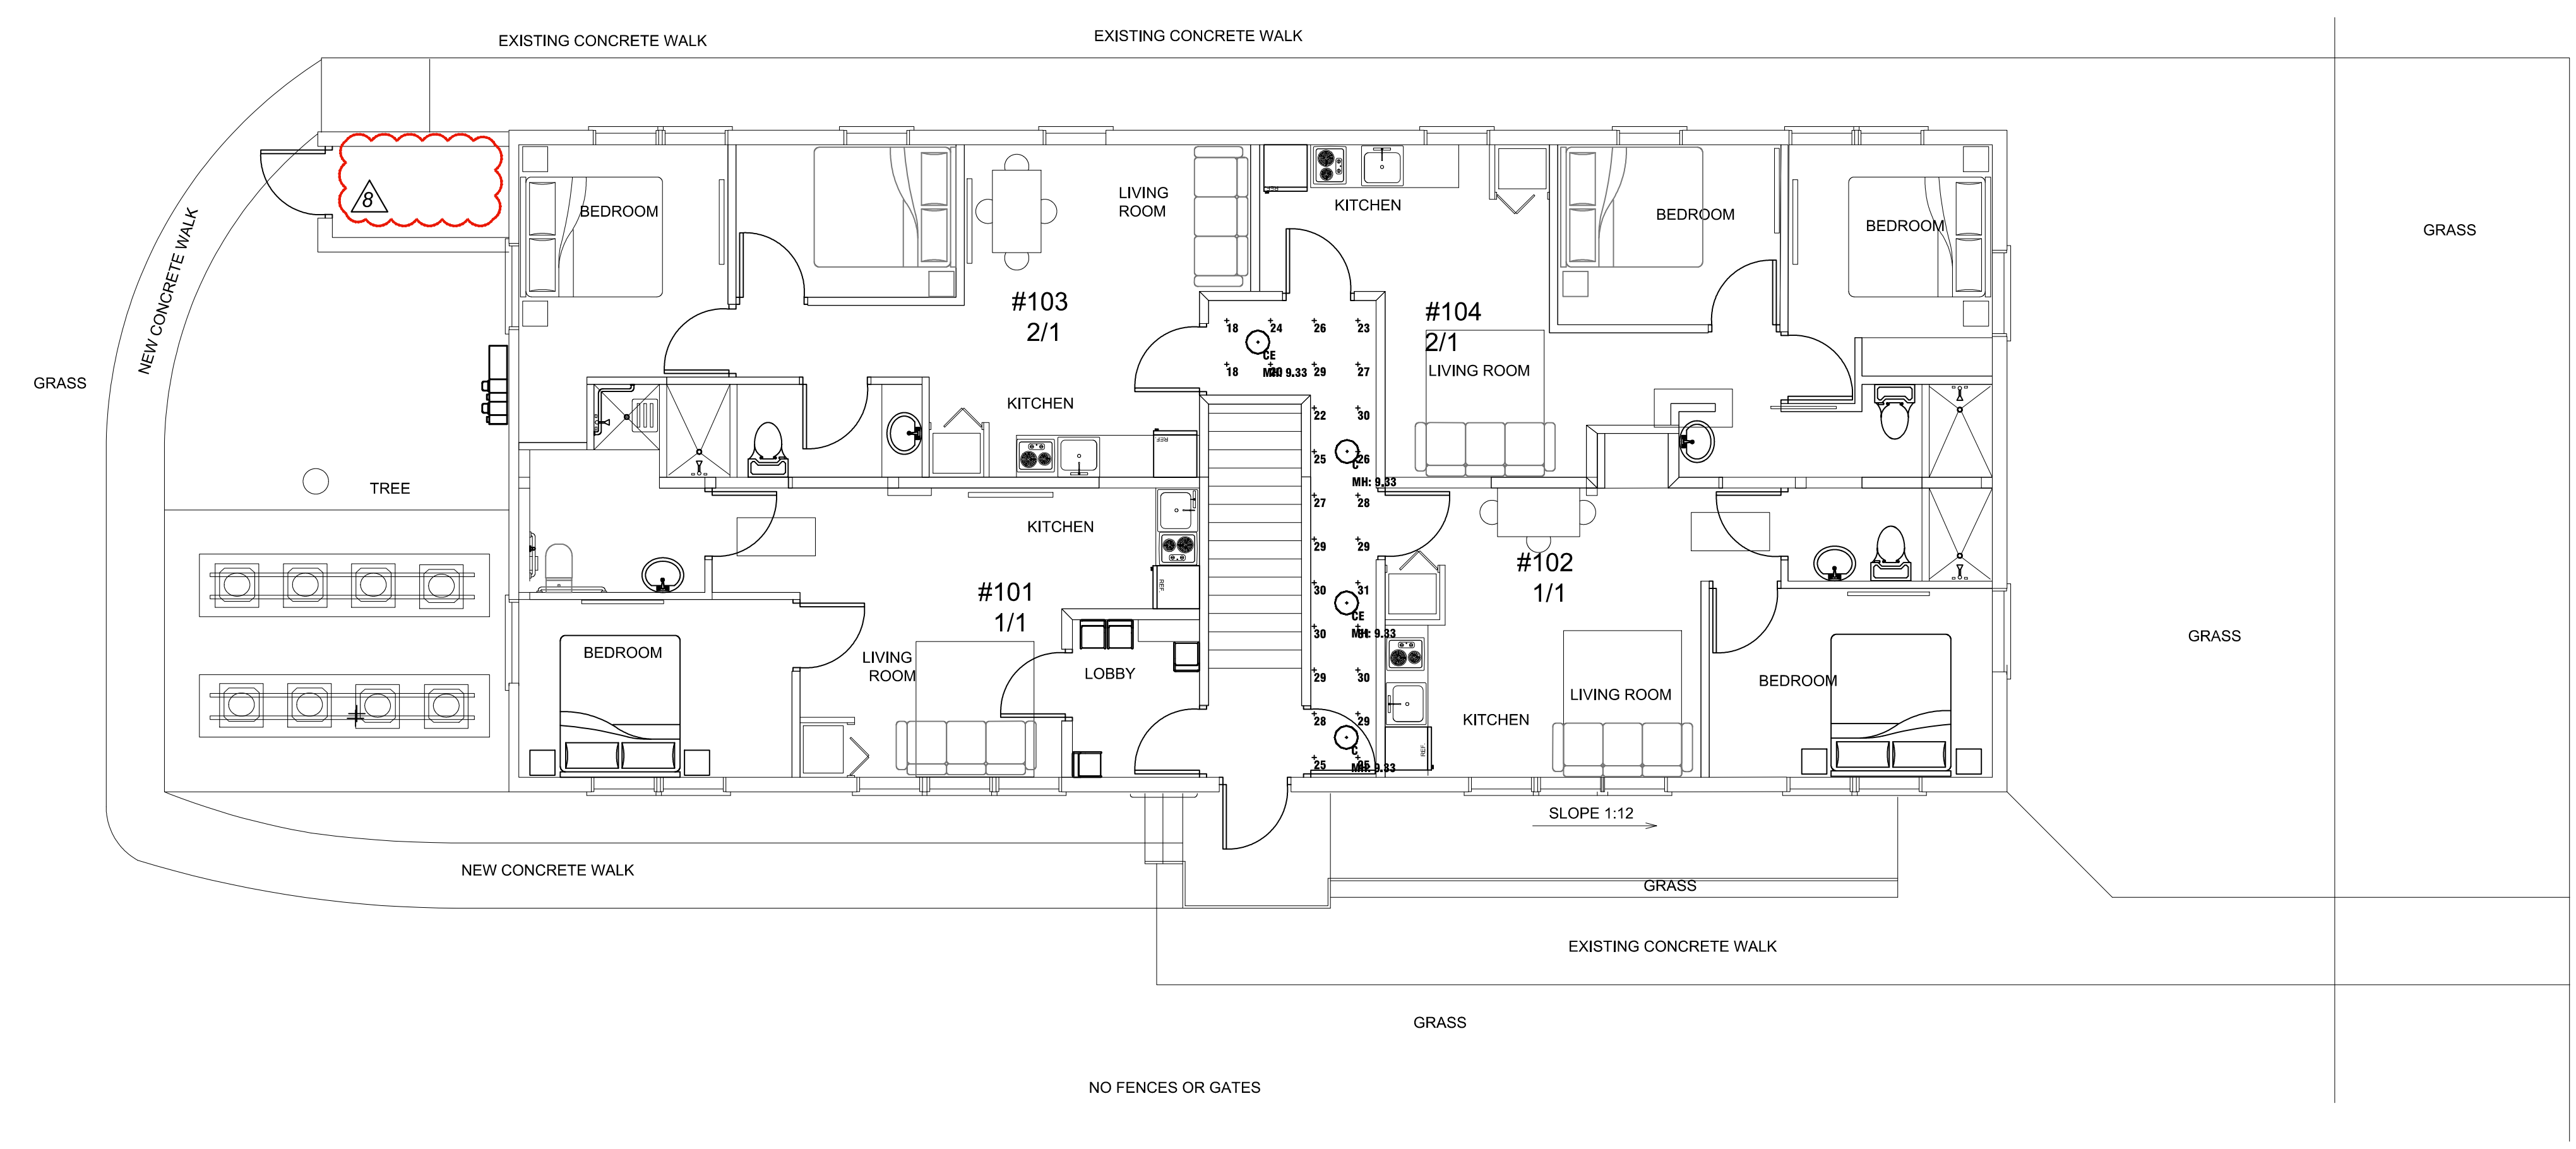


PHOTOMETRICS GROUND FLOOR PLAN
SCALE: 1/4" = 1'-0"



SIGNATURE / DATE / SEAL

NOT VALID IF MISSING SIGNATURE

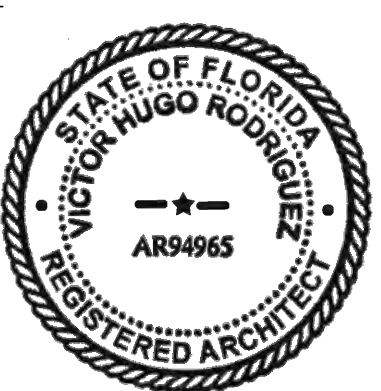

Victor H. Rodriguez,
Registered Architect
State of Florida # AR0094965
305.282.0005 v.h.rodriguez@rda-archint.com

PERMIT SET


Issue	Issue Date / For
	09.12.2016 / Change of Architect
	12.17.2017 / Fire Dept. Comments
	02.19.2018 / City Comments
	04.20.2018 / Reviewer Comments
	05.29.2018 / Reviewer Comments

DDCI Project #: 1628.00
Drawn by: VHR
Approved by: VHR

SHEET INDEX
- Photometrics Ground Floor

SCALE:
SHEET NO.

E-9

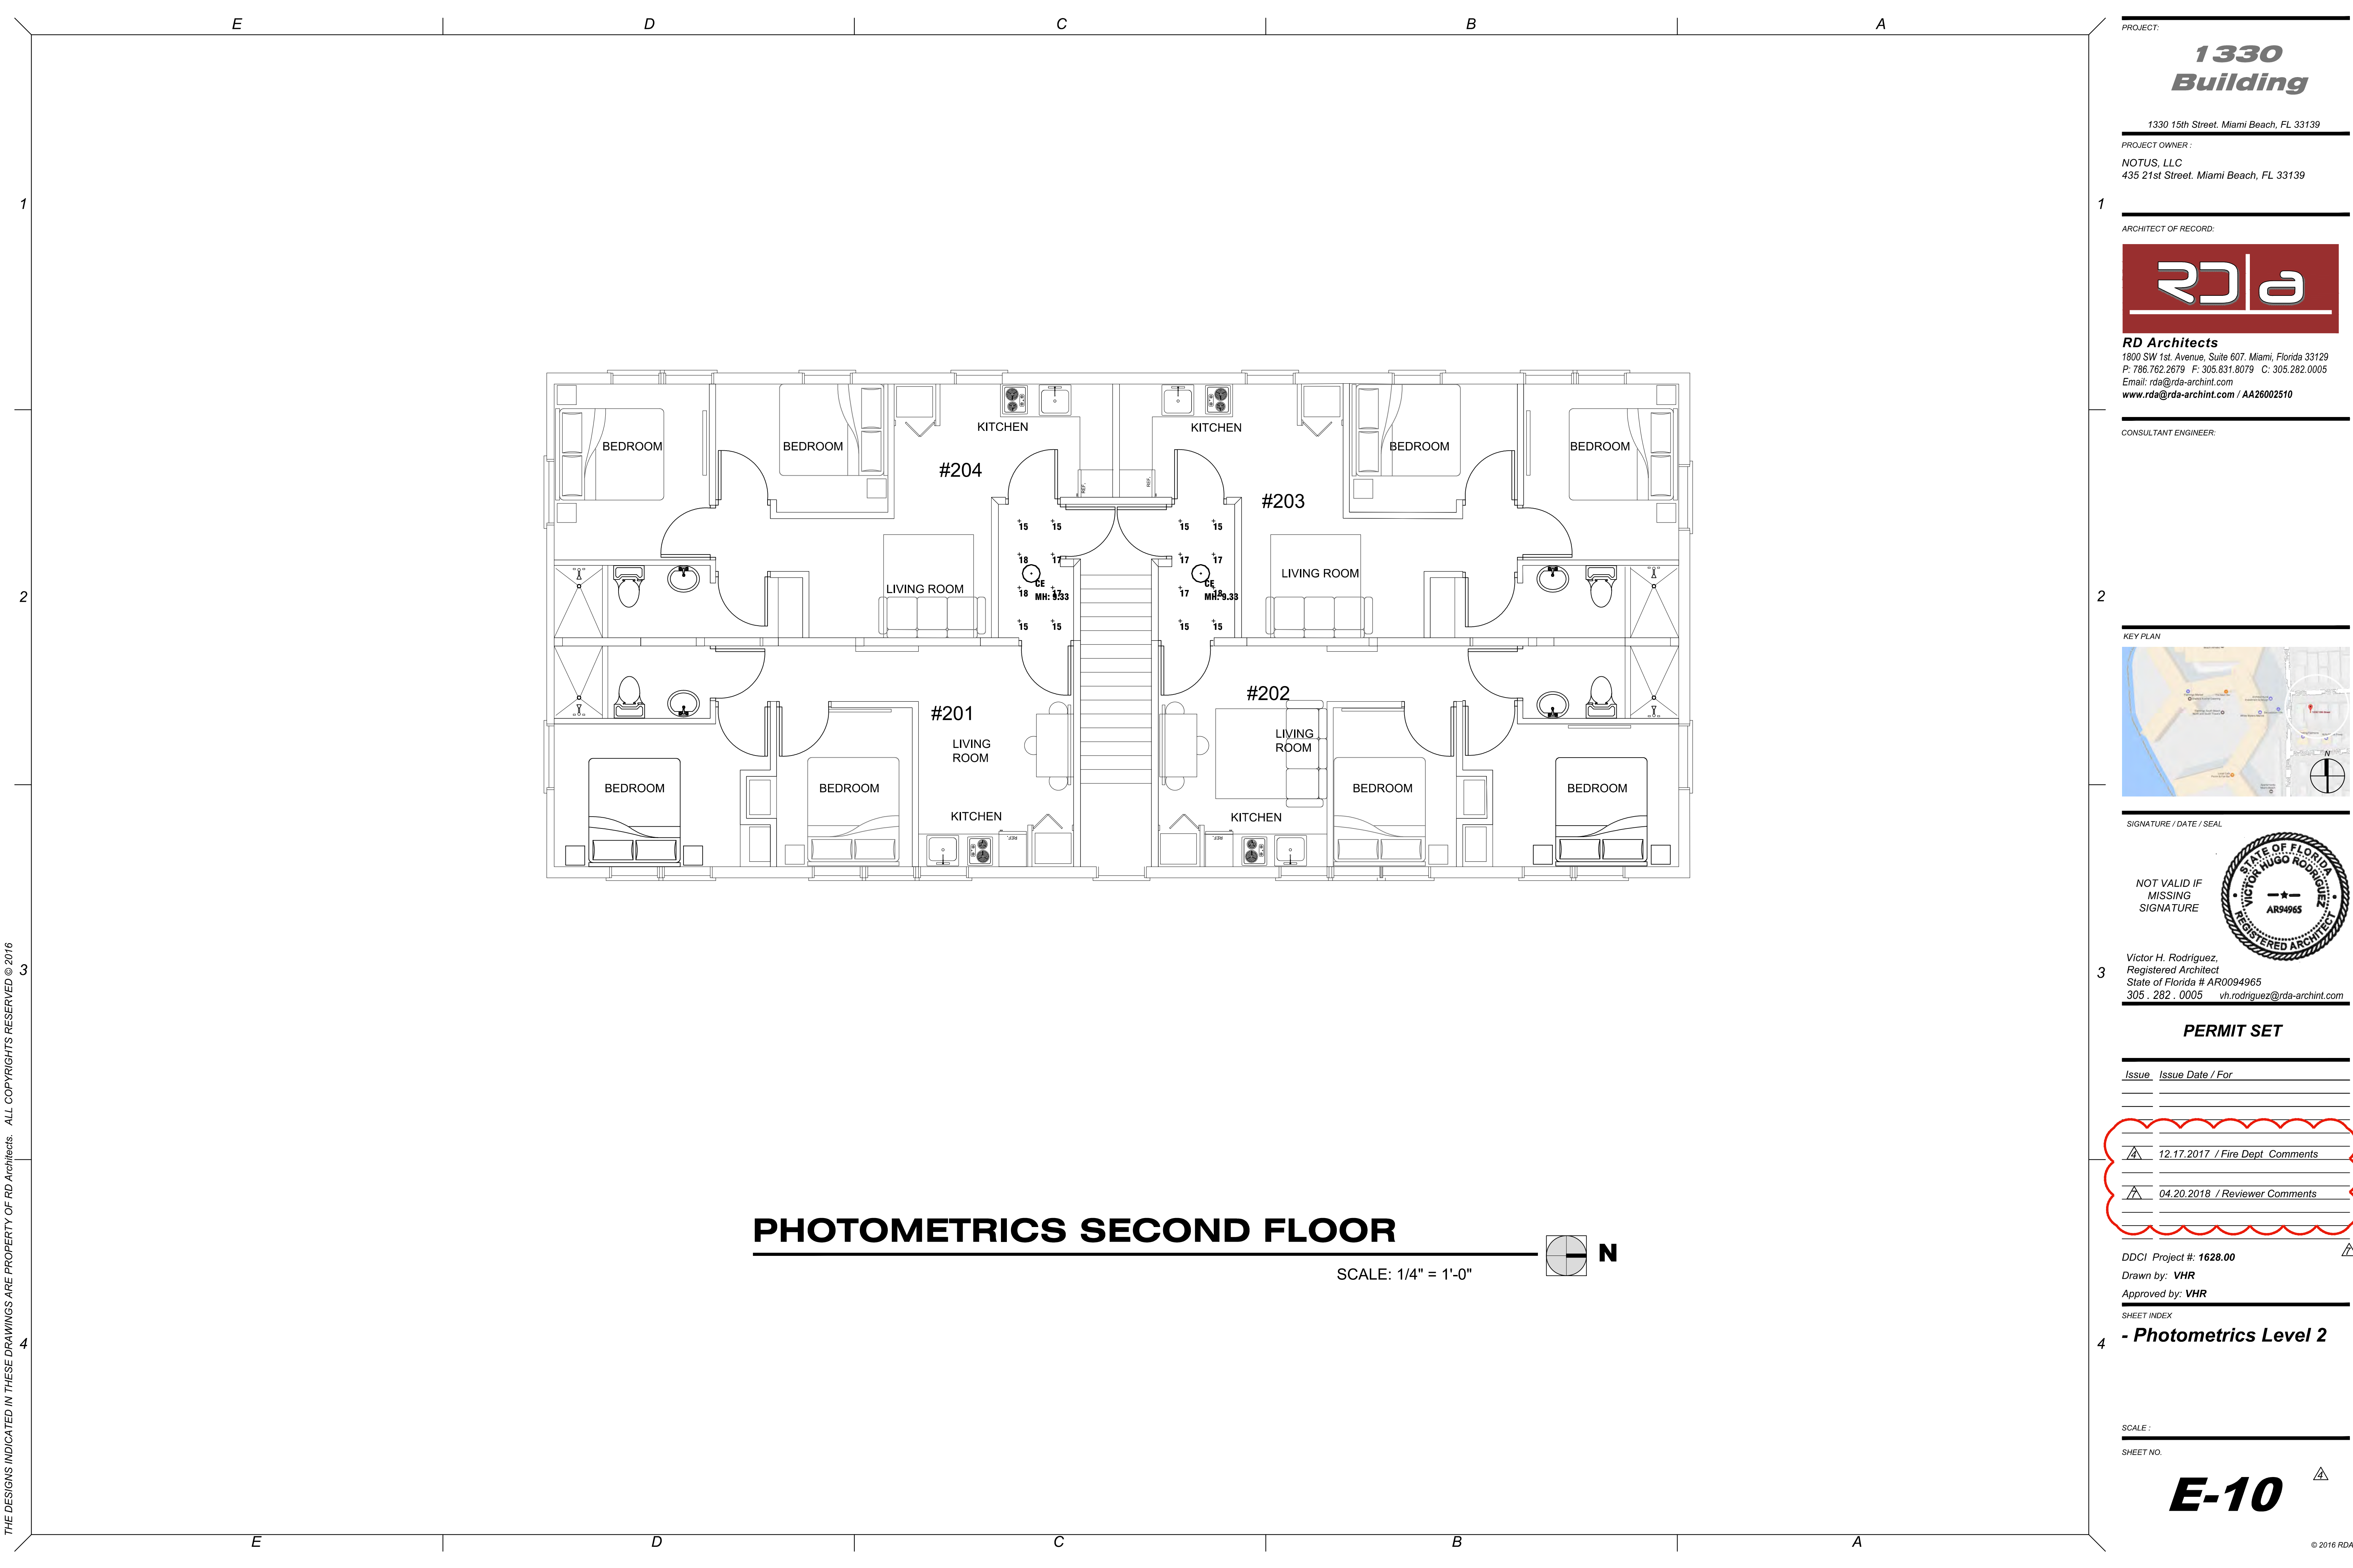

PHOTOMETRICS SECOND FLOOR

SCALE: 1/4" = 1'-0" 

PROJECT:

1330 Building

1330 15th Street, Miami Beach, FL 33139
 PROJECT OWNER:
 NOTUS, LLC
 435 21st Street, Miami Beach, FL 33139

ARCHITECT OF RECORD:




RD Architects
 1800 SW 1st Avenue, Suite 607, Miami, Florida 33129
 P: 786.762.2679 F: 305.831.8079 C: 305.282.0005
 Email: rda@rda-archint.com
 www.rda@rda-archint.com / AA26002510

CONSULTANT ENGINEER:





SIGNATURE / DATE / SEAL

NOT VALID IF MISSING SIGNATURE

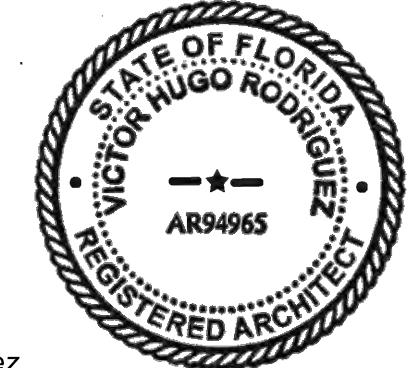

Victor H. Rodriguez,
 Registered Architect
 State of Florida # AR0094965
 305.282.0005 v.h.rodriguez@rda-archint.com

PERMIT SET

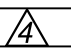Issue	Issue Date / For
	12.17.2017 / Fire Dept. Comments
	04.20.2018 / Reviewer Comments


DDCI Project #: 1628.00
 Drawn by: VHR
 Approved by: VHR

SHEET INDEX
- Photometrics Level 2

SCALE:
 SHEET NO.


E-10 

THE DESIGNS INDICATED IN THESE DRAWINGS ARE PROPERTY OF RD Architects. ALL COPYRIGHTS RESERVED © 2016

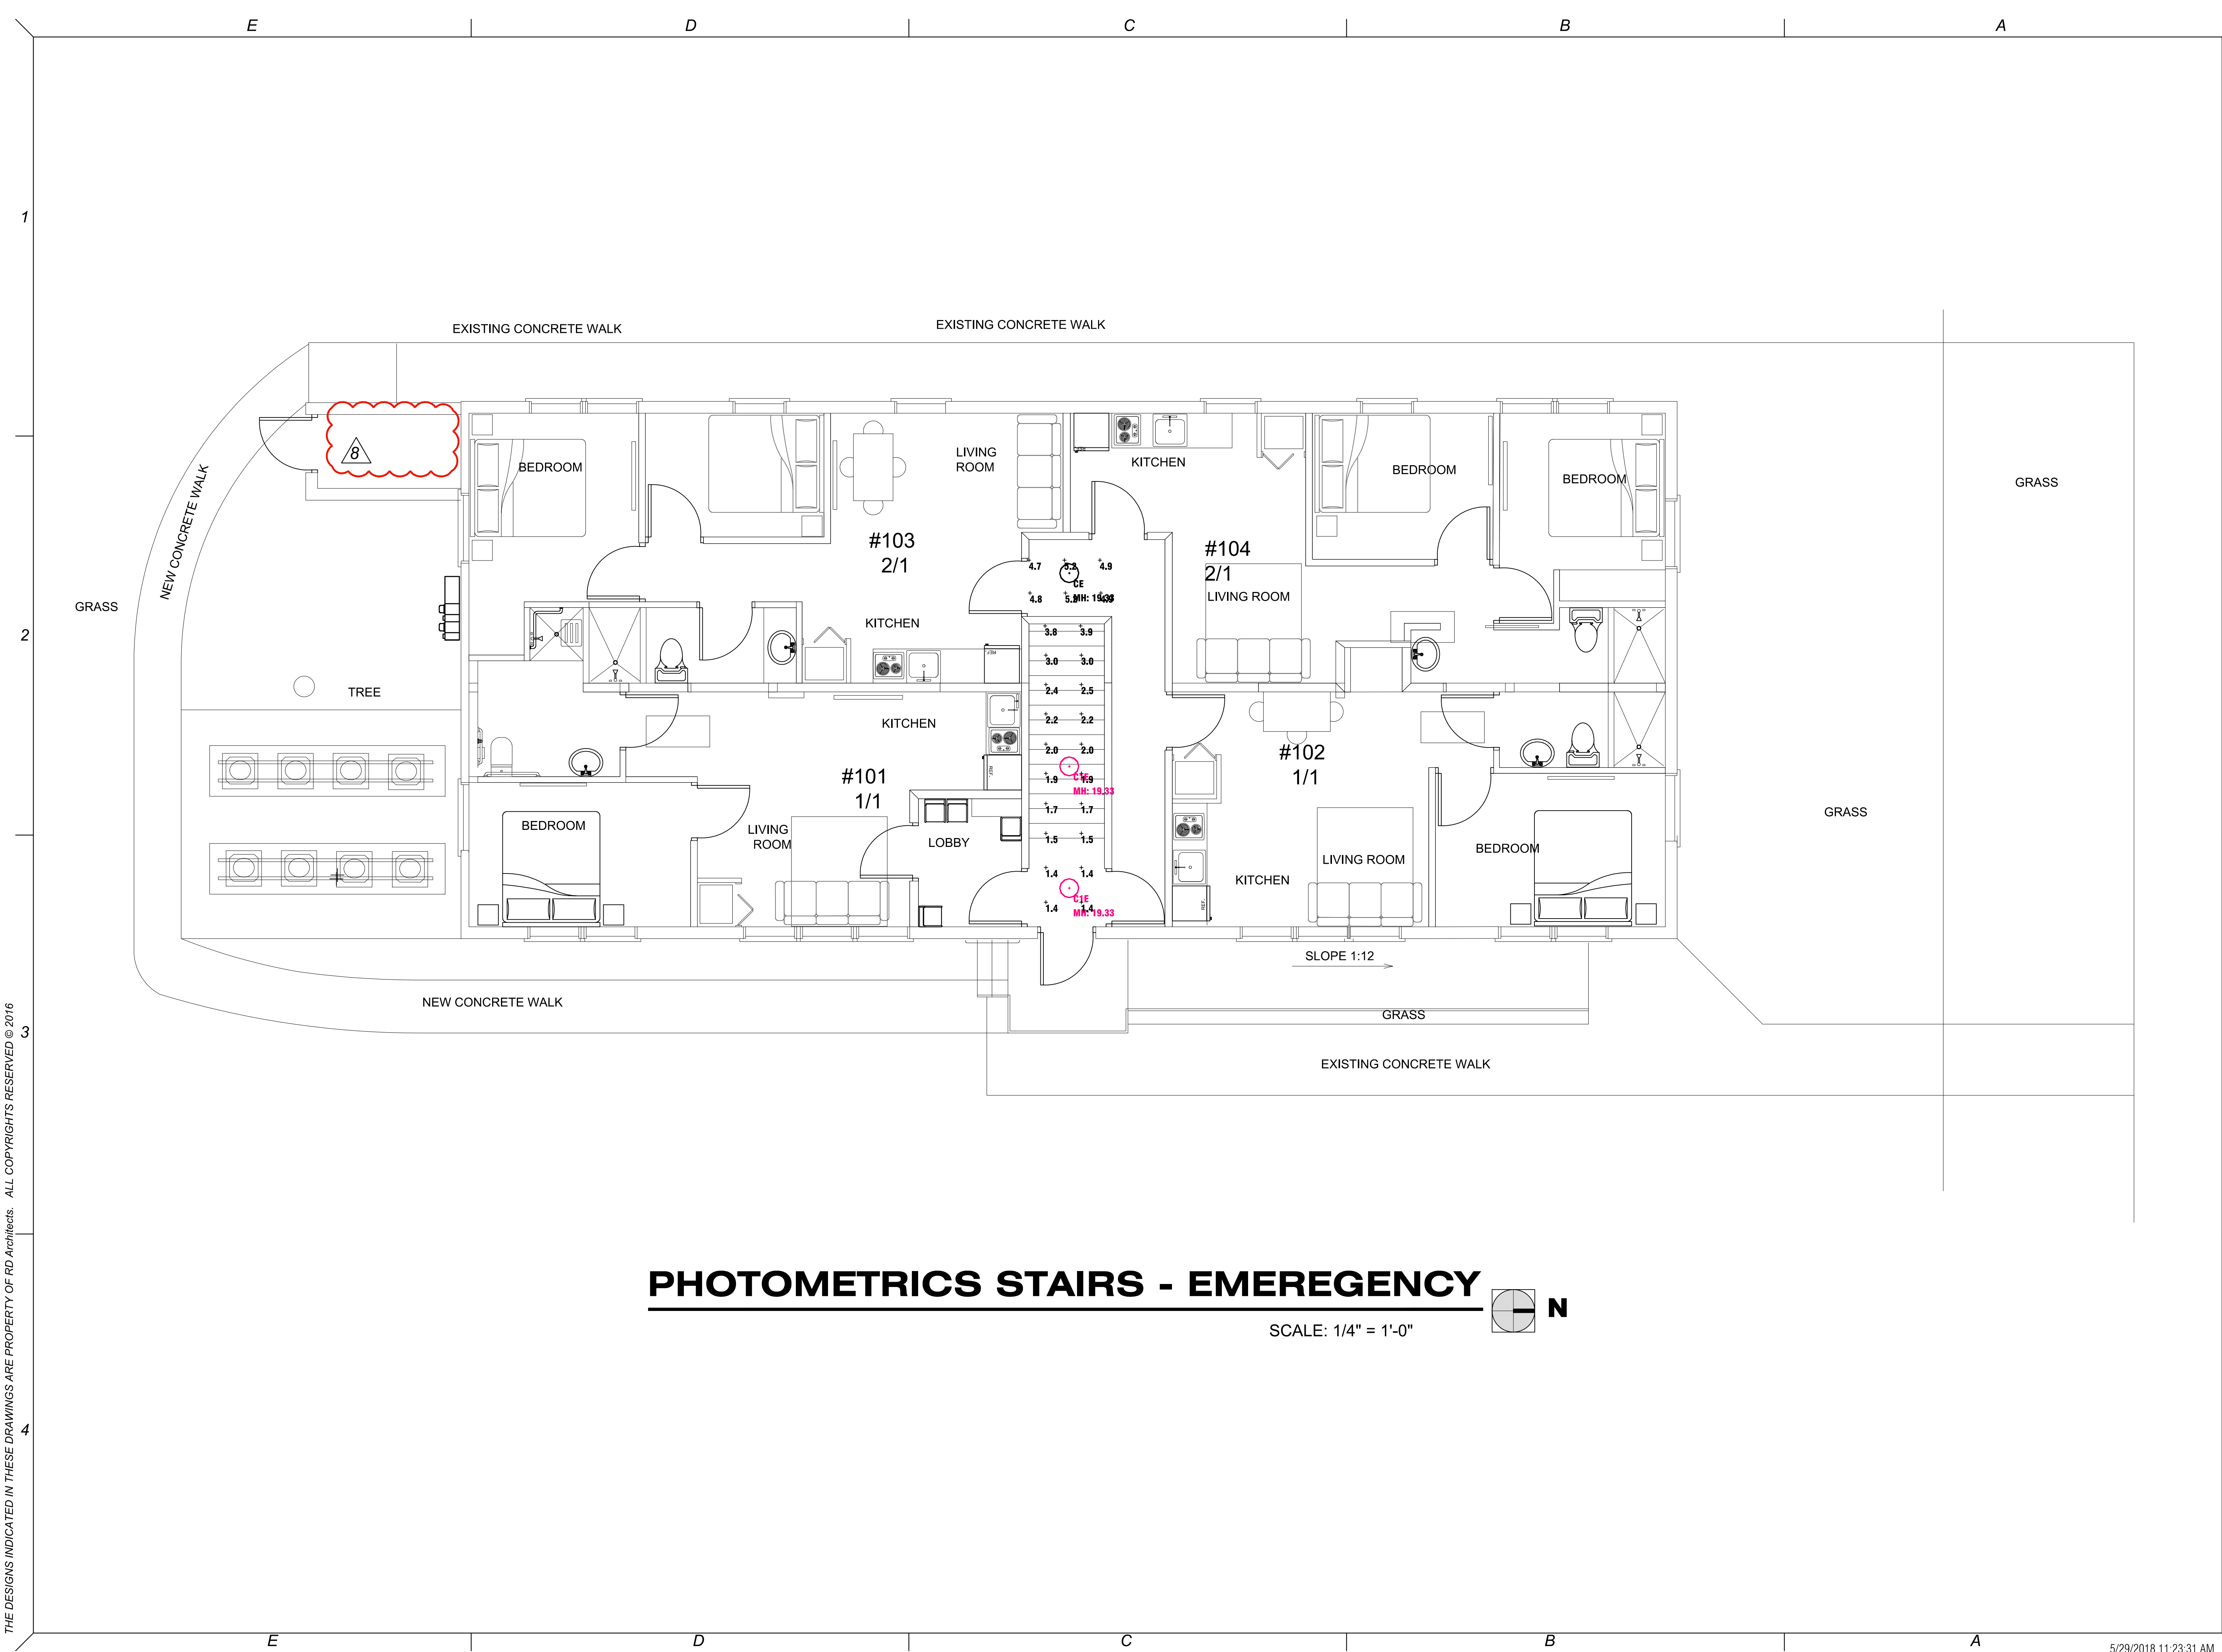

PHOTOMETRICS STAIRS - EMERGENCY

SCALE: 1/4" = 1'-0"

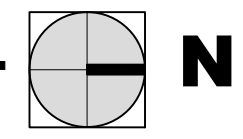

PROJECT: **1330 Building**
 1330 15th Street, Miami Beach, FL 33139
 PROJECT OWNER:
 NOTUS, LLC
 435 21st Street, Miami Beach, FL 33139
 ARCHITECT OF RECORD:


RD Architects
 1800 SW 1st Avenue, Suite 607, Miami, Florida 33129
 P: 786.762.2679 F: 305.831.8079 C: 305.282.0005
 Email: rda@rda-archint.com
 www.rda@rda-archint.com / AA26002510

CONSULTANT ENGINEER:



SIGNATURE / DATE / SEAL

NOT VALID IF MISSING SIGNATURE

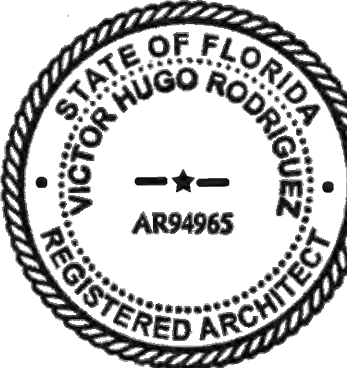

Victor H. Rodriguez,
 Registered Architect
 State of Florida # AR0094965
 305.282.0005 vh.rodriguez@rda-archint.com

PERMIT SET

Issue	Issue Date / For
①	09.12.2016 / Change of Architect
△	12.17.2017 / Fire Dept. Comments
△	02.19.2018 / City Comments
△	04.20.2018 / Reviewer Comments
△	05.29.2018 / Reviewer Comments

DDCI Project #: 1628.00
 Drawn by: VHR
 Approved by: VHR

SHEET INDEX
4 - Photometrics Stairs Emergency Mode

SCALE:
 SHEET NO.

E-11


THE DESIGNS INDICATED IN THESE DRAWINGS ARE PROPERTY OF RD Architects. ALL COPYRIGHTS RESERVED © 2016

Luminaire Schedule			
Project: 1330 15TH STREET, MIAMI BEACH - INTERIOR STAIR & CORRIDORS - EM MODE --- JAN - 17 - 2018			
Symbol	Qty	Label	Description
	2	C1E	LUMINAIRE ARV13HO-50W-4000K-120_277-CP-EMB310 BATTERY BACKUP
	5	CE	LUMINAIRE ARV13-25W-4000K-120_277-CP-EMB310 BATTERY BACKUP

Calculation Summary					
Project: 1330 15TH STREET, MIAMI BEACH - INTERIOR STAIR & CORRIDORS - EM MODE --- JAN - 17 - 2018					
Label	Avg	Max	Min	Avg/Min	Max/Min
1ST FLR CORRIDOR_Floor	3.80	5.2	2.1	1.81	2.48
2ND FLR CORRIDOR_1_Floor	4.68	5.1	4.2	1.11	1.21
2ND FLR CORRIDOR_Floor	4.68	5.1	4.2	1.11	1.21
STAIRS	2.79	5.2	1.4	1.99	3.71

PROJECT: **1330 Building**
 1330 15th Street, Miami Beach, FL 33139
 PROJECT OWNER: NOTUS, LLC
 435 21st Street, Miami Beach, FL 33139
 ARCHITECT OF RECORD:
RD Architects
 1800 SW 1st Avenue, Suite 607, Miami, Florida 33129
 P: 786.762.2679 F: 305.831.8079 C: 305.282.0005
 Email: rda@rda-archint.com
 www.rda@rda-archint.com / AA26002510

CONSULTANT ENGINEER:

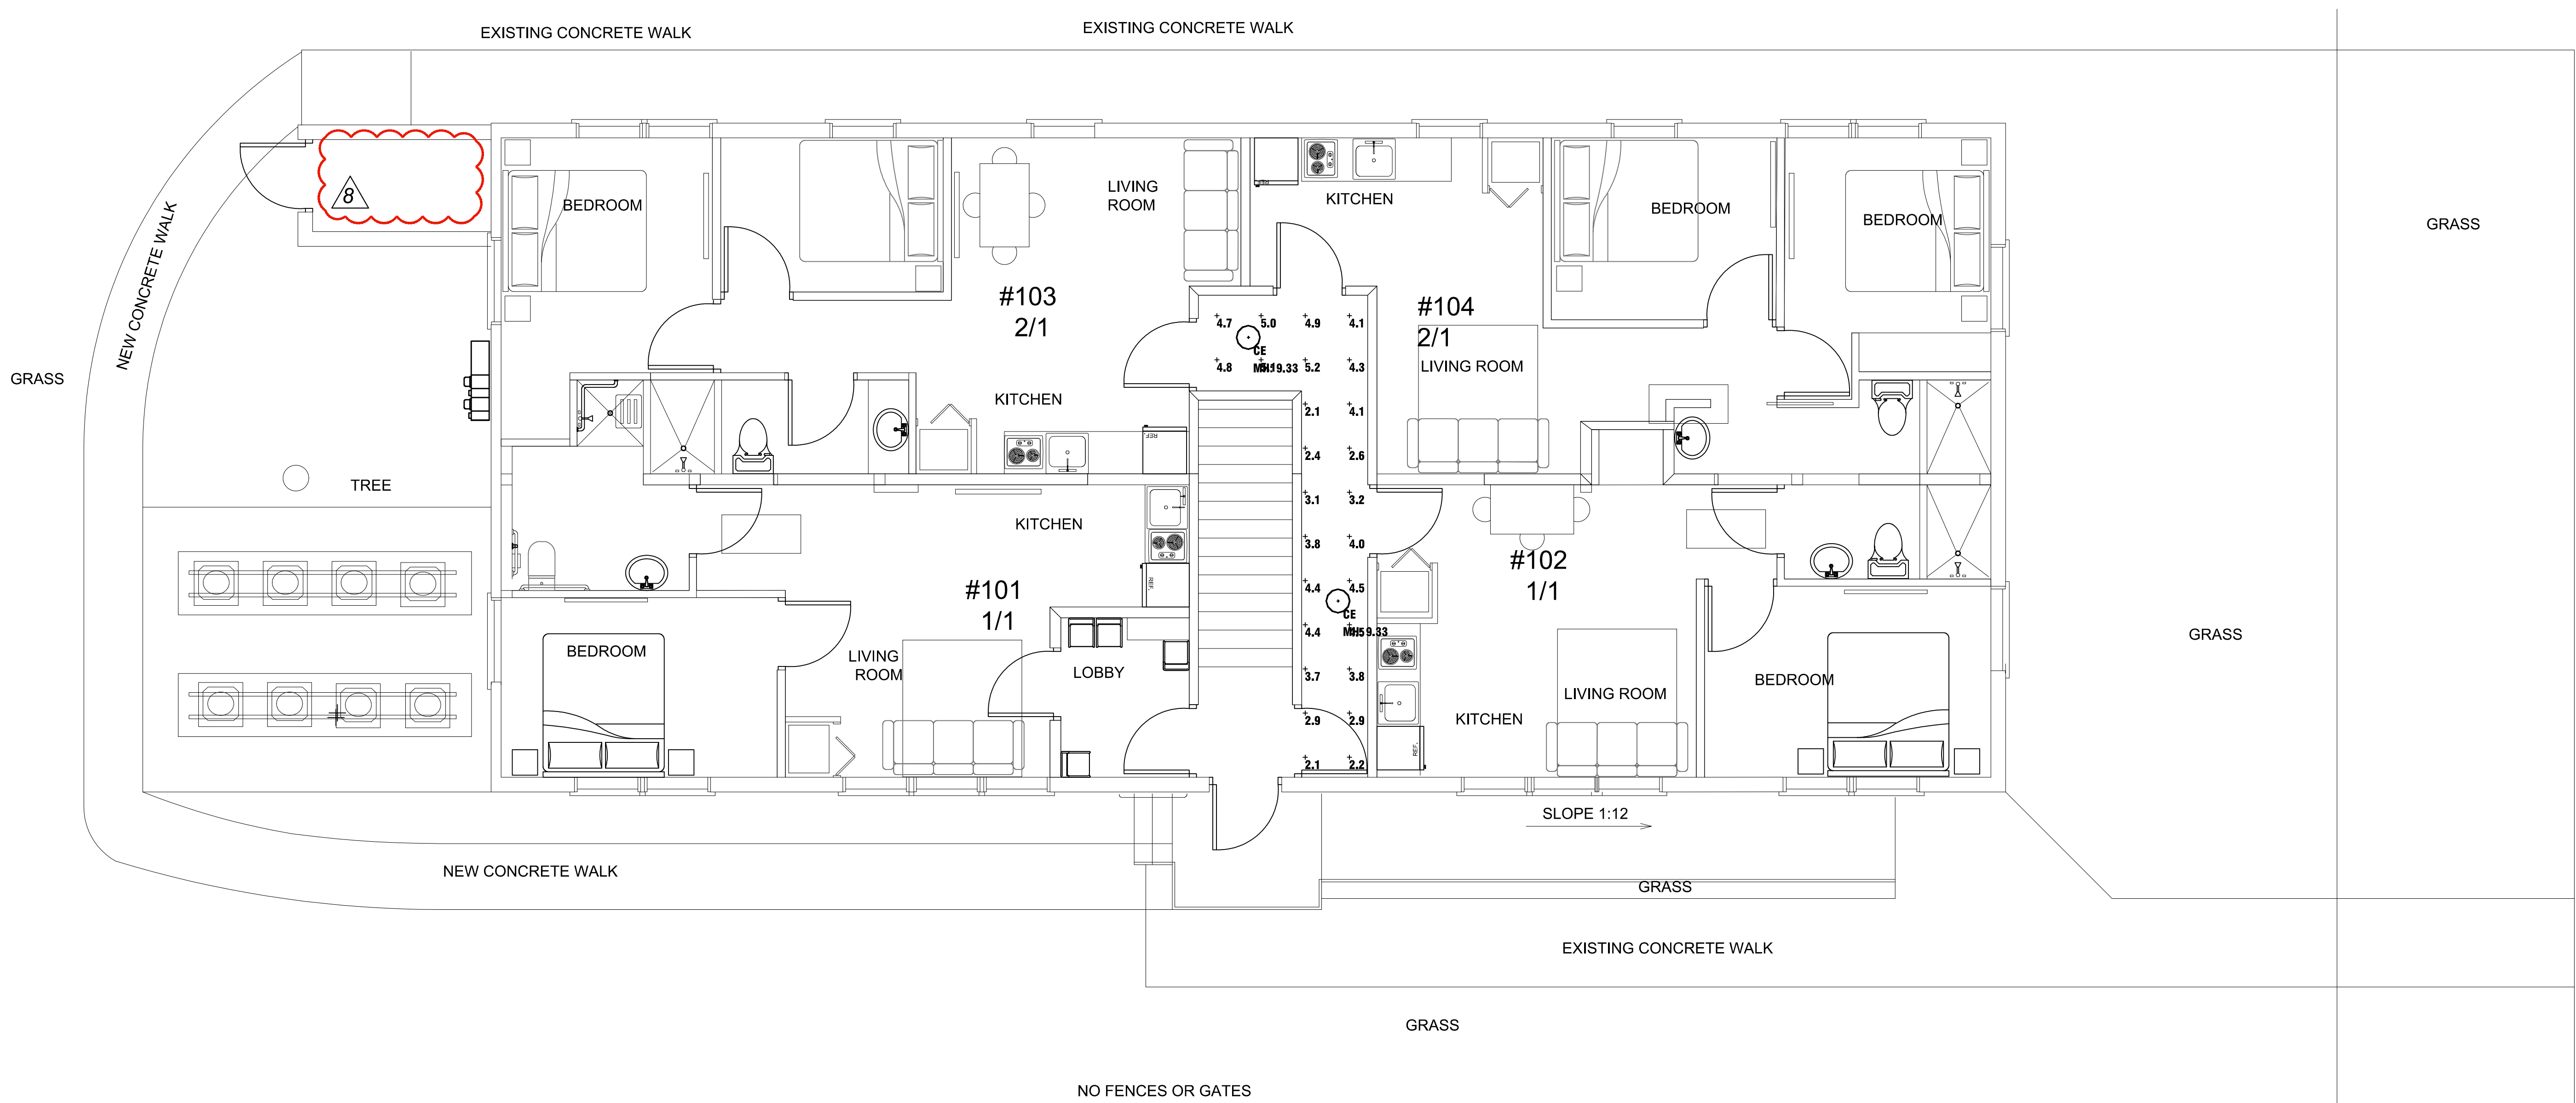


PHOTOMETRICS GROUND FLOOR PLAN - EMERGENCY
 SCALE: 1/4" = 1'-0"



SIGNATURE / DATE / SEAL

NOT VALID IF MISSING SIGNATURE

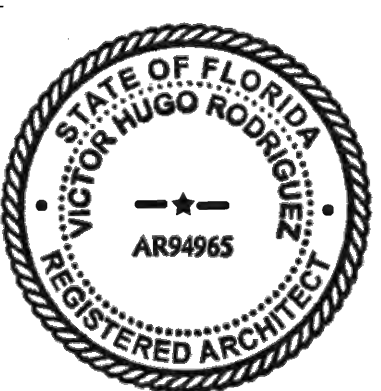

Victor H. Rodriguez,
 Registered Architect
 State of Florida # AR094965
 305.282.0005 vh.rodriguez@rda-archint.com

PERMIT SET

Issue	Issue Date / For
	09.12.2016 / Change of Architect
	12.17.2017 / Fire Dept. Comments
	02.19.2018 / City Comments
	04.20.2018 / Reviewer Comments
	05.29.2018 / Reviewer Comments

DDCI Project #: 1628.00
 Drawn by: VHR
 Approved by: VHR


SHEET INDEX
4 - Photometrics Ground Floor Emergency Mode

SCALE:
 SHEET NO.

E-12


THE DESIGNS INDICATED IN THESE DRAWINGS ARE PROPERTY OF RD Architects. ALL COPYRIGHTS RESERVED © 2016

1
2
3
4

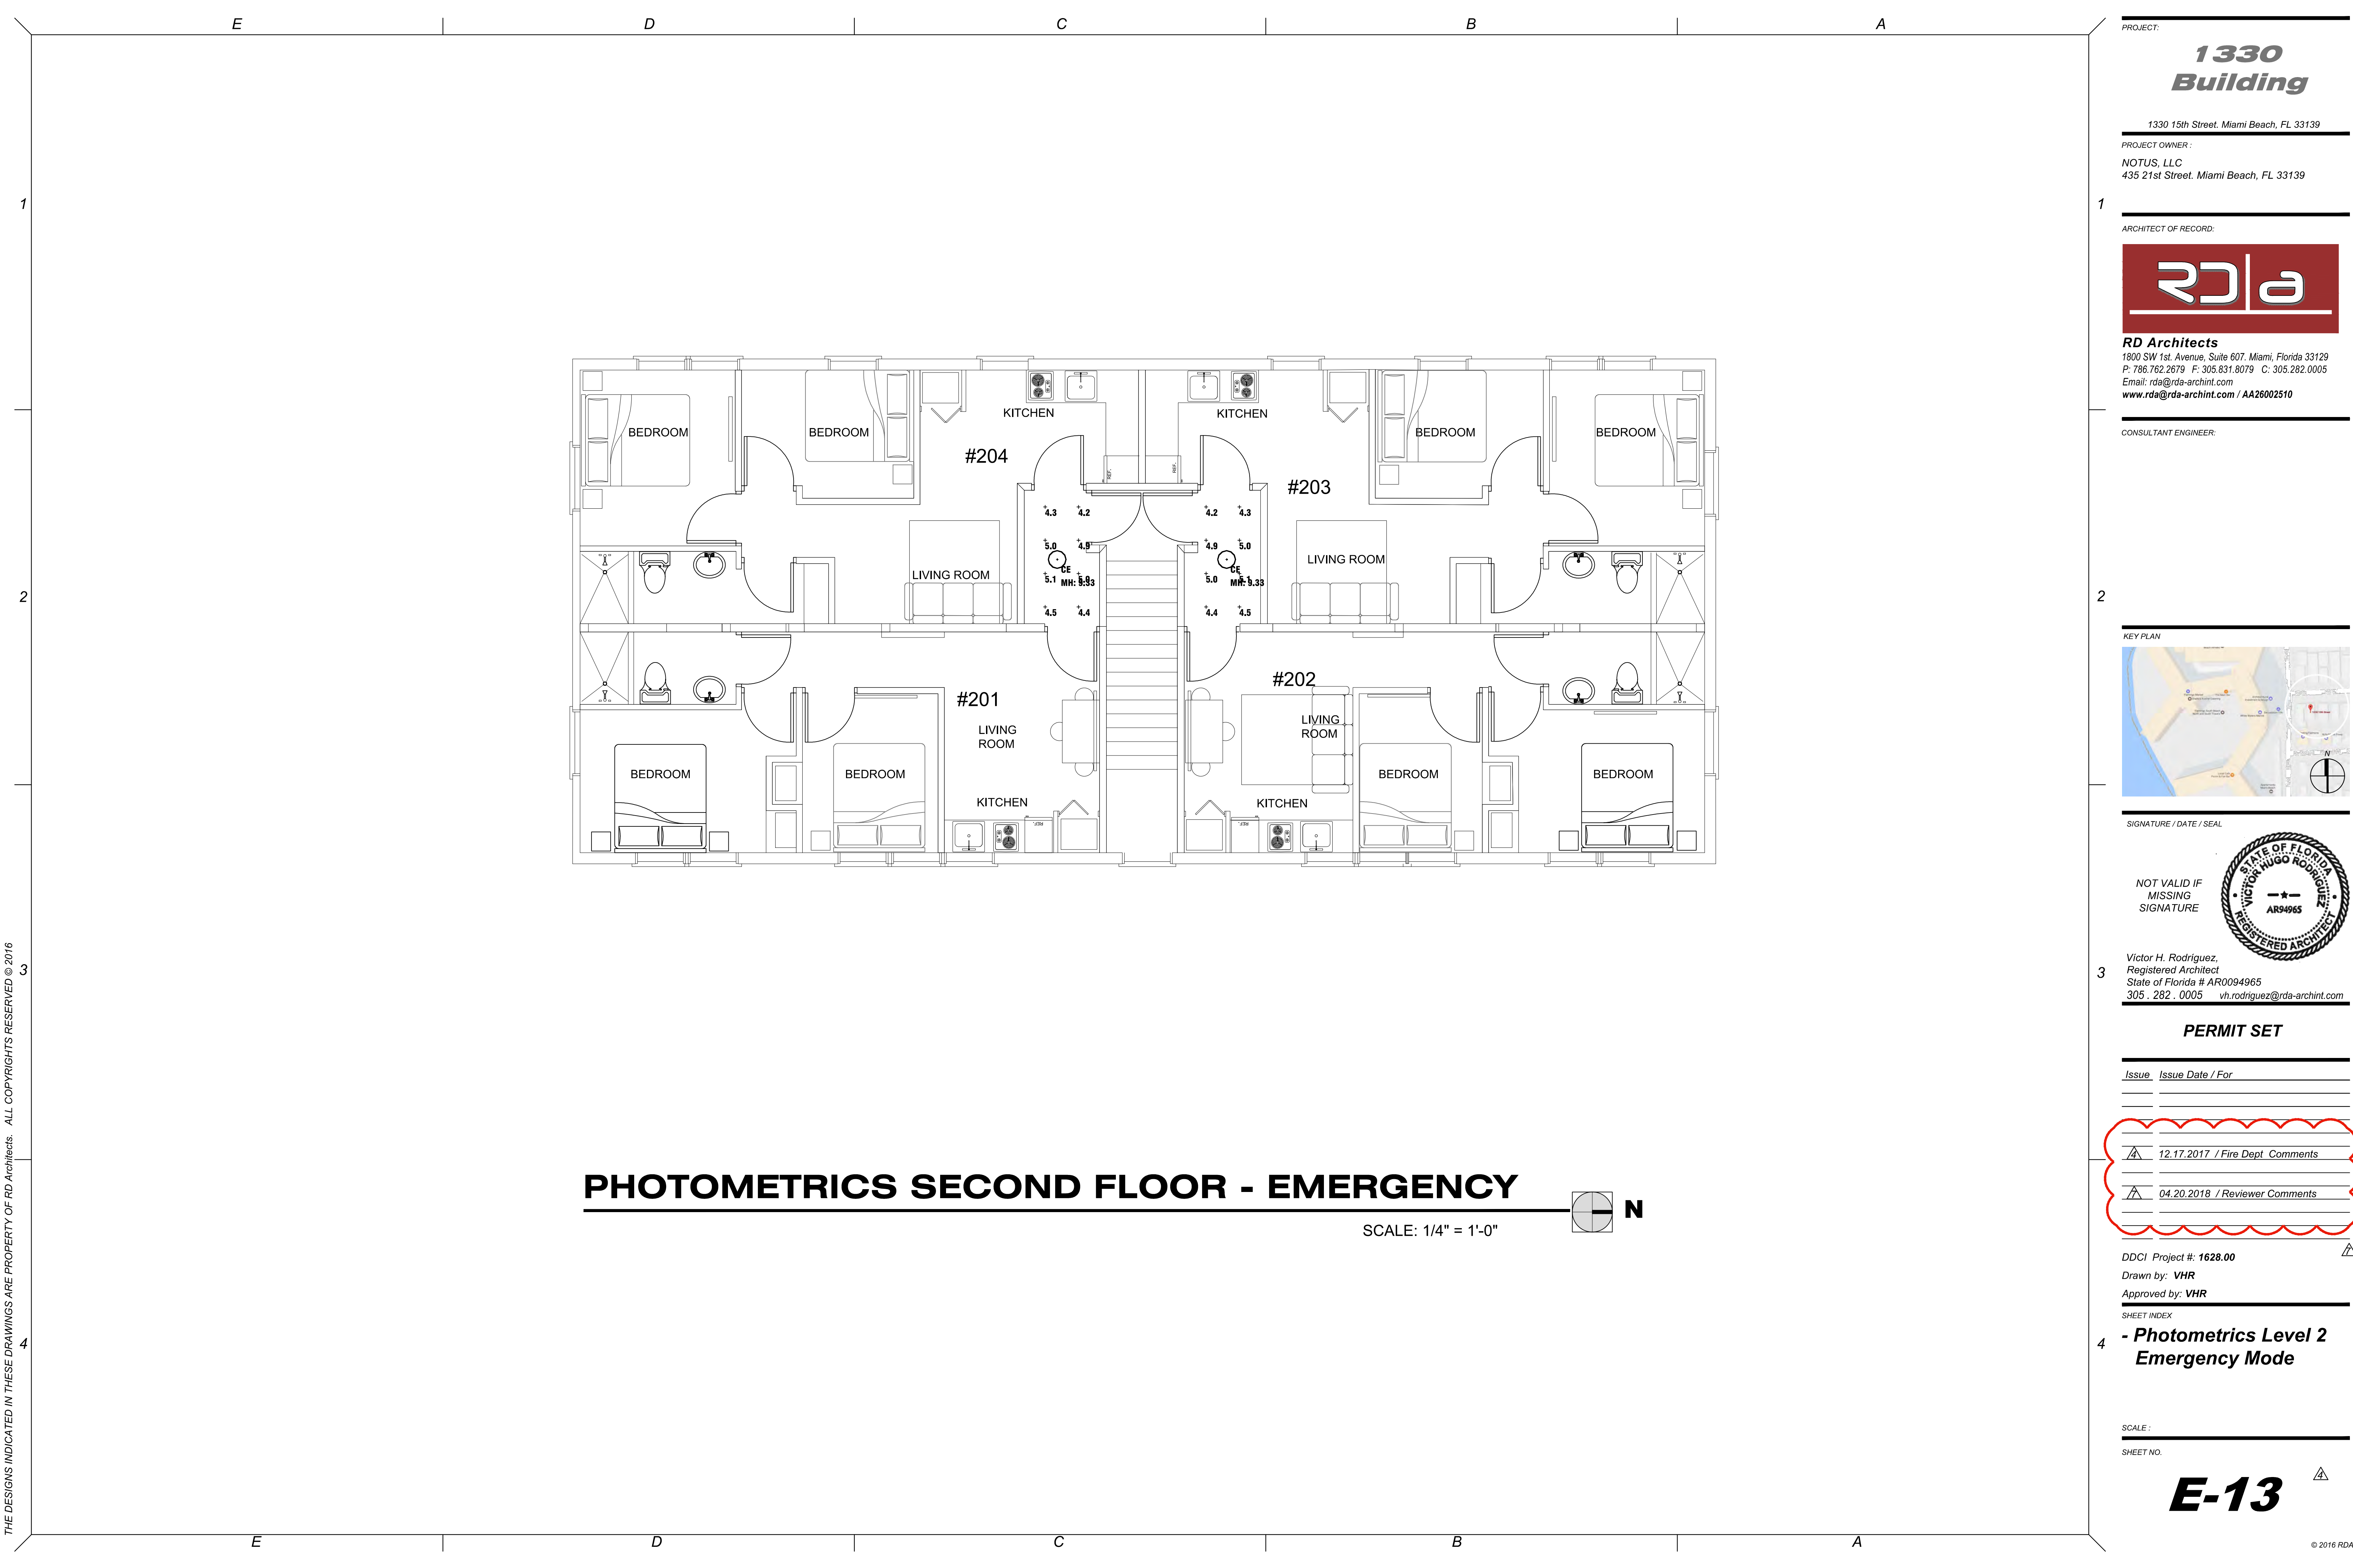

PHOTOMETRICS SECOND FLOOR - EMERGENCY

SCALE: 1/4" = 1'-0"

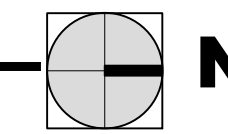

PROJECT:


1330 Building

1330 15th Street, Miami Beach, FL 33139

PROJECT OWNER:

NOTUS, LLC
435 21st Street, Miami Beach, FL 33139

ARCHITECT OF RECORD:

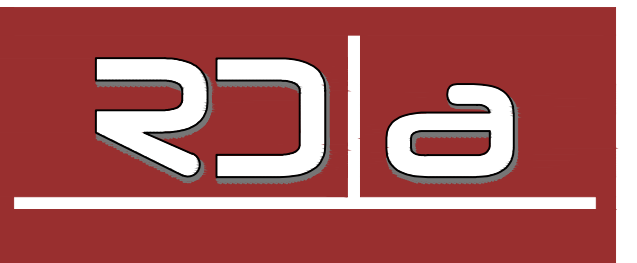

RD Architects

1800 SW 1st Avenue, Suite 607, Miami, Florida 33129
P: 786.762.2679 F: 305.831.8079 C: 305.282.0005
Email: rda@rda-archint.com
www.rda@rda-archint.com / AA26002510


CONSULTANT ENGINEER:

KEY PLAN



SIGNATURE / DATE / SEAL

NOT VALID IF MISSING SIGNATURE

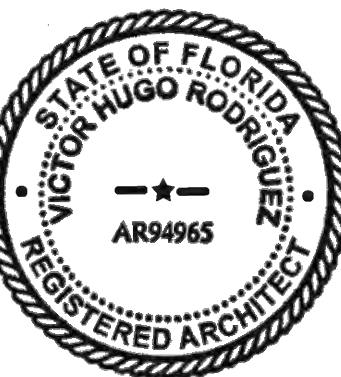

Victor H. Rodriguez,
Registered Architect
State of Florida # AR0094965
305.282.0005 vh.rodriguez@rda-archint.com

PERMIT SET

Issue, Issue Date / For

12.17.2017 / Fire Dept. Comments

04.20.2018 / Reviewer Comments

DDCI Project #: 1628.00

Drawn by: VHR

Approved by: VHR

SHEET INDEX

**- Photometrics Level 2
Emergency Mode**

SCALE:

SHEET NO.

E-13

THE DESIGNS INDICATED IN THESE DRAWINGS ARE PROPERTY OF RD Architects. ALL COPYRIGHTS RESERVED © 2016



Project: _____
 Location: _____
 Cat No: _____
 Type: _____
 Qty: _____
 Notes: _____

Philips Gardco LED wall sconce 121 offers distinction through its styling, powerful optical design, array of distributions, and impressive selection of control possibilities. Designed to add an element of style to your application by pairing straight lines with rounded edges, the form of the 121 is timeless, yet contemporary, and will complement a wide assortment of architectural styles and designs, while delivering high light levels and functional distributions. 121 sconces are available in Type 2, 3, and 4 distributions, and provide output of up to 10,103 lumens. Energy saving control options help to increase energy savings and offer California Title 24 compliance. Emergency Battery Backup option available for path-of-egress and is integral to the luminaire.

Ordering guide example: 121-32L-700-NW-G3-3-120-IMR2-BZ

Prefix	Number of LEDs	Drive Current	LED Color - Generation	Distribution	Emergency	Voltage	Controls	Electrical	Finish
121	16 LEDs (1 module)	530 530mA 650 650mA 700 700mA 1000 1000mA 1200 1200mA	CW-G3 Cool White 3000K 70CRI Generation 3 HW-G3 Warm White 3000K 70CRI Generation 3	2 Type 2 3 Type 3 4 Type 4	EBPC Emergency Battery Pack Cold Weather ¹ to meet an emergency option	UNV 120-277V HVV 347-480V 208 208V 240 240V 277 277V 347 347V 480 480V	DD 0-10V Dimming Driver ² DCC Dual Circuit Control ³ DynaDriver Automatic Profile Dimming CSO Safety 50% Dimming ⁴ CMSO Median 50% Dimming ⁴ CSO Economy 50% Dimming ⁴ DASO All Night 50% Dimming ⁴ Photoelectric systems PCB Photocell System InfraRed Motion Response systems Network system (Star/Wire) CW CW integral module ⁵ Wireless system (luminaire mounted) LLC2 Module with #2 lens ⁶ LLC3 Module with #3 lens ⁶	F1 Single (20, 375, 347VAC) ⁷ F2 Double (20L, 240, 480VAC) ⁷ F3 Canadian Double Pole (208, 240, 480VAC) ⁷	BR Black WH White BZ Bronze GG Green Gray MG Medium Gray Customer specified color or RAL (see: CIP or DC-RA7524) CC Custom color (Must supply color chip for required factory quote)

1. Only available with EBPC
2. Only available with 16 LEDs
3. Available in 120V or 277V only
4. EBPC available only in 330mA or 650mA
5. Not available with 1.2A drive current
6. Available in 120V thru 277V and UNV only
7. DCC available only in 330mA with 32 LED
8. Not available with EBPC
9. Not available with DCC
10. Voltage must be specified
11. Not available in 480V
12. SW option is not available with any other control options with the exception of IMR2, IMR3 motion response options

121_LED_wall_sconce 06/17 page 1 of 7

ANYX 13

ARV13 BRV13 CRV13 Vandal Resistant
 NRV13 XRV13 YRV13 ARV 13 Series LED

WALL / CEILING MOUNT LED

Fixture Type _____ Date _____
 Job Name _____ Approved By _____
 Catalog Number _____

DESCRIPTION The Anyx 13 LED fixtures build on the highly successful Anyx line. The Anyx 13 series features a durable, color-impregnated polycarbonate housing supported by a marine grade, die cast aluminum base plate to provide a lighting fixture that will survive in the harshest environments. The Anyx 13 series has been installed successfully in large scale projects such as dorm rooms, unsecured hallways, transportation stations and public schools.

Trim One piece injection molded UV stabilized polycarbonate mechanically interlocked to base plate and sealed against moisture and contaminants with two high temperature silicone O-rings. Color is molded through entire part for scratch resistant finish. Locked in place with one concealed tamper resistant set screw.

Lens One piece injection molded prismatic polycarbonate with minimum 0.130" wall thickness. Secured to base plate by trim and sealed with two high temperature silicone O-rings.

Reflector Die formed heavy gauge specular aluminum, shaped for maximum efficiency.

Base Plate Pressure die cast marine grade aluminum. Chemically primed and finished with electrostatically applied polyester powder coat.

Drivers Constant current drivers, 100-277V.

LED Samsung LM561B+ Series @ 3000K, 3500K, 4000K, 5000K and 82 CRI wired in parallel-series. L₇₀ projected life of 130,000 hours at 50°C. Tested in accordance with LM-80. Ten year warranty on LED boards against operational defects.

Gaskets Closed cell die cut neoprene gasket provided between fixture mounting plate and mounting surface. High temperature silicone O-ring between the trim and lens, between the lens and base plate, and between the mounting plate and base plate.


UL Listing U.L., C.U.L., Wet standard. 1598a Marine Listed.

DLC Product listed on the Designlights Consortium Qualified Products List. View the latest version here for current configuration details.

Lifetime Warranty Luminaire LED Incorporated will repair or replace any fixture damaged due to vandalism for the lifetime of the installation.

DIMENSIONAL DATA

	A	B
ARV13	13.13	3.85
BRV13	13.13	4.00
CRV13	13.13	4.00
NRV13	13.13	4.00
XRV13	13.13	4.00
YRV13	13.13	4.00

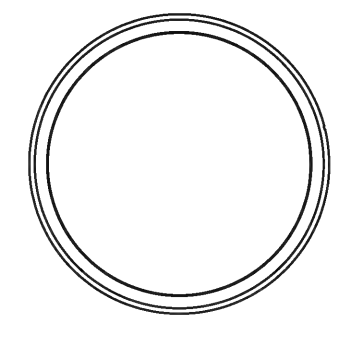

Luminaire Led
 www.luminaireled.net
 5 Sutton Place
 P.O. Box 2162
 Edison, NJ 08818
 P. 732.549.0056
 F. 732.549.9737

Luminaire LED Incorporated products are manufactured in the USA with components purchased from USA suppliers, and meet the Buy American requirements under the AFRA. Content of specification sheets is subject to change, please consult our website for current product information.
 Rev: 5/17+

ANYX 13

ARV13 HO BRV13 HO CRV13 HO Vandal Resistant
 NRV13 HO XRV13 HO YRV13 HO High Output LED

WALL / CEILING MOUNT LED

Fixture Type _____ Date _____
 Job Name _____ Approved By _____
 Catalog Number -50W - -120 - 277 - -

DESCRIPTION The Anyx 13 LED fixtures build on the highly successful Anyx line. The Anyx 13 series features a durable, color-impregnated polycarbonate housing supported by a marine grade, die cast aluminum base plate to provide a lighting fixture that will survive in the harshest environments.

Trim One piece injection molded UV stabilized polycarbonate mechanically interlocked to base plate and sealed against moisture and contaminants with two high temperature silicone O-rings. Color is molded through entire part for scratch resistant finish. Locked in place with one concealed tamper resistant set screw.

Lens One piece injection molded opal prismatic polycarbonate with minimum 0.130" wall thickness. Secured to base plate by trim and sealed with two high temperature silicone O-rings.

Reflector Die formed heavy gauge specular aluminum, shaped for maximum efficiency.

Base Plate Pressure die cast marine grade aluminum. Chemically primed and finished with electrostatically applied polyester powder coat.

Drivers Constant current drivers, 100-277V.

LED Samsung LM561B Series @ 3000K, 3500K, 4000K, 5000K and 82 CRI wired in parallel-series. L₇₀ projected life of 130,000 hours at 50°C. Tested in accordance with LM-80. Ten year warranty on LED boards against operational defects.

Gaskets Closed cell die cut neoprene gasket provided between fixture mounting plate and mounting surface. High temperature silicone O-ring between the trim and lens; between the lens and base plate; and between the mounting plate and base plate.



Housing Pressure die cast marine grade aluminum. Chemically primed and finished with electrostatically applied polyester powder coat.

UL Listing U.L., C.U.L., Wet standard. 1598a Marine Listed.

Lifetime Warranty Luminaire LED Incorporated will repair or replace any fixture damaged due to vandalism for the lifetime of the installation.

DIMENSIONAL DATA

	A	B
ARV13 HO	13.13	5.60
BRV13 HO	13.13	5.75
CRV13 HO	13.13	5.75
NRV13 HO	13.13	5.75
XRV13 HO	13.13	5.75
YRV13 HO	13.13	5.75

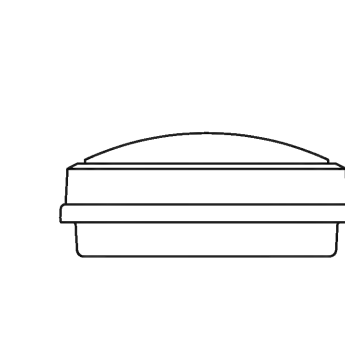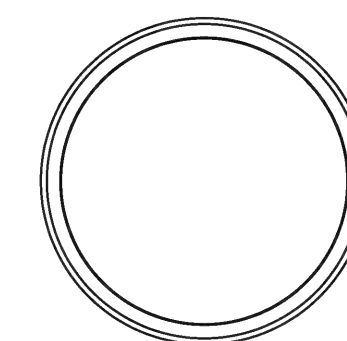

Luminaire Led
 www.luminaireled.net
 5 Sutton Place
 P.O. Box 2162
 Edison, NJ 08818
 P. 732.549.0056
 F. 732.549.9737

Luminaire LED Incorporated products are manufactured in the USA with components purchased from USA suppliers, and meet the Buy American requirements under the AFRA. Content of specification sheets is subject to change, please consult our website for current product information.
 Rev: 5/17+

1330 Building

1330 15th Street, Miami Beach, FL 33139

PROJECT OWNER:

NOTUS, LLC
 435 21st Street, Miami Beach, FL 33139

ARCHITECT OF RECORD:



RD Architects
 1800 SW 1st Avenue, Suite 607, Miami, Florida 33129
 P: 786.762.2679 F: 305.831.8079 C: 305.282.0005
 Email: rda@rda-archint.com
 www.rda@rda-archint.com / AA26002510


CONSULTANT ENGINEER:

KEY PLAN



SIGNATURE / DATE / SEAL

NOT VALID IF MISSING SIGNATURE

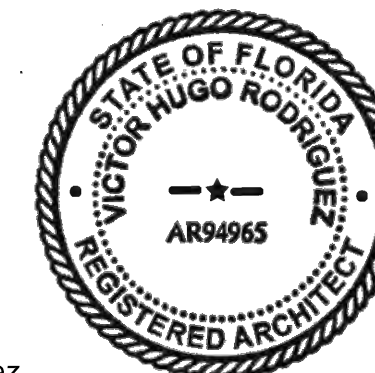

Victor H. Rodriguez,
 Registered Architect
 State of Florida # AR0094965
 305.282.0005 vh.rodriguez@rda-archint.com

PERMIT SET

Issue, Issue Date / For

02.19.2018 / City Comments
 04.20.2018 / Reviewer Comments

DDCI Project #: 1628.00

Drawn by: VHR

Approved by: VHR

SHEET INDEX

- Exterior Light Fixtures

SCALE:


SHEET NO.

E-14


1
2
3
4
THE DESIGNS INDICATED IN THESE DRAWINGS ARE PROPERTY OF RD Architects. ALL COPYRIGHTS RESERVED © 2016

P / L P / L P / L P / L P / L P / L
 EXISTING CONCRETE WALK EXISTING CONCRETE WALK

LEGEND	
	RECTANGULAR DUCT INSIDE DIMENSIONS
	FLEXIBLE ROUND DUCT INSIDE DIMENSIONS
	ELBOW W/ TURNING VALVES
	EXISTING FLEXIBLE ROUND DUCT INSIDE DIMENSIONS
	SUPPLY AIR, WALL MOUNTED REGISTER
	SUPPLY AIR, CEILING MOUNTED REGISTER
	RETURN AIR, CEILING MOUNTED REGISTER
	CEILING EXHAUST FAN
	CONDENSATE DRAIN PIPING (INSULATE WITH 3/4" AMCOFLEX)
	X: AIR DEVICE TYPE # CFM AXB: NECK SIZE
	DIAMETER
	ROOM TEMPERATURE SENSOR/ THERMOSTAT, TYPE PROGRAMMABLE
	CONDENSATE DRAIN
	VOLUME MANUAL DAMPER
	UNDER CUT
	RETURN AIR
	CUBIC FEET PER MINUTE
	EXHAUST FAN

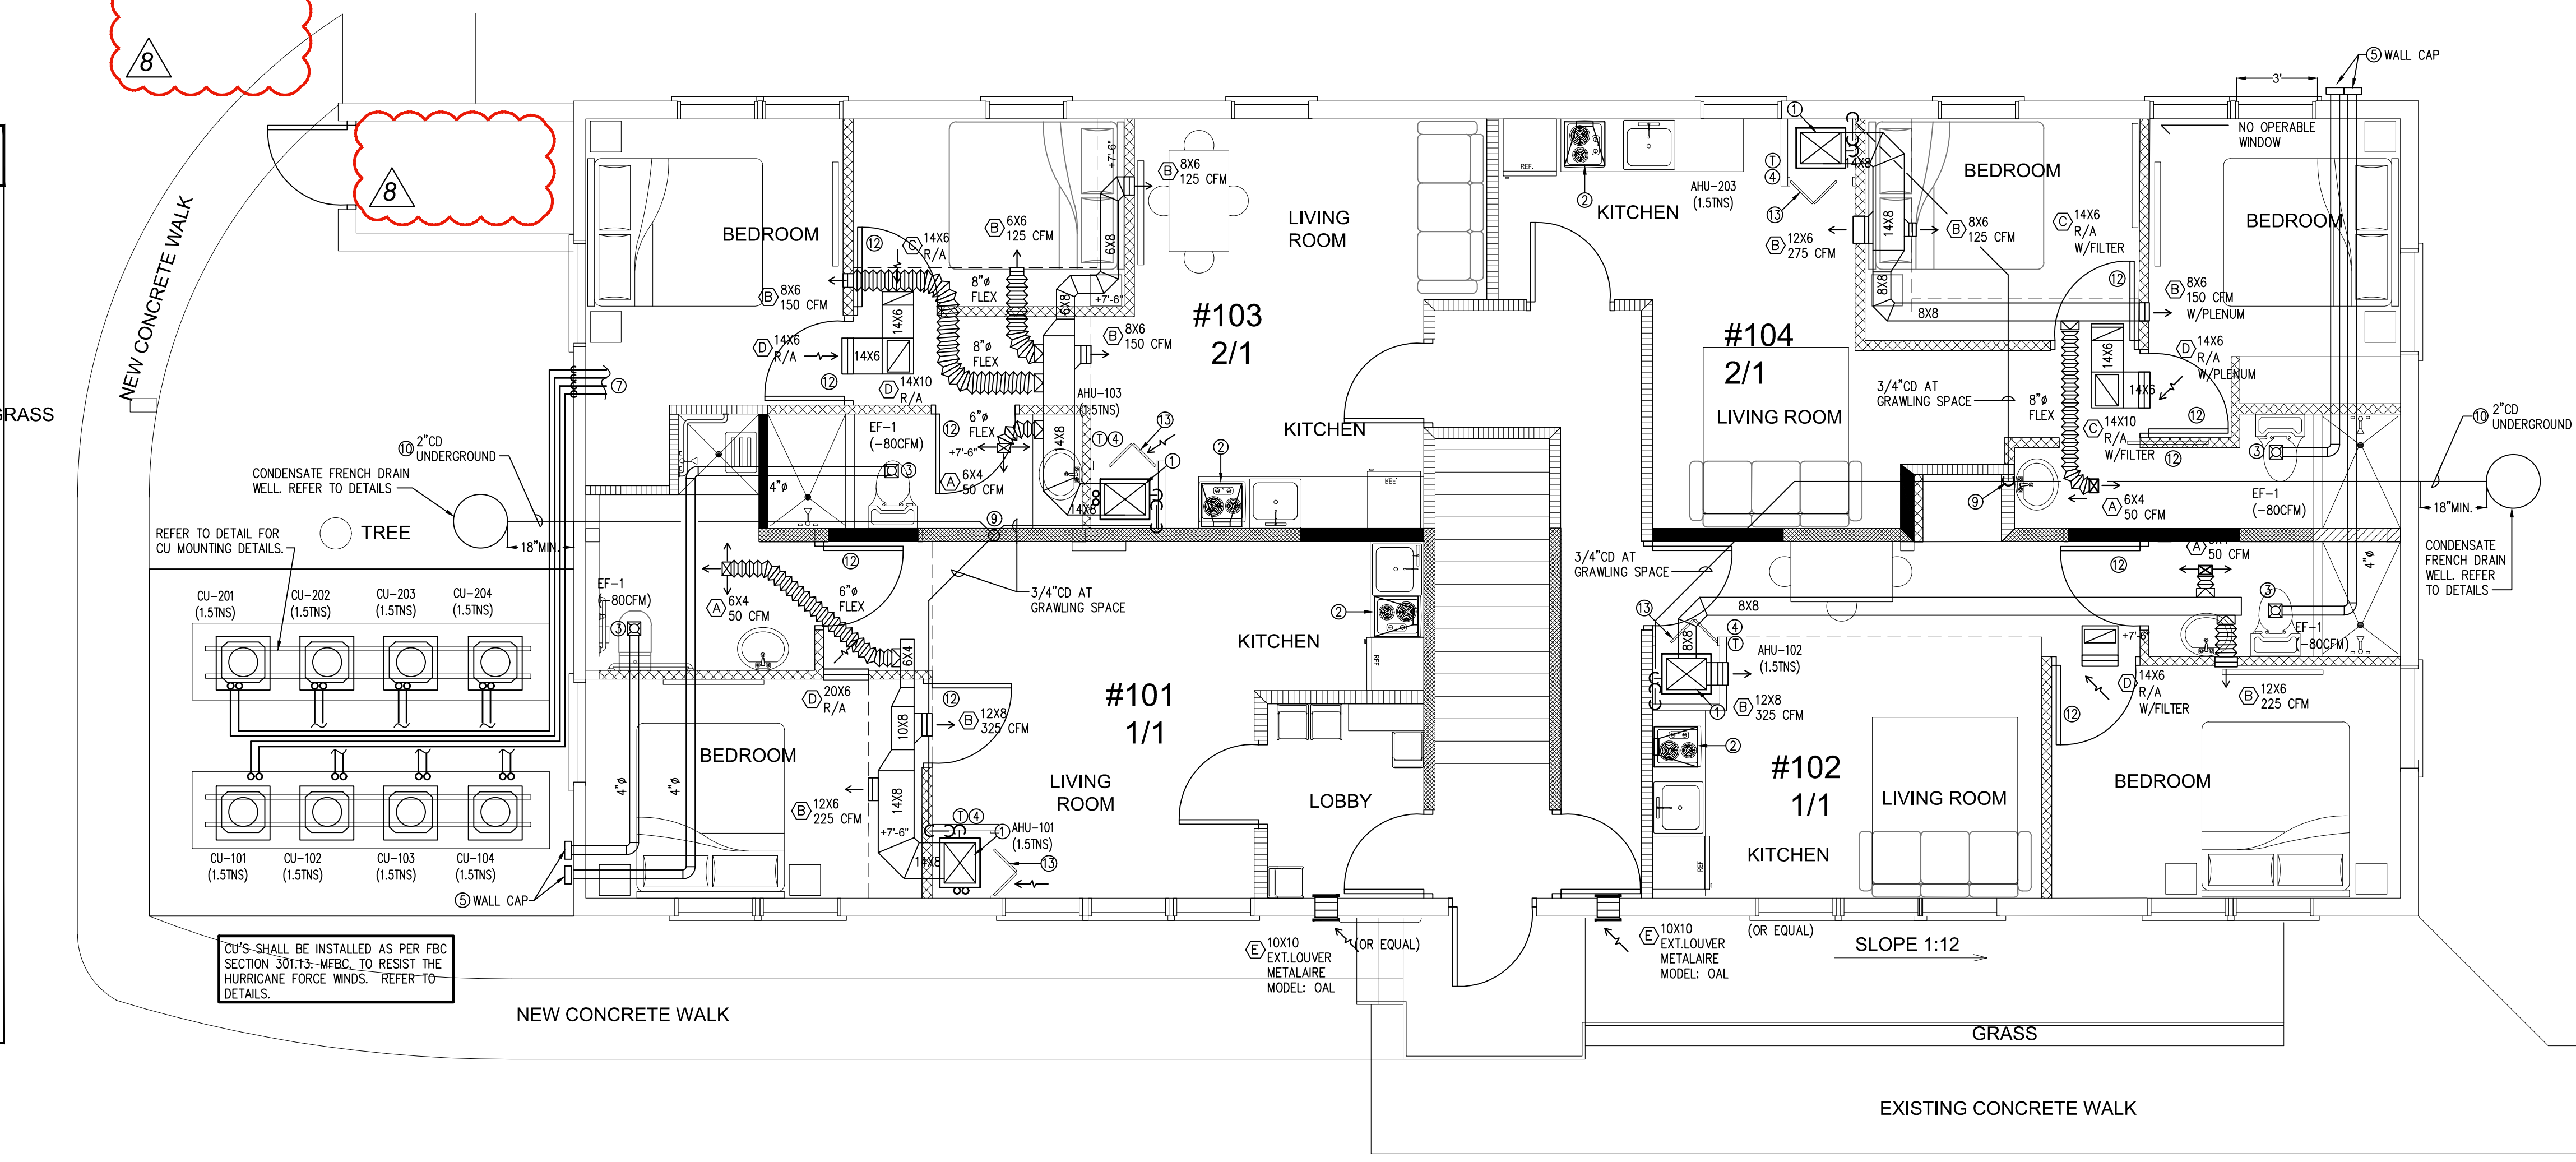

SIGNATURE / DATE / SEAL
 NOT VALID IF MISSING SIGNATURE
 Victor H. Rodriguez,
 Registered Architect
 State of Florida # AR0094965
 305.282.0005 vh.rodriguez@rda-archint.com

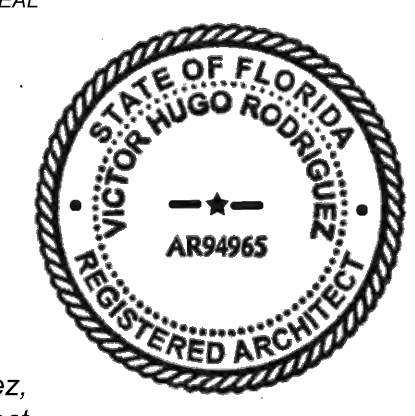

PERMIT SET

Issue	Issue Date / For
(1)	09.12.2016 / Change of Architect
(2)	
(3)	
(4)	
(100)	

DDCI Project #: 1628.00
 Drawn by: VHR
 Approved by: VHR
 SHEET INDEX
 4 - Mechanical Plan
 Ground Level

MECHANICAL GROUND FLOOR PLAN
 SCALE: 1/4" = 1'-0"

SCALE:
 SHEET NO.

M-1

1330 Building

1330 15th Street, Miami Beach, FL 33139
 PROJECT OWNER:
 NOTUS, LLC
 435 21st Street, Miami Beach, FL 33139

ARCHITECT OF RECORD:




RD Architects
 1800 SW 1st Avenue, Suite 607
 Miami, FL 33129
 Phone: 786.762.2679
 email: rda@rda-archint.com
 www.rda-archint.com
 AA26002510

INTERIOR DESIGNER:


- ### HVAC- NOTES
- ① FULL SIZE PLENUM
 - ② RECIRCULATING KITCHEN HOOD
 - ③ TOILET EXHAUST FAN
 - ④ PROGRAMMABLE THERMOSTAT
 - ⑤ TOILET EXHAUST DUCT THRU WALL CAP/ROOF EAVE W/ CORROSION RESISTANT SCREEN. AS PER FBC 401.5. 2014.
 - ⑦ REFRIGERANTE LINES AT CRAWLING SPACE.
 - ⑧ 3/4" CONDENSATE DRAIN (CD) HORIZONTAL AT CLS. SPACE. BELOW FLOOR
 - ⑨ 2" CONDENSATE DRAIN (CD) DN. INTO PARTITION SPACE
 - ⑩ 2" CONDENSATE DRAIN (CD) AT CRAWLING SPACE
 - ⑪ DRAIN WALL TYPE FRECH WELL
 - ⑫ PROVIDE RETURN AIR PLUS 1" U/C DOOR.
 - ⑬ FULL LOUVER DOOR

- ### IMPORTANT NOTE:
- ALL MECH. ROOMS SHALL HAVE A MINIMUM WORKING SPACE CLEARANCE OF 4' ALONG THE SIDES, BACK AND TOP WITH A TOTAL WIDTH OF THE ENCLOSING SPACE BEING AT LEAST 12 INCHES WIDER THAN THE AIR HANDLER. AS PER SECTION 1305.1.1. MFCR 2014.
 - DISCHARGE LOCATION OF THE CONDENSATE DRAIN SHALL BE IN COMPLIANCE BY SECTION 307 OF THE FMC AND SECTION 1503.7 OF THE 2014 FBC.
 - PROVIDE 1"UC DOOR ALL ROOM DOORS TO MAKE UP AIR IN COMPLIANCE WITH SECTION 601.4, MFCB 2014
 - ALL MECHANICAL EQUIPMENT SHALL BE LOCATED AT OR ABOVE THE FLOOR ELEVATION. REFER TO ARCH. DWGS FOR ALL EXISTING AND PROPOSED FFE AND CROWN OF THE ROAD ELEVATION IN NVDV FOR ALL MECH. EQUIPMENT.
 - REFRIGERATION PIPING RUNNING MORE THAN 50' COORDINATE SIZE LINES WITH MANUFACTURER RECOMMENDATION.
 - TOILET EXHAUST DUCT UP TO ROOF (WALL) CAP W/ CORROSION RESISTANT SCREEN. AS PER FBC 401.5. 2010. MIN. 3FT CLEARANCE FROM ANY OPERABLE BLDG. OPENING FMC 1506.2
 - NO COMBUSTIBLE MATERIAL ALLOWED AT RETURN AIR PLENUM. CONTRACTOR TO COORD. W/ SUBCONTRACTORS TO PROVIDE PROPER MATERIALS.

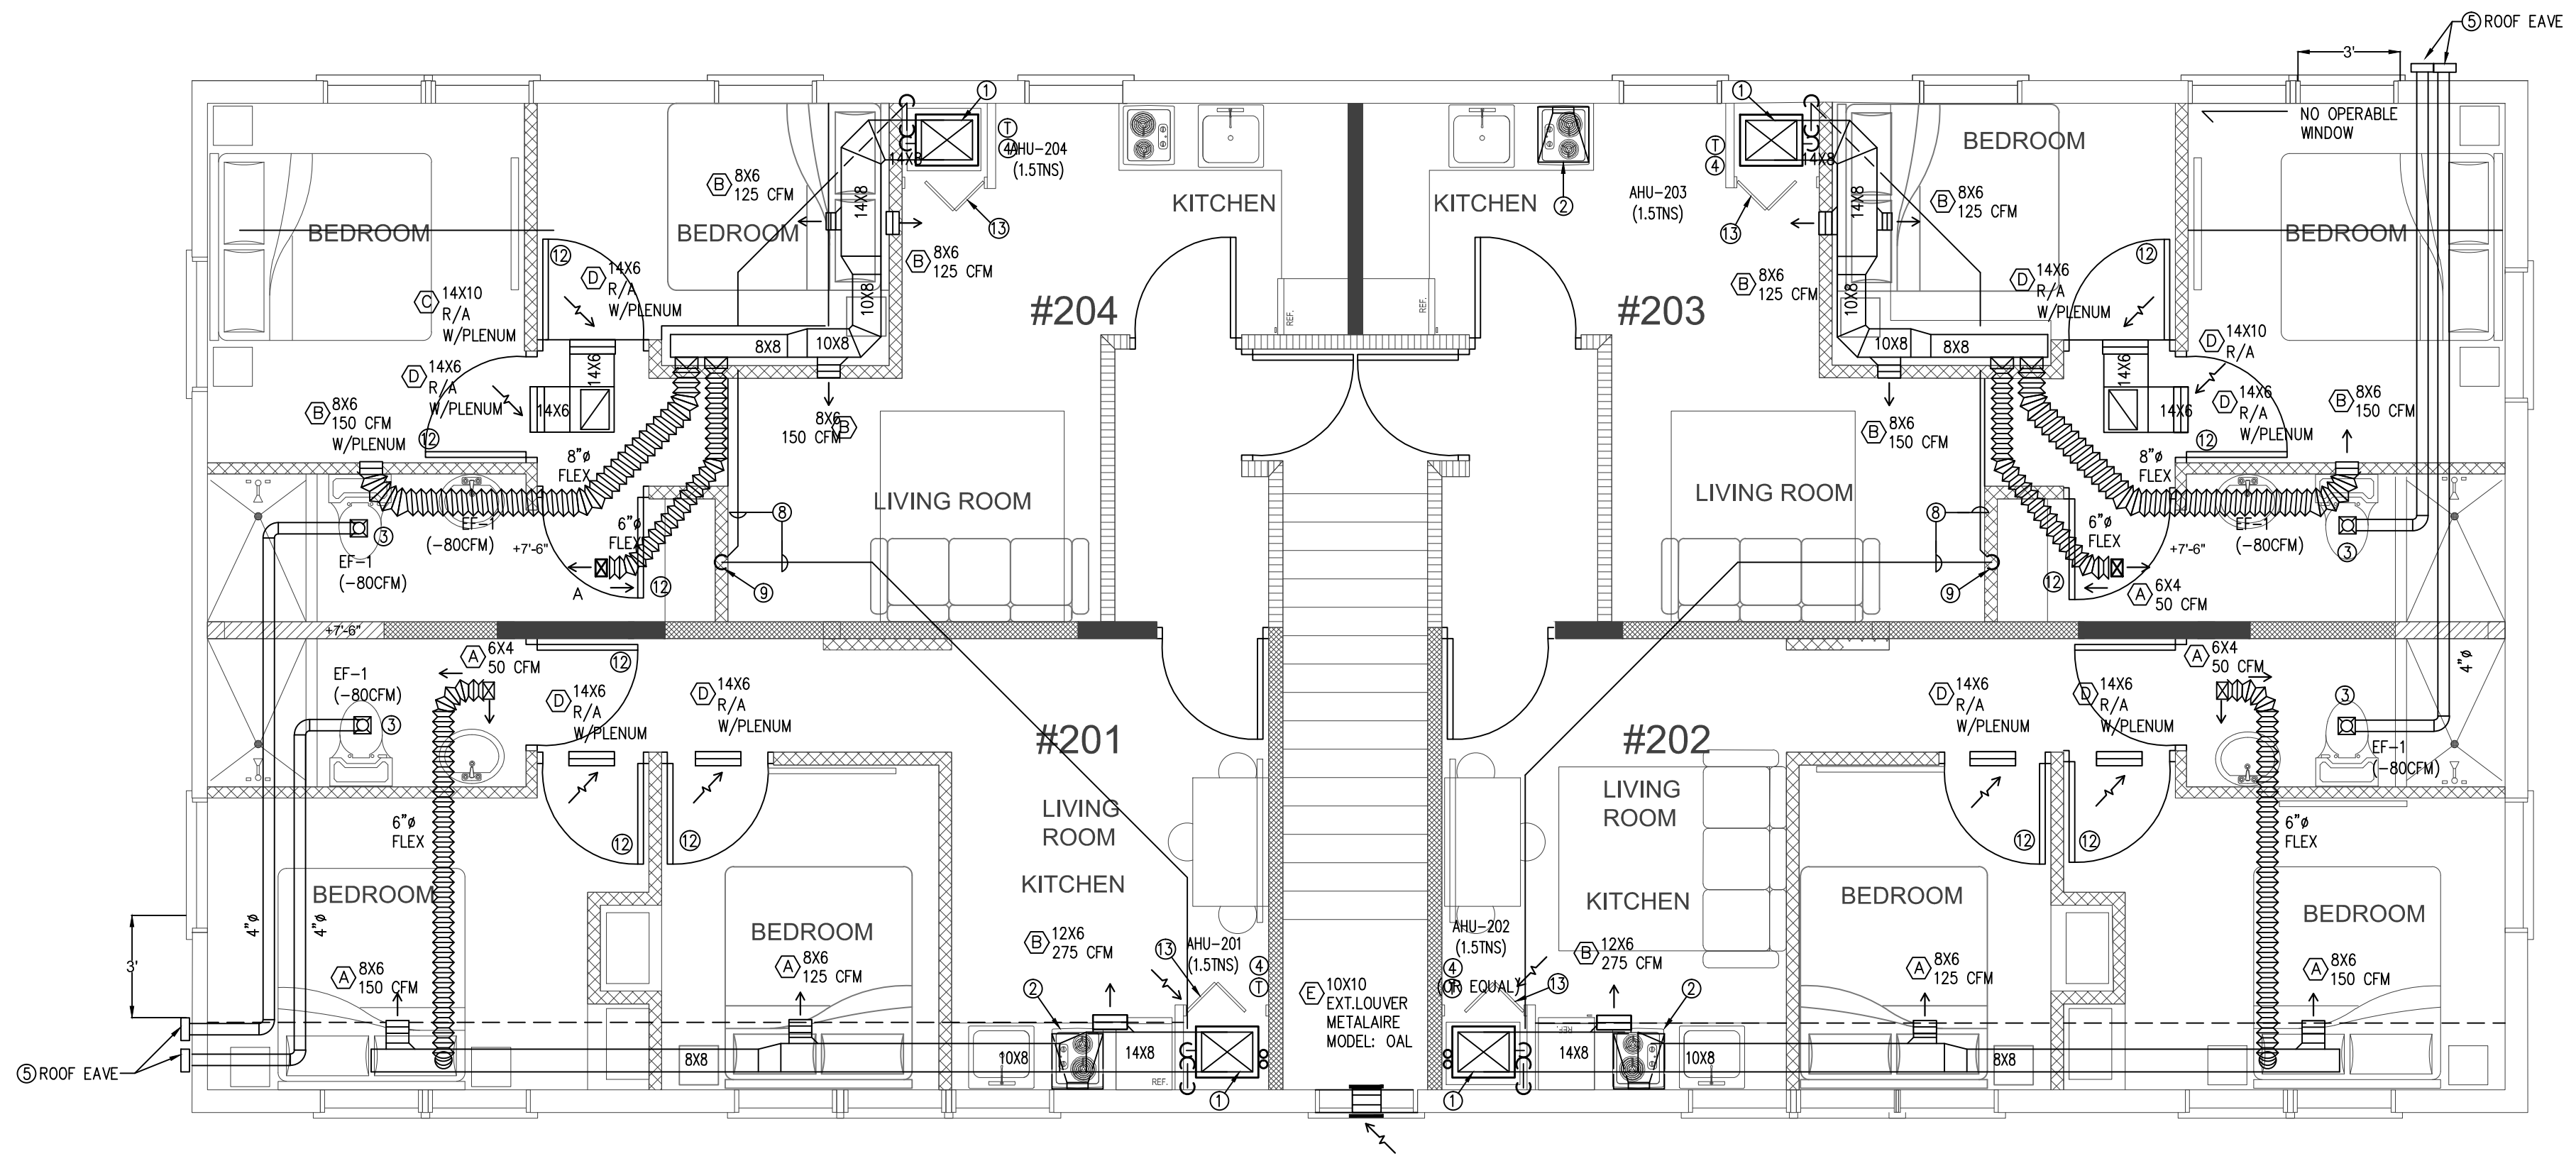

MECHANICAL SECOND FLOOR PLAN

SCALE: 1/4" = 1'-0"

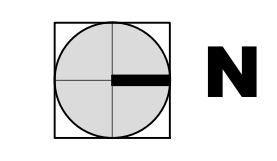

OUTSIDE AIR CALCULATIONS (PER TABLE 403.3 MFBC 2014)										
AREA SERVED	GROSS AREA (SQ.FT.)	MAX. OCCUPANCY (P/1000 SQ.FT.)	TOTAL NO. OF PEOPLE (QTY.)	PEOPLE OUTDOOR AIR FLOW RATE IN BREATHING ZONE. (CFM/P)	TOTAL CFM VENTILATION RATE. (REQ.)	EXHAUST AIRFLOW RATE. (REQ.) (CFM/SQF)	AREA OUTDOOR AIRFLOW RATE IN BREATHING ZONE. (CFM/SQF)	TOTAL AREA OUTDOOR AIRFLOW IN BREATHING ZONE. (CFM)	TOTAL CFM O/A REQUIRED (CFM)	TOTAL CFM O/A PROVIDED (CFM)
	(A)	(B)	(C)	(D)	(E)=(C)x(D)	(F)	(G)	(H)=(A)x(G)	(I)= E+H	
LOBBY AREA	42 SF	30/1000	2 P	7.5 CFM/P	15	---	0.06 CFM/SF	3	18	18
CORRIDOR AREAS (1ST FL)	86 SF	---	---	---	---	---	0.06 CFM/SF	6	6	6
CORRIDOR/STAIR AREA	187 SF	---	---	---	---	---	0.06 CFM/SF	12	12	12

Q=VAE
 Q= 18 CFM (TABLE 403.3 MEC. BLDG. CODE)
 V= VELOCITY 2 MPH = 352 FT PER MINUTE. A= SQ. FT OF FREE AREA OF WALL OPENING W/ SCREEN OR LOUVER OPENING NOT LESS THAN 1/4" AND NOT GREATER THAN 1/2".
 E= EFFECTIVENESS WITH WIND DIAGONAL TO WALL USE FACTOR 0.3
 A= Q / V * E = 18 / (352 * 0.3) = 0.18 SQ FT.
 A= 0.18 SQ FT. X 144 = 24 SQ. IN. (NET FREE OPENING)
 PROVIDE EXTERIOR WALL LOUVER 10 x 10. METALARE. MODEL:0AL

KEY PLAN



SIGNATURE / DATE / SEAL

Victor H. Rodriguez,
 Registered Architect
 State of Florida # AR0094965
 305.282.0005 vhr.rodriquez@rda-archint.com

PERMIT SET

Issue	Issue Date / For
1	12.05.2016 / Owner Revisions

DDCI Project #: 1628.00
 Drawn by: VHR
 Approved by: VHR

SHEET INDEX

4 - Mechanical Plan Level 2

SCALE:
 SHEET NO.

M-2

HVAC NOTES	
1. GENERAL	
A.	ALL WORK SHALL BE DONE in accordance with the Florida Building Code 2014 and with all applicable regulations.
B.	DRAWINGS: Refer to all drawings for coordination of the HVAC work.
C.	ARRANGE AND PAY for all permits licenses, inspections and tests. Obtain the required certificates and present to owner.
D.	GUARANTEE: The completed installation shall be fully guaranteed against defective materials and/or improper workmanship for a minimum of one year for material and labor. Compressors shall be guaranteed for a period of five years.
E.	As built drawings shall be submitted to owner at the completion of project.
2.	SHOP DRAWINGS: Contractors shall submit for approval, within 30 days after signing contract, a minimum of five copies of fully descriptive literature, including but not limited to: fans, air conditioning units, air outlets. No work shall proceed without approval of these submittals.
3.	DESIGN PARAMETERS: A. Outdoor design temperature (Summer): 91°F DB and 77°F WB B. Outdoor design temperature (Winter): 46°F C. Indoor design temperature (Summer): 78°F DB D. Indoor design temperature (Winter): 72°F DB
4.	ALL THERMOSTATS SHALL have heating mode maximum setting of 75 F, and cooling mode minimum setting of 70 F. The thermostat shall be arranged to prevent the simultaneous operation of heating and cooling.
5.	ELECTRICAL CONTROLS AND POWER WIRING: Under electrical contract.
6.	EQUIPMENT SPECIFIED BY manufacturer's number shall include all accessories, controls, etc., listed in the catalog as standard with the equipment. Optional or additional accessories shall be furnished as specified.
7.	MATERIALS: A. REFRIGERANT PIPING: Shall be type L soft drawn, copper tubing, dehydrated for refrigerant use. Sized as shown on drawings or as per air conditioning equipment manufacturer's recommendations. B. INSULATION: Refrigerant suction piping shall be insulated with 1/2" thick foamed plastic insulation, fire retarding type. Insulation shall be installed in piping before assembly. No split insulation will be acceptable. Seal joints with manufacturer's approved adhesive and gray tape. - Refrigerant suction line to be insulated w/ insulation having a thermal resistivity of at least R-4 and having an external permanence not exceeding 0.05 perm when tested in accordance w/ ASTM E96, and in compliance w/ FMC-M1411.5 C. DUCTWORK: a. All supply air ductwork shall be fiberglass duct board, fabricated and installed as per latest edition of SMACNA "Fibrous Glass Duct Manual". 1-1/2" thick R-6.0 b. All exhaust ductwork shall be galvanized sheet metal duct not lighter than 28 gage. c. All duct dimensions are clear inside dimensions. d. Flexible insulated ductwork with 1 1/2" thick fiberglass insulation with FRK vapor barrier, class I air duct, U.L. R-6.0 MIN. D. CLOTHES DRYER EXHAUST: * Installation: clothes dryers shall be exhausted in accordance with the manufacturer recommendation and as per section 504/502.6 /FMC * Makeup air: installations exhausting more than 200 CFM shall be provided with make up air. Where a closet is designed for installation or a clothes dryer exhaust ducts shall not extend into or through ducts or plenums. * Dryer ductwork: 26 ga. min. galvanized steel (as per FBC R-M1502.4.1), having a smooth interior surface with joints running in the direction of airflow and without sheet metal screws or other fasteners in the air stream. Maximum length shall not exceed 25 feet. wall caps shall be provided with backdraft damper. * Dryer wall cap shall not be screened as per FBCR-M1502.3. * Dryer wall cap shall have a min. of 3ft clearance from any operable bldg. opening FMC 501.2.1(3) 8. Provide metal round fittings with scoop at all flexible duct connection to supply duct. 9. TEST AND BALANCE: Contractor shall test and balance all ventilation and air conditioning systems. Submit four copies of Test and Balance Report to owner for approval. 10. CONTROLS: Air conditioning units shall be started and stopped thru individual thermostat. Individual thermostats shall start/stop supply fans and activate cooling/heating systems as selected. 11. Mechanical plans in general, are diagrammatic in nature, and are to be read in conjunction with arch, Plumbing, electrical and structural plans and shall be considered as one set of documents. Duct and piping offsets, bends and transitions will be required to provide and install a complete functional system and shall be provided by the contractor at no additional cost to the owner. 12. Contractor shall verify job conditions prior to ordering, fabrication or installation of materials or equipment. Notify architect/engineer of any conflicts before fabrication.

VENTILATION FAN SCHEDULE	
UNIT DESIGNATION	EF-1
AREA SERVED	SEE DWG
OPERATING WEIGHT, LBS	19
LOCATION	CEILING
FAN TYPE	SEE DWGS
TOTAL AIR, CFM	80
DRIVE TYPE	DIRECT
FAN WHEEL TYPE	CENTRIFUGAL
FAN TIP SPEED, FPM MAX.	---
FAN SPEED, RPM	---
TOTAL STATIC PRESSURE, IN OF WATER	---
FAN MOTOR HP. (NON-OVERLOAD)	0.7 AMPS
FAN MOTOR STARTER TYPE	WALL SWITCH
STARTER FURNISHED BY	MC
ELECTRICAL SERVICE AVAILABLE	120-1-60
---	---
SONES	1.5
DESIGN MANUFACTURER	BROAN
MODEL NUMBER	QTXE80
SERVICE SWITCH	YES
SMOKE DETECTOR (U.L. APPROVED)	NO
FIRE DAMPER	---
CONSTRUCTION	ALUM/PLASTIC
MULTIBLADE BACK DRAFT DAMPER	YES
BIRD SCREEN	NO
SOLID STATE SPEED CONTROL	NO
THERMOSTAT CONTROL	NO
FACTORY FABRICATED CURB	NO
FILTER AND FILTER FRAME	NO


HVAC DESIGN REQUIRES:	YES	NO
DUCT SMOKE DETECTOR		●
FIRE DAMPER(S)		●
SMOKE DAMPER(S)		●
FIRE RATED ENCLOSURE		●
FIRE RATED ROOF/FLOOR CEILING ASSEMBLY		●
FIRE STOPPING	●	
SMOKE CONTROL		●

AIR DISTRIBUTION SCHEDULE						
SYMBOL	TAG	USE	TYPE	ACCESSORIES	MFG. & MODEL NO.	REMARK
	A	SUPPLY AIR	ALUMINUM CEILING DIFFUSER	O.B.D.	TITUS TITUS 250-AA	CEILING MOUNTED
	B	SUPPLY AIR	ALUMINUM WALL DIFFUSER	O.B.D.	TITUS TITUS 250-AA	WALL MOUNTED
	C	RETURN AIR	ALUMINUM RETURN GRILL	---	TITUS MODEL 350F	RETURN REGISTER
	D	RETURN AIR	WALL RETURN GRILL	---	TITUS 55F	RETURN REGISTER

- NOTE: 1. ALL AIR DISTRIBUTION DEVICES SHALL BE ALL ALUMINUM CONSTRUCTION.
 2. FINISHES AND TYPES OF MOUNTS SHALL BE COORDINATED WITH ARCHITECTURAL DRAWING. COORDINATE COLOR FINISH
 3. DESIGN IS BASED ON TITUS OR APPROVED EQUAL.
 4. MAX. ACCEPTABLE FACE VELOCITY THROUGH NET FREE AREA: 400 FT/MIN.
 5. 30 MAX NOISE CRITERIA

SPLIT AC UNIT SCHEDULE	
UNIT DESIGNATION	AHU-101, 102, 103, 104, 201, 202, 203 & 204
AREA SERVED	SEE PLAN
LOCATION	UTILITY ROOM
DIMENSIONS, (L,W,H)	22 X 18 X 50
OPERATING WEIGHT, LBS	122
MODEL NUMBER	FX40NF019T00
SEER	16.0
TOTAL AIR, CFM	600
OUTSIDE AIR, CFM	0
EXTERNAL STATIC PRESSURE, IN OF WATER	0.4
FAN MOTOR FLA-HP	2.8 - 1/3
ELECTRICAL SERVICE AVAILABLE	208/1/60
M.C.A. (AHU+HTR)(208 V)	26.0
M.O.C.P. (AHU+HTR)(208 V)	30
DESIGN AIR FLOW, CFM	600
TOTAL CAPACITY, MBH	18.0
SENSIBLE CAPACITY, MBH	12.8
ENTERING AIR TEMP., F°DB/WB	80/67
COIL MODEL NO.	----
FILTER	CLEANABLE /1"
HEATER KW (240 V)	ELECT.(5 KW)
ELECTRICAL SERVICE AVAILABLE	208-240/1/60
UNIT DESIGNATION	CU-1
NO. OF FANS	1/--
CONDENSER FAN F.L.A. - H.P	0.5-1/12
AMBIENT AIR TEMP. °F DB	95
CONDENSING TEMP. °F DB	---
NO. OF COMPRESSORS	1
CAPACITY REDUCTION EA.	---
COMPRESSOR F.L.A. - L.R.A. EA.	9.0-48.0
ELECTRICAL SERVICE AVAILABLE	208/1/60
OPERATING WEIGHT, LBS	118
DESIGN MANUFACTURER	CARRIER
DIMENSIONS, (L,W,H)	23 X 23 X 29
MODEL NUMBER	24ABC618A003
M.C.A.	11.8
M.O.C.P.	20
SUCTION (IN. OD)	3/4
LIQUID (IN. OD)	3/8
REFRIGERANT	R-410A

- NOTES: 1.- ALL FAN COIL UNITS SHALL BE PROVIDED WITH FACTORY INSTALLED CIRCUIT BREAKER.
 2.- ALL THERMOSTATS SHALL BE PROGRAMMABLE TYPE.
 3.- DESIGN IS BASED ON CARRIER OR APPROVED EQUAL W/ SIMILAR SPEC'S AS SHOWN. (SAME SENSIBLE CAPACITY)
 4.- VOLTAGE VALUES BETWEEN PARENTHESIS DENOTES ONLY FOR ELECTRICAL CALCULATIONS. FOR GOOD PRACTICE VOLTAGE AND SPECIFICATION TO BE COORDINATED WITH MANUFACTURER AND ELECTRICAL SERVICE AVAILABLE.
 5.- REFER TO ELEC. DWGS FOR ELEC. SPEC'S.

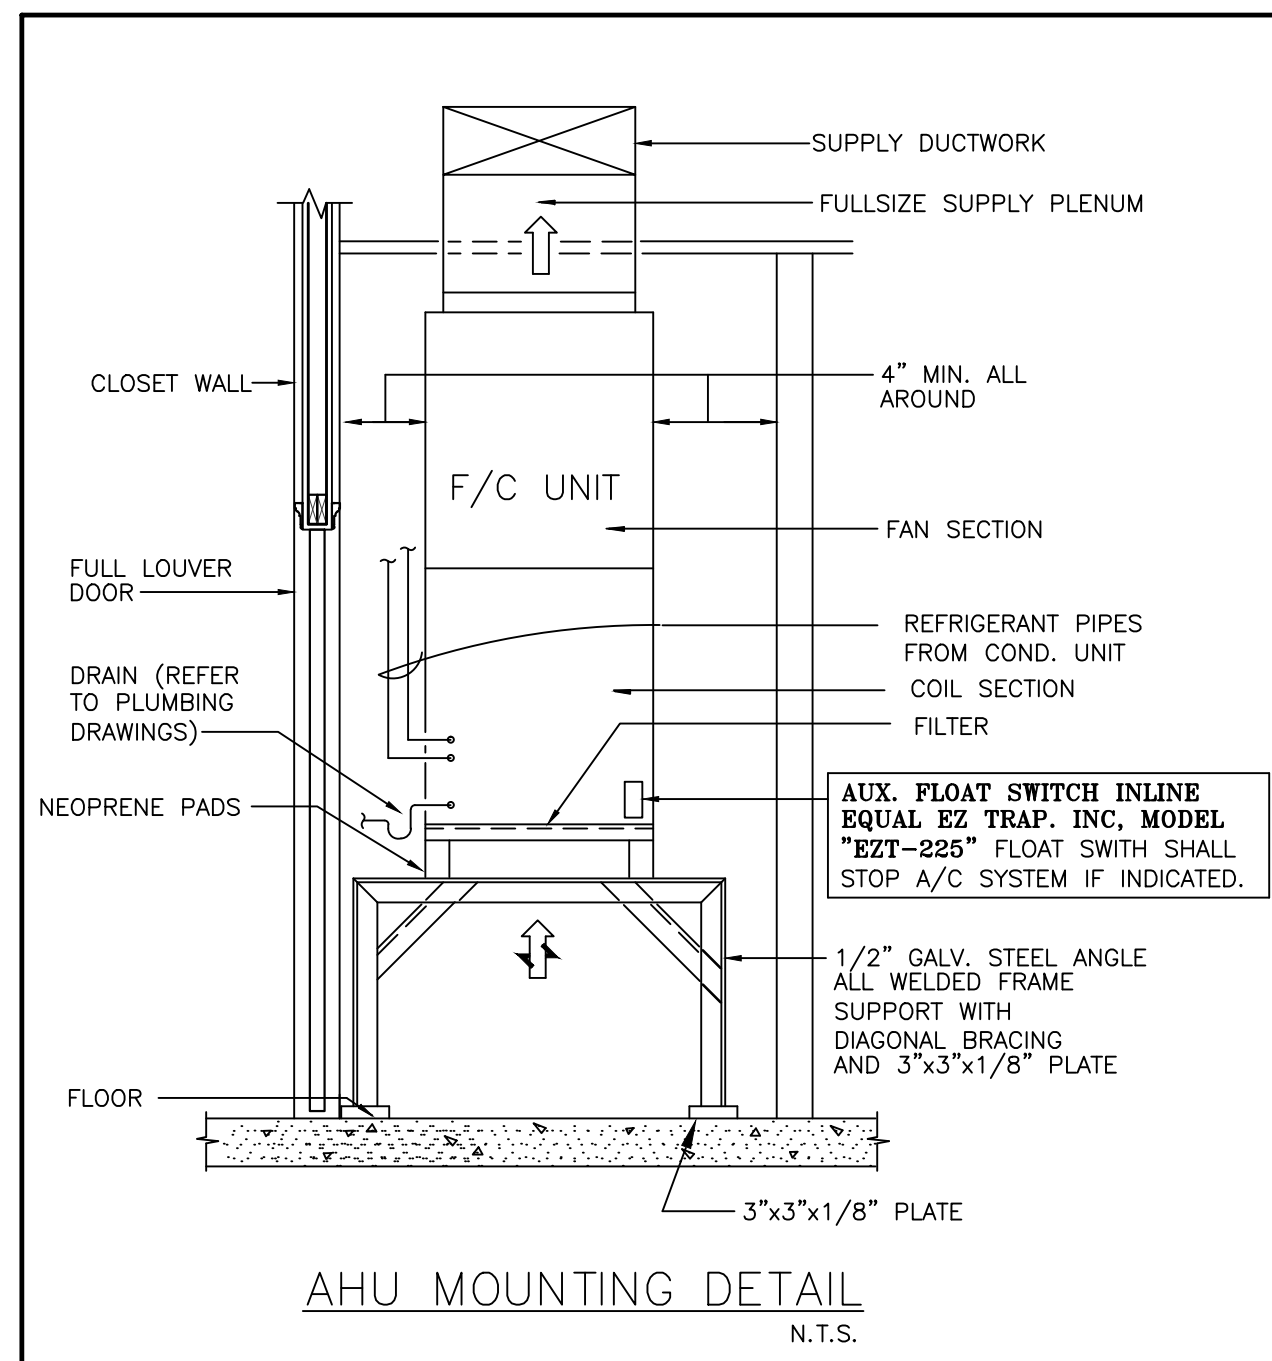

PROJECT: **1330 Building**
 1330 15th Street, Miami Beach, FL 33139
 PROJECT OWNER: NOTUS, LLC
 435 21st Street, Miami Beach, FL 33139
 ARCHITECT OF RECORD:
RD Architects
 1800 SW 1st Avenue, Suite 607
 Miami, FL 33129
 Phone: 786.762.2679
 email: rda@rda-archint.com
 www.rda-archint.com
 AA28602510
 INTERIOR DESIGNER:
 KEY PLAN:
 SIGNATURE / DATE / SEAL
 Victor H. Rodriguez,
 Registered Architect
 State of Florida # AR0094965
 305.282.0005 vh.rodriguez@rda-archint.com
PERMIT SET
 Issue: Issue Date / For
 12.05.2016 / Owner Revisions
 DDCI Project #: 1628.00
 Drawn by: VHR
 Approved by: VHR
 SHEET INDEX
- Mech. General Notes
- Schedules
- Details
 SCALE:
 SHEET NO.