



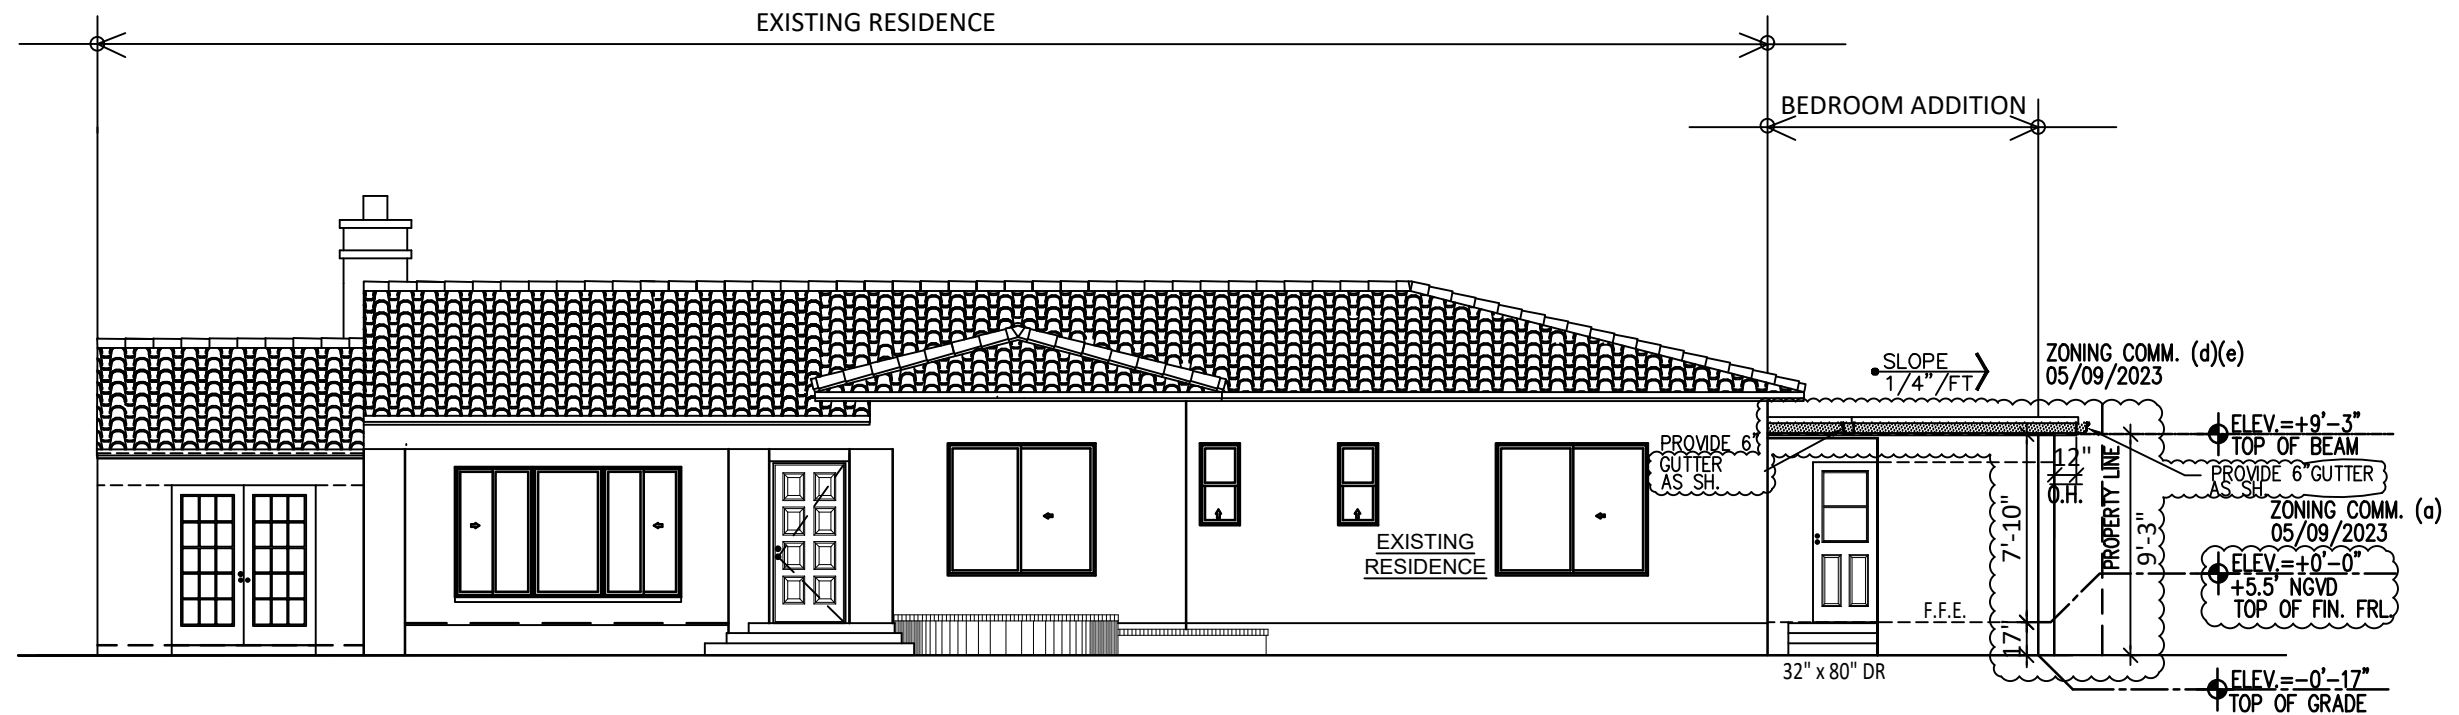

FRONT ELEVATION (SOUTH)

SCALE: 1/8" = 1'-0"

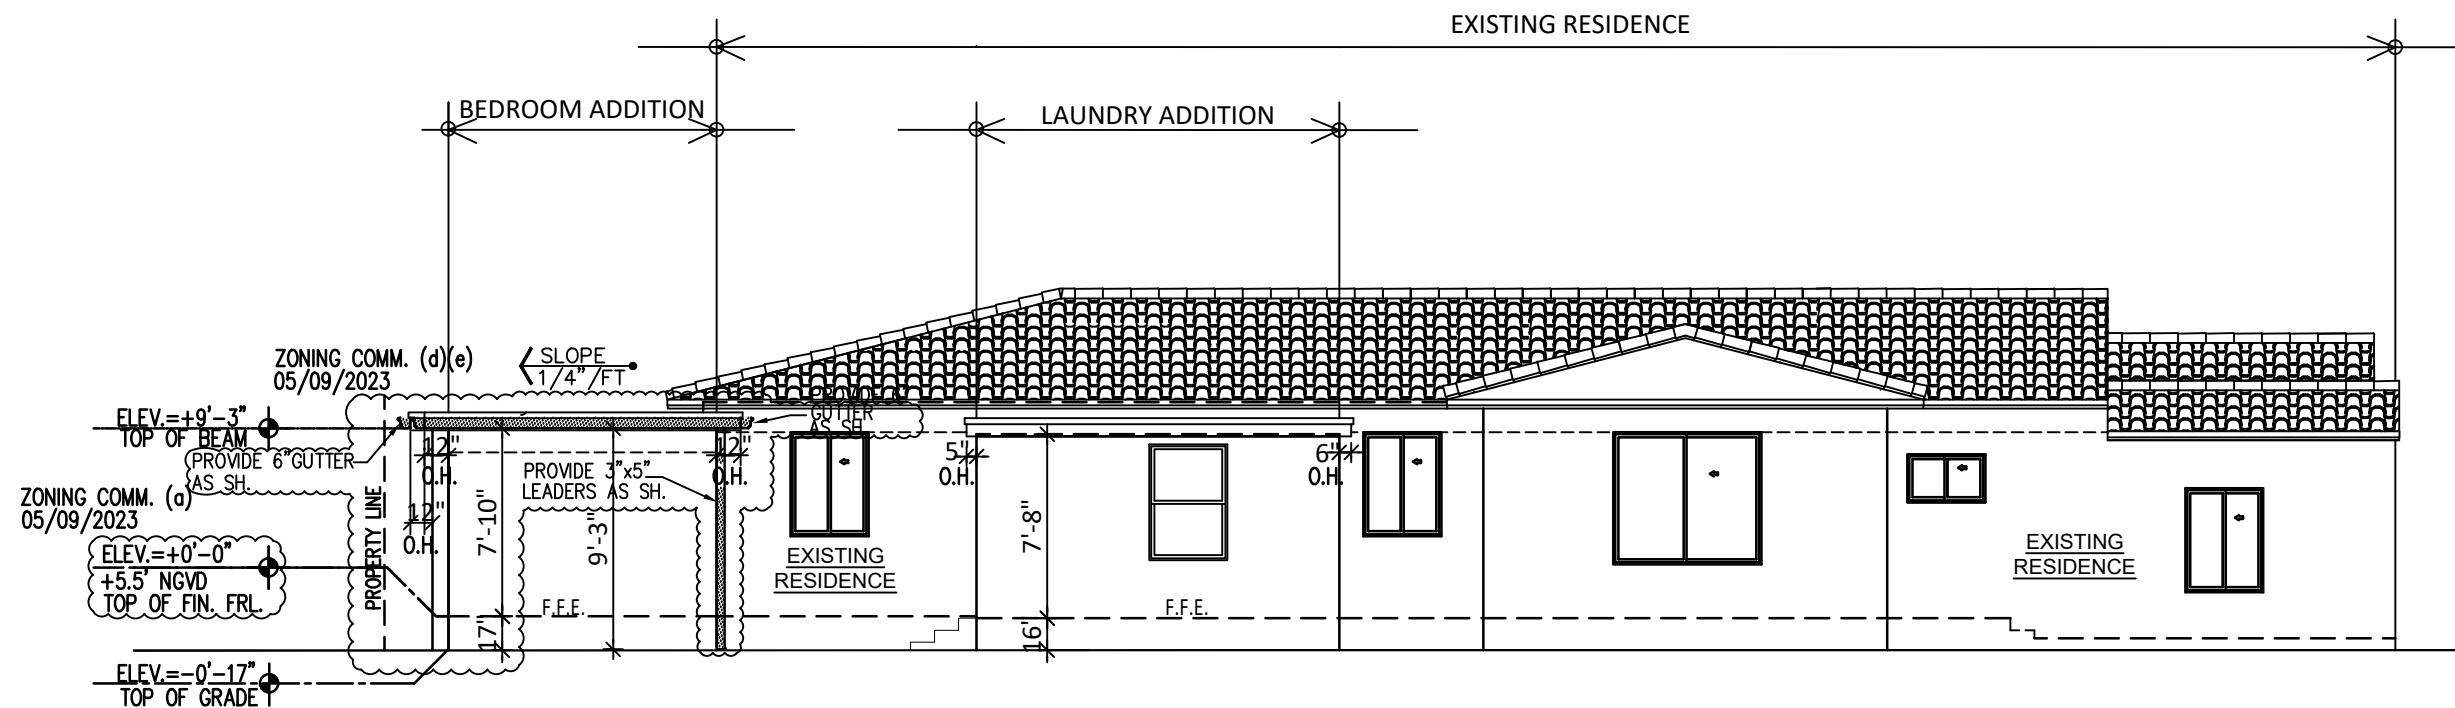

REAR ELEVATION (NORTH)

SCALE: 1/8" = 1'-0"

Emilio Castro

P.E.
Civil # 41592

E.C. & ASSOCIATES INC
Consulting
Engineers

EB 06576

14811 S.W. 9th Lane
Miami, Florida 33194
Cell: 786-286-5793
Ph/Fax: 305-480-7886

E-mail:
edcastro14811@gmail.com
edcastro14811@comcast.net

Project Name and Address:
CODE RELIEF ADDITION
625 WEST 42 STREET
Miami Beach, Florida 33141

Client Name and Address:
STEPHEN KALOS Yael Kalos
625 West 42 Street
Miami Beach, Florida 33141

PROJECT No. 23-007

DRAWN BY: E.C. E.S. J.S.

CHECKED BY: E.C.

Permit: 68-3222-001-1880

DATE: 03-25-2023

ZONING 05-09-2023

MARK	DESCRIPTION	DATE
A.B.	AS-BUILT	
R.A.P.	REVISION AFTER PERMIT	
B.D.C.	BUILDING DEPT. COMMENTS	
C.C.	COORDINATION CHANGES	
P.S.	PERMIT SET	
D.D.	DESIGN DEVELOPMENT	
P.H.	PUBLIC HEARING	

Engineer:

EMILIO CASTRO
SEAL



plot date:

05-15-2023

SHEET TITLE

**FRONT
& REAR
ELEVATION**

A-2.0

SHEET 4 OF 8