

THE DESIGNS INDICATED IN THESE DRAWINGS ARE PROPERTY OF RD Architects. ALL COPYRIGHTS RESERVED © 2016

1

2

3

4

E

D

C

B

A

1

2

3

4

E

D

C

B

A

1

2

3

4

E

D

C

B

A

1

2

3

4

E

D

C

B

A

1

2

3

4

E

D

C

B

A

1

2

3

4

E

D

C

B

A

1

2

3

4

E

D

C

B

A

1

2

3

4

E

D

C

B

A

1

2

3

4

E

D

C

B

A

1

2

3

4

E

D

C

B

A

1

2

3

4

E

D

C

B

A

1

2

3

4

E

D

C

B

A

1

2

3

4

E

D

C

B

A

1

2

3

4

E

D

C

B

A

1

2

3

4

E

D

C

B

A

1

2

3

4

E

D

C

B

A

1

2

3

4

E

D

C

B

A

1

2

3

4

E

D

C

B

A

1

2

3

4

E

D

C

B

A

1

2

3

4

E

D

C

B

A

1

2

3

4

E

D

C

B

A

1

2

3

4

E

D

C

B

A

1

2

3

4

E

D

C

B

A

1

2

3

4

E

D

C

B

A

1

2

3

4

E

D

C

B

A

1

2

3

4

E

D

C

B

A

1

2

3

4

E

D

C

B

A

1

2

3

4

E

D

C

B

A

1

2

3

4

E

D

C

B

A

1

2

3

4

E

D

C

B

A

1

2

3

4

E

D

C

B

A

1

2

3

4

E

D

C

B

A

1

2

3

4

E

D

C

B

A

1

2

3

4

E

D

C

B

A

1

2

3

4

E

D

C

B

A

1

2

3

4

E

D

C

B

A

1

2

3

4

E

D

C

B

A

1

2

3

4

E

D

C

B

A

1

2

3

4

E

D

C

B

A

1

2

3

4

E

D

C

B

A

1

2

3

4

E

D

C

B

A

1

2

3

4

E

D

C

B

A

1

2

3

THE DESIGNS INDICATED IN THESE DRAWINGS ARE PROPERTY OF RD Architects. ALL COPYRIGHTS RESERVED © 2016


1

2

3


4

PLUMBING SYMBOL LEGEND	
SYMBOL	DESCRIPTION
	SANITARY LINE
	VENT LINE
	SEWER LINE
	GREASE WASTE LINE
	EXISTING LINE TO REMAIN
	GATE VALVE
	COLD WATER LINE
	HOT WATER LINE
	RECIRCULATED HOT WATER LINE
	PLUMBING FIXTURE DESIGNATION
	FLUSH CLEAN OUT
	FLOOR DRAIN
	FLOOR PENETRATION
	WATER HAMMER ARRESTOR
	WALL CLEANOUT
	VENT THRU ROOF
	CLEANOUT ON GRADE
	HOSE BIBB W/ VACUUM BREAKER AND SHUT-OFF VALVE
	HEATER RELIEF LINE
	SHUT-OFF VALVE
	TIE-IN TO EXISTING PIPING VERIFY LOCATION AND INVERT BEFORE ROUGH-IN. NOTIFY ENGINEERS FOR ANY DISCREPANCIES.
	BALANCING VLV. W/ INDICATOR

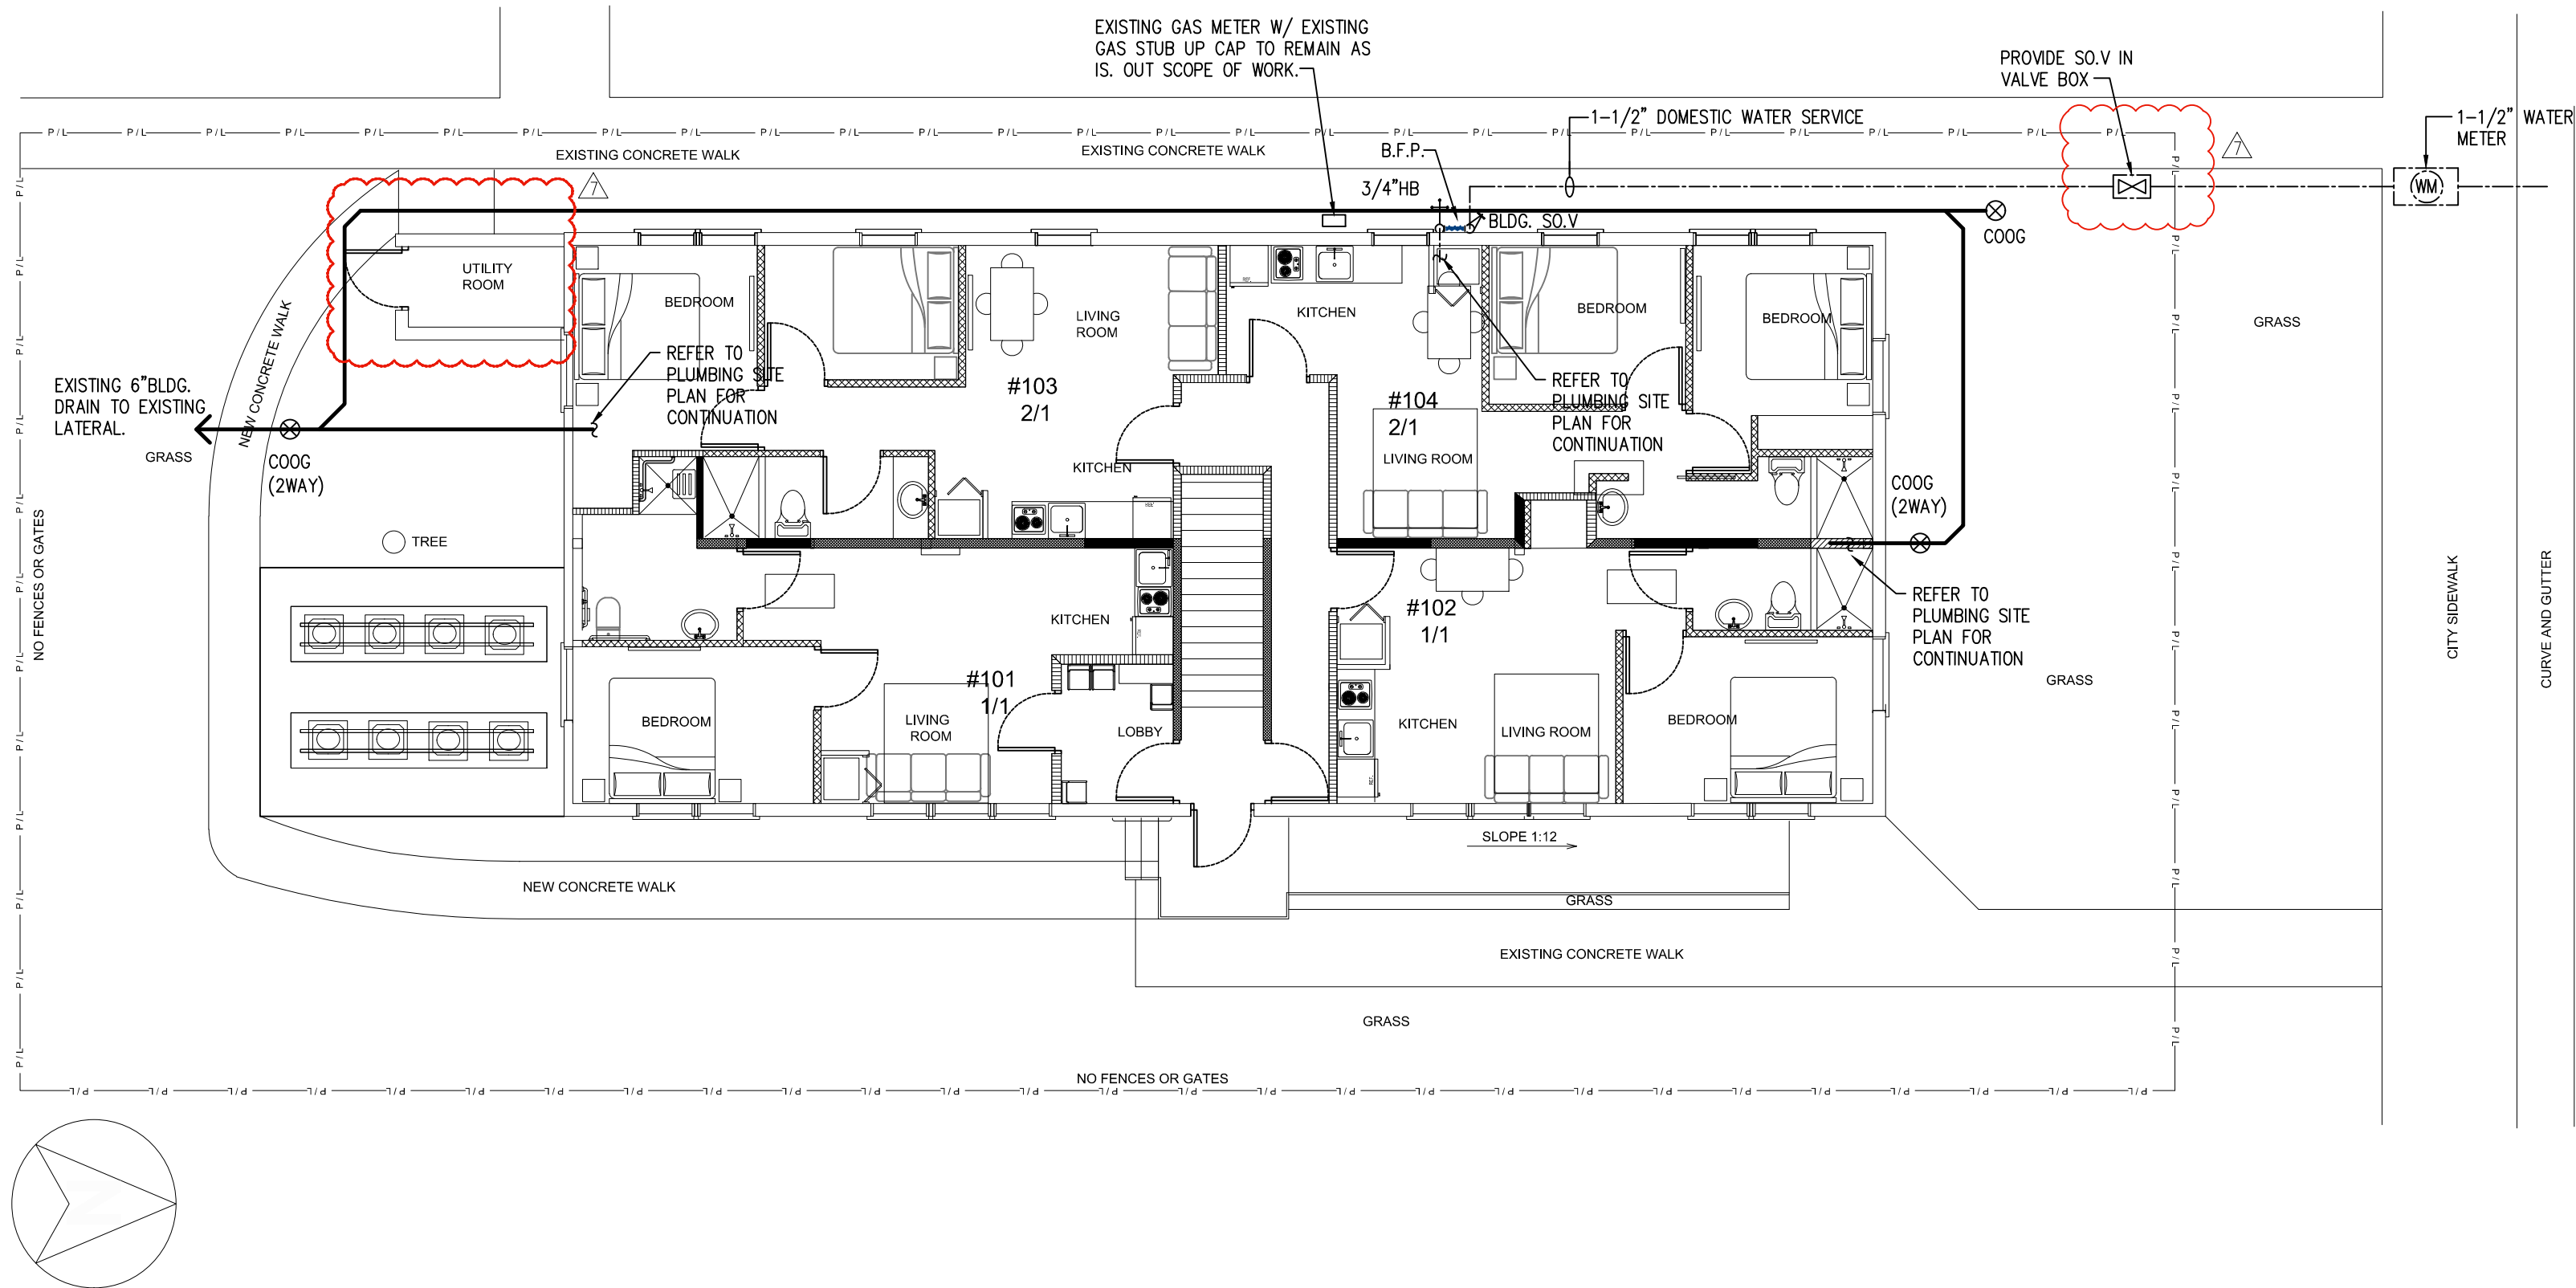

PLUMBING SITE PLAN

SCALE: 1/8" = 1'-0"

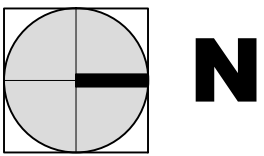

PROJECT:

1330 Building

1330 15th Street, Miami Beach, FL 33139

PROJECT OWNER :

NOTUS, LLC
435 21st Street, Miami Beach, FL 33139

ARCHITECT OF RECORD:



RD Architects

1800 SW 1st Avenue, Suite 607, Miami, Florida 33129
P: 786.762.2679 F: 305.831.8079 C: 305.282.0005
Email: rda@rda-archint.com / AA26002510
www.rda@rda-archint.com / AA26002510

CONSULTANT ENGINEER:


2

KEY PLAN



SIGNATURE / DATE / SEAL

NOT VALID IF
MISSING
SIGNATURE

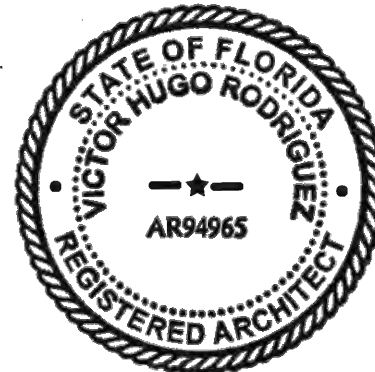

Victor H. Rodriguez,
Registered Architect
State of Florida # AR0094965
305 . 282 . 0005 vh.rodriguez@rda-archint.com

PERMIT SET

Issue	Issue Date / For
	12.05.2016 / Owner Revisions
	05.05.2017 / Reviewer Comments
	08.07.2017 / Reviewer Comments
	12.17.2017 / Fire Dept. Comments
	12.17.2017 / Fire Dept. Comments
	02.19.2018 / City Comments
	04.20.2018 / Coordination w/ comments

DDCI Project #: 1628.00

Drawn by: VHR

Approved by: VHR

SHEET INDEX


4 - Plumbing Site Plan

SCALE :

SHEET NO.


P-1

THE DESIGNS INDICATED IN THESE DRAWINGS ARE PROPERTY OF RD Architects. ALL COPYRIGHTS RESERVED © 2016

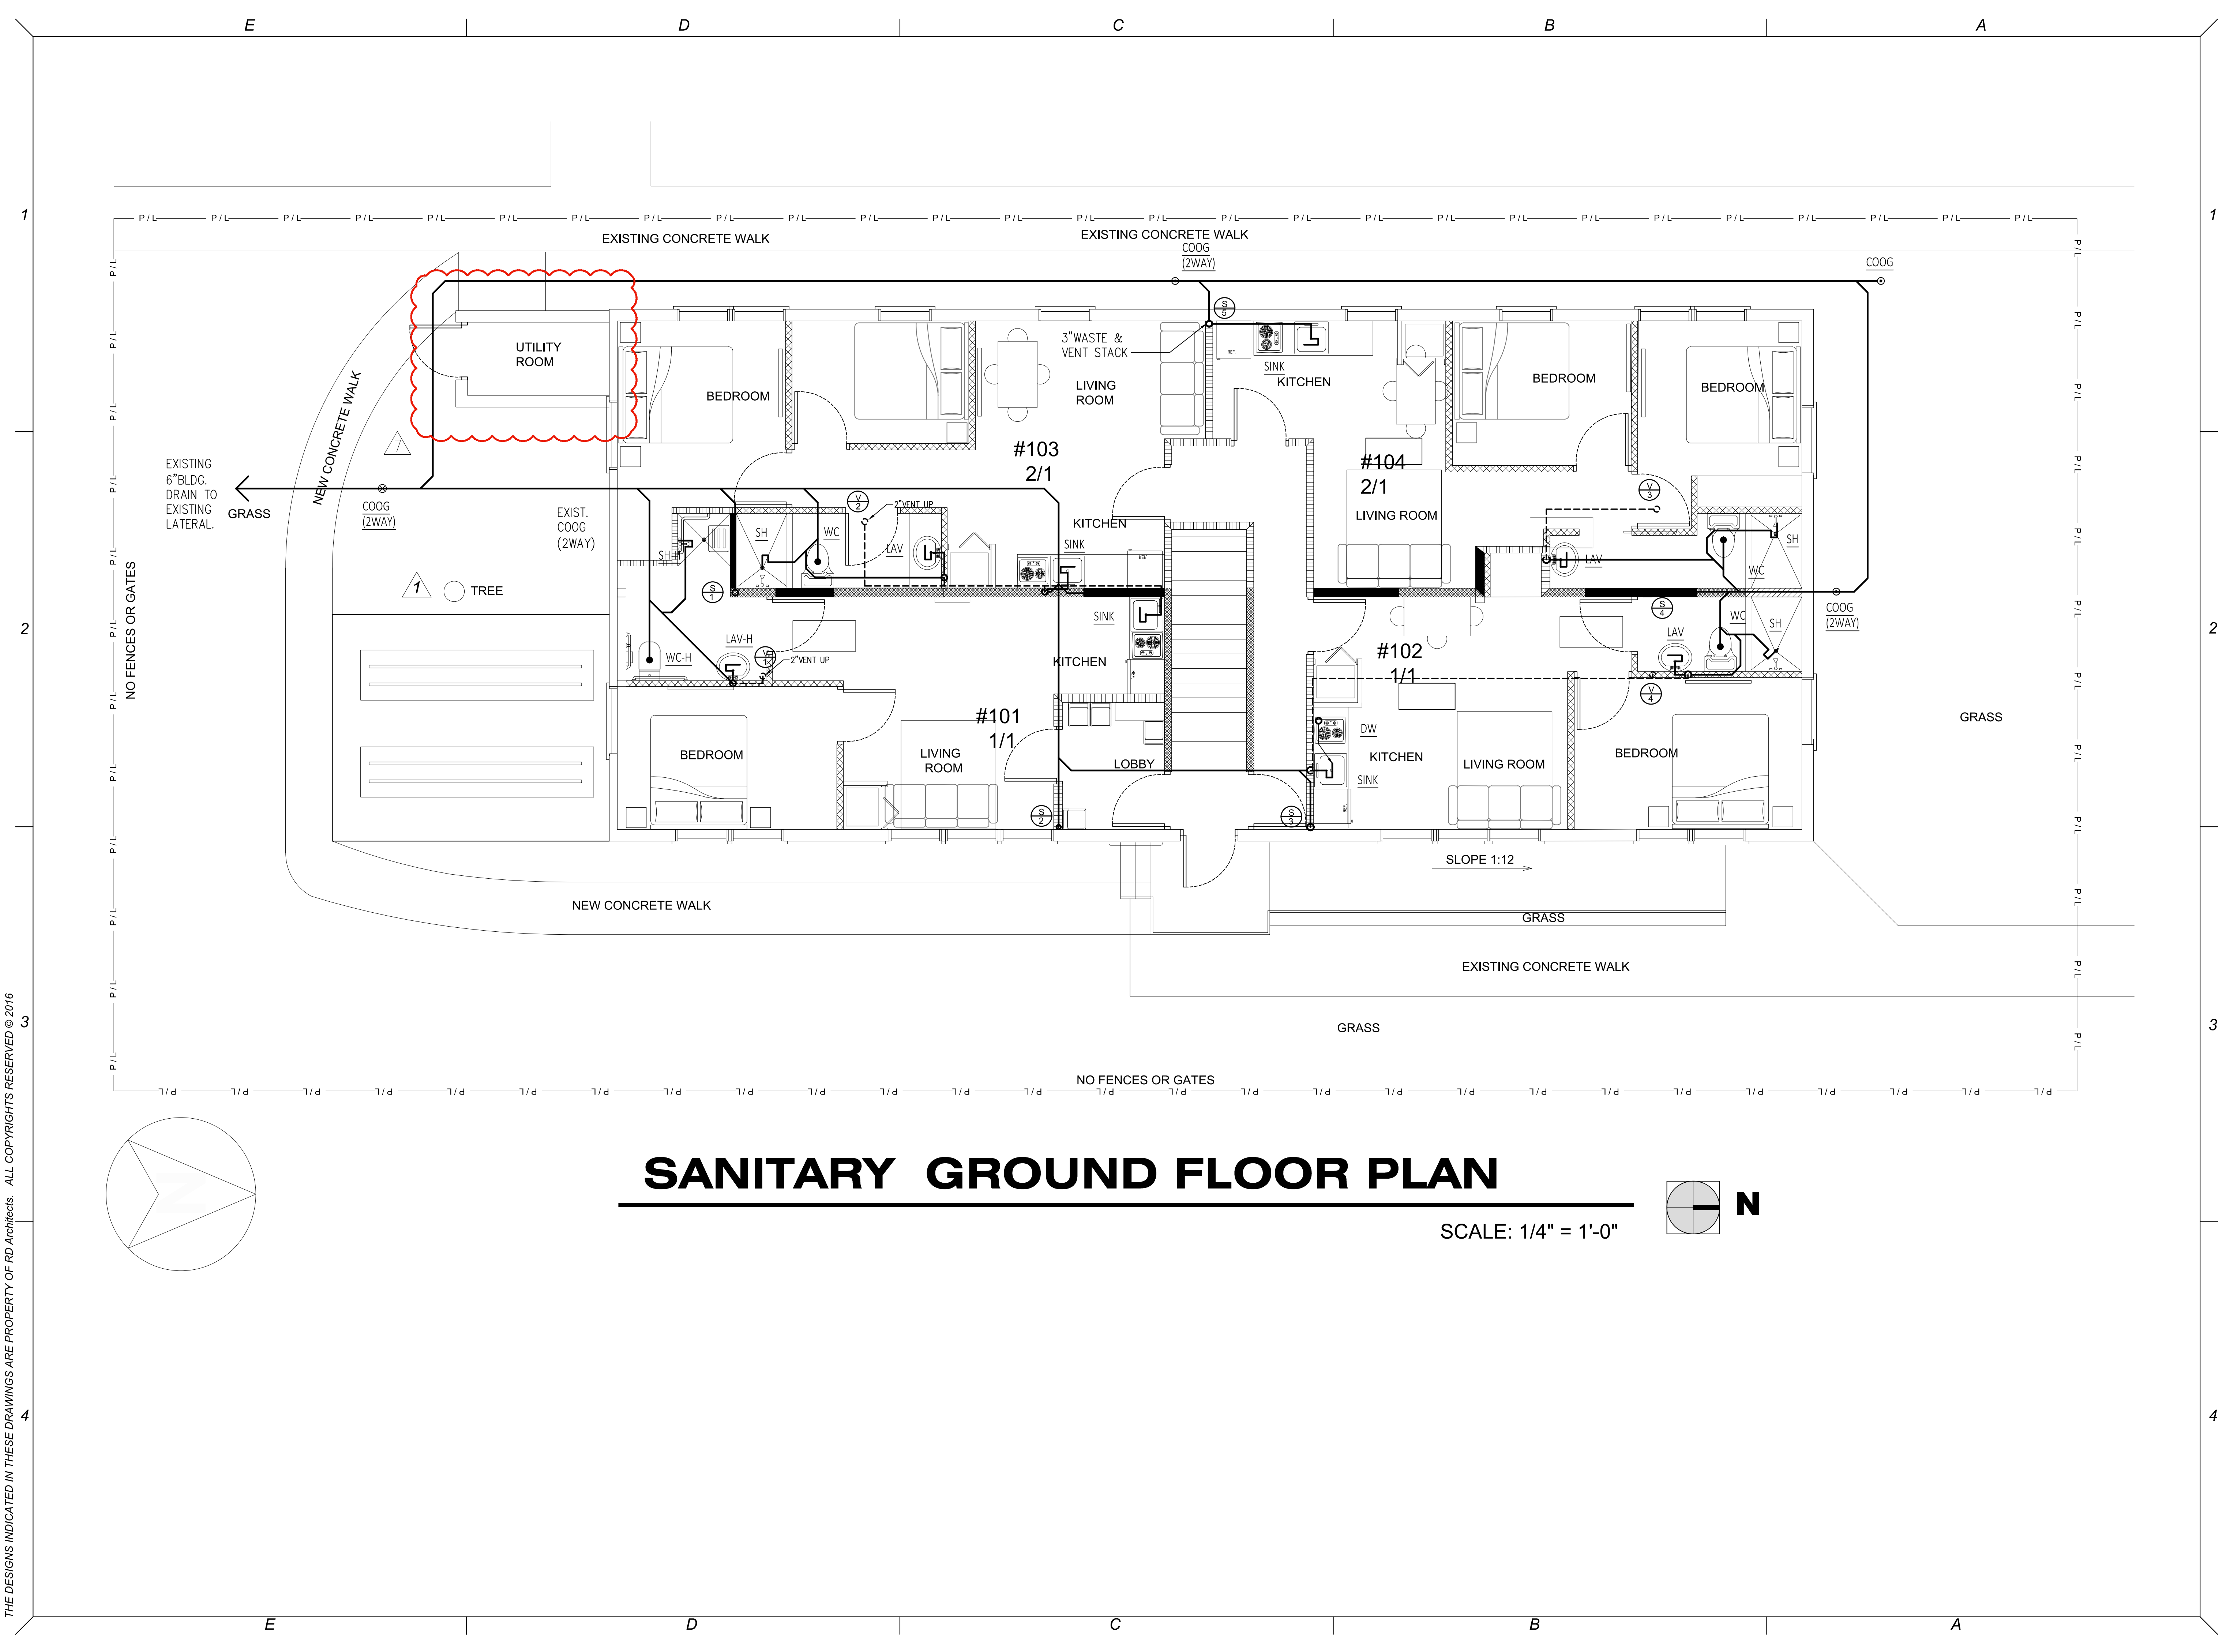

SANITARY GROUND FLOOR PLAN

SCALE: 1/4" = 1'-0"

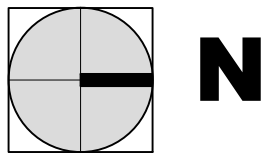


PROJECT: **1330 Building**
1330 15th Street, Miami Beach, FL 33139

PROJECT OWNER :
NOTUS, LLC
435 21st Street, Miami Beach, FL 33139

ARCHITECT OF RECORD:
RD Architects
1800 SW 1st Avenue, Suite 607, Miami, Florida 33129
P: 786.762.2679 F: 305.831.8079 C: 305.282.0005
Email: rda@rda-archint.com / AA26002510
www.rda@rda-archint.com / AA26002510

CONSULTANT ENGINEER:

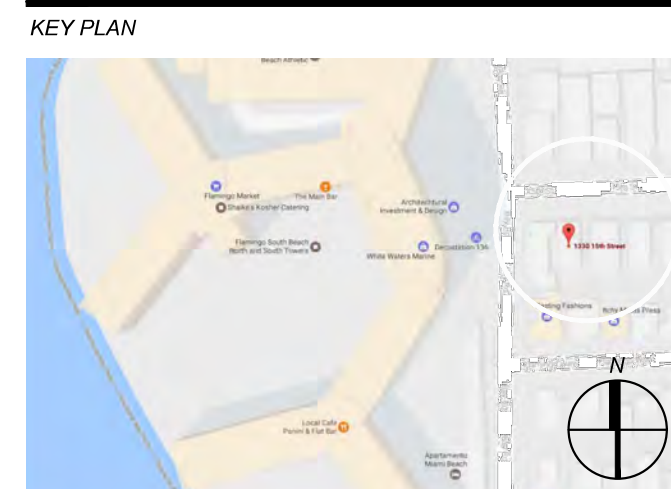

SIGNATURE / DATE / SEAL

NOT VALID IF MISSING SIGNATURE

VICTOR H. RODRIGUEZ
REGISTERED ARCHITECT
ARS4965

Victor H. Rodriguez,
Registered Architect
State of Florida # AR0094965
305 . 282 . 0005 vh.rodriguez@rda-archint.com

PERMIT SET	
Issue	Issue Date / For
1	12.05.2016 / Owner Revisions
2	
3	05.05.2017 / Reviewer Comments
4	08.07.2017 / Reviewer Comments
5	12.17.2017 / Fire Dept. Comments
6	12.17.2017 / Fire Dept. Comments
7	02.19.2018 / City Comments
8	04.20.2018 / Coordination w/ comments

DDCI Project #: 1628.00
Drawn by: VHR
Approved by: VHR

SHEET INDEX
4 - Sanitary Plan
Ground Floor

SCALE :
SHEET NO.

P-2


THE DESIGNS INDICATED IN THESE DRAWINGS ARE PROPERTY OF RD Architects. ALL COPYRIGHTS RESERVED © 2016

1

2


3

4

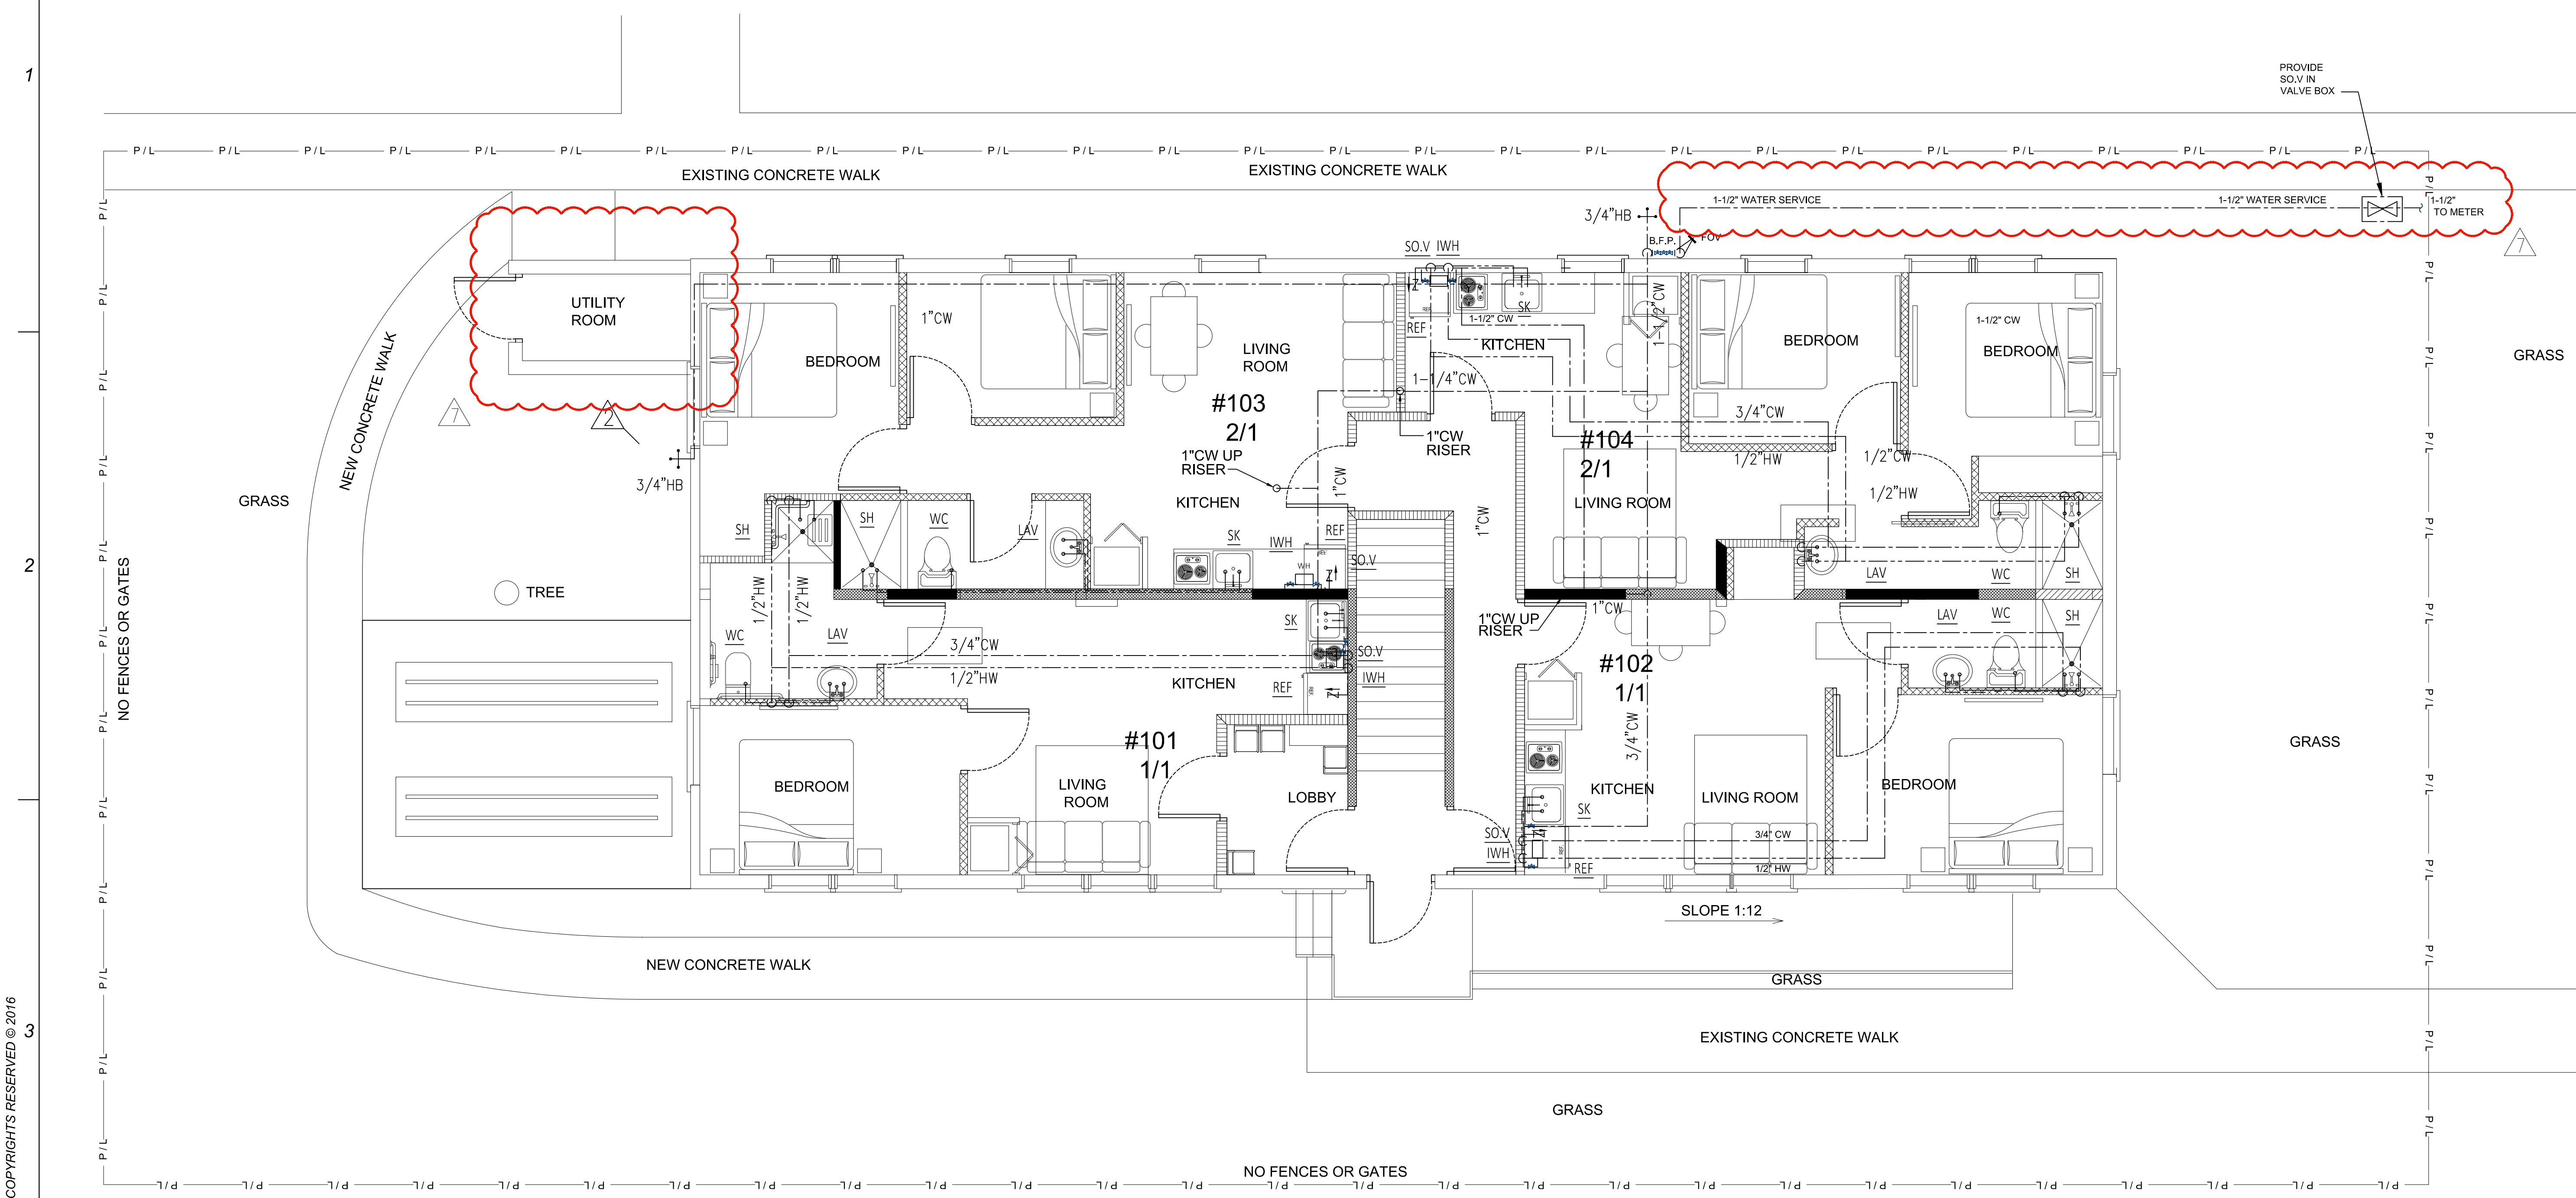

WATER GROUND FLOOR PLAN

SCALE: 1/4" = 1'-0"

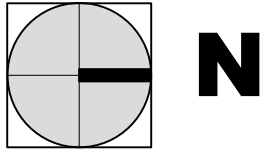

PROJECT:

1330 Building

1330 15th Street, Miami Beach, FL 33139

PROJECT OWNER :

NOTUS, LLC
435 21st Street, Miami Beach, FL 33139

ARCHITECT OF RECORD:



RD Architects

1800 SW 1st Avenue, Suite 607, Miami, Florida 33129
P: 786.762.2679 F: 305.831.8079 C: 305.282.0005
Email: rda@rda-archint.com
www.rda@rda-archint.com / AA26002510


CONSULTANT ENGINEER:

KEY PLAN



SIGNATURE / DATE / SEAL

NOT VALID IF
MISSING
SIGNATURE

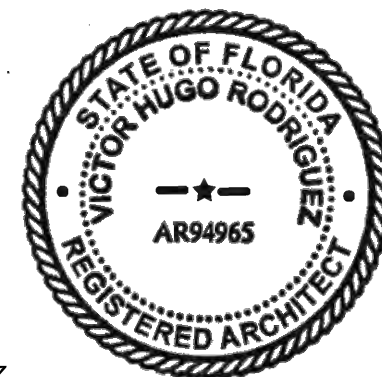

Victor H. Rodriguez,
Registered Architect
State of Florida # AR0094965
305.282.0005 vh.rodriguez@rda-archint.com

PERMIT SET

Issue	Issue Date / For
1	12.05.2016 / Owner Revisions
2	05.05.2017 / Reviewer Comments
3	08.07.2017 / Reviewer Comments
4	12.17.2017 / Fire Dept. Comments
5	12.17.2017 / Fire Dept. Comments
6	02.19.2018 / City Comments
7	04.20.2018 / Coordination w/ comments

DDCI Project #: 1628.00

Drawn by: VHR

Approved by: VHR

SHEET INDEX


4 - Water Ground Plan

SCALE :

SHEET NO.


P-3

THE DESIGNS INDICATED IN THESE DRAWINGS ARE PROPERTY OF RD Architects. ALL COPYRIGHTS RESERVED © 2016

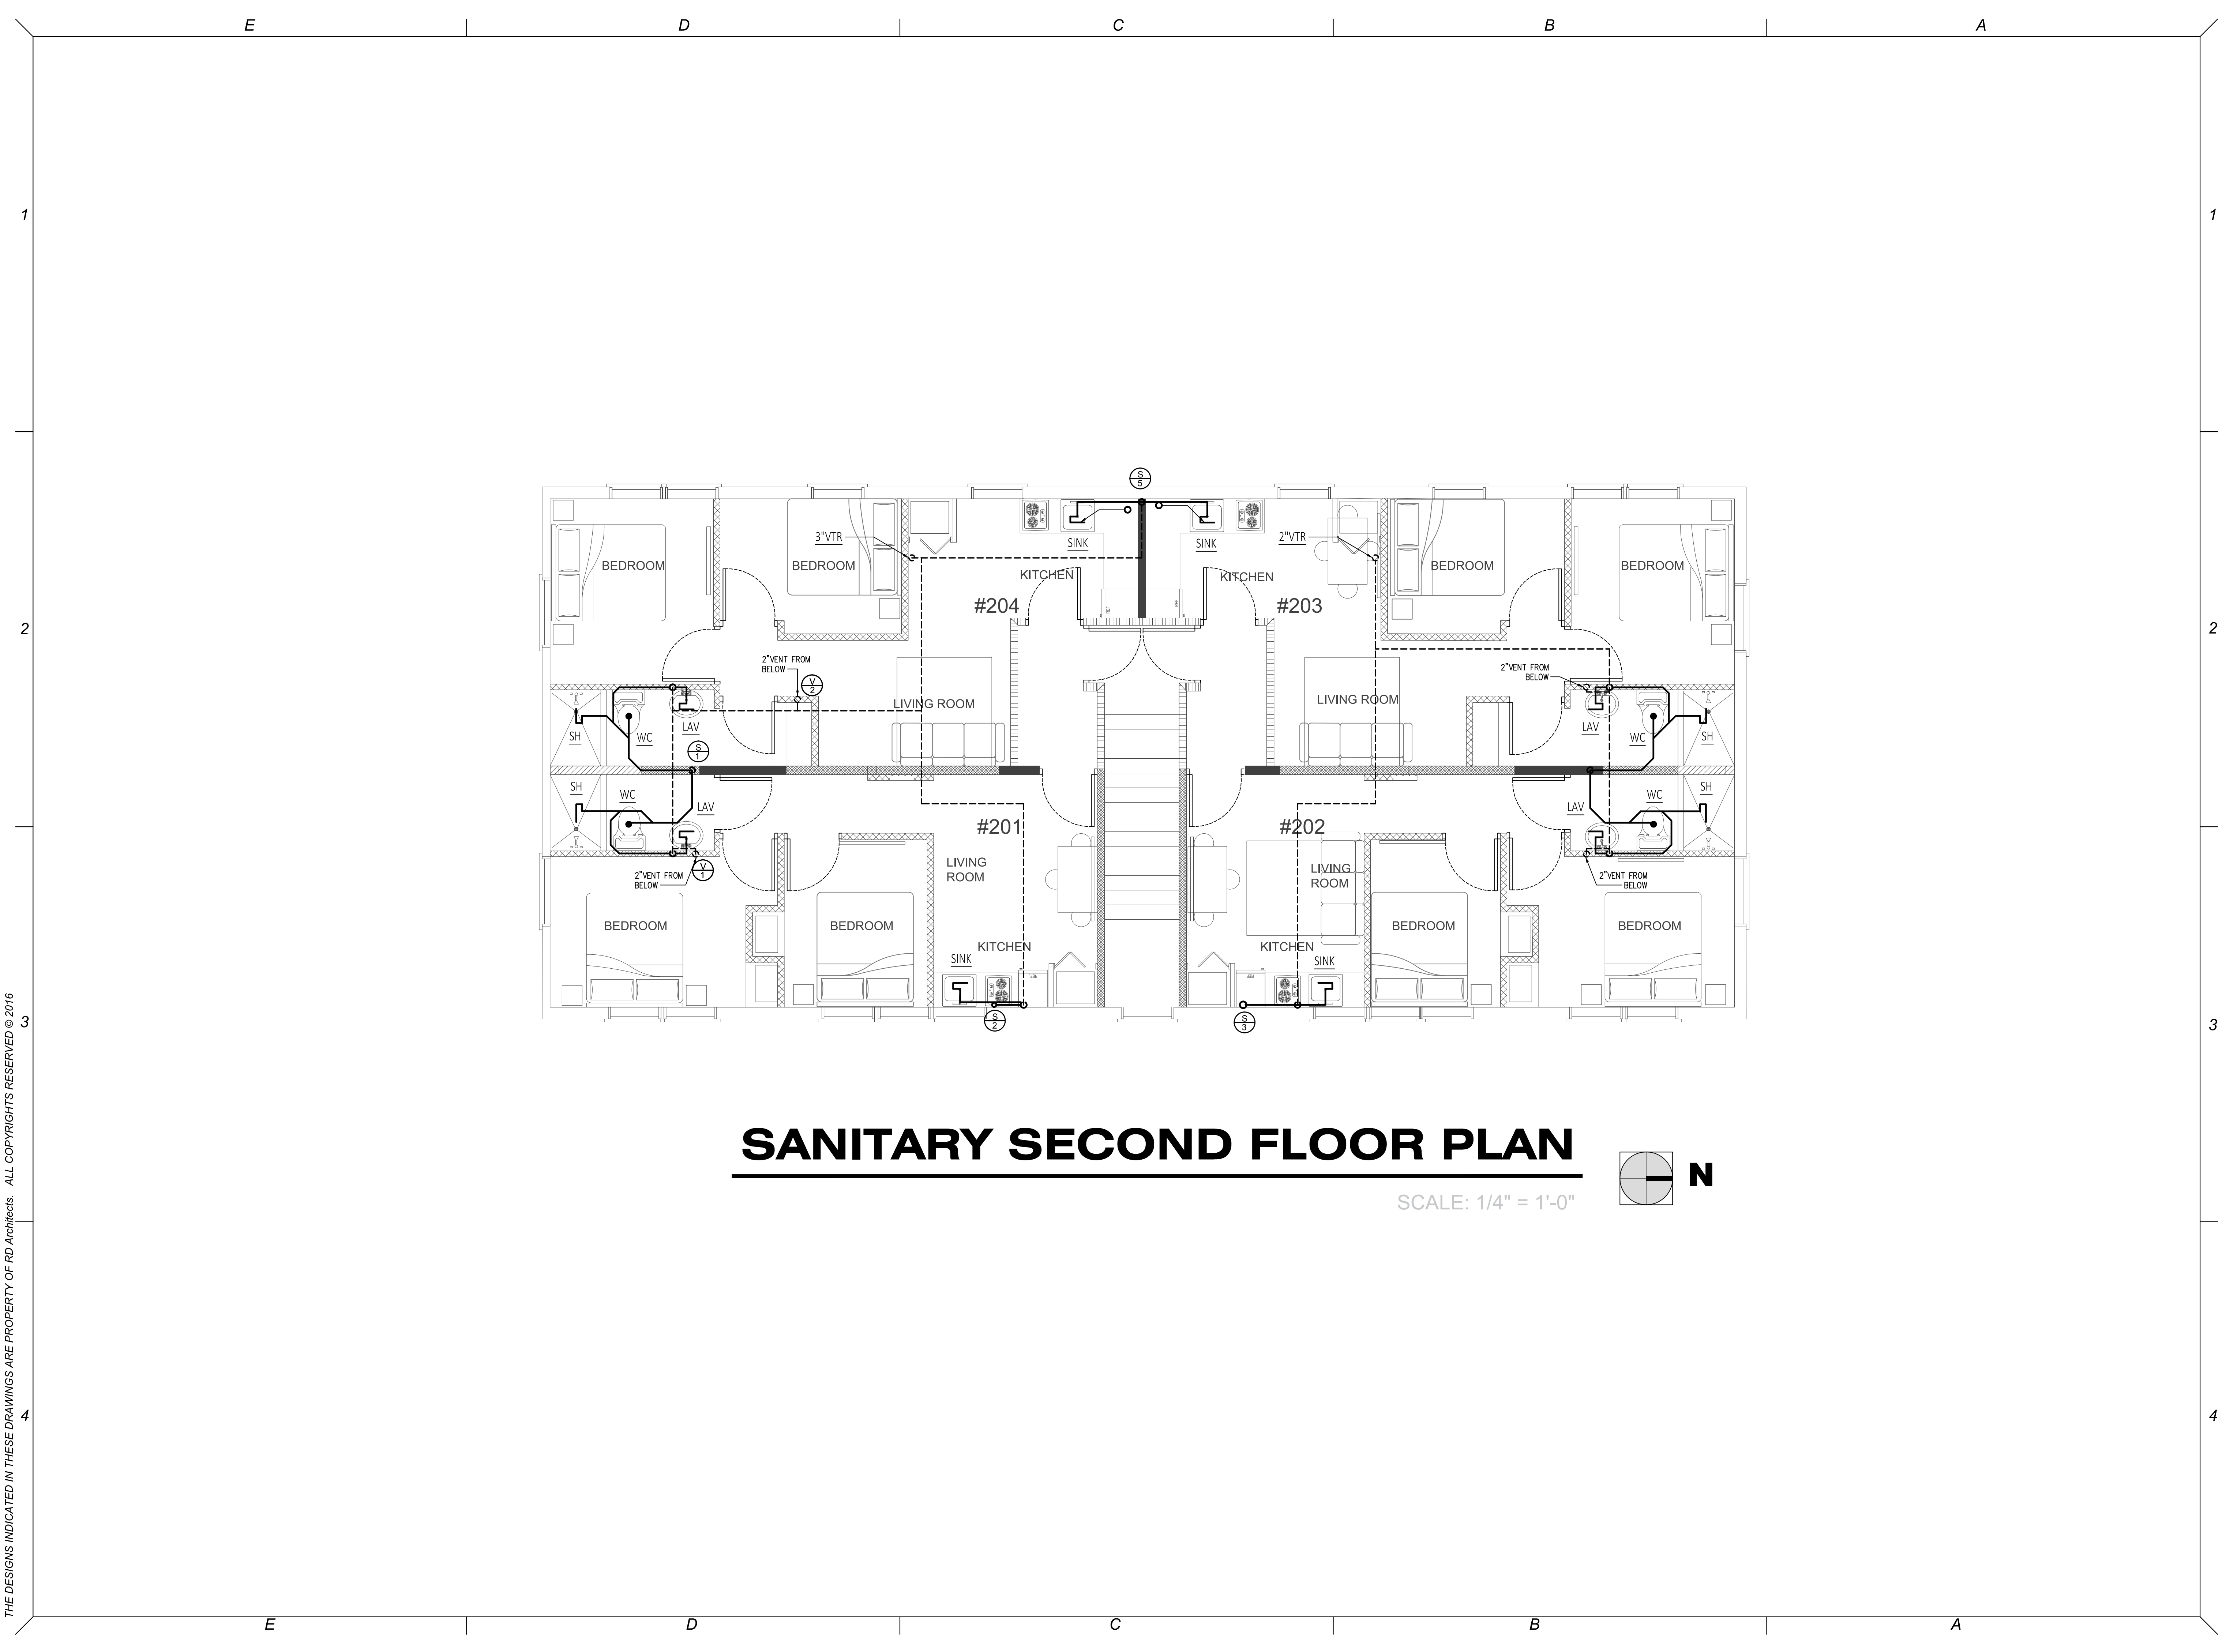

SANITARY SECOND FLOOR PLAN

SCALE: 1/4" = 1'-0"

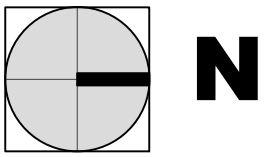

PROJECT:

1330 Building

1330 15th Street, Miami Beach, FL 33139

PROJECT OWNER :

NOTUS, LLC
435 21st Street, Miami Beach, FL 33139

ARCHITECT OF RECORD:



RD Architects

1800 SW 1st Avenue, Suite 607
Miami, FL 33129
Phone: 786 . 762 . 2679
email: rda@rda-archint.com
www.rda-archint.com
AA26002510

INTERIOR DESIGNER:

KEY PLAN



SIGNATURE / DATE / SEAL

Victor H. Rodriguez,
Registered Architect
State of Florida # AR0094965
305 . 282 . 0005 vh.rodriguez@rda-archint.com

PERMIT SET

Issue	Issue Date / For
1	12.05.2016 / Owner Revisions

DDCI Project #: 1628.00

Drawn by: VHR

Approved by: VHR

SHEET INDEX


- Sanitary Level 2

SCALE :

SHEET NO.

P-4

THE DESIGNS INDICATED IN THESE DRAWINGS ARE PROPERTY OF RD Architects. ALL COPYRIGHTS RESERVED © 2016

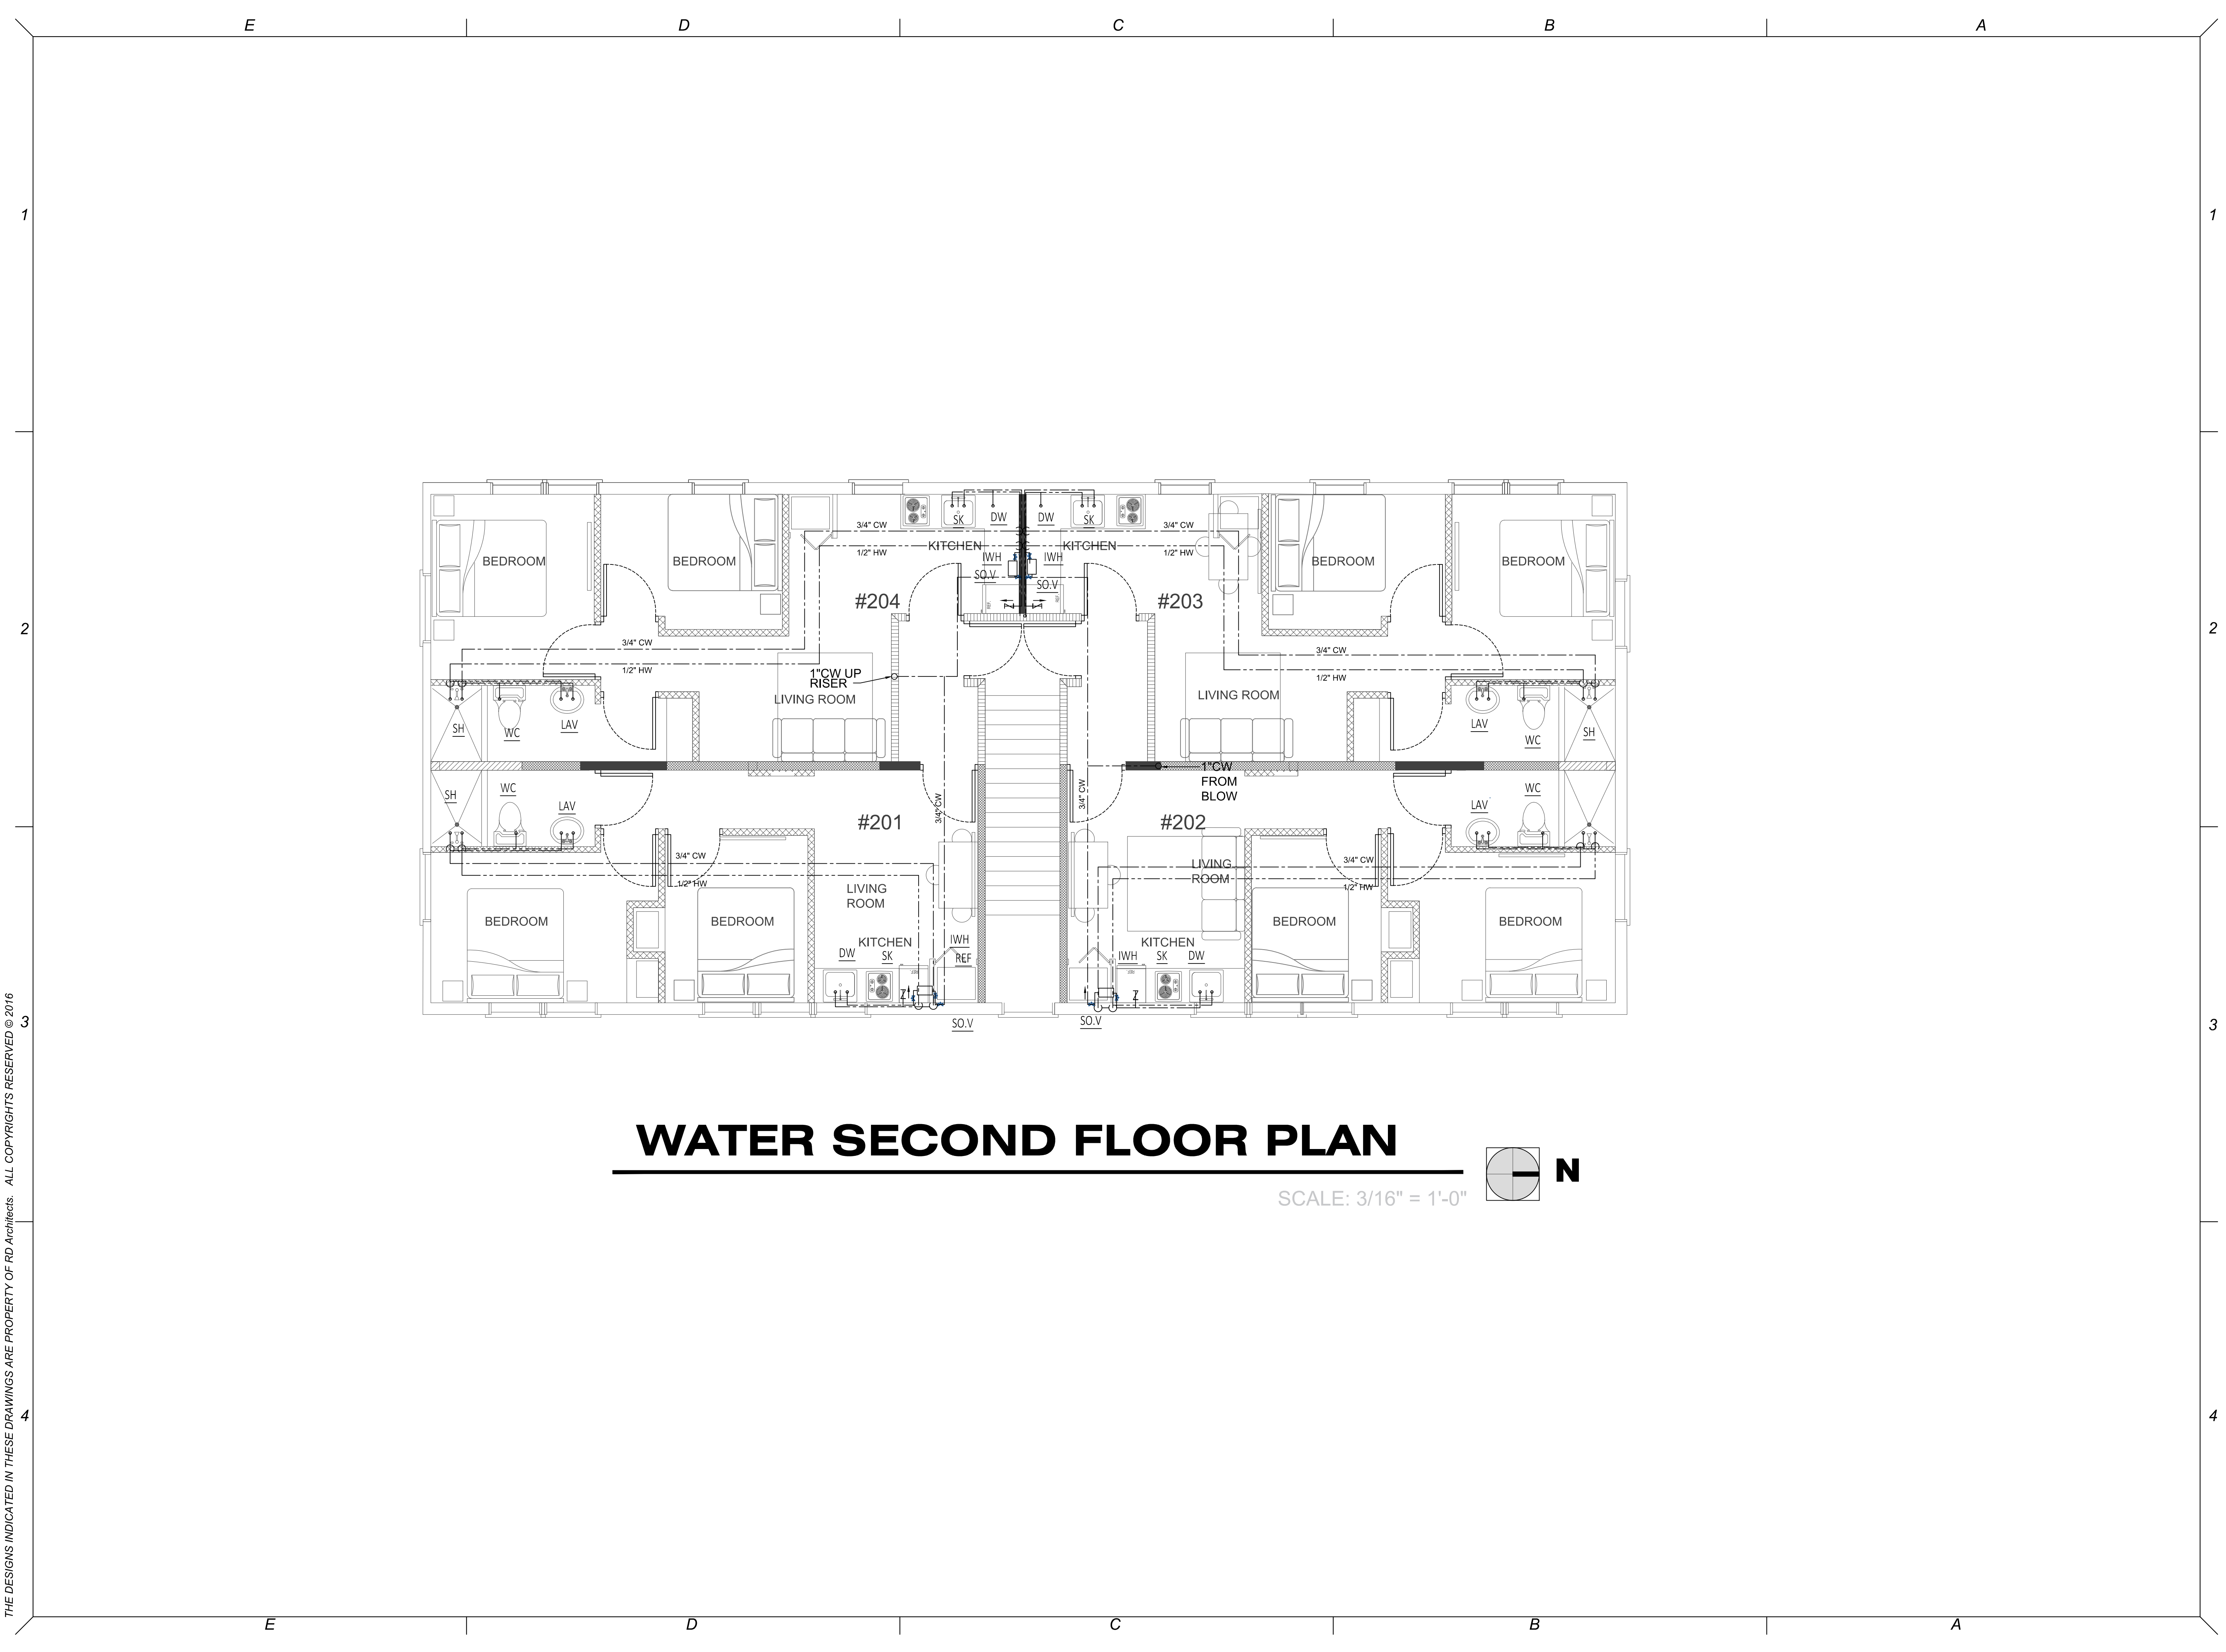

PROJECT:

**1330
Building**

1330 15th Street, Miami Beach, FL 33139

PROJECT OWNER :

NOTUS, LLC
435 21st Street, Miami Beach, FL 33139

ARCHITECT OF RECORD:



RD Architects

1800 SW 1st Avenue, Suite 607
Miami, FL 33129
Phone: 786 . 762 . 2679
email: rda@rda-archint.com
www.rda-archint.com
AA26002510

INTERIOR DESIGNER:

KEY PLAN



SIGNATURE / DATE / SEAL

Victor H. Rodriguez,
Registered Architect
State of Florida # AR0094965
305 . 282 . 0005 vh.rodriguez@rda-archint.com

PERMIT SET

Issue	Issue Date / For
1	12.05.2016 / Owner Revisions

DDCI Project #: 1628.00

Drawn by: VHR

Approved by: VHR


SHEET INDEX

- Water Plan Level 2

SCALE :

SHEET NO.

P-5

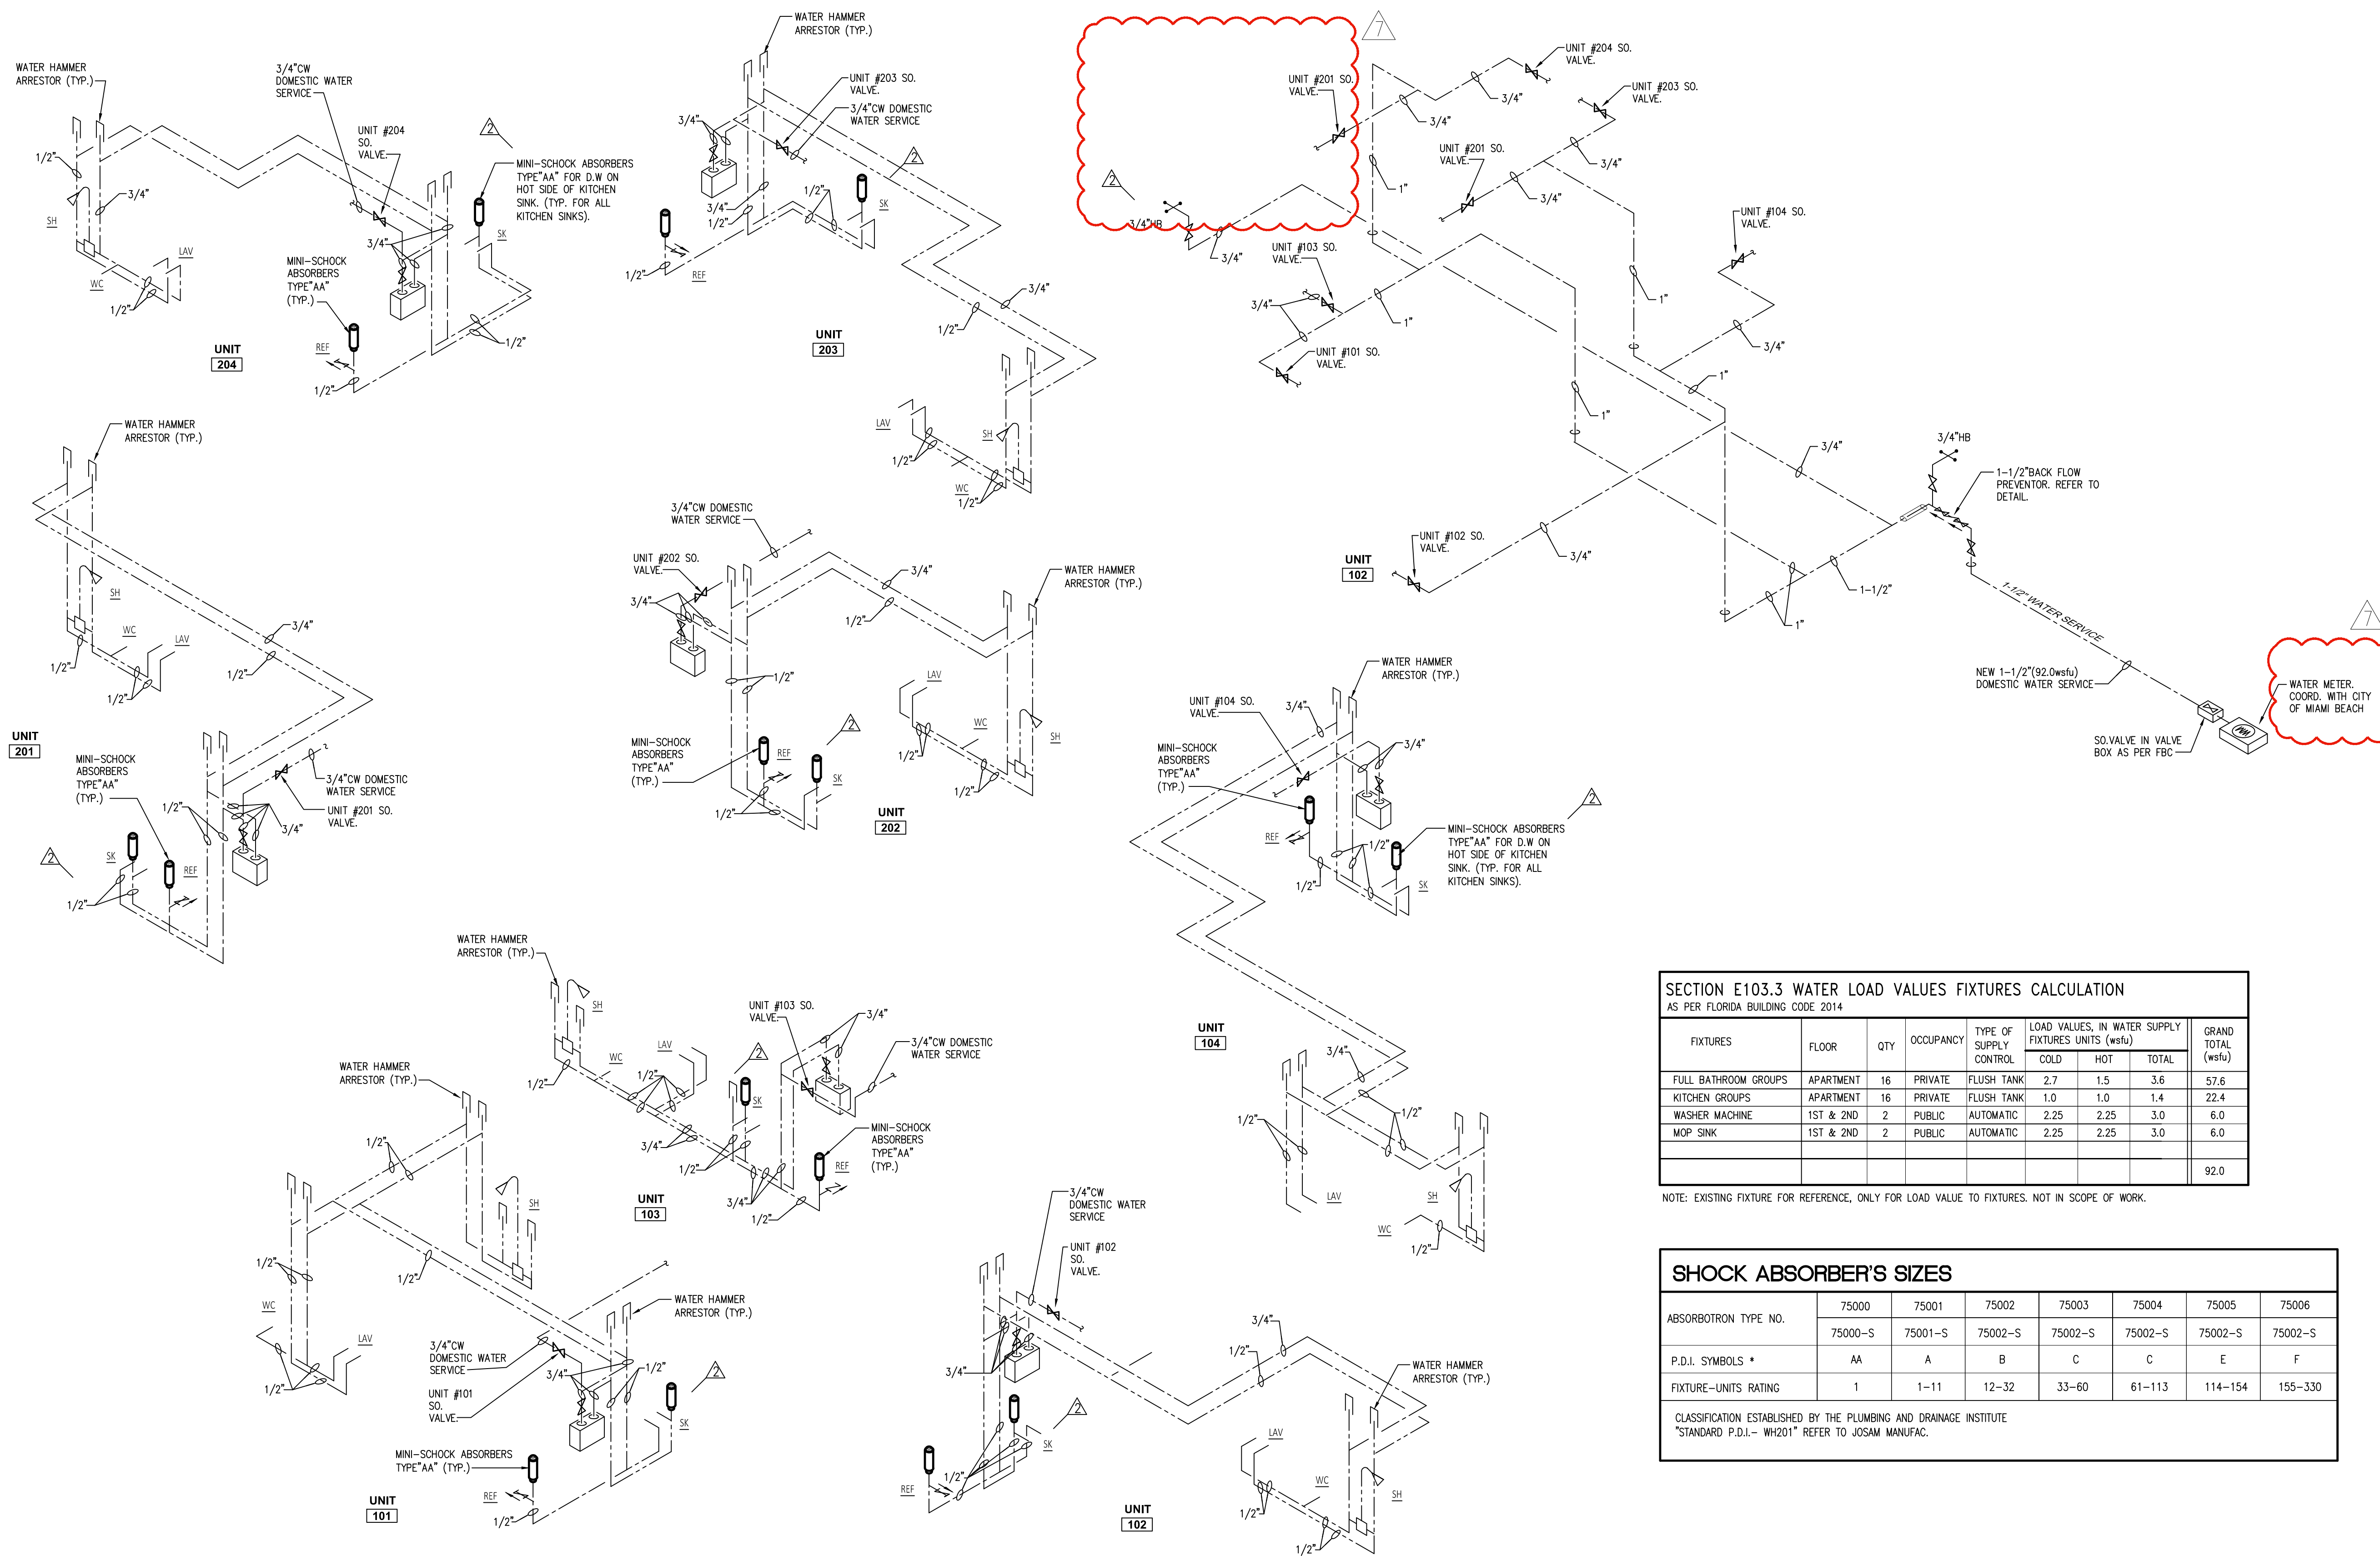

WATER PIPING ISOMETRIC – NTS

[illegible]

NOTE: EXISTING FIXTURE FOR REFERENCE, ONLY FOR LOAD VALUE TO FIXTURES. NOT IN SCOPE OF WORK

SHOCK ABSORBER'S SIZES							
ABSORBOTRON TYPE NO.	75000	75001	75002	75003	75004	75005	75006
	75000-S	75001-S	75002-S	75002-S	75002-S	75002-S	75002-S
P.D.I. SYMBOLS *	AA	A	B	C	C	E	F
FIXTURE-UNITS RATING	1	1-11	12-32	33-60	61-113	114-154	155-330


CLASSIFICATION ESTABLISHED BY THE PLUMBING AND DRAINAGE INSTITUTE
 STANDARD P.D.I.- WH201 REFER TO JOSAM MANUFAC.

GENERAL PLUMBING NOTES:

- ALL WORK SHALL BE DONE in accordance with the Florida Building Code 2014 and with all applicable regulations.
- DRAWINGS: Refer to all drawings for coordination of the plumbing work.
- ARRANGE AND PAY for all permits, licenses, inspections and tests. Obtain the required certificates and present to owner.
- GUARANTEE: The completed installation shall be fully guaranteed against defective materials and/or improper workmanship for a minimum of one year for material and labor.
- ALL HORIZONTAL SANITARY PIPING 3" and larger shall slope at 1/8 inch per foot minimum, unless noted otherwise, per foot minimum, unless noted otherwise. All piping 2" and smaller shall slope at 1/4" inch per foot minimum.
- SHOP DRAWINGS: Contractor shall submit for approval, within 30 days of signing contract, a minimum of five copies of fully descriptive literature, including but not limited to: water heaters, and plumbing fixtures. No work shall proceed without the approval of these submittals.
- PLUMBING FIXTURES: Fixtures shall be as specified and shall be furnished by the owner and installed by this contractor. Fixtures shall be complete with drains, traps, supplies and any other accessory provided w/ the unit.
- MATERIALS:
 - PIPING:
 - Soil, waste and vent, and storm: Sanitary pipe, PVC, DWV, Schedule 40.
 - Domestic water: Copper pipe, Type L with sweat wrought copper fittings. Type "M" in concealed spaces is acceptable. Isolate piping from concrete with insulating material.
 - Condensate drain: DWV Copper pipe and fittings.
 - P & T Relief and Drain Pan lines: DWV Copper pipe and ftgs.
 - Domestic water supply assembly: Chrome finish tubing with angle shut off valves.
 - Domestic water supply assembly: Chrome finish tubing
 - Domestic water supply assembly: Chrome finish tubing
 - Insulation:
 - Hot water & hot water return: Provide 1" thick fiberglass pipe insulation with jacket and self sealing flaps.
 - Circulating hot water piping shall be insulated to at least R-2 as per FBC 403.4.1, 2014
 - Minimum pipe insulation Circulation hot water system shall be insulated in accordance with the requirements of table 607.2.1 FBCP
 - INSULATE CONDENSATE DRAIN PIPES with 3/4" thick armaflex. slip insulation over piping without spitting. buttends firmly together, seal all joints with vapor seal adhesive recommended by insulation manufacturer. where piping is outdoor apply two coats of armaflex finish. Insulate hot water piping with 3/4" thick preformed fibrous glass insulation with a factory applied skim krap jacket. insulate fittings w/ fibrous glass preformed insulation with a zeston jacket.
- ALL AUTOMATIC ELECTRIC water heaters shall meet the standards of the latest state energy conservation code.
- PIPING TEST AND DISINFECTIONS:
 - Test: All sanitary and domestic water supply piping shall be tested for leaks before piping is concealed or connected to equipment and plumbing fixtures. test drain, vent and condensate piping to a pressure of 5 psig hydrostatic. test domestic water to 100 psig hydrostatic. test other piping to a pressure of 100 psig hydrostatic. all tests to be a minimum duration of two hours.
 - Disinfection: All domestic water piping shall be disinfected by introducing a solution of calcium hypochlorite of 50 parts per million of chloride and as per AWWA Standards.
- VALVES: Domestic water valves shall be of bronze body, sweat ends.
- HOSE BIBBS: Shall be 1/2 inch. rough brass construction with shut off valve and vacuum breaker.
- ALL OUTDOORS FLOOR clean outs shall be terminated up to grade and shall be marked.
- CONTRACTOR SHALL COORDINATE exact location of sanitary, and domestic water piping before starting any work. Notify Architect/Engineer of any deviations from design drawings. (coordinate infield w/ owner)
- WASTE PIPING: Install all pipe 3" and larger at 1/8"/ft slope. Install pipe smaller than 3" at 1/4"/ft slope.
- CONTRACTOR to fire protect and seal all openings and pipe penetrations thru fire rated walls and ceiling. Materials and methods of fire rating shall be approved by the local product control aproval department and shall be U.L. listed.
- PROVIDE CEILING/WALL ACCESS DOORS where indicated on drawings and when required to access mechanical equipment. Doors shall be recessed type
- PLUMBING CONTRACTOR SHALL review structural drawings prior to bidding to fully familiarize himself with project. Refer to all construction documents for coordination of the plumbing work with other disciplines and to define complete scope of work.
- SAW OR CUT CORE DRILL slab as required to install new plumbing work. Patch slab to match existing and seal all penetrations to maintain fire rating of floor.
- LAY ALL UNDERGROUNG PIPING on a firm bed for its entire length. support above grade horizontal pipe from building structure by means of clevis or split ring hangers. support vertical piping by the use of riser clamps. provide copper clad supports for copper piping. support pvc piping above ground at no more than 5'-0" on centers. locate supports near each joint and at each change of direction. support copper or steel pipe at no more than 8'-0" on centers, and no more than 1'-0" away from a change in direction. support vertical copper piping at each floor slab no more than 6" above or below connection to a fixture and at ceiling height. install steel pipe sleeves whenever piping passes through floors or walls. sleeves should be large enough to provide a 1/2" annular space between the pipe and the sleeve. provide an intumescent fire sealant to fill the annular space between the pipe and the sleeve.
- BEFORE STARTING WORK, examine all drawings, verify dimensions and routing of ducts to avoid interfering with other trades. where interferences occur coordinate with other trades and obtain approval from the general contractor and architect/engineer for the proposed adjustments. report conflicts prior to commencing installation. should interference develop involving work already installed, the architect/engineer will decide which items must be relocated.
- CONTRACTOR SHALL PROTECT AND FIRE SEAL ALL OPENINGS AND PIPE PENETRATIONS thru fire rated walls and ceilings with adequate firestopping materials to maintain the indicated fire ratings of the assemblies being penetrated.
- VERIFY EXACT LOCATION OF AREA DRAINS, ROOF DRAINS AND EMERGENCY OVERFLOW DRAINS, Against architectural drawings. bring any discrepancies to the attention of the engineer prior to commencing any work.

TABLE 607.2.1 MINIMUM PIPE INSULATION						
FLUID DESIGN OPERATING TEMPERATURE RANGE, (°F)	INSULATION CONDUCTIVITY		NOMINAL PIPE DIAMETER OR TUBE SIZE (IN.)			
	CONDUCTIVITY Btu * N	MEAN TEMPERATURE RATING	< 1	1 TO 1-1/2	1-1/2 TO 4	4 TO 8 >
DOMESTIC AND SERVICE HOT WATER SYSTEMS						
> 105	0.22 - 0.285	100	0.5	0.5	1.0	1.0

Minimum pipe insulation Circulation hot water system shall be insulated in accordance with the requirements of table 607.2.1 FBCP

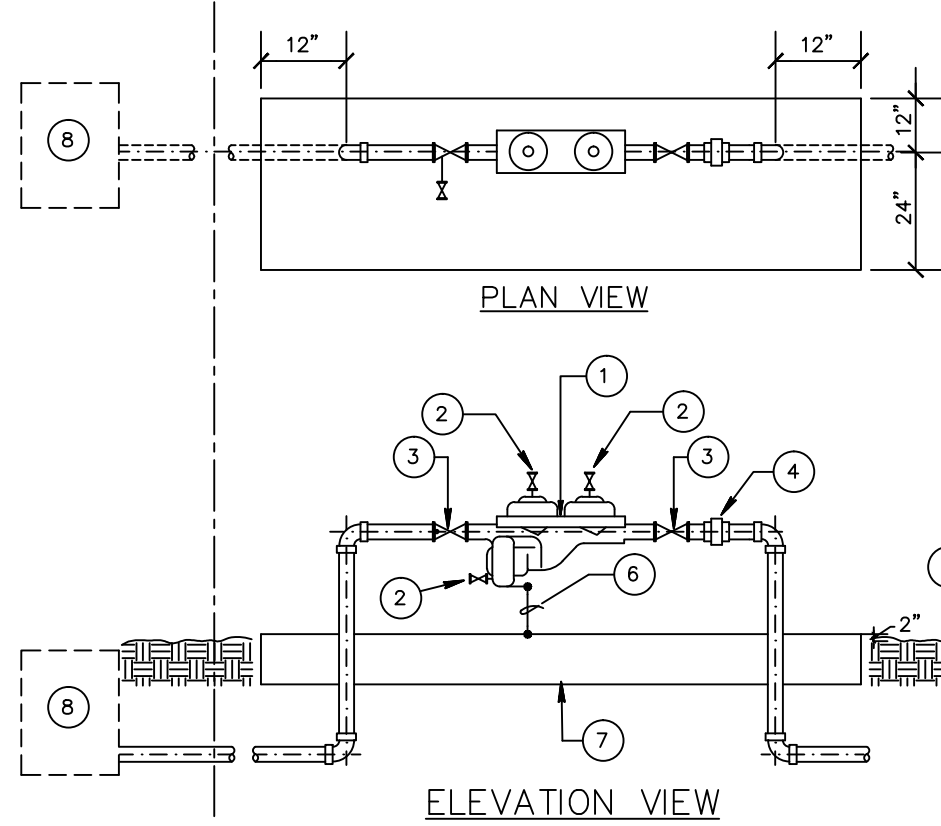

NOTES:


- WATTS SERIES 909 REDUCED PRESSURE BACKFLOW PREVENTION ASSEMBLY
- TEST COCK
- BALL VALVE (TYP)
- UNION
- FINISHED GRADE
- 12" MIN. ABOVE FLOOD LEVEL AND CONC. SLAB
- 6" CONC. SLAB WITH #4 AT 12" E.W.
- METER VAULT

THE ASSEMBLY SHALL BE INSTALLED WITH MINIMUM HORIZONTAL CLEARANCES OF 30 INCHES FREE FROM OBSTRUCTIONS IN SERVICE REQUIRED DIRECTIONS.

- GUARD POSTS SHALL BE INSTALLED IF THE ASSEMBLY IS EXPOSED TO POSSIBLE DAMAGE FROM VEHICULAR TRAFFIC, AS DETERMINED BY AUTHORITY HAVING JURISDICTION.
- PIPING SHALL BE AS INDICATED ON GENERAL DRAWING NOTES/PLUMBING SPECIFICATIONS.
- ALL EXPOSED METALLIC THREADS SHALL BE PAINTED WITH BITUMASTIC PAINT.
- THE AUTHORITY HAVING JURISDICTION SHALL HAVE UNRESTRICTED AND CONTINUOUS ACCESS TO THE BACKFLOW PREVENTION ASSEMBLY.
-


REDUCED PRESSURE BACKFLOW ASSEMBLY

N.T.S. FOR SERVICE SIZES 3/4" THRU 2"

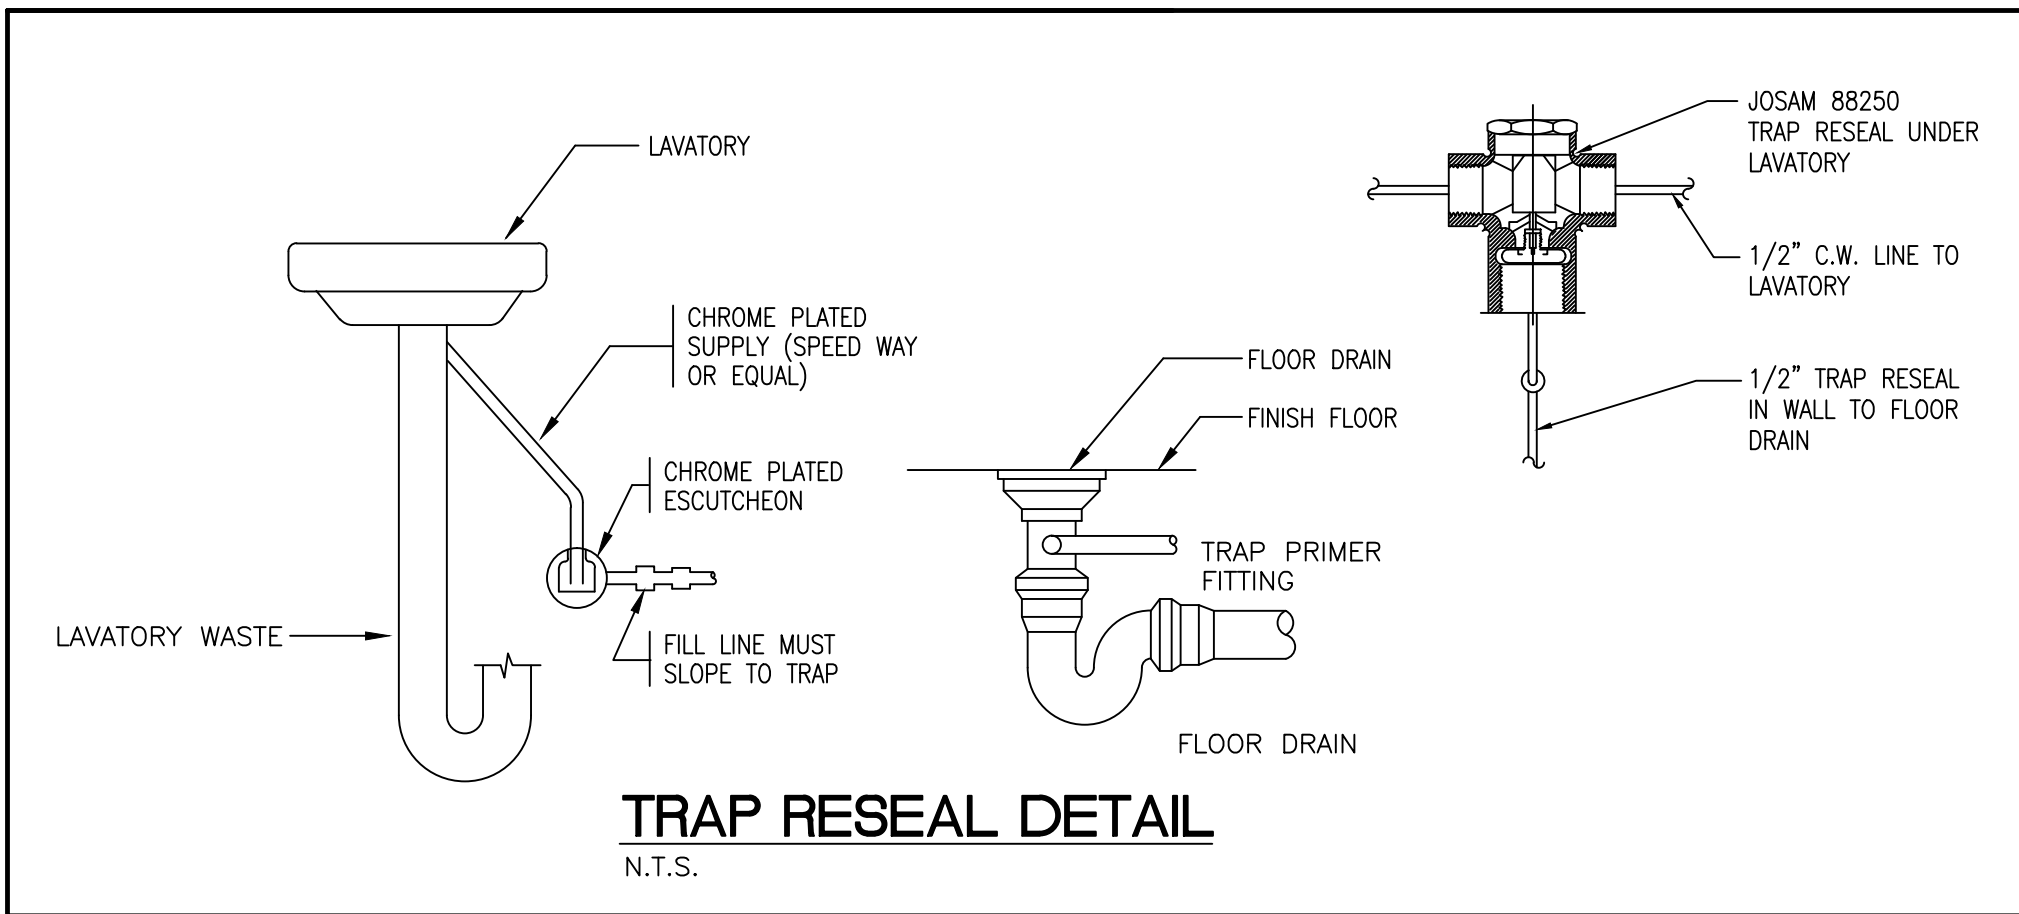


TRAP RESEAL DETAIL

N.T.S.

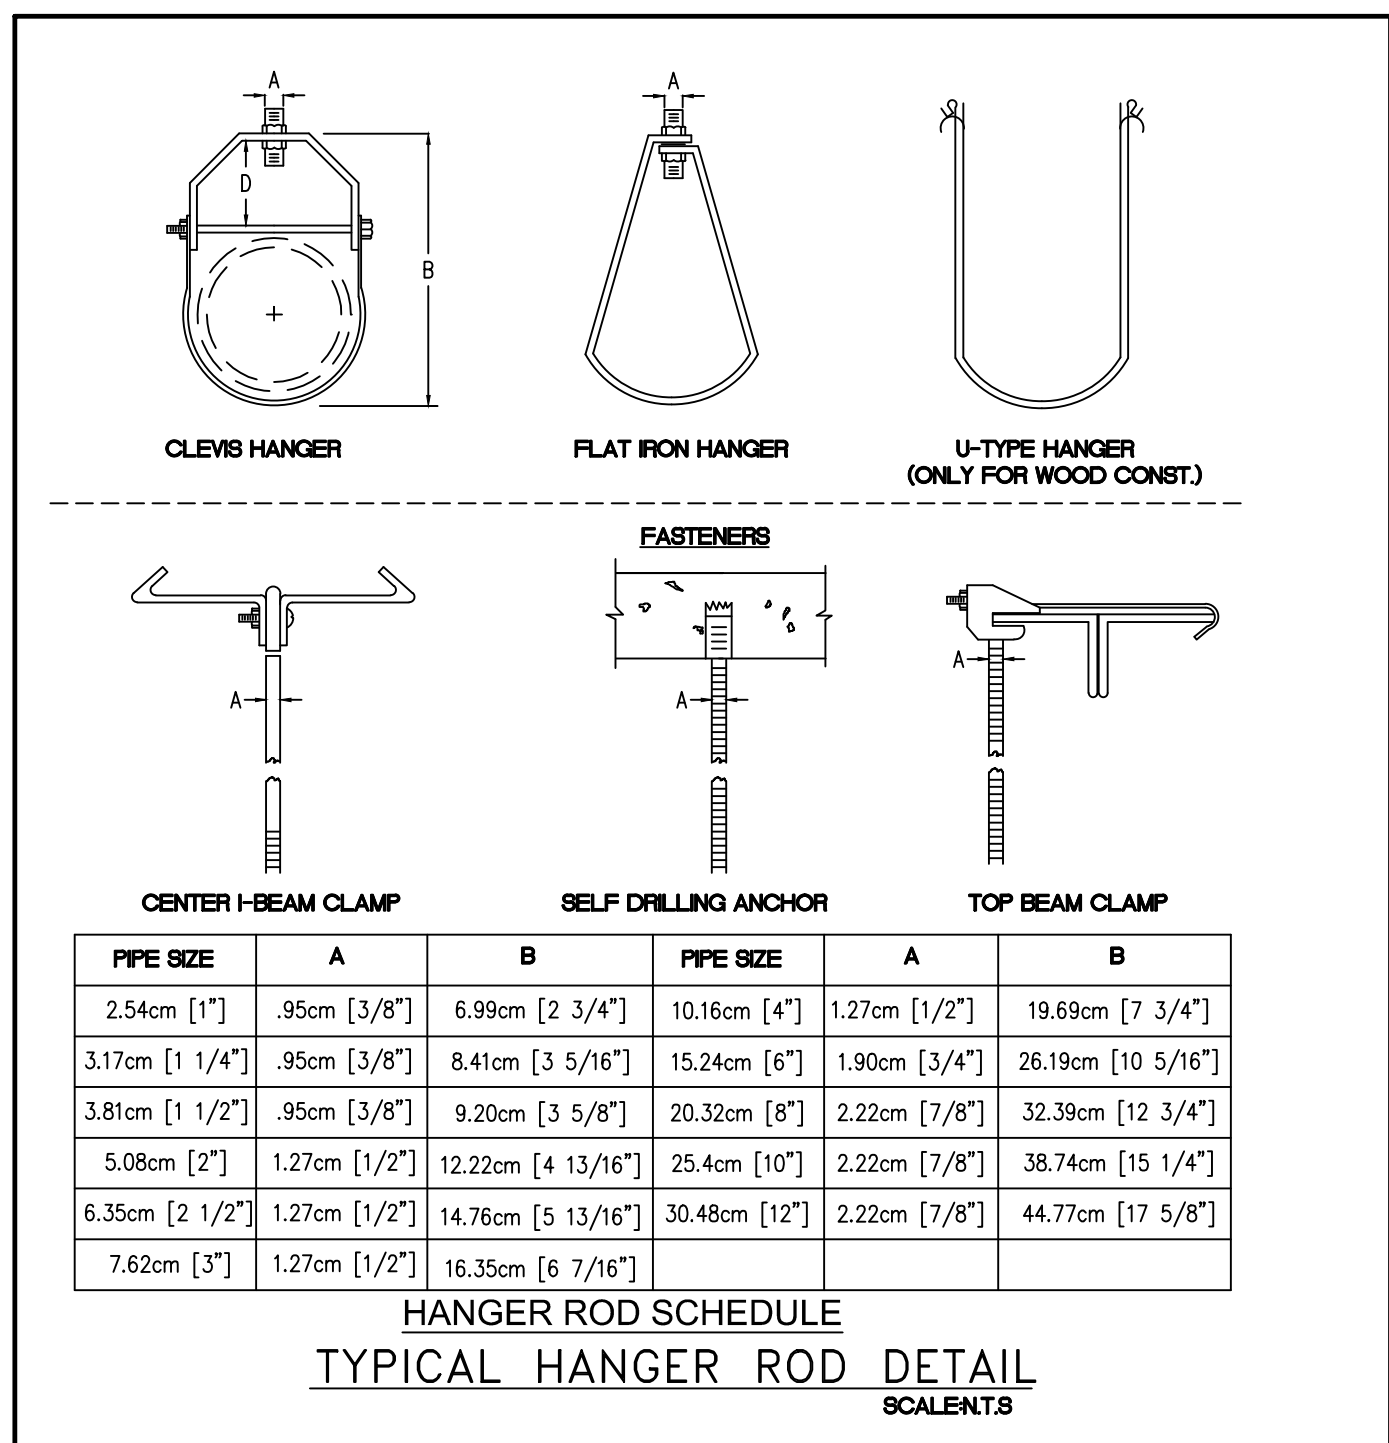

HANGER ROD SCHEDULE
TYPICAL HANGER ROD DETAIL
SCALE: 1/8" = 1'-0"

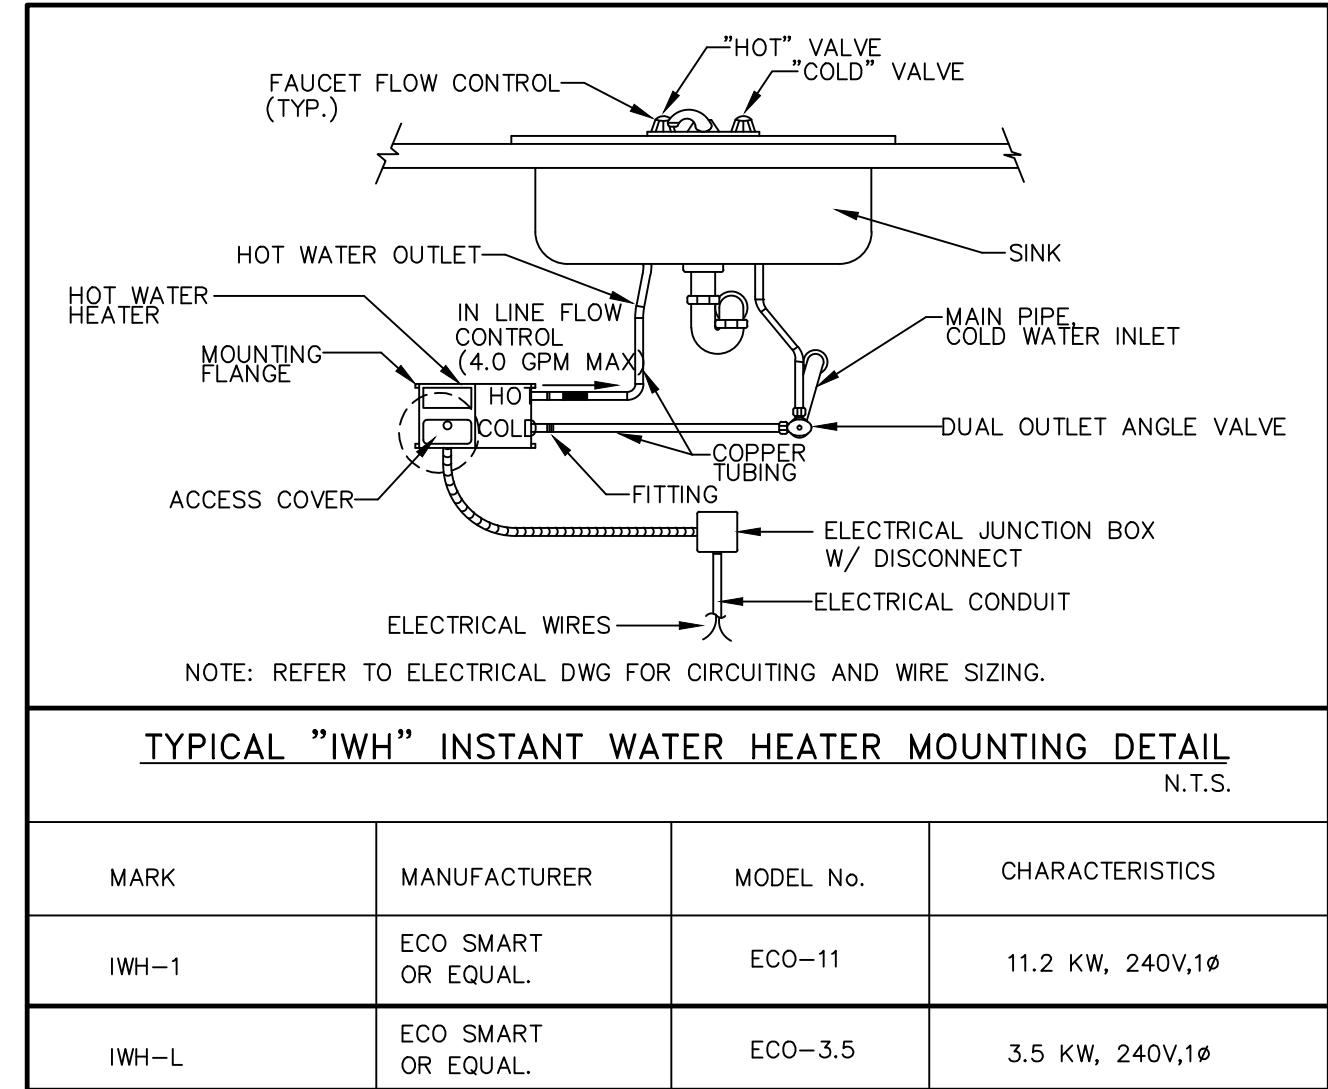

TYPICAL "IWH" INSTANT WATER HEATER MOUNTING DETAIL

N.T.S.

MARK	MANUFACTURER	MODEL No.	CHARACTERISTICS
IWH-1	ECO SMART OR EQUAL.	ECO-11	11.2 KW, 240V, 1ø
IWH-L	ECO SMART OR EQUAL.	ECO-3.5	3.5 KW, 240V, 1ø

PROJECT:


1330 Building

1330 15th Street, Miami Beach, FL 33139

PROJECT OWNER :

NOTUS, LLC
435 21st Street, Miami Beach, FL 33139

ARCHITECT OF RECORD:

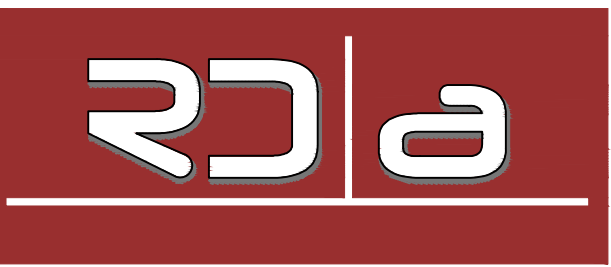

RD Architects

1800 SW 1st Avenue, Suite 607
Miami, FL 33129
Phone: 786 . 762 . 2679
email: rda@rda-archint.com
www.rda-archint.com
AA26002510

INTERIOR DESIGNER:

KEY PLAN



SIGNATURE / DATE / SEAL

Victor H. Rodriguez,
Registered Architect
State of Florida # AR0094965
305 . 282 . 0005 vh.rodriguez@rda-archint.com

PERMIT SET

Issue: Issue Date / For
12.05.2016 / Owner Revisions

DDCI Project #: 1628.00

Drawn by: VHR

Approved by: VHR

SHEET INDEX

- General Notes
- Details

SCALE:

SHEET NO.

P-8

1

2

3

4

E




D

C

B


A

- 1 MAY EXTEND AS A WASTE OR VENT. REFER TO PLANS.
- 2 CHROME WALLCOVER & SCREW.
- 3 WALL
- 4 PLUGGED TEE W/CLEANOUT.
- 5 FLOOR LINE
- 6 1/8" BEND
- 7 BALANCE OF PIPING SAME AS CLEANOUT TO GRADE.
- 8 BALANCE OF PIPING SAME AS CLEANOUT TO GRADE.
- 9 CLEANOUT & ACCESS COVER TO BE FLUSH W/TOP OF FLOOR.
- 10 BRASS CLEANOUT PLUG W/ COUNTER SUNK HEAD.
- 11 FINISH GRADE
- 12 16" SQUARE CONC. PAD TROWEL SMOOTH AND EDGE.
- 13 WASTE LINE. LENGTH TO SUITE.
- 14 WASTE LINE
- 15 1/8 BEND IF CLEANOUT OCCURS AT END OF LINE.

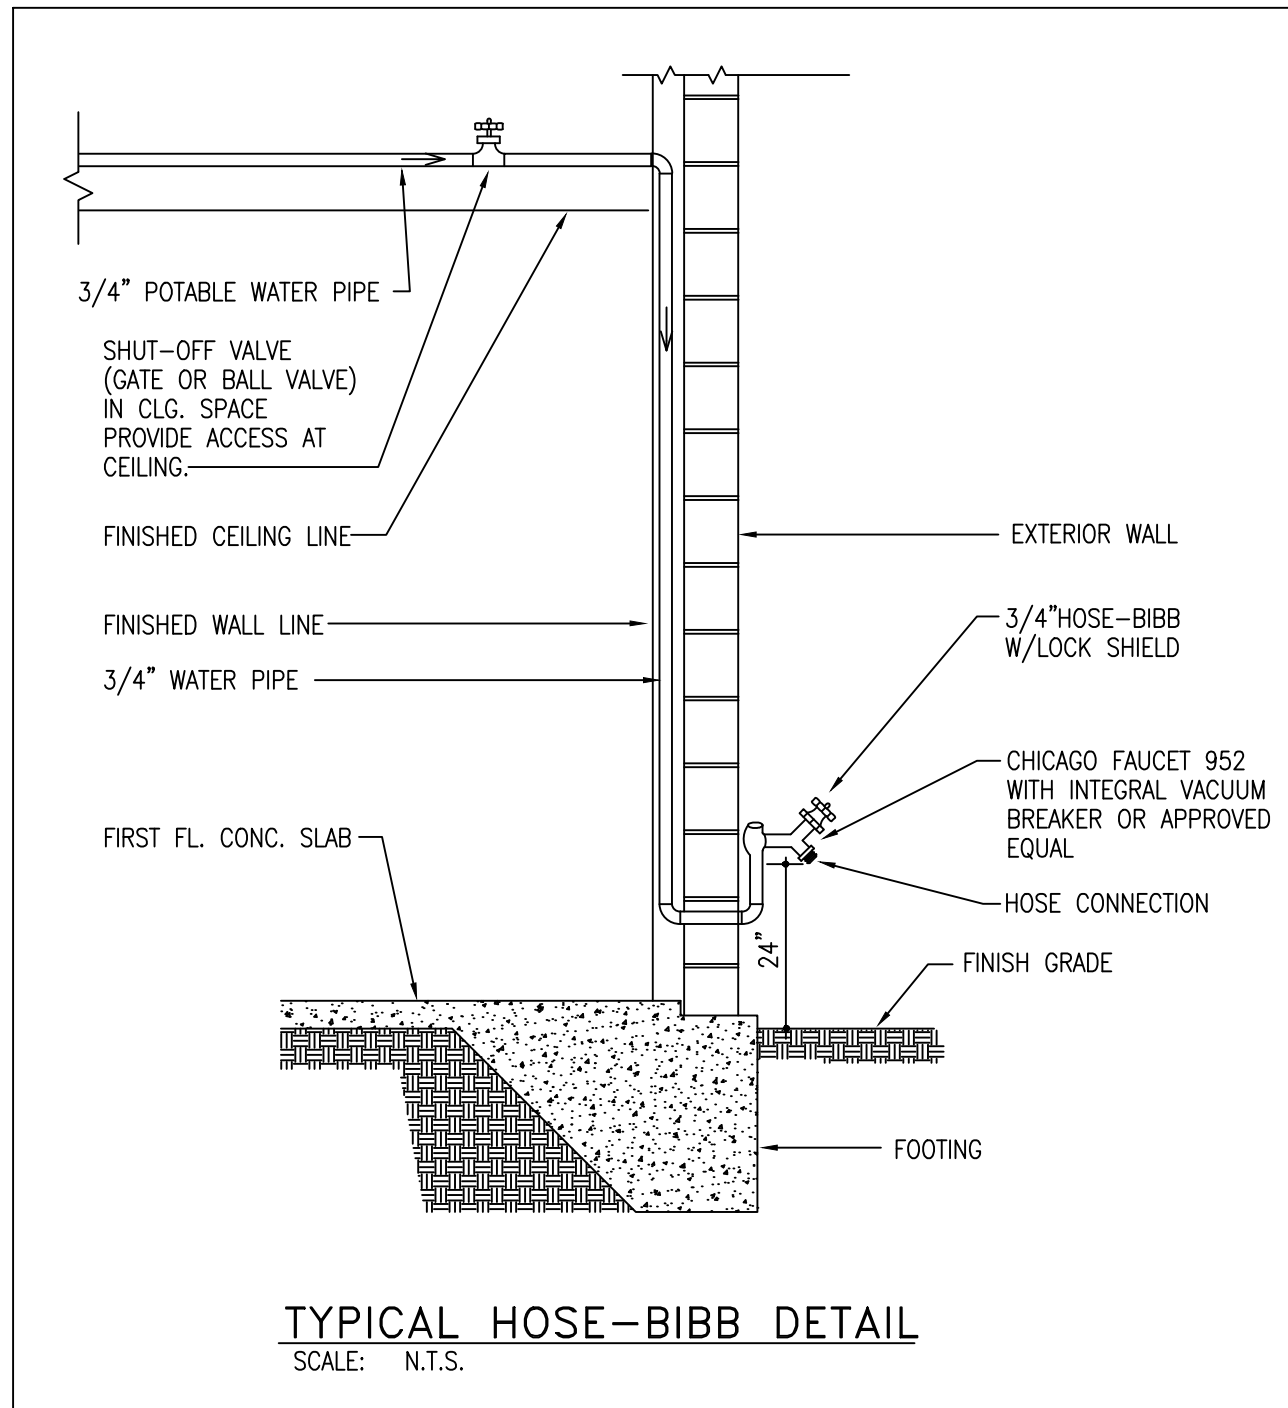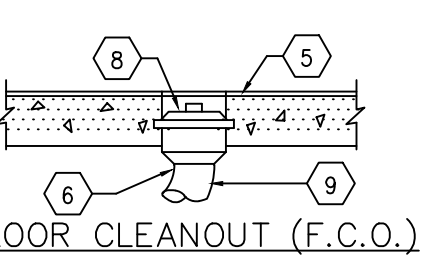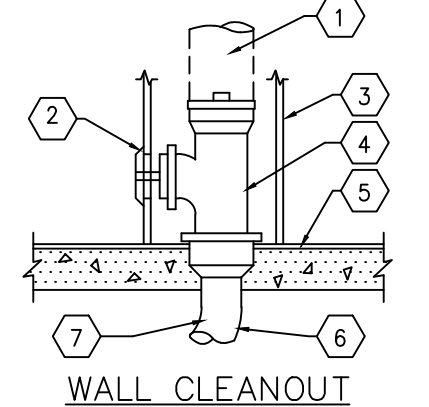

TYPICAL HOSE-BIBB DETAIL
SCALE: N.T.S.

System No. F-C-1106
F Rating - 1 Hr
T Rating - 1/4 Hr

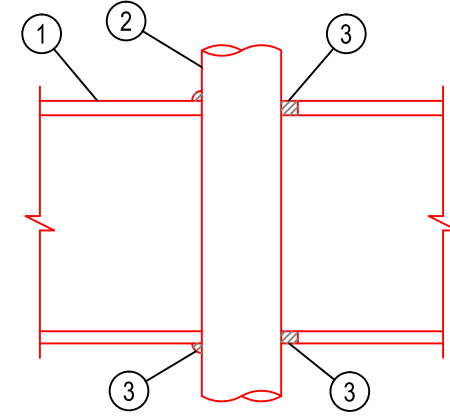

1. Floor-Ceiling Assembly — The 1 hr fire-rated solid or trussed lumber joist floor-ceiling assembly shall be constructed of the materials and in the manner specified in the individual U300 Series Floor-Ceiling Designs in the UL Fire Resistance Directory. The general construction features of the floor-ceiling assembly are summarized below:
A. Flooring System — Lumber or plywood subfloor with finish floor of lumber, plywood or Floor Topping Mixture* as specified in the individual Floor-Ceiling Design. Max diam of opening shall be 5 in. (127 mm).
B. Wood Joists* — Nom 10 in. (254 mm) deep (or deeper) lumber, steel or combination lumber and steel joists, trusses or Structural Wood Members* with bridging as required and with ends firestopped.
C. Gypsum Board* — Min 5/8 in. (16 mm) thick as specified in the individual Floor-Ceiling Design. Gypsum board secured to wood joists or furring channels as specified in the individual Floor-Ceiling Design. Max diam of opening shall be 5 in. (127 mm).
1A. Chase Wall — (Optional, Not Shown) — The through penetrants (Item 2) may be routed through a 1 hr fire rated single, double or staggered wood stud/gypsum board chase wall. Depth of chase wall stud cavity to be min 1/2 in. greater than diameter of opening cut in sole and top plates to accommodate the through penetrant (Item 2). The chase wall shall be constructed of the materials and in the manner specified in the individual U300 Series Wall and Partition Designs in the UL Fire Resistance Directory and shall include the following construction features:
A. Studs — Nom 2 by 4 in. (51 by 102 mm), 2 by 6 in. (51 by 152 mm), 2 by 8 in. (51 by 203 mm) or double nom 2 by 4 in. (51 by 102 mm) lumber studs.
B. Sole Plate — Nom 2 by 4 in. (51 by 102 mm) or 2 by 6 in. (51 by 152 mm) or 2 by 8 in. (51 by 203 mm) lumber plates or double nom 2 by 4 in. (51 by 102 mm) lumber plates tightly butted together. Circular opening to be centered in sole plate. Sole plate to be min 1 in. (25mm) wider than diam of opening. Max diam of opening in sole plate is 5 in. (140 mm).
C. Top Plate — The double top plate shall consist of two nom 2 by 4 in. (51 by 102 mm), 2 by 6 in. (51 by 152 mm) or 2 by 8 in. (51 by 203 mm) lumber plates or double nom 2 by 4 in. (51 by 102 mm) lumber plates tightly butted together. Circular opening to be centered in top plate. Top plate to be min 1 in. (25mm) wider than diam of opening. Max diam of opening in top plate is 5-1/2 in. (140 mm).
D. Gypsum Board* — Thickness, type, number of layers and fasteners shall be as specified in individual Wall and Partition Design.
2. Through Penetrants — One metallic pipe, conduit or tubing, to be installed concentrically or eccentrically within the opening. The diam of the opening shall be min 0 in. (point contact) to max 7/8 in. (22 mm). Pipe, conduit or to be rigidly supported on both sides of floor-ceiling assembly. The following types and sizes of metallic pipes, conduits or tubing may be used:
A. Copper Tube — Nom 4 in. (102 mm) diam (or smaller) Type L (or heavier) copper tube.
B. Copper Pipe — Nom 4 in. (102 mm) diam (or smaller) Regular (or heavier) copper pipe.
C. Steel Pipe — Nom 4 in. (102 mm) diam (or smaller) Schedule 10 (or heavier) steel pipe.
D. Iron Pipe — Nom 4 in. (102 mm) diam (or smaller) cast or ductile iron pipe.
E. Conduit — Nom 4 in. (102 mm) diam (or smaller) steel electrical metallic tubing (EMT) or steel conduit.


HILTI
FIRESTOP SYSTEMS
Hilti Firestop Systems

Reproduced by HILTI, Inc. Courtesy of
Underwriters Laboratories, Inc.
October 09, 2006



Page: 1 of 2

System No. F-C-2142
F Rating - 1 Hr
T Rating - 1 Hr

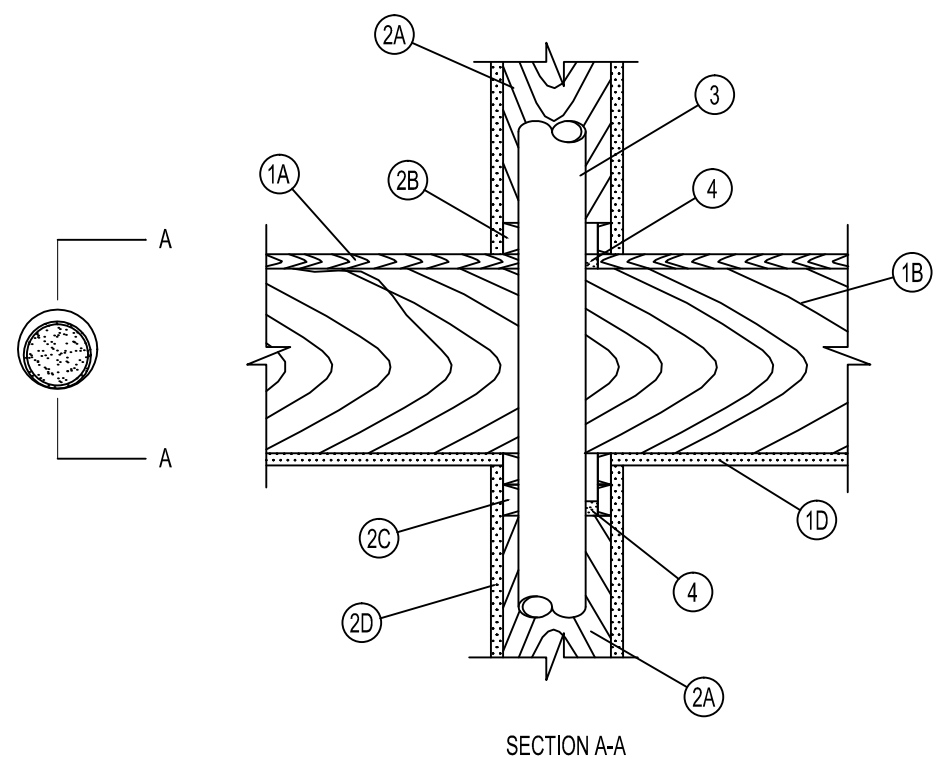

1. Floor-Ceiling Assembly The fire-rated solid or trussed lumber joist floor-ceiling assembly shall be constructed of the materials and in the manner specified in individual U500 Series Floor-Ceiling Designs in the UL Fire Resistance Directory. The general construction details of the floor-ceiling assembly are summarized below:
A. Flooring System Lumber or plywood subfloor with finish floor of lumber, plywood or Floor Topping Mixture* as specified in the individual Floor-Ceiling Design. Max diam of floor opening is 3 in.
B. Wood Joists Nom 2 by 10 in. lumber joists spaced 16 in. OC with nom 1 by 3 in. lumber bridging and with ends firestopped. As an alternate to lumber joists, nom 10 in. deep (or deeper) lumber, steel or combination lumber and steel joists, trusses or Structural Wood Members* with bridging as required with ends firestopped.
C. Furring Channels (Not shown) - Resilient galv steel furring installed perpendicular to wood joists (Item 1B) between wallboard (Item 1D) and wood joists as required in the individual Floor-Ceiling Design.
D. Gypsum Board* Nom 4 ft wide by 5/8 in. thick as specified in the individual Floor-Ceiling Design.

HILTI
FIRESTOP SYSTEMS

Reproduced by HILTI, Inc. Courtesy of
Underwriters Laboratories, Inc.
February 09, 1999



Page: 1 of 2

System No. F-C-1106
F Rating - 1 Hr
T Rating - 1/4 Hr

3. Fill, Void or Cavity Materials* Sealant — Min 3/4 in. (19 mm) thickness of sealant applied within the annulus flush with the top surface of the floor or sole plate and min 5/8 in. (16 mm) thickness of sealant applied within the annulus flush with the bottom surface of gypsum board or lower top plate. A min 1/2 in. (13 mm) diameter bead of sealant applied at the penetrant/subflooring or sole plate interface and the penetrant/gypsum board or top plate interface at point contact locations.
HILTI CONSTRUCTION CHEMICALS, DIV OF HILTI INC — CP 606 Flexible Firestop Sealant, FS-One Sealant.
*Bearing the UL Classification Mark

HILTI
FIRESTOP SYSTEMS
Hilti Firestop Systems

Reproduced by HILTI, Inc. Courtesy of
Underwriters Laboratories, Inc.
October 09, 2006



Page: 2 of 2

System No. F-C-2142
F Rating - 1 Hr
T Rating - 1 Hr

2. Chase Wall The through penetrant (Item 3) shall be routed through a 1 hr fire-rated single, double or staggered wood stud/gypsum wallboard chase wall constructed of the materials and in the manner specified in the individual U300 Series Wall and Partition Designs in the UL Fire Resistance Directory and shall include the following construction features:
A. Studs Nom 2 by 4 in. lumber studs.
B. Sole Plate Nom 2 by 4 in. lumber plates.
C. Top Plate The double top plate shall consist of two nom 2 by 4 in. lumber plates. Max diam of opening is 3 in.
D. Gypsum Board* Thickness, type, number of layers and fasteners shall be as specified in individual Wall and Partition Design.
3. Through — Penetrants One nonmetallic pipe to be installed either eccentrically or concentrically within the firestop system. The annular space between the through penetrant and the periphery of the opening shall be a min 0 in. (point contact) to a max of 5/8 in. Pipe to be rigidly supported on both sides of the floor-ceiling assembly. The following types and sizes of nonmetallic pipes may be used:
A. Polyvinyl Chloride (PVC) Pipe Nom 2 in. diam (or smaller) Schedule 40 cellular or solid core PVC pipe for use in closed (process or supply) or vented (drain, waste, or vent) piping systems.
B. Acrylonitrile Butadiene Styrene (ABS) Pipe Nom 2 in. diam (or smaller) Schedule 40 cellular or solid core ABS pipe for use in closed (process or supply) or vented (drain, waste or vent) piping systems.
C. Chlorinated Polyvinyl Chloride (CPVC) Pipe Nom 2 in. diam (or smaller) SDR17 CPVC pipe for use in closed (process or supply) or vented (drain, waste or vent) piping systems.
D. Fill, Void or Cavity Material* — Sealant Min 3/4 in. thickness of fill material applied within the annulus, flush with top surface of floor and flush with bottom surface of lower top plate.
HILTI CONSTRUCTION CHEMICALS, DIV OF
HILTI INC — FS — ONE Sealant
*Bearing the UL Classification Marking

HILTI
FIRESTOP SYSTEMS

Reproduced by HILTI, Inc. Courtesy of
Underwriters Laboratories, Inc.
February 09, 1999



Page: 2 of 2

2 Hour Fire Rated Through Penetration Firestop for Plastic Pipe through Gypsum Walls using intumescent devices

WL2063

F-rating = 2 Hr.
T-rating = 1 Hr.

TREMCO
3735 Green Rd.
Beachwood, OH, 44122

Drawing not to scale

- 1 2-Hour Fire Rated gypsum wallboard/stud assembly.
- 2 Plastic Pipe - 4" dia. (or smaller) sch. 40 PVC pipe for use in closed or vented piping systems, with a nom. annular space of 1/8".
- 3 A) TREMstop WS - wrap strips, tightly wrapped 6 times around pipe.
B) TREMstop MCR - steel restricting collar.
C) FYRE-SIL - Min. 1/4" thick sealant applied to wall/collar and collar/pipeline interfaces.

Project: _____	The products used in the above assembly have been tested in accordance with the following: - ASTM E814 (UL 1479) Standard Test Method for Through Penetration Firestopping.	The above described assembly and products have been tested and are based on both past and anticipated performance criteria. Tremco shall not be liable for any damages, direct or consequential, resulting from use of the material or design. Tremco shall only be responsible for replacing material found to be defective.
Location: _____	Date: 2/26/94	Drawing: TR-W2063
Installer: _____	Approved by: C. Tuzzeo	
Signature: _____		

1 or 2 Hour Fire Rated Through Penetration Firestop for Single Metallic Pipe through Gypsum Walls using TREMstop 1A.

WL 1113

F-Rating = 1 and 2 Hr.
T-Rating = 0 Hr.

TREMCO
3735 Green Rd.
Beach wood, OH, 44122

Drawing not to scale

- 1 Pre-Rated Gypsum Wallboard/Stud Wall Assembly
- 2 Metallic Pipe - A) Steel Pipe - 4" diam. (or smaller) Sch. 40 (or heavier) steel pipe.
B) Iron Pipe - 4" diam. (or smaller) cast or ductile iron pipe.
C) Conduit - 4" diam. (or smaller) EMT or rigid steel conduit.
D) Copper Tubing - 4" diam. (or smaller) Type L (or heavier) copper tubing.
E) Copper Pipe - 4" diam. (or smaller) Regular (or heavier) copper pipe.
The annular space shall be min. 1/4" to max. 5/8" within the firestop system.
- 3 TREMstop 1A - Min. 1/2" thickness of sealant applied within opening. Additional sealant to be installed such that a min. 1/4" crown is formed around the penetrating item.

Project: _____	The Tremco products used above have been tested in accordance with the following: - ASTM E814 (UL 1479) Standard Test Method for Through Penetration Firestopping.	The above described assembly has been tested and is based on both past and anticipated performance criteria. Tremco shall not be liable for any damages, direct or consequential, resulting from use of this material or design. Tremco shall only be responsible for replacing material found to be defective.
Location: _____	Date: 6/30/97	Drawing: TW-1113
Installer: _____	Approved by: J. Pitcole	
Signature: _____		

PROJECT:

1330 Building

1330 15th Street, Miami Beach, FL 33139

PROJECT OWNER :

NOTUS, LLC
435 21st Street, Miami Beach, FL 33139

ARCHITECT OF RECORD:



RD Architects

1800 SW 1st Avenue, Suite 607
Miami, FL 33129
Phone: 786 . 762 . 2679
email: rda@rda-archint.com
www.rda-archint.com
AA26002510

INTERIOR DESIGNER:

KEY PLAN



SIGNATURE / DATE / SEAL

Victor H. Rodriguez,
Registered Architect
State of Florida # AR0094965
305 . 282 . 0005 vh.rodriguez@rda-archint.com

PERMIT SET

Issue: 12.05.2016 / Owner Revisions

DDCI Project #: 1628.00

Drawn by: VHR

Approved by: VHR

SHEET INDEX

- Wall and Floor Penetration Details

SCALE:

SHEET NO.

P-9


THE DESIGNS INDICATED IN THESE DRAWINGS ARE PROPERTY OF RD Architects. ALL COPYRIGHTS RESERVED © 2016

1

2

3


4

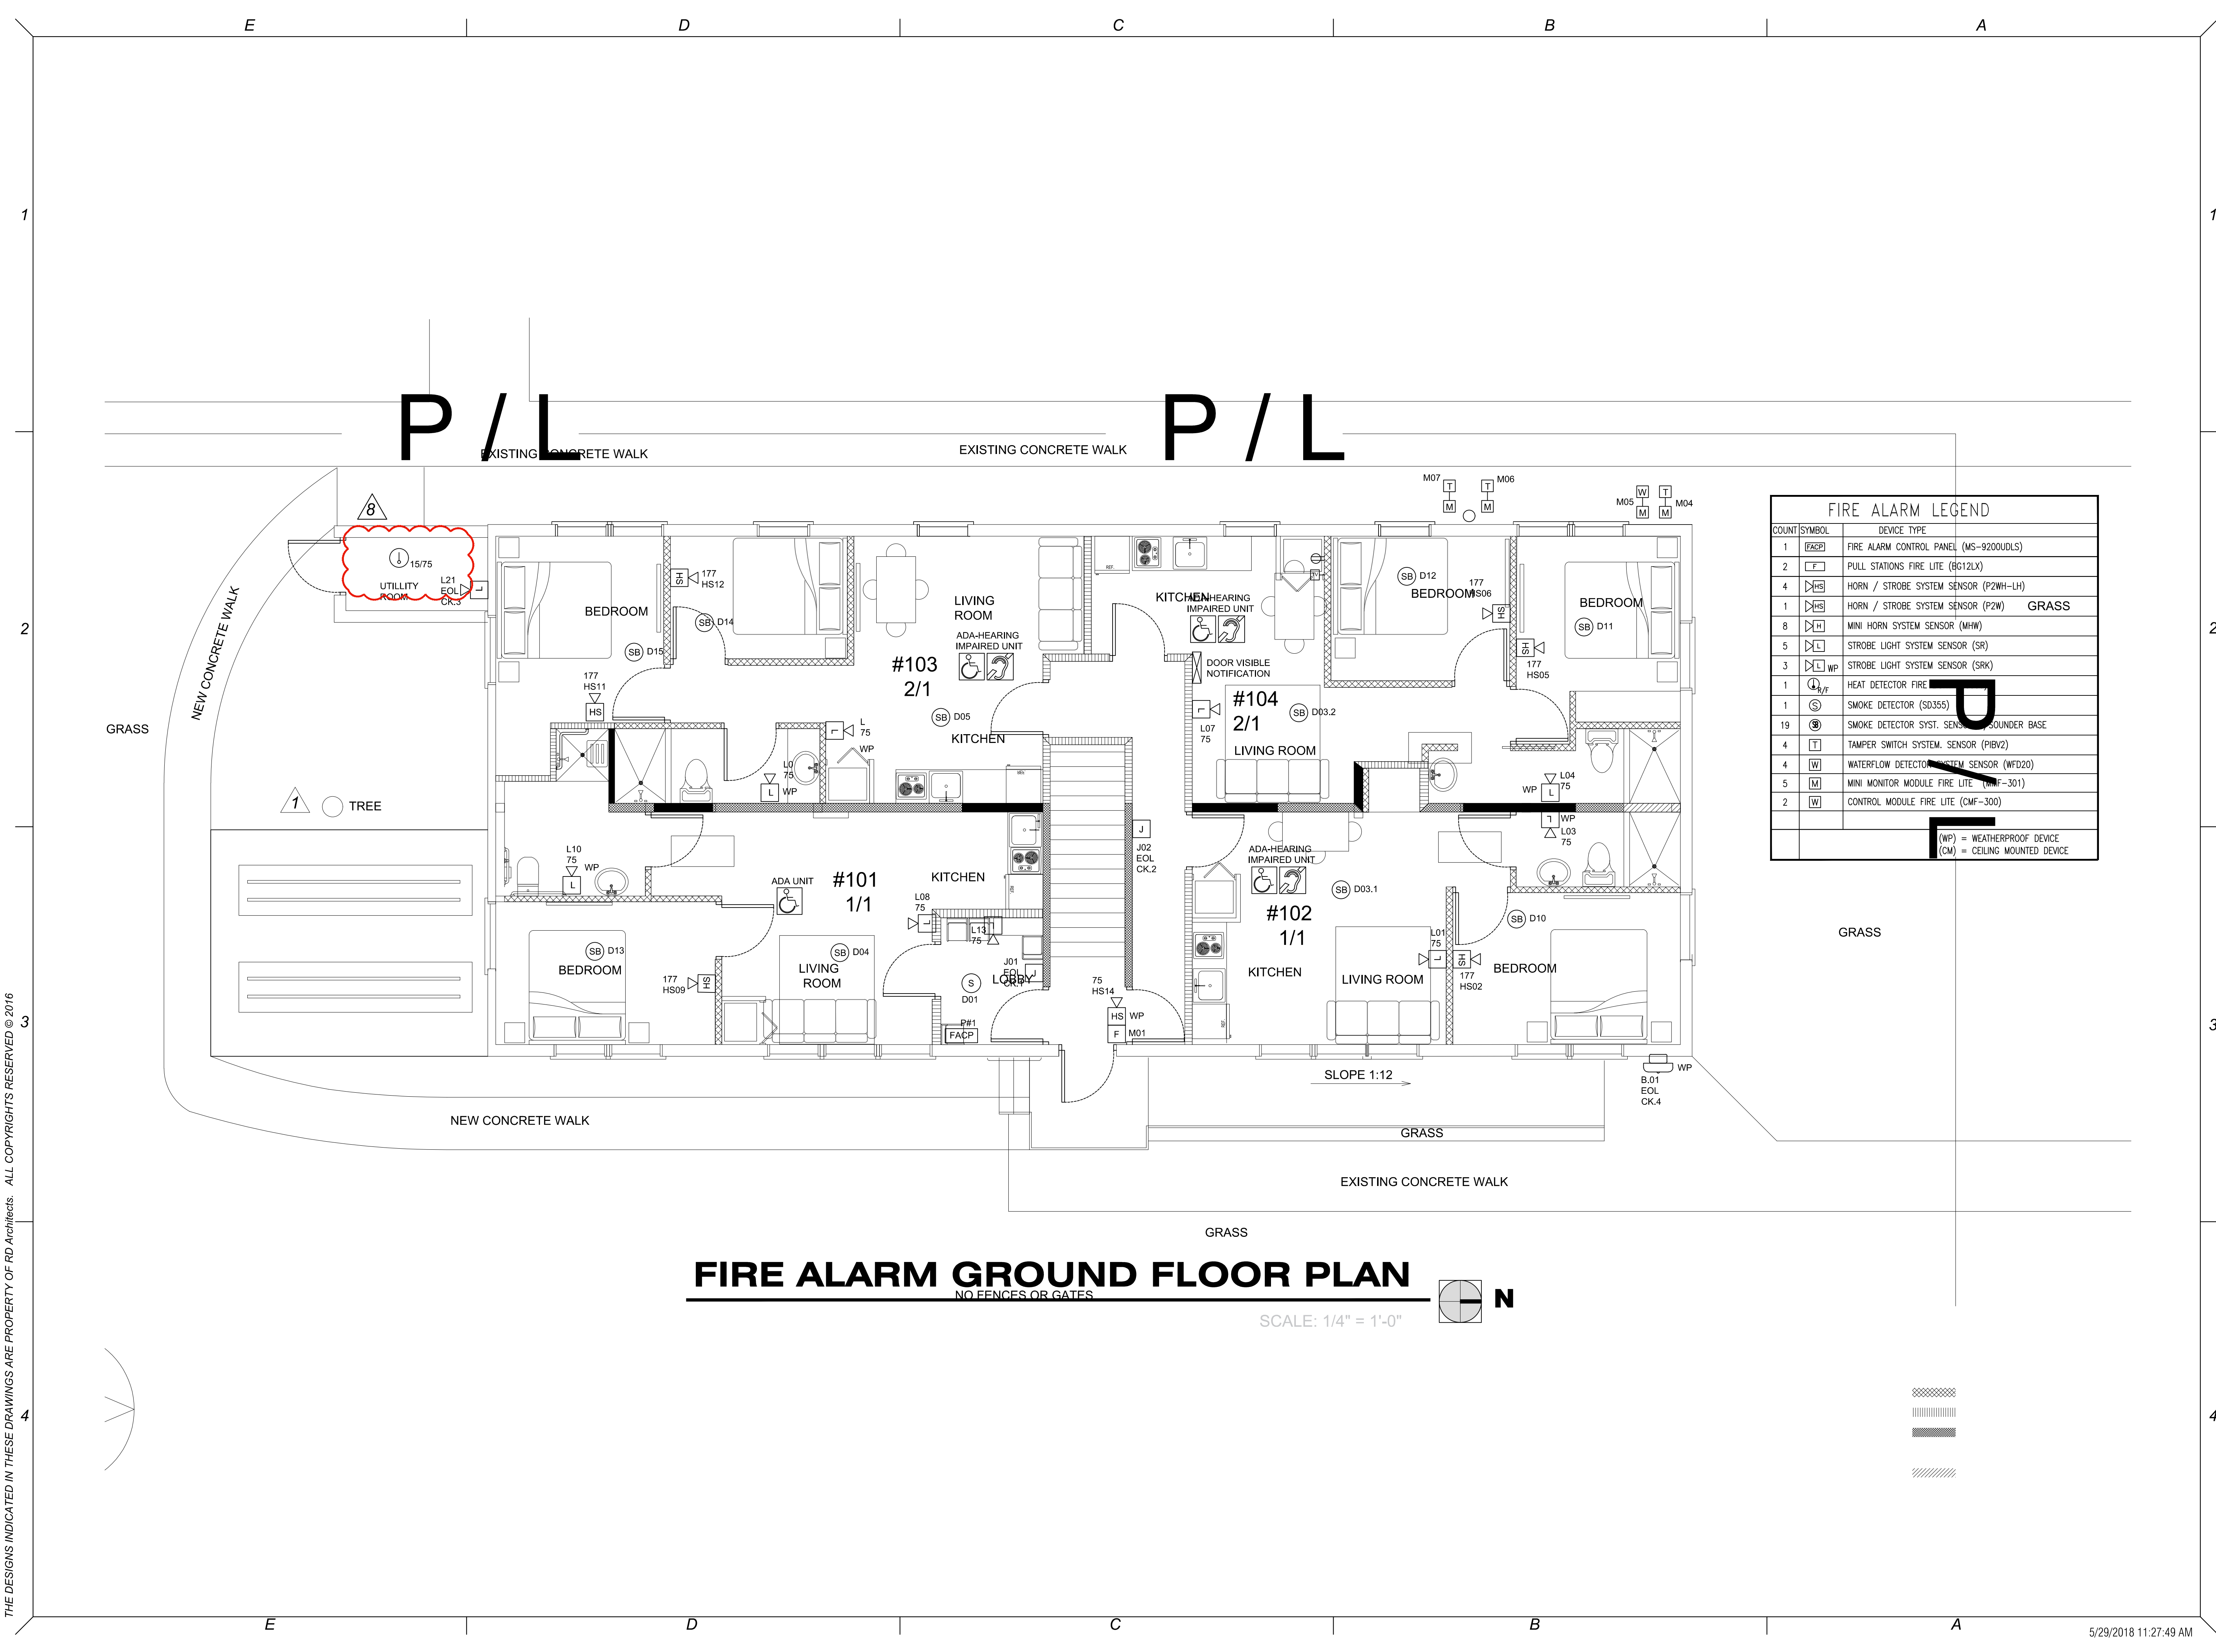

FIRE ALARM GROUND FLOOR PLAN

NO FENCES OR GATES

SCALE: 1/4" = 1'-0"

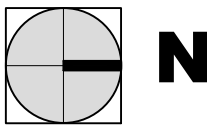

FIRE ALARM LEGEND		
COUNT	SYMBOL	DEVICE TYPE
1	[FACP]	FIRE ALARM CONTROL PANEL (MS-9200UDLS)
2	[F]	PULL STATIONS FIRE LITE (BG12LX)
4	[HS]	HORN / STROBE SYSTEM SENSOR (P2WH-LH)
1	[HS]	HORN / STROBE SYSTEM SENSOR (P2W) GRASS
8	[H]	MINI HORN SYSTEM SENSOR (MHW)
5	[SL]	STROBE LIGHT SYSTEM SENSOR (SR)
3	[SL WP]	STROBE LIGHT SYSTEM SENSOR (SRK)
1	[Q _{h/f}]	HEAT DETECTOR FIRE
1	[S]	SMOKE DETECTOR (SD355)
19	[S]	SMOKE DETECTOR SYST. SENS. SOUNDER BASE
4	[T]	TAMPER SWITCH SYSTEM. SENSOR (PIV2)
4	[W]	WATERFLOW DETECTOR SYSTEM SENSOR (WFD20)
5	[M]	MINI MONITOR MODULE FIRE LITE (MMF-301)
2	[W]	CONTROL MODULE FIRE LITE (CMF-300)
(WP) = WEATHERPROOF DEVICE		
(CM) = CEILING MOUNTED DEVICE		

PROJECT:

1330 Building

1330 15th Street, Miami Beach, FL 33139

PROJECT OWNER :

NOTUS, LLC
435 21st Street, Miami Beach, FL 33139

ARCHITECT OF RECORD:



RD Architects

1800 SW 1st Avenue, Suite 607, Miami, Florida 33129
P: 786.762.2679 F: 305.831.8079 C: 305.282.0005
Email: rda@rda-archint.com
www.rda@rda-archint.com / AA26002510


CONSULTANT ENGINEER:

KEY PLAN



SIGNATURE / DATE / SEAL

NOT VALID IF
MISSING
SIGNATURE

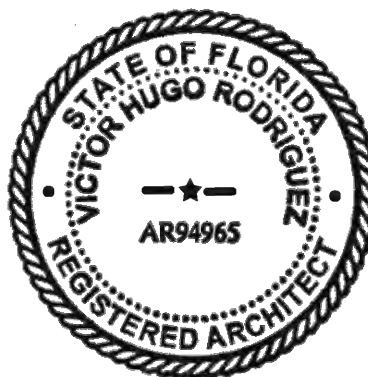

Victor H. Rodriguez,
Registered Architect
State of Florida # AR0094965
305 . 282 . 0005 vh.rodriguez@rda-archint.com

PERMIT SET

Issue, Issue Date / For

① 09.12.2016 / Change of Architect
△ 12.05.2016 / Owner Revisions

△ 05.29.2018 / Reviewer Comments

DDCI Project #: 1628.00

Drawn by: VHR

Approved by: VHR

SHEET INDEX


4 - Fire Alarm Ground Floor

SCALE :

SHEET NO.


FA-1

THE DESIGNS INDICATED IN THESE DRAWINGS ARE PROPERTY OF RD Architects. ALL COPYRIGHTS RESERVED © 2016

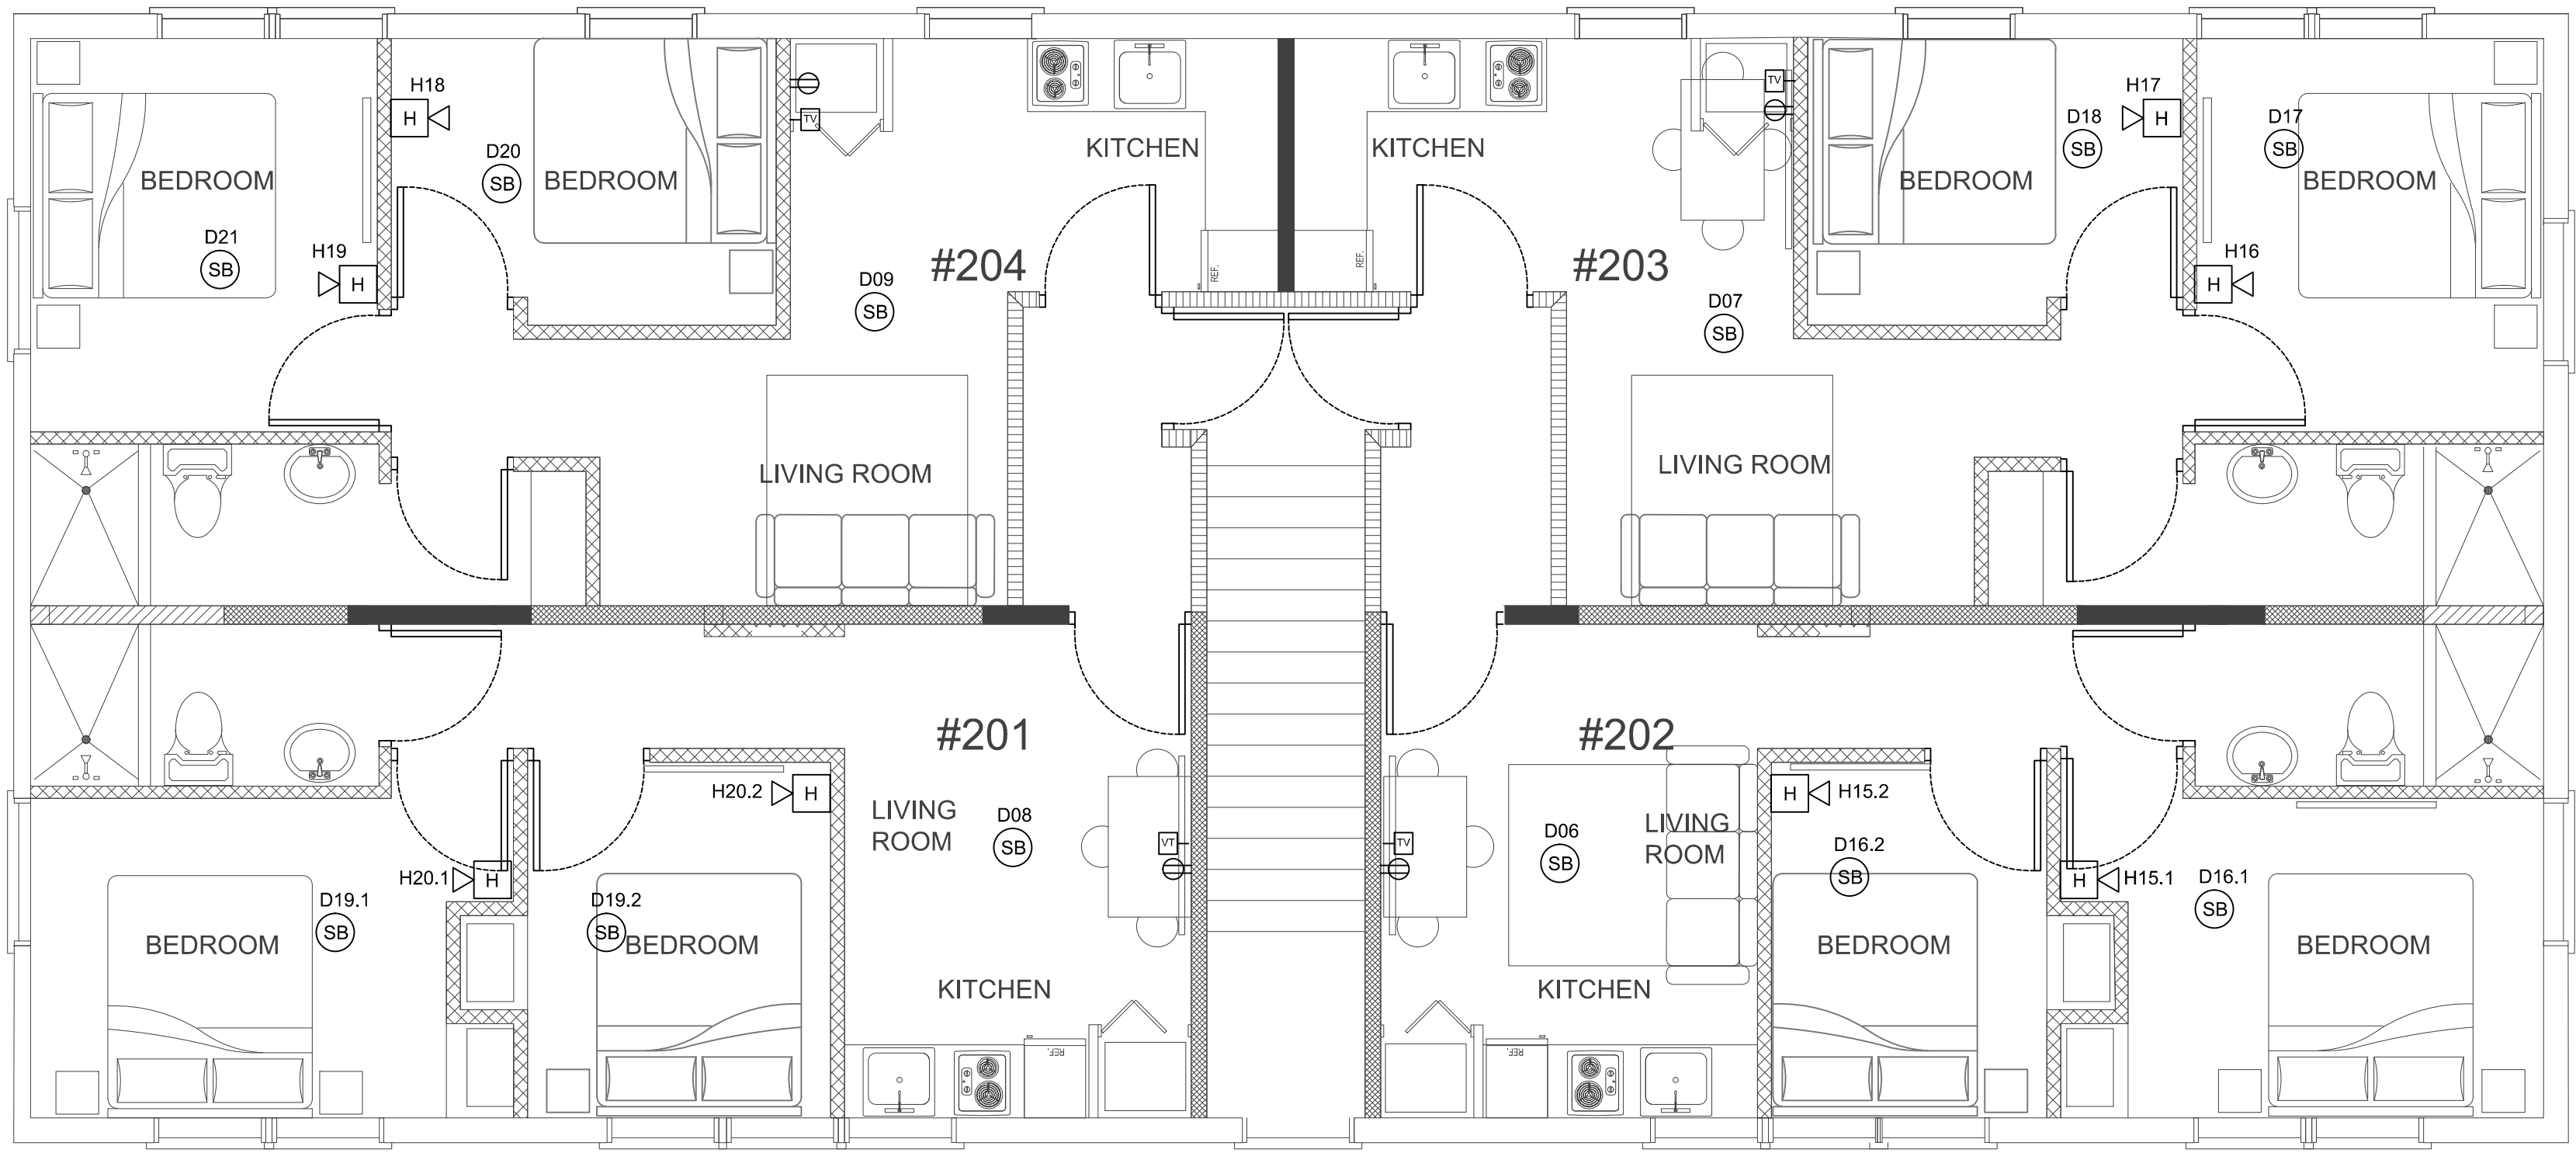

FIRE ALARM SECOND FLOOR PLAN

SCALE: 1/4" = 1'-0"

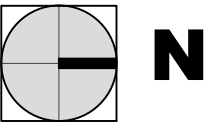

FIRE ALARM LEGEND		
COUNT	SYMBOL	DEVICE TYPE
1	[PACP]	FIRE ALARM CONTROL PANEL (MS-9200UDLS)
2	[F]	PULL STATIONS FIRE LITE (BG12LX)
4	[HSG]	HORN / STROBE SYSTEM SENSOR (P2WH-LH)
1	[HSG]	HORN / STROBE SYSTEM SENSOR (P2W)
8	[H]	MINI HORN SYSTEM SENSOR (MHW)
5	[L]	STROBE LIGHT SYSTEM SENSOR (SR)
3	[L WP]	STROBE LIGHT SYSTEM SENSOR (SRK)
1	[Hf]	HEAT DETECTOR FIRE LIGHT (H3550)
1	[S]	SMOKE DETECTOR (SD355)
19	[S]	SMOKE DETECTOR SYST. SENSOR W/SOUNDER BASE
4	[T]	TAMPER SWITCH SYSTEM SENSOR (PIBV2)
4	[W]	WATERFLOW DETECTOR SYSTEM SENSOR (WFD20)
5	[M]	MINI MONITOR MODULE FIRE LITE (MMF-301)
2	[W]	CONTROL MODULE FIRE LITE (CMF-300)
(WP) = WEATHERPROOF DEVICE (CM) = CEILING MOUNTED DEVICE		

PROJECT:
1330 Building
1330 15th Street, Miami Beach, FL 33139

PROJECT OWNER :
NOTUS, LLC
435 21st Street, Miami Beach, FL 33139

ARCHITECT OF RECORD:

RD Architects
1800 SW 1st Avenue, Suite 607
Miami, FL 33129
Phone: 786 . 762 . 2679
email: rda@rda-archint.com
www.rda-archint.com
AA26002510

INTERIOR DESIGNER:



SIGNATURE / DATE / SEAL

Victor H. Rodriguez,
Registered Architect
State of Florida # AR0094965
305 . 282 . 0005 vh.rodriguez@rda-archint.com

PERMIT SET

Issue	Issue Date / For
1	12.05.2016 / Owner Revisions

DDCI Project #: 1628.00
Drawn by: VHR
Approved by: VHR

SHEET INDEX
- Fire Alarm Plan Level 2

SCALE :
SHEET NO.

FA-2

THE DESIGNS INDICATED IN THESE DRAWINGS ARE PROPERTY OF RD Architects. ALL COPYRIGHTS RESERVED © 2016

1

2

3

4

1

2

3

4

1

1

2

3

4

E










D

C

B

A

MOUNTING HEIGHTS

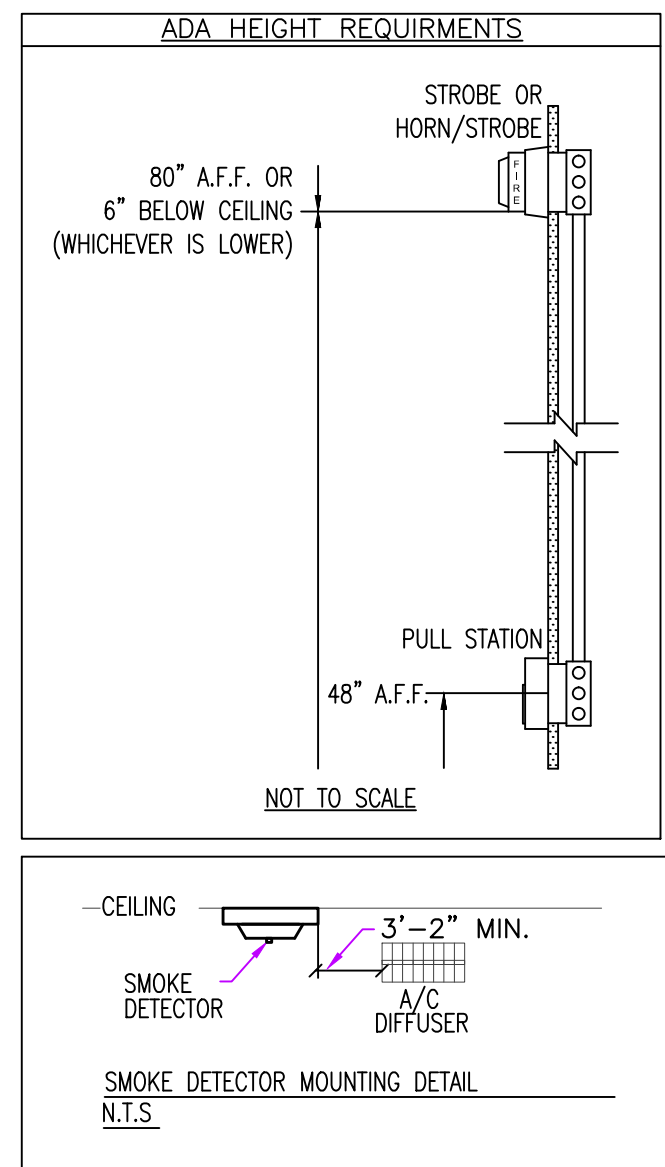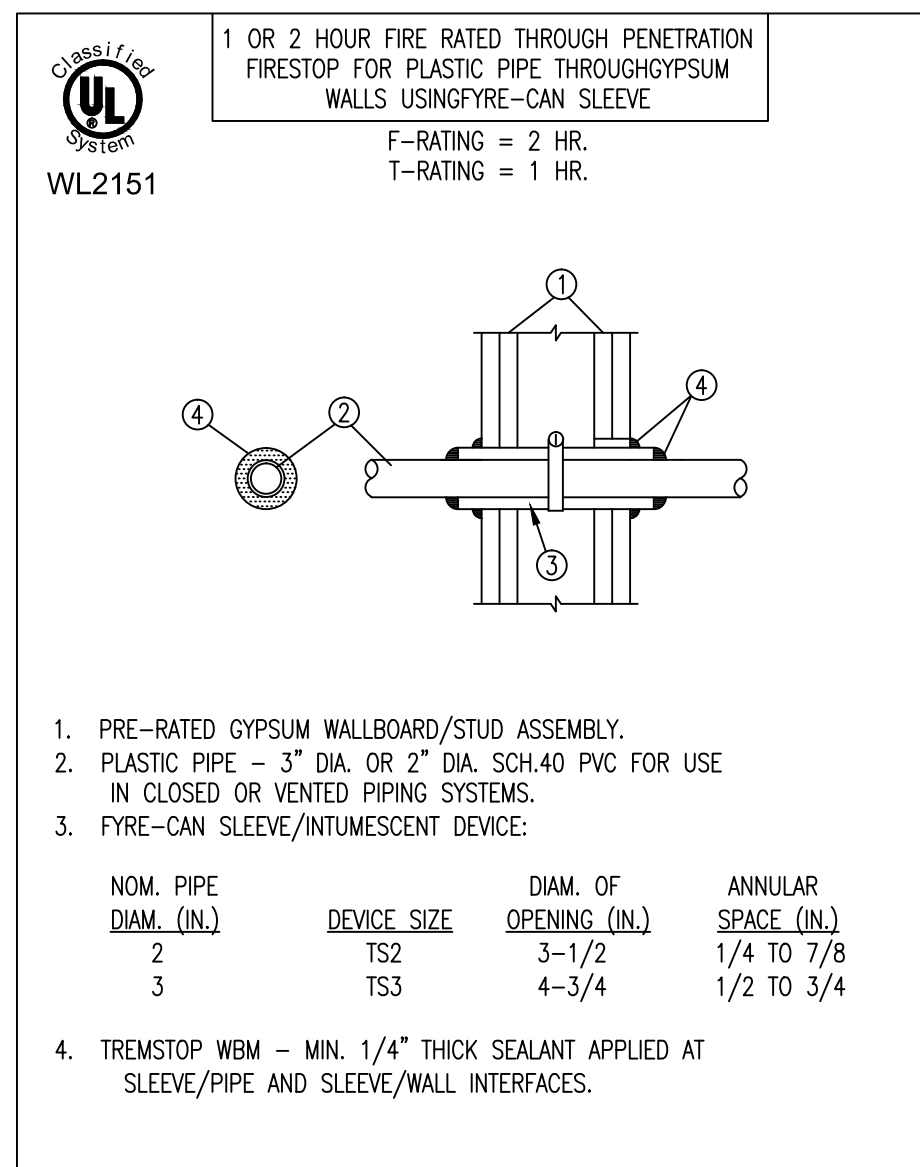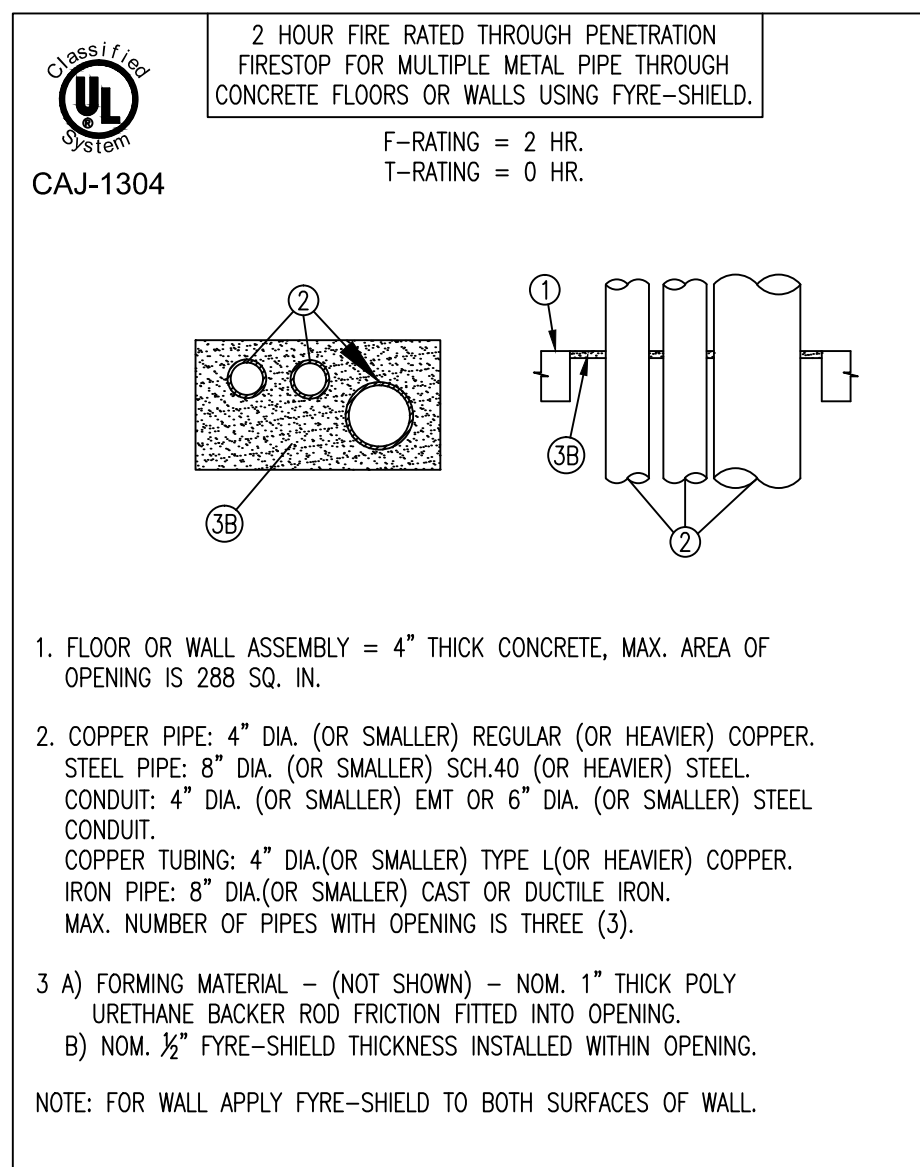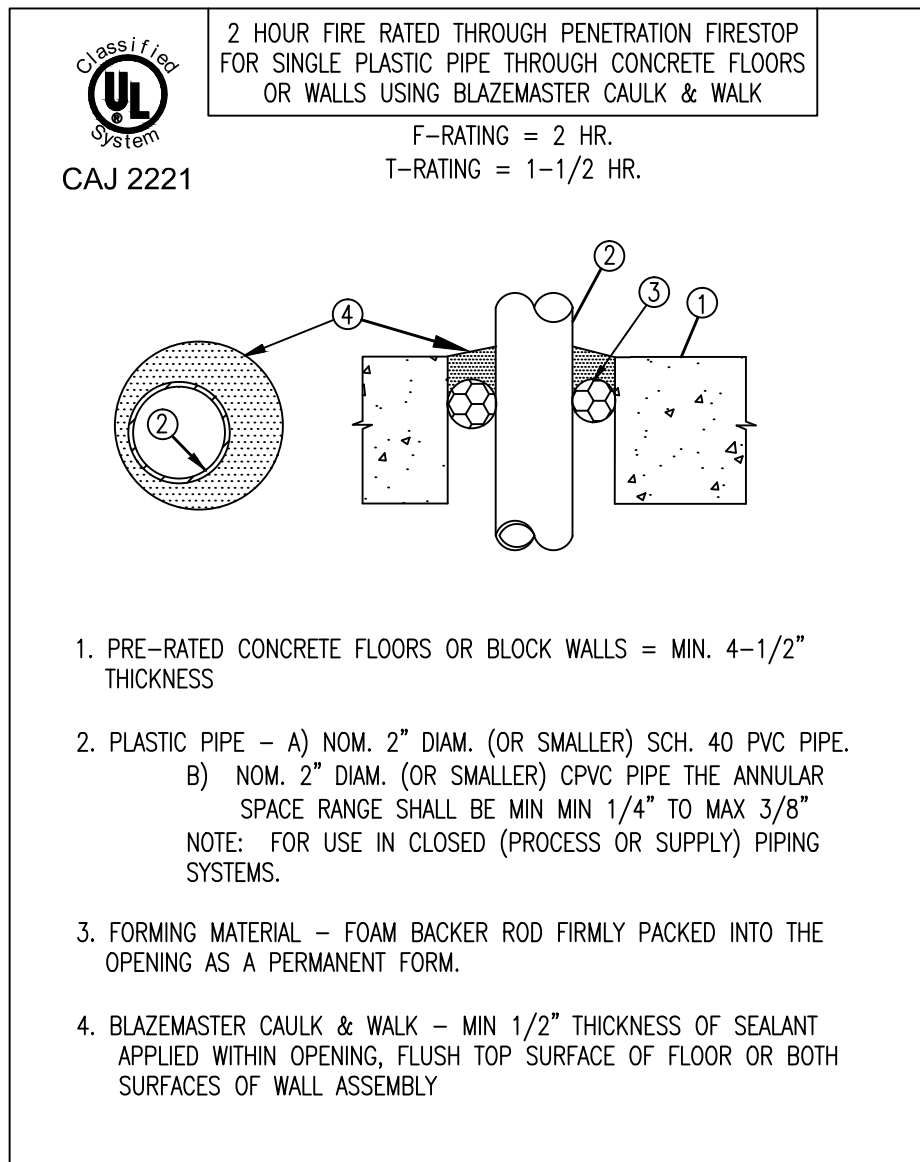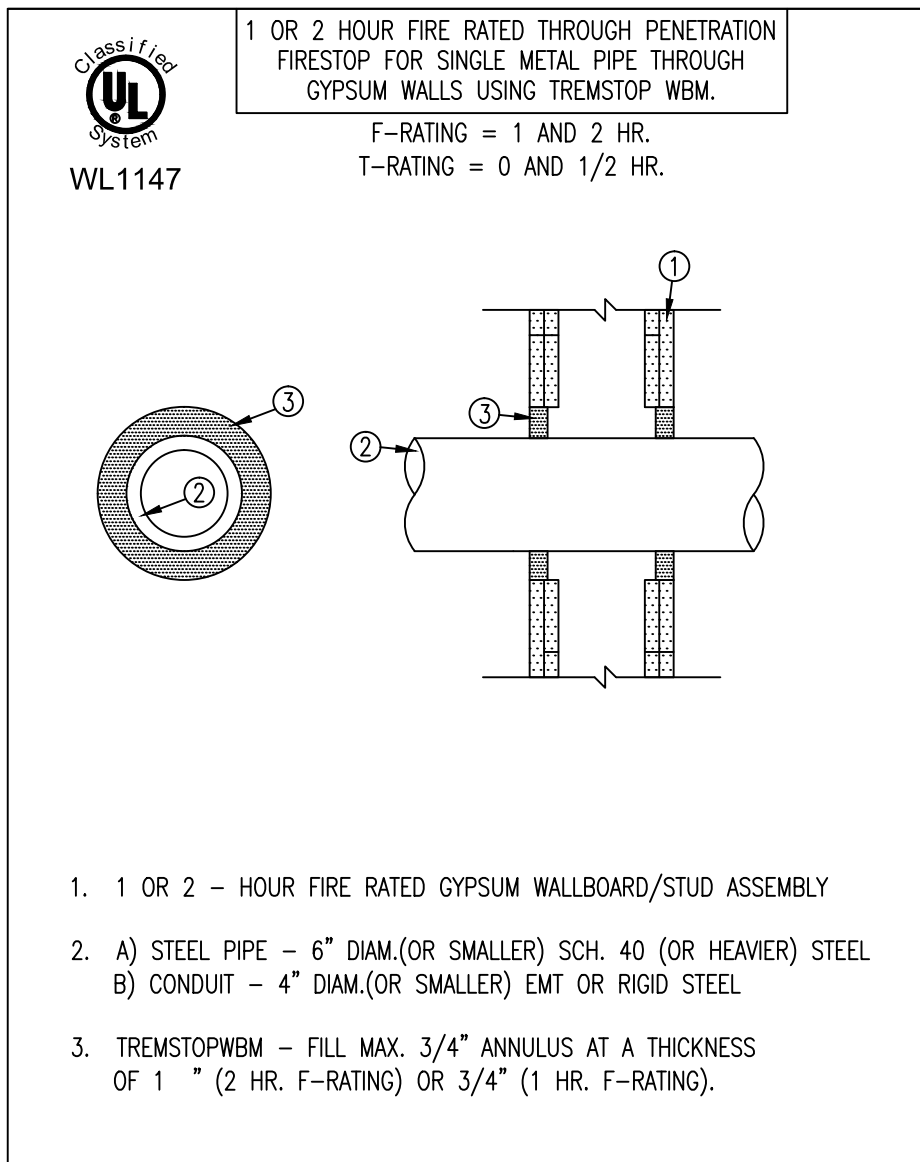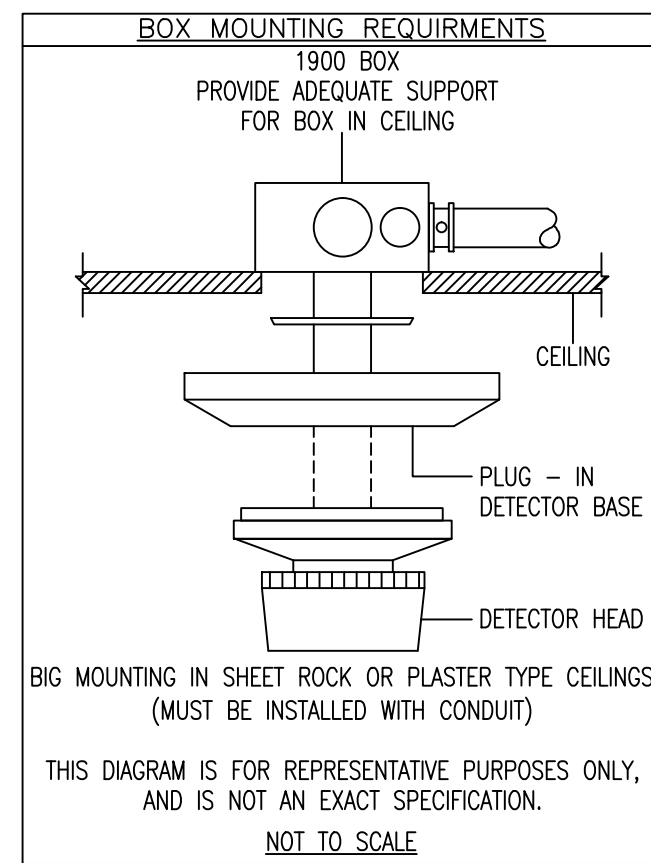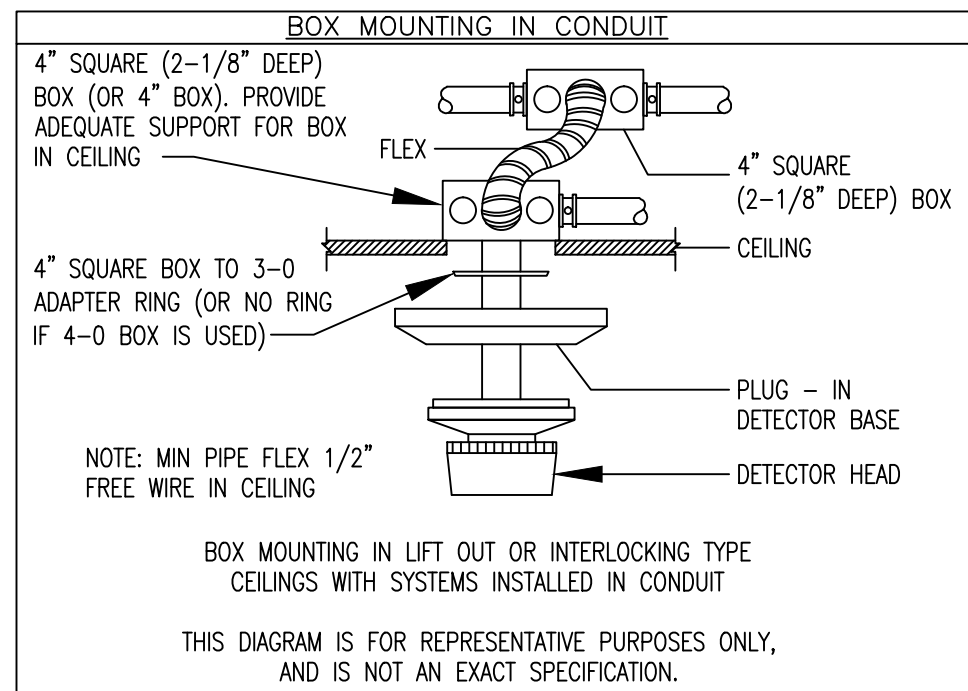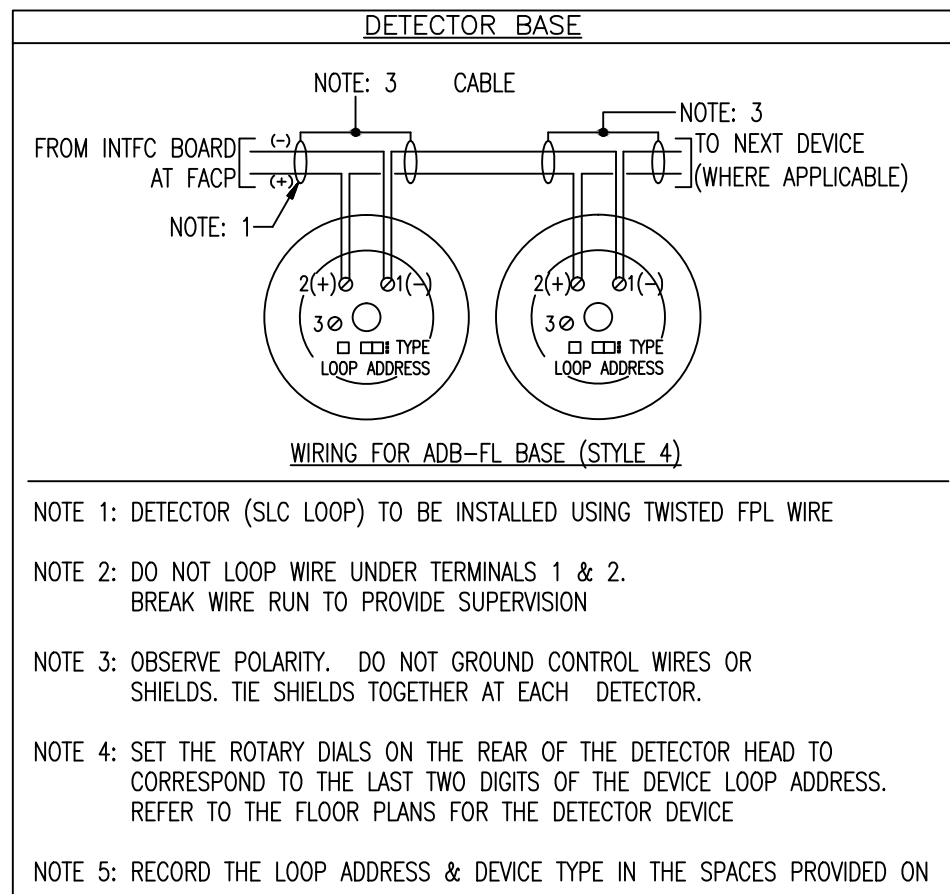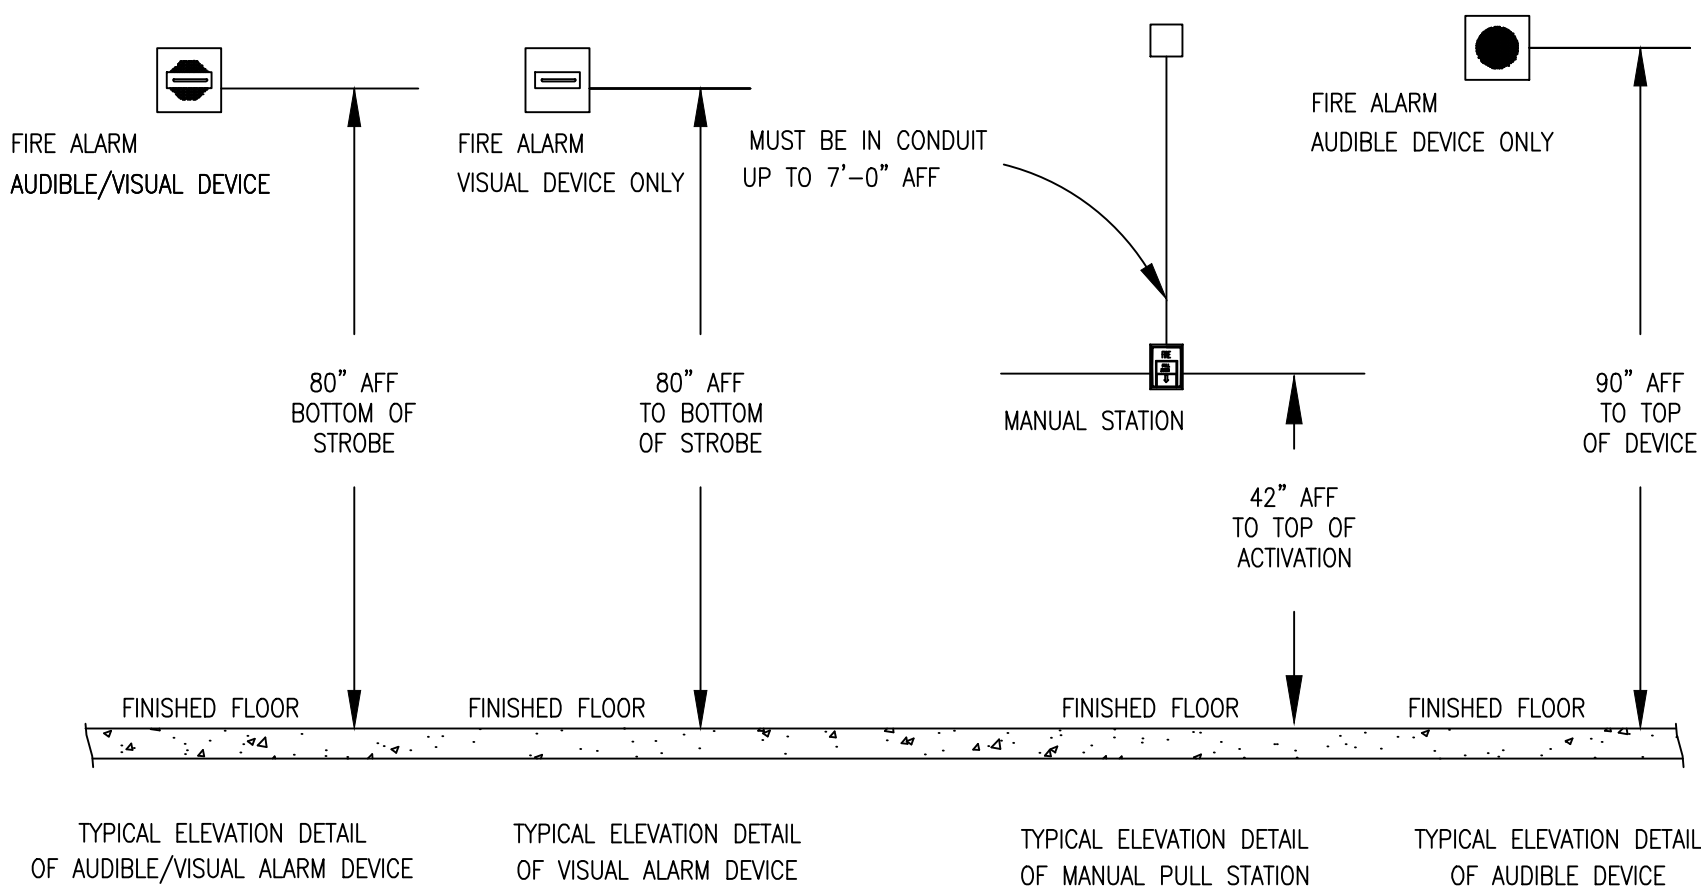

SEQUENCE OF OPERATIONS:	
MANUAL PULL STATIONS: THE ACTIVATION OF A MANUAL PULL STATION SHALL INITIATE AN "ALARM" CONDITION IN THE BUILDING FOR EVACUATION PURPOSES. IT SHALL BE INSTALLED PER NFPA 72, (LAST EDITION) CHAPTER 5.12 AND NFPA 1 CHAPTER 13.7.3.3.1-8, OF THE FLORIDA FIRE PREVENTION CODE (LAST EDITION) AT NOT LESS THAN 3'-1/2' & NOT MORE THAN 4'-1/2' AFF. AN AUDIBLE ALARM TONE SHALL SOUND AT THE FIRE ALARM CONTROL PANEL AND THE LOCATION OF THE ALARM SHALL BE DISPLAYED, IN ENGLISH, AT THE CONTROL PANEL AND ANY REMOTE ANNUNCIATOR. THE ALARM SHALL ALERT THE BUILDING OCCUPANTS BY WAY OF HORNS, HORN/STROBES AND/OR STROBE DEVICES ON THE FLOOR OF ALARM, THE FLOOR ABOVE AND THE FLOOR BELOW, AS WELL AS ALL STAIRWELLS AND ELEVATOR CARS. (AN "ALL-CALL" TO EVACUATE THE ENTIRE BUILDING CAN BE GENERATED FROM THE FIRE ALARM CONTROL PANEL.) THE ALARM CONDITION SHALL BE REPORTED TO AN UL LISTED CENTRAL STATION COMPANY BY WAY OF DIGITAL COMMUNICATOR FOR THE PURPOSES OF FIRE DEPARTMENT NOTIFICATION AND ACTION.	SUPERVISORY SIGNAL INITIATING DEVICES: (TAMPERS, PIV, FIRE PUMP SUPERVISION, EMERGENCY GENERATOR, ETC.) THE ACTIVATION OF A SUPERVISORY SIGNAL INITIATING DEVICE MODULE SHALL INITIATE A "SUPERVISORY TROUBLE" CONDITION AT THE FIRE ALARM CONTROL PANEL IN ACCORDANCE WITH NFPA 72, (LAST EDITION) CHAPTER 5.13. AN AUDIBLE SUPERVISORY TROUBLE TONE SHALL SOUND AT THE FIRE ALARM CONTROL PANEL(S) AND ANY REMOTE ANNUNCIATORS. THE SUPERVISORY CONDITION SHALL BE REPORTED TO AN UL LISTED CENTRAL STATION COMPANY BY WAY OF DIGITAL COMMUNICATOR.
SMOKE DETECTORS: THE ACTIVATION OF A SMOKE DETECTOR SHALL INITIATE AN "ALARM" CONDITION IN THE BUILDING FOR EVACUATION PURPOSES AS PER NFPA 72, (LAST EDITION) CHAPTER 5.5. AN AUDIBLE ALARM TONE SHALL SOUND AT THE FIRE ALARM CONTROL PANEL AND THE LOCATION OF THE ALARM SHALL BE DISPLAYED, IN ENGLISH, AT THE CONTROL PANEL(S) AND ANY REMOTE ANNUNCIATORS. THE ALARM SHALL ALERT THE BUILDING OCCUPANTS BY WAY OF HORNS, HORN/STROBES AND/OR STROBE DEVICES ON THE FLOOR OF ALARM, THE FLOOR ABOVE AND THE FLOOR BELOW, AS WELL AS ALL STAIRWELLS AND ELEVATOR CARS. (AN "ALL-CALL" TO EVACUATE THE ENTIRE BUILDING CAN BE GENERATED FROM THE FIRE ALARM CONTROL PANEL.) THE ALARM CONDITION SHALL BE REPORTED TO AN UL LISTED CENTRAL STATION COMPANY BY WAY OF DIGITAL COMMUNICATOR FOR THE PURPOSES OF FIRE DEPARTMENT NOTIFICATION AND ACTION.	ALARM MONITORING POINTS: (KITCHEN HOOD SYSTEMS, SUPPRESSION PANEL, ETC.) THE ACTIVATION OF A MODULE THAT MONITORS AN ALARM POINT SHALL INITIATE AN "ALARM" CONDITION IN THE BUILDING FOR EVACUATION PURPOSES PER NFPA 72, (LAST EDITION) CHAPTER 6.8.5.6. AN AUDIBLE ALARM TONE SHALL SOUND AT THE FIRE ALARM CONTROL PANEL AND THE LOCATION OF THE ALARM SHALL BE DISPLAYED, IN ENGLISH, AT THE CONTROL PANEL(S) AND ANY REMOTE ANNUNCIATORS. THE ALARM SHALL ALERT THE BUILDING OCCUPANTS BY WAY OF HORNS, HORN/STROBES AND/OR STROBE DEVICES ON THE FLOOR OF ALARM, THE FLOOR ABOVE AND THE FLOOR BELOW, AS WELL AS ALL STAIRWELLS AND ELEVATOR CARS. (AN "ALL-CALL" TO EVACUATE THE ENTIRE BUILDING CAN BE GENERATED FROM THE FIRE ALARM CONTROL PANEL.) THE ALARM CONDITION SHALL BE REPORTED TO AN UL LISTED CENTRAL STATION COMPANY BY WAY OF DIGITAL COMMUNICATOR FOR THE PURPOSES OF FIRE DEPARTMENT NOTIFICATION AND ACTION.
CEILING MOUNTED SMOKE DETECTOR SHALL NOT BE LOCATED IN A DIRECT AIRFLOW, NOR CLOSER THAN 3' FROM AN AIR SUPPLY DIFFUSER IN ACCORDANCE WITH NFPA 72, (LAST EDITION) CHAPTER 5.7.4.1 WALL MOUNTED SMOKE DETECTOR SHALL BE MOUNTED 4" MINIMUM FROM CEILING WITH 12" MAXIMUM FROM CEILING, AS PER NFPA 72, (LAST EDITION) CHAPTER 5.7.3.2.1 IF APPLICABLE, THE ACTIVATION OF ANY CORRIDOR SMOKE DETECTOR SHALL RELEASE THE MAGNETIC HOLD OPEN DEVICES ASSOCIATED WITH ANY SMOKE/FIRE DOORS SO THAT THE DOORS CLOSE. MAGNETIC HOLD OPEN DEVICES ARE FAIL-SAFE AND SHALL RELEASE (CLOSE) ON A POWER FAILURE OF THE FIRE ALARM SYSTEM, PER NFPA 72, (LAST EDITION) CHAPTER 5.14.6 AND 6.15.6	POWER UP AND POWER DOWN SEQUENCE FOR FIRE ALARM PANELS: POWER DOWN: 1. DISCONNECT BATTERY 2. TURN OFF AC POWER PRIMARY & SECONDARY POWER UP: 1. TURN ON AC POWER PRIMARY & SECONDARY 2. RECONNECT BATTERIES
F/A NOTES : ALL FIRE ALARM WORK TO BE DONE BY THE LANDLORD'S APPROVED CONTRACTOR, THIS PERMIT ONLY FOR REFERENCE TO FIRE ALARM DRAWINGS FOR CONCEPTUAL FIRE ALARM DESIGN. CONTRACTOR TO SUBMIT SHOP DRAWINGS FOR PERMIT. FIRE ALARM SHOP DRAWINGS, SIGNED AND SEALED, AS REQUIRED BY THE JURISDICTION HAVING AUTHORITY NEW FIRE ALARM SYSTEM DETAILS AND REQUIREMENTS. THE SYSTEM TO BE INSTALLED IN ACCORDANCE WITH : F.B.C. 2010, N.F.P.A. 72, N.F.P.A.-101, N.E.C. ARTICLES 250, 300 AND 760.	

FIRE ALARM SPECIFICATIONS:	
1. ALL EQUIPMENT SHALL BE NEW U.L. LISTED, AND SHALL BE LISTED FOR USE AND COMPATIBLE.	18. CONDUIT, IF REQUIRED, SHALL BE NO MORE THAN 40% FILL, PER NFPA 70, NATIONAL ELECTRICAL CODE (2008 EDITION)
2. THE INSTALLATION OF THE FIRE ALARM SYSTEM SHALL COMPLY WITH NFPA 70, NATIONAL ELECTRICAL CODE (2008 EDITION), FLORIDA FIRE PREVENTION CODE (LAST EDITION), NFPA 72 (LAST EDITION), AND THE FLORIDA ACCESSIBILITY CODE PER FBC (2007 EDITION), 11-4.28	19. THE FIRE ALARM PANEL(S) SHALL NOT BE USED TO POWER ANY UNAUTHORIZED EXTERNAL DEVICES.
3. THE FIRE ALARM SYSTEM SHALL CONSIST OF A FIRE DETECTION CONTROL AND NOTIFICATION SYSTEM.	20. ALL FIRE STOP PENETRATIONS SHALL BE SEALED WITH A UL APPROVED FIRESTOP MATERIAL. (SEE FIRESTOP DETAIL)
4. THE FIRE ALARM EQUIPMENT SHALL BE "POWER LIMITED".	21. THE FIRE ALARM PANEL MUST HAVE AN EARTH GROUND CONNECTION AS PER MANUFACTURER'S RECOMMENDATIONS AND ARTICLE 760 OF NFPA 70, NATIONAL ELECTRICAL CODE (2008 EDITION). MINIMUM WIRE SIZE IS 14 AWG FOR GND CONNECTION. (NOTE: PANEL NEUTRAL OR CONDUIT RING IS NOT ACCEPTABLE.)
5. THE FIRE ALARM CONTROL PANEL SHALL BE INTELLIGENT AND HAVE STANDBY BATTERY BACKUP AS PER NFPA 72, (LAST EDITION) CHAPTER 4.4.1 PROVIDING BATTERY POWER CAPACITY FOR THE ENTIRE SYSTEM TO OPERATE FOR 24 HOURS IN STANDBY MODE AND THE ENTIRE SYSTEM FOR 5 MINUTES IN THE ALARM MODE.	22. ALL SURGE/TRANSIENT SUPPRESSERS MUST BE CONNECTED TO BUILDING OR COLD WATER GROUND.
6. THE PRIMARY POWER SOURCE FOR THE FIRE ALARM SYSTEM SHALL BE CONNECTED TO A DEDICATED LOCKED CIRCUIT BREAKER.	23. FIRE ALARM RISER CIRCUITS SHALL BE CLASS "B", STYLE "Y" & STYLE "4".
7. CABLE TYPE, SIZE AND INSTALLATION REQUIREMENTS SHALL COMPLY WITH ARTICLE 760 OF NFPA 70, NATIONAL ELECTRICAL CODE (2008 EDITION) FOR POWER LIMITED FIRE PROTECTION SIGNALING CIRCUITS-WIRING METHODS AND MATERIALS.	24. A BREAK IN ANY FIELD WIRING OR GROUNDING OF ANY CONDUCTOR WILL RESULT IN THE ACTIVATION OF THE FIRE ALARM CONTROL PANEL(S) "TROUBLE" SIGNAL WHICH WILL PRODUCE AN AUDIBLE AND VISIBLE ANNUNCIATION AT THE PANEL(S) AND ANY REMOTE ANNUNCIATOR.
8. MINIMUM CABLE SIZE - REFER TO WIRE LEGEND.	25. THE 120-VAC POWER FEED FOR THE FIRE ALARM PANELS AND POWER SUPPLIES MUST BE FROM A DEDICATED EMERGENCY PANEL BREAKER AND THE BREAKER SHALL BE IDENTIFIED AS "FIRE ALARM CIRCUIT", AS PER NFPA 72 (2010 EDITION) 4.4.1.4.2.2
9. ALL WIRING AND CONDUIT TO CONFORM TO NFPA 70, NATIONAL ELECTRICAL CODE (2008 EDITION), WIRE SHALL BE SOLID COPPER OR STRANDED COPPER WITH A MAXIMUM OF 7 STRANDS FOR SIZES 16 AND 18AWG. STRANDED COPPER WITH A MAXIMUM OF 19 STRANDS.	26. THE FIRE ALARM SYSTEM SHALL BE MONITORED OFF-PREMISE BY A UL LISTED CERTIFICATED CENTRAL STATION IN ACCORDANCE WITH NFPA 72, CHAPTER 8.2 (2010 EDITION)
10. ALL WIRING INSTALLED IN DUCTS, PLENUMS AND OTHER SPACES USED FOR ENVIRONMENTAL AIR SHALL BE TYPE FPLP, AS PER NFPA 70, NATIONAL ELECTRICAL CODE (2008 EDITION).	27. TWO TELEPHONE LINES SHALL BE PROVIDED TO THE FIRE ALARM COMMUNICATOR FOR PURPOSES OF MONITORING THE FIRE ALARM SYSTEM. TELEPHONE LINES SHALL BE CONNECTED IN CONFORMANCE WITH NFPA 72, CHAPTER 8.5.3.2.1 (LAST EDITION)
11. ALARM NOTIFICATION APPLIANCES SHALL BE VISUAL, AUDIBLE-VISUAL AND/OR AUDIBLE TYPE.	28. UPON COMPLETION OF THE INSTALLATION A "CERTIFICATE OF COMPLETION" SHALL BE PROVIDED TO THE CUSTOMER AND THE LOCAL AUTHORITY HAVING JURISDICTION. A LOG BOOK SHALL REMAIN ON THE PREMISES THAT SHALL INCLUDE DRAWINGS, MANUALS, INSPECTION RECORDS, ETC.
12. AUDIBLE COMPONENTS SHALL BE HORNS, AND SHALL CONFORM WITH NFPA 72 (LAST EDITION), AFTER 7.4 FOR LOCATION, SPACING AND AUDIBILITY REQ'S.	29. ALL EQUIPMENT SHALL BE INSTALLED IN CONFORMITY OF THE LIFE SAFETY CODE (LAST EDITION)
13. VISUAL DEVICES SHALL BE XENON, WITH A MINIMUM CANDELA RATING OF 75-CANDELA AND SHALL BE PLACED AT 80" TO THE BOTTOM OR 6" FROM THE CEILING WHICHEVER IS LOWER PER ARTICLE 4.28 OF THE FLORIDA ACCESSIBILITY CODE. VISUAL DEVICES SHALL CONFORM WITH NFPA 72 (LAST EDITION), CHAPTER 7.5 FOR SPACING IN ROOMS AND CORRIDORS. IF MORE THAN 2 VISUAL DEVICES ARE IN ANY FIELD OF VIEW THEY SHALL BE SYNCHRONIZED, PER NFPA 72 (LAST EDITION) CHAPTER 7.5.4.1.2(3) AND 7.5.4.2.7	30. THIS SYSTEM IS A CERTIFICATED CENTRAL STATION SERVICE AND A CERTIFICATE WILL BE PROVIDED FOR IT. IT WILL BE PLACED WITHIN 3' OF THE FIRE CONTROL PANEL.
14. THE LOCATION OF SMOKE DETECTORS SHALL BE SPECIFIED ON THE DRAWINGS. LOCATION AND PACING SHALL BE IN CONFORMANCE WITH NFPA 72 (LAST EDITION) CHAPTER 5.5.2, 5.7, 5.8 AND 5.9	
15. MANUAL PULL STATIONS SHALL BE INSTALLED IN CONFORMANCE WITH NFPA 72 (LAST EDITION) CHAPTER 5.1.2 AND THE FLORIDA FIRE PREVENTION CODE CHAPTER: 13.7.1.4.7.1-6	
16. CONTRACTOR WILL MAKE ANY CORRECTIONS TO DRAWINGS TO REFLECT THE FIRE ALARM SYSTEM, AS FINALED. DEVICES SHOWN ON PLANS MAY NEED TO BE RELOCATED DUE TO ACTUAL BUILDING AND SPRINKLER DESIGN.	
17. CIRCUIT POLARITY MUST BE OBSERVED.	

PROJECT:

1330 Building

1330 15th Street, Miami Beach, FL 33139

PROJECT OWNER :

NOTUS, LLC
435 21st Street, Miami Beach, FL 33139

ARCHITECT OF RECORD:



RD Architects
1800 SW 1st Avenue, Suite 607
Miami, FL 33129
Phone: 786.762.2679
email: rda@rda-archint.com
www.rda-archint.com
AA26002510

INTERIOR DESIGNER:

2

KEY PLAN



SIGNATURE / DATE / SEAL

3

Victor H. Rodriguez,
Registered Architect
State of Florida # AR0094965
305.282.0005 vhr.rodriguez@rda-archint.com

PERMIT SET

Issue, Issue Date / For
12.05.2016 / Owner Revisions

DDCI Project #: 1628.00

Drawn by: VHR

Approved by: VHR

SHEET INDEX

4 - Fire Alarm Details

SCALE :

SHEET NO.

FA-4


THE DESIGNS INDICATED IN THESE DRAWINGS ARE PROPERTY OF RD Architects. ALL COPYRIGHTS RESERVED © 2016

1


2

3

4

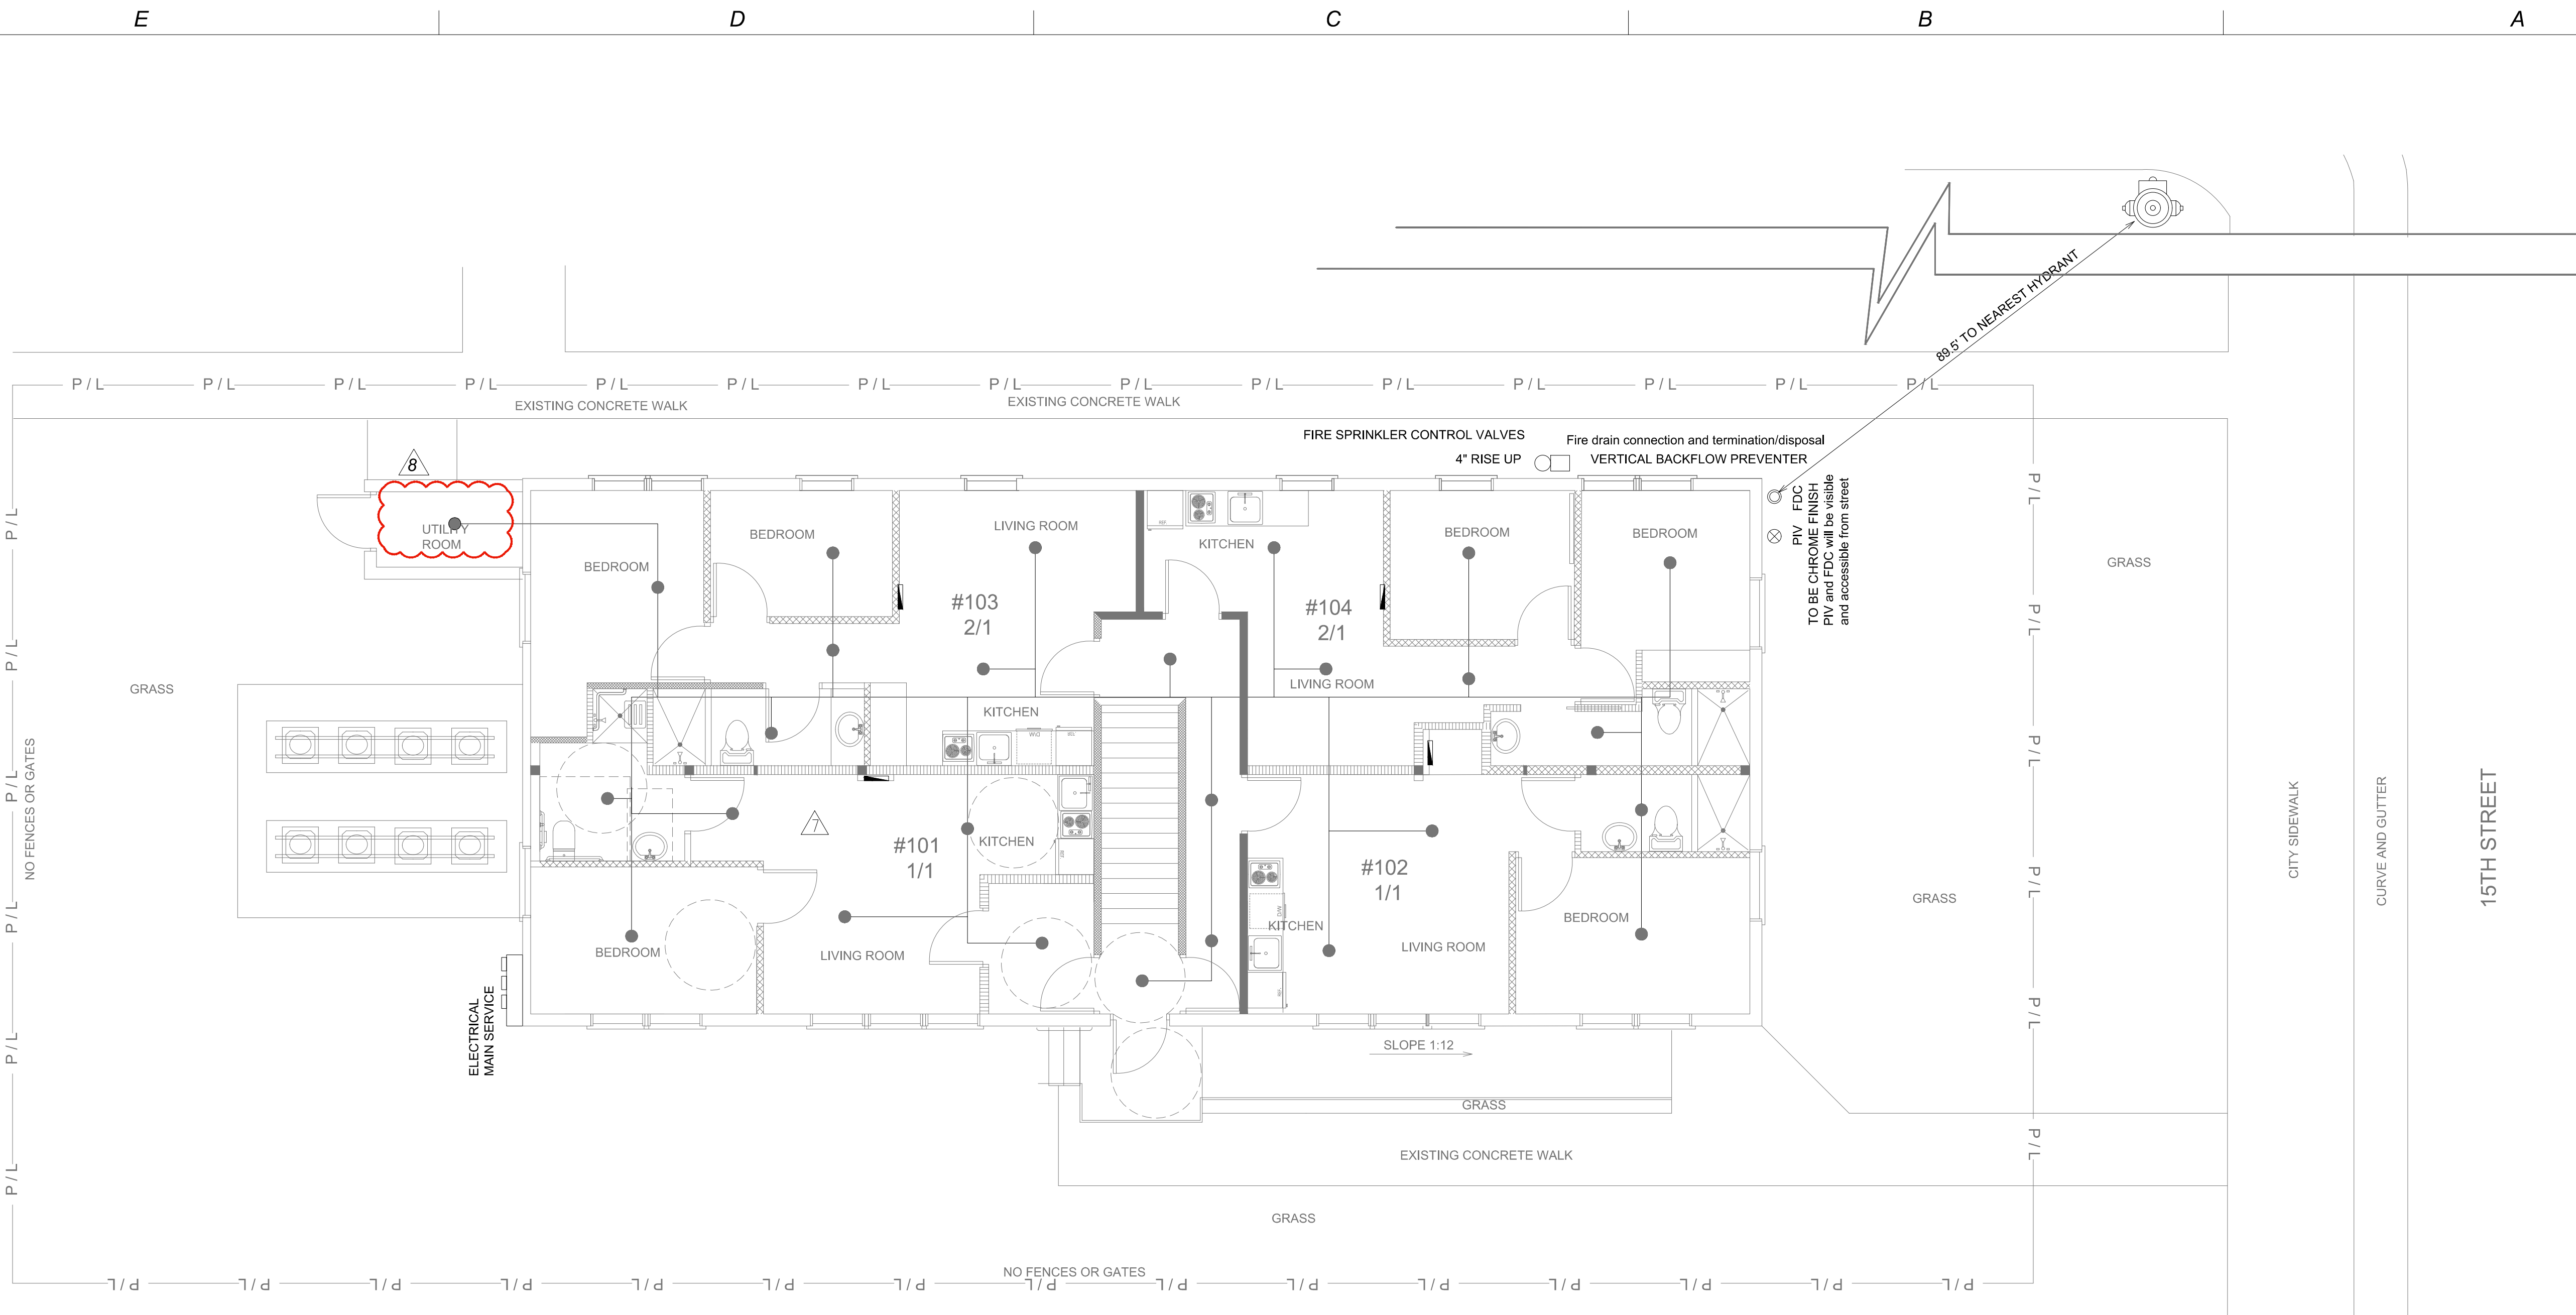

FIRST (GROUND) FLOOR PLAN

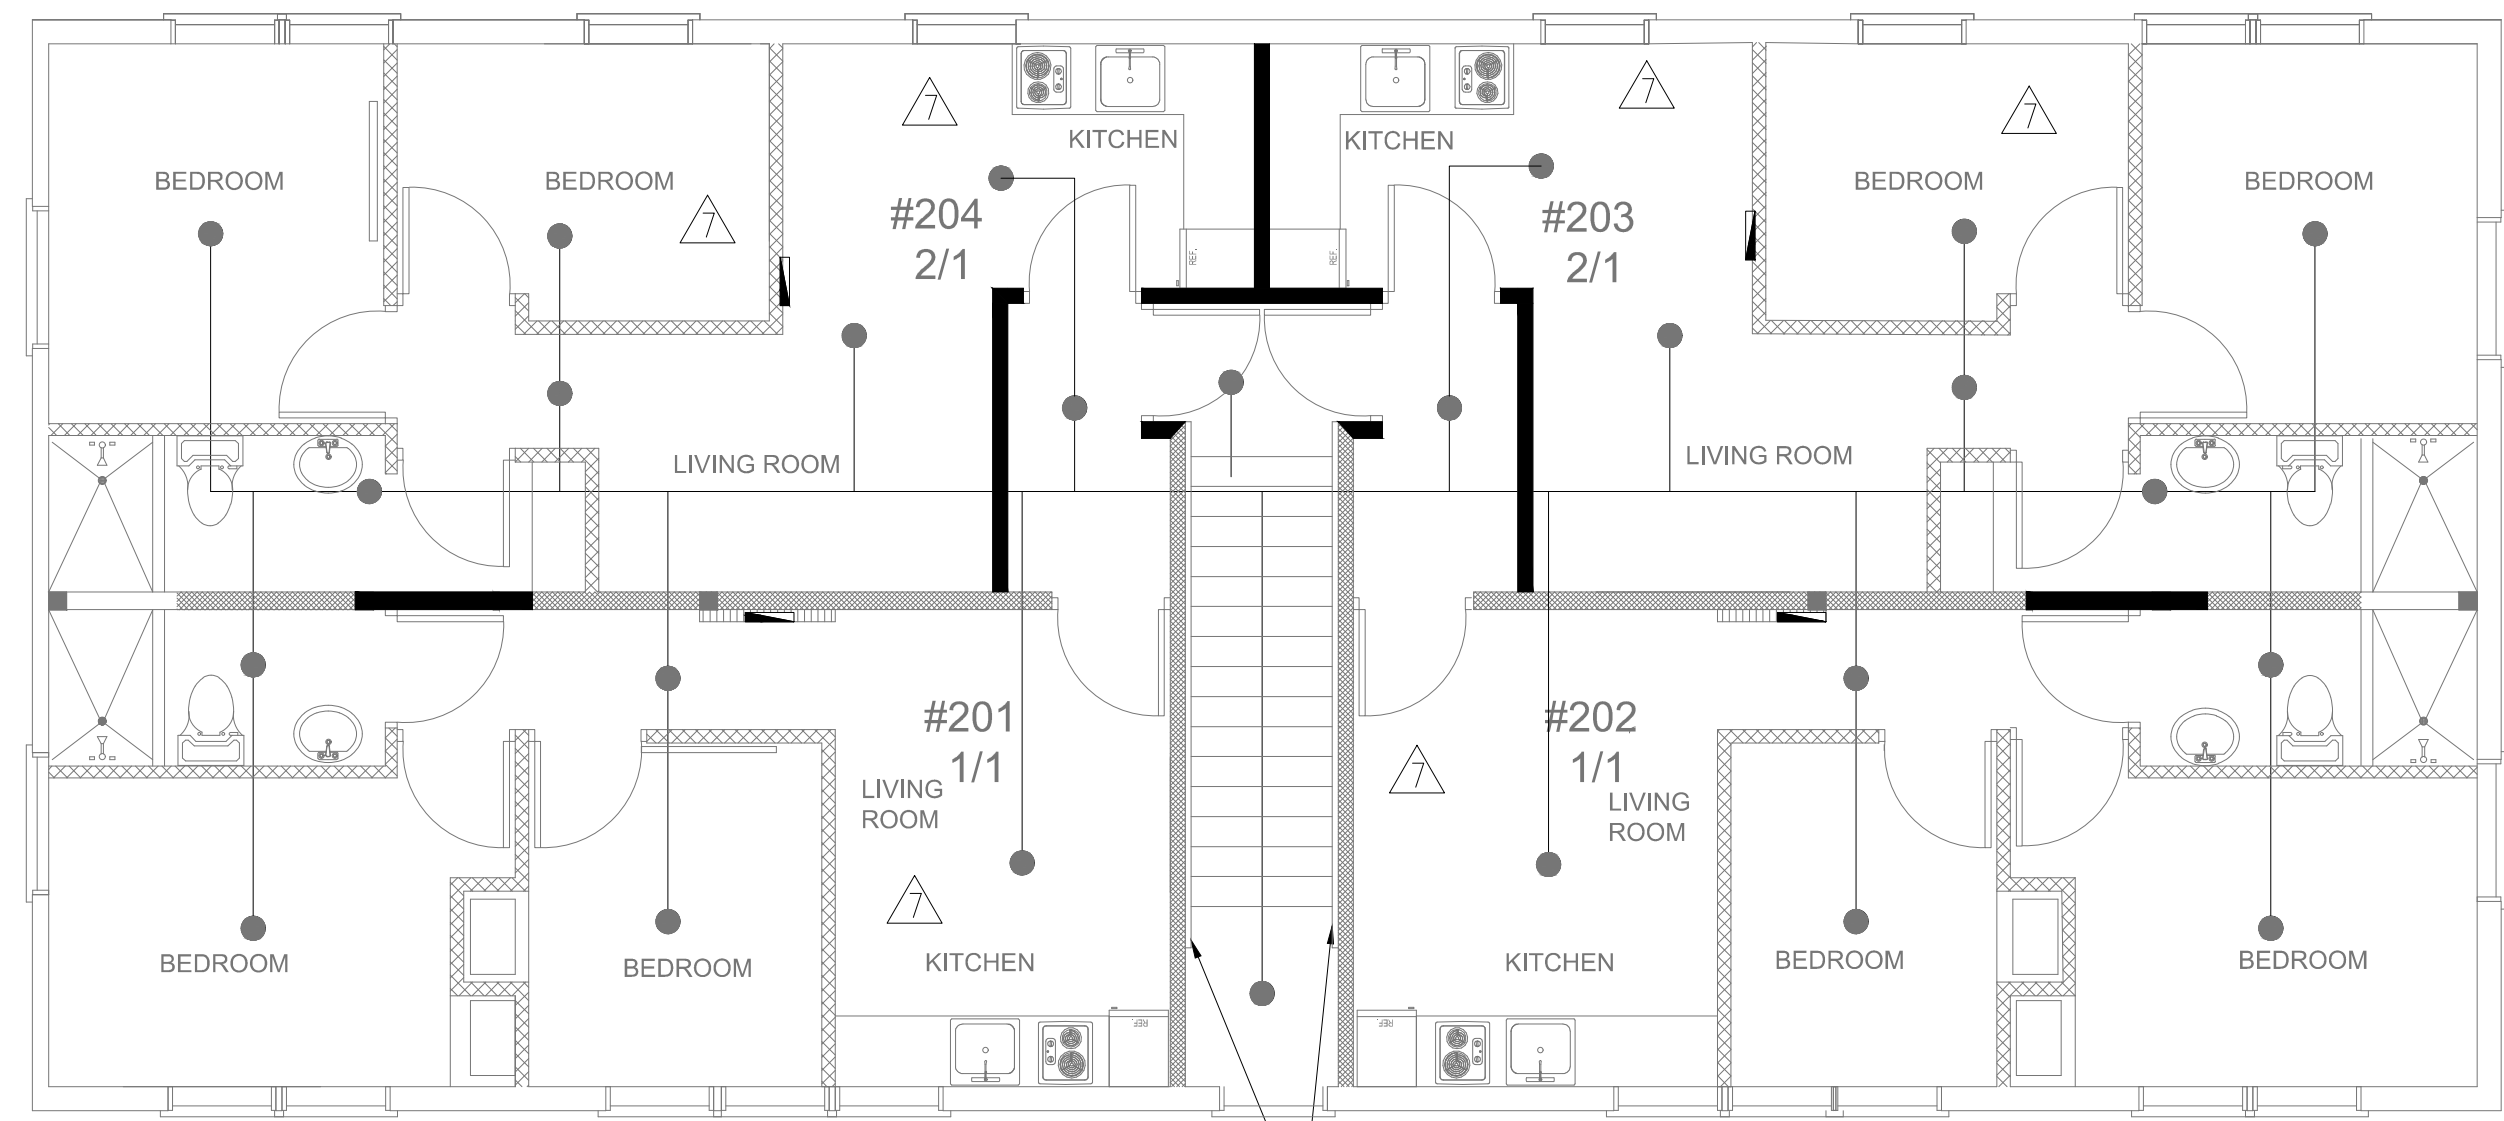

SECOND FLOOR PLAN

SCALE: 3/16" = 1'-0"

NOTES:

Shop drawings will be provided for permitting which will include the required details, cut sheets, hanger locations, and calculations based on current city water flow test result.

Fire Sprinklers and the fire line service connection shall be under separate permit, and drawings will be provided.

Any work and/or use of equipment and/or improvements form/to the right of way including landscaping and irrigation, will require a separate CMB Public Works Department right-of-way construction permit.

The FDC and PIV will be visible and accessible and not be block by any vegetation.

The small attic space is not accessible and is not combustible.

PROJECT:

1330 Building

1330 15th Street, Miami Beach, FL 33139

PROJECT OWNER :

NOTUS, LLC
435 21st Street, Miami Beach, FL 33139

ARCHITECT OF RECORD:



RD Architects

1800 SW 1st Avenue, Suite 607, Miami, Florida 33129
P: 786.762.2679 F: 305.831.8079 C: 305.282.0005
Email: rda@rda-archint.com
www.rda@rda-archint.com / AA26002510


CONSULTANT ENGINEER:

KEY PLAN



SIGNATURE / DATE / SEAL

NOT VALID IF
MISSING
SIGNATURE

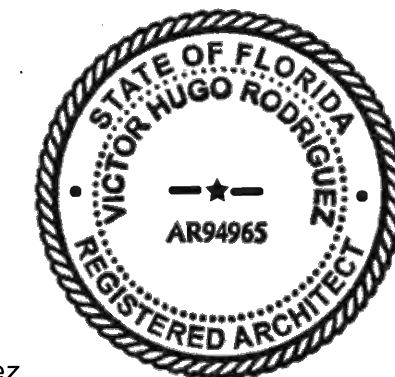

Victor H. Rodriguez,
Registered Architect
State of Florida # AR0094965
305.282.0005 vh.rodriguez@rda-archint.com

PERMIT SET

Issue, Issue Date / For

① 09.12.2016 / Change of Architect

⑥ 02.19.2018 / City Comments

⑦ 04.20.2018 / Reviewer Comments

⑧ 05.29.2018 / Reviewer Comments

DDCI Project #: 1628.00

Drawn by: VHR

Approved by: VHR

SHEET INDEX

4 - Fire Protection Levels 1 and 2

SCALE :

SHEET NO.

FP-1

6

THE DESIGNS INDICATED IN THESE DRAWINGS ARE PROPERTY OF RD Architects. ALL COPYRIGHTS RESERVED © 2016

1



2

3


4

FIRE SPRINKLER HEAD SCHEDULE					
	TYPE	ORIFICE SIZE	TEMP RATING	K FACTOR	MANUFACTURER & MODEL
○	SEMI-RECESSED PENDENT SPRINKLER HEAD	1/2"	155° F	5.6	TYCO, QUICK RESPONDE MODEL TY3234
○	UPRIGHT GLASS BULB	1/2"	155° F	5.6	TYCO, QUICK RESPONDE MODEL TY3131
⊗	EXTENDED COVERAGE UPRIGHT SPRINKLER HEAD	3/4"	155° F	5.6	TYCO, QUICK RESPONDE MODEL TY3131 EXTENDED COVERAGE
◁	SIDEWALL GLASS BULB	1/2"	155° F	4.2	TYCO, QUICK RESPONDE MODEL TY1334


FIRE HOSE VALVE DETAIL
NTS

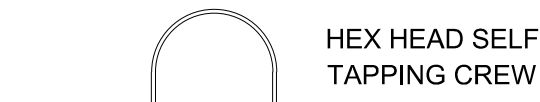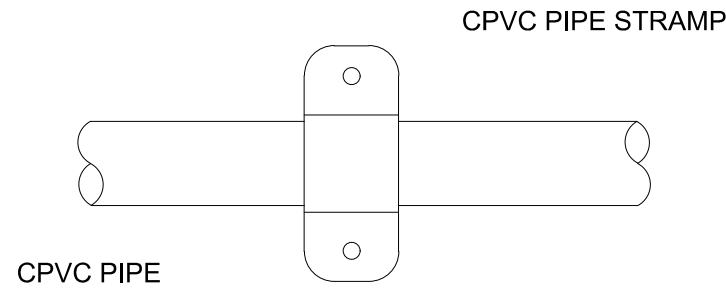



DOUBLE FASTENER
CPVC PIPE STRAP

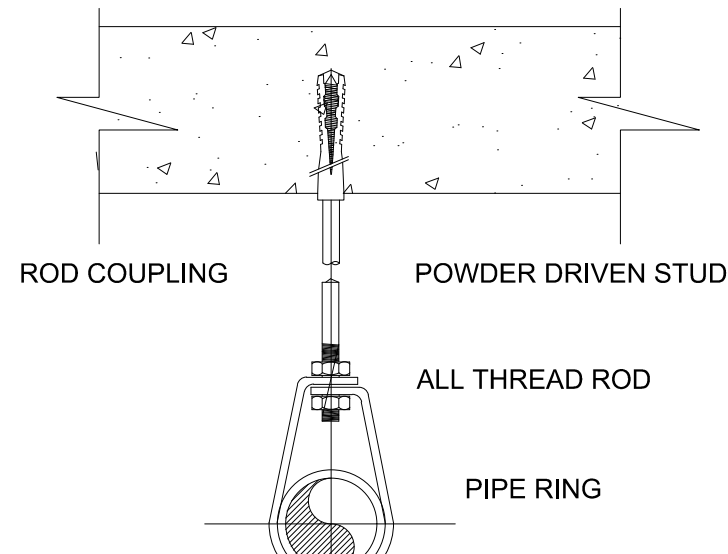

DRILLER CONC. ANCHOR
HANGER

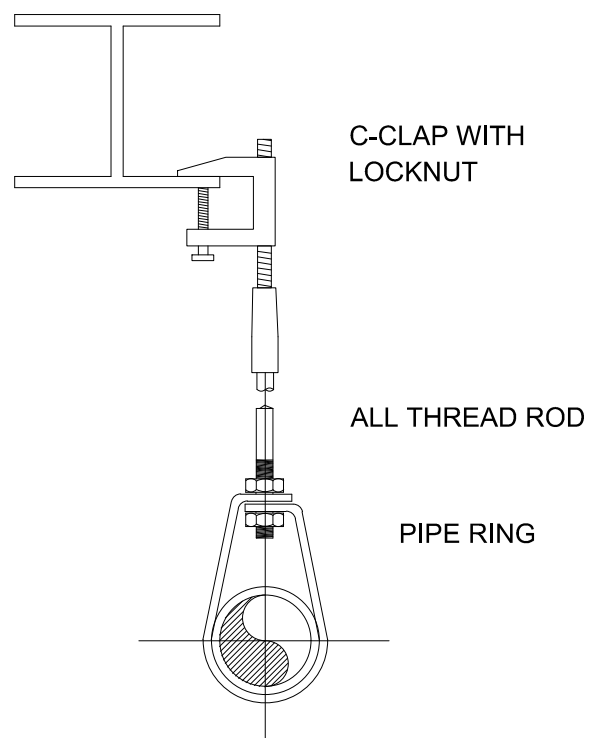

C-CLAMP HANGER

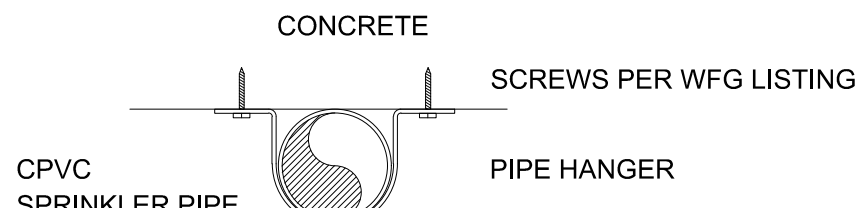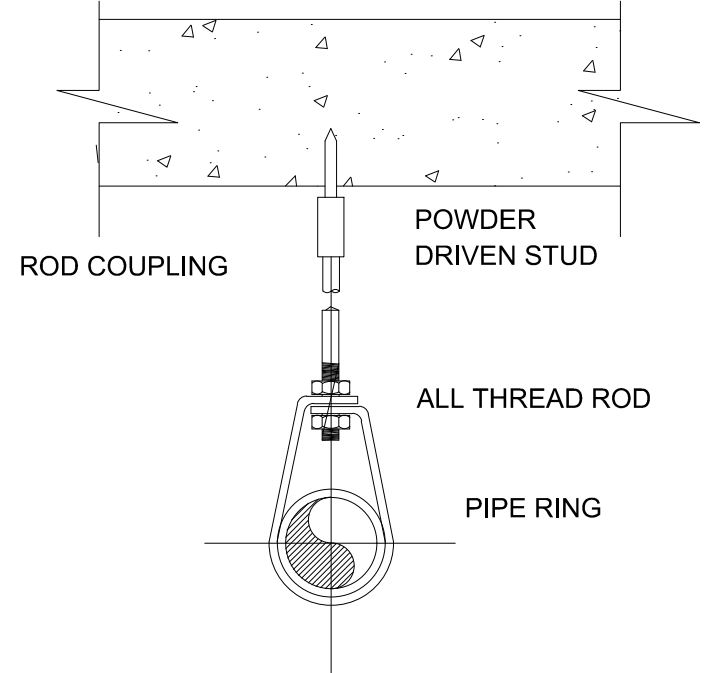

DOUBLE FASTENER
CPVC PIPE STRAP
N.T.S.

AUTO SPRINKLER
MIN 1" RAISED LETTERS

CHECK VALVE


FINISHED GRADE

4" PVC UNDERGROUND
FIRE MAIN TO SYSTEM
SEE PLAN FOR CONT.


4" PIPE

WOOD FRAMING
SANNY SIDEWINDER


3/6" A.T.R.
BAND HANGER

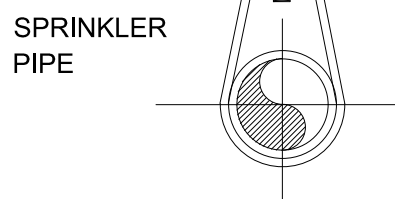


WOOD FRAME
HANGER DETAIL
N.T.S.

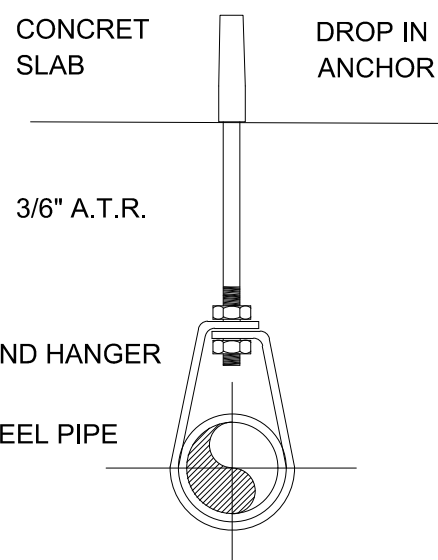

CONCRETE
HANGER DETAIL
N.T.S.

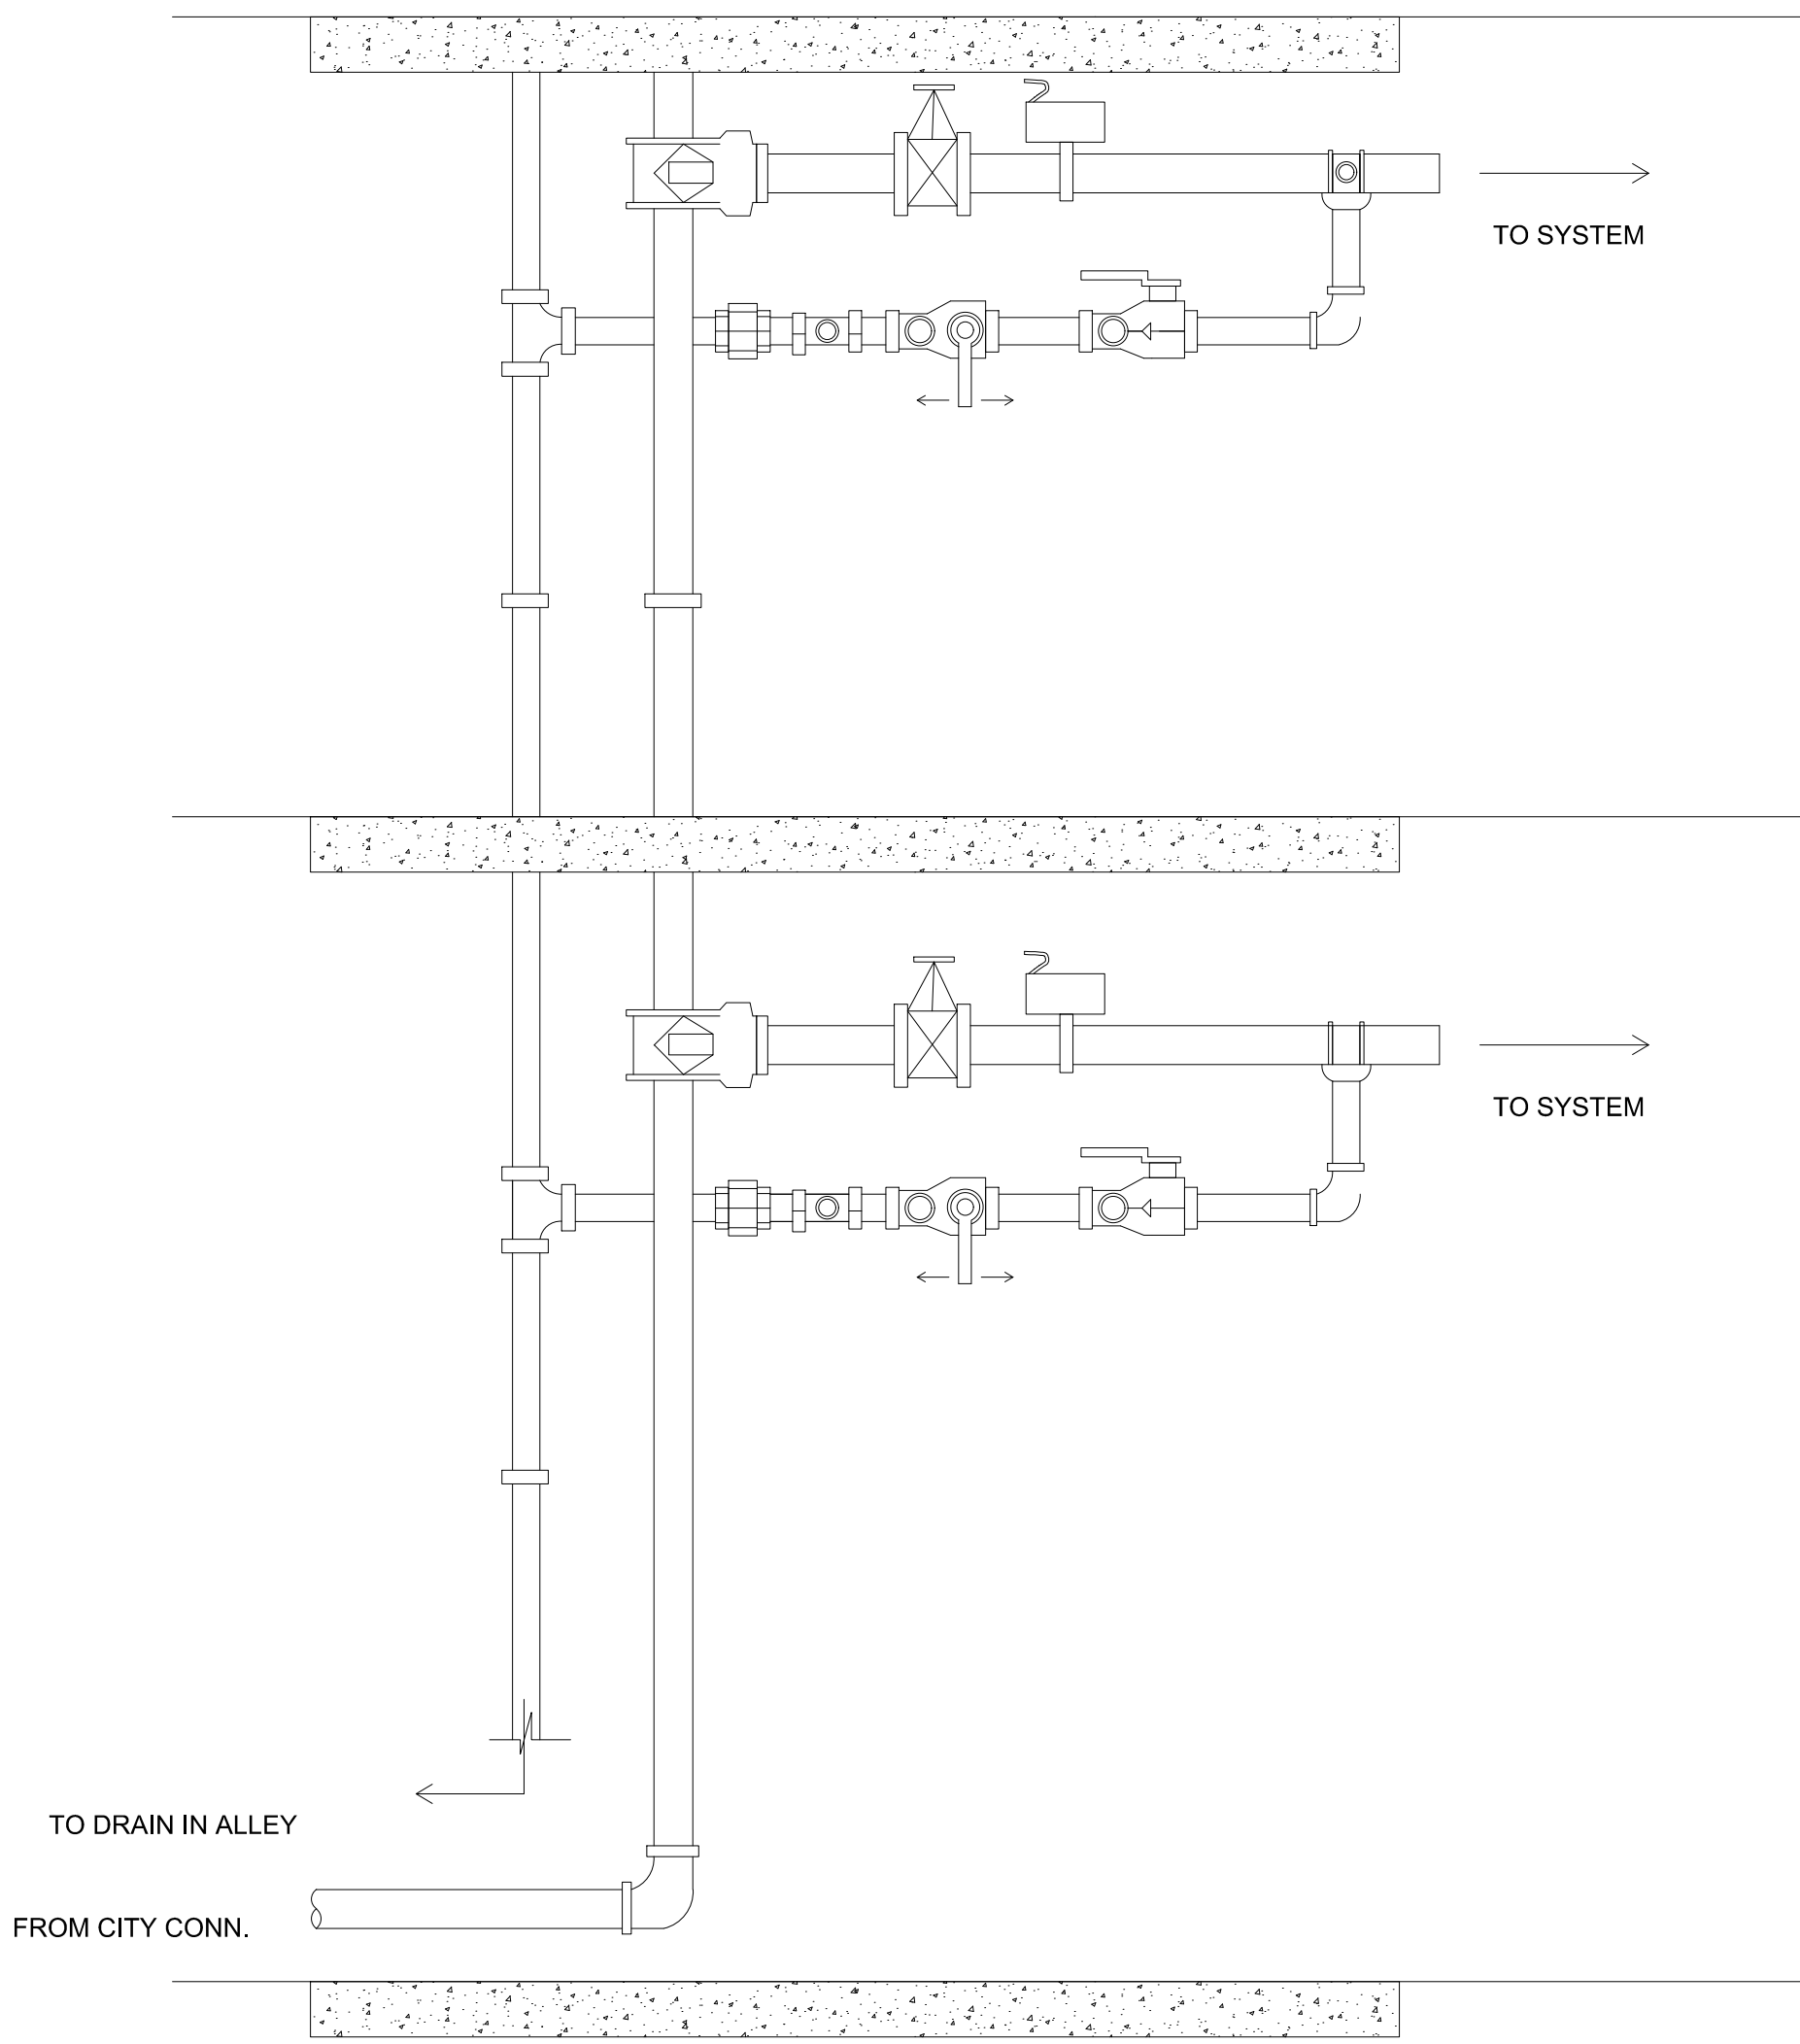

TYPICAL SECTION

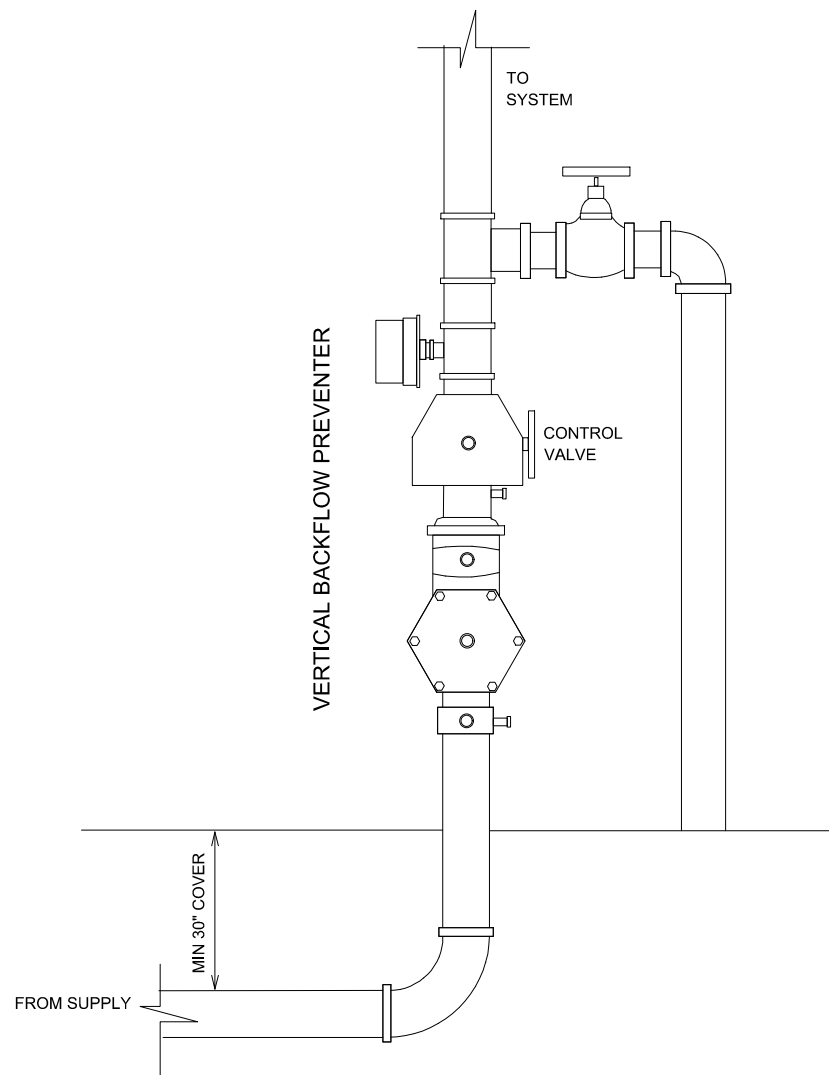

PROJECT:

1330
Building

1330 15th Street, Miami Beach, FL 33139

PROJECT OWNER :

NOTUS, LLC
435 21st Street, Miami Beach, FL 33139

ARCHITECT OF RECORD:



RD Architects

1800 SW 1st Avenue, Suite 607, Miami, Florida 33129
P: 786.762.2679 F: 305.831.8079 C: 305.282.0005
Email: rda@rda-archint.com
www.rda@rda-archint.com / AA26002510

CONSULTANT ENGINEER:


2

KEY PLAN



SIGNATURE / DATE / SEAL

NOT VALID IF
MISSING
SIGNATURE

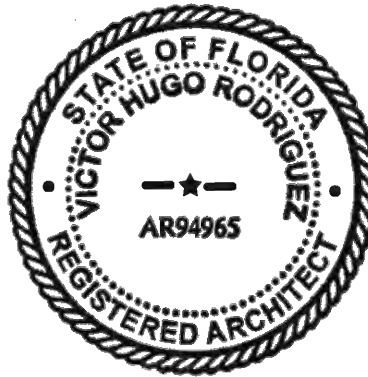

Victor H. Rodriguez,
Registered Architect
State of Florida # AR0094965
305 . 282 . 0005 - vh.rodriguez@rda-archint.com

PERMIT SET

Issue, Issue Date / For

04.20.2018 / Reviewer Comments

DDCI Project #: 1628.00

Drawn by: VHR

Approved by: VHR

SHEET INDEX

4 - Fire Sprinklers Details
- Schedule

SCALE :

SHEET NO.

FP-2

© 2016 RDA