


EXISTING ELEVATION


SCALE: 3/32"=1'-0"

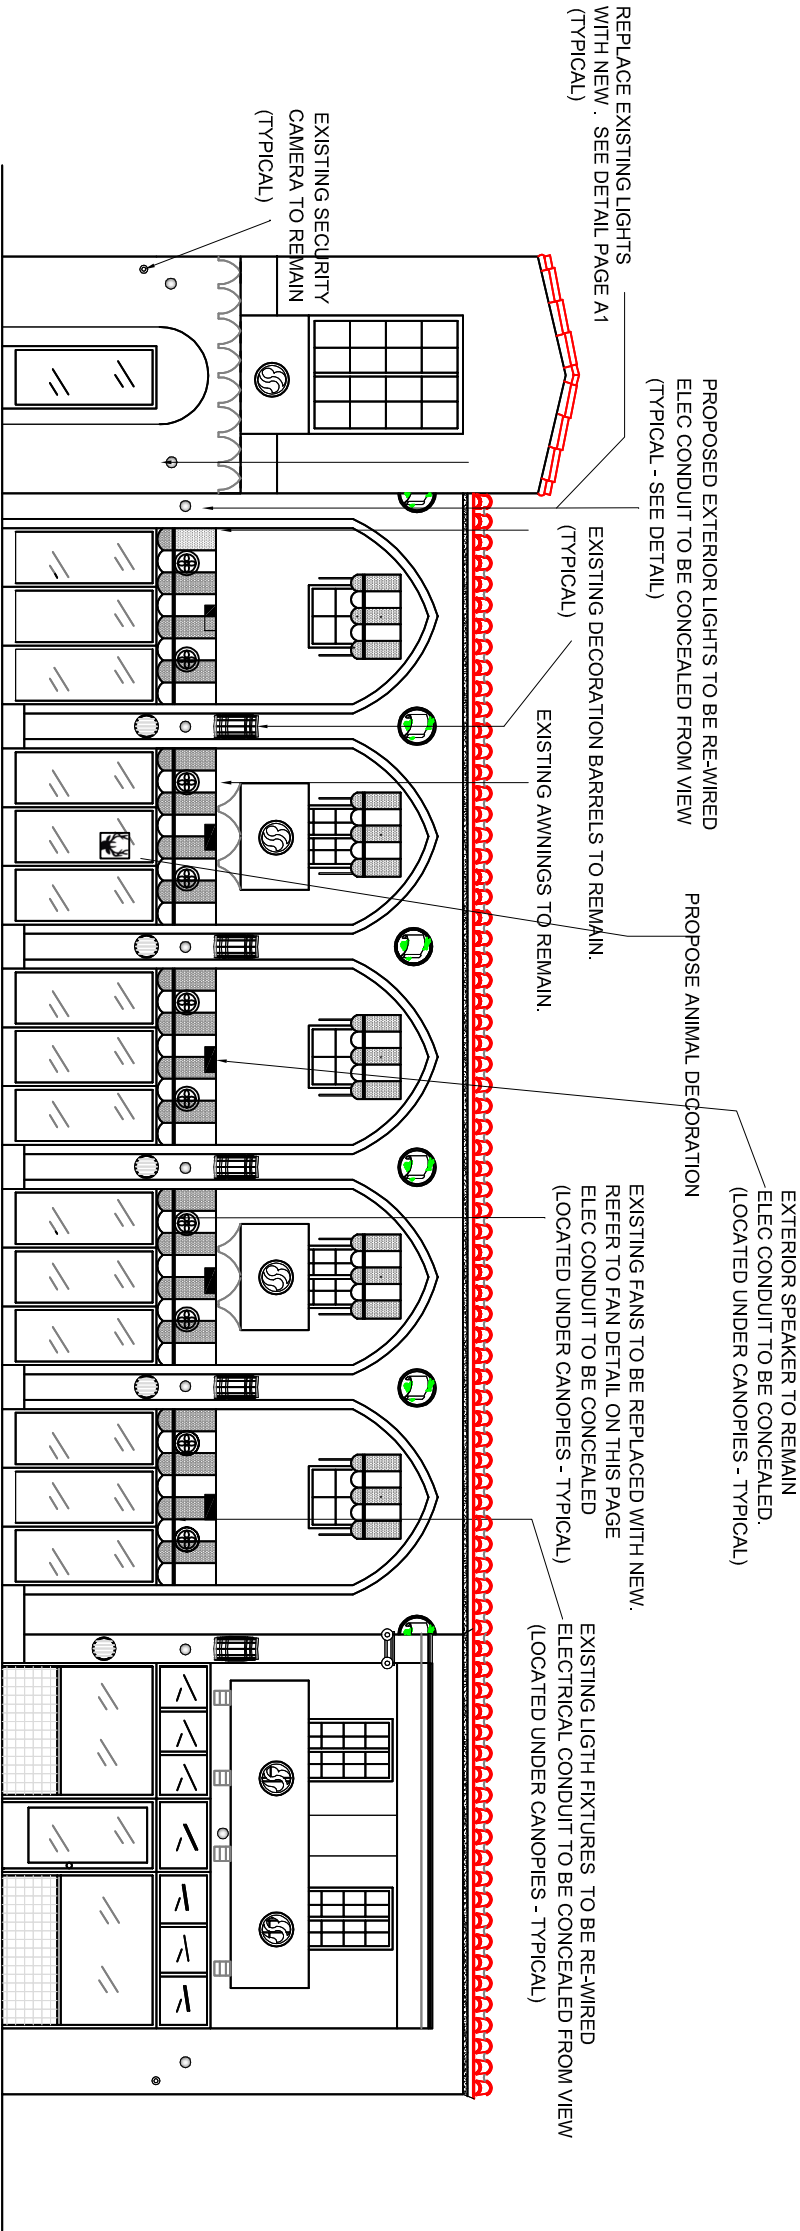

PROPOSED (AS BUILT) ELEVATION

SCALE: 3/32"=1'-0"

- MELODY WALL FAN. SEE DETAIL @ THIS PAGE
- BARREL TOP.
- BARREL FROT.
- CAMERA.
- ECLIPSE 2 LIGHT FLUSH MOUNT. SEE DETAIL @ THIS PAGE
- SPEAKER -EXISTING TO REMAIN.
- ORNAMENTAL DIE.
- ORNAMENTAL RELIEF.

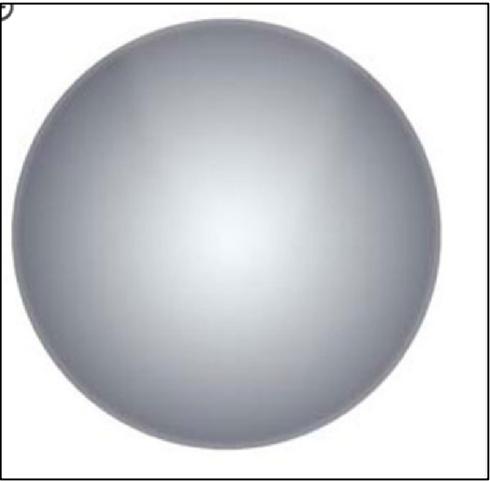

LIGHT FIXTURE DETAIL

PROPOSED


SCALE: nts



FAN FIXTURE DETAIL


PROPOSED

SCALE: nts

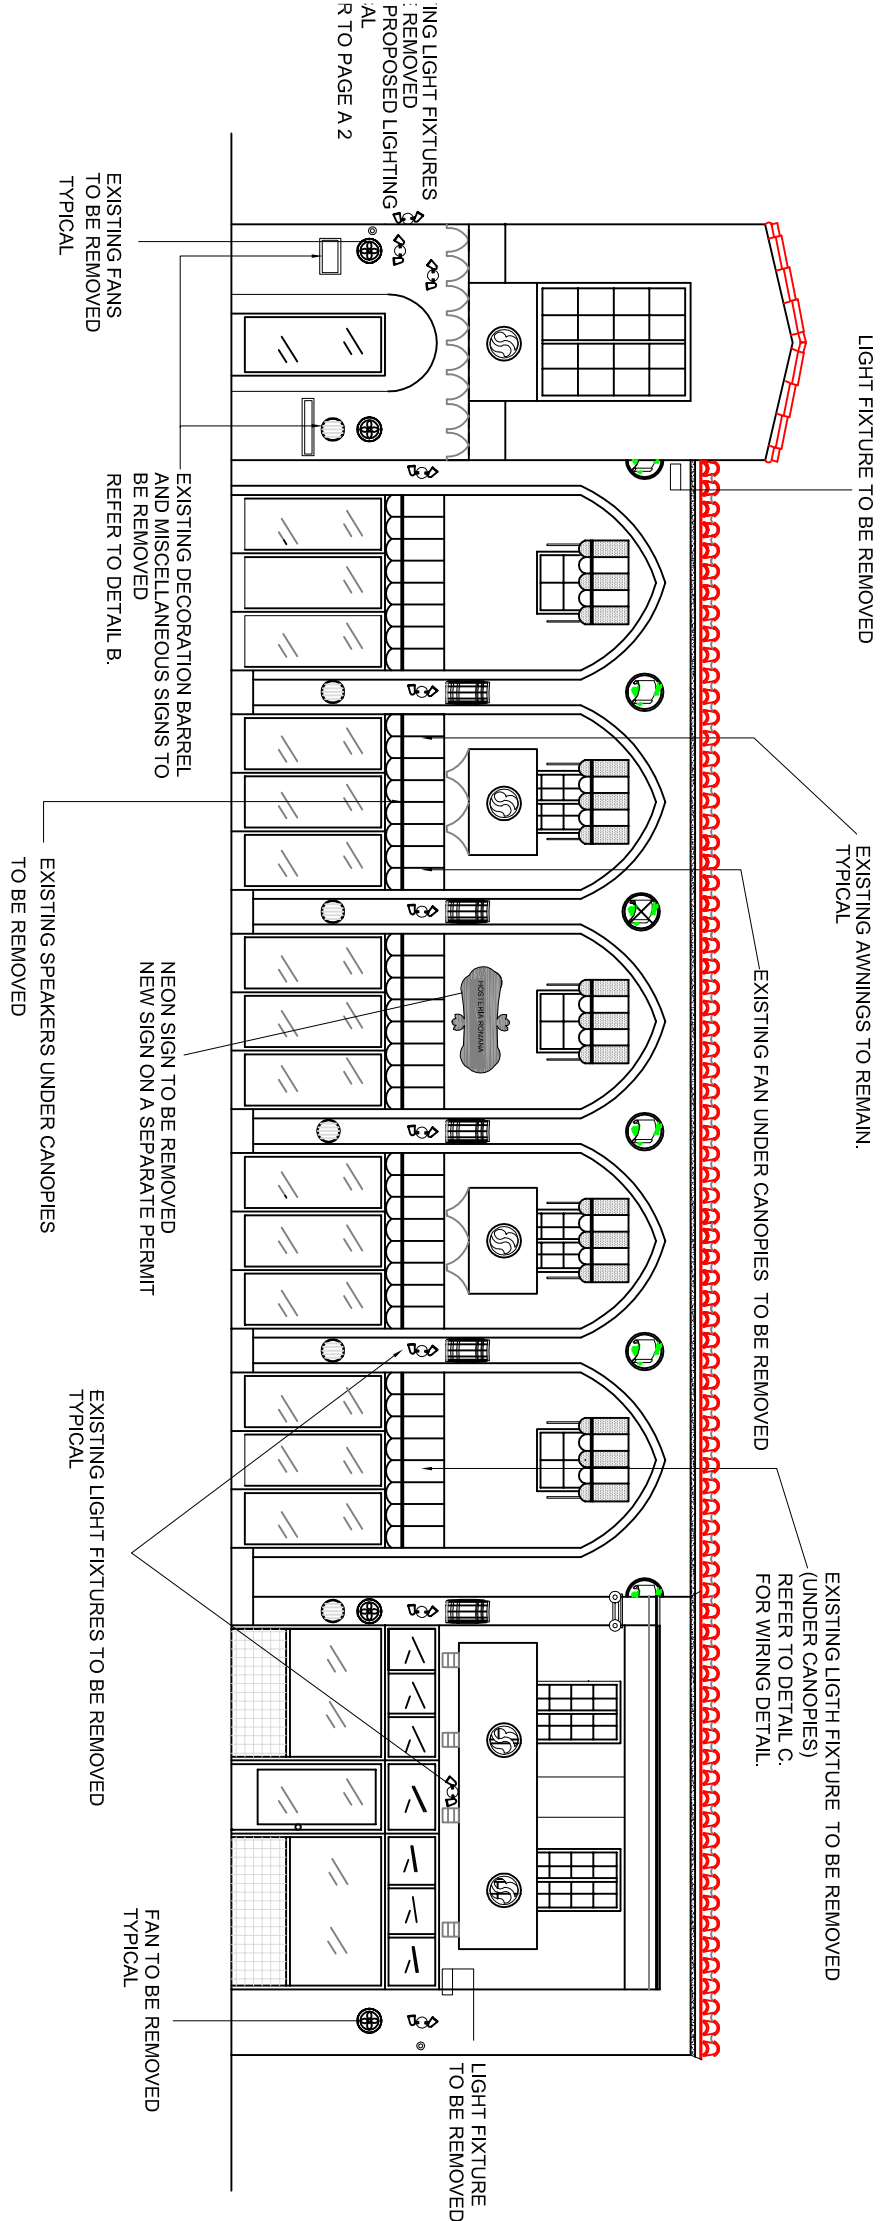

ELEVATION –PARTIAL DEMOLITION FLOOR PLAN SHOWING EXISTING CONDITIONS

SCALE: 3/32"=1'-0"

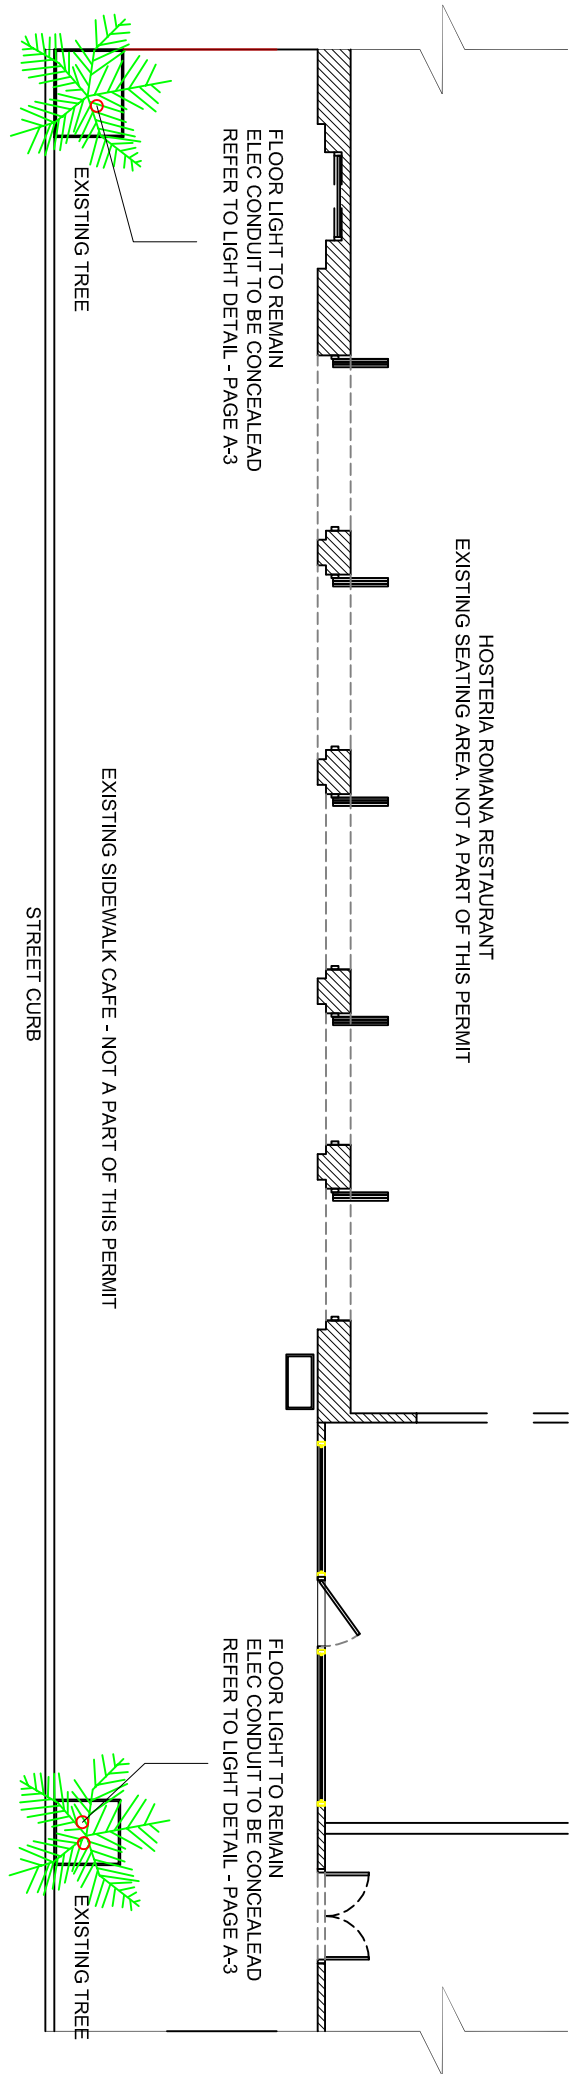


SIDEWALK SHOWING PROPOSED TO REMAIN FLOOR LIGHTING

SCALE: 3/32"=1'-0"

ELECTRICAL WIRING DETAIL

SCALE: NTS

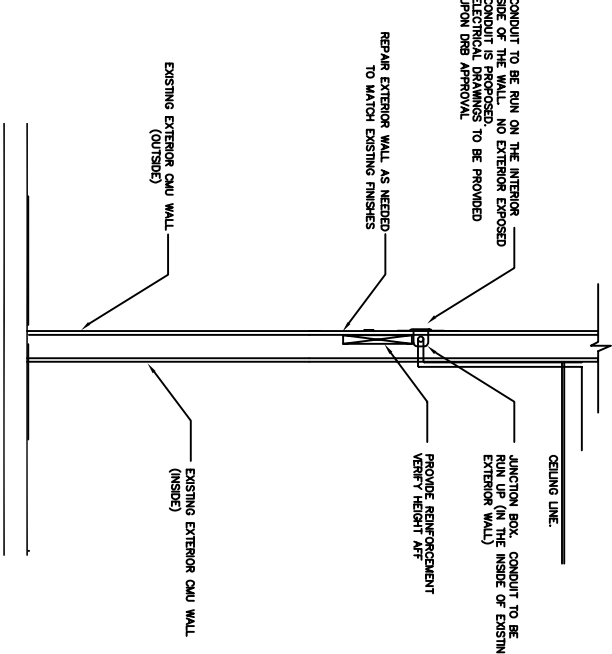

L.I.M. DESIGN GROUP
ARCHITECTURE & INTERIORS, P.A.
DANIEL L. ROBERTSON, P.A., LICENSE NUMBER: 3911725
MEMBER A.I.A. LICENSE NUMBER: AA002490
1000 Metrop Avenue Suite 910 Miami Beach, FL 33139
PHONE 305.1872-5555
FAX 305.1872-5555
WWW.HRDESIGN.COM EMAIL: HRDESIGN@THEBEACH.NET

HOSTERIA ROMANA
429 ESPAÑOLA WAY
MIAMI BEACH, FLORIDA 33139

| | |
|-------------------|---|
| COMMISSION NUMBER | 0 |
| BID SET | |
| PERMIT SET | |
| REVISIONS | |
| FINAL SUBMITTAL | |
| MARCH 3, 2015 | |
| | |
| | |
| | |
| | |

