
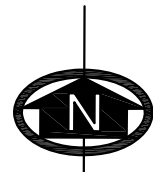


SKETCH OF BOUNDARY SURVEY


SCALE: 1" = 20'

CANAL

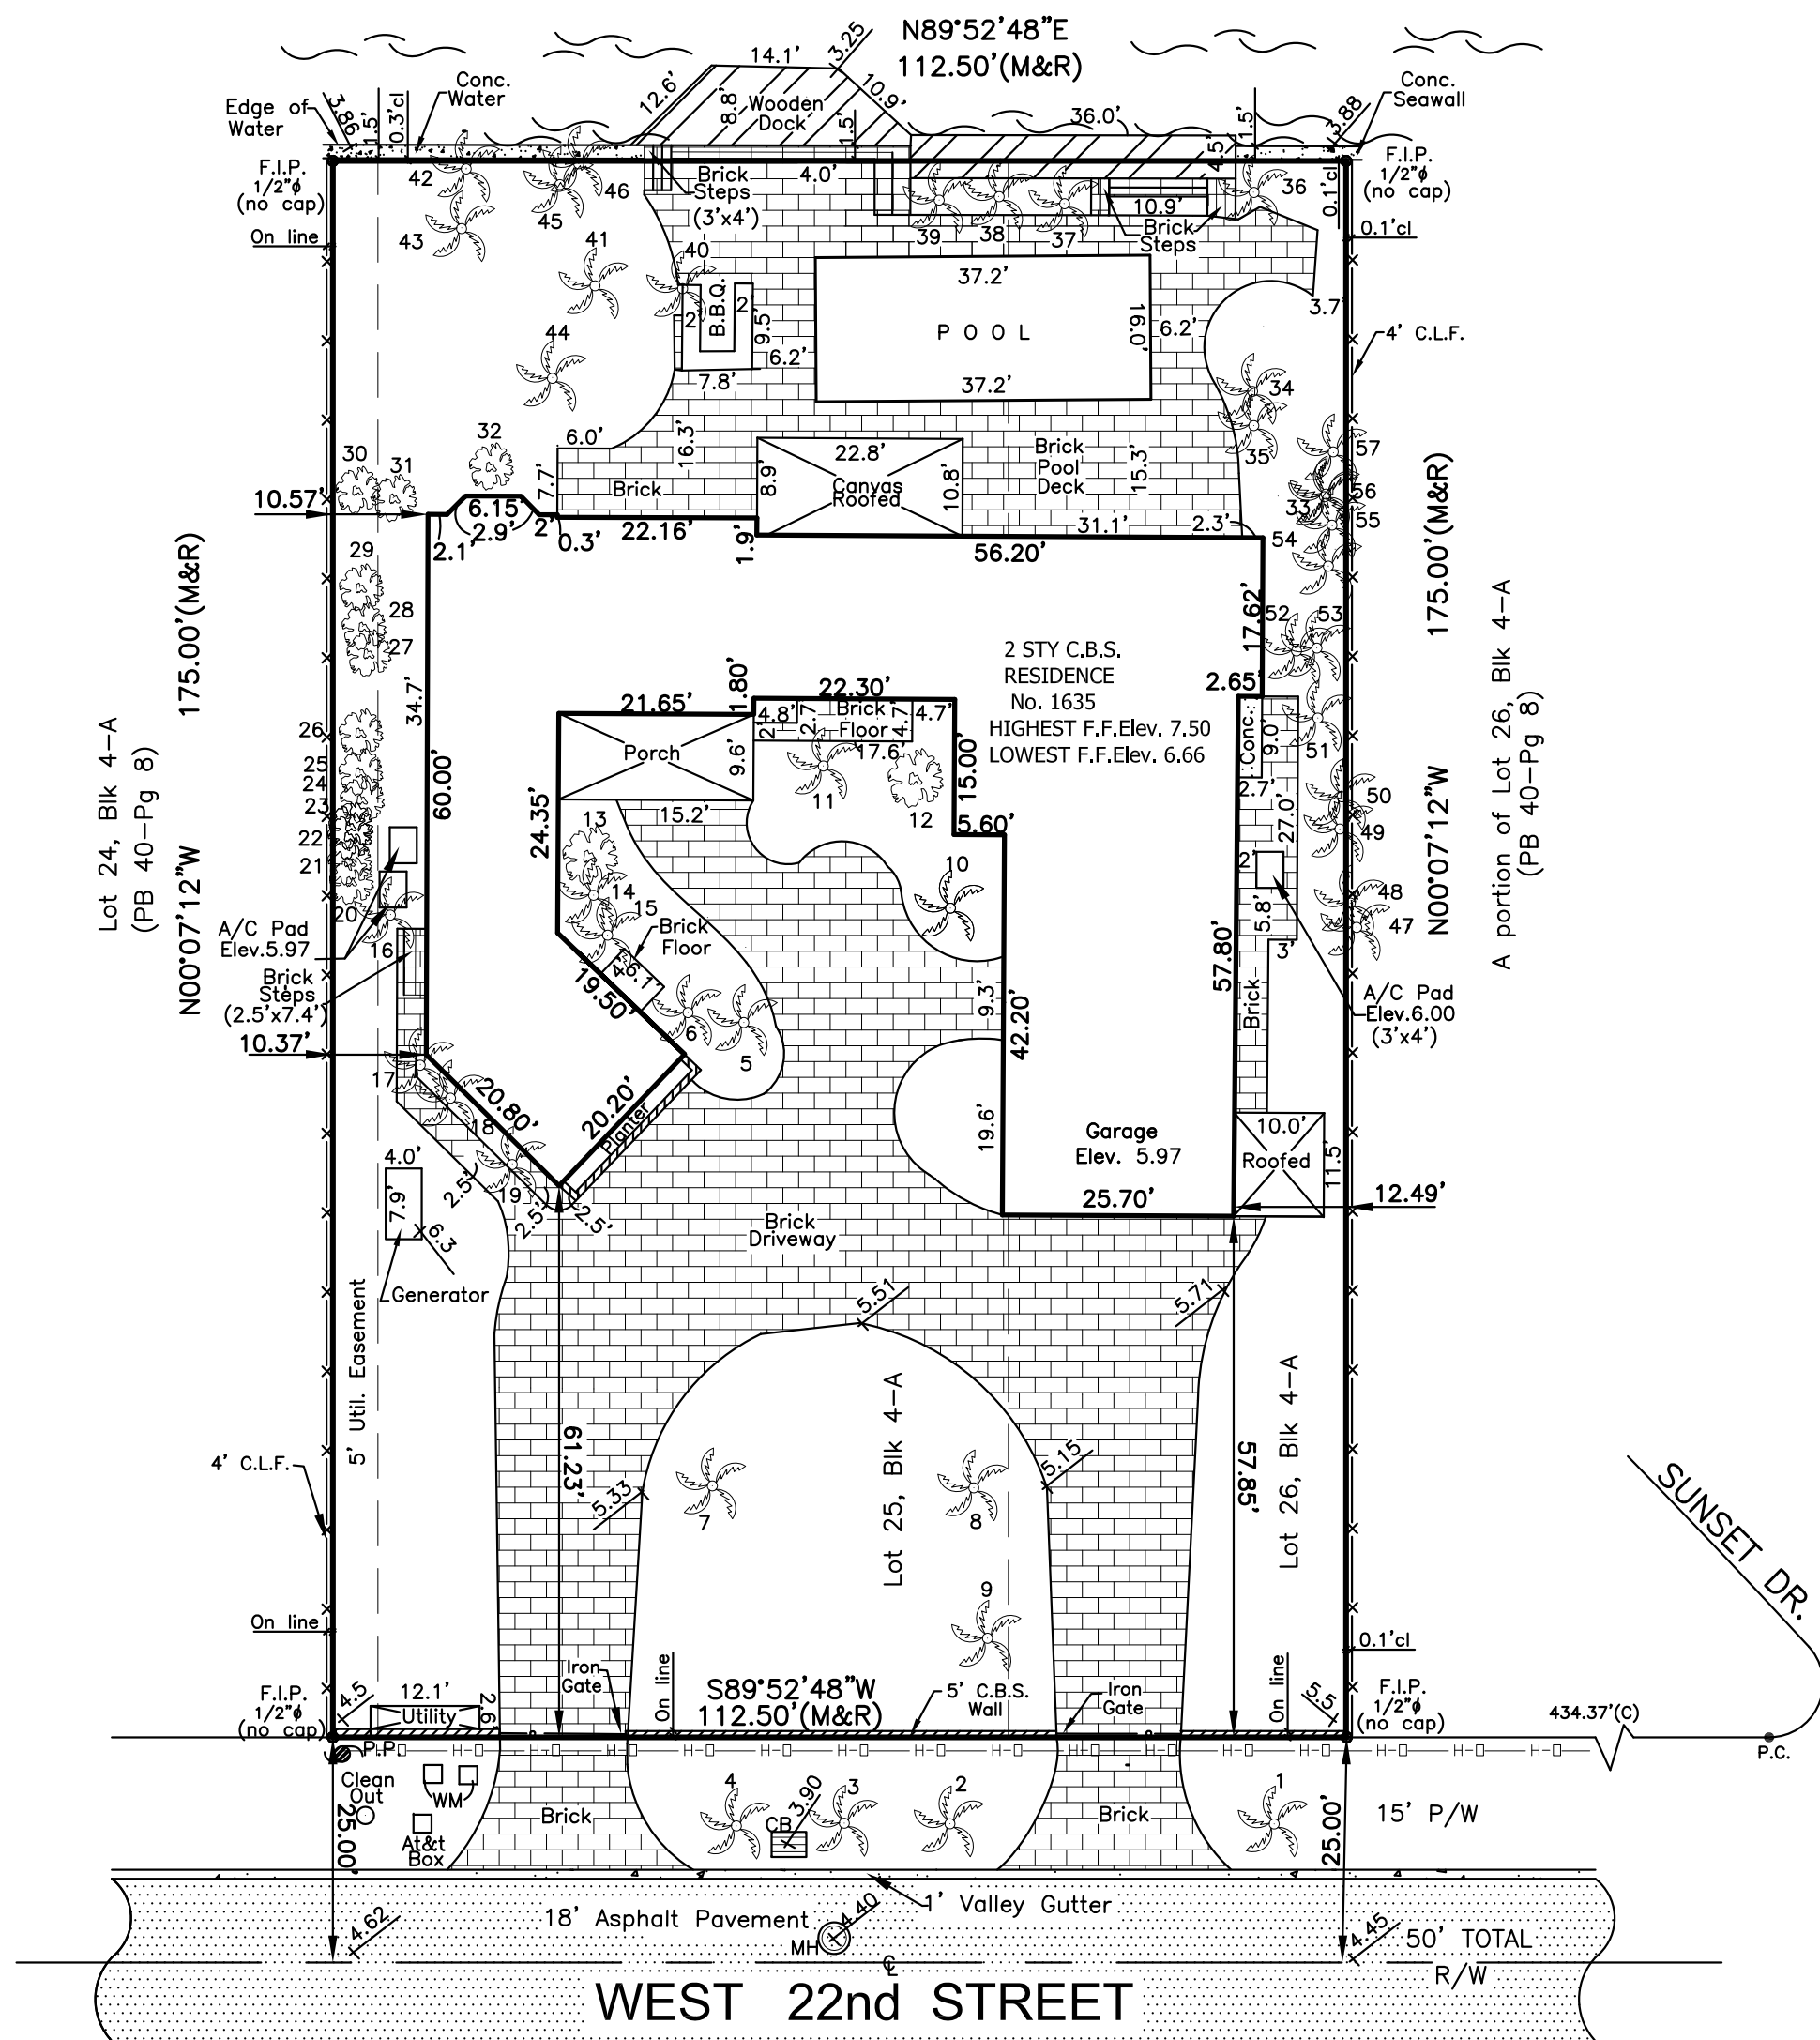

LOCATION MAP

SCALE: NTS

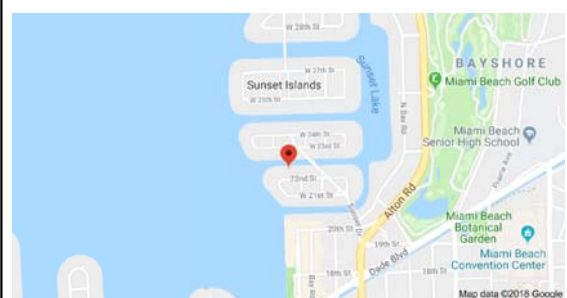

SITE PICTURE



ABBREVIATION (IF ANY APPLIED)

A = CURVE
A/C = AIR CONDITIONING UNIT
ASPH. = ASPHALT
B.M. = BENCH MARK
B/COR = BLOCK CORNER
CALC(C) = CALCULATED
CB = CATCH BASIN
C.B.S. = CONCRETE BLOCK STRUCTURE
CL = CLEAR
CONC. = CONCRETE
D.M.E. = DRAINAGE MAINT. EASEMENT
ELEV. = ELEVATION
EASMT. = EASEMENT
F.I.P. = FOUND IRON PIPE
F.N/D = FOUND NAIL AND DISC
F.S. = FOUND SPIKE
L.P. = LIGHT POLE
MEAS(U) = MEASURED
MH = MANHOLE
M = MONUMENT
NTS = NOT TO SCALE
P/W = PARAWAY
P.O.B. = POINT OF BEGINNING
P.O.C. = POINT OF COMMENCEMENT
P.C. = POINT OF CURVATURE
P.I. = POINT OF INTERSECTION
P.L. = PROPERTY LINE
P.P. = POWER POLE
P.R.M. = PERMANENT REFERENCE MONUMENT
P.T. = POINT OF TANGENCY
RAD. = RADIAL
REC. (R) = RECORDED
RES. = RESIDENCE
R/W = RIGHT OF WAY
SEC. = SECTION
S.D/H = SET DRILL HOLE
S.N/D = SET NAIL AND DISC
S.I.P. = SET IRON PIPE
S.R.B. = SET REBAR
S.T.Y. = STORY
SWC = SIDEWALK
T.O.P. = TOP OF BANK
U.E. = UTIL. EASEMENT
W.P. = WOODEN POLE
S = SECTION LINE

SURVEYOR'S LEGEND (IF ANY APPLIED)

BOUNDARY LINE
STRUCTURE (BLDG.)
CONCRETE BLOCK WALL
METAL FENCE
WOODEN FENCE
CHAIN LINK FENCE
WOOD DECK/DOCK
ASPHALTED AREAS
CONCRETE
BRICKS OR PAVERS
ROOFED AREAS
WATER (EDGE OF WATER)
CATCH BASIN
MANHOLE
OVERHEAD ELECT.
POWER POLE
LIGHT POLE
HANDICAP SPACE
FIRE HYDRANT
EASEMENT LINE
WATER VALVE
TV-CABLE BOX
WATER METER
CONC. LIGHT POLE

JOB SPECIFIC SURVEYOR NOTES:

- THE PROPERTY DESCRIBED ON THIS SURVEY DOES LIE WITHIN A SPECIAL HAZARD AREA AS DEFINED BY THE FEDERAL EMERGENCY MANAGEMENT AGENCY; THE PROPERTY LIES WITHIN A FLOOD ZONE "AE" OF THE FLOOD INSURANCE RATE MAP IDENTIFIED AS COMMUNITY PANEL No. **120651-0317L**, WITH AN EFFECTIVE DATE OF SEPTEMBER 11, 2009. **BASE FLOOD ELEVATION OF 8.00 FEET** (NGVD)
- LAND AREA OF SUBJECT PROPERTY: **19,688 SF (+/-)**
- ELEVATIONS ARE BASED ON THE NATIONAL GEODETIC VERTICAL DATUM (NGVD) OF 1929, AS PER MIAMI-DADE COUNTY **BENCH MARK No. D-131**, WITH AN ELEVATION OF **8.73 FEET**.
- BEARINGS SHOWN HEREON ARE BASED ON AN ASSUME MERIDIAN OF N.00°07'12"W., BEING THE RECORDED BEARING FOR THE CENTERLINE OF LUCERNE AVE., AS SHOWN ON PLAT BOOK 40 AT PAGE 8 OF THE PUBLIC RECORD OF MIAMI-DADE COUNTY, FLORIDA.

GENERAL SURVEYOR NOTES:

NOT VALID WITHOUT THE SIGNATURE AND RAISED SEAL OF A FLORIDA LICENSED SURVEYOR AND MAPPER
THE SHOWN LEGAL DESCRIPTION USED TO PERFORM THIS BOUNDARY SURVEY WAS PROVIDED BY THE CLIENT.

SURVEY IS BASED ON RECORDED INFORMATION PROVIDED BY CLIENT. NO SPECIFIC SEARCH OF THE PUBLIC RECORD HAS BEEN MADE BY OUR OFFICE.

UNLESS OTHERWISE NOTED, AN EXAMINATION OF THE ABSTRACT OF TITLE WAS NOT DONE BY THE SIGNING SURVEYOR TO DETERMINE WHICH INSTRUMENTS, IF ANY ARE AFFECTING THE SUBJECT PROPERTY.

THIS SURVEY IS EXCLUSIVELY FOR THE USE OF THE PARTIES TO WHOM IT WAS CERTIFIED.

PURSUANT TO RULE 5J-17 OF THE FLORIDA ADMINISTRATIVE CODE THE EXPECTED USE OF LAND IS SUBURBAN, THE MINIMUM RELATIVE DISTANCE ACCURACY FOR THIS TYPE OF SURVEY IS 1 FOOT IN 7,500 FEET. THE ACCURACY OBTAINED BY MEASUREMENT AND CALCULATIONS OF CLOSED GEOMETRIC FIGURES WAS FOUND TO EXCEED THIS REQUIREMENT.

THERE ARE NO VISIBLE, ABOVE GROUND ENCROACHMENTS (a) BY THE IMPROVEMENTS OF THE SUBJECT PROPERTY UPON ADJOINING PROPERTIES, STREETS OR ALLEYS, OR (b) BY THE IMPROVEMENTS OF THE ADJOINING PROPERTIES, STREETS OR ALLEYS UPON THE SUBJECT PROPERTY OTHER THAN THOSE SHOWN ON THIS BOUNDARY SURVEY.

THERE ARE NO VISIBLE EASEMENTS OR RIGHT-OF-WAY OF WHICH THE UNDERSIGNED HAS BEEN ADVISED OTHER THAN THOSE SHOWN ON THIS SURVEY.

THE MAP OF SURVEY IS INTENDED TO BE DISPLAYED AT THE SHOWN GRAPHIC SCALE IN ENGLISH UNITS OF MEASUREMENT. IN SOME CASES GRAPHIC REPRESENTATION HAVE BEEN EXAGGERATED TO MORE CLEARLY ILLUSTRATE A PARTICULAR AREA WHERE DIMENSIONS SHALL HAVE PREFERENCE OVER GRAPHIC LOCATION.

THE ELEVATIONS (IF ANY) OF WELL-IDENTIFIED FEATURES AS DEPICTED ON THIS SURVEY AND MAP WERE MEASURED TO AN ESTIMATED VERTICAL POSITIONAL ACCURACY OF 1/10 FOOT FOR NATURAL GROUND SURFACES AND 1/100 FOOT FOR HARDSCAPE SURFACES, INCLUDING PAVEMENT, CURBS, SIDEWALKS AND OTHER MANMADE STRUCTURES.

THE SURVEYOR MAKES NO REPRESENTATION AS TO OWNERSHIP, POSSESSION OR OCCUPATION OF THE SUBJECT PROPERTY BY ANY ENTITY OR INDIVIDUAL.

ANY FEMA FLOOD ZONE INFORMATION PROVIDED ON THIS SURVEY IS FOR INFORMATIONAL PURPOSE ONLY AND IT WAS OBTAINED AT WWW.FEMA.COM.

IF YOU ARE READING THIS BOUNDARY SURVEY IN AN ELECTRONIC FORMAT, THE INFORMATION CONTAINED ON THIS DOCUMENT IS ONLY VALID IF THIS DOCUMENT IS ELECTRONICALLY SIGNED AS SPECIFIED IN CHAPTER 5J-17.062 (3) OF THE FLORIDA ADMINISTRATIVE CODE. IF THIS DOCUMENT IS IN PAPER FORMAT, IT IS NOT VALID WITHOUT THE SIGNATURE AND ORIGINAL RAISED SEAL OF THE PROFESSIONAL LAND SURVEYOR AND MAPPER OF RECORD.

LEGAL DESCRIPTION:

LOT 25 AND THE WEST 37.50 FEET OF LOT 26, IN BLOCK 4-A, OF 3rd REVISED PLAT OF SUNSET ISLANDS, ACCORDING TO THE PLAT THEREOF AS RECORDED IN PLAT BOOK 40 AT PAGE 8, OF THE PUBLIC RECORDS OF MIAMI-DADE COUNTY, FLORIDA.

SITE ADDRESS: 1635 W. 22nd ST, MIAMI BEACH, FL. 33140

JOB NUMBER: 18-301

DATE OF SURVEY: MARCH 6, 2018

FOLIO NUMBER: 02-3228-001-1940

ENCROACHMENTS AND OTHER POINTS OF INTEREST:

- THERE ARE NO VISIBLE ENCROACHMENT OF THE SUBJECT PROPERTY
- THERE IS A 5' UTIL. EASEMENT ON THE SIDE OF THE SUBJECT PROPERTY

WE HEREBY CERTIFY THAT THIS BOUNDARY AND TOPOGRAPHICAL SURVEY AND THE SURVEY MAP RESULTING THEREFROM WAS PERFORMED UNDER MY SUPERVISION AND/OR DIRECTION AND IS TRUE AND CORRECT TO THE BEST OF MY KNOWLEDGE AND BELIEF AND FURTHER, THAT SAID "BOUNDARY AND TOPOGRAPHICAL SURVEY" MEETS THE INTENT OF THE APPLICABLE PROVISIONS OF THE "STANDARDS OF PRACTICE FOR LAND SURVEYING IN THE STATE OF FLORIDA", PURSUANT TO RULE 5J-17 OF THE FLORIDA ADMINSTRATIVE CODE AND ITS IMPLEMENTING LAW, CHAPTER 472.027 FO THE FLORIDA STATUTES.



LB 6683

American Services of Miami, Corp.

Consulting Engineers . Planners . Surveyors

9370 S.W. 72nd Street, Suite A-102

Miami, Florida, 33173

PH: (305) 598-5101 FAX: (305) 598-8627

ASOMIAMI.COM



Ed Pino

PROFESSIONAL LAND SURVEYOR

AND MAPPER No. 6771

STATE OF FLORIDA

DATE: MARCH 14, 2018

NOT VALID WITHOUT THE SIGNATURE AND RAISED SEAL OF A FLORIDA LICENSED SURVEYOR AND MAPPER