

LENOX AVENUE PARKING LOT BISONIZA

REAL PROPERTIES LENOX, LLC
MIAMI BEACH, DADE COUNTY, FLORIDA

LEGEND

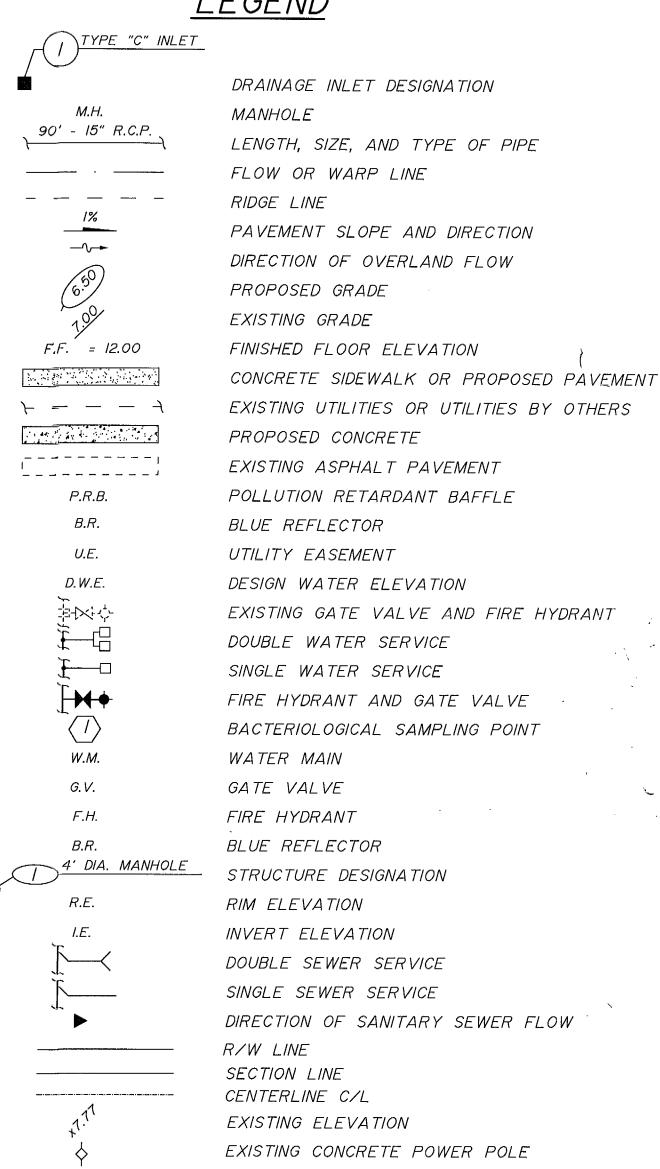

EXISTING WOOD POLE

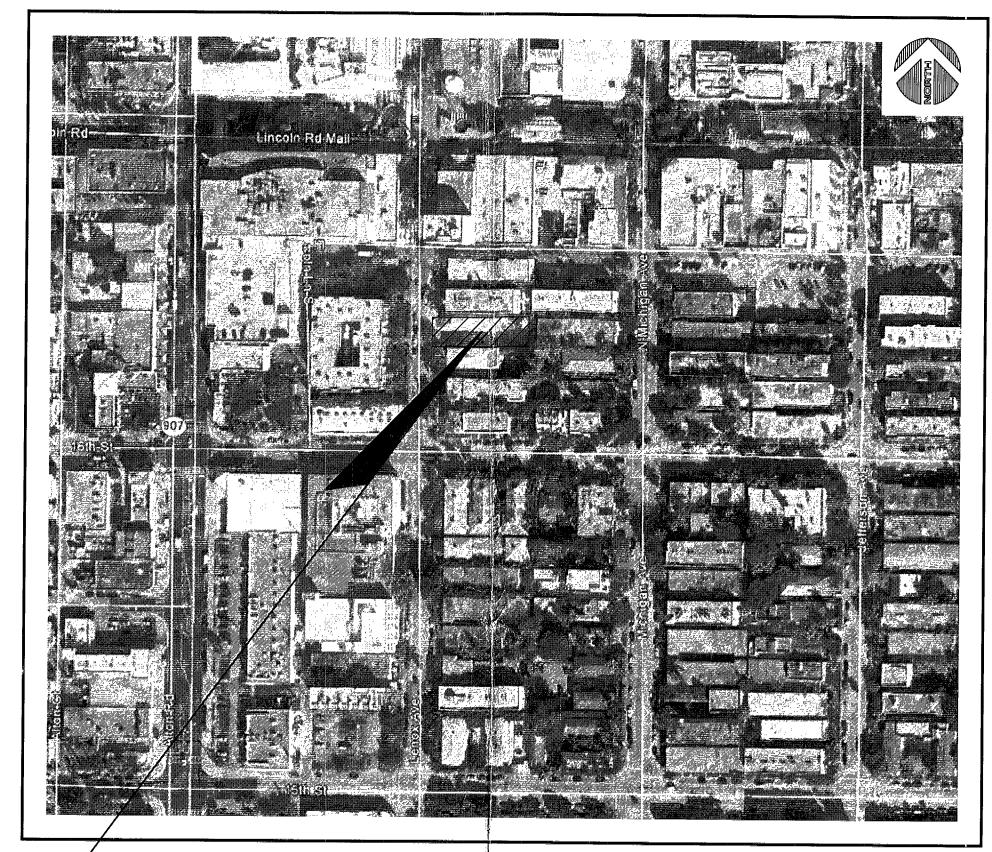


PROJECT LOCATION

LOCATION MAP



2737 Northeast 30th Place Fort Lauderdale, Florida 33306 Phone: (954) 491-7811 Authorization No. EB-26343

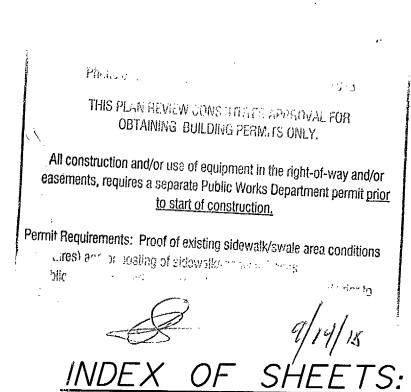

CITY OF MIAMI BEACH

DESCRIPTION:

COVER SHEET

GENERAL NOTES AND SPECIFICATIONS

2

SITE PLAN

PAVING AND DRAINAGE SYSTEM - PLAN, SECTION AND NOTES

7

PAVING AND DRAINAGE SYSTEM - DETAILS

PAVING AND DRAINAGE SYSTEM - DETAILS

PAVEMENT MARKINGS AND SIGNAGE - PLAN AND DETAILS


PROPOSED PARKING LAYOUT

IRRIGATION PLAN

ELECTRICAL PLAN

STORMWATER POLITION PREVENTION - PLAN

8

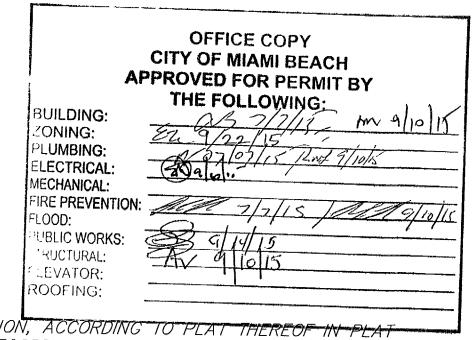

LOT 15, BLOCK 47, LINCOLN SUBDIVISION, ACCORDING TO PLAT THEREOF IN PLA BOOK 9, PAGE 69, OF THE PUBLIC RECORDS OF MIAMI-DADE COUNTY, FLORIDA.

LEGAL DESCRIPTION



THIS PLAN WAS PREPARED UNDER MY DIRECTION AND TO THE BEST OF MY KNOWLEDGE AND BELIEF COMPLIES WITH THE INTENT OF THE MANUAL OF UNIFORM MINIMUM STANDARDS FOR DESIGN, CONSTRUCTION AND MAINTENANCE FOR STREETS AND HIGHWAYS, AS ADOPTED BY THE STATE OF FLORIDA LEGISLATURE, CHAPTER 72-328 F.S.



SITE IMPROVEMENTS PLAN

Sally Control	
Engineer of Record: CARLOS J. BALLBE' Date: 6/12/2015	Project Number: 201511
Registered Engineer Number: 4/8/1 State of Florida	Sheet Number:

PB No. 2216 - 1615 Lenox Avenue

1. This conditional Use Permit is issued to Asta Parking. Subsequent owners and/or operators shall be required to appear before the Board within 90 days of the change of ownership or operator to affirm their understanding of the conditions listed herein and to obtain a Modification to this Conditional Use Permit.

2. The Planning Board shall maintain jurisdiction on this Conditional Use Permit. If deemed necessary, at the request of the Planning Director or a Board member, the applicant shall present a progress report to the Board. The Board reserves the right to modify the Conditional Use approval at the time of the progress report in a non-substantive manner, to impose additional conditions to address possible problems, and to determine the timing and need for future progress reports. This Conditional Use Permit is also subject to modification or revocation under City Code Sec. 118-194 (c).

3. Within 90 days of the commencement of operation, the owner and/or operator shall be required to appear before the Board for a progress report.

4. The Planning Board shall retain the right to call the applicant or operator back before them and make modifications to this Conditional Use Permit should there be valid complaints about loud, excessive, unnecessary, or unusual noise, or if code violations have been issued to the property. Nothing in this provision shall be deemed to limit the right of the Planning Board to call back the applicant or operator for other reasons and for other modifications of this Conditional Use Permit.

5. The conditions of approval for this Conditional Use Permit are binding on the applicant, the property owners, operators, and all successors in interest and assigns. Any change of operator or 50% (fifty percent) or more stock ownership, partnership interest or equivalent, shall require review and approval by the Planning Board as a modification to this Conditional Use Permit. Subsequent owners and operators shall be required to appear before the Board, in advance, to affirm their understanding of the conditions listed herein.

6. The hours of operation for the parking lot shall be from 7:00 AM to Midnight.

7. A revised site and landscape plan shall be submitted to and approved by staff, in accordance to the following:

a. All existing and proposed lighting shall be noted on the site plan, subject to the review and approval of staff.

b. The applicant shall provide a revised landscape plan that includes irrigation.

c. The applicant shall obtain an approved building permit for resurfacing, striping and landscaping, and complete all work on site associated with such permit prior to the issuance of the Certificate of Use/Business Tax Receipt for the extended hours.

PB No. 2216 - 1615 Lenox Avenue

MIANT-DADE COUNTY, FLORIDA

CF14 2015R024855 OR 8k 29582 P3 2321 - 2224 (4pas) RECORDED 04/17/2015 14/54:49 HARVEY SUVING CLERK OF COURT

d. All vehicles shall be parked in marked spaces, and there shall not be any tandem

PLANNING BOARD

FILE NO.

IN RE:

LEGAL

DESCRIPTION:

CITY OF MIAMI BEACH, FLORIDA

MEETING DATE: February 24, 2015

2216

1615 Lenox Avenue

The application for Conditional Use approval to operate a surface parking

Lot 15, Block 47, Lincoln Subdivision, According to the Plat Thereof, as

Recorded in Plat Book 9, Page 69, of the Public Records of Mlami-Dade

lot 24 hours a day, pursuant to Section 130, Article III.

CONDITIONAL USE PERMIT

The applicant, Asta Parking, requested Conditional Use approval to operate a surface

parking lot 24 hours a day, pursuant to Section 130, Article III. Notice of the request was

given as required by law and mailed out to owners of property within a distance of 375 feet of

The Planning Board of the City of Miami Beach makes the following FINDINGS OF FACT.

based upon the evidence, information, testimony and materials presented at the public hearing

That the property in question is located in the CD-1, Commercial Low Intensity District

That the use is consistent with the Comprehensive Plan for the area in which the

That the intended use or construction will not result in an impact that will exceed the

That structures and uses associated with the request are consistent with the Land

That the public health, safety, morals, and general welfare will not be adversely affected:

That necessary safeguards will be provided for the protection of surrounding property,

thresholds for the levels of service as set forth in the Comprehensive Plan; and

the exterior limits of the property upon which the application was made.

and which are part of the of the record for this matter:

zoning district; and

property is located; and

Development Regulations; and

persons, and neighborhood values.

e. The applicant shall be responsible for operating this facility in an orderly, clean and quiet manner so that neighboring residents are not disturbed during the hours of operation. This shall include removing all trash from the lot not less than twice daily. The sounding of car alarms, automobile horns, playing of radios or any kind of audio system and screeching of tires shall be prohibited. Two signs, one addressing City Code provisions regarding car alarms, and one prohibiting the screeching of tires and sounding of homs, shall be posted on the site so they are plainly visible by, and legible to, users of the facility.

f. The applicant shall install a sign indicating the name and phone number of the operator to report complaints, as well as the phone number for Code Compliance. The design, material and location of such sign shall be part of the revised site plan, and shall be subject to the review and approval of staff. The maximum size of such sign shall not exceed that permitted by the City Code.

8. The applicant shall obtain a full building permit within 18 months from the date of the meeting at which the original Conditional Use permit was issued and the work shall proceed in accordance with the Florida Building Code. Extensions of time for good cause, not to exceed a total of one year for all extensions, may be granted by the Planning Board.

9. The applicant shall resolve all outstanding code violations and fines for the subject property prior to the issuance of a Business Tax Receipt/Certificate of Use for this

10. Substantial modifications to the plans submitted and approved as part of the application, as determined by the Planning Director or designee, may require the applicant to return to the Board for approval.

11. The applicant, now and in the future, shall abide by all the documents and statements submitted with this application.

12. Compliance with the aforesaid conditions shall be a prerequisite to obtaining a Certificate of Use/Business Tax Receipt.

13. A Conditional Use Permit which lists the aforementioned conditions shall be recorded in the Public Records of Miami-Dade County at the expense of the applicant, prior to the issuance of a Business Tax Receipt /Certificate of Use, or Certificate of Occupancy, whichever may

14. This order is not severable, and if any provision or condition hereof is held void or unconstitutional in a final decision by a court of competent jurisdiction, the order shall be returned to the board for reconsideration as to whether the order meets the criteria for approval absent the stricken provision or condition, and/or it is appropriate to modify the remaining conditions or impose new conditions.

OK BK 29522 PG 2324 PB No. 2216 - 1615 Lenox Avenue

15. The establishment and operation of this Conditional Use shall comply with all the aforementioned conditions of approval; non-compliance shall constitute a violation of the Code of the City of Miami Beach, Florida, and shall be subject to enforcement procedures set forth in Section 114-8 of said Code and such enforcement procedures as are otherwise available. Any failure by the applicant to comply with the conditions of this Order shall also constitute a basis for consideration by the Planning Board for a revocation of this Conditional Use permit.

16. Within a reasonable time after applicant's receipt of this Conditional Use Permit as signed and issued by the Planning Director, the applicant shall record it in the Public Records of Miami-Dade County at applicant's expense and then return the recorded Instrument to the Planning Department. No building permit, certificate of occupancy, or certificate of completion shall be issued until this requirement has been satisfied.

17. Nothing in this order authorizes a violation of the City Code or other applicable law, nor allows a relaxation of any requirement or standard set forth in the City Code.

Dated this 14th day of APRIL

PLANNING BOARD OF THE CITY OF MIAMI, BEACH, FLORIDA Michael Belush, Planning and Zoning Manager For Chairman

STATE OF FLORIDA COUNTY OF MIAMI-DADE

The foregoing instrument was acknowledged before me this 17 day of April 2015, by Michael Belush, Planning and Zoning Manager of the City of Miami Beach, Florida, a Florida Municipal Corporation, on behalf of the corporation. He is personally known to me.

> Print Name Notary Public, State of Florida My Commission Expires: Commission Number:

[NOTARIAL SEAL] Approved As To Form:

Legal Department Filed with the Clerk of the Planning Board on 04/14/15

FNPLAN(\$PLB\2015\2-24-15\2216 - 1615 Lenox Ave\2216 - CUP.docx

Fire Prevention Division PLANS APPROVE

Designed by: <u>A.D.M.</u> Date: <u>4/2015</u> Drawn by: ___*A.D.M.*___ Date: _*4/2015*_

BY

REVISION

DATE

REVISION

NO. DATE BY



2737 Northeast 30th Place Fort Lauderdale, Florida 33306 Phone: (954) 491-7811 **Authorization No. EB-26343**

gineer of Record: CARLOS J./BALLBE'	
E A A & A E	
= 100 * 2 0 = 000000	
Date 6/22/2015	
gistered Engineer Number: 41811	
ate of Florida	
1/1 x = 97 1 1 1	


340He


CONDITIONAL USE PERMIT LENOX AVENUE PARKING LOT


REAL PROPERTIES LENOX. LLC

Project Number: 201511

Sheet Number: 9

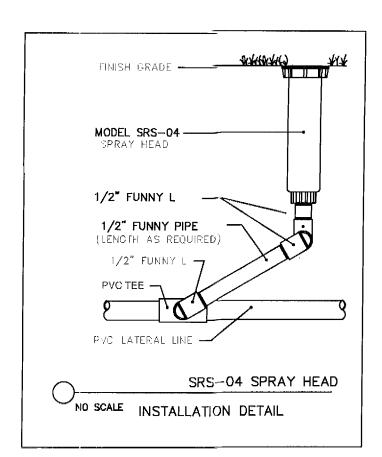

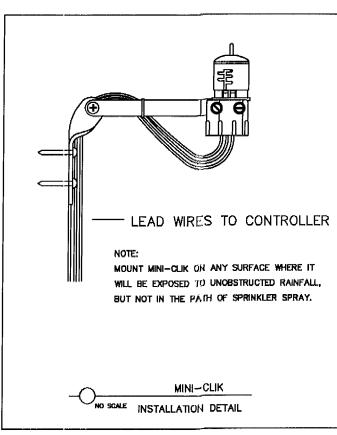

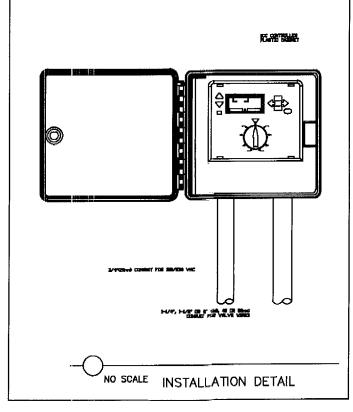


LAYDUT

LAYOUT IRRIGATION SYSTEM MAINLINES
AND LATERAL LINES, MAKE ALL
NECCESSARY ADJUSTMENTS AS REQUIRED
TO TAKE INTO ACCOUNT ALL SITE
OBSTRUCTIONS AND LIMITATIONS PRIOR TO
EXCAVATING TRENCHES


FLAG ALL SPRINKLER HEAD LOCATIONS.
ADJUST LOCATION AND MAKE THE
NECESSARY MODIFICATIONS TO NOZZLE
TYPES ETC. REQUIRED TO INSURE
100% COVERAGE.

PIPE

PIPE LOCATIONS SHOWN ON PLAN ARE SCHEMATIC ONLY AND SHALL BE ADJUSTED IN THE FIELD. WHEN LAYING-OUT MAINS AND LATRALS, LOCATE PIPE NEAR EDGES OF PAVEMENT OR AGAINST BUILDINGS WHENEVER POSSIBLE TO ALLOW SPACE FOR PLANT ROOT BALLS. PIPING UNDER HARDSCAPES SUCH AS ROADS, WALKS, AND PATIOS ARE TO BE SLEEVED USING SCH. 40 PIPE.

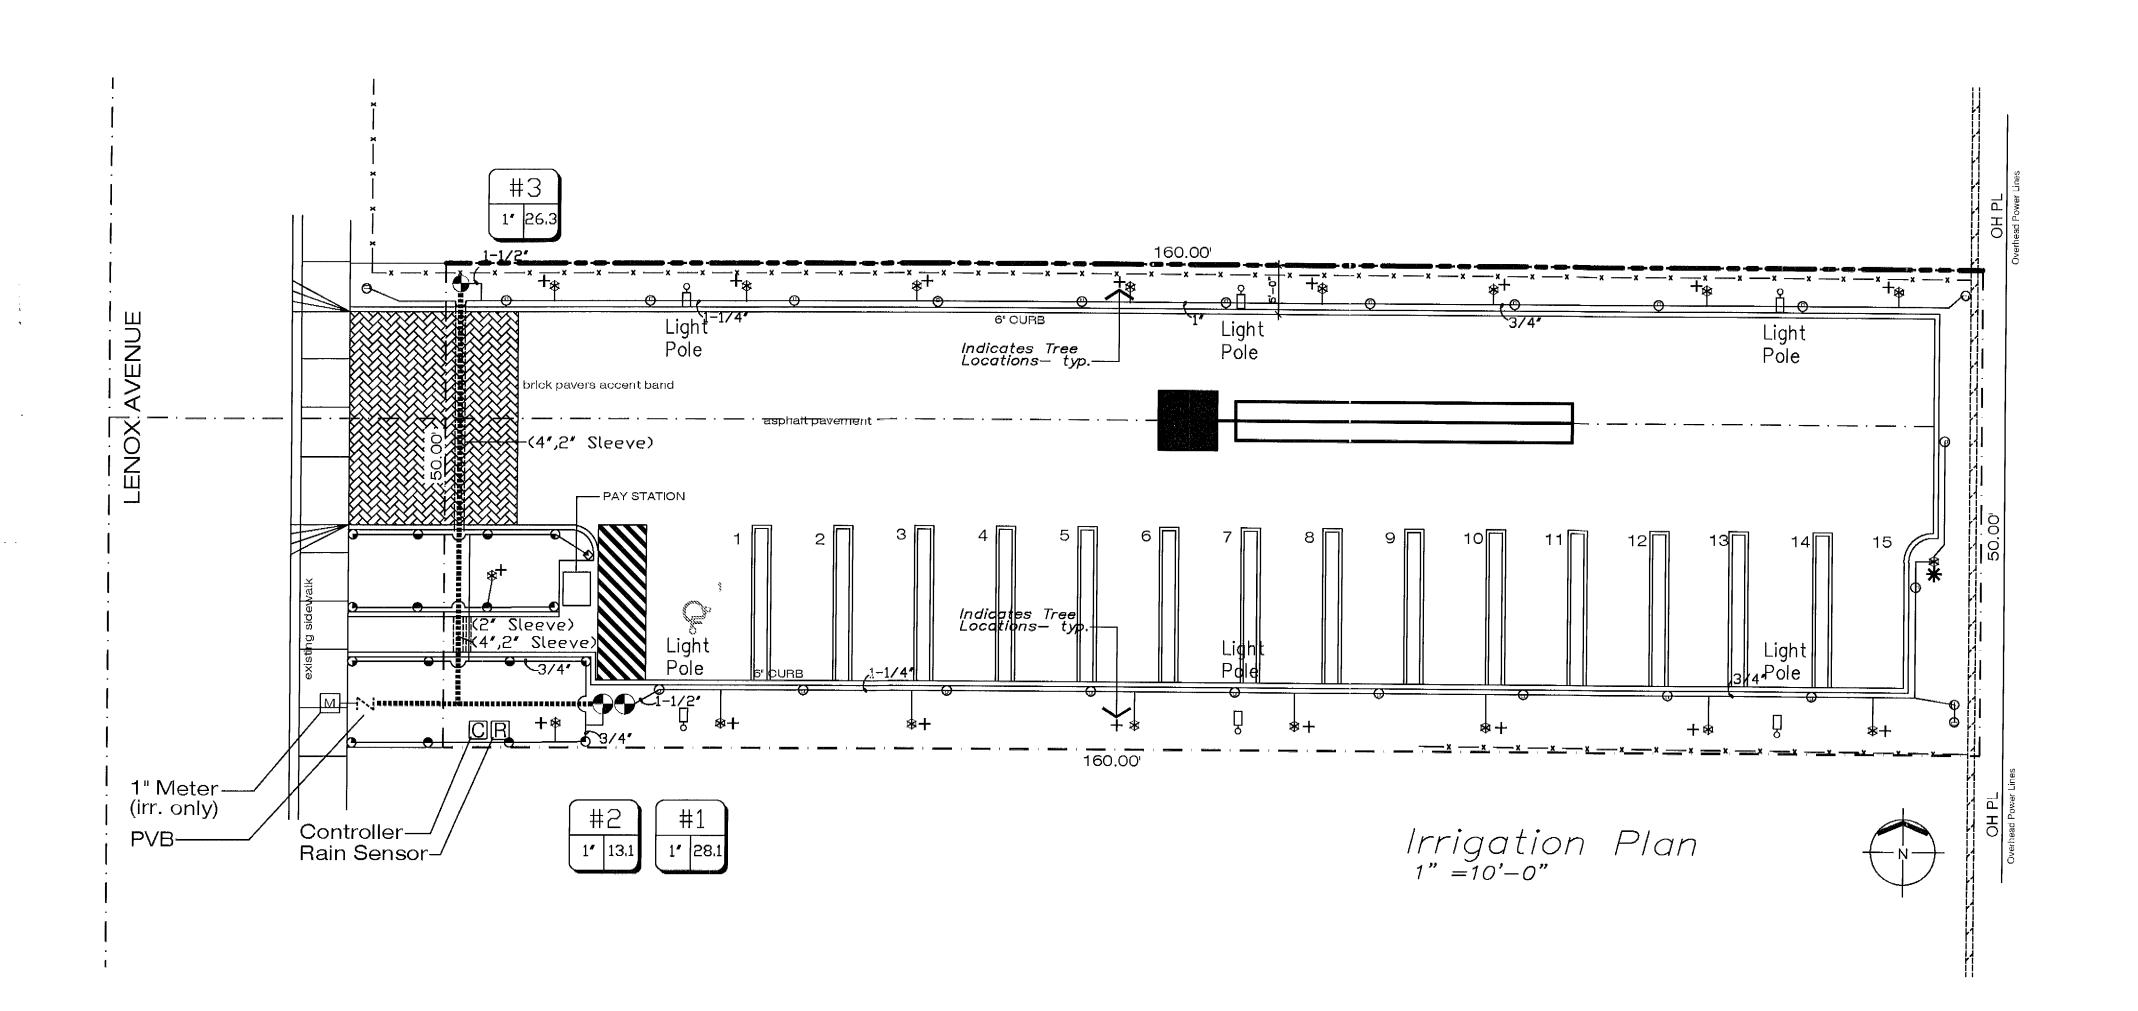



<u>1/2" - 2" ASSEMBLY</u> PRESSURE VACUUM BREAKER (PVB) BACKFLOW PREVENTER (BFP)

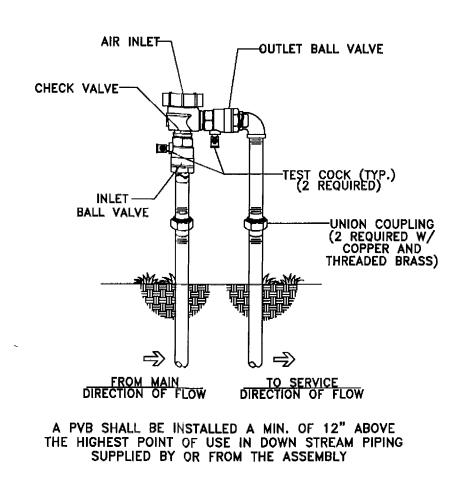


*INSTALL RAIN SENSOR AS PER LOCAL CODE FLUSHING

PRIOR TO PLACEMENT OF HEADS FLUSH ALL LINES UNTIL LINES ARE COMPLETLY CLEAN OF DEBRIS.

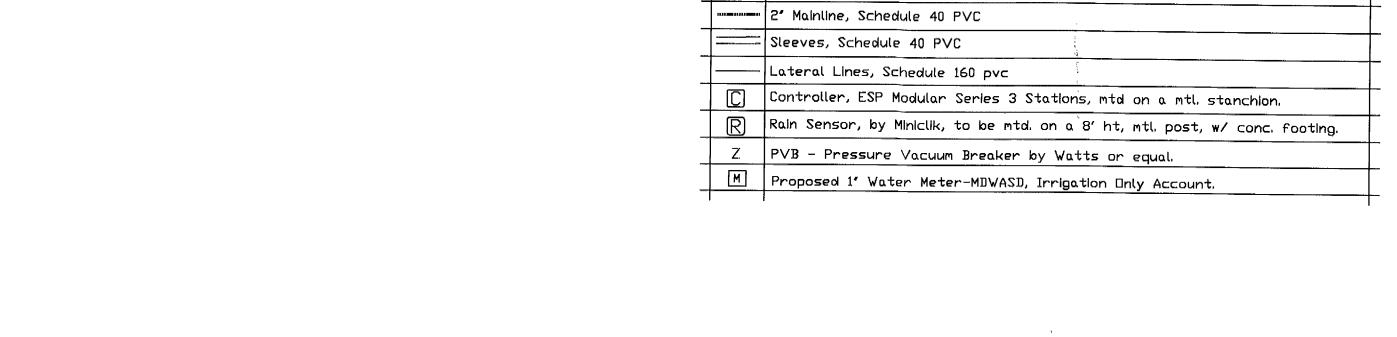

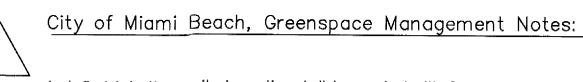


 A final irrigation orisite inspection shall be required with Greenspace Management staff prior to any official acceptance of the irrigation system. Failure to conduct the inspection could result in rejection of the irrigation system.

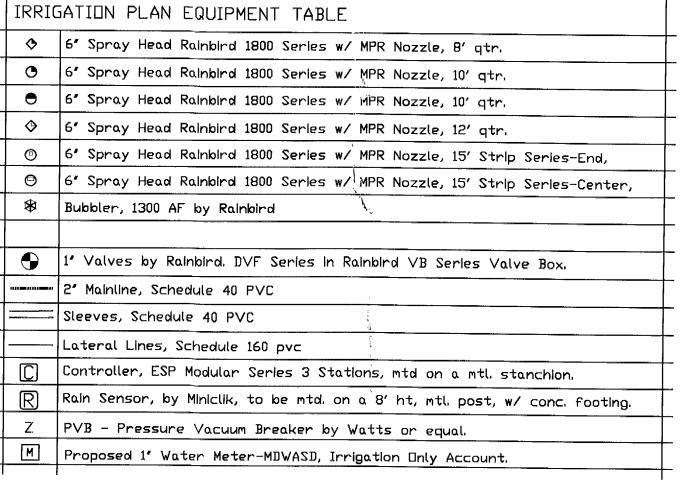

City of Miami Beach
Fire Prevention Division
PLANS APPROVED





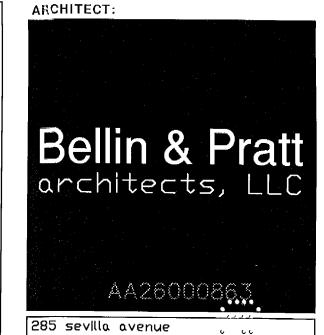

285 sevilla avenue coral gables, florida 33194;;; tel 305.447.1927 - fax 305.443.5986°

CONSULTANTS:

H.L. Martin, Landscape Architect, P.A.

LC# 26000404 LA #0001722 5965 SW 38th Street, Miami, Florida 33155 305 790-4372, hlmartinufiu©bellsouth.net Herbert L. Martin, Landscape Architect

© 2013 BELLIN & PRATT ARCHITECTS, LLC
THE DESIGN AND DRAWINGS FOR THIS PROJECT ARE THE PROPERTY OF THIS
ARCHITECT AND ARE PROTECTED UNDER THE COPYRIGHT PROTECTION ACT

ALL DRAWINGS AND WRITTEN MATERIALS HEREIN CONSTITUTE ORIGINAL
WORK OF THE ARCHITECT AND MAY NOT BE REPRODUCED, DUPLICATED &/OR
USED WITH THE WRITTEN CONSENT OF BELLIN & PRATT ARCHITECTS, LLC

PARKING LOT

PROJECT ADDRESS:

1615 LENOX AVENUE
MIAMI BEACH FL. 33139

OWNER INFORMATION:

ASTA PARKING INC.

725 N.E. 26 AVE
FT. LAUDERDALE, FL 33304

PROJECT NAME:

								-
Р	E	R	М	ľ	T	S	Ε	•

ISSUE DATE: 08.21.2014
PROJECT No.: 2014-20

REVISIONS:

APPROVED BY:

DRAWN BY:

No. Date Description

7-27-15 ADD 6" CURBS & CUT PARKING TO 16" DEPTH

8-20-15 REVISE DRIVEWAY TO 22" WIDTH

THESE PLANS ARE FOR BUILDING DEPARTMENT REVIEW ONLY. THEY ARE NOT TO BE CONSTRUED AS CONSTRUCTION DOCUMENTS UNTIL ALL BUILDING DEPARTMENT & A.H.J. (AUTHORITIES HAVING JURISDICTION) APPROVALS ARE OBTAINED.

SIGNATURE:

Marshall Bellin AR-5564
Glenn H Pratt, AIA, AR-9608


SHEET TITLE:


IRRIGATION PLAN


SCALE: AS NOTED

SHEET No.:

IR-1

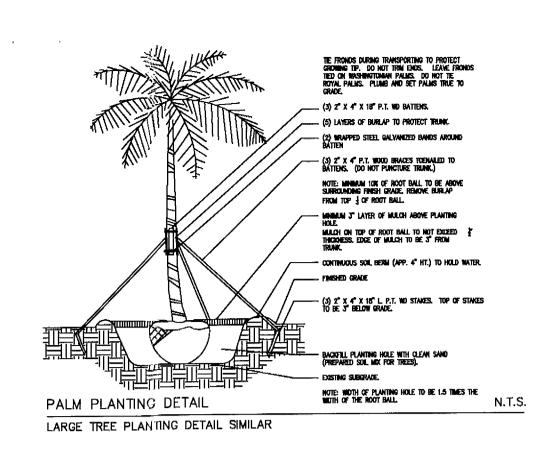

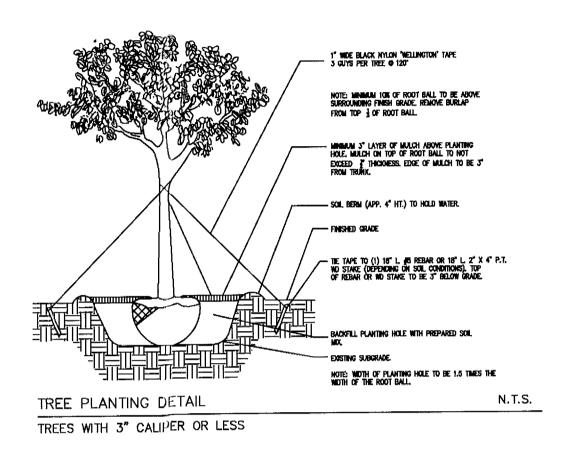

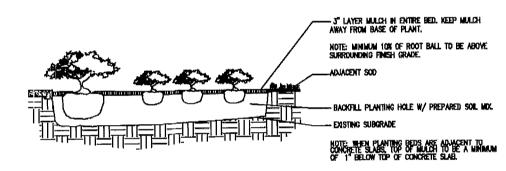

N.T.S.


SHRUB/GROUND COVER DETAIL


PLANT NOTES

- 1. ALL PLANT MATERIAL TO BE FLORIDA NO. 1 OR BETTER FLORIDA DEPARTMENT OF ACRICULTURE GRADES AND STANDARDS; PARTS I AND II, 2ND EDITION: FEBRUARY 1998, RESPECTIVELY.
- MULCH TO BE "PREMIUM PINEBARK BROWN" SHREDDED MULCH, BY AMERIGROW, OR A CITY APPROVED ALTERNATIVE.
- 3. ALLTREES TO BE STAKED IN A GOOD WORKMANLIKE MANNER, NO NAIL STAKING IN TRUNKS PERMITTED. ALL GUYING & STAKING TO BE REMOVED WITHIN 12 MONTHS AFTER PLANTING.
- 4. LANDSCAPE PLAN SHALL BE INSTALLED IN COMPLIANCE WITH ALL LOCAL CODES.
- 5. ALL SOD SHALL BE ST. AUGUSTINE 'FLORATAM' SOLID SOD, (UNLESS OTHERWISE NOTED) AND LAID WITH ALTERNATING AND ABUTTING
- 6. ALL PLANTING BEDS TO BE WEED AND GRASS FREE.
- 7. LANDSCAPE CONTRACTOR SHALL LOCATE AND VERIFY ALL UNDER-GROUND UTILITIES PRIOR TO DIGGING.
- 8. LANDSCAPE CONTRACTOR SHALL REVIEW ALL DRAWINGS AND PREPARE ONES OWN QUANTITY COUNTS(PRIOR TO BID COST AND COMPARE TO ARCHITECT'S PLANT LIST). LANDSCAPE CONTRACTOR IS RESPONSIBLE FOR ATTAINING ACCURATE COUNT OF PLANT MATERIALS SPECIFIED. IN THE EVENT OF DISCREPANCIES, LANDSCAPE CONTRACTORS SHALL BRING TO THE ATTENTION OF LANDSCAPE ARCHITECT. PLAN SHALL TAKE PRECEDENCE OVER PLANT LIST.
- 9. NO CHANGES SHALL BE MADE WITHOUT THE PRIOR CONSENT OF THE LANDSCAPE ARCHITECT. ADDITIONALLY, SEE CITY OF MIAMI BEACH'S GREENSPACE MANAGEMENT NOTE #4 BELOW.
- 10. ALL PLANTED AREAS TO RECEIVE 100% COVERAGE BY AN AUTOMATIC IRRIGATION SYSTEM, WITH A MINIMUM OF 50% OVERLAP. RAIN SENSOR TO BE PROVIDED.

City of Miami Beach, Greenspace Management Notes:

- An onsite inspection shall be required with Greenspace Management staff
 prior to installation of any plant material., in order to perform a grades and standards
 inspection. Failure to conduct the inspection could result in rejection of the plant material.
- A final onsite inspection shall be required with Greenspace Management staff
 prior to any official acceptance of plant material, in order to verify proper planting
 depth, spacing and quality of the material. Failure to conduct the inspection could result
 in rejection of the plant material.
- 3. Please utilize Amerigrow (Premium Pinebark Brown) shredded mulch or a City approved alternative. Mulch shall not be applied within 6" of the trunks of any existing or proposed
- All guying & staking shall be removed within twelve months after planting. Exceptions require written authorization from the City Urban Forester.
- No substitutions shall be made without prior consent of the City Urban Forester and/or the Planning Department.

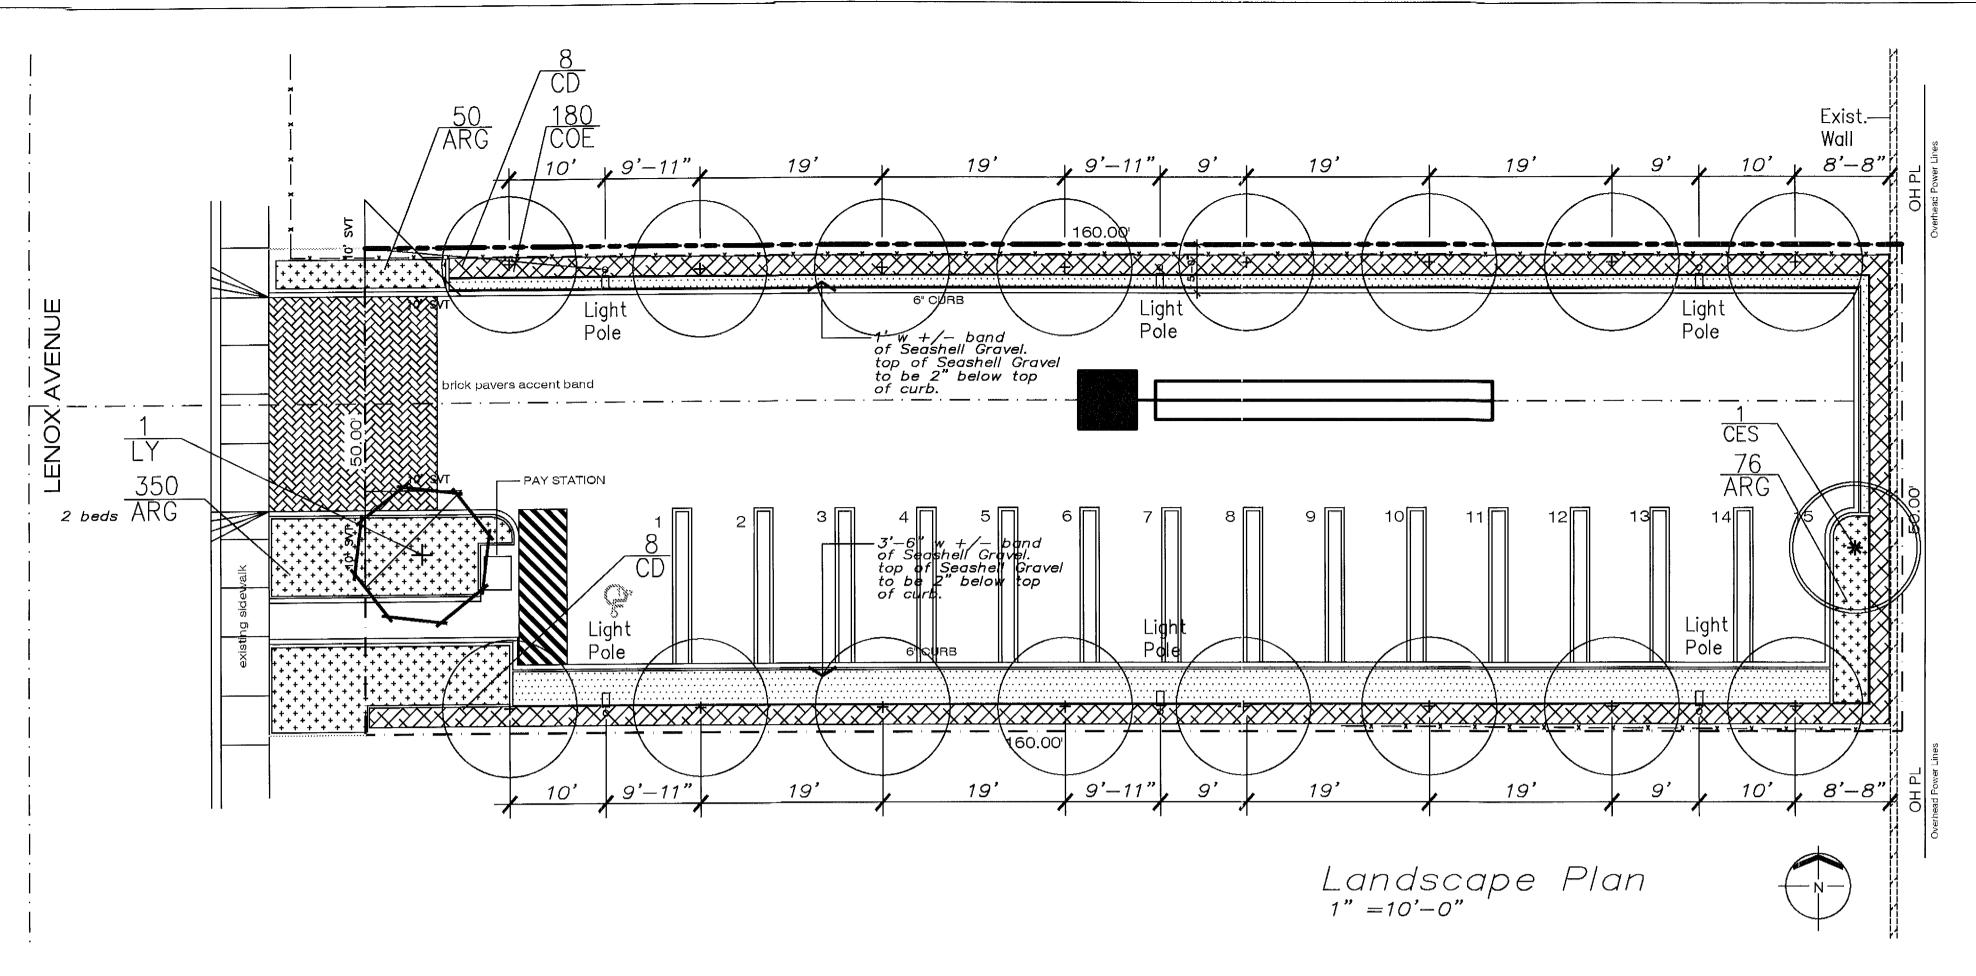

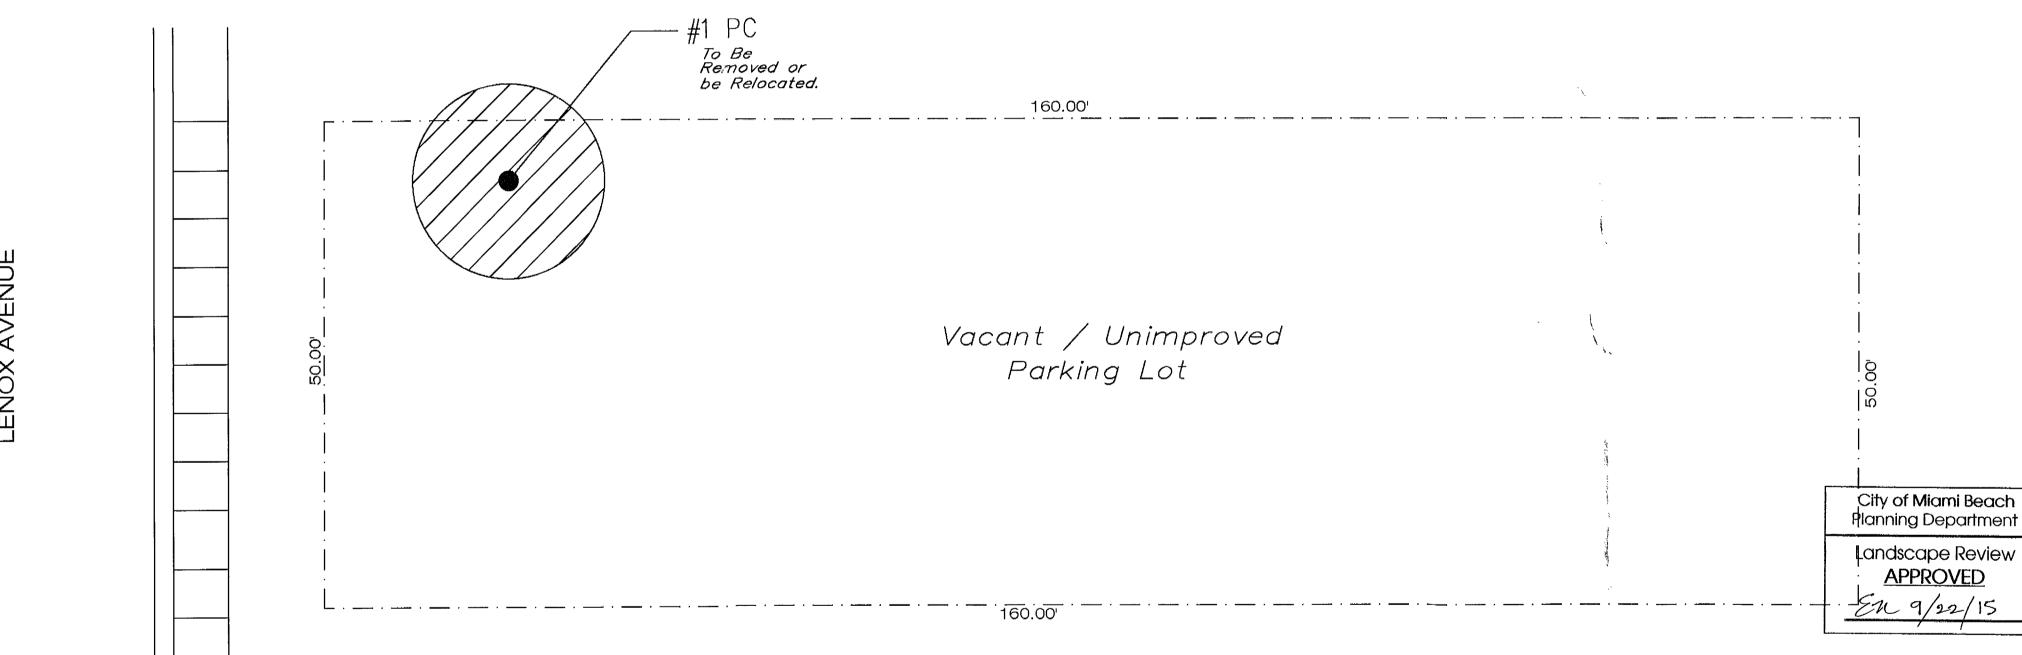

Num	Botanical / Commmon Name	Disposition	Description: HT/SPR/DBH/Notes	Canopy SF to be removed
#1	Phoenix canariensis / Canary Island Date Palm	-Remove-	35' ht, 20' spr, 23" dbh.	314 sf.
Pend	: Canary Island Date Palm to be reviewed by a Ce ling Arborist's evaluation, Canary Island Date Palm t n off—site location, to be determined.	o be relocated		

		City of Miami Beach Fire Prevention Division PLANS APPROVED				
NT	LIST	PLANSAP	PROVED			
KEY	Botanical Name / Common Name	Description	Native Yes No			
CD	Coccoloba diversifolia / Pigeon Plum	12'oa ht, 5' spr, 4'ct, 2" cal.	Yes			
LY	Lysiloma latisiliqua / Wild Tamarind	15-16'oa ht, 6' spr, 5'ct, 4" cal.	Yes			
CES	Conocarpus e. sericeus / Silver Buttonwood	12'oa ht, 5' spr, 4'ct, 2" cal.	No			
COE	Conocarpus erectus / Green Buttonwood	24" ht, 18" spr, full.	Yes			
ARG	Arachis glabrata / Perennial Peanut	1 gal.	No			
	KEY CD LY CES	CD Coccoloba diversifolia / Pigeon Plum LY Lysiloma latisiliqua / Wild Tamarind CES Conocarpus e. sericeus / Silver Buttonwood COE Conocarpus erectus / Green Buttonwood	KEY Botanical Name / Common Name CD Coccoloba diversifolia / Pigeon Plum Ly Lysiloma latisiliqua / Wild Tamarind CES Conocarpus e. sericeus / Silver Buttonwood COE Conocarpus erectus / Green Buttonwood Description 12'oa ht, 5' spr, 4'ct, 2" cal. 15—16'oa ht, 6' spr, 5'ct, 4" cal. 12'oa ht, 5' spr, 4'ct, 2" cal. 24" ht, 18" spr, full.			

Tree Survey/Disposition Plan

A Tree Removal Permit shall be required from the City of Miami Beach for all trees & palms to be removed or relocated, that are not considered exempt, prior to ANY tree or palm removal activity. Please provide a copy of the issued permit prior to FINAL inspection and if not required, proof of exemption.



coral gables, florida 33134 tel 305,447,1927 - fax 305,443,5986

....

CONSULTANTS:

H.L. Martin, Landscape Architect, P.A. 5965 SW 38th Street, Miami, Florida 33155 305 790-4372, hlmartinufiu@bellsouth.net Herbert L. Martin, Landscape Architect

© 2013 BELLIN & PRATT ARCHITECTS, LLC THE DESIGN AND DRAWINGS FOR THIS PROJECT ARE THE PROPERTY OF TH ARCHITECT AND ARE PROTECTED UNDER THE COPYRIGHT PROTECTION ACT DRAWINGS AND WRITTEN MATERIALS HEREIN CONSTITUTE ORIGINAL WORK OF THE ARCHITECT AND MAY NOT BE REPRODUCED, DUPLICATED &/OR USED WITH THE WRITTEN CONSENT OF BELLIN & PRATT ARCHITECTS, LLC

PARKING LOT

PROJECT ADDRESS: 1615 LENOX AVENUE MIAMI BEACH FL. 33139 **OWNER INFORMATION:** ASTA PARKING INC 725 N.E. 26 AVE FT. LAUDERDALE, FL 33304

PROJECT NAME:

							_
P	E	R	M	IT	S	E	

ISSUE DATE: 08.21.2014 PROJECT No.: 2014-20 DRAWN BY:

REVISIONS:

<u>APPROVED</u>

APPROVED BY:

ADD 6" CURBS & CUT PARKING TO 16" DEPTH REVISE DRIVEWAY TO 22' WIDTH

THESE PLANS ARE FOR BUILDING DEPARTMENT REVIEW ONLY. THEY ARE NOT TO BE CONSTRUED AS CONSTRUCTION DOCUMENTS UNTIL ALL BUILDING DEPARTMENT & A.H.J. (AUTHORITIES HAVING JURISDICTION) APPROVALS ARE OBTAINED.


SIGNATURE: Marshall Bellin AR-5564 Glenn H Pratt, AIA, AR-9608

SHEET TITLE:

LANDSCAPE PLAN

SCALE: AS NOTED

SHEET No.:

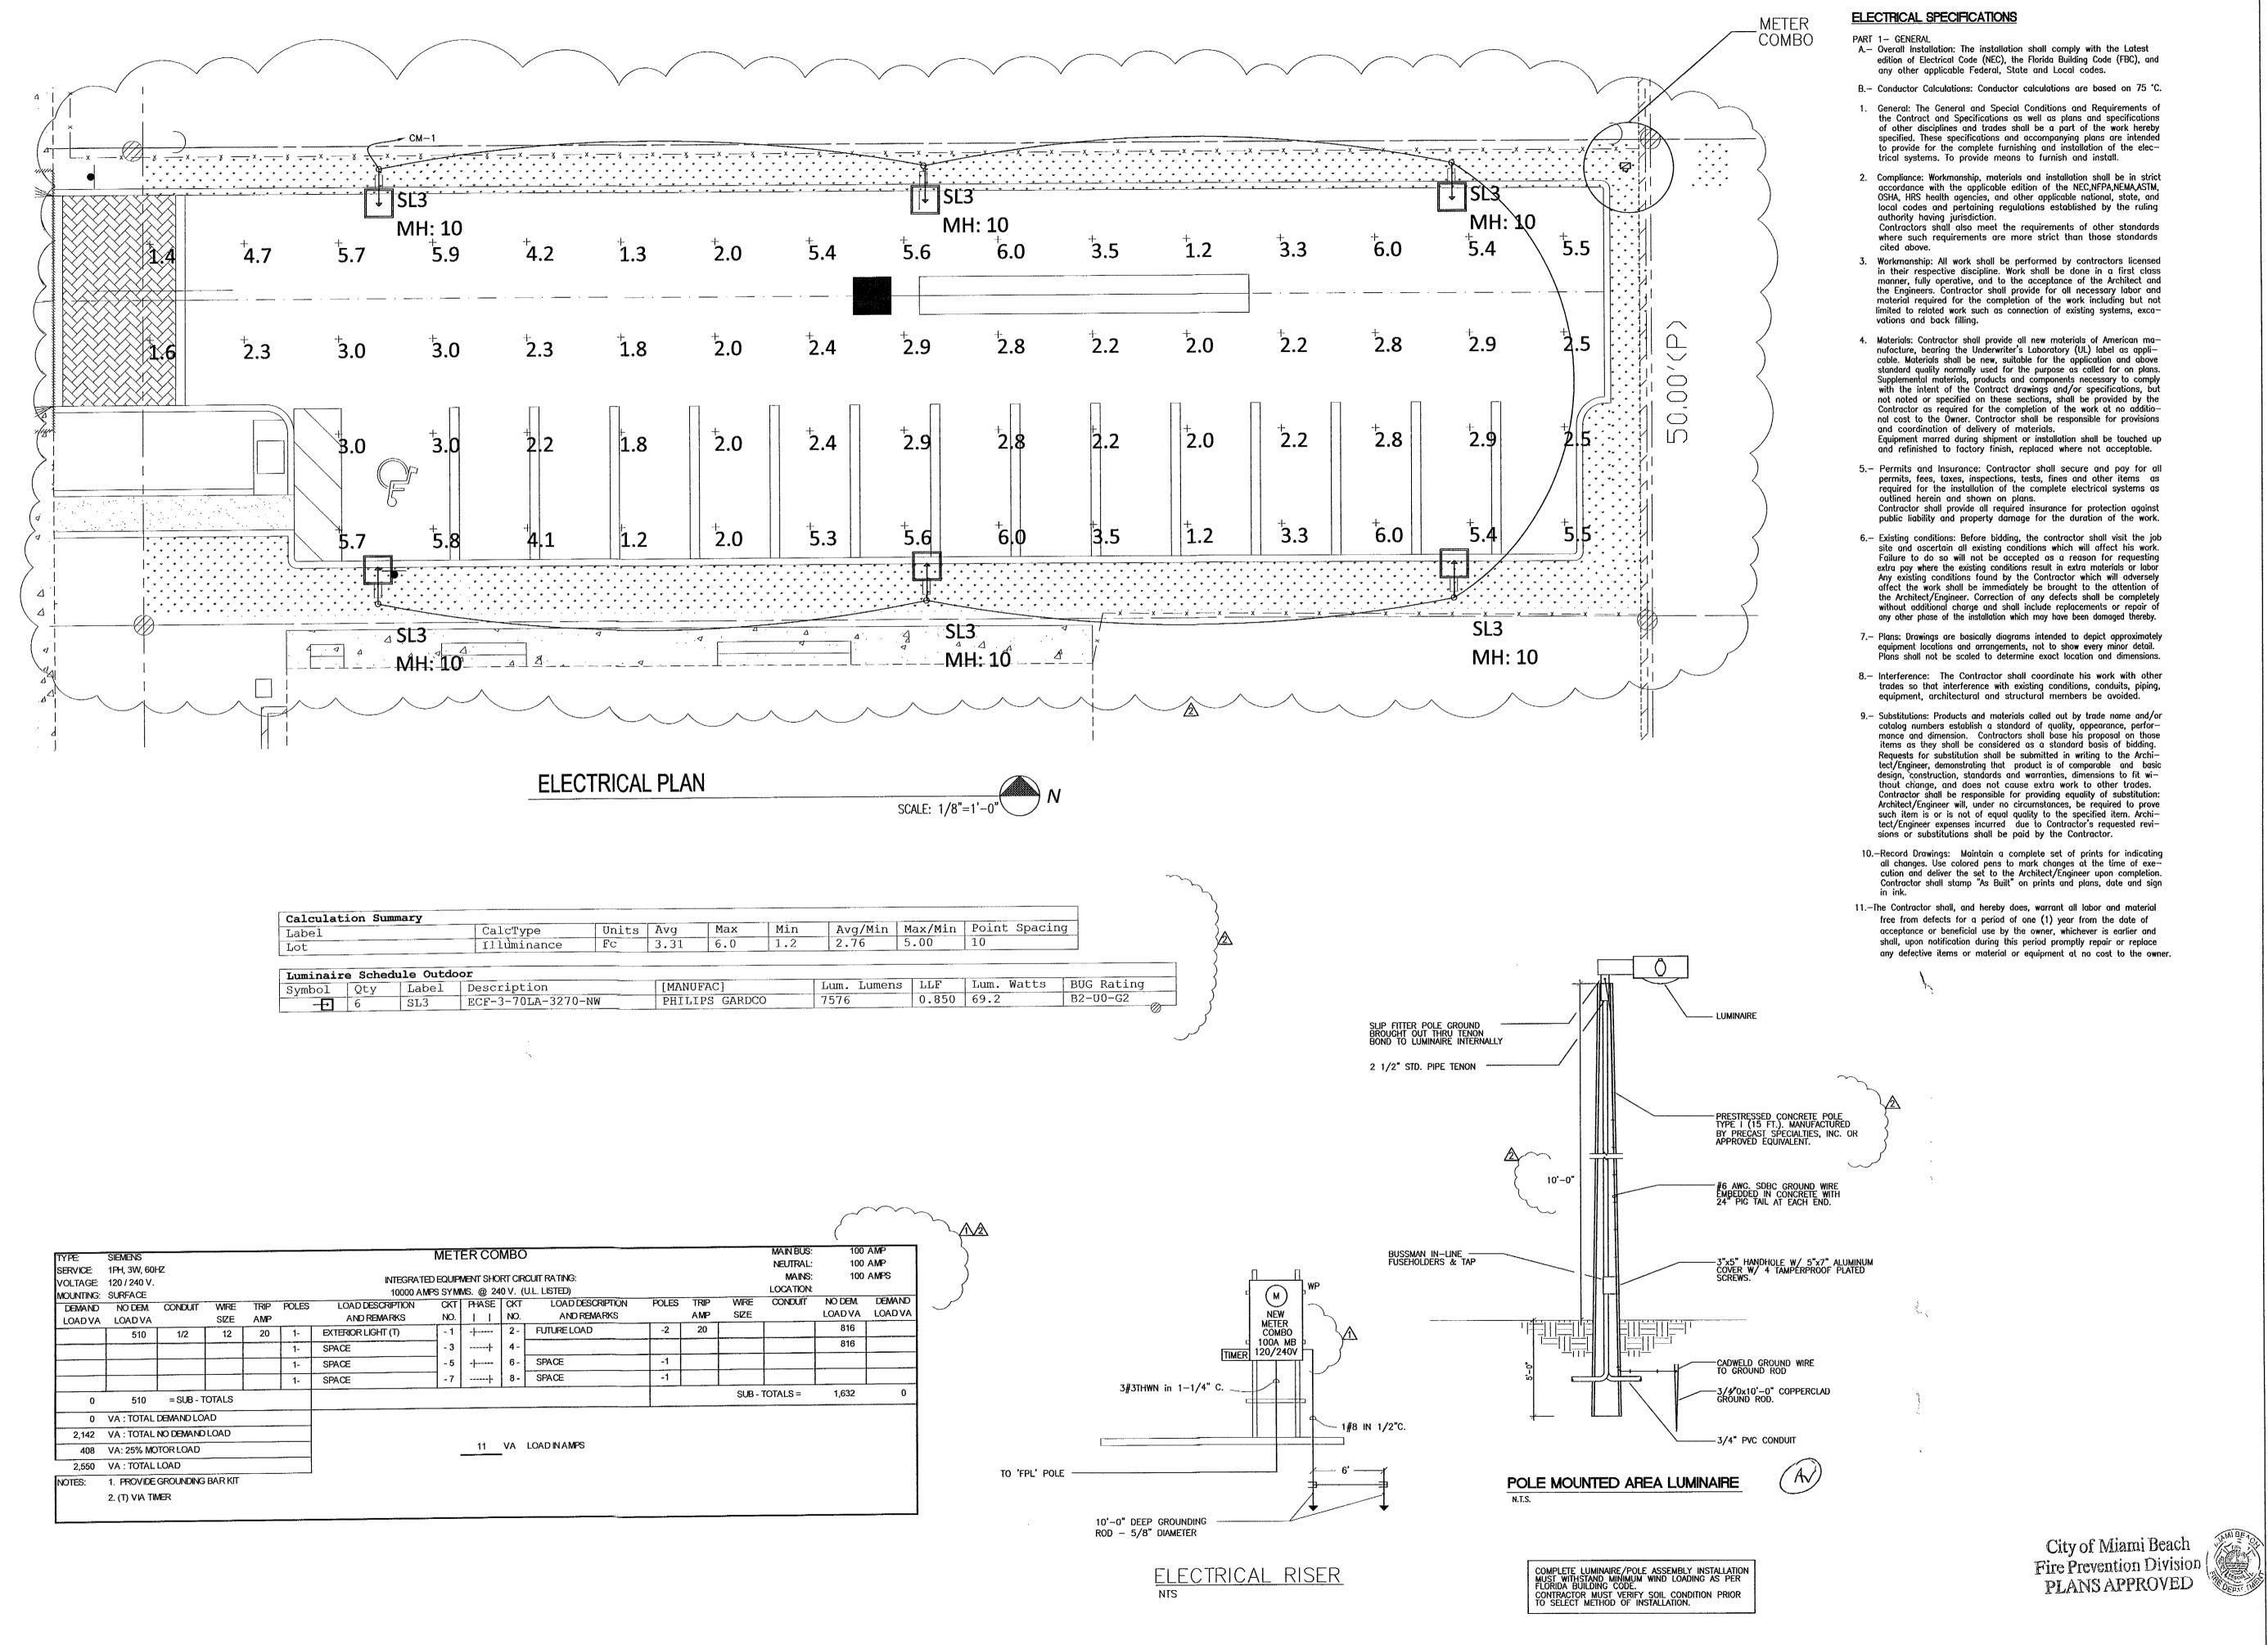

Bellin & Pratt architects, LLC AA26000863

285 sevilla avenue coral gables . florida . 33134 tel 305.447.1927 fax 305.443.5986

Marshall Bellin AR-5564 Glenn H Pratt, AIA, AR-9608

CONSULTANTS:

GUIROLA & ASSOCIATES P.A. CONSULTING ENGINEERS P.E. No 57468 David Guirola

Electrical Engineer 1150 NW 72nd AVE, S-451 MIAMI, FLORIDA 33126 P.H: (305) 513-9665 EMAIL: GUIRO 5@AOL.COM

00000

PROJECT NAME:

PARKING GARAGE

PROJECT ADDRESS: 1611 AND 1615 LENOX AVE, MIAMI BEACH, FLORIDA 33134

OWNER INFORMATION:

PERMIT SET

ISSUE DATE: July 31, 2014 PROJECT No.:

DRAWN BY: **APPROVED BY:**

REVISIONS:

7/13/15 REV#1 BUILDING DEP. COMM. 8/20/15 REV#2 BUILDING DEP. COMM.

ALL DRAWING AND WRITTEN MATERIALS HEREIN CONSTITUTE ORIGINAL WORK OF THE ARCHITECT AND MAY ONLY BE DUPLICATED WITH THEIR WRITTEN

CONSENT. SEAL: SIGNATURE: David Guirola P.E. PE # 57468

SHEET TITLE:

Electrical Plan

SCALE: AS SHOWN

SHEET No.:

