

OF BOUNDARY SURVEY

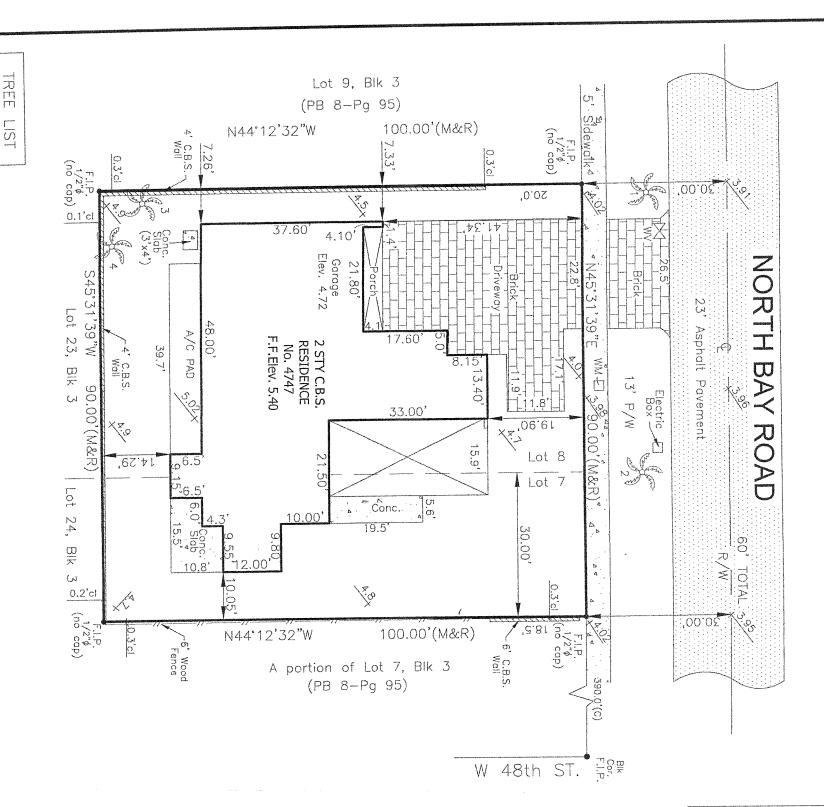

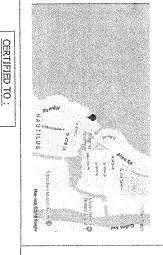

LOCATION MAP

ABREVIATION (IF ANY APPLIED)

CALLER CONDITIONING UNIT

SERVIN A ASSEMULT

M. = BENCH MARK

V.CORN.S BLOCK CORNER

V.CORN.S BLOCK CORNER


E CALLER SASIN


CALLER

CA

. = CONCRETE . = DRAINAGE MAINT EASEMENT DIAMETER

P/W = PARKWY
POLE = PONT OF BECKNING
POLE = PONT OF COMMENCEMENT
POLE = PONT OF COMMENCEMENT
POLE = PONT OF COMMENCEMENT
POLE = PONT OF INTERESCTION
POLE = PONT OF INTERE

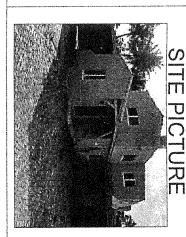

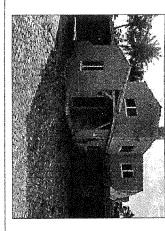

EAST EASTERN
EAST ELEVATION
EICY. E ELEVATION
ENC. E ENCRONARENT
ENC. E ENCRONARENT
EN. A FOUND OBILL HOLE
F.H. E FOUND OBILL HOLE
F.H. E FOUND SERIE
LP. E FOUND SERIE
LP. E FOUND SERIE
LP. EUCHT FOLE
MEAS(M) = MEASURED
MH = MANPOLE
ME MANPOL

TODD GLASER

SITE ADDRESS: JOB NUMBER: 4747 N BAY ROAD MIAMI BEACH, FL. 33140 18-510

WOODEN FENCE
CHAIN LINK FENCE
CHAIN LINK FENCE

CATCH BASIN

C.E. OVERHEAD BLECT.

S.P. DOWER POLE

HANDICAP SPACE

HANDICAP SPACE

FIRE HYDRANT

SURVEYOR'S LEGEND (IF ANY APPLIED)

BOUNDARY LINE
STRUCTURE (BLDG.)
CONCRETE BLOCK WALL

DATE OF SURVEY: FOLIO NUMBER: MAY 8, 2018 02-3222-011-0560

JOB SPECIFIC SURVEYOR NOTES:

(1) THE PROPERTY DESCRIBED ON THIS SURVEY DOES LIE WITHIN A SPECIAL HAZARD AREA AS DEFINED BY FLOOD ZONE "AE" OF THE FLOOD INSURANCE RATE MAP IDENTIFIED AS COMMUNITY PANEL NO. 120651 ELEVATION OF 8.00 FEET (NGVD) BRICKS OR PAVERS

WATER VALVE

CENTER (EDGE OF WATER)

WATER VALVE

TV-CABLE BOX

(ESSEN)

WATER VALVE

TV-CABLE BOX

(ESSEN)

WATER WEITER

WITH WATER WEITER

PROPERTY LIES WITHIN A

CONC. LIGHT POLE

20651-0309L, WITH AN EFFECTIVE DATE OF SEPTEMBER 11, 2009. BASE FLOOD

- 3) ELEVATIONS ARE BASED ON THE NATIONAL GEODETIC VERTICAL DATUM (NOVD) OF 1929, AS PER MIAMI DADE COUNTY BENCH MARK No. D-132-B, WITH AN ELEVATION OF 8.23 FEET.
 - ② LAND AREA OF SUBJECT PROPERTY: 9,000 SF (+/-)
- BEARINGS SHOWN HEREON ARE BASED ON AN ASSUME MERIDIAN OF N.44°12'32'W., BEING THE RECORDED BEARING FOR THE CENTERLINE OF W. 48th ST., AS SHOWN ON PLAT BOOK 8 AT PAGE 95 OF THE PUBLIC RECORD OF MIAMI DADE COUNTY, FLORIDA.

(4)

THE SHOWN LEGAL DESCRIPTION USED TO PERFORM THIS BOUNDARY SURVEY WAS PROVIDED BY THE CLIENT.

SURVEY IS BASED ON RECORDED INFORMATION PROVIDED BY CLIENT. NO SPECIFIC SEARCH OF THE PUBLIC RECORD HAS BEEN MADE BY OUR OFFICE.

UNLESS OTHERWISE NOTED, AN EXAMINATION OF THE ABSTRACT OF TITLE WAS NOT DONE BY THE SIGNING SURVEYOR TO DETERMINE WHICH INSTRUMENTS, IF ANY ARE AFFECTING THE SUBJECT PROPERTY

THIS SURVEY IS EXCLUSIVELY FOR THE USE OF THE PARTIES TO WHOM IT WAS CERTIFIED

THERE ARE NO VISIBLE, ABOVE GROUND ENCROACHMENTS (a) BY THE IMPROVEMENTS OF THE SUBJECT PROPERTY UPON ADJOINING PROPERTIES, STREETS OR ALLEYS, OR (b) BY THE IMPROVEMENTS OF THE ADJOINING PROPERTIES, STREETS OR ALLEYS, UPON THE SUBJECT PROPERTY OTHER THAN THOSE SHOWN ON THIS BOUNDARY SURVEY. PURSUANT TO RULE 53-17 OF THE FLORIDA ADMINISTRATIVE CODE THE EXPECTED USE OF LAND IS SUBL FEET, THE ACCURACY OBTAINED BY MEASUREMENT AND CALCULATIONS OF CLOSED GEOMETRIC FIGURES IRBAN, THE MINIMUM RELATIVE DISTANCE ACCURACY FOR THIS TYPE OF SURVEY IS 1 FOOT IN 7,500 5 WAS FOUND TO EXCEED THIS REQUIREMENT.

THERE ARE NO VISIBLE EASEMENTS OR RIGHT-OF-WAY OF WHICH THE UNDERSIGNED HAS BEEN ADVISED OTHER THAN THOSE SHOWN ON THIS SURVEY.

THE MAP OF SURVEY IS INTENDED TO BE DISPLAYED AT THE SHOWN GRAPHIC SCALE IN ENGLISH UNITS (CLEARLY ILLUSTRATE A PARTICULAR AREA WHERE DIMENSIONS SHALL HAVE PREFERENCE OVER GRAPHIC OF MEASUREMENT. IN SOME CASES GRAPHIC REPRESENTATION HAVE BEEN EXAGERATED TO MORE : LOCATION.

THE ELEVATIONS (IF ANY) OF WELL-IDENTIFIED FEATURES AS DEPICTED ON THIS SURVEY AND MAP WERE MEASURED TO AN ESTIMATED VERTICAL POSITIONAL ACCURACY OF $\frac{1}{20}$ FOOT FOR NATURAL GROUND SURFACES AND $\frac{1}{20}$ FOOT FOR HARDSCAPE SURFACES, INCLUDING PAVEMENT, CURBS, SIDEWALKS AND OTHER MANIMADE STRUCTURES.

THE SURVEYOR MAKES NO REPRESENTATION AS TO OWNERSHIP, POSSESSION OR OCCUPATION OF THE I SUBJECT PROPERTY BY ANY ENTITY OR INDIVIDUAL

ANY FEMA FLOOD ZONE INFORMATION PROVIDED ON THIS SURVEY IS FOR INFORMATIONAL PURPOSE ONLY AND IT WAS OBTAINED AT WWW.FEMA.COM.

IF YOU ARE READING THIS BOUNDARY SURVEY IN AN ELECTRONIC FORWAT, THE INFORMATION CONTAINED ON THIS DOCUMENT IS ONLY VALID IF THIS DOCUMENT IS ELECTRONICALLY SIGNED AS SPECIFIED IN CHAPTER CHAPTER 53-17,062 (3) OF THE FLORIDA ADMINISTRATIVE CODE. IF THIS DOCUMENT IS IN PAPER FORMAT, IT IS NOT VALID WITHOUT THE SIGNATURE AND ORIGINAL RAISED SEAL OF THE PROFESSIONAL LAND SURVEYOR AND MAPPER OF RECORD.

LEGAL DESCRIPTION:
LOT 8, IN BLOCK 3, OF NAUTILUS SUBDIVISION OF THE NIAMI BEACH BAY SHORE CO., ACCORDING TO THE PLAT THEREOF RECORDED IN PLAT BOOK 8, AT PAGE 95, OF THE PUBLIC RECORDS OF MIAMI-DADE COUNTY, FLORIDA; ALSO THAT PART OF LOT 7, IN BLOCK 3, OF NAUTILUS SUBDIVISION, ACCORDING TO THE PLAT THEREOF RECORDED IN PLAT BOOK 8, AT PAGE 95, OF THE PUBLIC RECORDS OF MIAMI-DADE COUNTY, FLORIDA, DESCRIBED AS FOLLOWS:

BEGINNING ON THE SOUTHERLY LINE OF BAY ROAD AT THE POINT OF INTERSECTION WITH THE LINE DIVIDING LOTS 7 AND 8, OF BLOCK 3, OF NAUTILUS SUBDIVISION/THENCE NORTHEASTERLY ALONG THE SOUTHEASTERLY LINE OF BAY ROAD A DISTANCE OF 100 FEET TO A POINT; THENCE SOUTHEASTERLY ARGE TO THE SOUTHEASTERLY LINE OF LOT 7, OF BLOCK 3, OF NAUTILUS SUBDIVISION; THENCE SOUTHEASTERLY ALONG THE SOUTHEASTERLY LINE OF LOT 7, OF BLOCK 3, OF NAUTILUS SUBDIVISION; THENCE SOUTHAMESTERLY ALONG THE SOUTHEASTERLY LINE OF LOT 7, OF BLOCK 3, OF NAUTILUS SUBDIVISION A DISTANCE OF 100 FEET TO THE POINT OF BEGINNING. WE HEREBY CERTIFY THAT THIS BOUNDARY AND TOPOGRAPHICAL SURVEY AND THE SURVEY MAP RESULTING THEREFROM WAS PERFORMED UNDER MY SUPERVISION AND/OR DIRECTION AND IS TRUE AND CORRECT TO THE BEST OF MY KNOWLEDGE AND BELIEF AND FURTHER, THAT SAID "BOUNDARY AND TOPOGRAPHICAL SURVEY" MEETS THE INTENT OF THE APPLICABLE PROVISIONS OF THE "STANDARDS OF PRACTICE FOR LAND SURVEYING IN THE STATE OF FLORIDA", PURSUANT TO RULE 51-17 OF THE FLORIDA ADMINISTRATIVE CODE AND ITS IMPLEMENTING LAW, CHAPTER

American Consulting Engineers . Planners . Surveyors Services of ıamı,

PH: (305) 598-5101 FAX: 9370 S.W. 72nd Street, Suite A-1 Miami, Florida, 33173 ASOMIAMI.COM (305) 598-

-8627

LB 6683

MACARTHUR PALM ROYAL PALM ROYAL PALM

ROYSTONIA ELATA

ROYSTONIA ELATA

BOTANICAL NAME

D.B.H.

HEIGHT

SPREAD

25

PALM

PTYCHOSPERMA MACARTHUR PTYCHOSPERMA MACARTHUR

0.4. 0.4

20, 18, 20,

ENCROACHMENTS AND OTHER POINTS OF INTEREST:
-THERE ARE NO VISIBLE ENCROACHMENT OF THE SUBJECT PROPERTY
-THE SUBJECT PROPERTY IS WITHIN A FLOOD ZONE AH (SEE NOTE 1)
-THERE NO PLATTED UTIL. EASEMENT ON THE SUBJECT PROPERTY

TREE NAME



2