
 **SITE PLAN**
SCALE: 1/8" = 1'-0"

ALTON ROAD

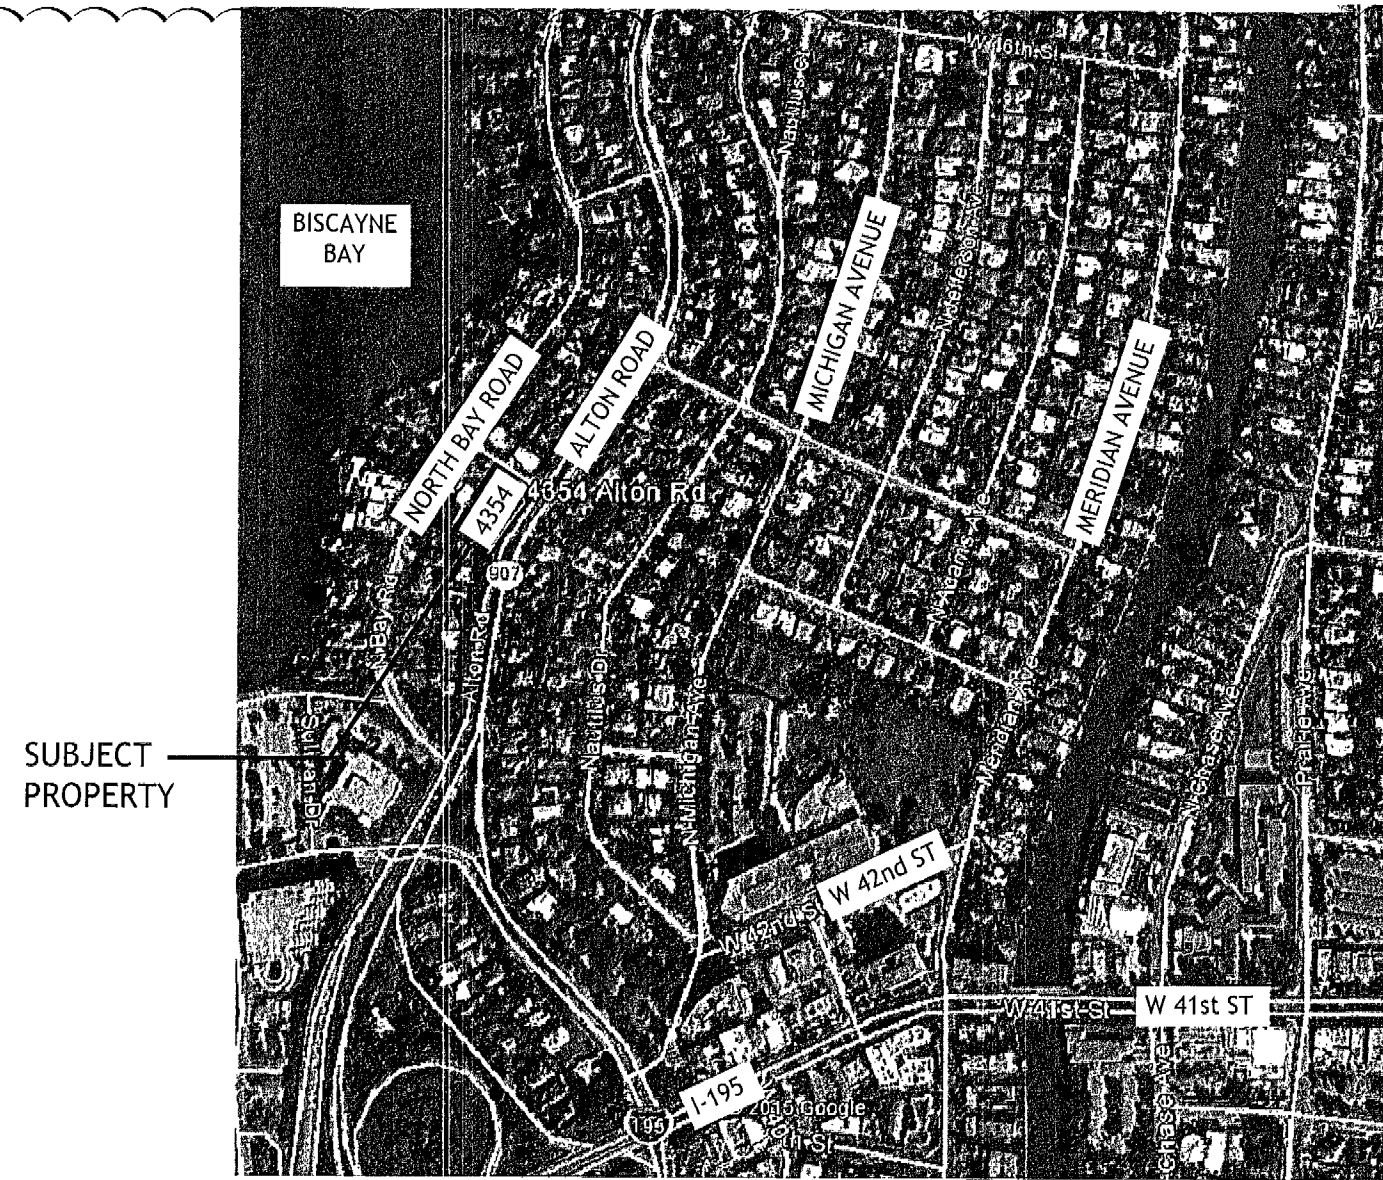

 **AERIAL VIEW/LOCATION MAP**
SCALE: N.T.S

FRONT YARD

AREA OF FRONT YARD 2,295 S.F.	ALLOWED	PROVIDED
AREA - IMPERVIOUS	1,491.75 S.F. (65% Max.)	671.77 S.F. (29.3%)
AREA - PERVIOUS	803.25 S.F. (35% Min.)	1,621.58 S.F. (70.7%)

INTERIOR SIDE YARD

AREA OF REAR YARD 1,225 S.F.	ALLOWED	PROVIDED
AREA - IMPERVIOUS	N/A	435.34 S.F. (35%)
AREA - PERVIOUS	N/A	789.50 S.F. (65%)

STREET SIDE YARD

AREA OF STREET SIDE YARD 1,377 S.F.	ALLOWED	PROVIDED
AREA - IMPERVIOUS	895 S.F. (65% Max.)	421.23 S.F. (31%)
AREA - PERVIOUS	482 S.F. (35% Min.)	955.66 S.F. (69%)

REAR YARD

AREA OF FRONT YARD 2,607 S.F.	ALLOWED	PROVIDED
AREA - IMPERVIOUS	782 S.F. (30% Max.)	505.68 S.F. (19.4%)
AREA - PERVIOUS	1,825 S.F. (70% Min.)	2,101.5 S.F. (80.6%)

SITE PLAN NOTES:

- ALL RAINWATER TO BE CONTAINED WITHIN THE SITE. NO RUNOFF ALLOWED ONTO ADJACENT PROPERTIES. A SWALE 4" DEEP X 4' WIDE SLOPING AWAY FROM PROPERTY LINE AND ADJACENT PROPERTY TO BE PROVIDED AT PERIMETER OF PROPERTY. EXCEPT AT RETAINING WALL IN REAR.
- ALL LANDSCAPING BY OTHERS.
- ALL METAL FENCES, GATES TO BE UNDER SEPARATE PERMIT.
- ALL MISSING, BROKEN, CRACKED OR UPLIFTED SIDEWALK SHALL BE RECONSTRUCTED.
- NO TREES TO BE REMOVED ON THIS SITE.
- ALL ELECTRICAL, MECHANICAL AND PLUMBING EQUIPMENT MUST BE AT OR ABOVE BASE FLOOD ELEVATION (B.F.E.), +7.0' NGVD.

DRAWN BY:

REVISIONS:

8-14-15

A40003689
ANTHONY LEON
0016732

DESIGN
ARCHITECTURE

4300 Biscayne Blvd. #G-04, Miami, FL 33137
P: 305.438.9377 | F: 305.438.9379

Antony
AUG 24 2015
SEAL

NEW RESIDENCE
AT:
4354 ALTON ROAD
MIAMI BEACH, FL 33139

A.1.1
PERVIOUS &
IMPERVIOUS AREAS

1. THE CONTRACTOR IS RESPONSIBLE FOR REMOVING SILT FROM SITE IF NOT REUSABLE ON-SITE AND ASSURING PLAN ALIGNMENT AND GRADE IN ALL DITCHES AND SWALES AT COMPLETION OF CONSTRUCTION.
2. THE SITE CONTRACTOR IS RESPONSIBLE FOR REMOVING THE TEMPORARY EROSION AND SEDIMENT CONTROL DEVICES AFTER COMPLETION OF CONSTRUCTION AND ONLY WHEN AREAS HAVE BEEN STABILIZED.
3. ADDITIONAL PROTECTION - ON-SITE PROTECTION MUST BE PROVIDED THAT WILL NOT PERMIT SILT TO LEAVE THE PROJECT CONTIGUOUS DUE TO UNFORSEEN CONDITIONS OR ACCIDENTS.
4. CONTRACTOR SHALL INSURE THAT ALL DRAINAGE STRUCTURES, PIPES, ETC. ARE CLEANED OUT AND WORKING PROPERLY AT TIME OF ACCEPTANCE.
5. WIRE MESH SHALL BE LAID OVER THE TOP DROP INLET SO THAT THE WIRE EXTENDS A MINIMUM OF 1 FOOT BEYOND EACH SIDE OF THE INLET STRUCTURE. HARDWARE CLOTH OR COMPARABLE WIRE MESH WITH 1/2-INCH OPENING SHALL BE USED. IF MORE THAN ONE STRIP OF MESH IS NECESSARY, THE STRIPS SHALL BE OVERLAPPED.
6. FOOT NO. 1 COARSE AGGREGATE SHALL BE PLACED OVER THE WIRE MESH AS INDICATED ON DETAIL. THE DEPTH OF STONE SHALL BE AT LEAST 12 INCHES OVER THE ENTIRE INLET OPENING. THE STONE SHALL EXTEND BEYOND THE INLET OPENING AT LEAST 18 INCHES ON ALL SIDES.
7. IF THE STONE FILTER BECOMES CLOGGED WITH SEDIMENT SO THAT IT NO LONGER ADEQUATELY PERFORMS ITS FUNCTION, THE STONE MUST BE PULLED AWAY FROM THE INLET, CLEANED AND REPLACED.
8. BALES SHALL BE EITHER WIRE-BOUND OR STRING-TIED WITH THE BENDINGS ORIENTED AROUND THE SIDES RATHER THAN OVER AND UNDER THE BALES.
9. BALES SHALL BE PLACED LENGTHWISE IN SINGLE ROW SURROUNDING THE INLET, WITH THE ENDS OF ADJACENT BALES PRESSED TOGETHER.
10. THE FILTER BARRIER SHALL BE EXTENDED AND BACKFILLED. A TRENCH SHALL BE EXCAVATED AROUND THE INLET AND WIDTH OF A BALE TO A MINIMUM DEPTH OF FOUR INCHES. AFTER THE BALES ARE STACKED, THE EXCAVATED SOIL SHALL BE BACKFILLED AND COMPACTED AGAINST THE FILTER BARRIER.
11. EACH BALE SHALL BE SECURELY ANCHORED AND HELD IN PLACE BY AT LEAST TWO STAKES OR REBARS DRIVEN THROUGH THE BALE.
12. LOOSE STRAW SHOULD BE WEDGE BETWEEN BALES TO PREVENT WATER FROM ENTERING BETWEEN BALES.
13. HAYBALE BARRIERS SHALL BE INSPECTED IMMEDIATELY AFTER EACH RAINFALL AND AT LEAST DAILY DURING PROLONGED RAINFALL.
14. CLOSE ATTENTION SHALL BE PAID TO THE REPAIR OF DAMAGED BALES, END RINS AND UNDERCUTTING BENEATH BALES.
15. NECESSARY REPAIRS TO BARRIERS OR REPLACEMENT OF BALES SHALL BE ACCOMPLISHED PROMPTLY.
16. SEDIMENT DEPOSITS SHOULD BE REMOVED AFTER EACH RAINFALL. THEY MUST BE REMOVED WHEN THE LEVEL OF DEPOSITION REACHES APPROXIMATELY ONE-HALF THE HEIGHT OF THE BARRIER.
17. ANY SEDIMENT DEPOSITS REMAINING IN PLACE AFTER THE HAYBALE BARRIER IS NO LONGER REQUIRED SHALL BE DISSEED TO CONFORM TO THE EXISTING GRADE, PREPARED AND SEED.
18. SILT FENCES AND FILTER BARRIERS SHALL BE INSPECTED IMMEDIATELY AFTER EACH RAINFALL AND AT LEAST DAILY DURING PROLONGED RAINFALL. ANY REQUIRED REPAIRS SHALL BE MADE IMMEDIATELY.
19. SHOULD THE FABRIC ON A SILT FENCE OR FILTER BARRIER DECOMPOSE OR BECOME INEFFECTIVE PRIOR TO THE END OF THE EXPECTED USABLE LIFE AND THE BARRIER IS STILL NECESSARY, THE FABRIC SHALL BE REPLACED PROMPTLY.
20. THE STRUCTURE SHALL BE INSPECTED AFTER EACH RAIN AND REPAIRS MADE AS NEEDED.
21. SEDIMENT SHALL BE REMOVED AND THE TRAP RESTORED TO ITS ORIGINAL DIMENSIONS WHEN THE SEDIMENT HAS ACCUMULATED TO ONE-HALF THE DESIGN DEPTH OF THE TRAP. REMOVED SEDIMENT SHALL BE DEPOSITED IN A SUITABLE AREA AND IN SUCH A MANNER THAT IT WILL NOT ERODE.
22. THE CONTRACTOR IS RESPONSIBLE FOR FOLLOWING THE BEST EROSION AND SEDIMENT CONTROL PRACTICES AS OUTLINED IN THE PLANS, SPECIFICATIONS AND APPLICABLE WATER MANAGEMENT DISTRICT PERMITS FOR THIS PROJECT.
23. FOR ADDITIONAL INFORMATION ON SEDIMENT AND EROSION CONTROL REFER TO "THE FLORIDA DEVELOPMENT MANUAL - A GUIDE TO SOUND LAND AND WATER MANAGEMENT" FROM THE STATE OF FLORIDA DEPARTMENT OF ENVIRONMENTAL REGULATION (FDER), CHAPTER 6.
24. EROSION AND SEDIMENT CONTROL BARRIERS SHALL BE PLACED ADJACENT TO ALL WETLAND AREAS WHERE THERE IS POTENTIAL FOR DOWNSTREAM WATER QUALITY DEGRADATION.
25. ALL DISTURBED AREAS SHALL BE GRASSED, FERTILIZED, MULCHED AND MAINTAINED UNTIL A PERMANENT VEGETATIVE COVER IS ESTABLISHED.
26. SOIL SHALL BE PLACED IN AREAS WHICH MAY REQUIRE INTERIM EROSION PROTECTION TO INSURE WATER QUALITY STANDARDS ARE MAINTAINED.
27. ANY DISCHARGE FROM DEWATERING ACTIVITY SHALL BE FILTERED AND CONVEYED TO THE OUTFALL IN A MANNER WHICH PREVENTS EROSION AND TRANSPORTATION OF SUSPENDED SOLIDS TO THE RECEIVING OUTFALL.
28. DEWATERING PUMPS SHALL NOT EXCEED THE CAPACITY OF THAT WHICH REQUIRES A CONSUMPTIVE USE PERMIT FROM THE APPLICABLE WATER MANAGEMENT DISTRICT.
29. ALL DISTURBED AREAS TO BE STABILIZED THROUGH COMPACTED, SILT SCREENS, HAYBALES AND GRASSING. ALL FILL SLOPES 3:1 OR STEEPER TO ACCEPTE STABILIZED SOIL.
30. ALL DEWATERING, EROSION, AND SEDIMENT CONTROL TO REMAIN IN PLACE AFTER COMPLETION OF CONSTRUCTION AND BE REMOVED ONLY WHEN AREAS HAVE BEEN STABILIZED.
31. THIS PLAN INDICATES THE MINIMUM EROSION AND SEDIMENT CONTROL MEASURES REQUIRED FOR THIS PROJECT. THE CONTRACTOR IS RESPONSIBLE FOR MEETING ALL APPLICABLE RULES, REGULATIONS AND WATER QUALITY GUIDELINES AND MAY NEED TO INSTALL ADDITIONAL CONTROLS.
32. ALL EXCAVATIONS AND EARTHWORK SHALL BE DONE IN A MANNER TO MINIMIZE WATER TURBIDITY AND POLLUTION. DISCHARGE SHALL BE CONTROLLED AND REROUTED THROUGH HAY FILTERS, STATION TRAPERS AND BUMPS. THE CONTRACTOR SHALL BE RESPONSIBLE FOR THE PREVENTION, CORRECTION, CONTROL AND ABATEMENT OF EROSION AND WATER POLLUTION IN ACCORDANCE WITH CHAPTER 62, 30C, FLORIDA ADMINISTRATIVE CODE.
33. THE CONTRACTOR IS RESPONSIBLE FOR THE REMOVAL OF ANY SEDIMENT THAT LEAVES THE SITE AND CHANGES ANY DOWNSTREAM CONDITIONS BY RAISING CHANNEL BOTTOMS AND/OR CLOGGING SMALL CULVERTS.
34. THE CONTRACTOR SHALL PAY FOR ANY WATER QUALITY CONTROL VIOLATIONS FROM ANY AGENCY THAT RESULTS IN FINES BEING ASSESSED TO THE COMPANY BECAUSE OF THE CONTRACTOR'S FAILURE TO ELIMINATE TURBID RUNOFF FROM LEAVING THE SITE AND RAISING BACKGROUND LEVELS ABOVE EXISTING BACKGROUND LEVEL.
35. A MINIMUM OF ONE OF THE EROSION CONTROL MEASURE OPTIONS SHOWN FOR ALL DROP INLETS WILL BE USED BY THE CONTRACTOR.
36. FLOATING TURBIDITY BARRIERS WILL BE PLACED AT ALL OUTFALL LOCATIONS IF BRANCHES ARE PRESENT. BARRIERS WILL NOT BE PLACED OVER THEM. THE FLOATING TURBIDITY BARRIERS SHALL BE INSTALLED IN A MANNER TO PREVENT MANUA ENTANGLEMENT.
37. SILT FENCES OR HAYBALES WILL BE USED ALONG BOTH SIDES OF LIMITS OF CONSTRUCTION TO MINIMIZE OFF-SITE SILTATION VIOLATION.

EROSION AND SEDIMENT CONTROL NOTES




STORMWATER POLLUTION PREVENTION PLAN FOR CONSTRUCTION

EROSION AND SEDIMENT CONTROL GENERAL NOTE:

THE FOLLOWING DETAILS AND SPECIFICATIONS ARE BEST MANAGEMENT PRACTICES (BMPs) FOR EROSION AND SEDIMENT CONTROL FOR CONSTRUCTION ACTIVITY. THE FOOT MANUAL AND FLORIDA'S EROSION AND SEDIMENT CONTROL MANUAL MAY BE UTILIZED TO MEET EROSION AND SETTLEMENT CONTROL REQUIREMENTS. THESE DETAILS, SPECIFICATIONS, AND STANDARDS ARE PRESENTED OR REFERENCED HERE ONLY AS A SUGGESTED APPROACH DEVELOPED FOR USE BY THE OWNER, THE DESIGN PROFESSIONAL, AND/OR THE CONTRACTOR IN THE SELECTION, THE DESIGN, AND THE IMPLEMENTATION OF APPROPRIATE POLLUTION PREVENTION TECHNIQUES TO COMPLY WITH THE NPDES STORM WATER REGULATIONS ESTABLISHED BY THE FDEP FOR CONSTRUCTION ACTIVITY.

IT IS THE RESPONSIBILITY OF THE DESIGN PROFESSIONAL TO PREPARE A STORMWATER POLLUTION PREVENTION PLAN THAT INCLUDES SITE-SPECIFIC BMPs. IT IS THE RESPONSIBILITY OF THE CONTRACTOR TO PREPARE AN EROSION AND SEDIMENT CONTROL PLAN AND TO IMPLEMENT BMPs PURSUANT TO THAT PLAN. IF SITE CONDITIONS WARRANT ADDITIONAL BMPs, THE CONTRACTOR SHALL IMPLEMENT THOSE BMPs ACCORDINGLY.

EROSION AND SEDIMENT CONTROL GENERAL NOTE

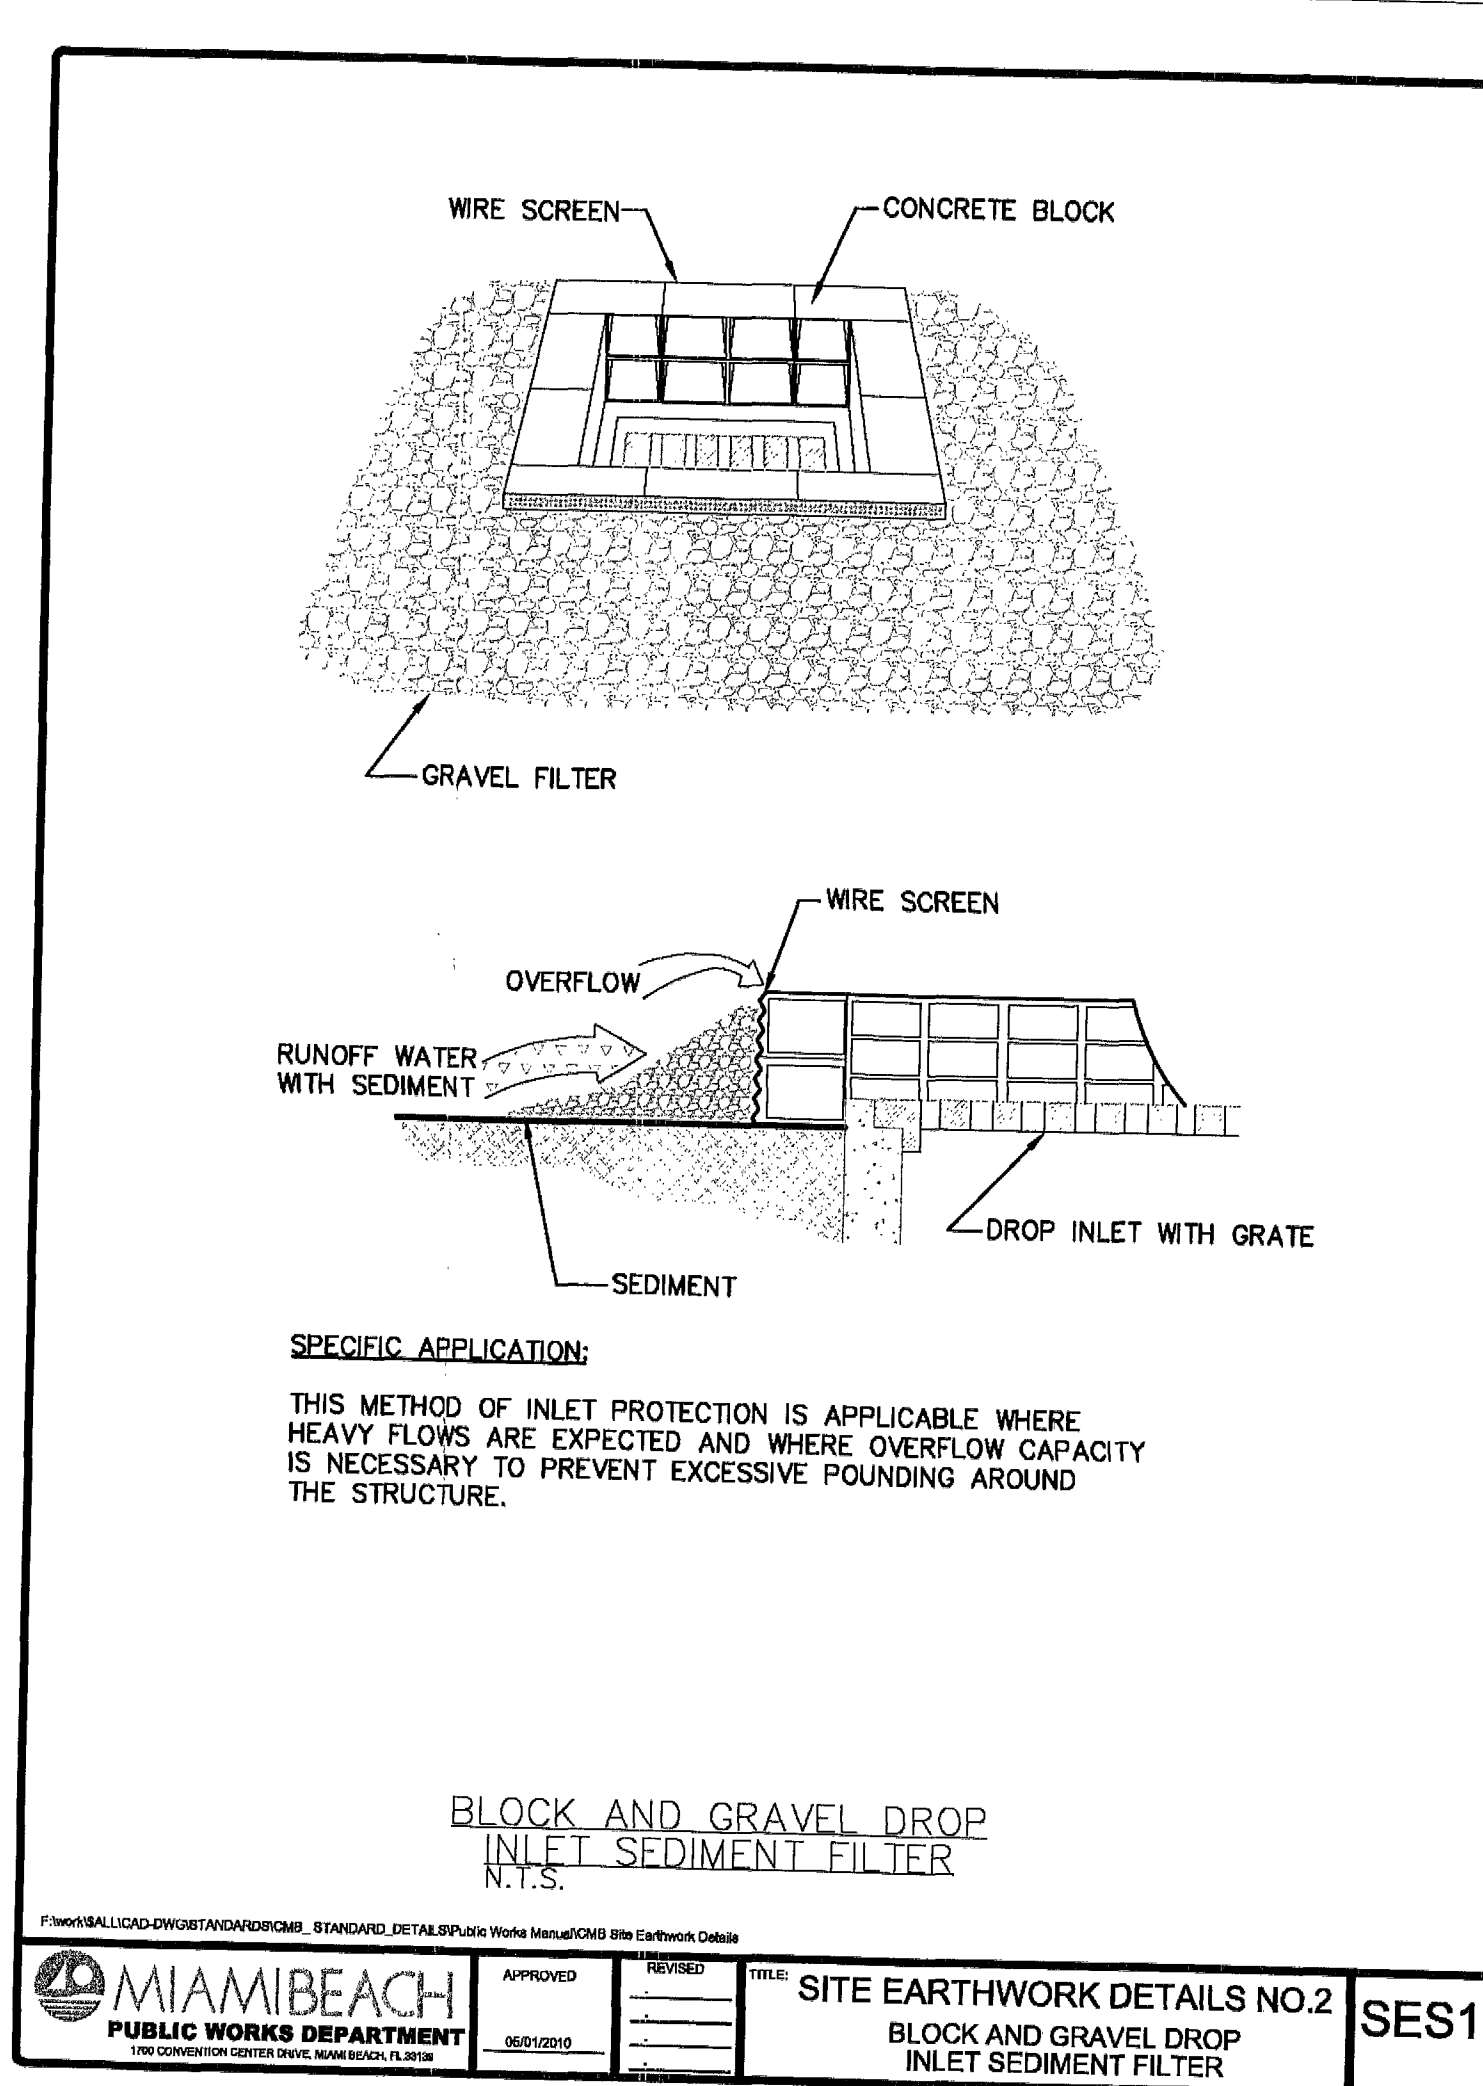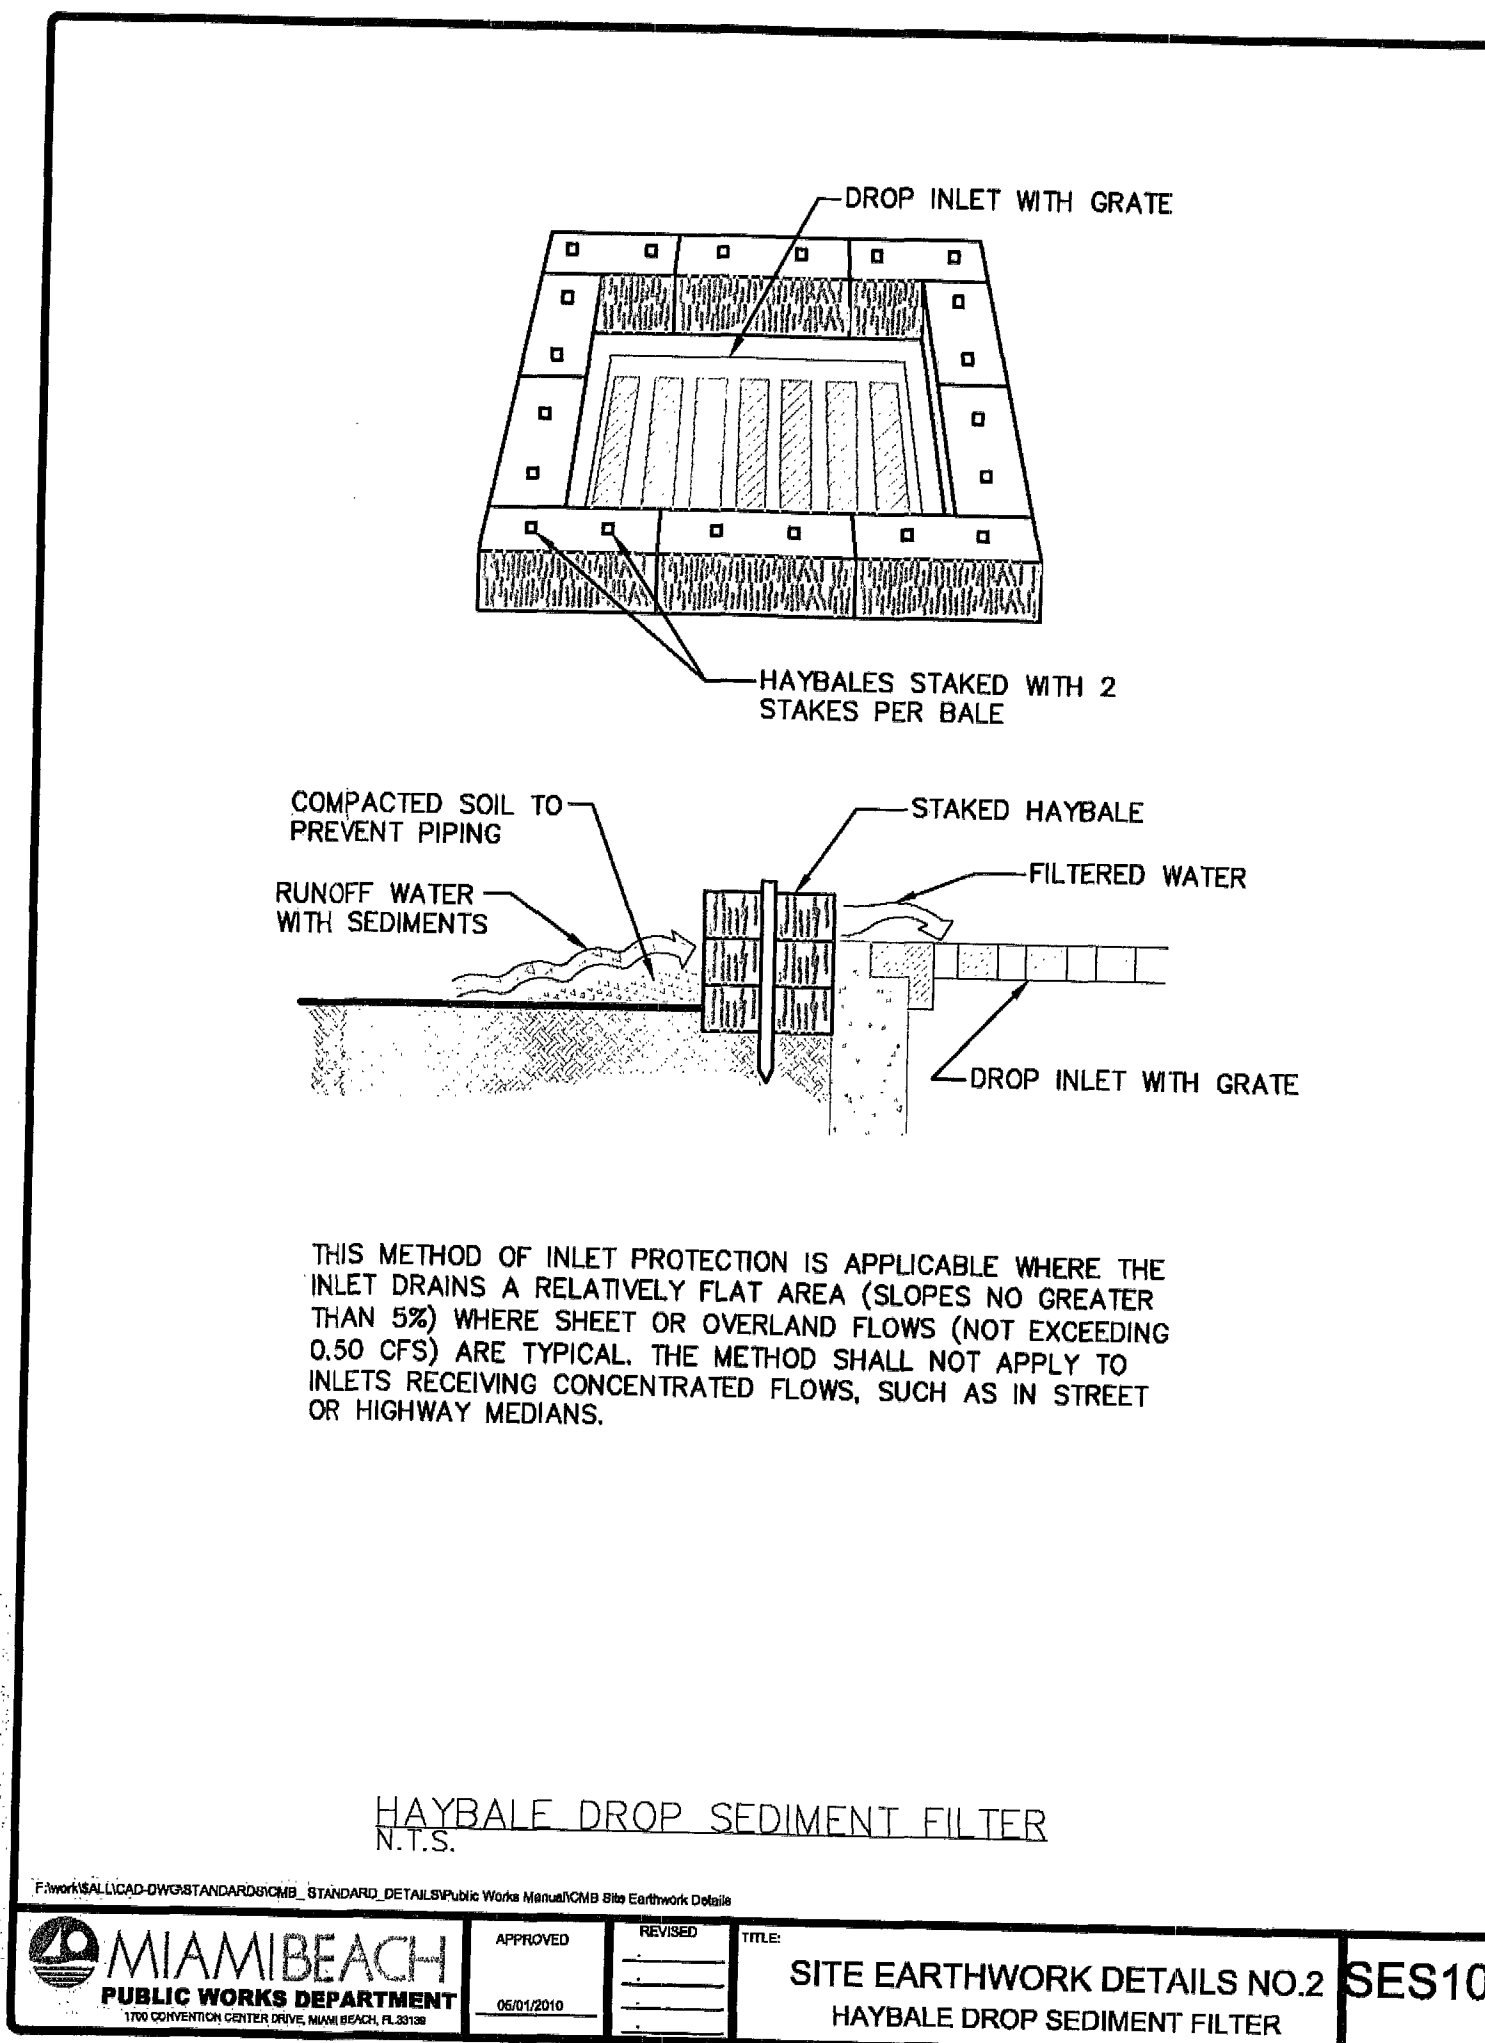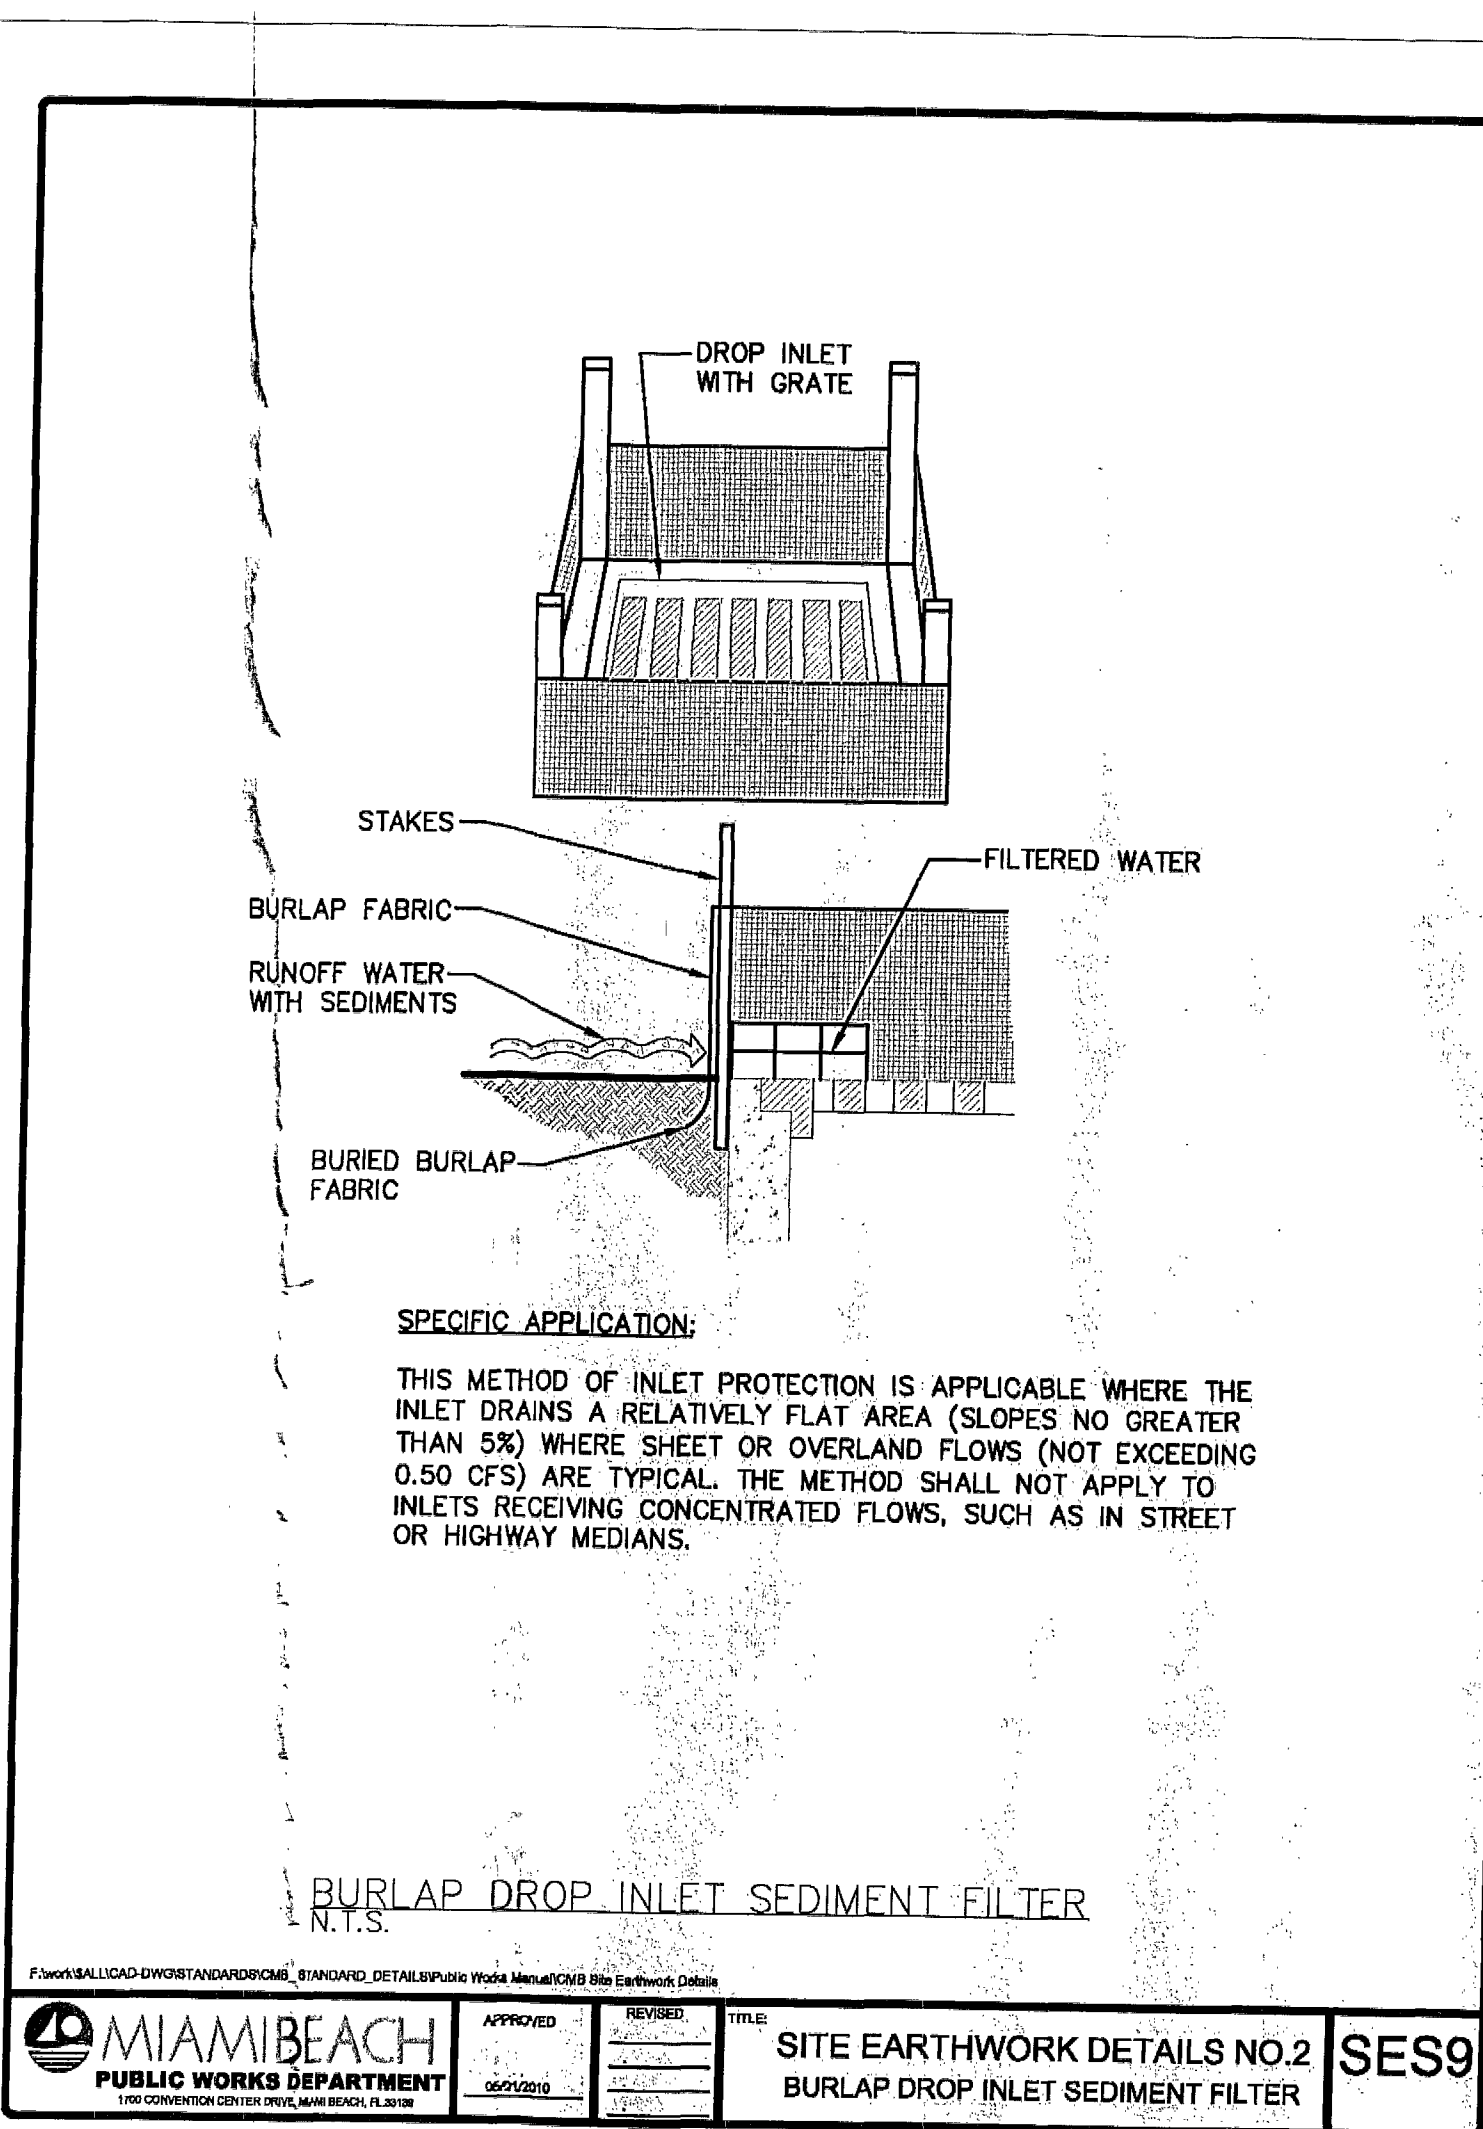

DRAWN BY:	
REVISIONS:	
2	11-01-15

AA0003669
ANTHONY LEON
0006762

DESIGN
ARCHITECTURE


4300 Biscayne Blvd. #G-04, Miami, FL 33137
P: 305.438.9377 | F: 305.438.9379

NOV 20 2015

NEW RESIDENCE
AT
4354 ALTON ROAD
MIAMI BEACH, FL 33139

THESE PLANS ARE FOR BUILDING DEPARTMENT REVIEW ONLY. THEY ARE NOT TO BE CONSIDERED AS CONSTRUCTION DOCUMENTS UNTIL ALL BUILDING DEPARTMENT APPROVALS ARE OBTAINED.

A.1.2
PUBLIC WORKS
DETAILS & NOTES

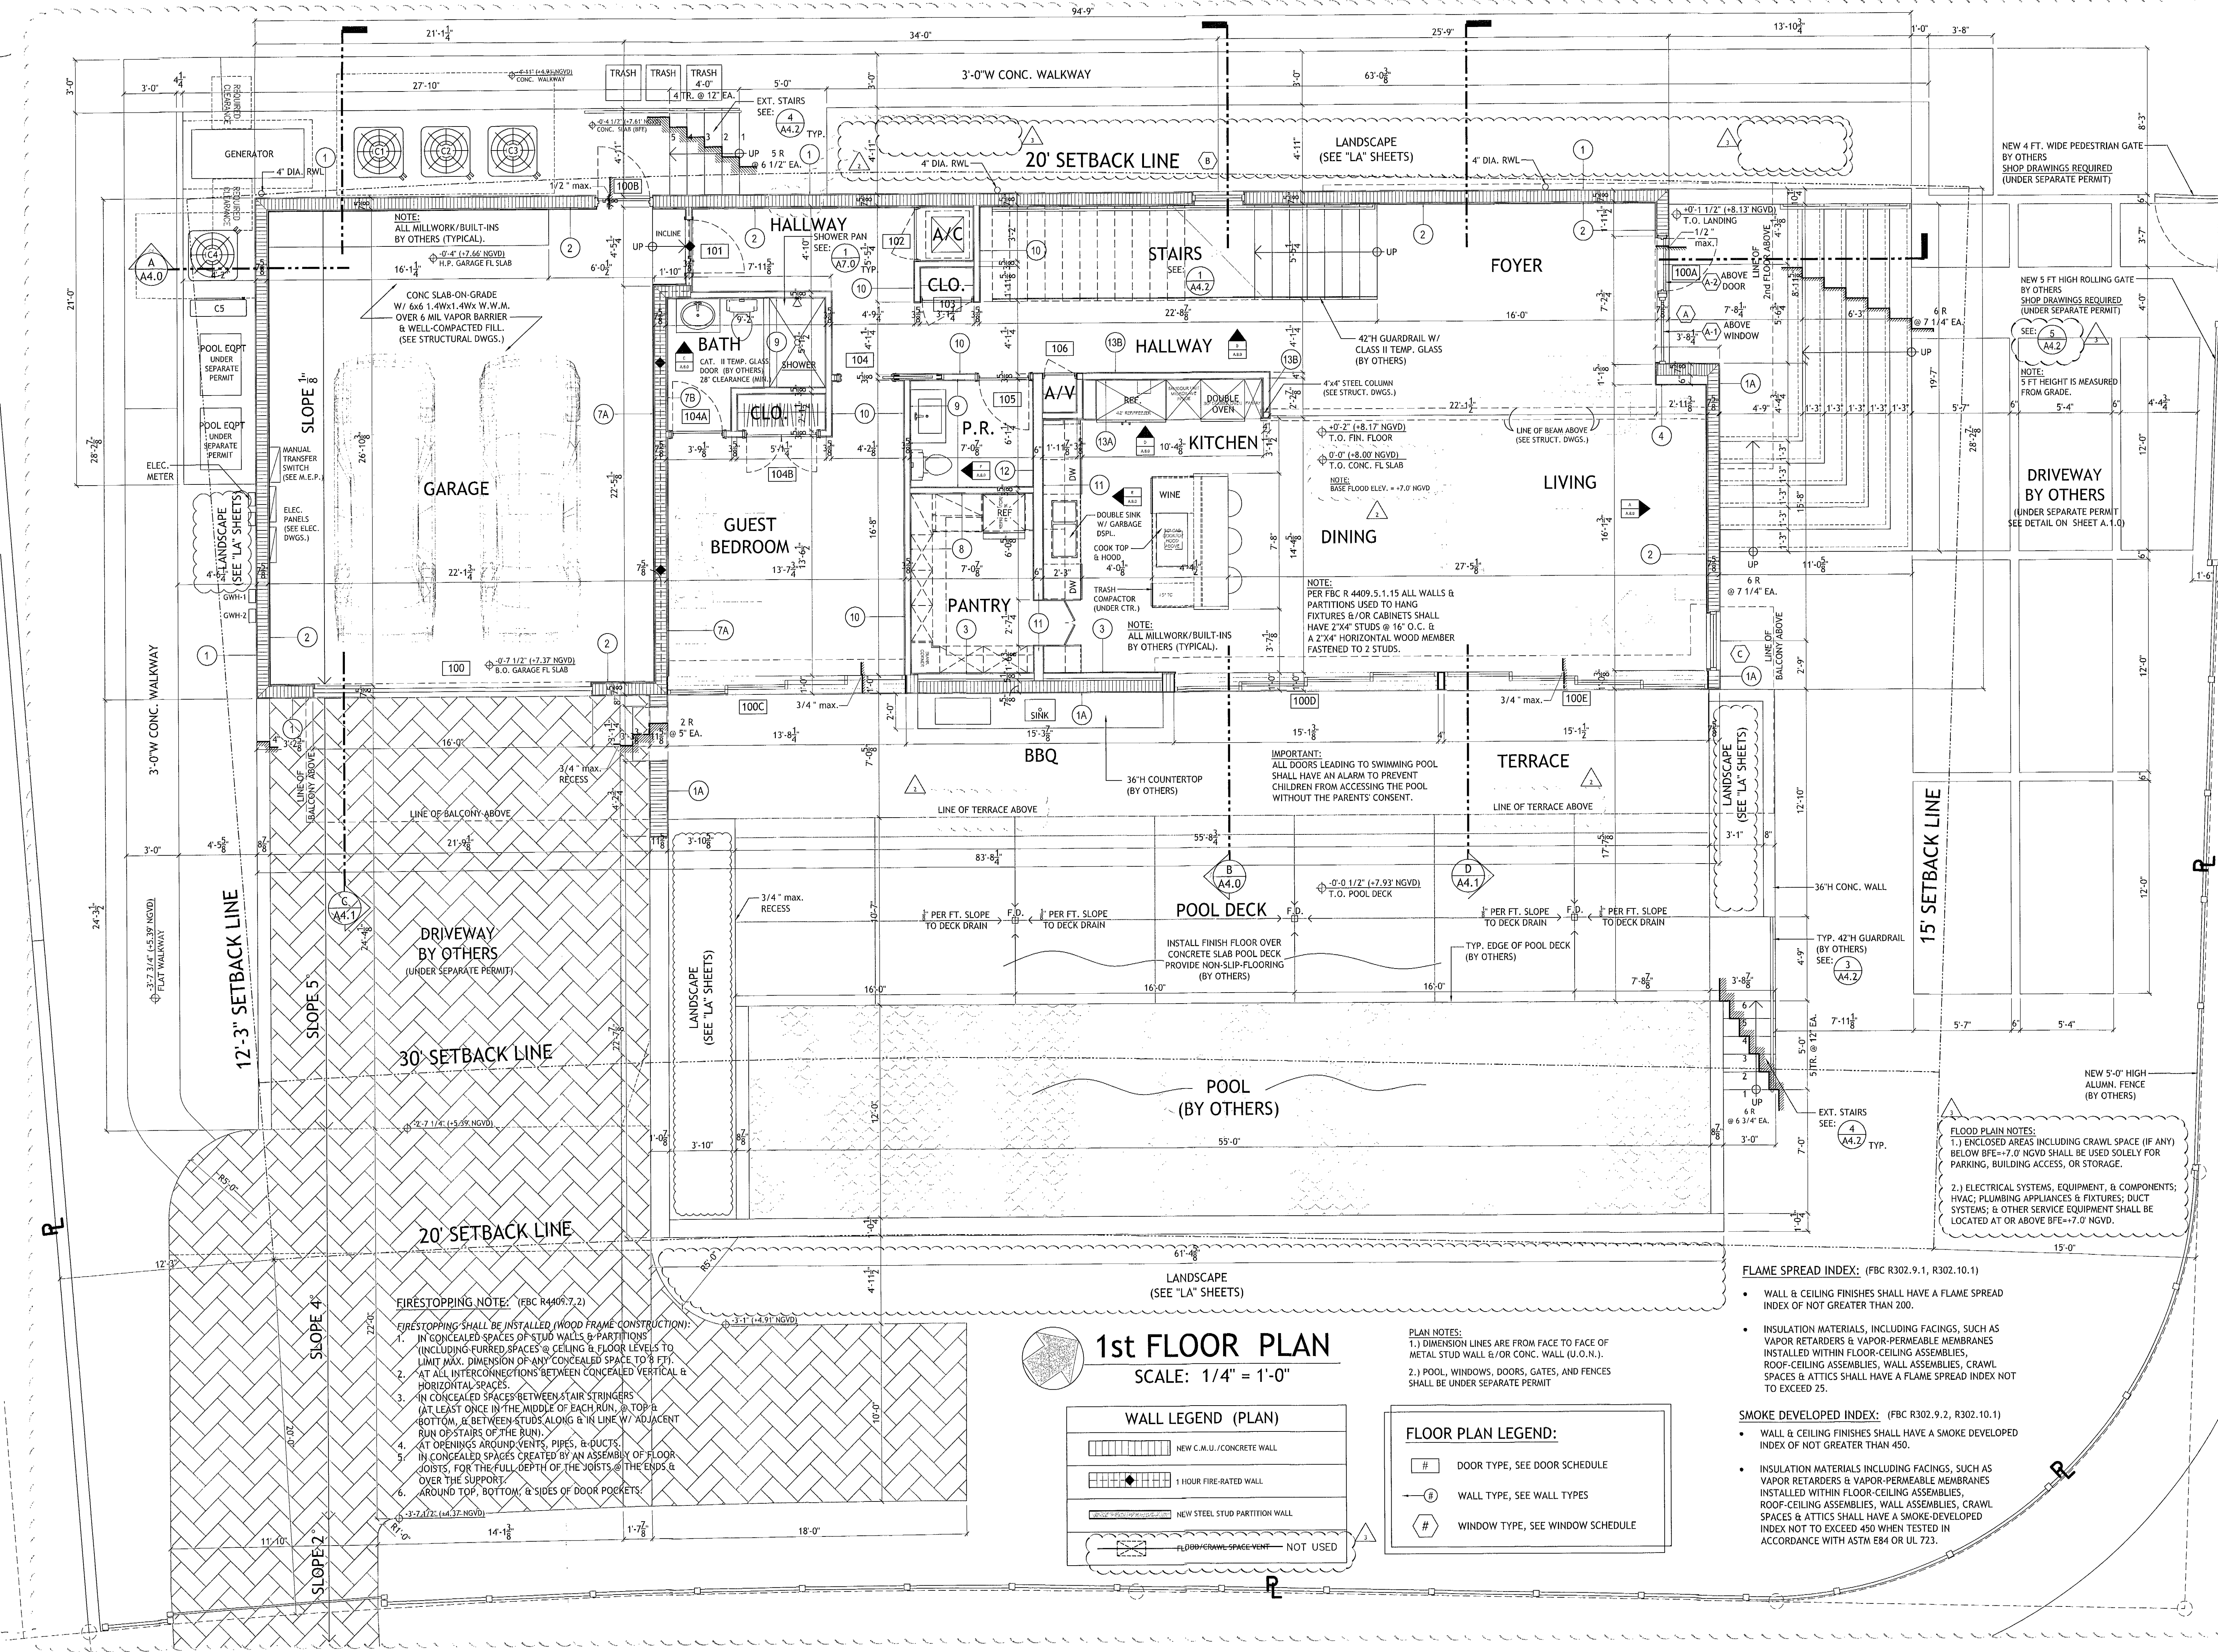

FIRESTOPPING NOTE: (FBC R409.7.2)
FIRESTOPPING SHALL BE INSTALLED (WOOD FRAME CONSTRUCTION):
1. IN CONCEALED SPACES OF STUD WALLS & PARTITIONS (INCLUDING FURRED SPACES @ CEILING & FLOOR LEVELS TO LIMIT MAX. DIMENSION OF ANY CONCEALED SPACE TO 8 FT.).
2. AT ALL INTERCONNECTIONS BETWEEN CONCEALED VERTICAL & HORIZONTAL SPACES.
3. IN CONCEALED SPACES BETWEEN STAIR STRINGERS (AT LEAST ONCE IN THE MIDDLE OF EACH RUN, @ TOP & BOTTOM, & BETWEEN STUDS ALONG & IN LINE W/ ADJACENT RUN OF STAIRS OF THE RUN).
4. AT OPENINGS AROUND VENTS, PIPES, & DUCTS.
5. IN CONCEALED SPACES CREATED BY AN ASSEMBLY OF FLOOR JOISTS, FOR THE FULL DEPTH OF THE JOISTS @ THE ENDS & OVER THE SUPPORT.
6. AROUND TOP, BOTTOM, & SIDES OF DOOR POCKETS.

1st FLOOR PLAN

SCALE: 1/4" = 1'-0"

WALL LEGEND (PLAN)	
	NEW C.M.U./CONCRETE WALL
	1 HOUR FIRE-RATED WALL
	NEW STEEL STUD PARTITION WALL
	FLOOR/CRAWL SPACE VENT - NOT USED

PLAN NOTES:
1.) DIMENSION LINES ARE FROM FACE TO FACE OF METAL STUD WALL &/OR CONC. WALL (U.O.N.).
2.) POOL, WINDOWS, DOORS, GATES, AND FENCES SHALL BE UNDER SEPARATE PERMIT

FLOOR PLAN LEGEND:	
	DOOR TYPE, SEE DOOR SCHEDULE
	WALL TYPE, SEE WALL TYPES
	WINDOW TYPE, SEE WINDOW SCHEDULE

FLAME SPREAD INDEX: (FBC R302.9.1, R302.10.1)

- WALL & CEILING FINISHES SHALL HAVE A FLAME SPREAD INDEX OF NOT GREATER THAN 200.
- INSULATION MATERIALS, INCLUDING FACINGS, SUCH AS VAPOR RETARDERS & VAPOR-PERMEABLE MEMBRANES INSTALLED WITHIN FLOOR-CEILING ASSEMBLIES, ROOF-CEILING ASSEMBLIES, WALL ASSEMBLIES, CRAWL SPACES & ATTICS SHALL HAVE A FLAME SPREAD INDEX NOT TO EXCEED 25.

SMOKE DEVELOPED INDEX: (FBC R302.9.2, R302.10.1)

- WALL & CEILING FINISHES SHALL HAVE A SMOKE DEVELOPED INDEX OF NOT GREATER THAN 450.
- INSULATION MATERIALS INCLUDING FACINGS, SUCH AS VAPOR RETARDERS & VAPOR-PERMEABLE MEMBRANES INSTALLED WITHIN FLOOR-CEILING ASSEMBLIES, ROOF-CEILING ASSEMBLIES, WALL ASSEMBLIES, CRAWL SPACES & ATTICS SHALL HAVE A SMOKE-DEVELOPED INDEX NOT TO EXCEED 450 WHEN TESTED IN ACCORDANCE WITH ASTM E84 OR UL 723.

FLOOD PLAIN NOTES:
1.) ENCLOSED AREAS INCLUDING CRAWL SPACE (IF ANY) BELOW BFE=+7.0' NGVD SHALL BE USED SOLELY FOR PARKING, BUILDING ACCESS, OR STORAGE.
2.) ELECTRICAL SYSTEMS, EQUIPMENT, & COMPONENTS; HVAC; PLUMBING APPLIANCES & FIXTURES; DUCT SYSTEMS; & OTHER SERVICE EQUIPMENT SHALL BE LOCATED AT OR ABOVE BFE=+7.0' NGVD.

DRAWN BY:
REVISIONS:
12-18-15
11-01-15
8-14-15

AA003659
ANTHONY LEON
0010752


3 DESIGN
ARCHITECTURE
4300 Biscayne Blvd. #G-04, Miami, FL 33137
P: 305.438.9377 | F: 305.438.9379

JAN 11 2016
SEAL

NEW RESIDENCE
AT:
4354 ALTON ROAD
MIAMI BEACH, FL 33139

THESE PLANS ARE FOR BUILDING DEPARTMENT REVIEW ONLY. THEY ARE NOT TO BE CONSTRUED AS CONSTRUCTION DOCUMENTS UNTIL ALL BUILDING DEPARTMENT APPROVALS ARE OBTAINED.

A.2.1
1st FLOOR PLAN

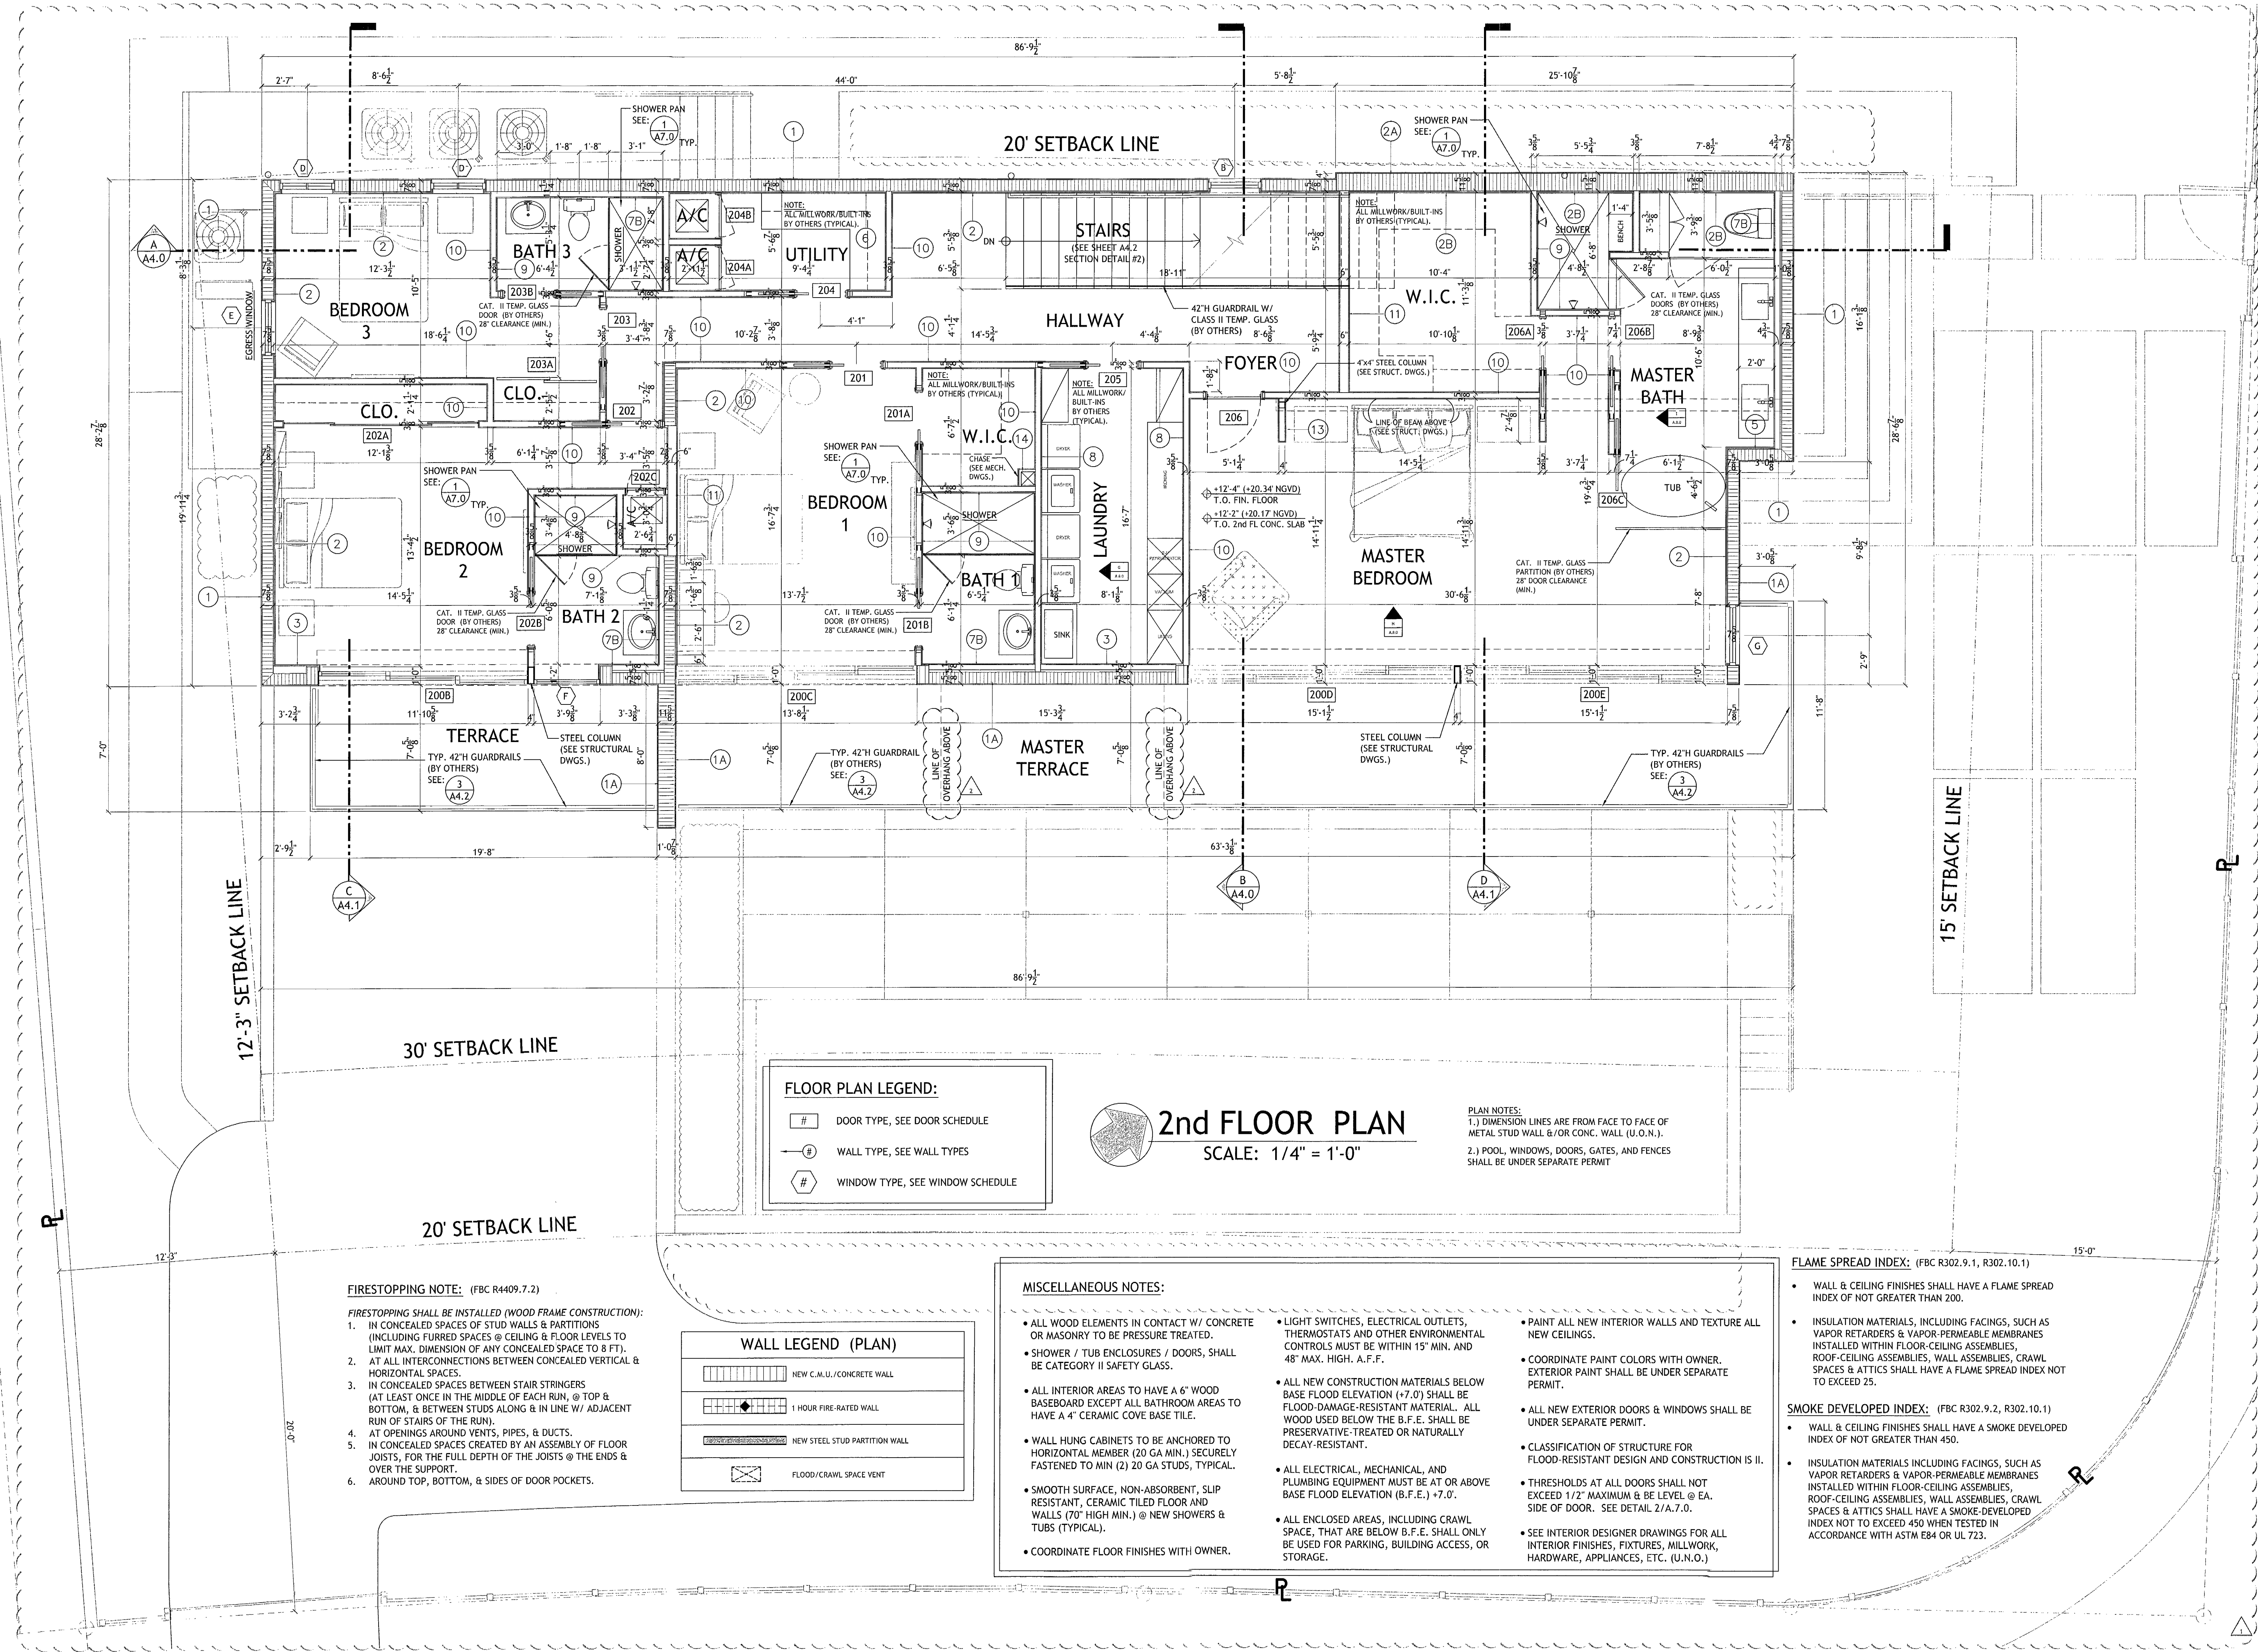

DRAWN BY:
REVISIONS:
11-01-15
8-14-15

AA00035689
ANTHONY LEON
0016752
3
DESIGN
ARCHITECTURE
4300 Biscayne Blvd., #G-04, Miami, FL 33137
P: 305.438.9377 | F: 305.438.9379




NOV 20 2015
SEAL

NEW RESIDENCE
AT:
4354 ALTON ROAD
MIAMI BEACH, FL 33139

A.2.2
2nd FLOOR PLAN

- REFLECTED CEILING NOTES:
1. ALL WORK TO BE NEW U.O.N.
 2. REFER TO REFLECTED CEILING PLAN FOR CEILING HEIGHTS. VERIFY THIS DIMENSION WITH THE PERIMETER WINDOW HEAD CONDITION AND REVIEW WITH THE ARCHITECT/DESIGNER PRIOR TO START OF CONSTRUCTION.
 3. ALL DIMENSIONS OF FIXTURES, DEVICES, ETC. ARE TO CENTERLINE OF FIXTURE, U.O.N. WHERE ITEMS ARE IN LINE, CENTERLINE OF ITEMS OR GROUP OF ITEMS TO ALIGN, U.O.N.
 4. ALL MEP-PP DEVICE LOCATIONS NOT SHOWN ON DRAWINGS, OR IN CONFLICT WITH MEP-PP DRAWINGS, ARE TO BE COORDINATED WITH ARCHITECT PRIOR TO INSTALLATION.
 5. CONTRACTOR TO COORDINATE LOCATIONS OF ALL CEILING ELEMENTS AND PROVIDE COMPLETE COORDINATION DRAWINGS FOR THE ARCHITECT, INTERIOR DESIGNER AND ENGINEER'S REVIEW FOR APPROVAL.
 6. REFER AND COORDINATE WITH I.D. DRAWINGS FOR FINISHES.
 7. ALL SMOKE DETECTORS SHOWN ARE NEW, AND SHALL BE 120v BATTERY INTERCONNECTED, 36" MIN. AWAY FROM ANY A/C SUPPLY REGISTER. TYPICAL.
 8. COORDINATE LOCATIONS OF CEILING ACCESS PANELS WITH LOCATIONS OF A/C UNITS ABOVE CEILING.

REFLECTED CEILING PLAN LEGEND:

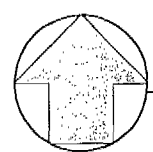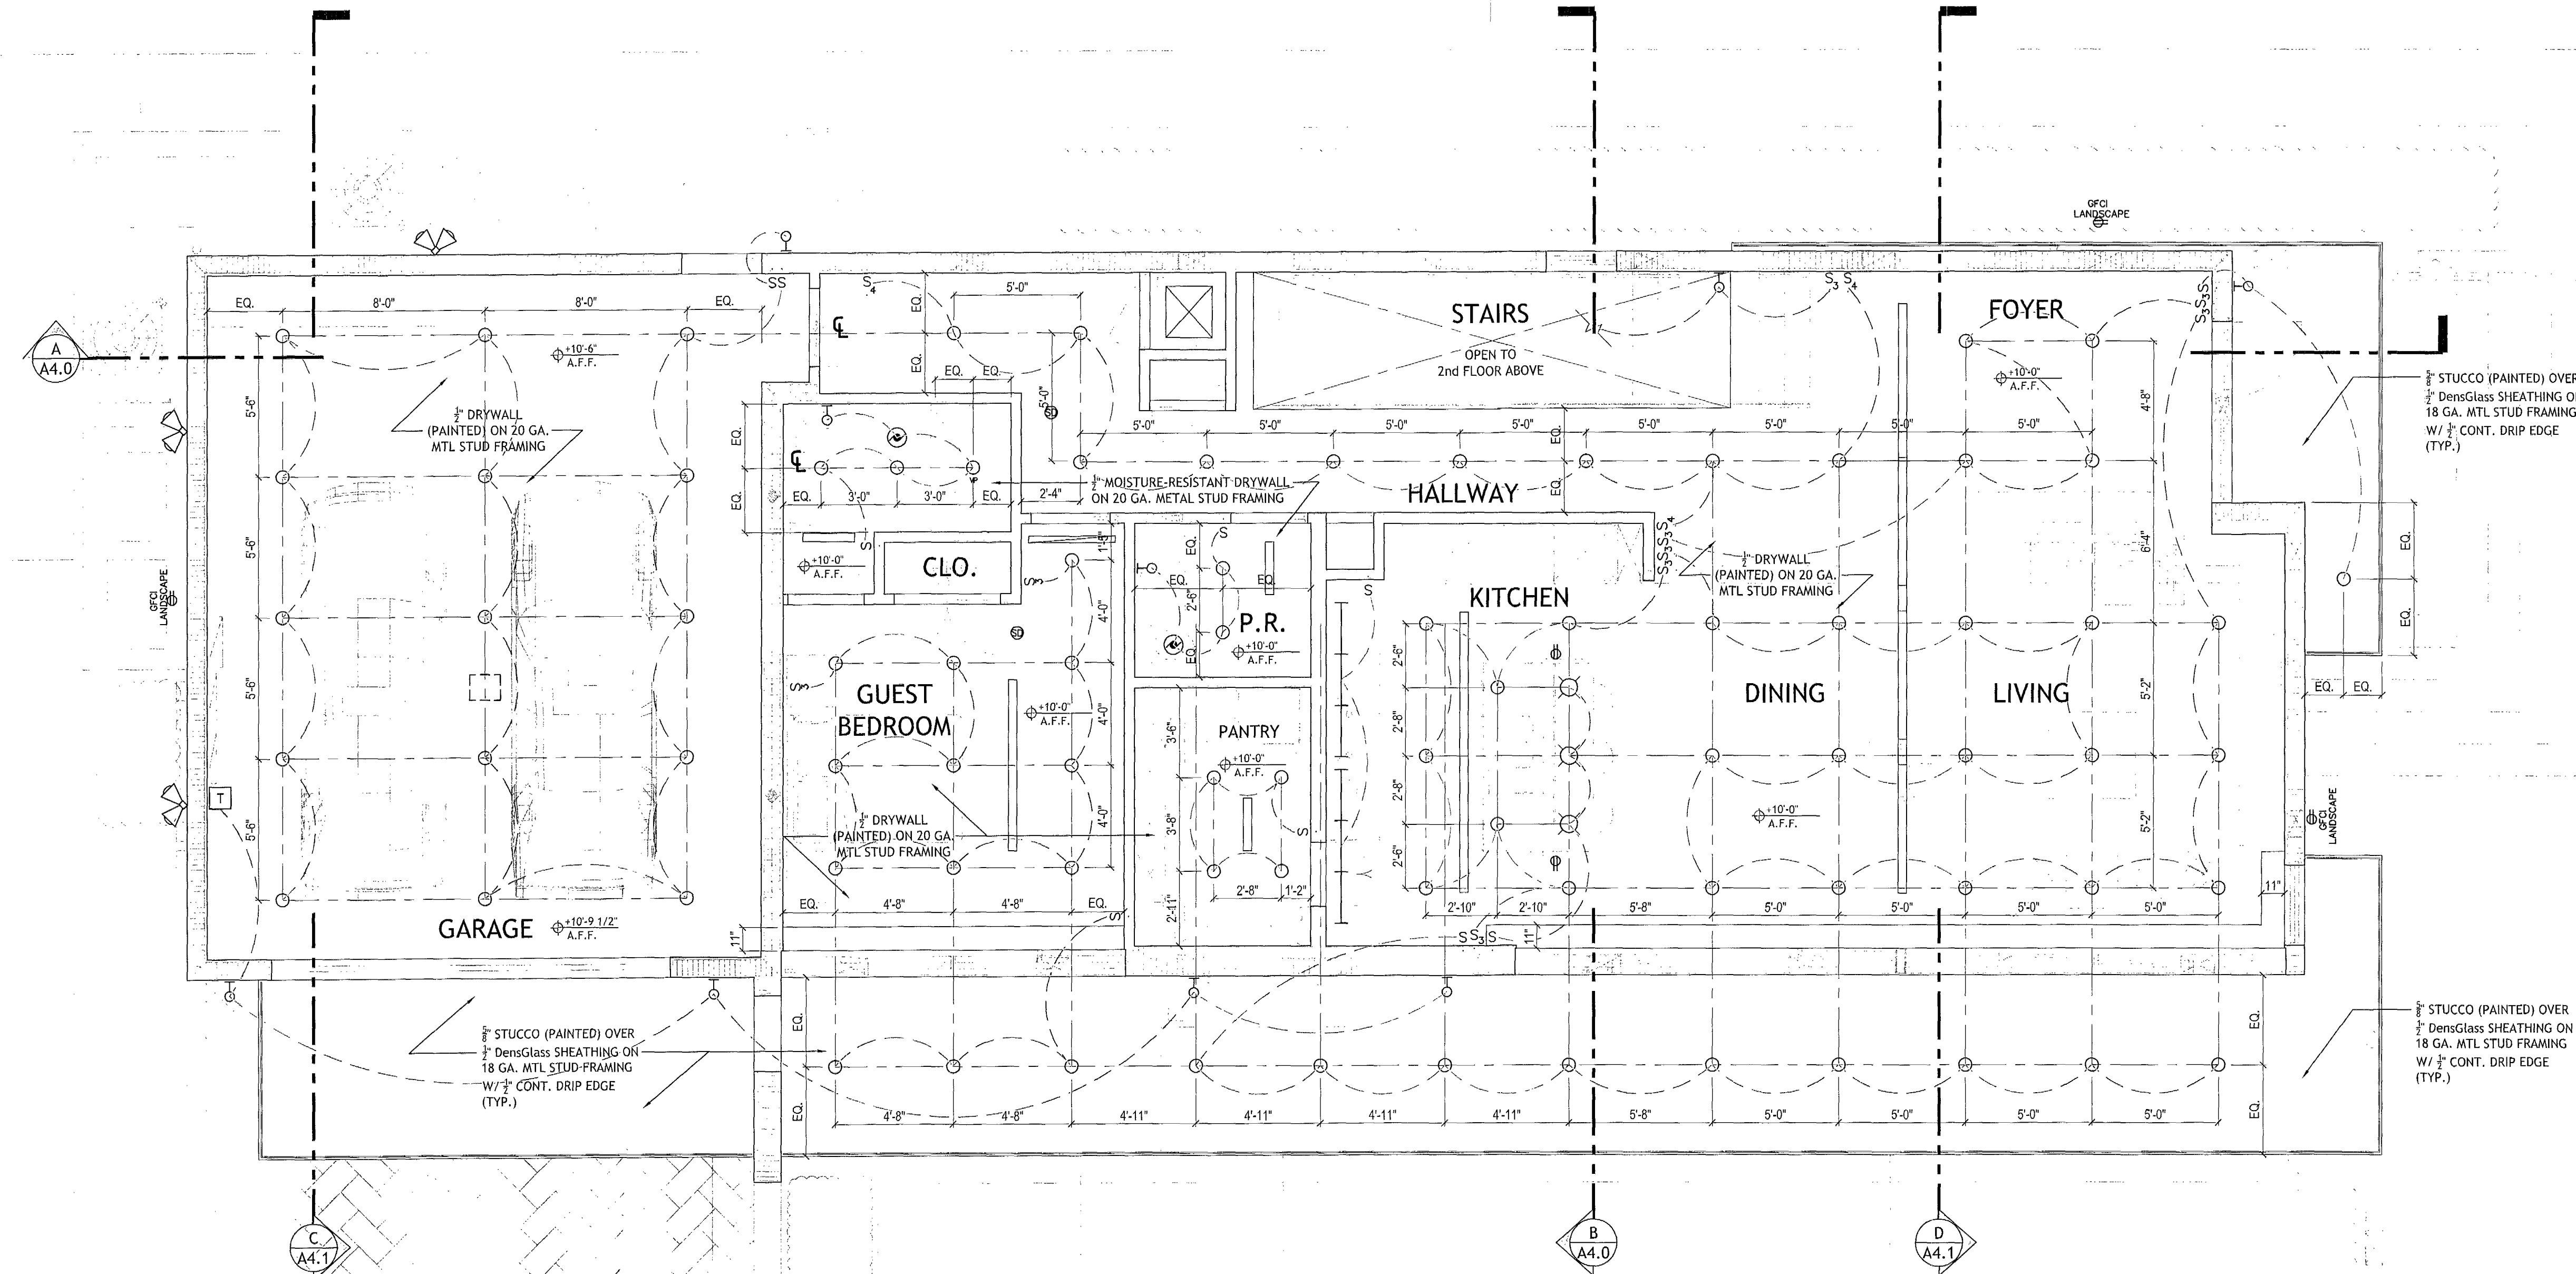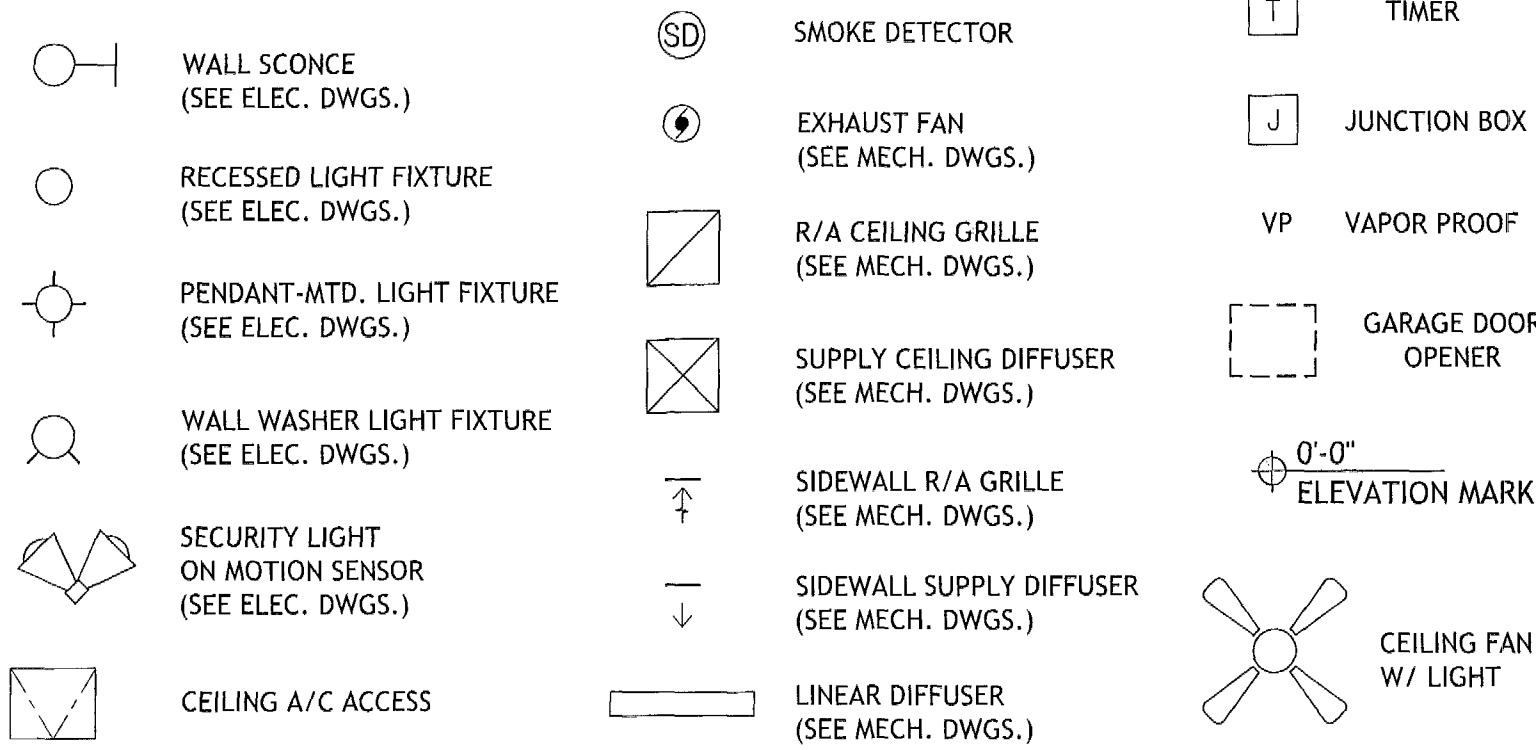

1st FLOOR REFLECTED CEILING PLAN

SCALE: 1/4" = 1'-0"

NOTE:
ALL NEW CEILINGS/SOFFITS SHALL BE CONSTRUCTED OF
1/2" G.W.B. (PAINTED) ON 20 GA 1-5/8" MTL STUDS
@ 16" O.C. (MIN.) W/ DIAGONAL BRACING
@ EACH VERTICAL SUPPORT (WHERE POSSIBLE), TYPICAL.

DRAWN BY:
REVISIONS:
8-14-15

AAC003569
ANTHONY LEON
0016152

3 DESIGN
ARCHITECTURE
4300 Biscayne Blvd. #G-04, Miami, FL 33137
P: 305.438.9377 | F: 305.438.9379

SEAL
AUG 24 2015



NEW RESIDENCE
AT:
4354 ALTON ROAD
MIAMI BEACH, FL 33139

THESE PLANS ARE FOR BUILDING
DEPARTMENT REVIEW ONLY. THEY ARE NOT
TO BE CONSIDERED AS CONSTRUCTION
DOCUMENTS UNTIL ALL BUILDING
DEPARTMENT APPROVALS ARE OBTAINED.

A.2.3
1st FLOOR
REFLECTED
CEILING PLAN

- REFLECTED CEILING NOTES:
1. ALL WORK TO BE NEW U.O.N.
 2. REFER TO REFLECTED CEILING PLAN FOR CEILING HEIGHTS. VERIFY THIS DIMENSION WITH THE PERIMETER WINDOW HEAD CONDITION AND REVIEW WITH THE ARCHITECT/DESIGNER PRIOR TO START OF CONSTRUCTION.
 3. ALL DIMENSIONS OF FIXTURES, DEVICES, ETC. ARE TO CENTERLINE OF FIXTURE, U.O.N. WHERE ITEMS ARE IN LINE, CENTERLINE OF ITEMS OR GROUP OF ITEMS TO ALIGN, U.O.N.
 4. ALL MEP-FP DEVICE LOCATIONS NOT SHOWN ON DRAWINGS, OR IN CONFLICT WITH MEP-FP DRAWINGS, ARE TO BE COORDINATED WITH ARCHITECT PRIOR TO INSTALLATION.
 5. CONTRACTOR TO COORDINATE LOCATIONS OF ALL CEILING ELEMENTS AND PROVIDE COMPLETE COORDINATION DRAWINGS FOR THE ARCHITECT, INTERIOR DESIGNER AND ENGINEER'S REVIEW FOR APPROVAL.
 6. REFER AND COORDINATE WITH I.D. DRAWINGS FOR FINISHES.
 7. ALL SMOKE DETECTORS SHOWN ARE NEW, AND SHALL BE 120V BATTERY INTERCONNECTED, 36" MIN. AWAY FROM ANY A/C SUPPLY REGISTER. TYPICAL.
 8. COORDINATE LOCATIONS OF CEILING ACCESS PANELS WITH LOCATIONS OF A/C UNITS ABOVE CEILING.

REFLECTED CEILING PLAN LEGEND:

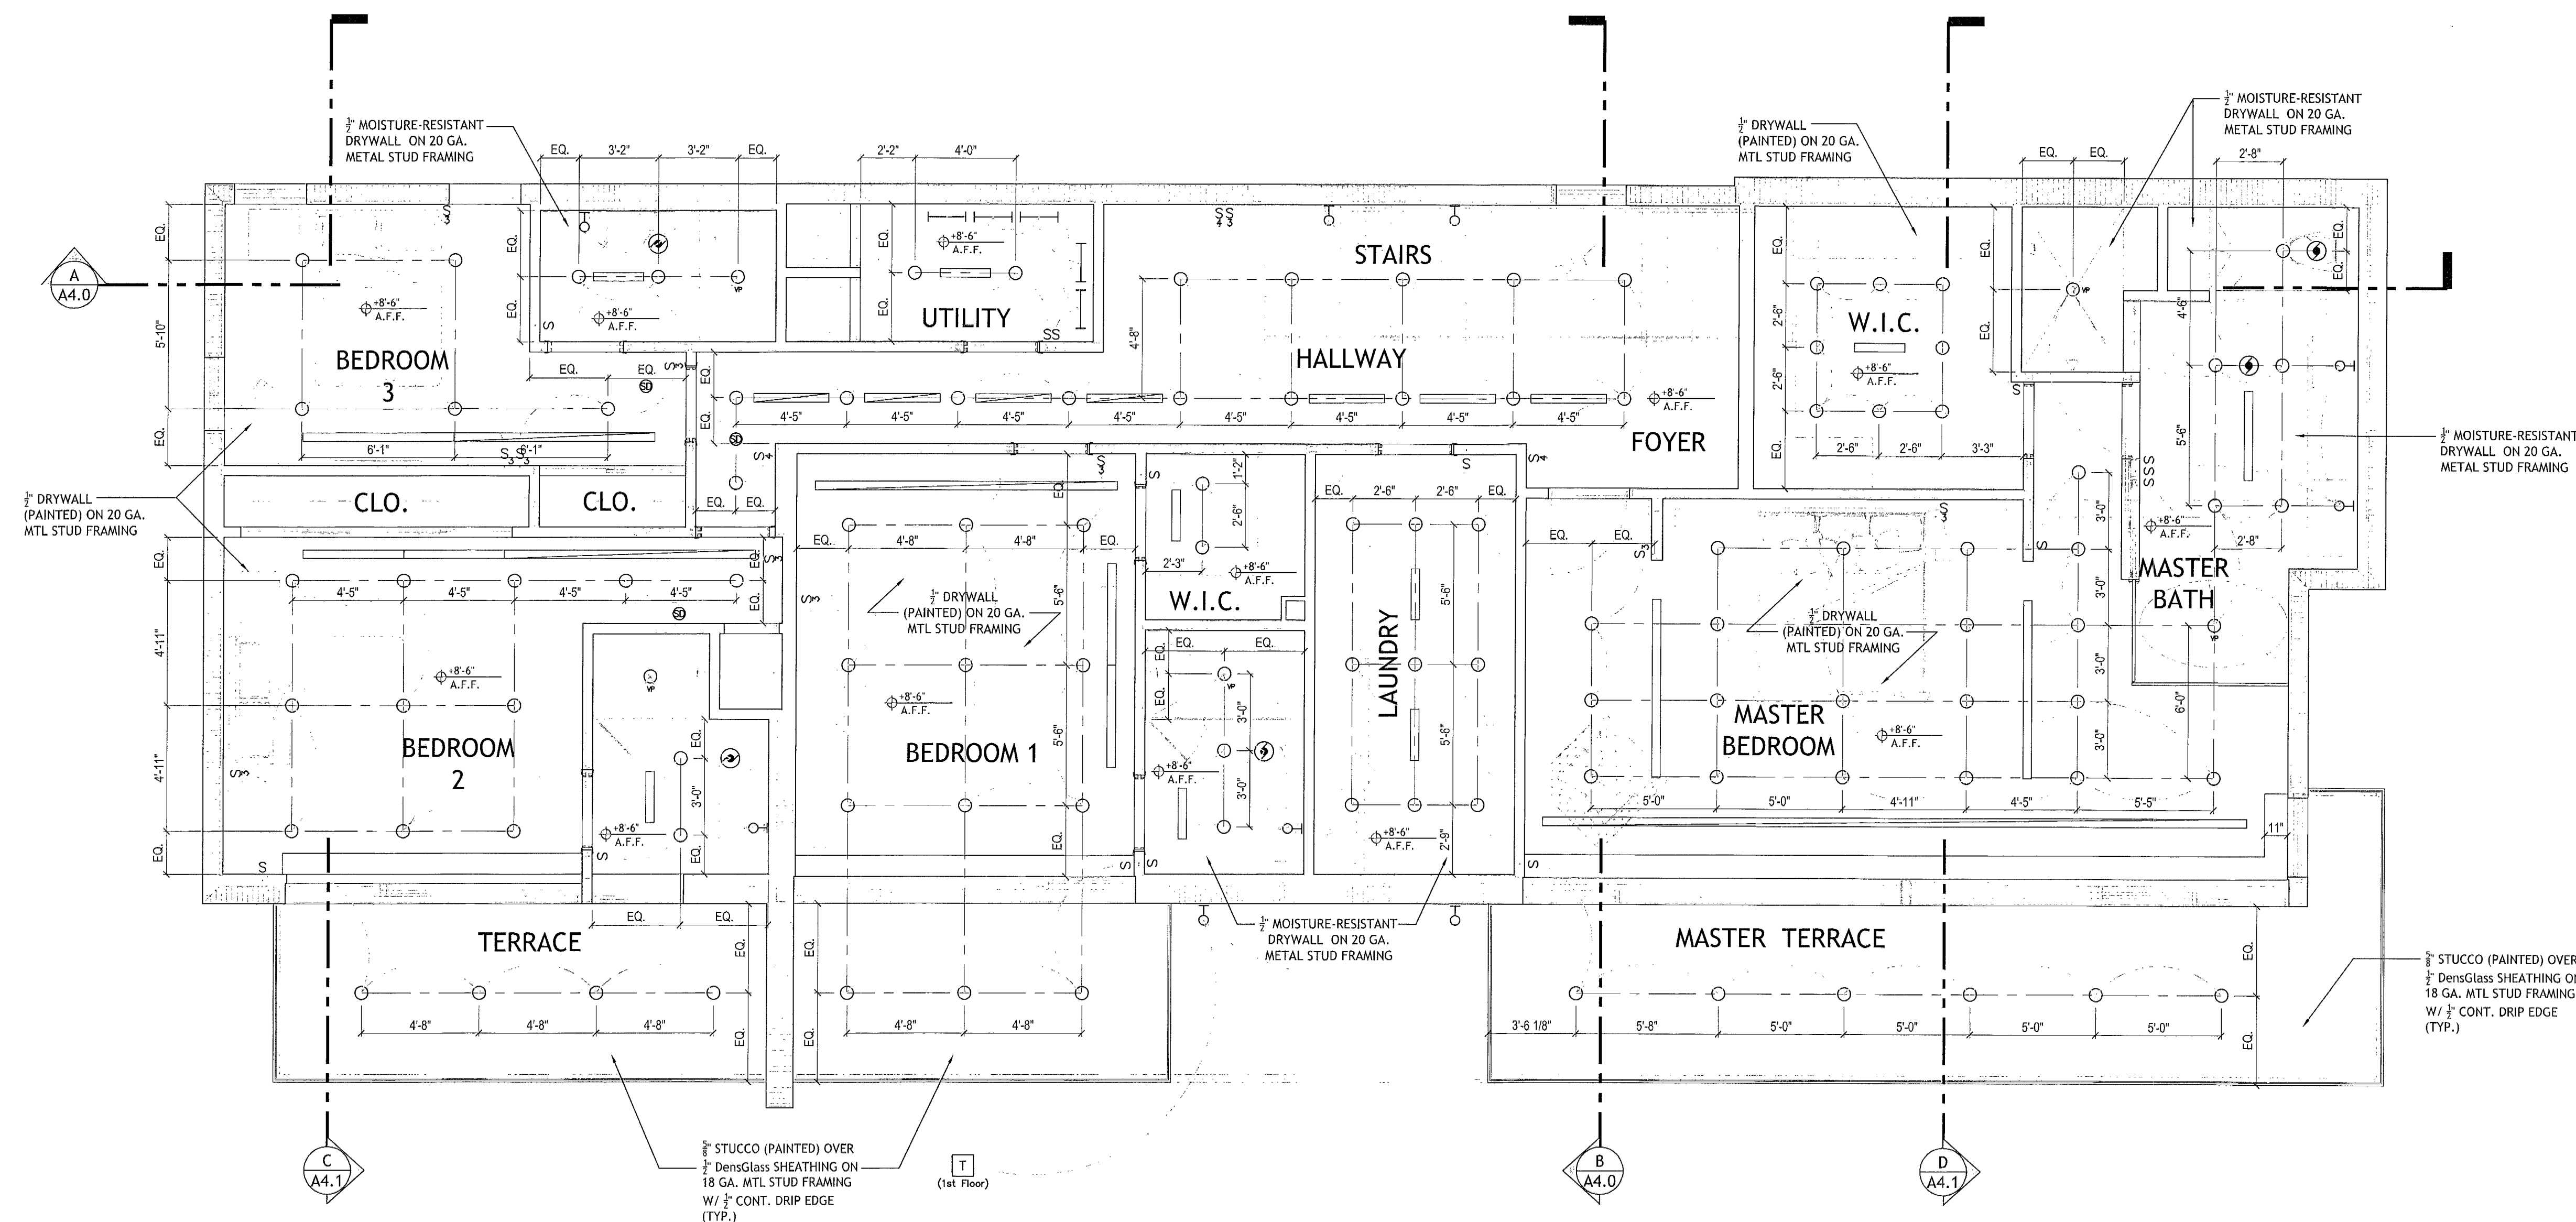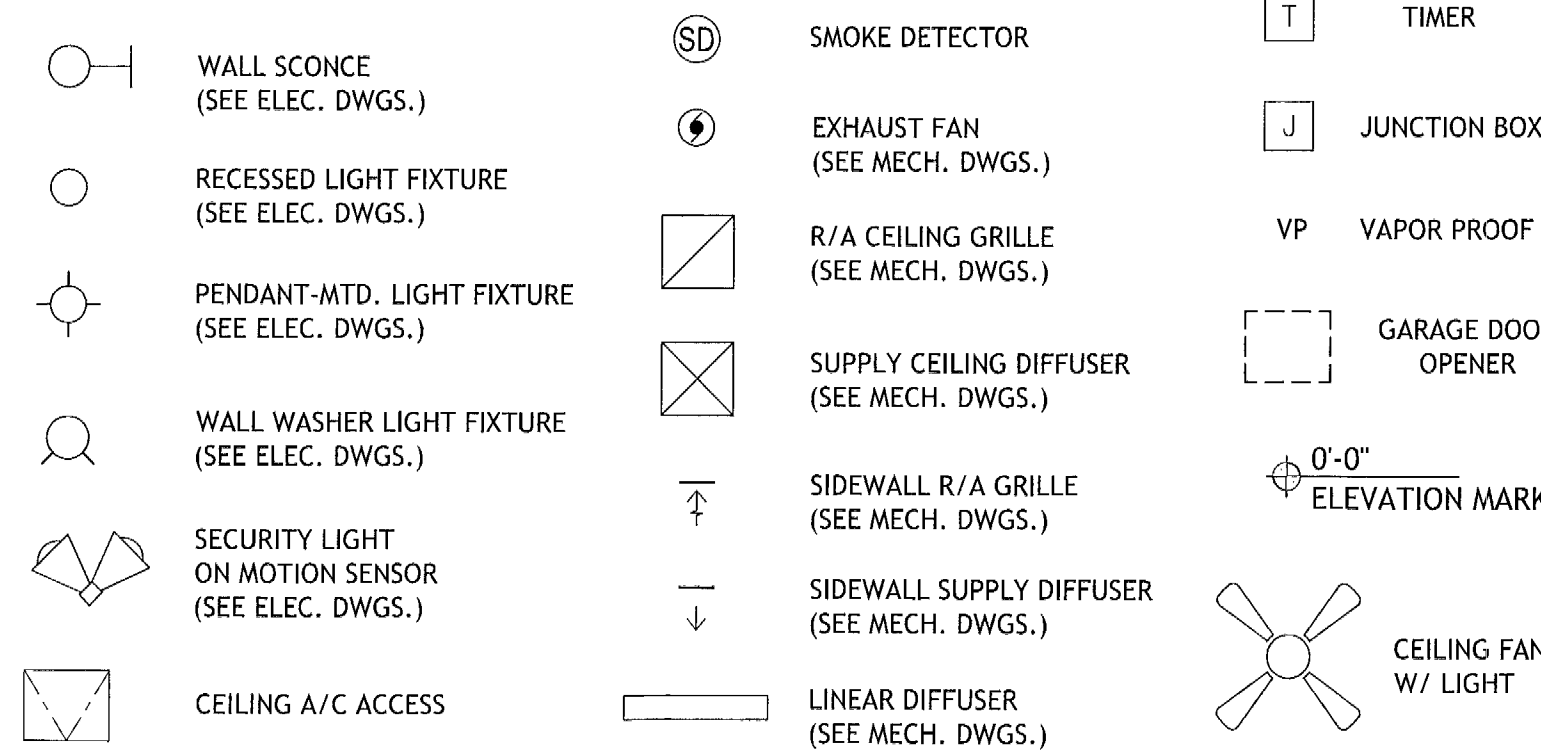

2nd FLOOR REFLECTED CEILING PLAN
SCALE: 1/4" = 1'-0"

NOTE:
ALL NEW CEILINGS/SOFFITS SHALL BE CONSTRUCTED OF
3/4" G.W.B. (PAINTED) ON 20 GA 1-3/8" MTL STUDS
@ 16" O.C. (MIN.) W/ DIAGONAL BRACING
@ EACH VERTICAL SUPPORT (WHERE POSSIBLE). TYPICAL.

DRAWN BY:
REVISIONS:
8-14-15

AAC003669
ANTHONY LEON
0016762


3 DESIGN
ARCHITECTURE
4300 Biscayne Blvd. #G-04, Miami, FL 33137
P: 305.438.9377 | F: 305.438.9375

SEAL
AUG 24 2015

NEW RESIDENCE
AT:
4354 ALTON ROAD
MIAMI BEACH, FL 33139

THESE PLANS ARE FOR BUILDING
DEPARTMENT REVIEW ONLY. THEY ARE NOT
TO BE CONSTRUED AS CONSTRUCTION
DOCUMENTS UNTIL ALL BUILDING
DEPARTMENT APPROVALS ARE OBTAINED.

A.2.4
2nd FLOOR
REFLECTED
CEILING PLAN

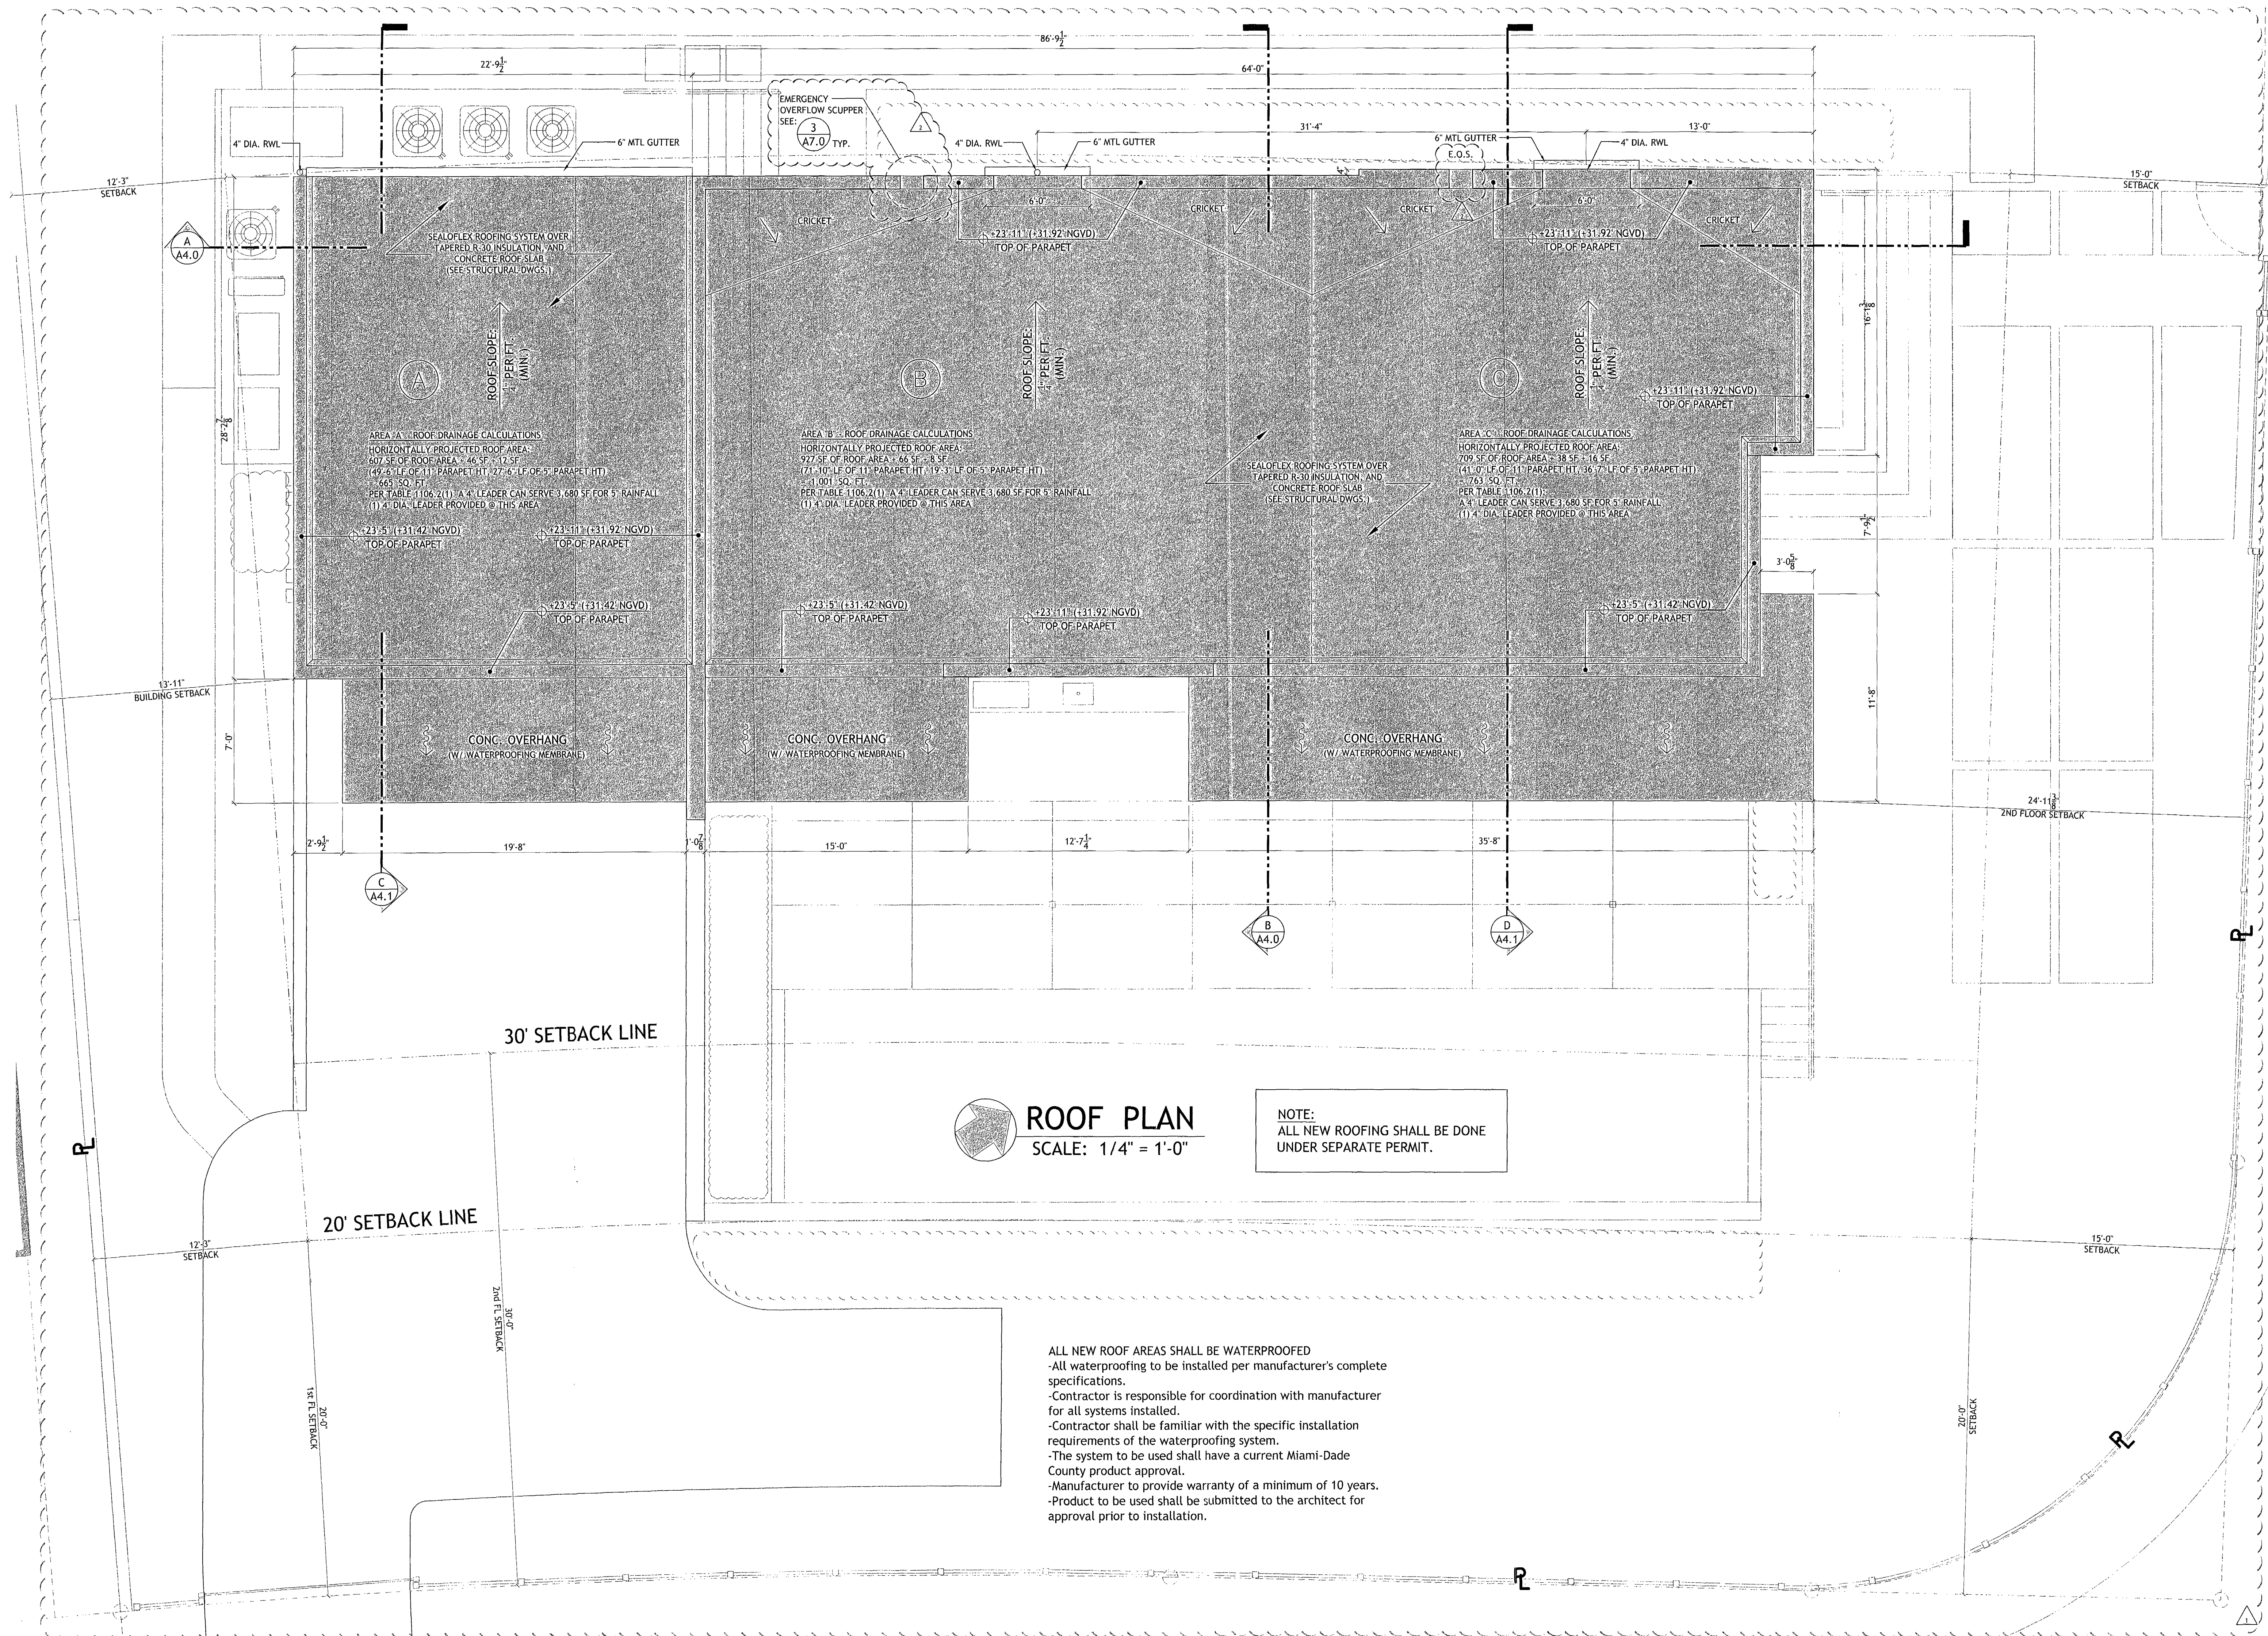



DRAWN BY:
REVISIONS:
11-01-15
8-14-15

A4000589
ANTHONY LEON
0016132
3
DESIGN
ARCHITECTURE
4300 Biscayne Blvd. #G-04, Miami, FL 33137
P: 305.438.9377 | F: 305.438.9379

SEAL
NOV 20 2015
NOV 20 2015

NEW RESIDENCE
AT
4354 ALTON ROAD
MIAMI BEACH, FL 33139

THESE PLANS ARE FOR BUILDING DEPARTMENT REVIEW ONLY. THEY ARE NOT TO BE CONSTRUED AS CONSTRUCTION DOCUMENTS UNTIL ALL BUILDING DEPARTMENT APPROVALS ARE OBTAINED.
A.2.5
ROOF PLAN

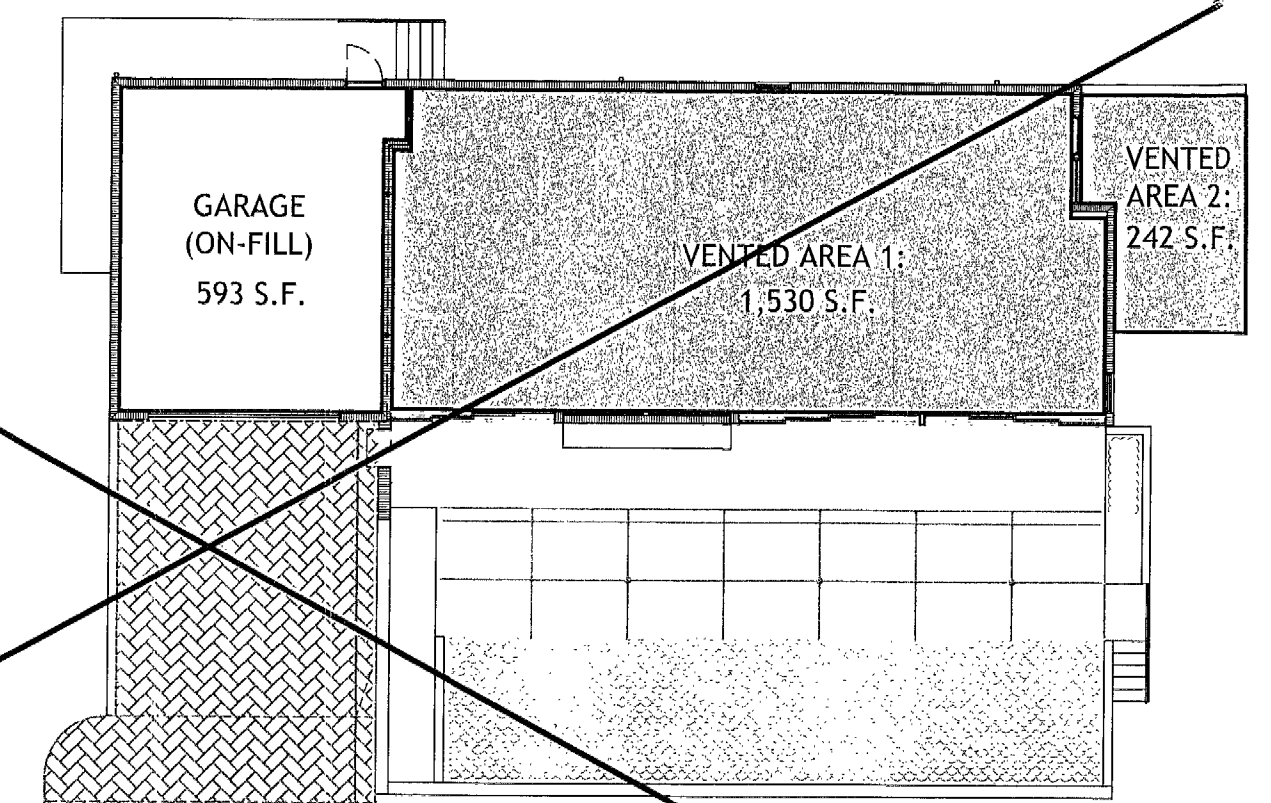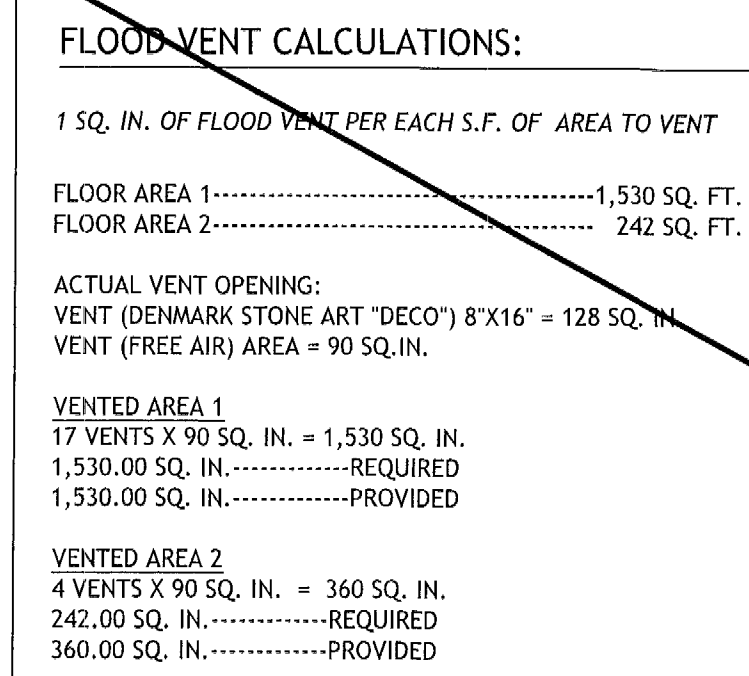

 **FLOOD VENT AREA PLAN**
SCALE: N.T.S.

NOT USED

- FLOOD VENT NOTES:**
- 1.) ALL BUILDING MATERIALS BELOW +7.0' NGVD SHALL BE OF FLOOD-PROOF MATERIALS.
ALL FLOOD VENTS MUST BE 12" (MAX.) ABOVE GRADE.
 - 2.) OPENINGS SHALL NOT BE LESS THAN 3" IN ANY DIRECTION IN THE PLANE OF THE WALL.
 - 3.) OPENING COVERS SHALL ALLOW THE AUTOMATIC FLOW OF FLOOD WATERS INTO & OUT OF THE ENCLOSED AREA.
 - 4.) VENTILATION OPENINGS SHALL BE COVERED W/ CORROSION-RESISTANT WIRE MESH W/ OPENINGS NOT GREATER THAN $\frac{1}{8}$ ".

- ELEVATION NOTES:

- PAINT BY OTHERS.
- DOORS & WINDOWS UNDER SEPARATE PERMIT.
(SEE WINDOW & DOOR SCHEDULES)
- ALL GUARD/HANDRAILS BY OTHERS, UNDER SEPARATE PERMIT. SUBMIT SHOP DRAWINGS TO ARCHITECT FOR APPROVAL.
- 5/8" STUCCO FINISH (PAINTED), TYPICAL.

ELEVATION CERTIFICATE NOTE:

1. UPON PLACEMENT OF THE LOWEST FLOOR AND PRIOR TO FURTHER VERTICAL CONSTRUCTION, THE GC SHALL SUBMIT AN "ELEVATION CERTIFICATE" PER FBC 2010, *BUILDING* - SECTION 110.3.
2. THE GC SHALL SUBMIT A FINAL "ELEVATION CERTIFICATE" FOR FINISHED CONSTRUCTION PRIOR TO ISSUE OF ANY C.O., T.C.O., OR P.C.O.

OWN BY:

VISIONS:

2-18-15

1-01-15

001673Z

m² DESIGN
ARCHITECTURE

P: 305.438.9377 | F: 305.438.9379

AT:
4354 ALTON ROAD
MIAMI BEACH, FL 331

PLANS ARE FOR BUILDING
MENT REVIEW ONLY. THEY ARE NOT
CONSTRUED AS CONSTRUCTION
NTS UNTIL ALL BUILDING
MENT APPROVALS ARE OBTAINED.

A.3.1

EVOLUTIONS

DRAWN BY:
REVISIONS:
1
2
3
12-18-15
11-01-15
8-14-15


AA0008589
ANTHONY LEON
0010752
DESIGN
ARCHITECTURE
4300 Biscayne Blvd. #G-04, Miami, FL 33137
P: 305.438.9377 | F: 305.438.9379

SEAL
JAN 11 2016


NEW RESIDENCE
AT:
4354 ALTON ROAD
MIAMI BEACH, FL 33139

THESE PLANS ARE FOR BUILDING DEPARTMENT REVIEW ONLY. THEY ARE NOT TO BE CONSTRUED AS CONSTRUCTION DOCUMENTS UNTIL ALL BUILDING DEPARTMENT APPROVALS ARE OBTAINED.


A.3.2
ELEVATIONS

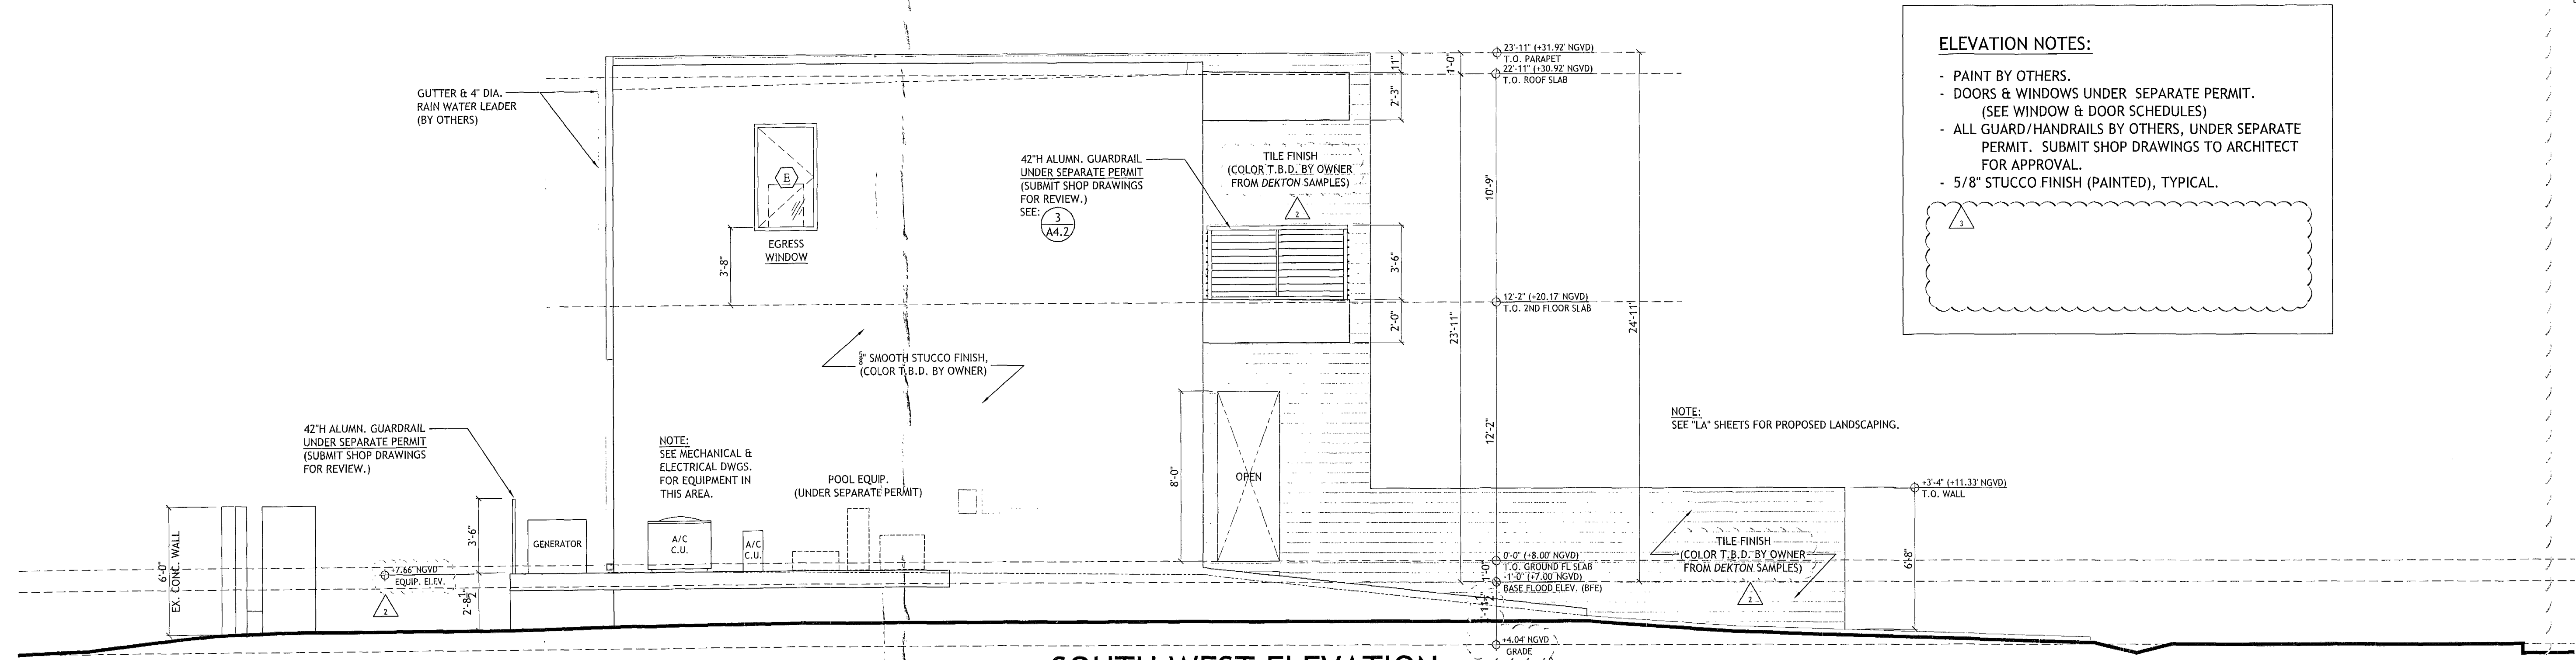

SOUTH WEST ELEVATION
SCALE: 1/4" = 1'-0"

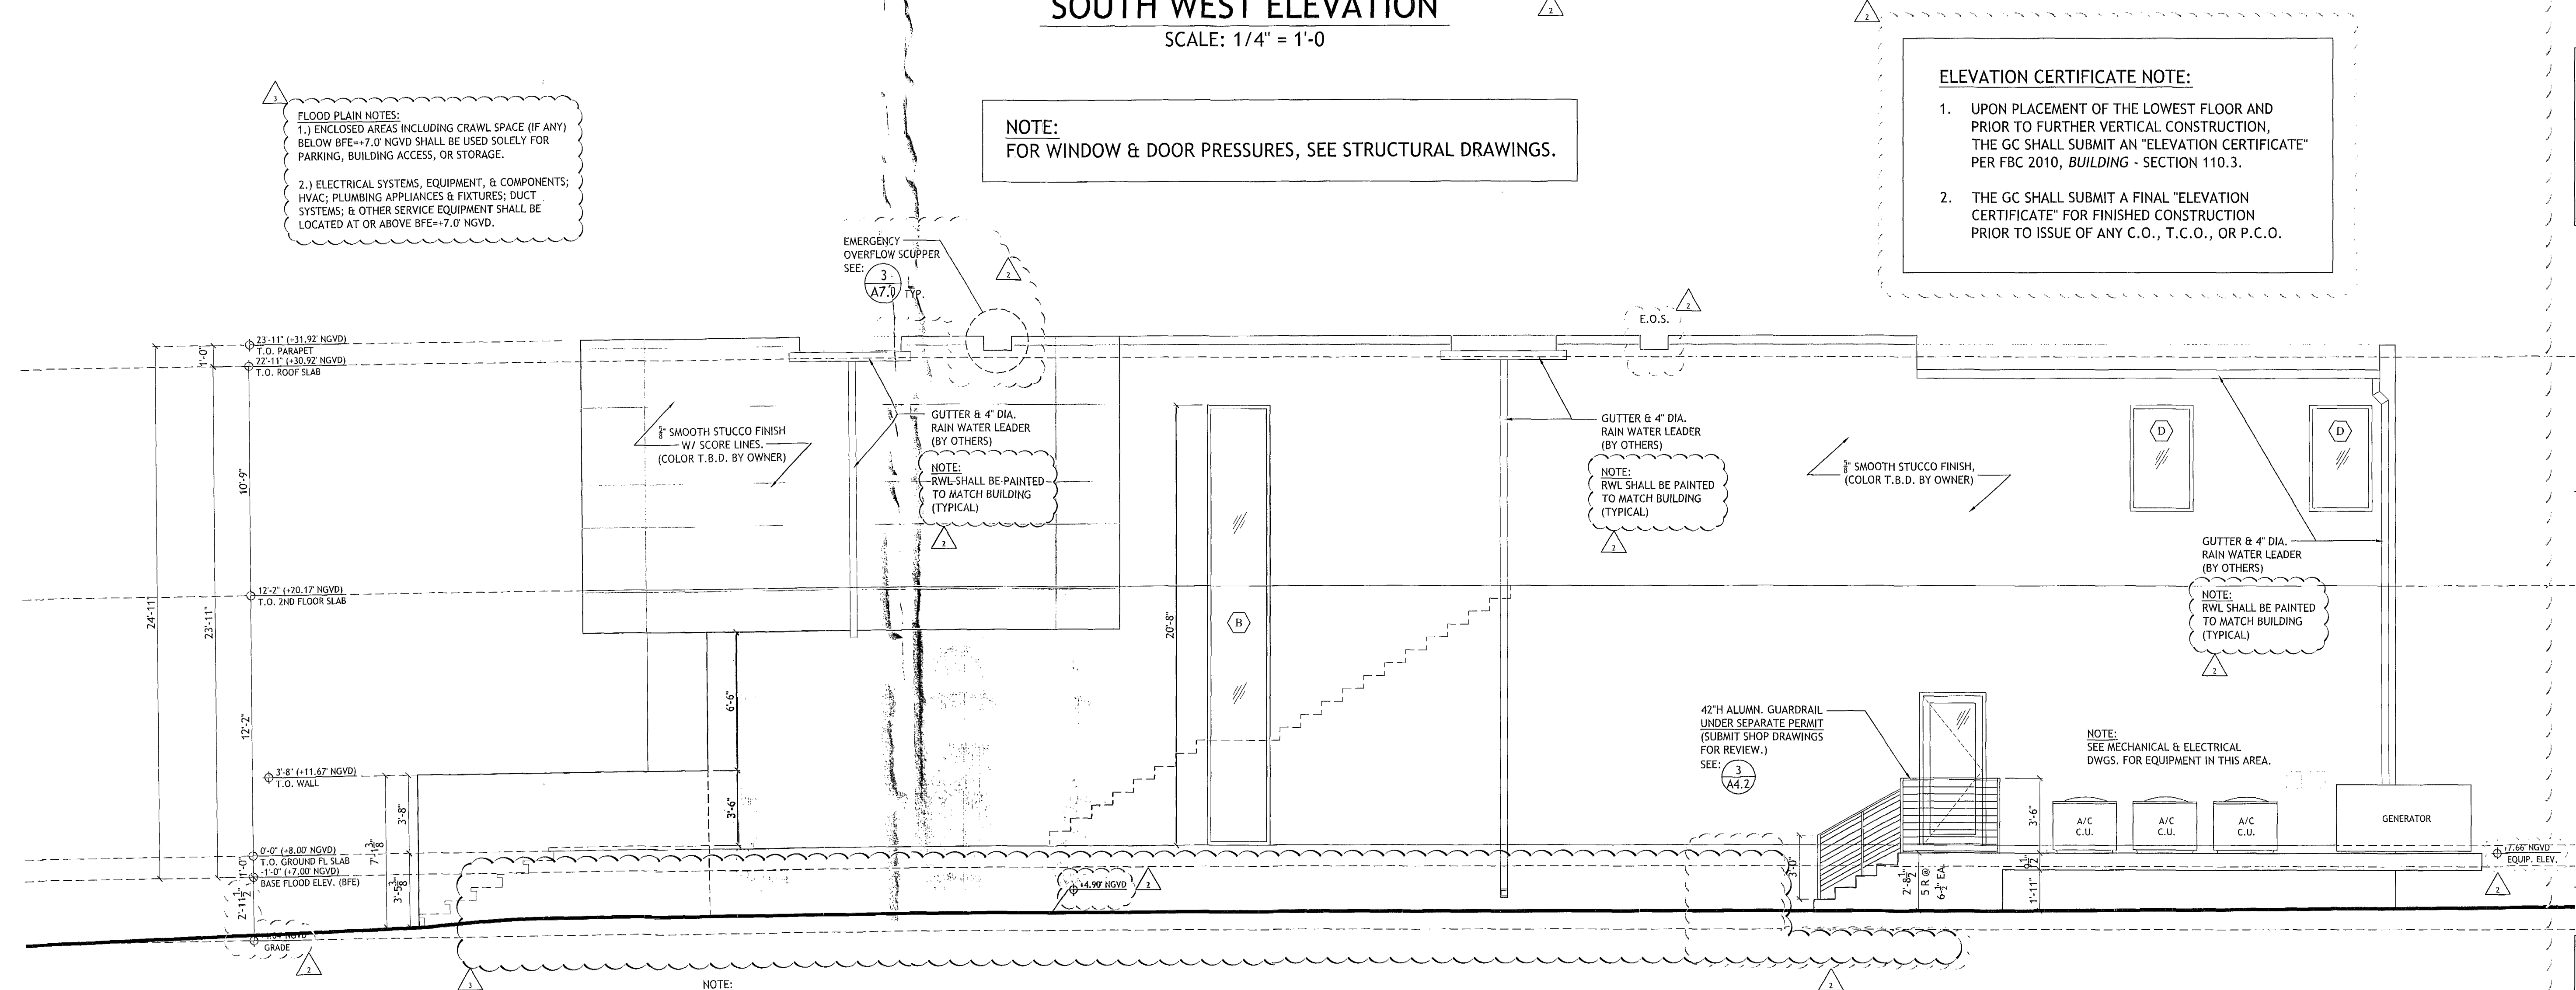

NORTH WEST ELEVATION
SCALE: 1/4" = 1'-0"

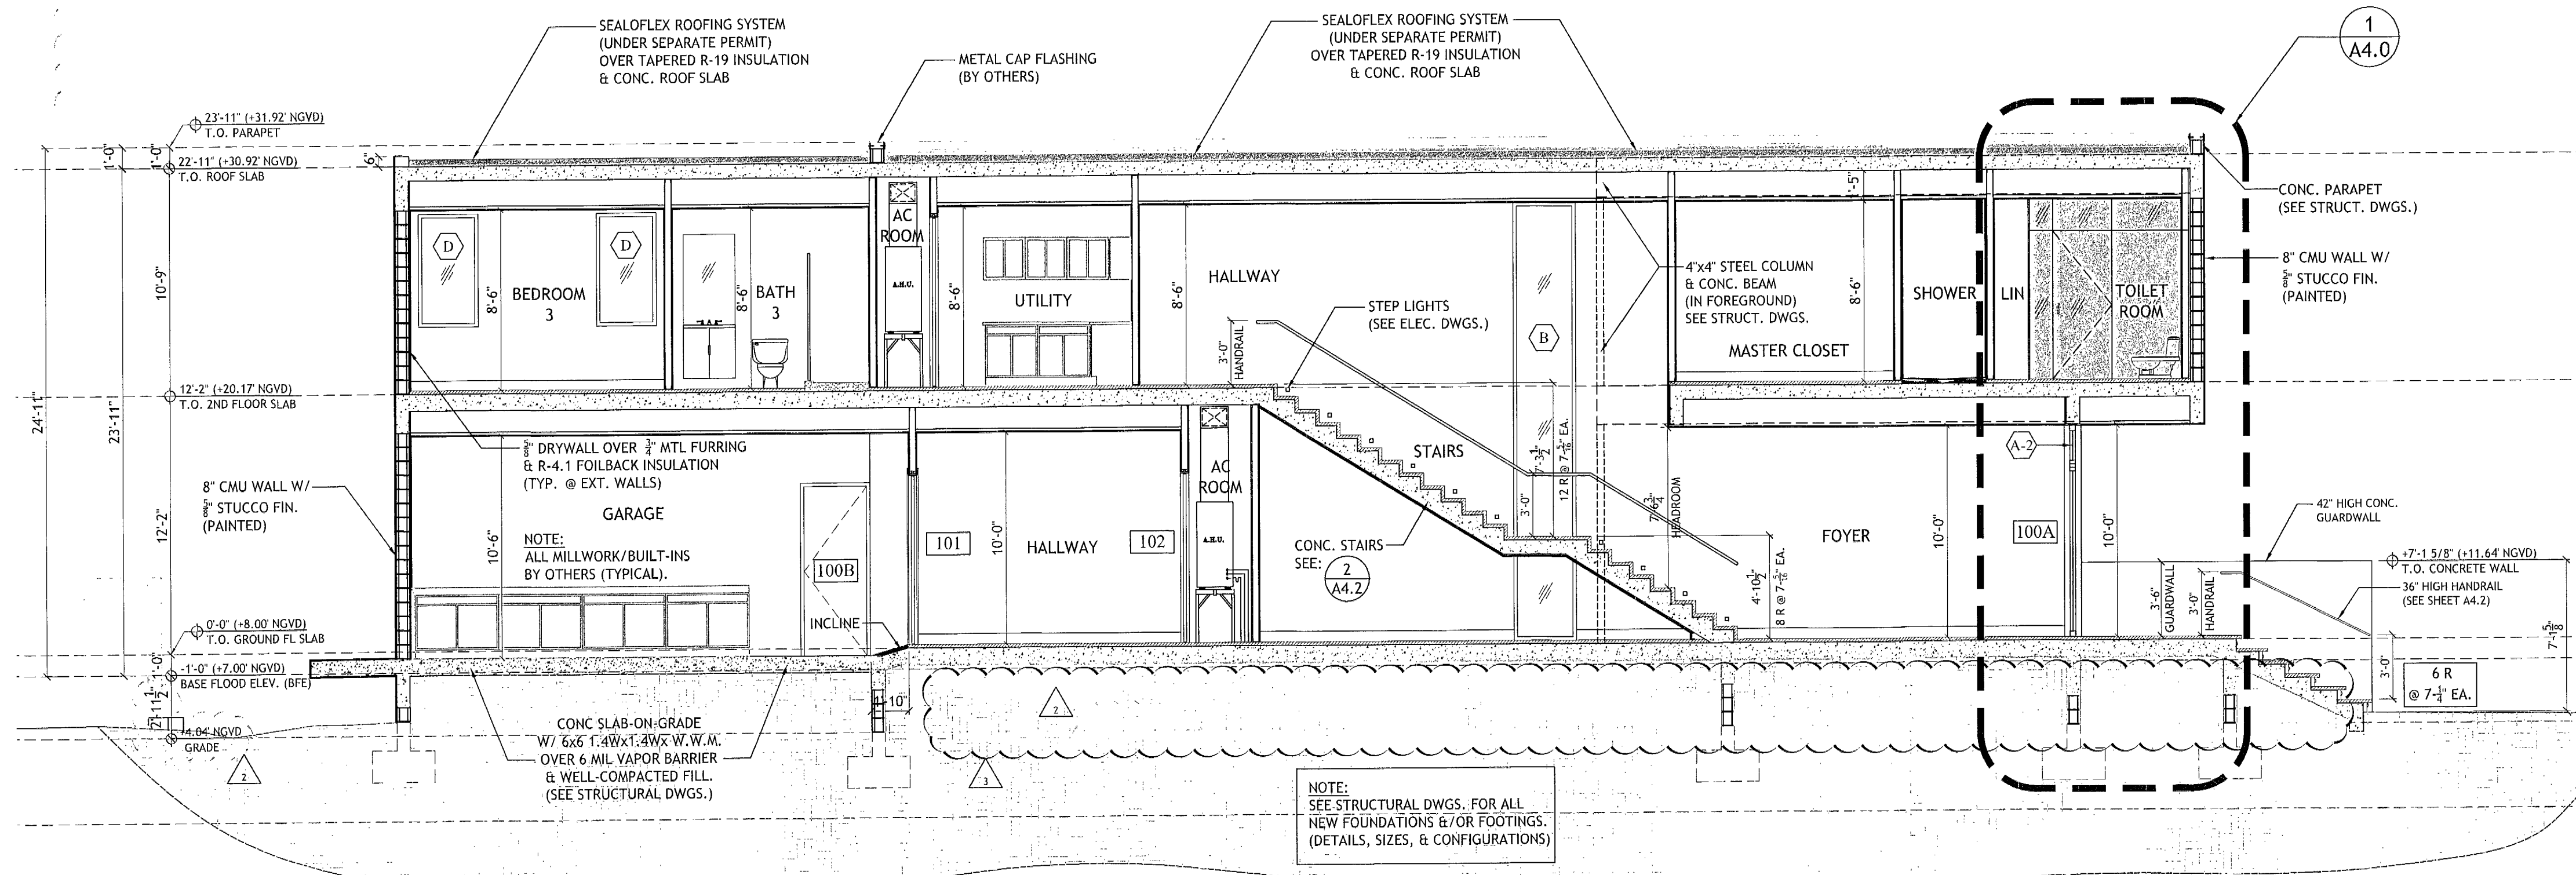


NOTE:
ALL ELECTRICAL EQUIPMENT (PANELS, METERS, ETC.) SHALL BE LOCATED @ THE B.F.E. + 1'-0" (MIN.).

SECTION A
SCALE: 3/16" = 1'-0"


ELEVATION CERTIFICATE NOTE:

- UPON PLACEMENT OF THE LOWEST FLOOR AND PRIOR TO FURTHER VERTICAL CONSTRUCTION, THE GC SHALL SUBMIT AN "ELEVATION CERTIFICATE" PER FBC 2010, *BUILDING* - SECTION 110.3.
- THE GC SHALL SUBMIT A FINAL "ELEVATION CERTIFICATE" FOR FINISHED CONSTRUCTION PRIOR TO ISSUE OF ANY C.O., T.C.O., OR P.C.O.

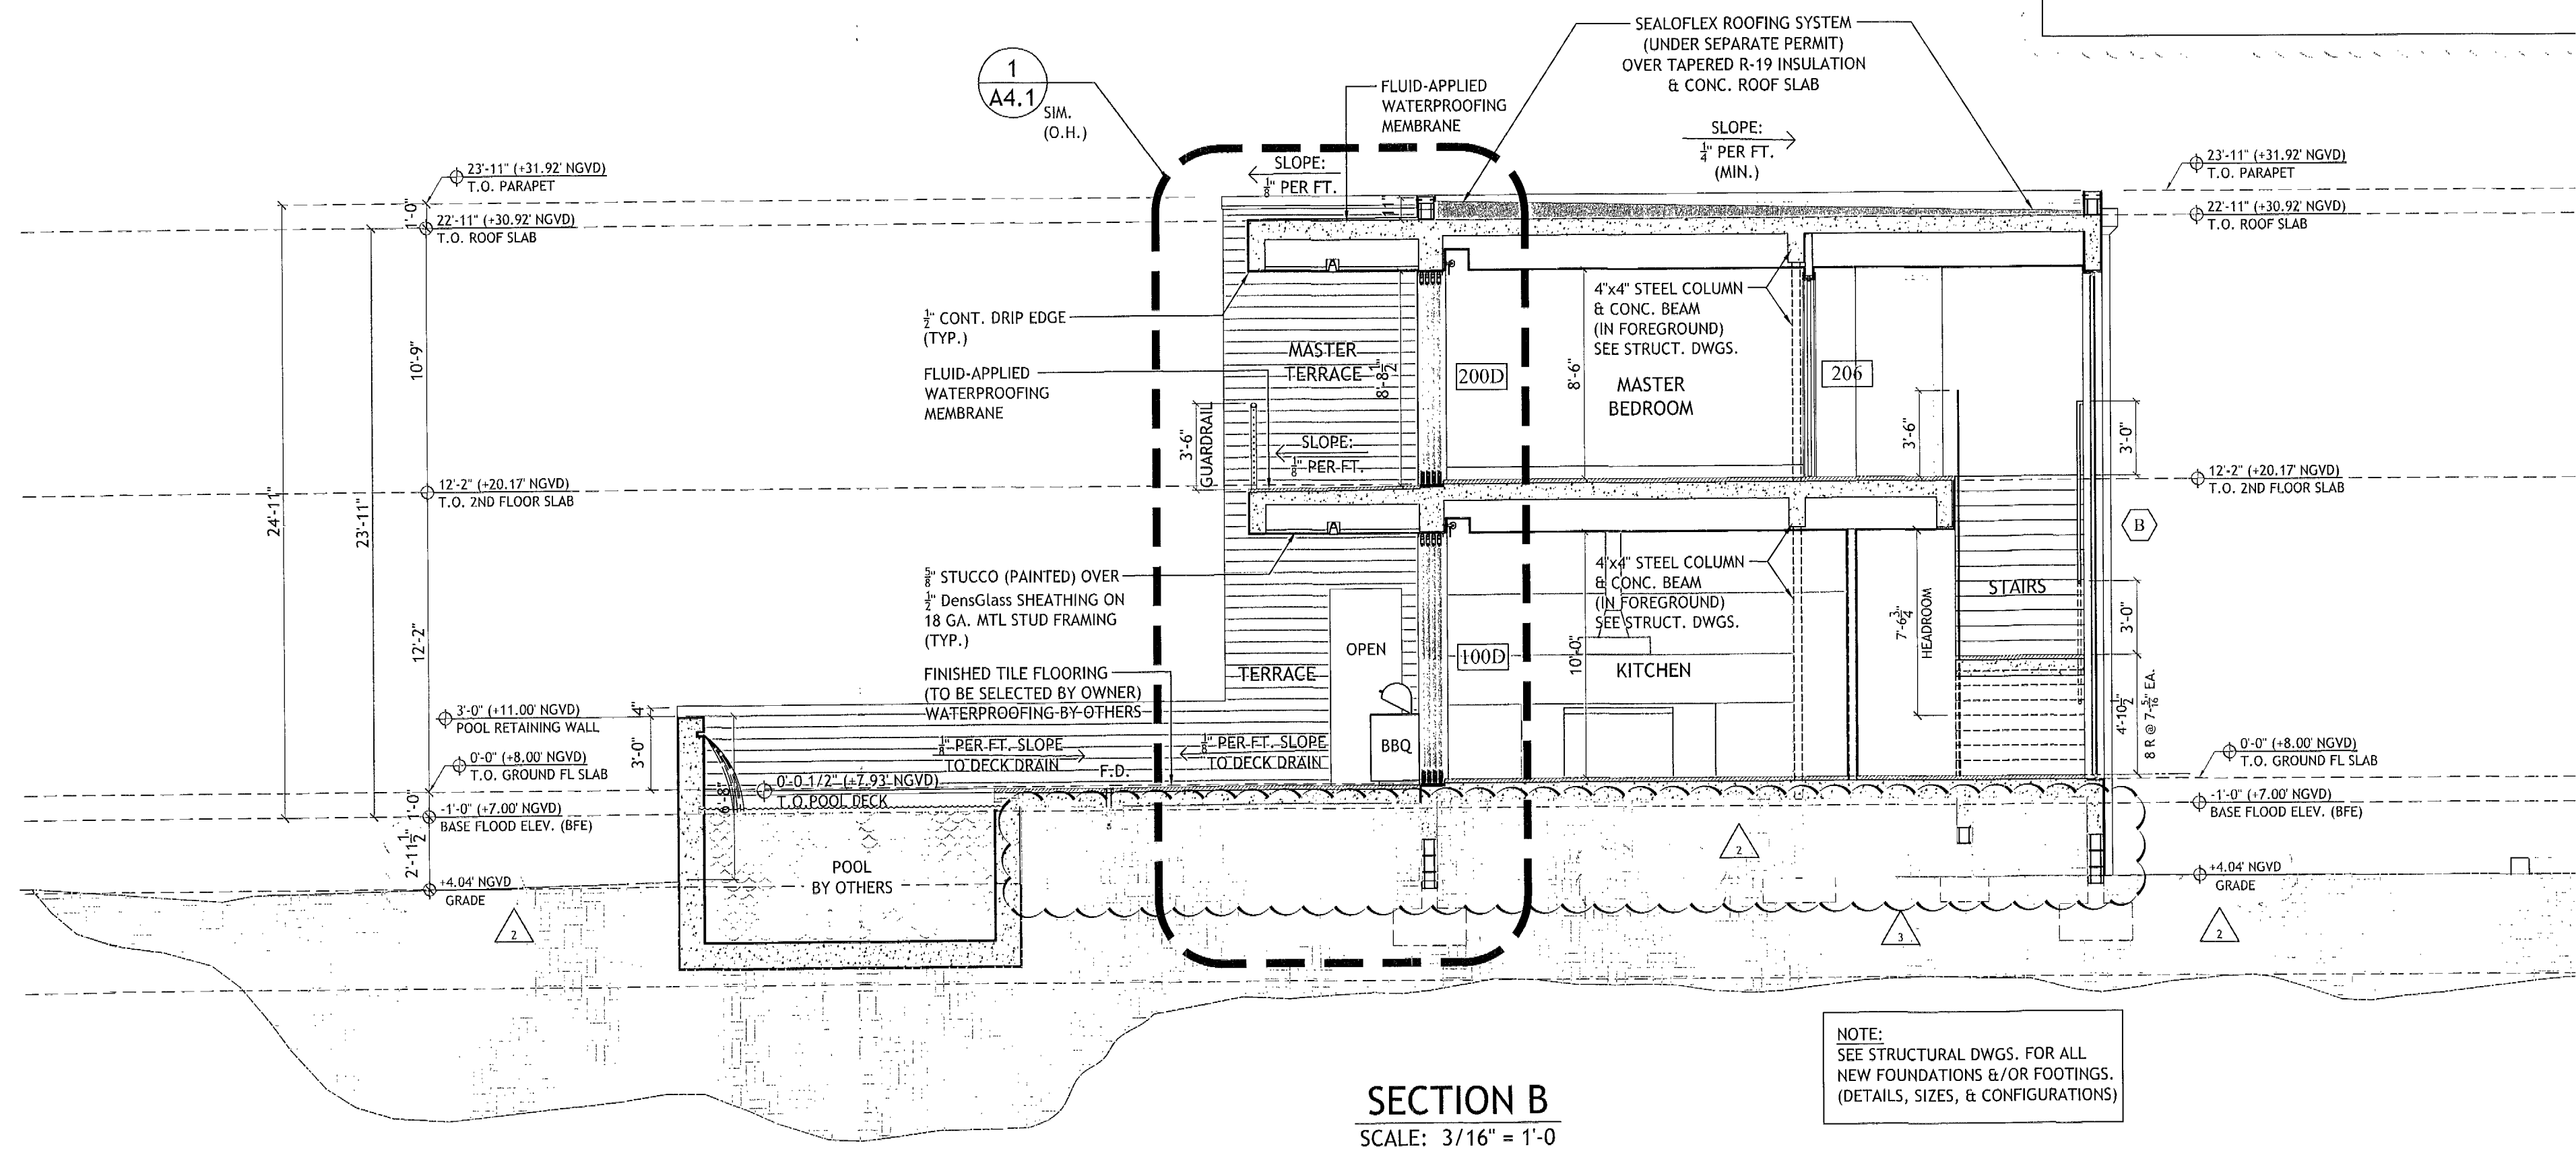

SECTION B
SCALE: 3/16" = 1'-0"

NOTE:
SEE STRUCTURAL DWGS. FOR ALL NEW FOUNDATIONS &/OR FOOTINGS. (DETAILS, SIZES, & CONFIGURATIONS)

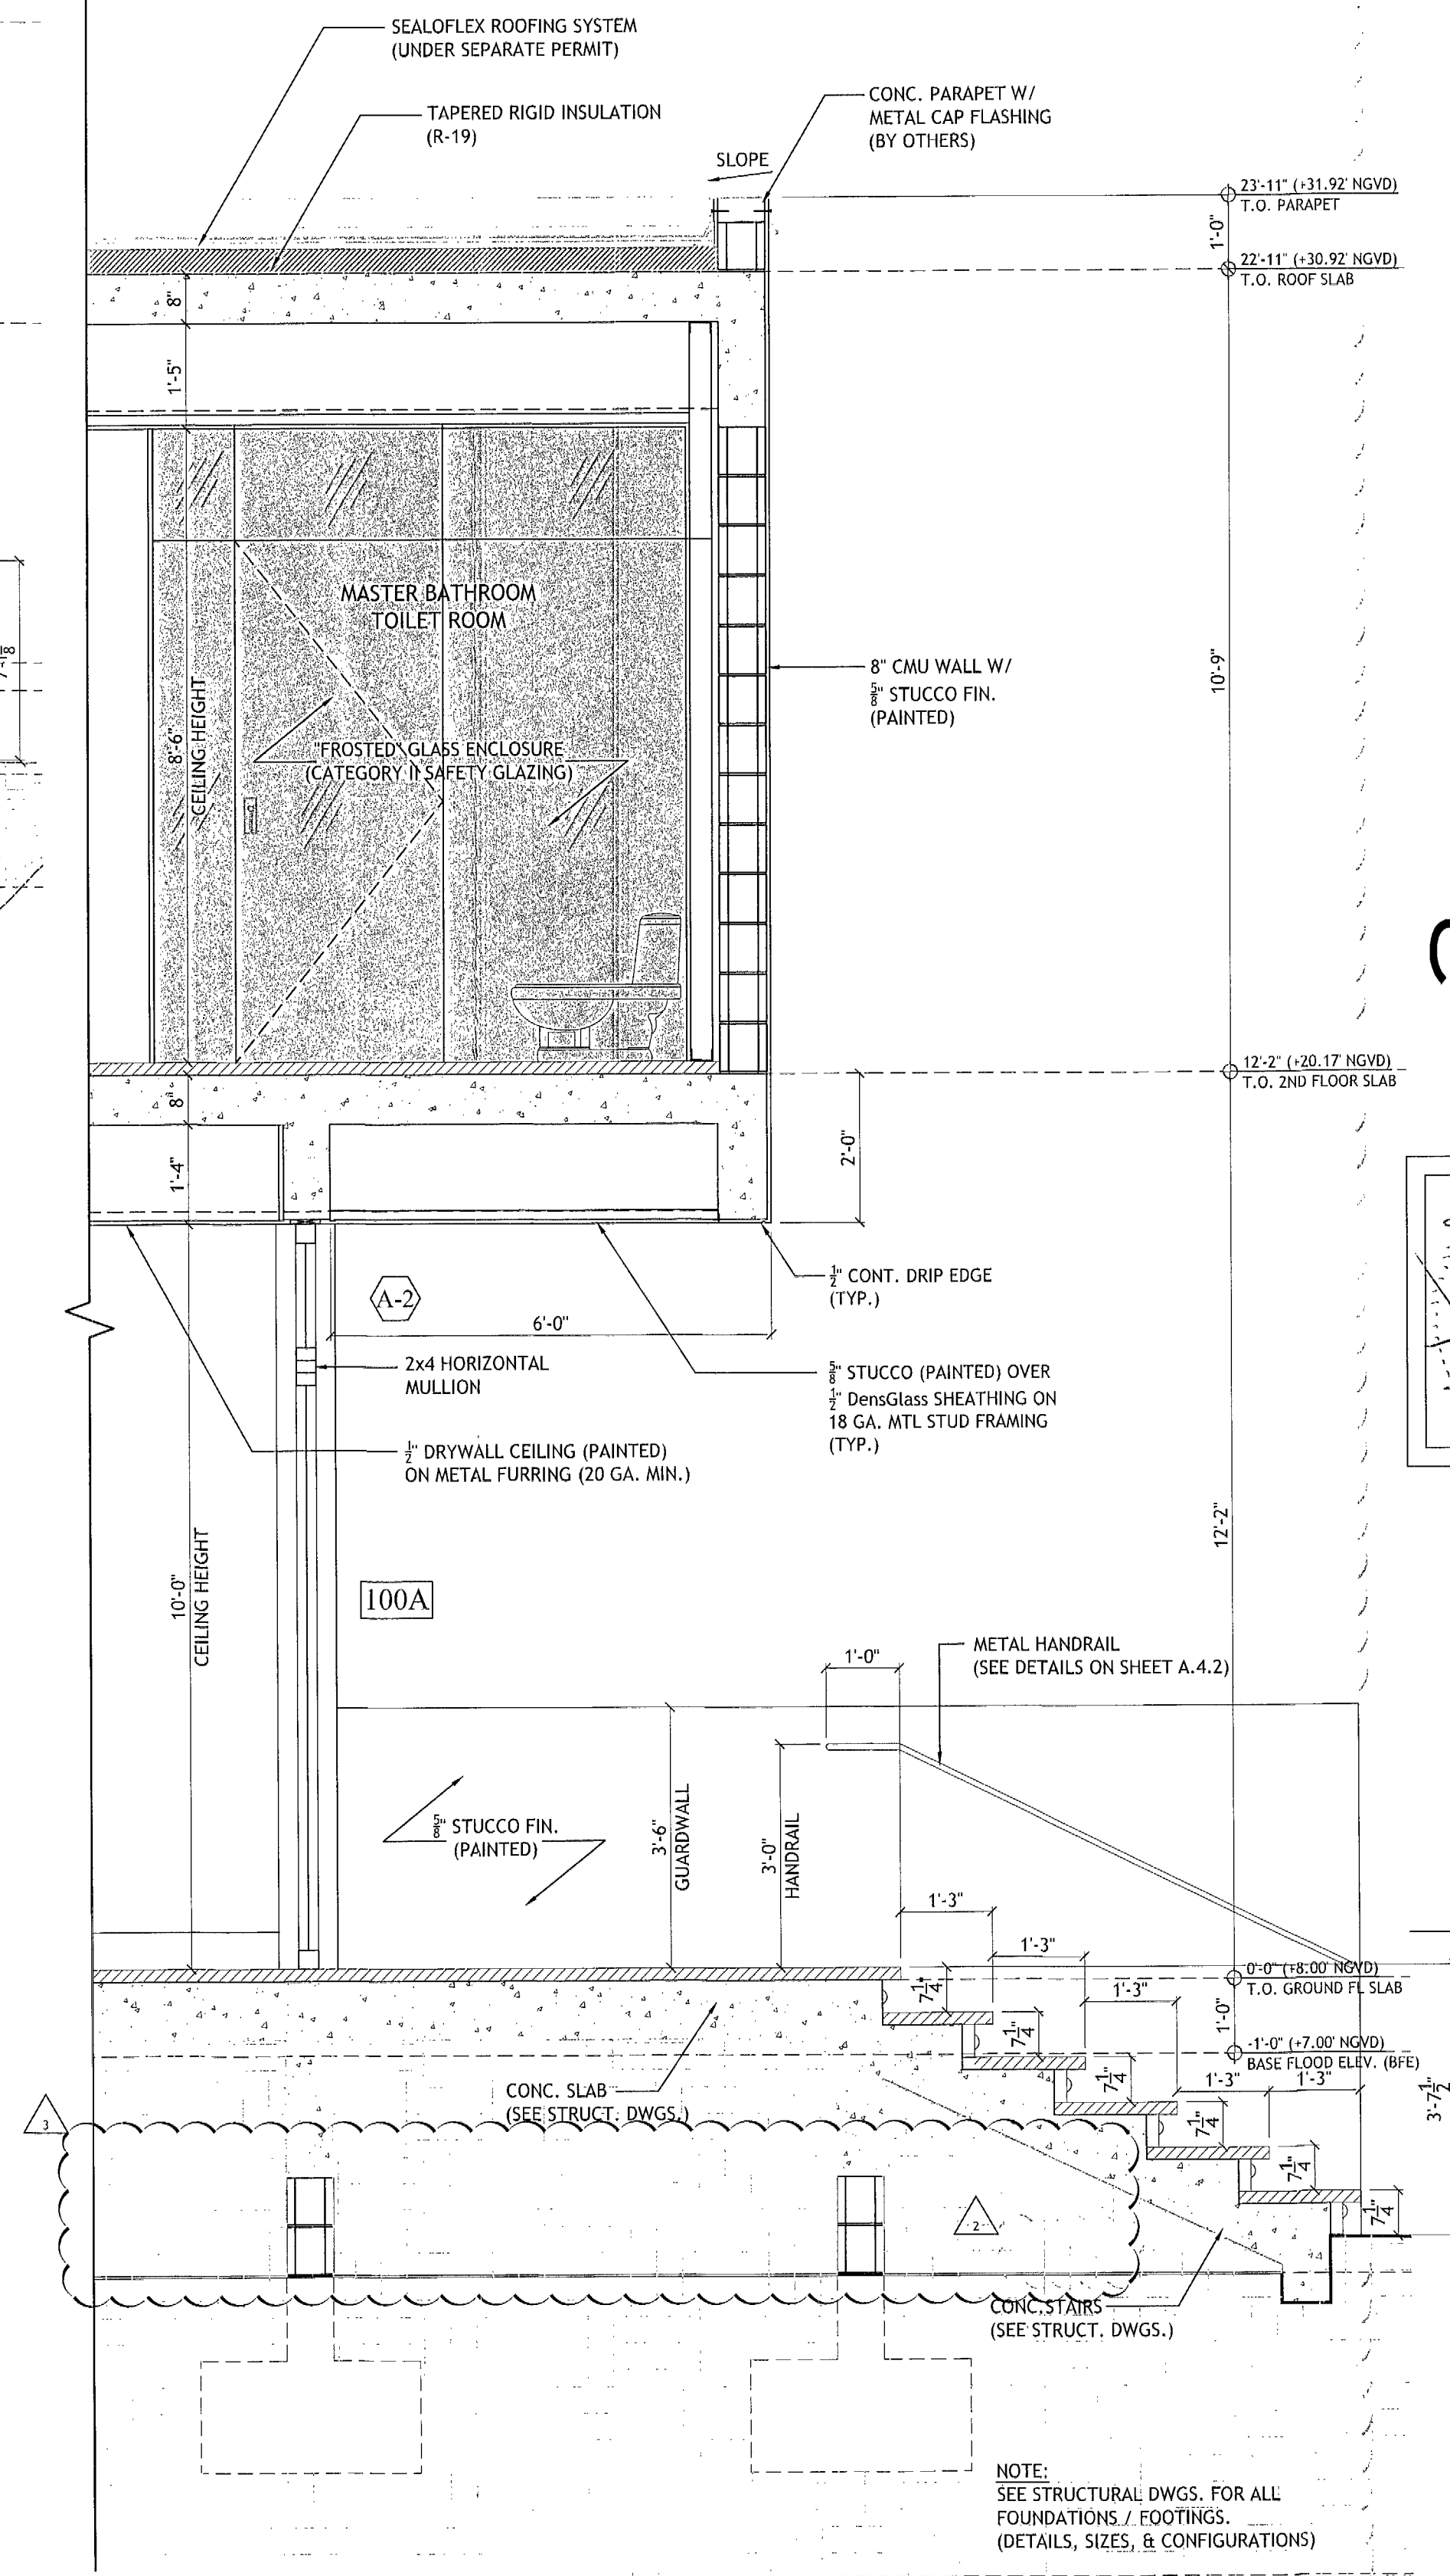


1
A4.0
WALL SECTION
SCALE: 1/2" = 1'-0"

NOTE:
SEE STRUCTURAL DWGS. FOR ALL FOUNDATIONS / FOOTINGS. (DETAILS, SIZES, & CONFIGURATIONS)

REVISIONS:	
1	12-18-15
2	11-01-15
3	8-14-15

AA0003659
ANTHONY LEON
0016752


3
DESIGN
ARCHITECTURE
4300 Biscayne Blvd. #G-04, Miami, FL 33137
P: 305.438.9377 | F: 305.438.9379

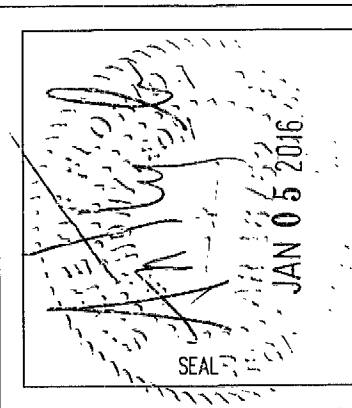

NEW RESIDENCE
AT:
4354 ALTON ROAD
MIAMI BEACH, FL 33139

THESE PLANS ARE FOR BUILDING DEPARTMENT REVIEW ONLY. THEY ARE NOT TO BE CONSTRUED AS CONSTRUCTION DOCUMENTS UNTIL ALL BUILDING DEPARTMENT APPROVALS ARE OBTAINED.


A.4.0
SECTIONS

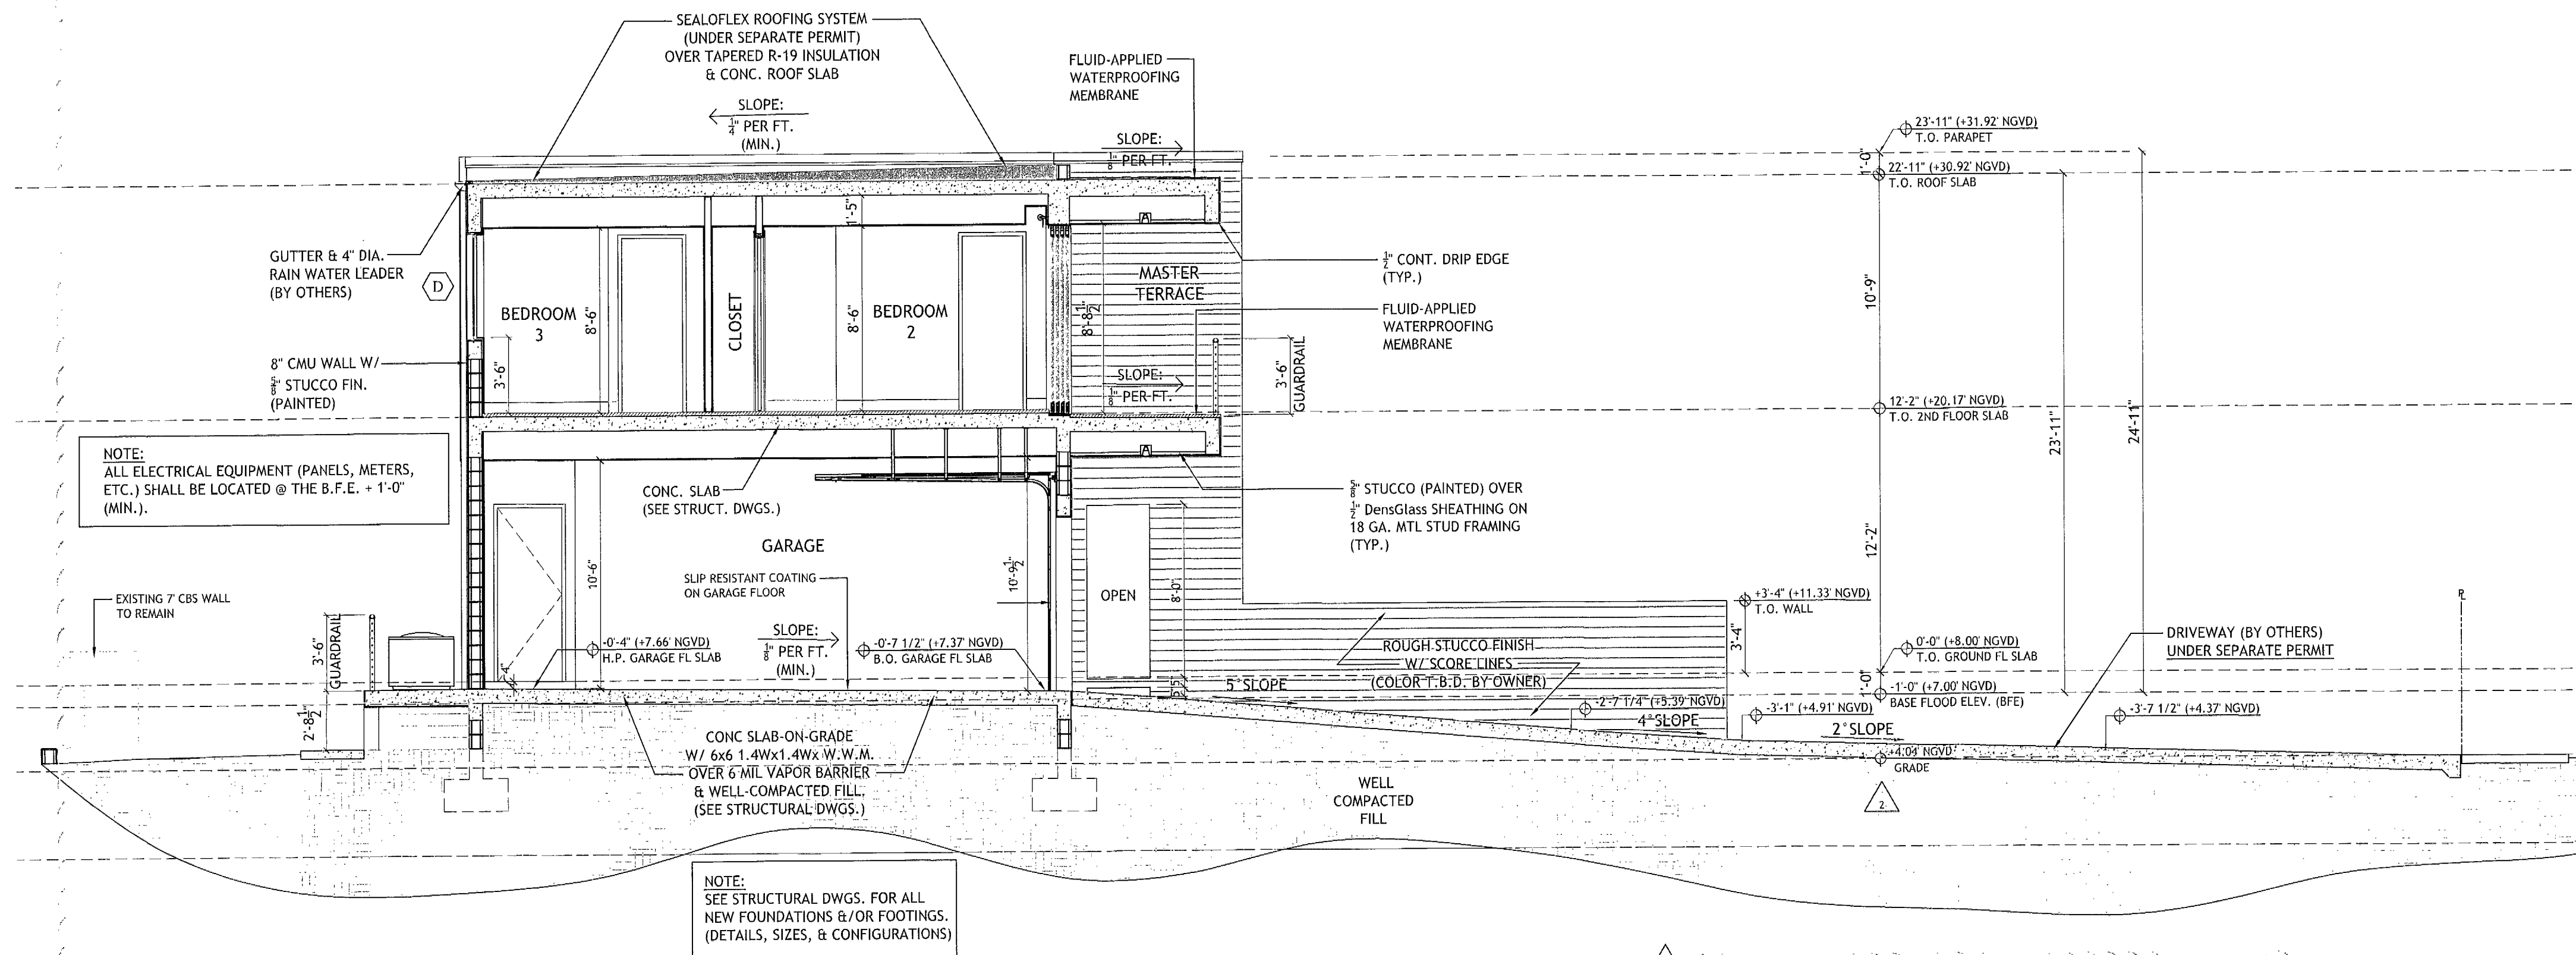

SECTION C
SCALE: 3/16" = 1'-0"


ELEVATION CERTIFICATE NOTE:

- UPON PLACEMENT OF THE LOWEST FLOOR AND PRIOR TO FURTHER VERTICAL CONSTRUCTION, THE GC SHALL SUBMIT AN "ELEVATION CERTIFICATE" PER FBC 2010, *BUILDING* - SECTION 110.3.
- THE GC SHALL SUBMIT A FINAL "ELEVATION CERTIFICATE" FOR FINISHED CONSTRUCTION PRIOR TO ISSUE OF ANY C.O., T.C.O., OR P.C.O.

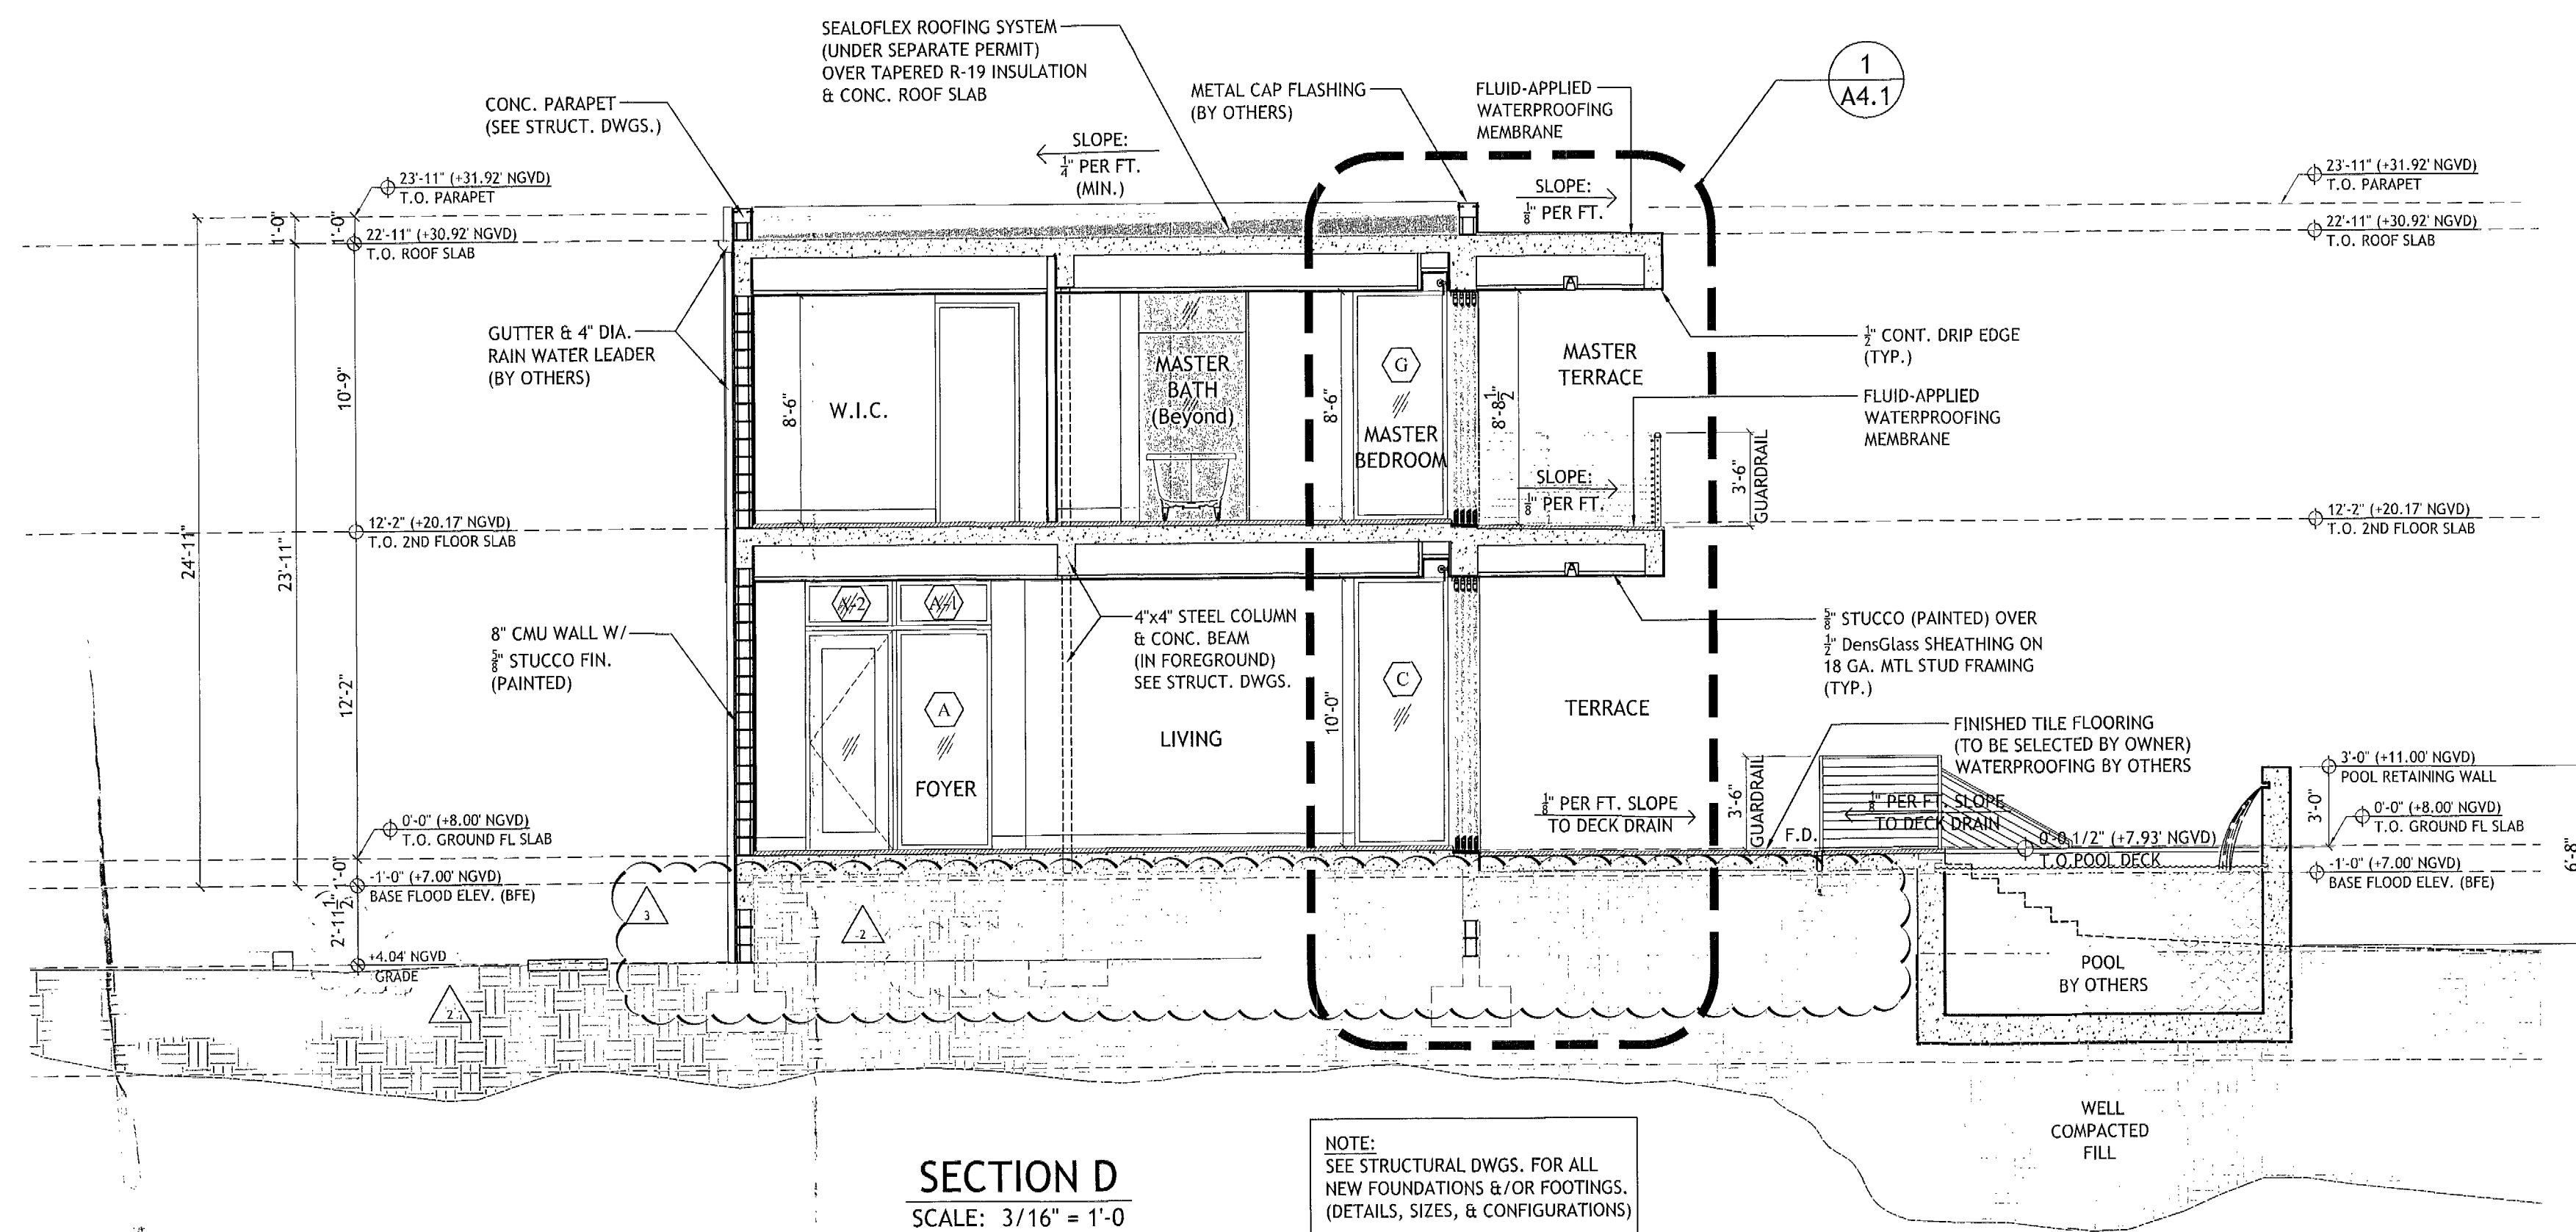

SECTION D
SCALE: 3/16" = 1'-0"

NOTE:
SEE STRUCTURAL DWGS. FOR ALL
NEW FOUNDATIONS &/OR FOOTINGS.
(DETAILS, SIZES, & CONFIGURATIONS)

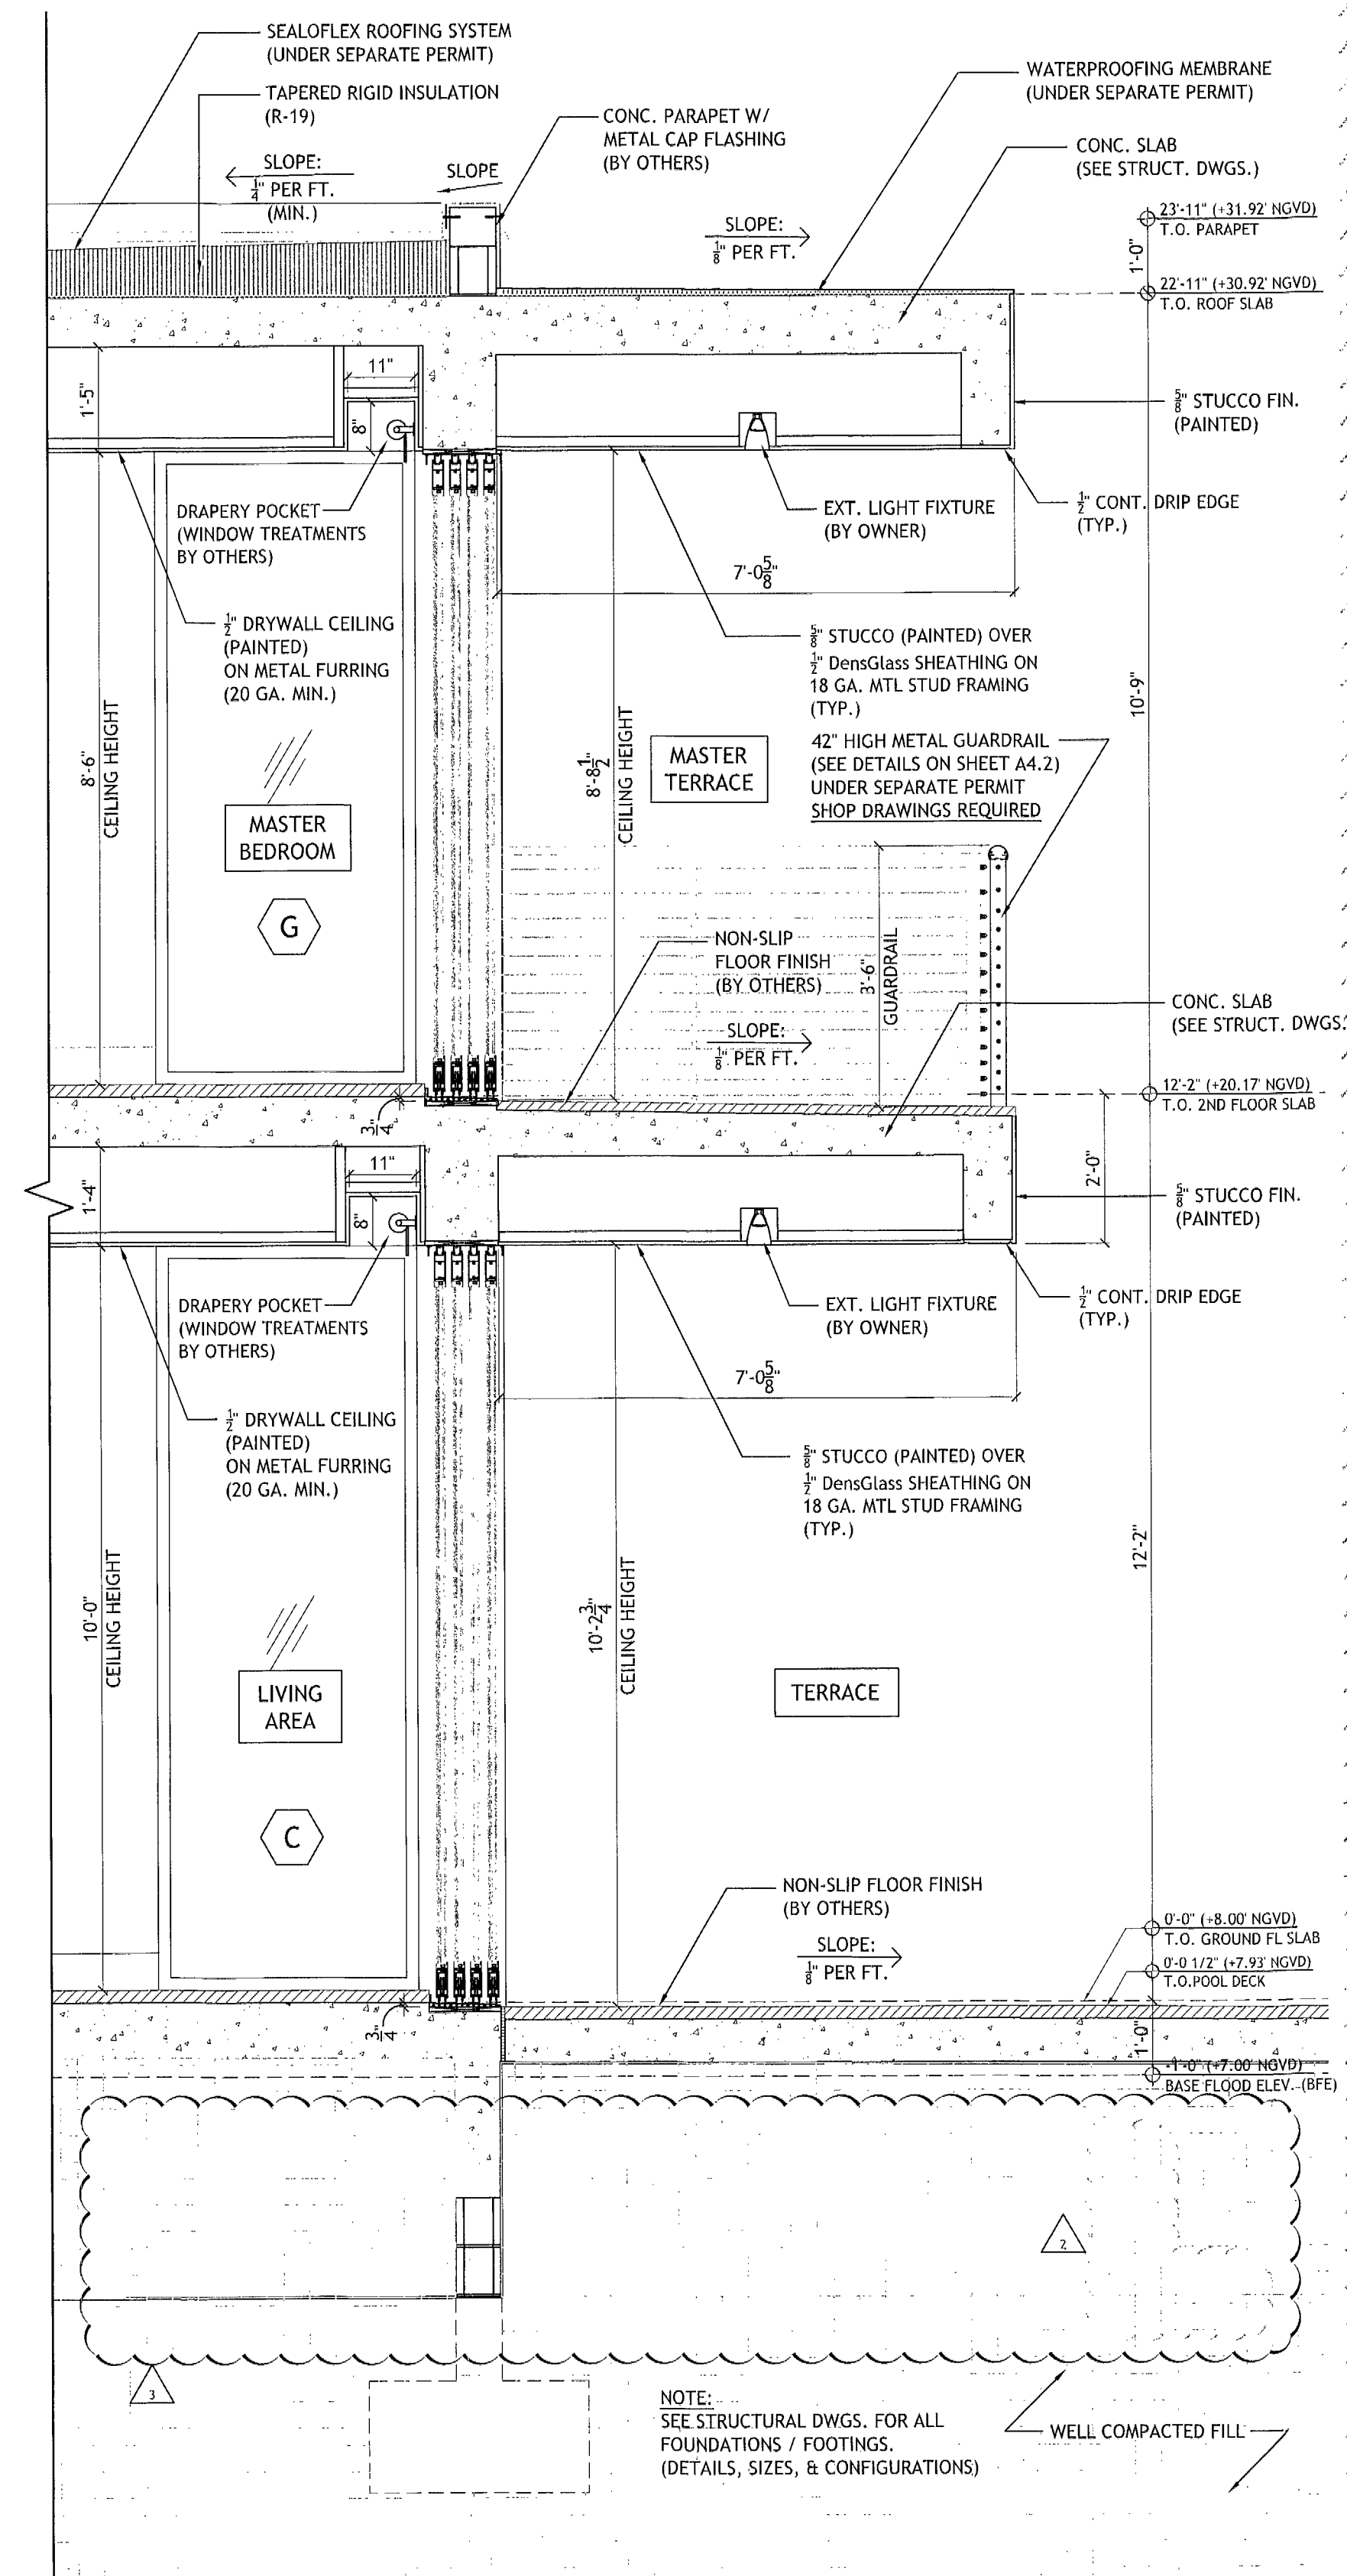

1 WALL SECTION
A4.1 SCALE: 1/2" = 1'-0"


NOTE:
SEE STRUCTURAL DWGS. FOR ALL
FOUNDATIONS / FOOTINGS.
(DETAILS, SIZES, & CONFIGURATIONS)

REVISIONS:	DATE	BY
1	12-18-15	AN
2	11-01-15	AN
3	8-14-15	AN

AA0003569
ANTHONY LEON
0016752




3 DESIGN
ARCHITECTURE

4300 Biscayne Blvd. #G-04, Miami, FL 33137
P: 305.438.9377 | F: 305.438.9379

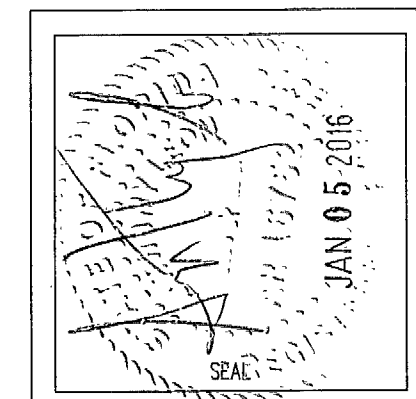

NEW RESIDENCE
AT:
4354 ALTON ROAD
MIAMI BEACH, FL 33139


A.4.1
SECTIONS

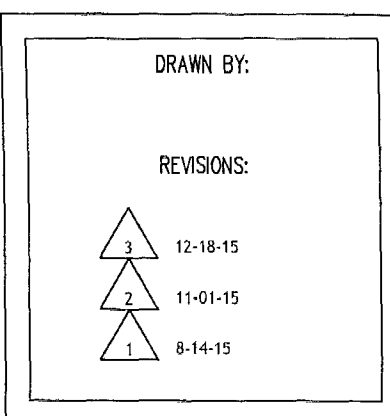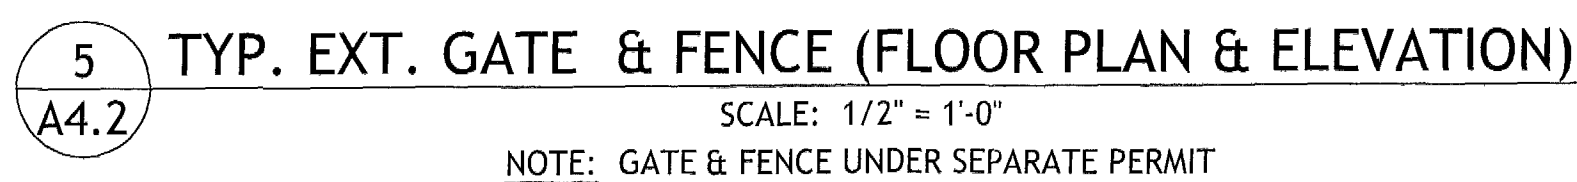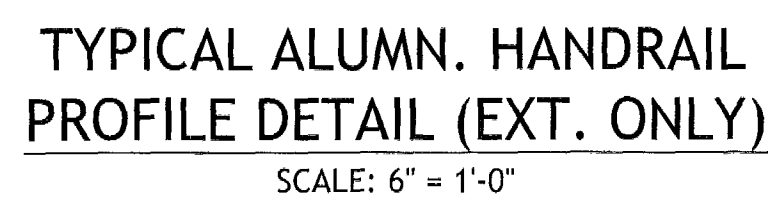

AA0003569
ANTHONY LEON

3
DESIGN
ARCHITECTURE

4300 Biscayne Blvd. #G-04, Miami, FL 33137
P: 305 438 9377 | F: 305 438 9379

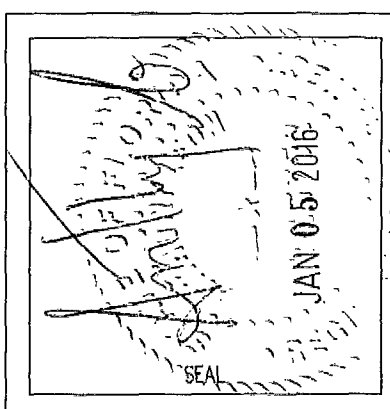


NEW RESIDENCE
AT:
4354 ALTON ROAD
MIAMI BEACH, FL 33139


THESE PLANS ARE FOR BUILDING
DEPARTMENT REVIEW ONLY. THEY ARE NOT
TO BE CONSTRUED AS CONSTRUCTION
DOCUMENTS UNTIL ALL BUILDING
DEPARTMENT APPROVALS ARE OBTAINED.

A.4.2


STAIR SECTIONS & DETAILS

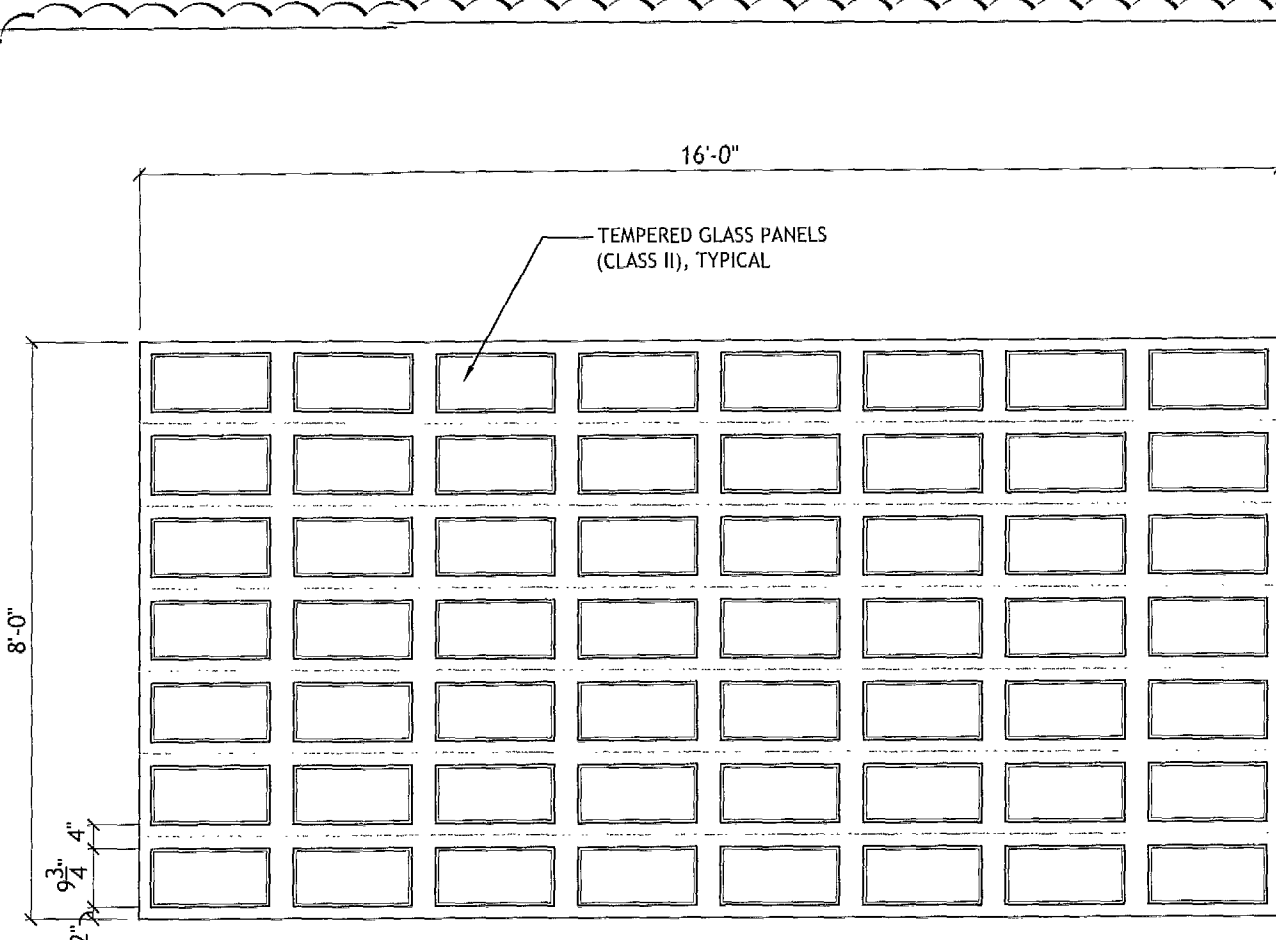


DOOR 100
SCALE: 3/8" = 1'-0"

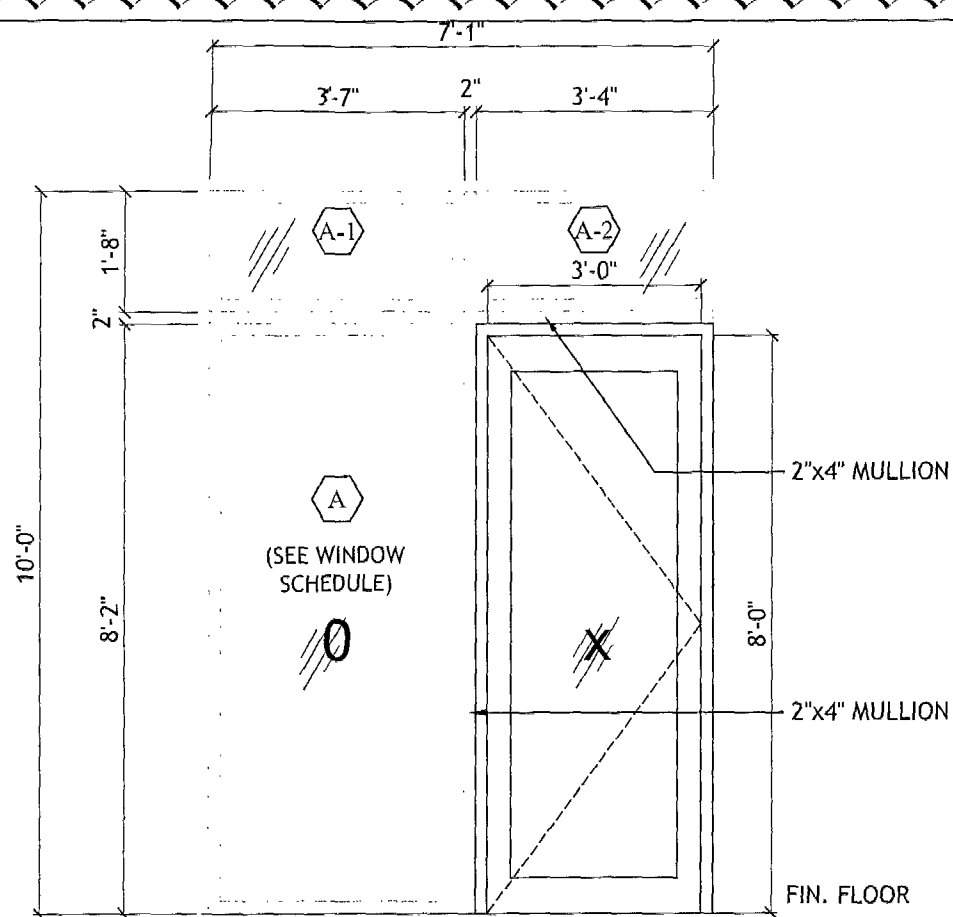


DOOR 100A
SCALE: 3/8" = 1'-0"

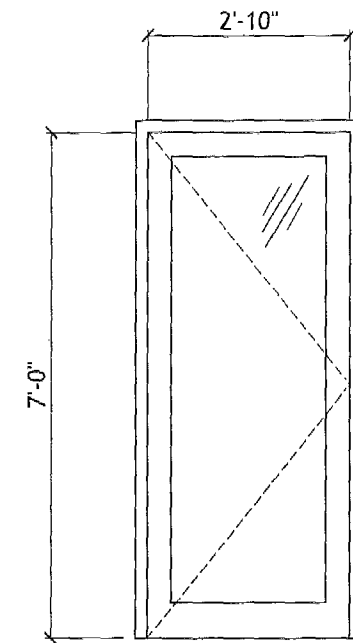


DOOR 100B
SCALE: 3/8" = 1'-0"

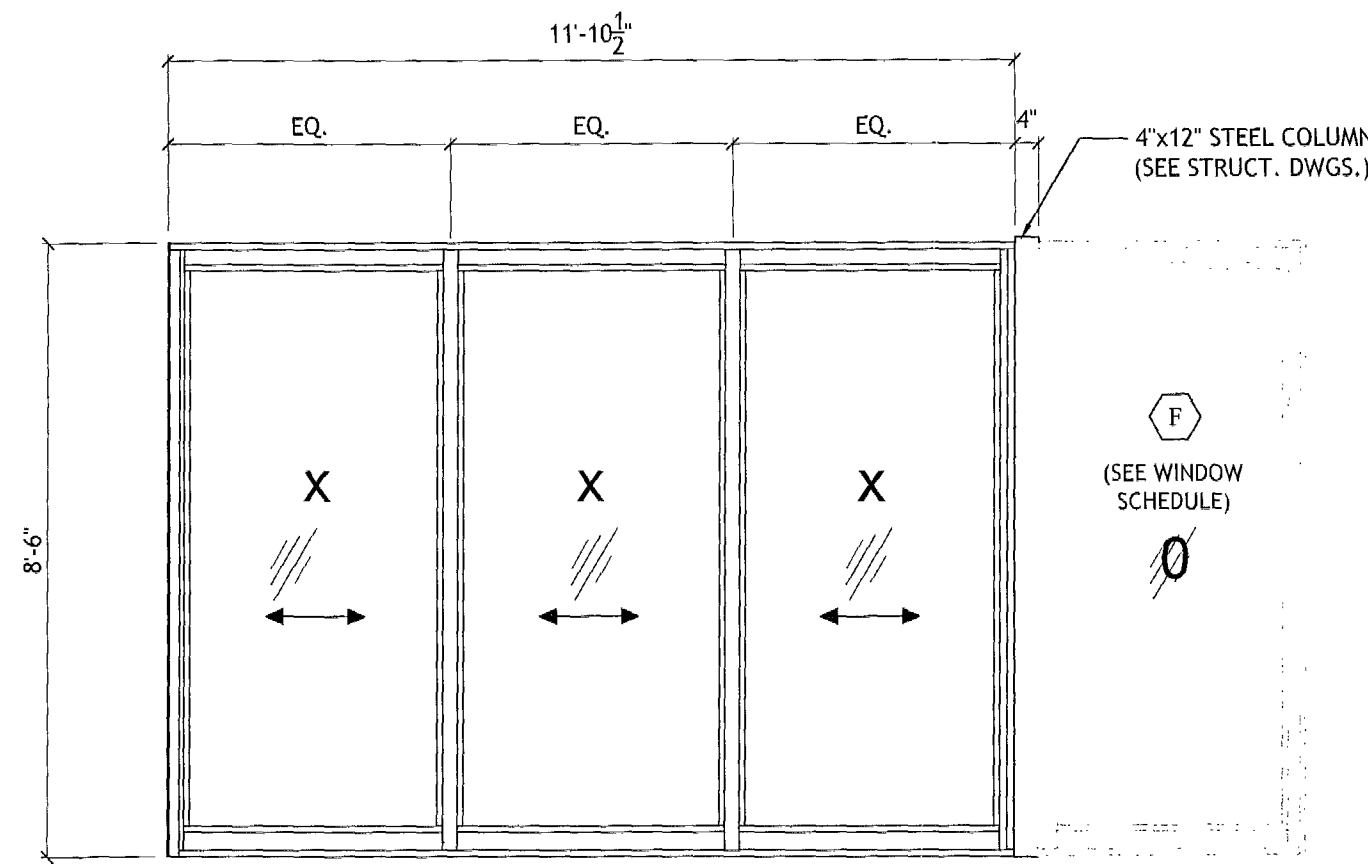


DOOR 200B
SCALE: 3/8" = 1'-0"

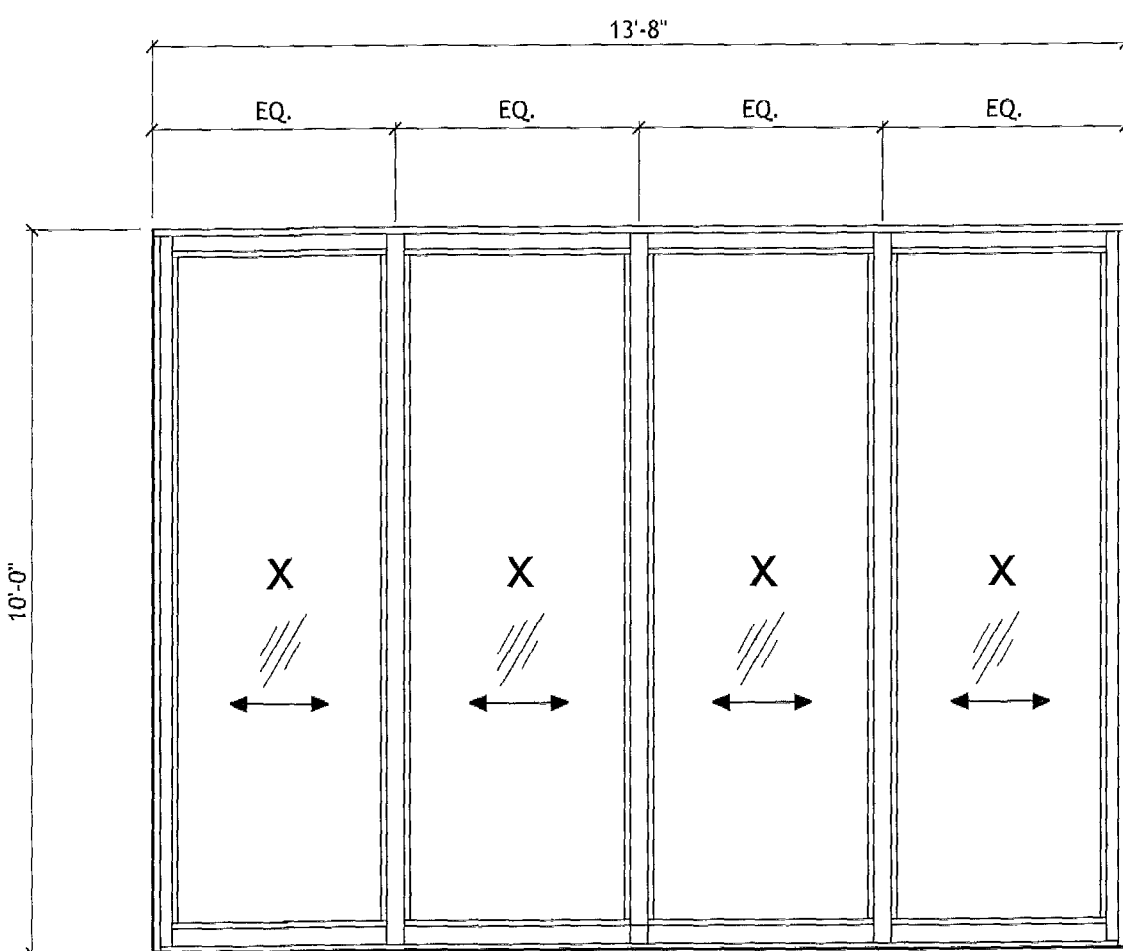


DOOR 100C
SCALE: 3/8" = 1'-0"

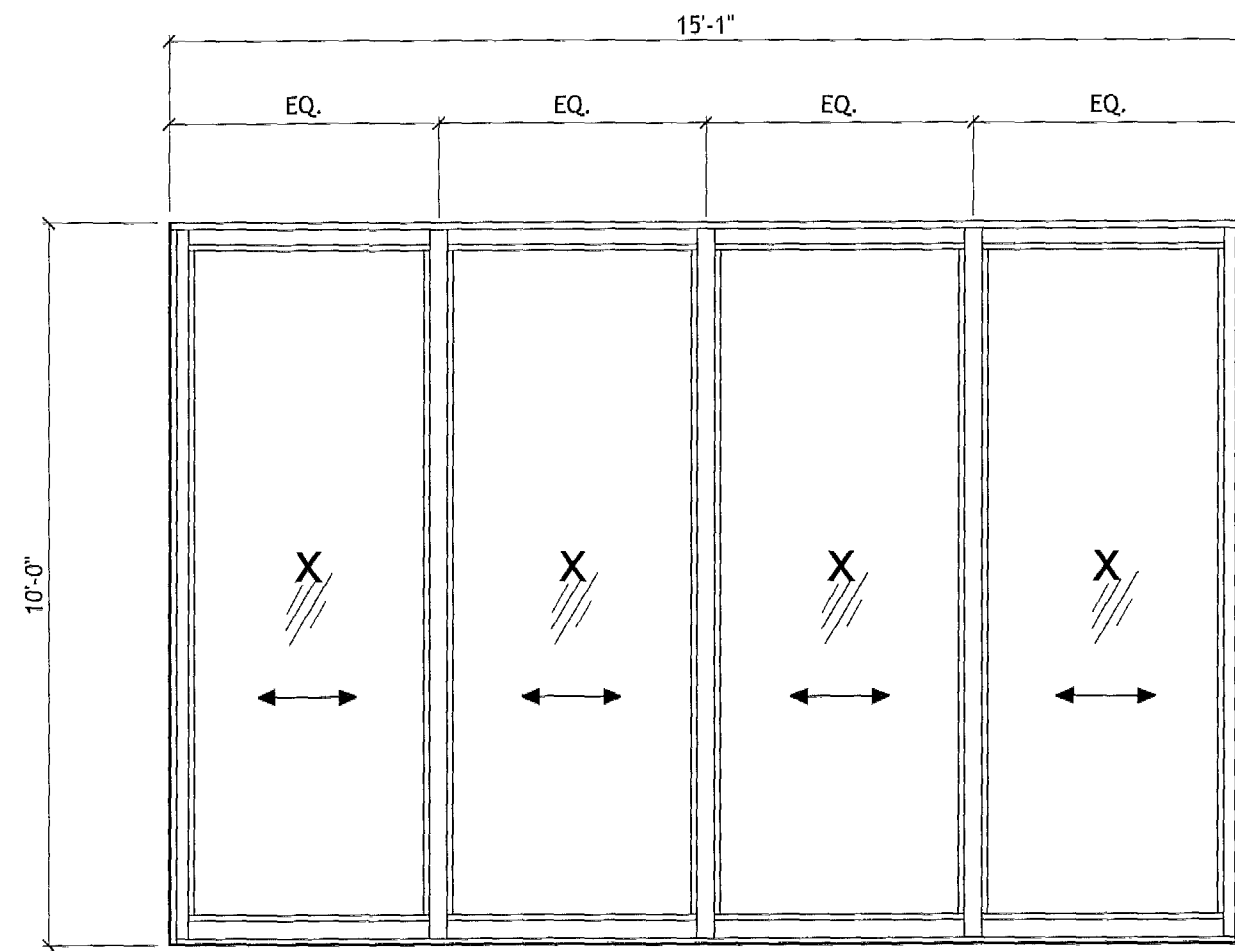


DOOR 100D, 100E
SCALE: 3/8" = 1'-0"

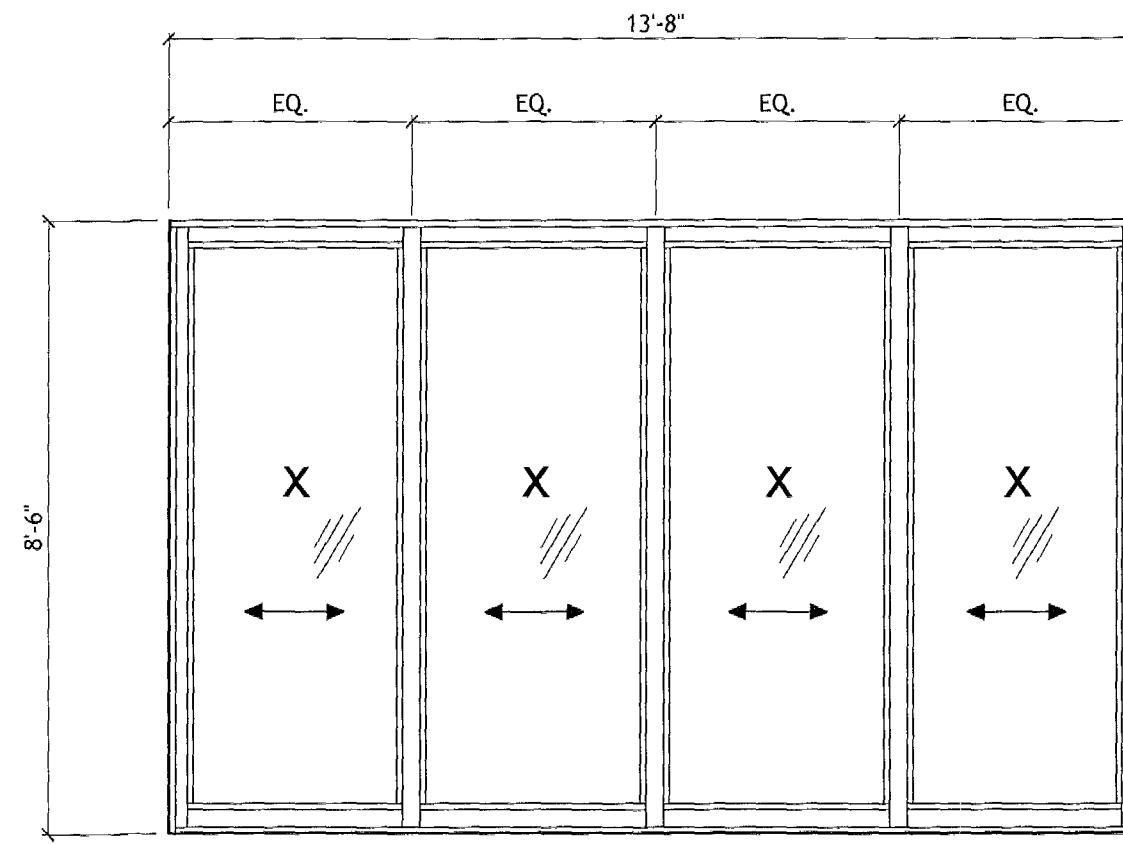


DOOR 200C
SCALE: 3/8" = 1'-0"

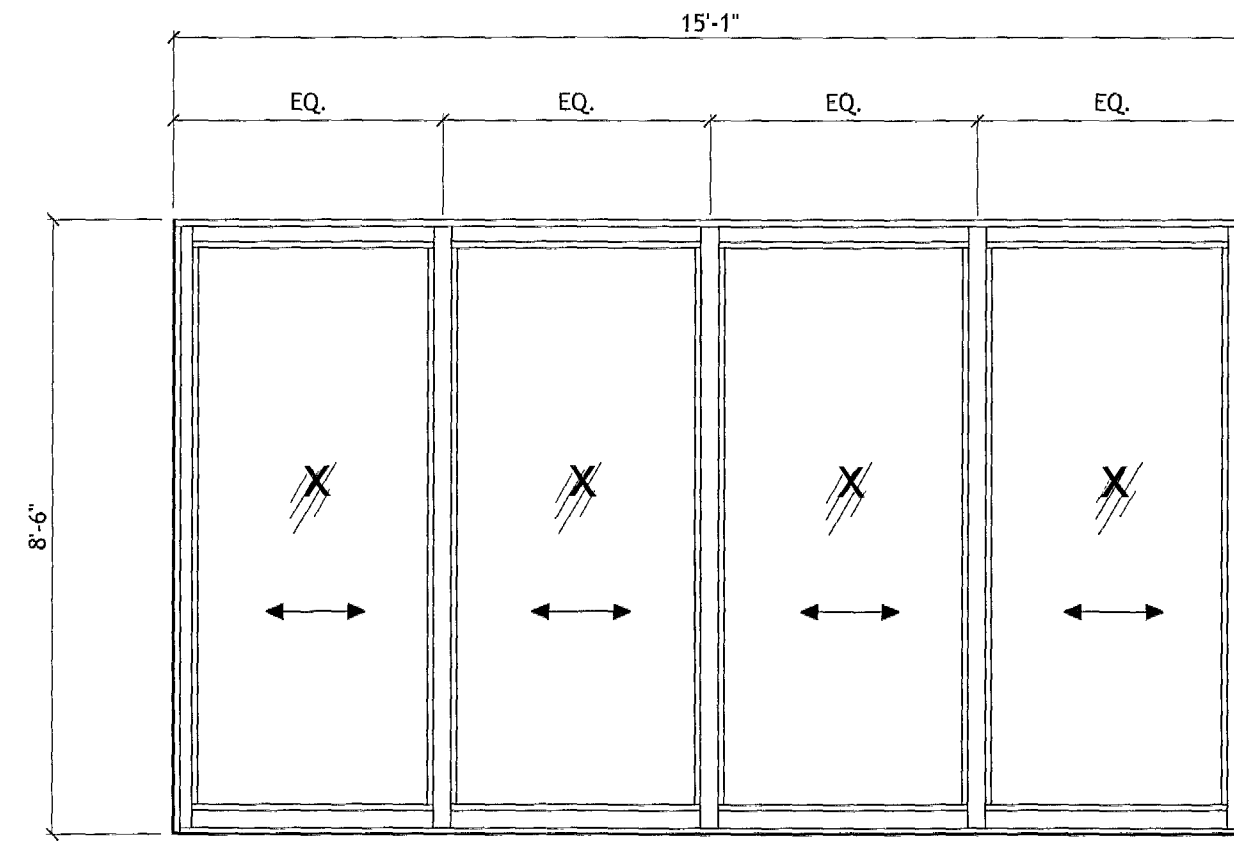


DOOR 200D, 200E
SCALE: 3/8" = 1'-0"

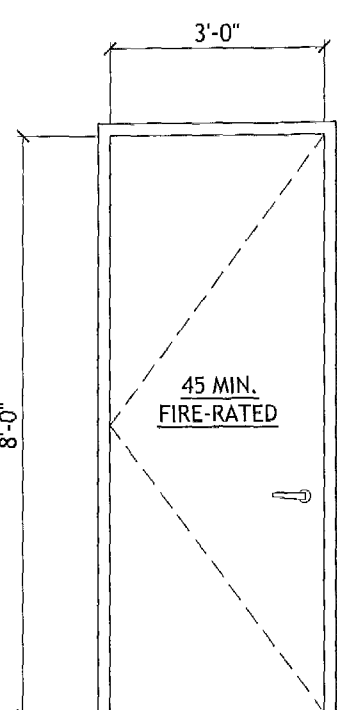


DOOR 101
SCALE: 3/8" = 1'-0"

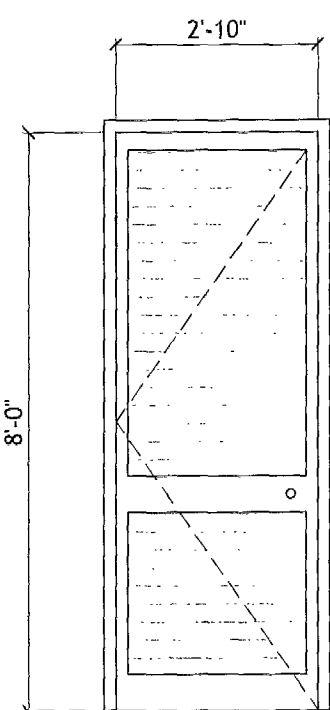


DOOR 102
SCALE: 3/8" = 1'-0"
NON-COMBUSTIBLE

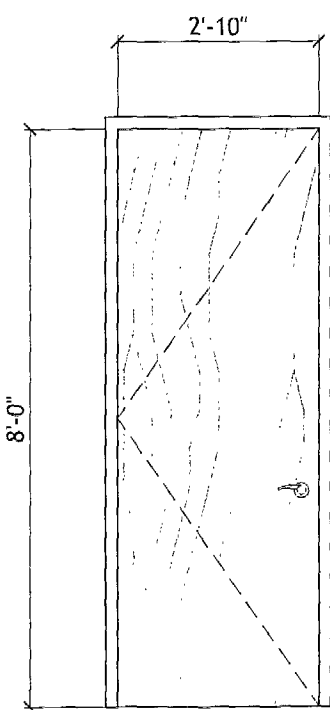


DOOR 103, 104A, 105, 206
SCALE: 3/8" = 1'-0"

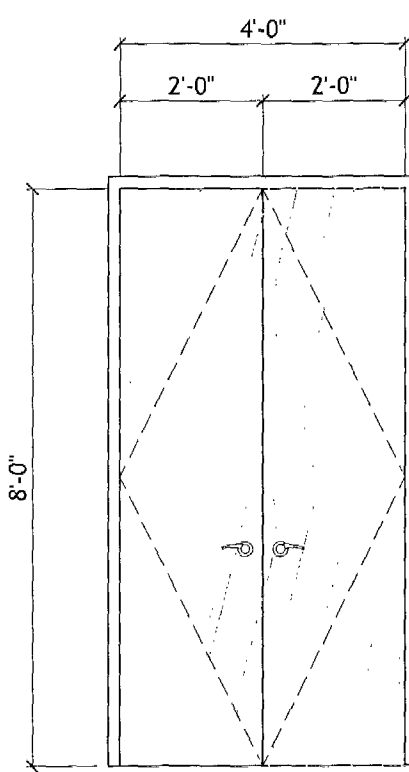


DOOR 104B
SCALE: 3/8" = 1'-0"

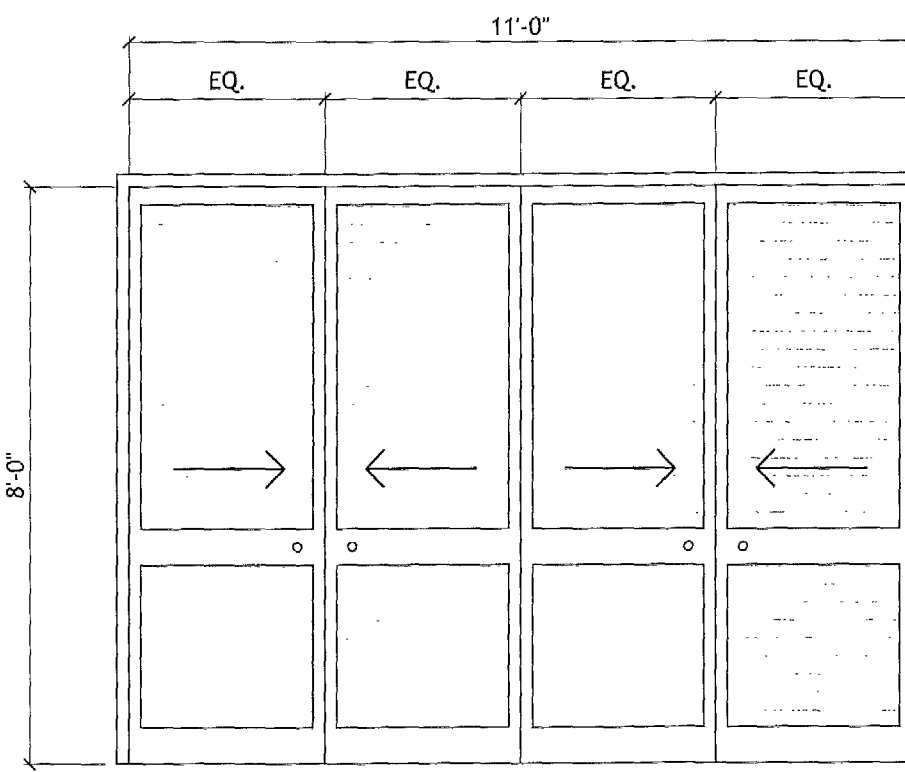


DOOR 202A
SCALE: 3/8" = 1'-0"

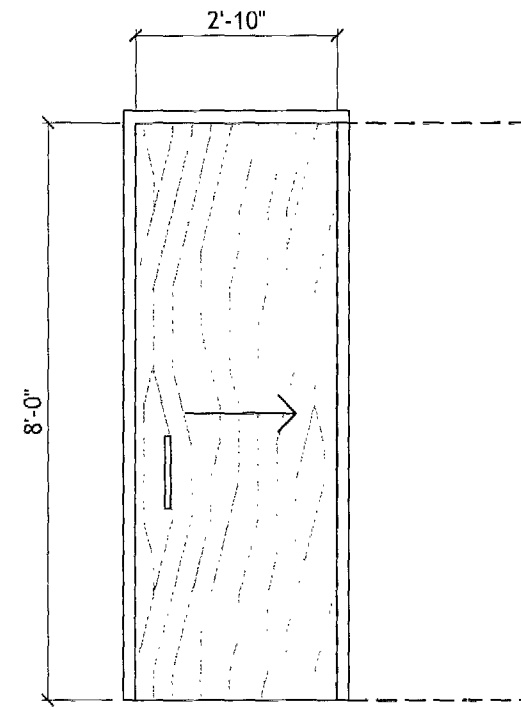


DOOR 104, 201, 201A,
201B, 202, 202B, 203,
203B, 205, 206A, 206B
SCALE: 3/8" = 1'-0"

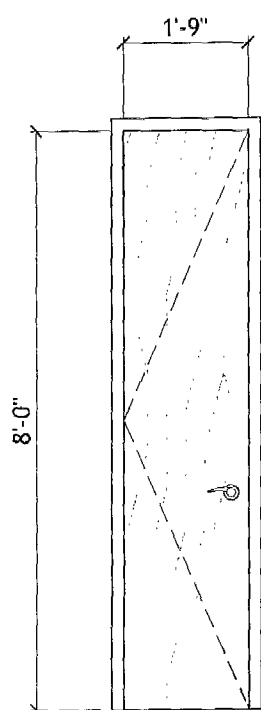


DOOR 106
SCALE: 3/8" = 1'-0"

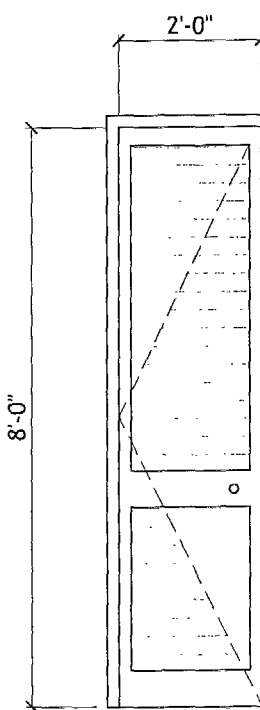


DOOR 202C
SCALE: 3/8" = 1'-0"
NON-COMBUSTIBLE

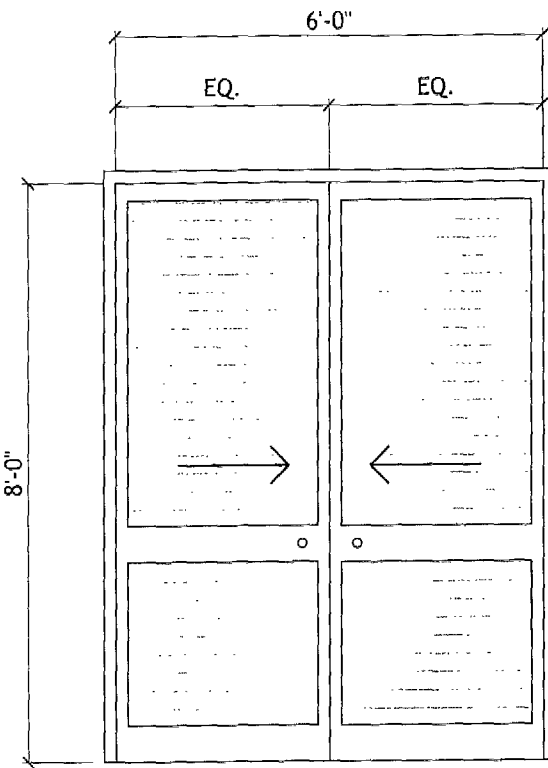


DOOR 203A
SCALE: 3/8" = 1'-0"

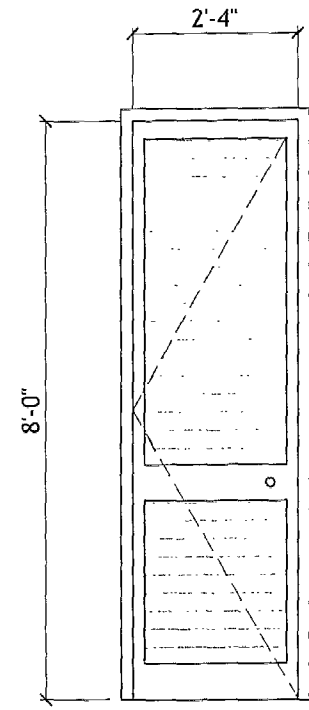

DOOR 204A, 204B
SCALE: 3/8" = 1'-0"
NON-COMBUSTIBLE

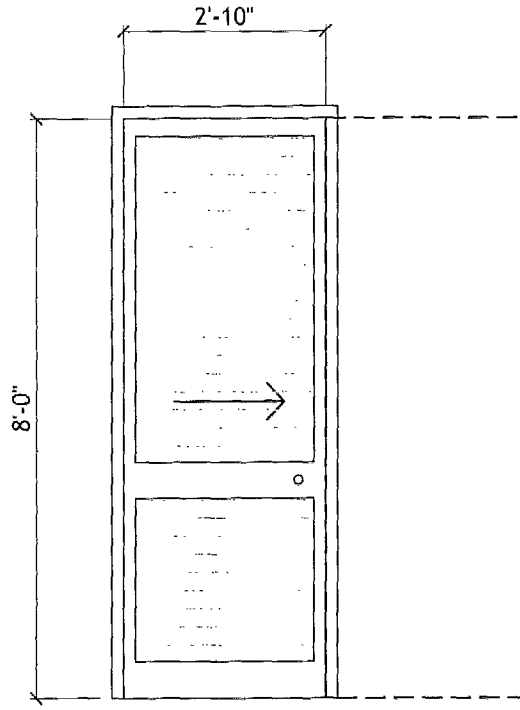

DOOR 204
SCALE: 3/8" = 1'-0"

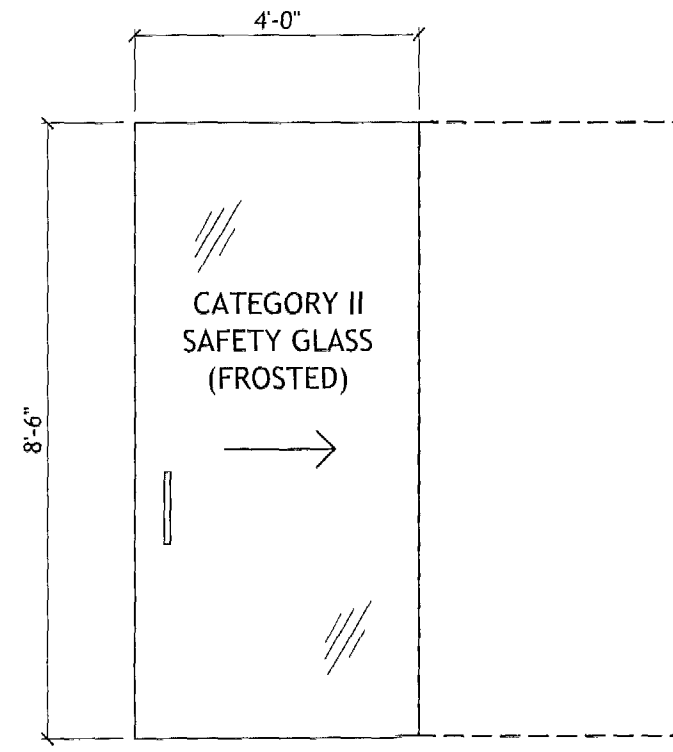

DOOR 206C
SCALE: 3/8" = 1'-0"

SYMBOL LEGEND:
O = FIXED PANEL
X = OPERABLE PANEL

DOOR TYPE LEGEND:
SW-H SWING (HINGE)
SW-P SWING (PIVOT)
BF BI-FOLD
PD POCKET
SL SLIDING
OH OVERHEAD
GAR GARAGE

DOOR SCHEDULE - (See Sheet A.5.1 for all Jamb Details)						
#	SIZE (W x H)	MATERIALS	HARDWARE	TYPE	N.O.A. #	NOTES
100	16'-0" X 8'-0"	STEEL	T.B.D.	GAR	15-0225.15	EXTERIOR - HIGH IMPACT RESISTANT
100A	3'-0" X 8'-0"	ALUMN./GLASS	T.B.D.	SW-H	12-0628.04	EXTERIOR - HIGH IMPACT RESISTANT
100B	2'-10" X 7'-0"	ALUMN./GLASS	T.B.D.	SW-H	12-0628.04	EXTERIOR - HIGH IMPACT RESISTANT
100C	(4) 3'-5" X 10'-0"	ALUMN./GLASS	T.B.D.	SL	12-0130.13	EXTERIOR - HIGH IMPACT RESISTANT
100D	(4) 3'-9 1/4" X 10'-0"	ALUMN./GLASS	T.B.D.	SL	12-0130.13	EXTERIOR - HIGH IMPACT RESISTANT
100E	(4) 3'-9 1/4" X 10'-0"	ALUMN./GLASS	T.B.D.	SL	12-0130.13	EXTERIOR - HIGH IMPACT RESISTANT
101	3'-0" X 8'-0"	HOLLOW METAL	T.B.D.	SW-H		INT., 45-MIN. FIRE-RATED, SELF-CLOSING & SELF-LATCHING
102	2'-10" X 8'-0"	METAL	T.B.D.	SW-H		INT., SWING DOOR, LOUVERED, NON-COMBUSTIBLE
103	2'-10" X 8'-0"	WOOD	T.B.D.	PD		INTERIOR, FLUSH, SWING DOOR
104	2'-10" X 8'-0"	WOOD	T.B.D.	PD		INTERIOR, POCKET DOOR W/ PRIVACY LOCKSET
104A	2'-10" X 8'-0"	WOOD	T.B.D.	SW-H		INTERIOR, FLUSH, SWING DOOR W/ PRIVACY LOCKSET
104B	(2) 2'-0" X 8'-0"	WOOD	T.B.D.	SW-H		INTERIOR, FLUSH, DOUBLE SWING DOOR
105	2'-10" X 8'-0"	WOOD	T.B.D.	SW-H		INTERIOR, FLUSH, SWING DOOR W/ PRIVACY LOCKSET
106	1'-9" X 8'-0"	WOOD	T.B.D.	SW-H		INTERIOR, FLUSH, SWING DOOR
200	NOT USED					
200A	NOT USED					
200B	(2) 3'-0" X 7'-0"	ALUMN./GLASS	T.B.D.	SL	12-0130.13	EXTERIOR - HIGH IMPACT RESISTANT
200C	(4) 3'-5" X 8'-6"	ALUMN./GLASS	T.B.D.	SL	12-0130.13	EXTERIOR - HIGH IMPACT RESISTANT
200D	(4) 3'-9 1/4" X 8'-6"	ALUMN./GLASS	T.B.D.	SL	12-0130.13	EXTERIOR - HIGH IMPACT RESISTANT
200E	(4) 3'-9 1/4" X 8'-6"	ALUMN./GLASS	T.B.D.	SL	12-0130.13	EXTERIOR - HIGH IMPACT RESISTANT
201	2'-10" X 8'-0"	WOOD	T.B.D.	PD		INTERIOR, POCKET DOOR W/ PRIVACY LOCKSET
201A	2'-10" X 8'-0"	WOOD	T.B.D.	PD		INTERIOR, POCKET DOOR
201B	2'-10" X 8'-0"	WOOD	T.B.D.	PD		INTERIOR, POCKET DOOR W/ PRIVACY LOCKSET
202	2'-10" X 8'-0"	WOOD	T.B.D.	PD		INTERIOR, POCKET DOOR W/ PRIVACY LOCKSET
202A	(4) 2'-9" X 8'-0"	WOOD	T.B.D.	SL		INTERIOR, 4-PANEL SLIDING DOOR, LOUVERED
202B	2'-10" X 8'-0"	WOOD	T.B.D.	PD		INTERIOR, POCKET DOOR W/ PRIVACY LOCKSET
202C	2'-0" X 8'-0"	METAL	T.B.D.	SW-H		INT., SWING DOOR, LOUVERED, NON-COMBUSTIBLE
203	2'-10" X 8'-0"	WOOD	T.B.D.	PD		INTERIOR, POCKET DOOR W/ PRIVACY LOCKSET
203A	(2) 3'-0" X 8'-0"	WOOD	T.B.D.	SL		INTERIOR, 2-PANEL SLIDING DOOR, LOUVERED
203B	2'-10" X 8'-0"	WOOD	T.B.D.	PD		INTERIOR, POCKET DOOR W/ PRIVACY LOCKSET
204	2'-10" X 8'-0"	WOOD	T.B.D.	PD		INTERIOR, POCKET DOOR, LOUVERED
204A	2'-4" X 8'-0"	METAL	T.B.D.	SW-H		INT., SWING DOOR, LOUVERED, NON-COMBUSTIBLE
204B	2'-4" X 8'-0"	METAL	T.B.D.	SW-H		INT., SWING DOOR, LOUVERED, NON-COMBUSTIBLE
205	2'-10" X 8'-0"	WOOD	T.B.D.	PD		INTERIOR, POCKET DOOR
206	2'-10" X 8'-0"	WOOD	T.B.D.	SW-H		INTERIOR, FLUSH, SWING DOOR W/ PRIVACY LOCKSET
206A	2'-10" X 8'-0"	WOOD	T.B.D.	PD		INTERIOR, POCKET DOOR
206B	2'-10" X 8'-0"	WOOD	T.B.D.	PD		INTERIOR, POCKET DOOR W/ PRIVACY LOCKSET
206C	4'-0" X 8'-6"	TEMP. GLASS	T.B.D.	PD		INT., FULL-HEIGHT TEMP. GLASS POCKET DOOR

DOOR NOTES:
-HARDWARE & FINISH TO BE COORDINATED W/ MILLWORK PROVIDER (U.N.O.).
-DOOR OPERATION VARIES LEFT OR RIGHT. (SEE PLANS)
-ALL ALUMINUM FINISHES T.B.D., (U.N.O.). SUBMIT SAMPLE TO ARCHITECT.
-ALL FIRE-RATED DOORS SHALL BE EQUIPPED WITH SELF-CLOSING AND SELF-LATCHING DEVICES AND COMPLY W/ NFPA 80.
-GENERAL CONTRACTOR TO SUBMIT HARDWARE PACKAGE TO OWNER AND ARCHITECT FOR REVIEW & APPROVAL.
-PROVIDE CATEGORY II SAFETY GLASS AT GLASS PANELS ADJACENT TO DOORS.
-CONTRACTOR TO FIELD VERIFY ALL OPENINGS AND DIMENSIONS AND SUBMIT SHOP DWGS FOR ARCHITECTS APPROVAL PRIOR TO DOOR FABRICATION.
-CONTRACTOR TO COORDINATE DOOR TYPES & SIZES W/ INT. DESIGNER DWGS.

DRAWN BY:
REVISIONS:
8-14-15


AA0003969
ANTHONY LEON
0006752

3 DESIGN
ARCHITECTURE
4300 Biscayne Blvd. #G-04, Miami, FL 33137
P: 305.438.9377 | F: 305.438.8378


NEW RESIDENCE
AT:
4354 ALTON ROAD
MIAMI BEACH, FL 33139
AUG 24 2015

THESE PLANS ARE FOR BUILDING
DEPARTMENT REVIEW ONLY. THEY ARE NOT
TO BE CONSIDERED AS CONSTRUCTION
DOCUMENTS UNTIL ALL BUILDING
DEPARTMENT APPROVALS ARE OBTAINED.

A.5.0
DOOR SCHEDULE

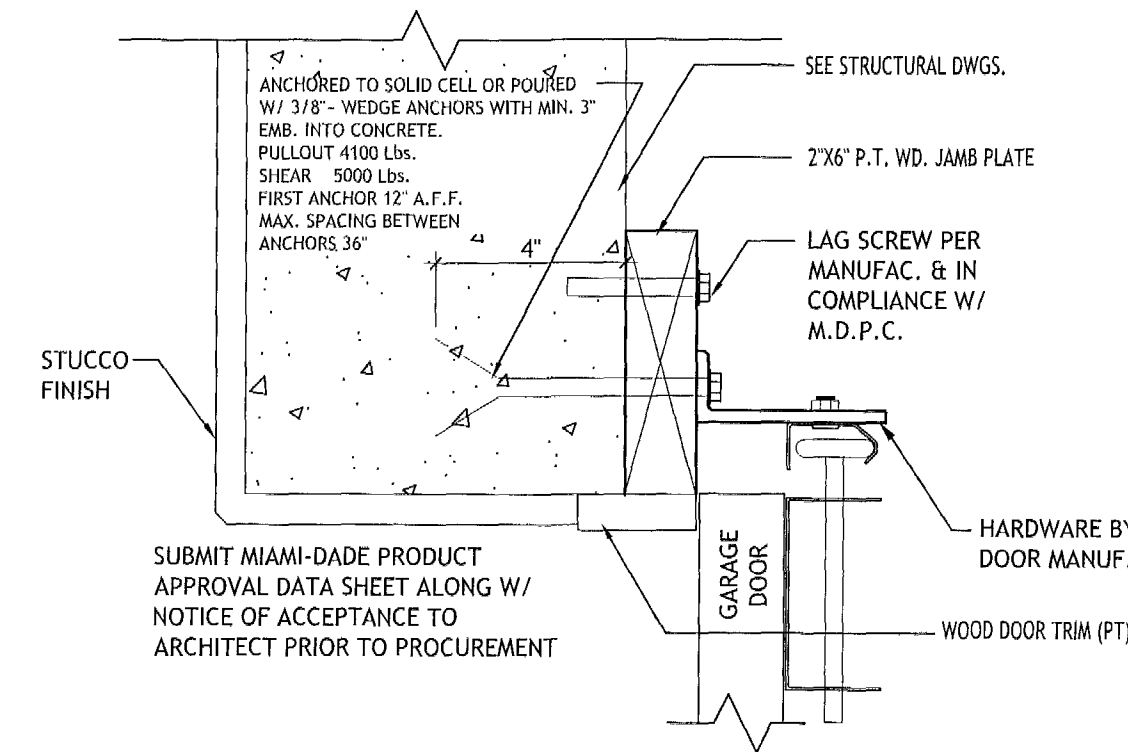


GARAGE DOOR JAMB DETAIL
SCALE: 3" = 1'-0"

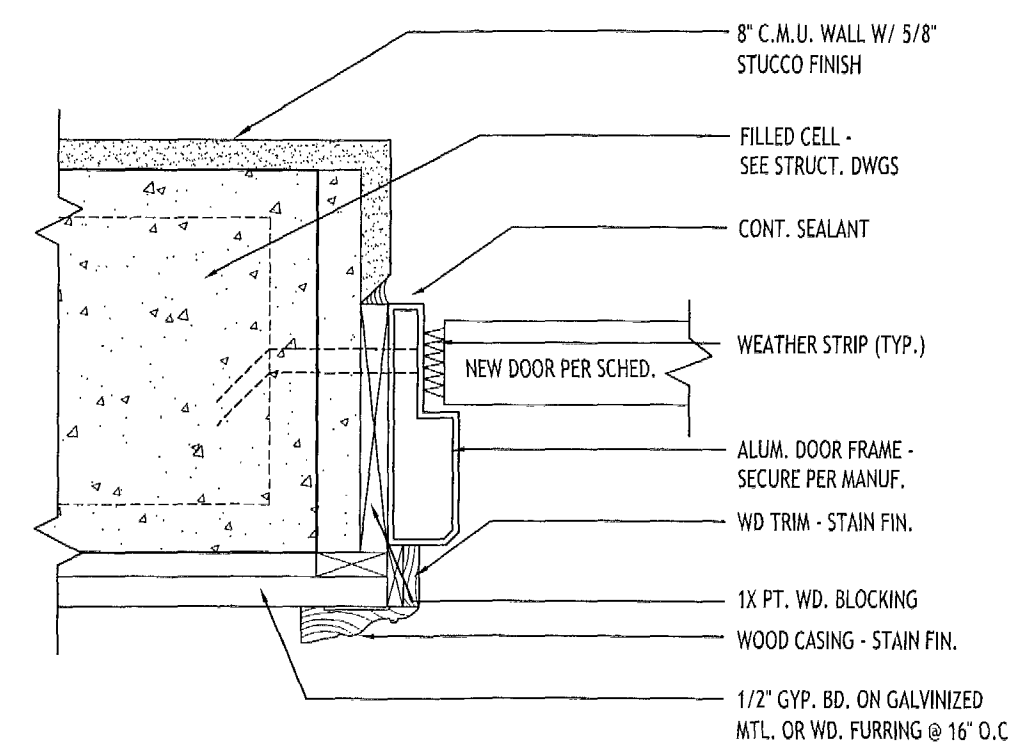


EXTERIOR SWING DOOR JAMB DETAIL
SCALE: 3" = 1'-0"


EXTERIOR DOOR JAMB DETAILS
SCALE: 3" = 1'-0"

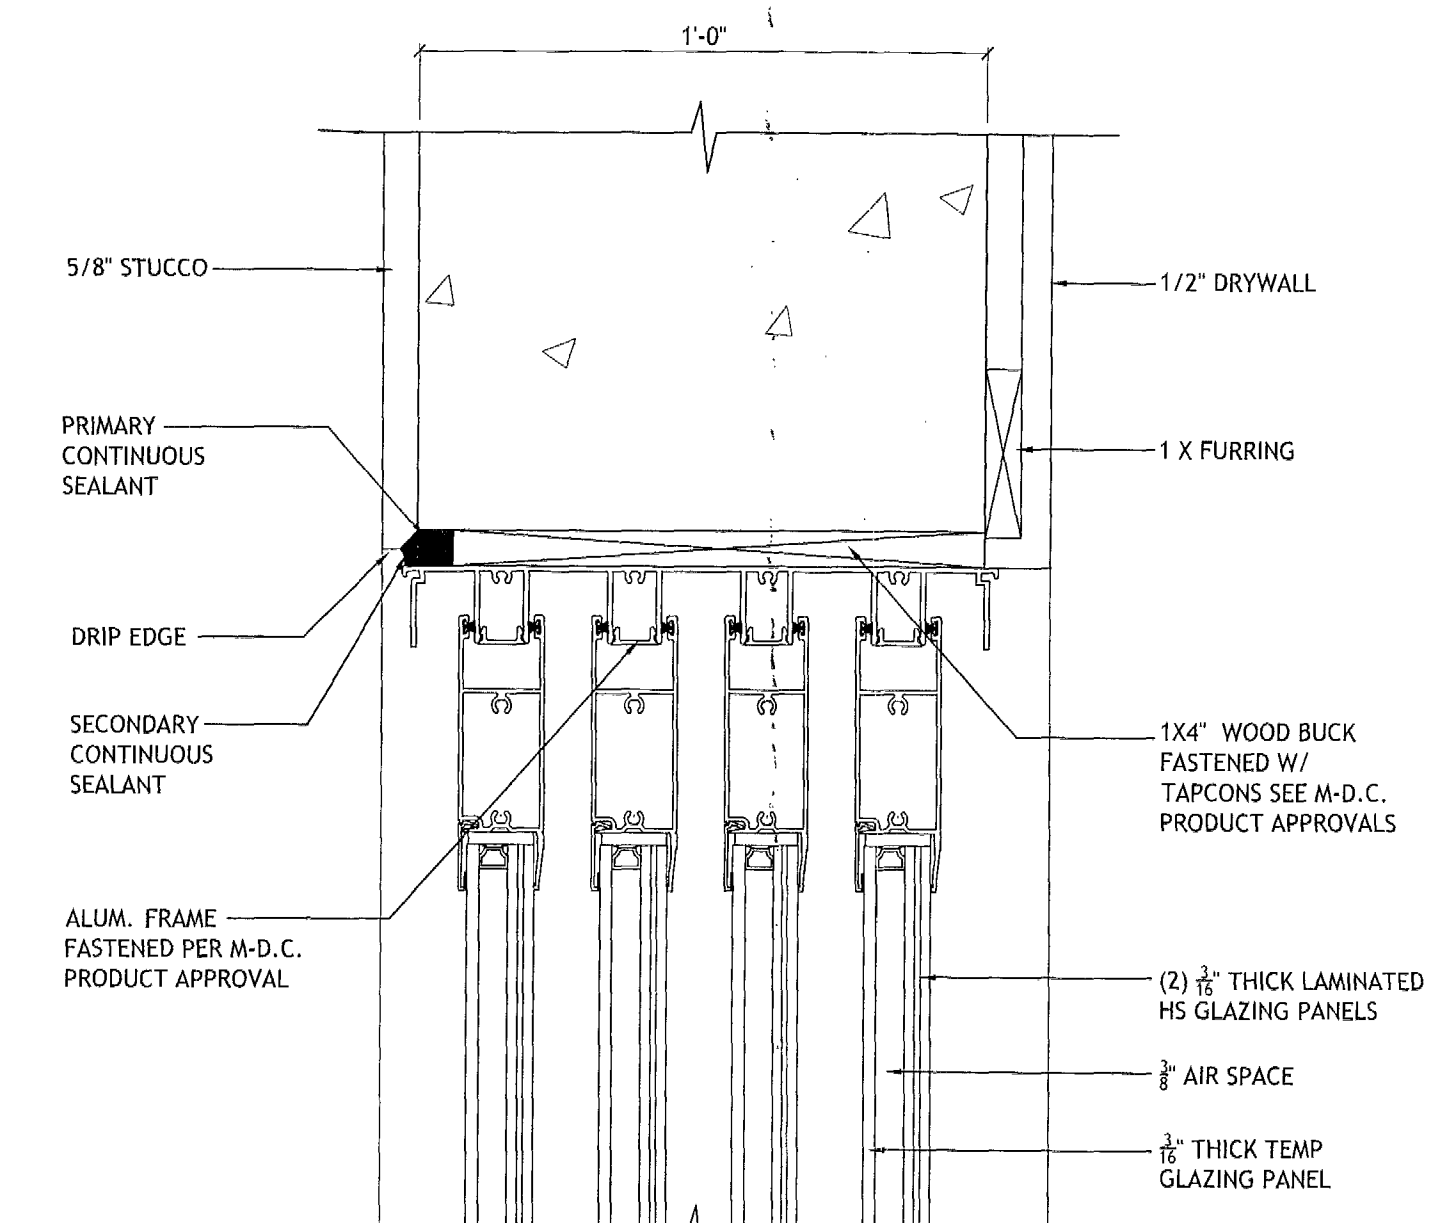


TYP. SLIDING DOOR HEAD
SCALE: 3" = 1'-0"

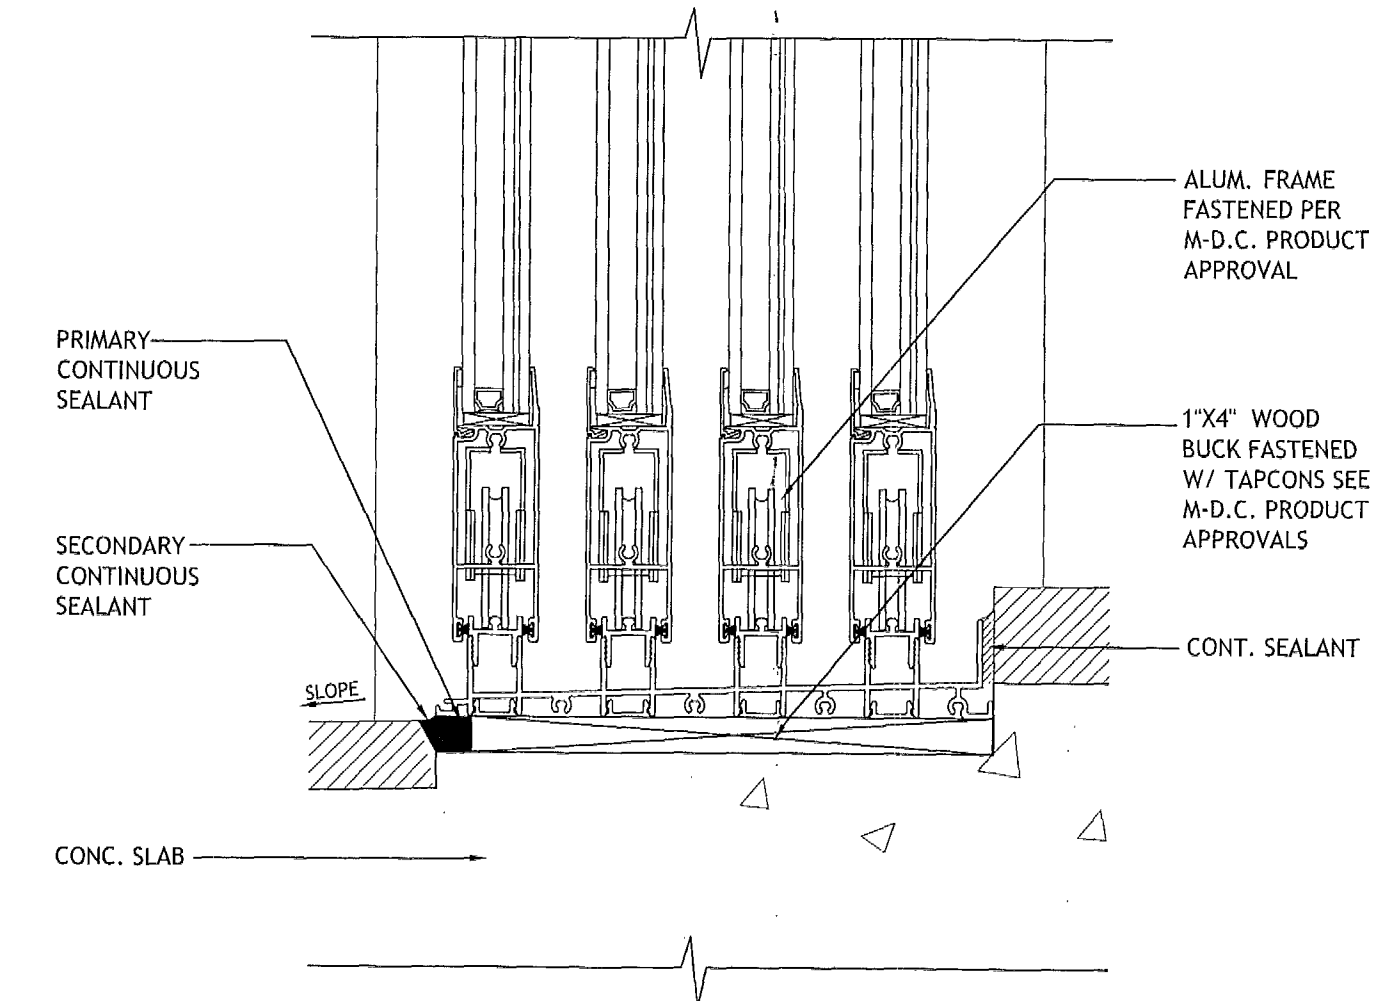


TYP. SLIDING DOOR SILL
SCALE: 3" = 1'-0"

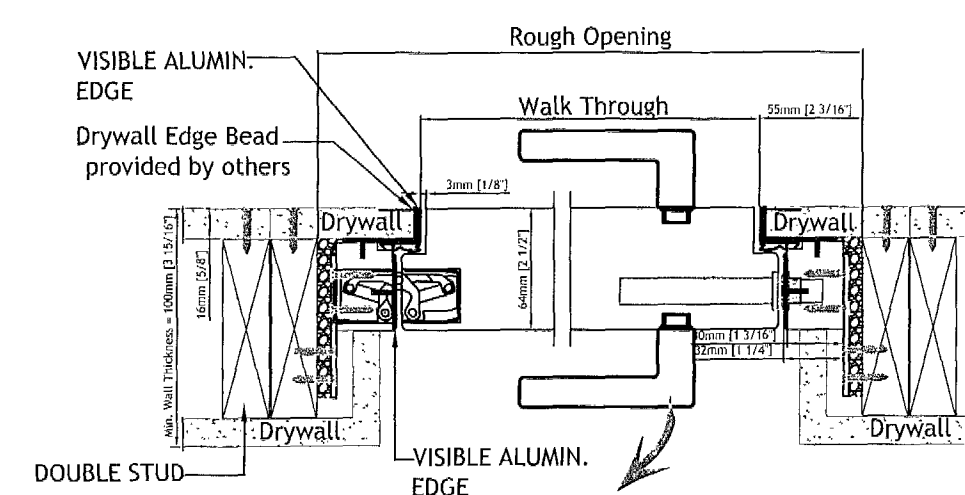


FLUSH WITH THE WALL (IN-SWING)

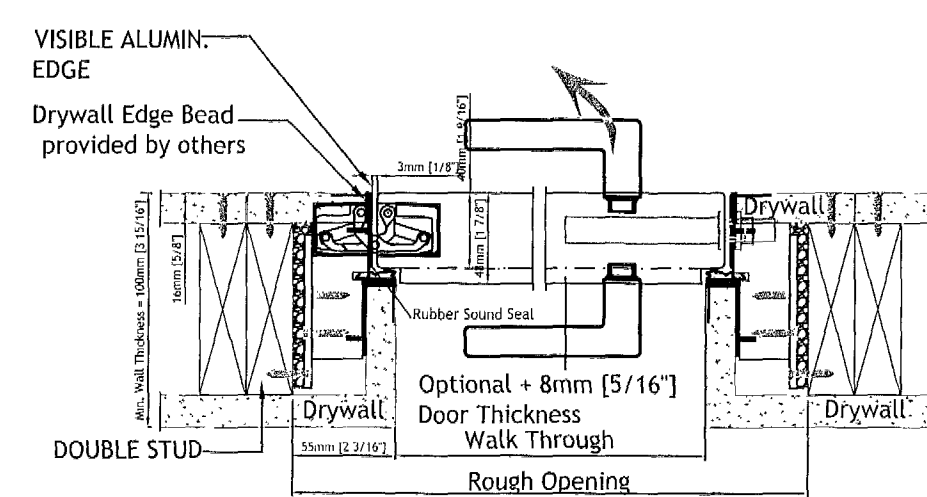

FLUSH WITH THE WALL (OUT-SWING)

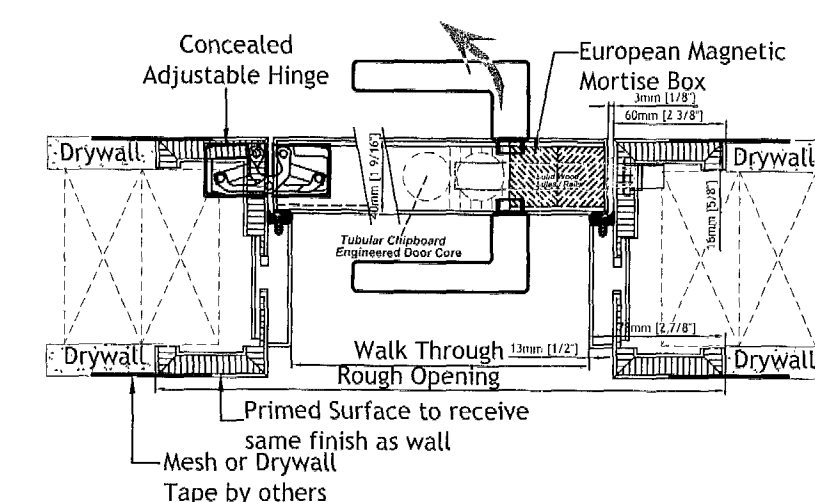

ULTRA-FLUSH CONCEALED CASING

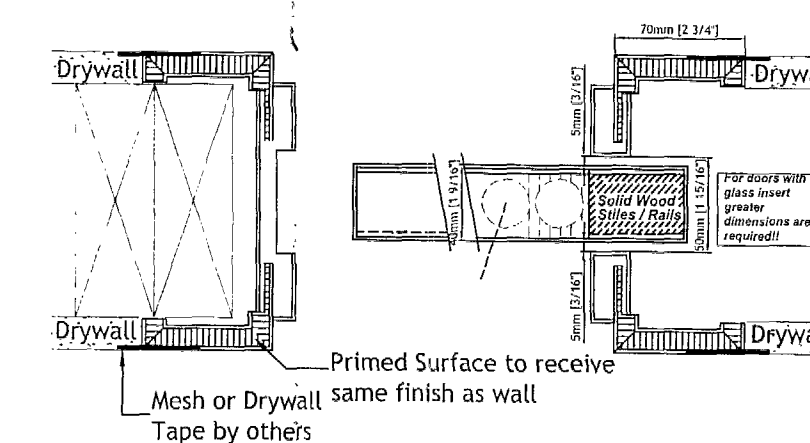

ULTRA-FLUSH POCKET DOOR

INTERIOR DOOR JAMB DETAILS
SCALE: 3" = 1'-0"

DRAWN BY:

REVISIONS:

AAD003669
ANTHONY LEON
001672

DESIGN
ARCHITECTURE
4300 Biscayne Blvd. #G-04, Miami, FL 33137
P: 305.438.9377 | F: 305.438.9329


Anthony Leon
AUG 24 2015

NEW RESIDENCE
AT
4354 ALTON ROAD
MIAMI BEACH, FL 33139


THESE PLANS ARE FOR BUILDING DEPARTMENT REVIEW ONLY. THEY ARE NOT TO BE CONSTRUED AS CONSTRUCTION DOCUMENTS UNTIL ALL BUILDING DEPARTMENT APPROVALS ARE OBTAINED.

A.5.1


DOOR JAMB
DETAILS

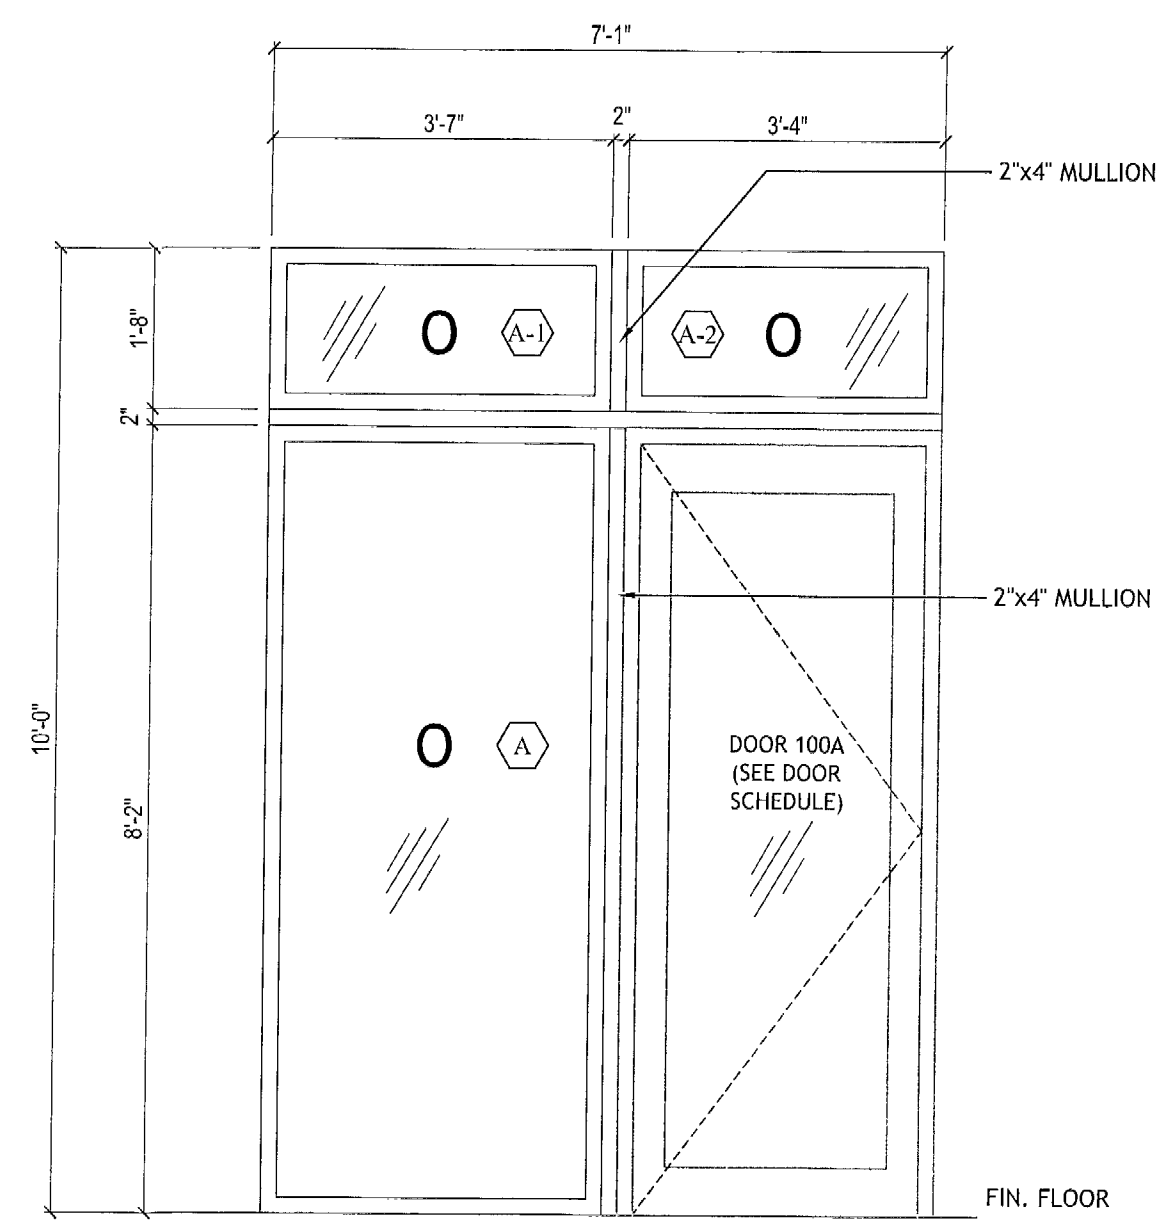


WINDOWS A, A-1, A-2
SCALE: 1/2" = 1'-0"

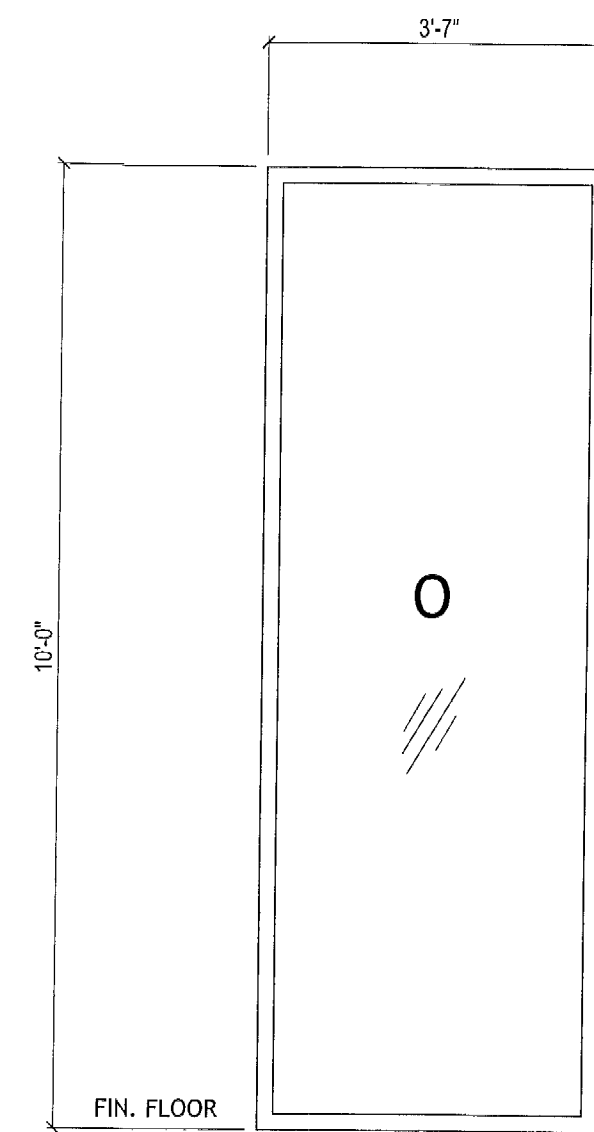


WINDOW C
SCALE: 1/2" = 1'-0"

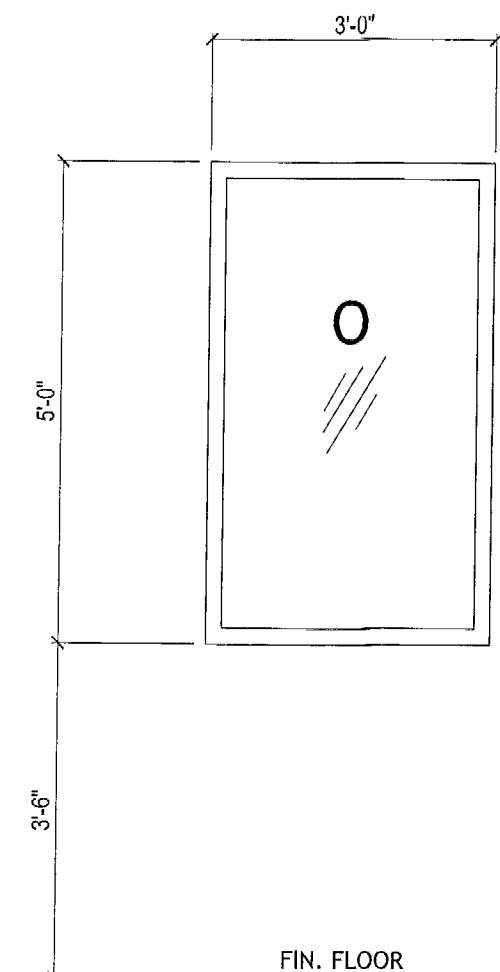


WINDOW D
SCALE: 1/2" = 1'-0"

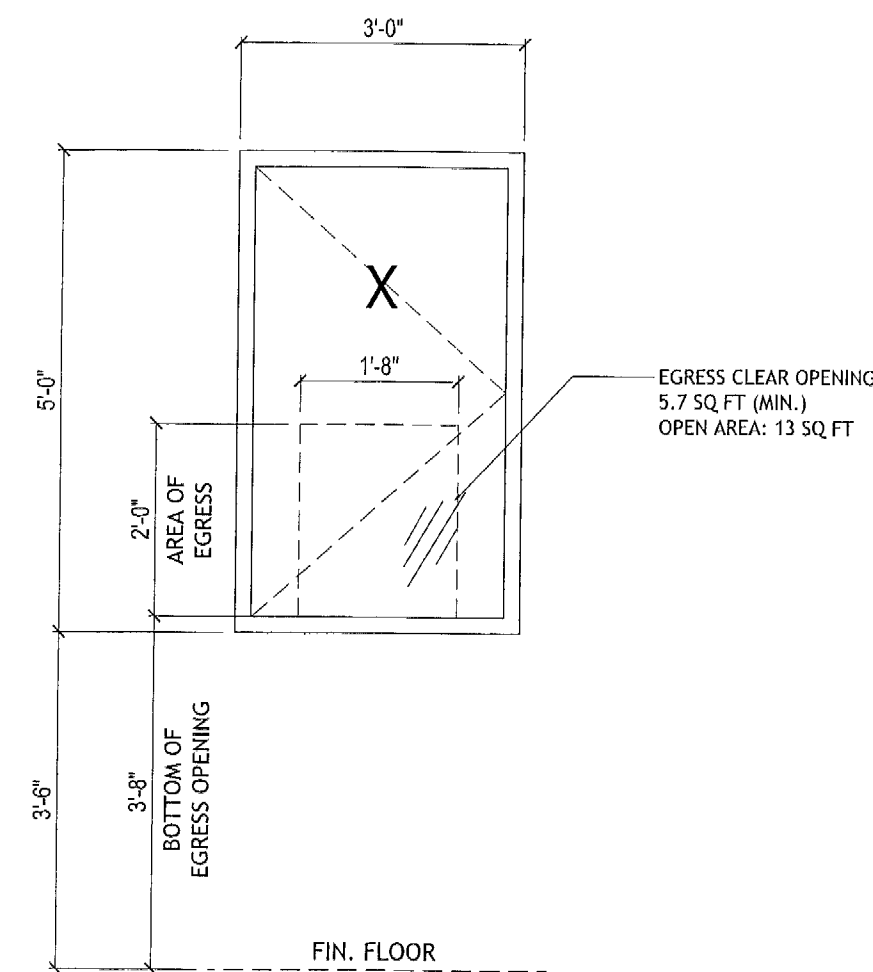


WINDOW E
SCALE: 1/2" = 1'-0"

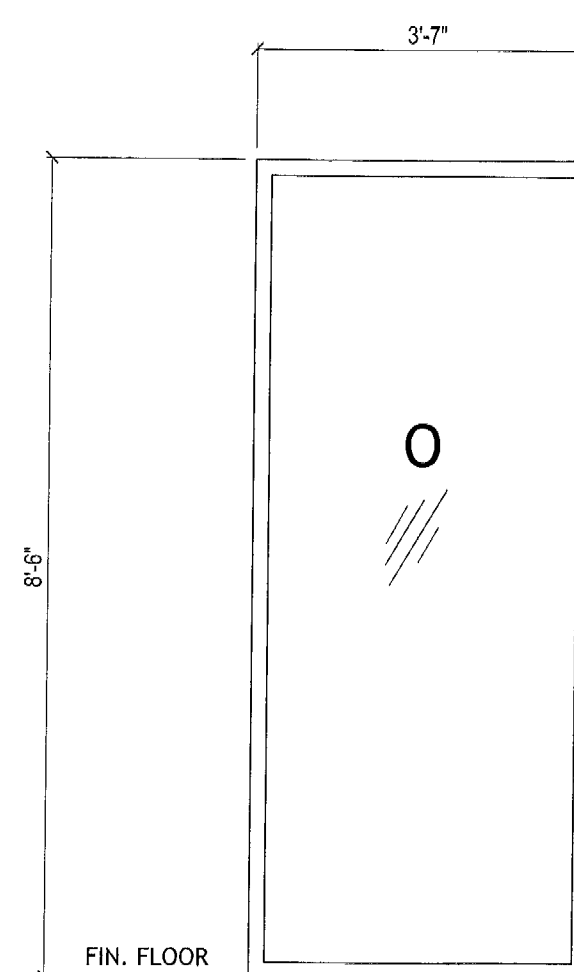


WINDOW G
SCALE: 1/2" = 1'-0"

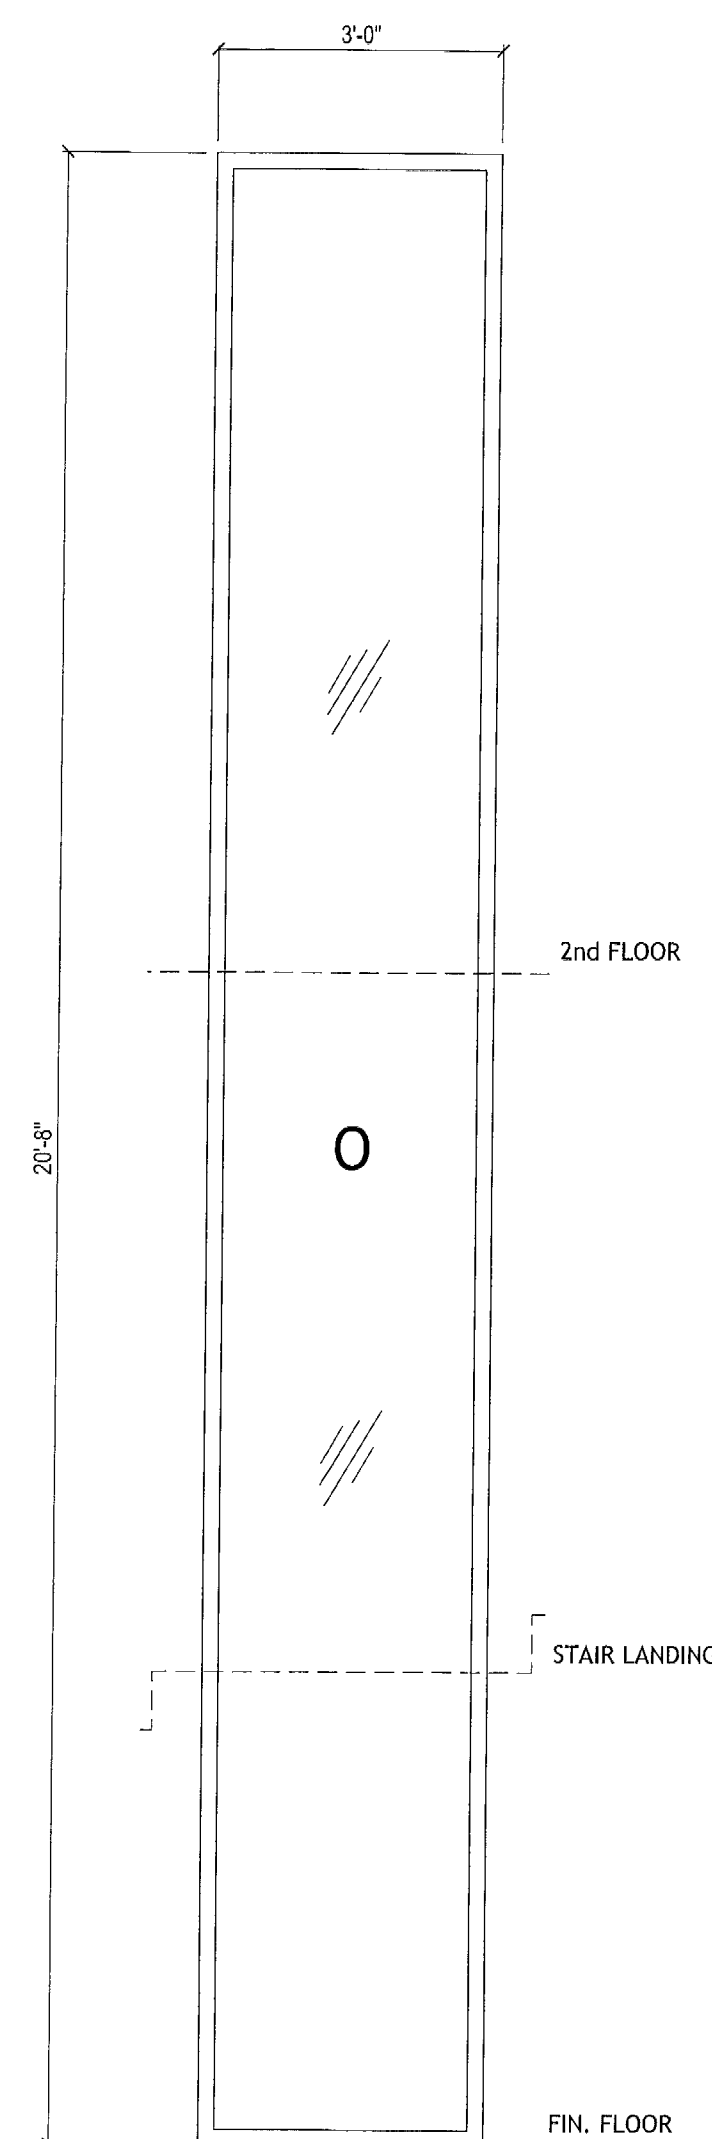


WINDOW B
SCALE: 1/2" = 1'-0"

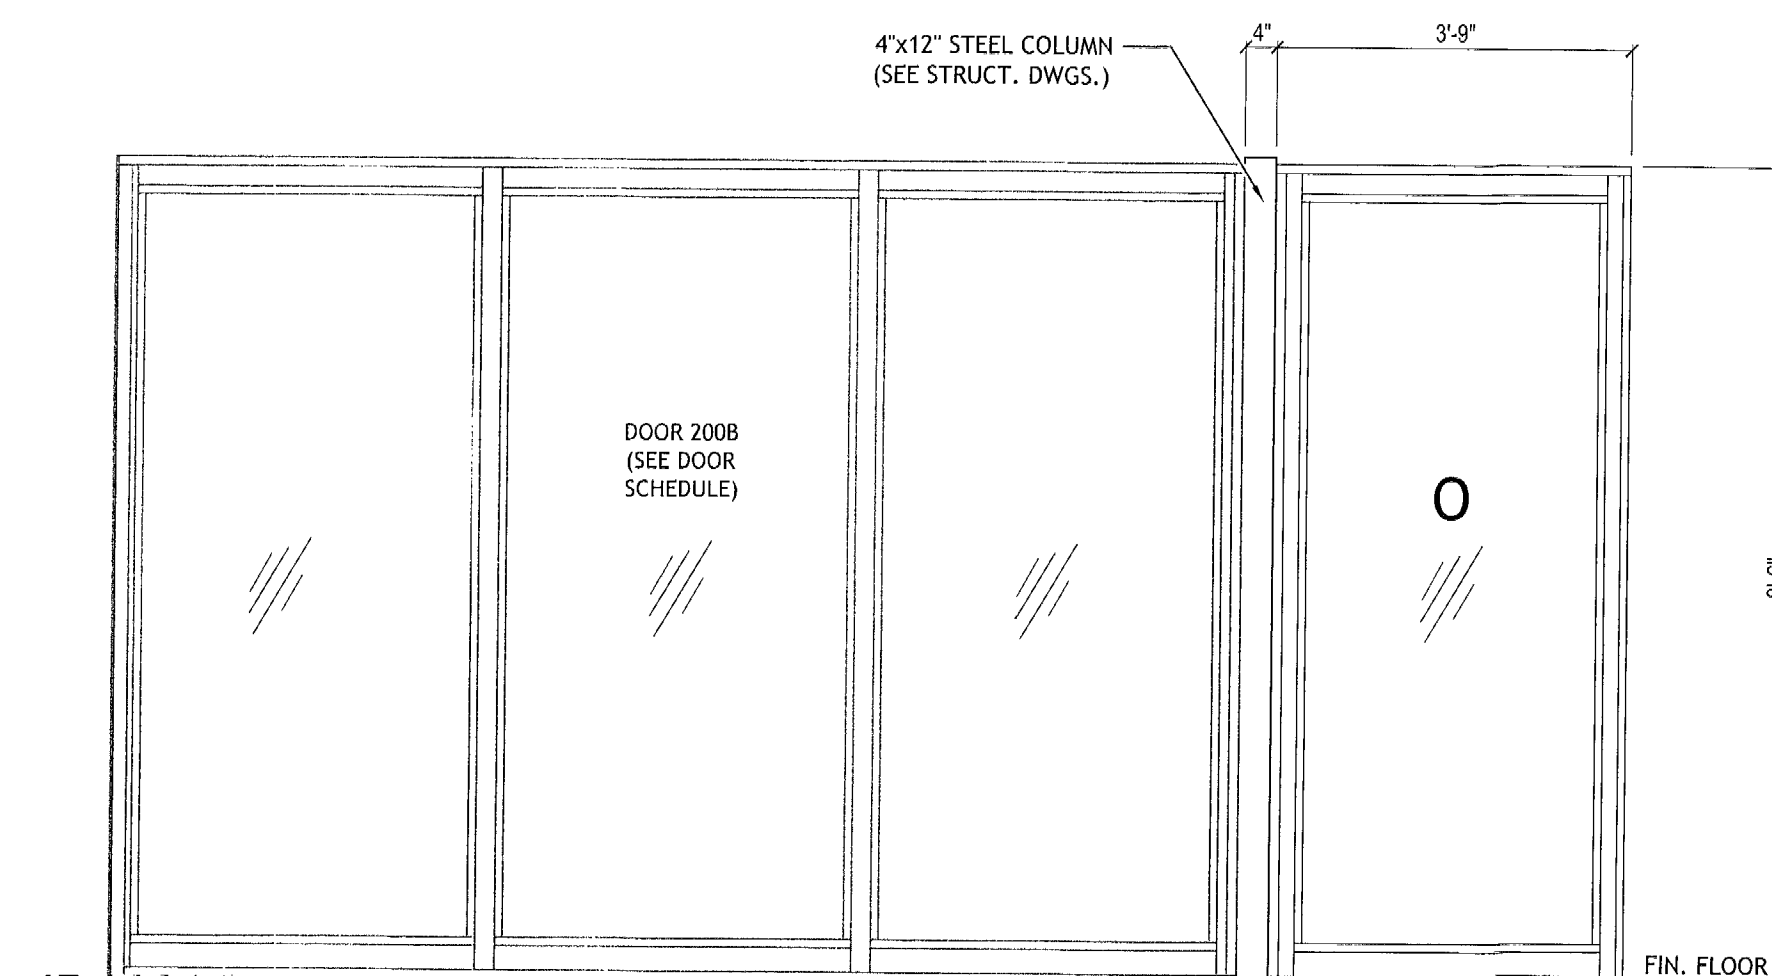


WINDOW F
SCALE: 1/2" = 1'-0"

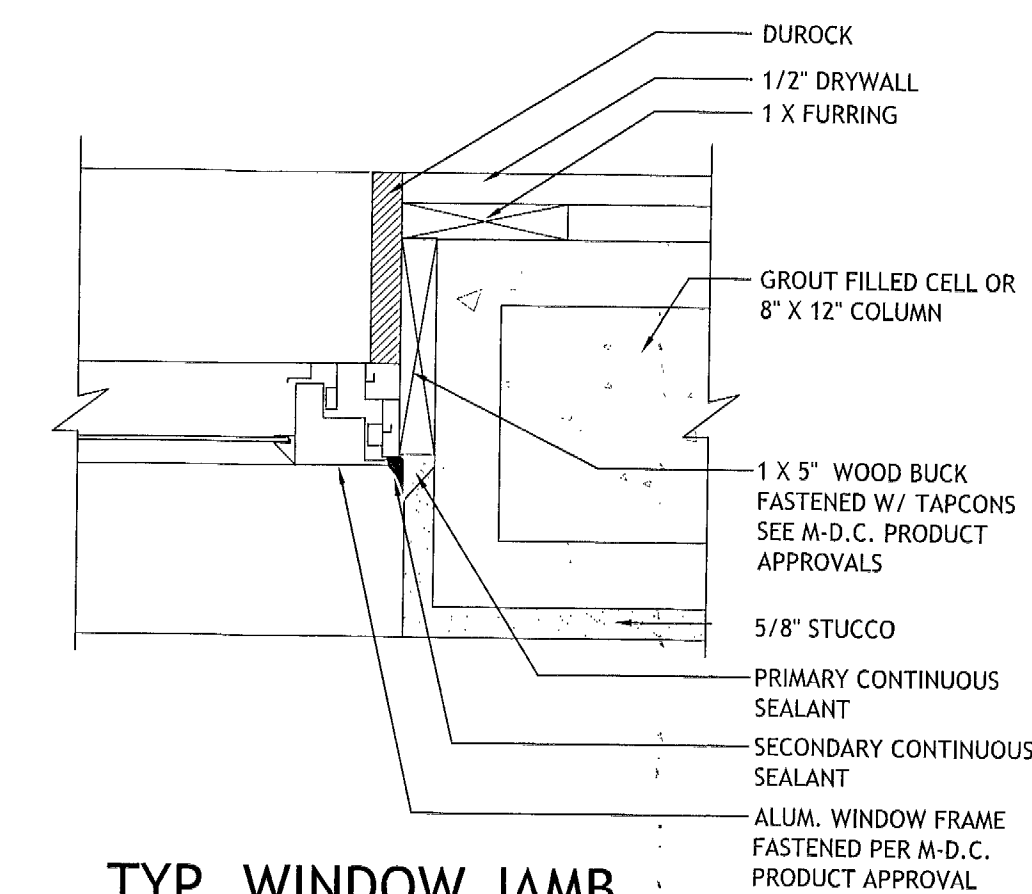

TYP. WINDOW JAMB
SCALE: 3" = 1'-0"

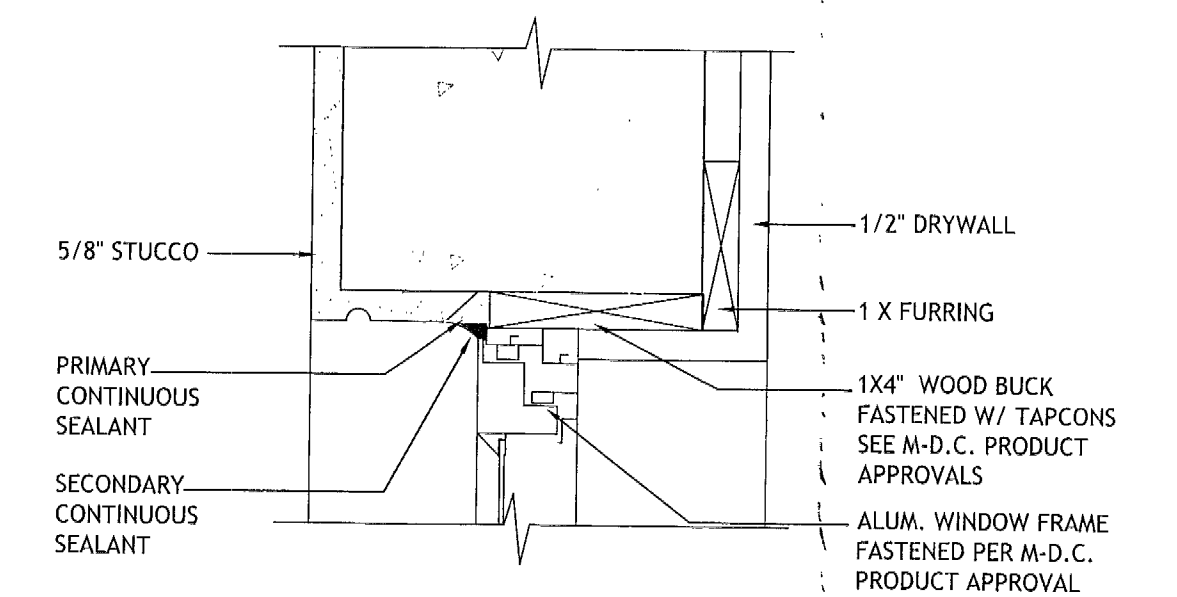

TYP. WINDOW HEAD
SCALE: 3" = 1'-0"

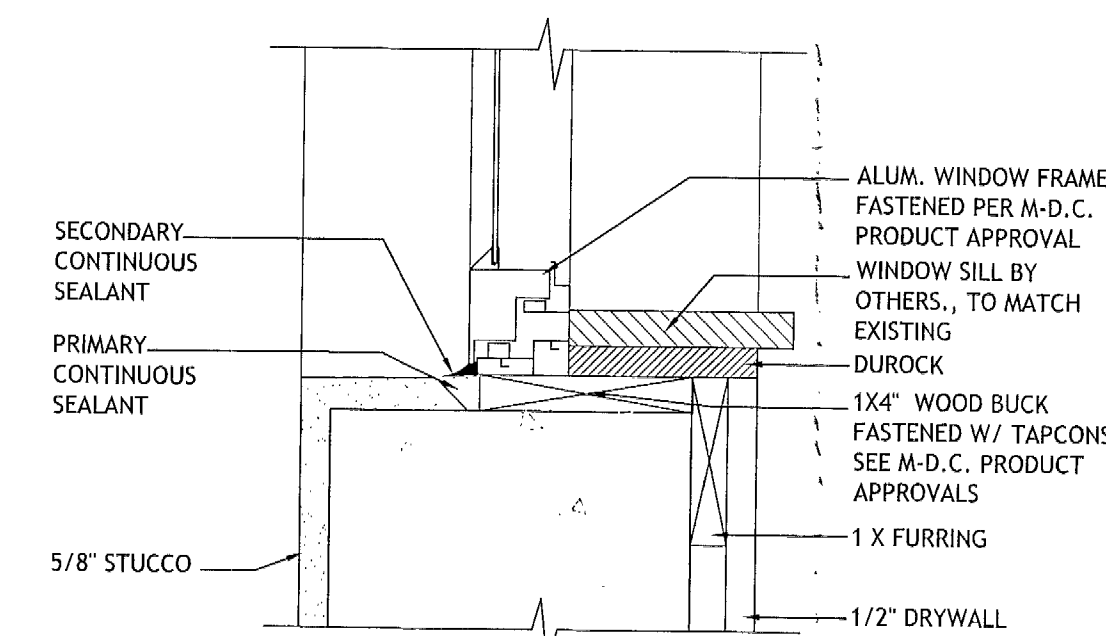

TYP. WINDOW SILL
SCALE: 3" = 1'-0"

WINDOW SCHEDULE:							MULLION(S)	
#	SIZE: W x H	QTY.	MATERIALS	TYPE	GLASS	N.O.A.#	NOTES	QTY. - SIZE - TYPE
A	3'-7" X 8'-2"	1	ALUM/GLASS	FIXED	IMPACT GLASS	14-0916.12		(1) 2x4 VERTICAL
A-1	3'-7" X 1'-8"	1	ALUM/GLASS	FIXED	IMPACT GLASS	14-0916.12	ABOVE ENTRANCE DOOR	14-1014.05
A-2	3'-4" X 1'-8"	1	ALUM/GLASS	FIXED	IMPACT GLASS	14-0916.12	ABOVE ENTRANCE DOOR	14-1014.05
B	3'-0" X 20'-8"	1	ALUM/GLASS	FIXED	IMPACT GLASS	14-0916.12		(1) 2x4 VERTICAL
C	3'-7" X 10'-0"	1	ALUM/GLASS	FIXED	IMPACT GLASS	14-0916.12		
D	3'-0" X 5'-0"	2	ALUM/GLASS	FIXED	IMPACT GLASS	14-0916.12		
E	3'-0" X 5'-0"	1	ALUM/GLASS	CASEMENT	IMPACT GLASS	14-0305.03		
F	3'-9" X 8'-6"	1	ALUM/GLASS	FIXED	IMPACT GLASS	14-0916.12	EGRESS WINDOW	
G	3'-7" X 8'-6"	1	ALUM/GLASS	FIXED	IMPACT GLASS	14-0916.12		

SYMBOL LEGEND:
O = FIXED PANEL
X = OPERABLE PANEL

NOTES:
• WINDOWS TO HAVE LOW E IMPACT GLASS
• ALL ALUMINUM FINISHES TO BE DETERMINED BY OWNER
• PROVIDE CATEGORY II SAFETY GLASS AT GLASS PANELS ADJACENT TO DOORS
• ALL GLASS TO HAVE A MAX U-VALUE OF 0.96 AND A SHGC OF 0.60
• WINDOW OPERATION VARIES LEFT OR RIGHT. SEE PLANS FOR CONFIGURATIONS.

CONTRACTOR SHALL FIELD VERIFY ALL OPENINGS & DIMENSIONS, AND SUBMIT SHOP DRAWINGS FOR ARCHITECTS APPROVAL PRIOR TO WINDOW FABRICATION.

*** FOR REFERENCE ONLY ***
ALL EXTERIOR WINDOWS UNDER SEPARATE PERMIT

DRAWN BY:
REVISIONS:
8/14/15

AA0003569
ANTHONY LEON
0016/52


3 DESIGN
ARCHITECTURE
4300 Biscayne Blvd. #G-04, Miami, FL 33137
P: 305.438.9377 | F: 305.438.9379

NEW RESIDENCE
AT:
4354 ALTON ROAD
MIAMI BEACH, FL 33139


NEW RESIDENCE
AT:
4354 ALTON ROAD
MIAMI BEACH, FL 33139

THESE PLANS ARE FOR BUILDING DEPARTMENT REVIEW ONLY. THEY ARE NOT TO BE CONTROLLED AS CONSTRUCTION DOCUMENTS UNTIL ALL BUILDING DEPARTMENT APPROVALS ARE OBTAINED.

A.6.0
WINDOW SCHEDULE

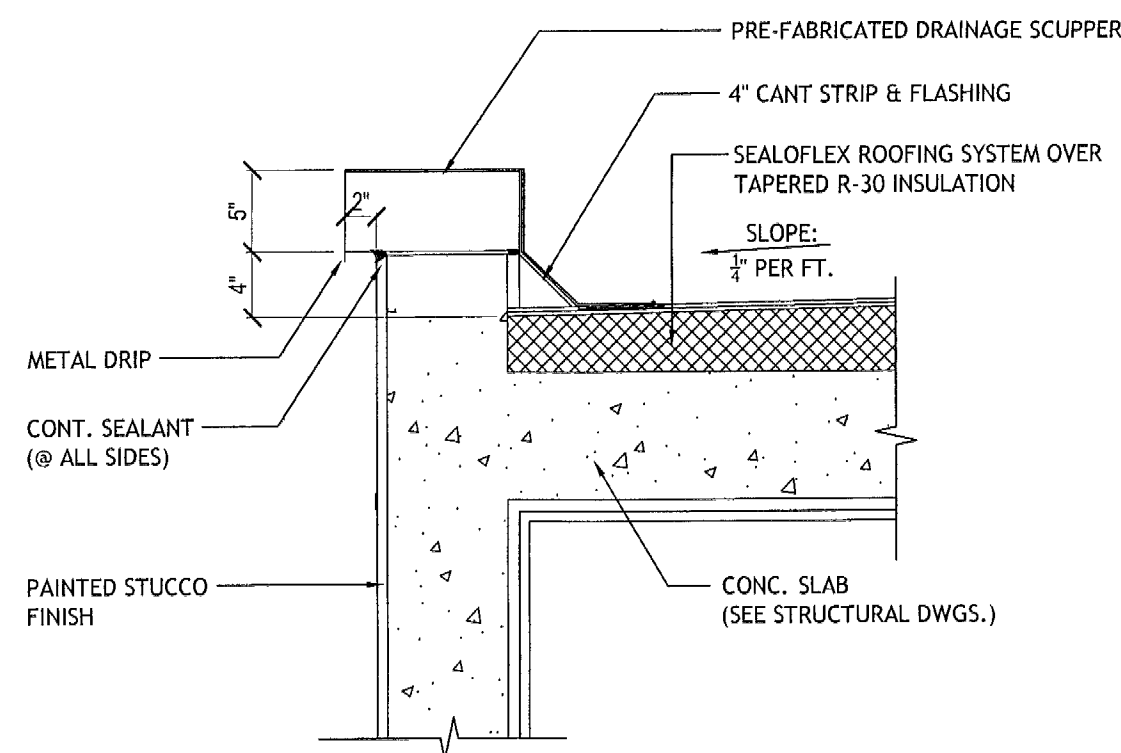


3 TYP. EMERGENCY OVERFLOW DETAIL
SCALE: 1" = 1'-0"

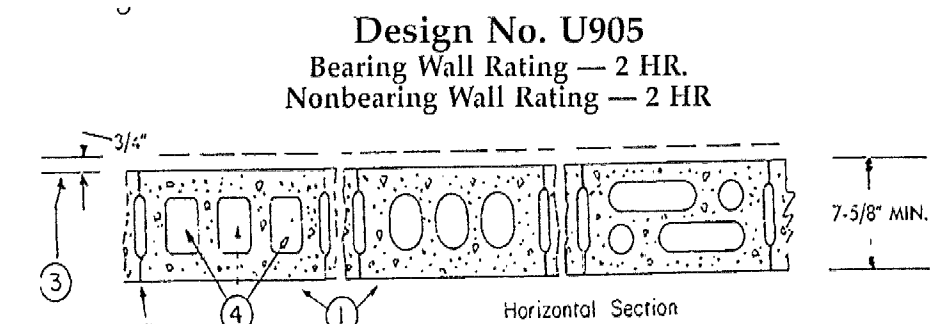


- Concrete Blocks** — Various designs. Classification D-2 (2 hr). See Concrete Blocks category for list of eligible manufacturers.
- Mortar** — Blocks laid in full bed of mortar, nom. 3/8 in. thick, of not less than 2-1/4 and not more than 3-1/2 parts of clean sharp sand to 1 part Portland cement (proportioned by volume) and not more than 50 percent hydrated lime (by cement volume). Vertical joints staggered.
- Portland Cement Stucco or Gypsum Plaster** — Add 1/2 hr to classification if used. Where combustible members are framed in wall, plaster or stucco must be applied on the face opposite framing to achieve a max. Classification of 1-1/2 hr. Attached to concrete blocks (Item 1).
- Loose Masonry Fill** — If all core spaces are filled with loose dry expanded slag, expanded clay or shale (Rotary Kiln Process), water repellent vermiculite masonry fill insulation, or silicone treated perlite loose fill insulation add 2 hr to classification.
- Foamed Plastic** — (Optional-Not Shown) — 1-1/2 in. thick max, 4 ft wide sheathing attached to concrete blocks (Item 1).


THE DOW CHEMICAL CO — Type Thermax
*Bearing the UL Classification Mark

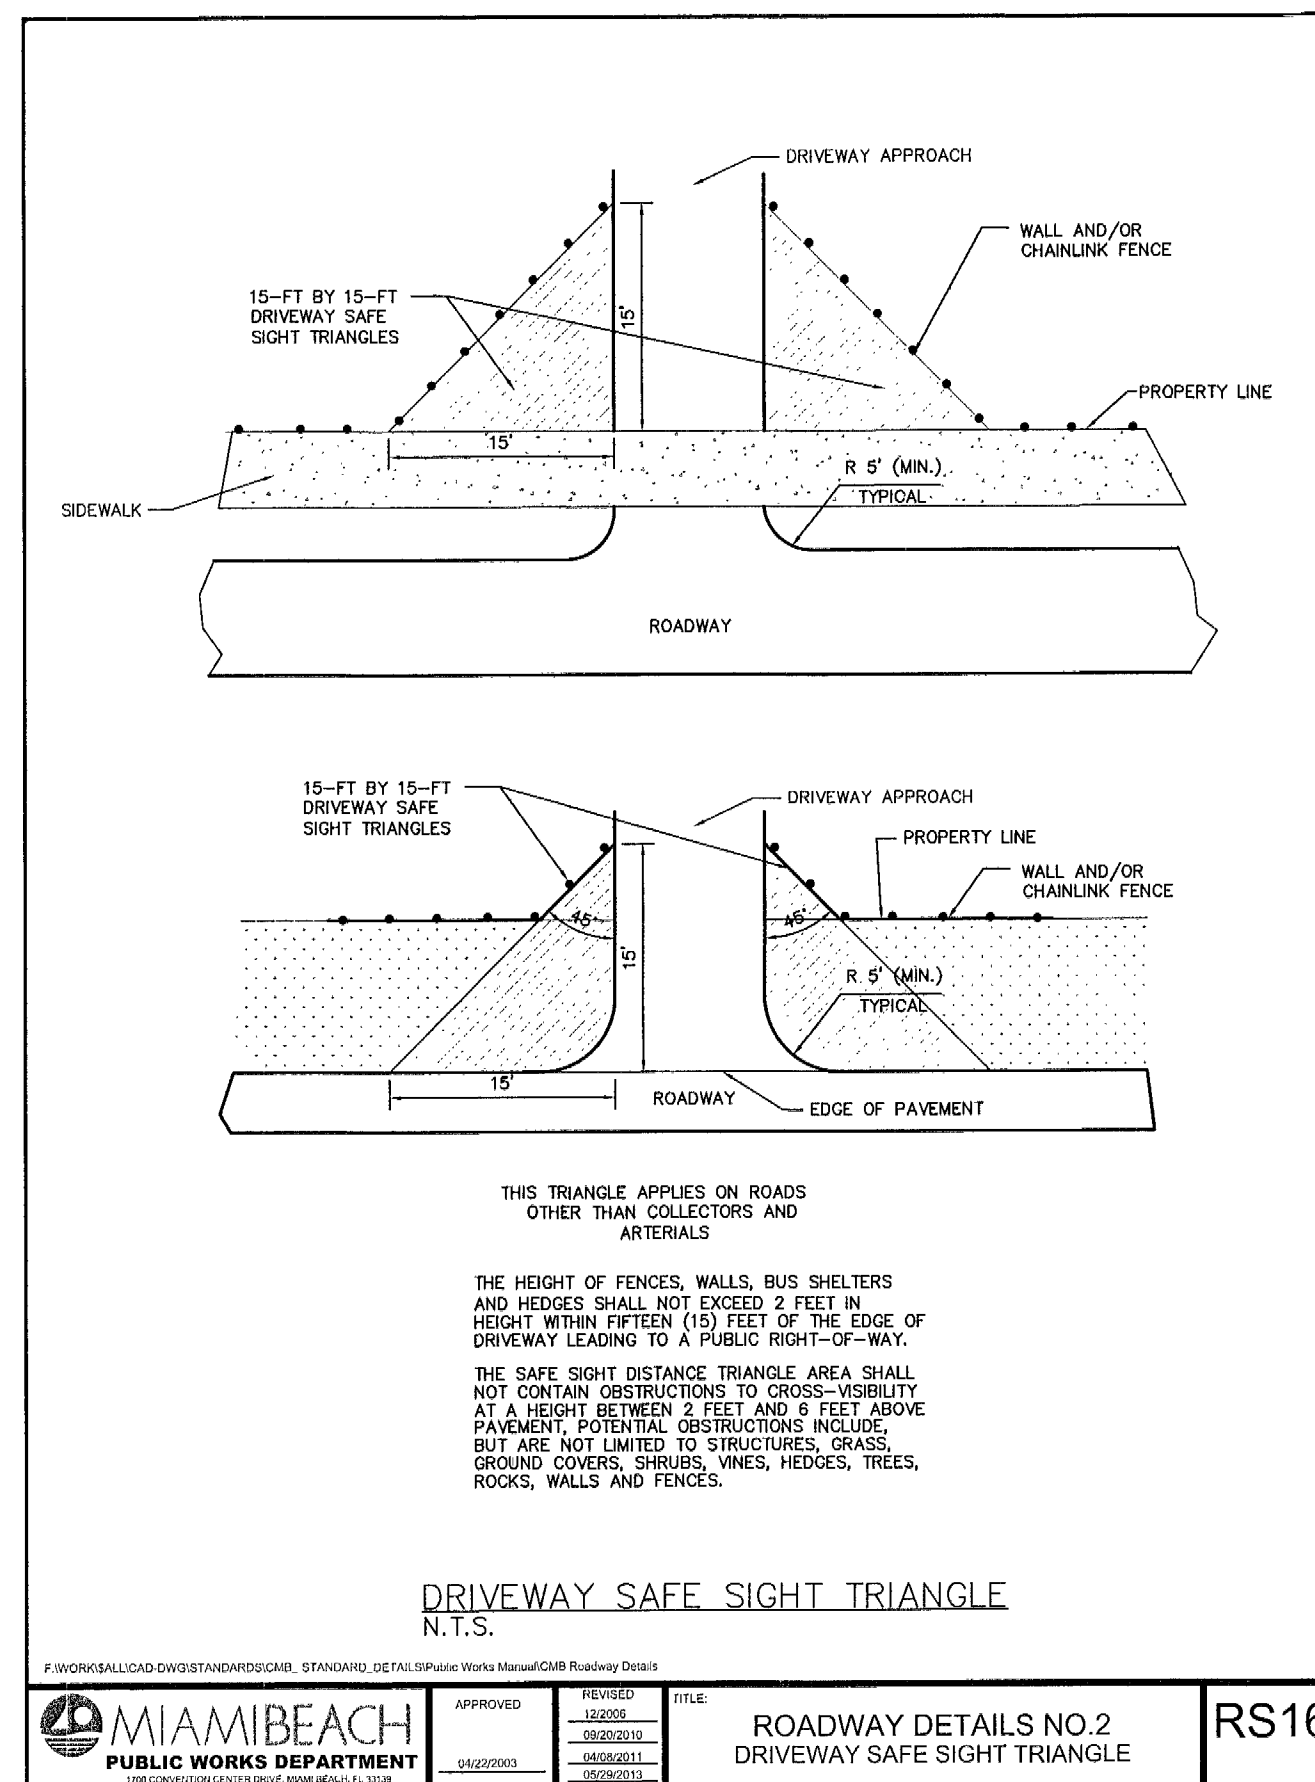

ROADWAY DETAILS NO.2 DRIVEWAY SAFE SIGHT TRIANGLE
RS16

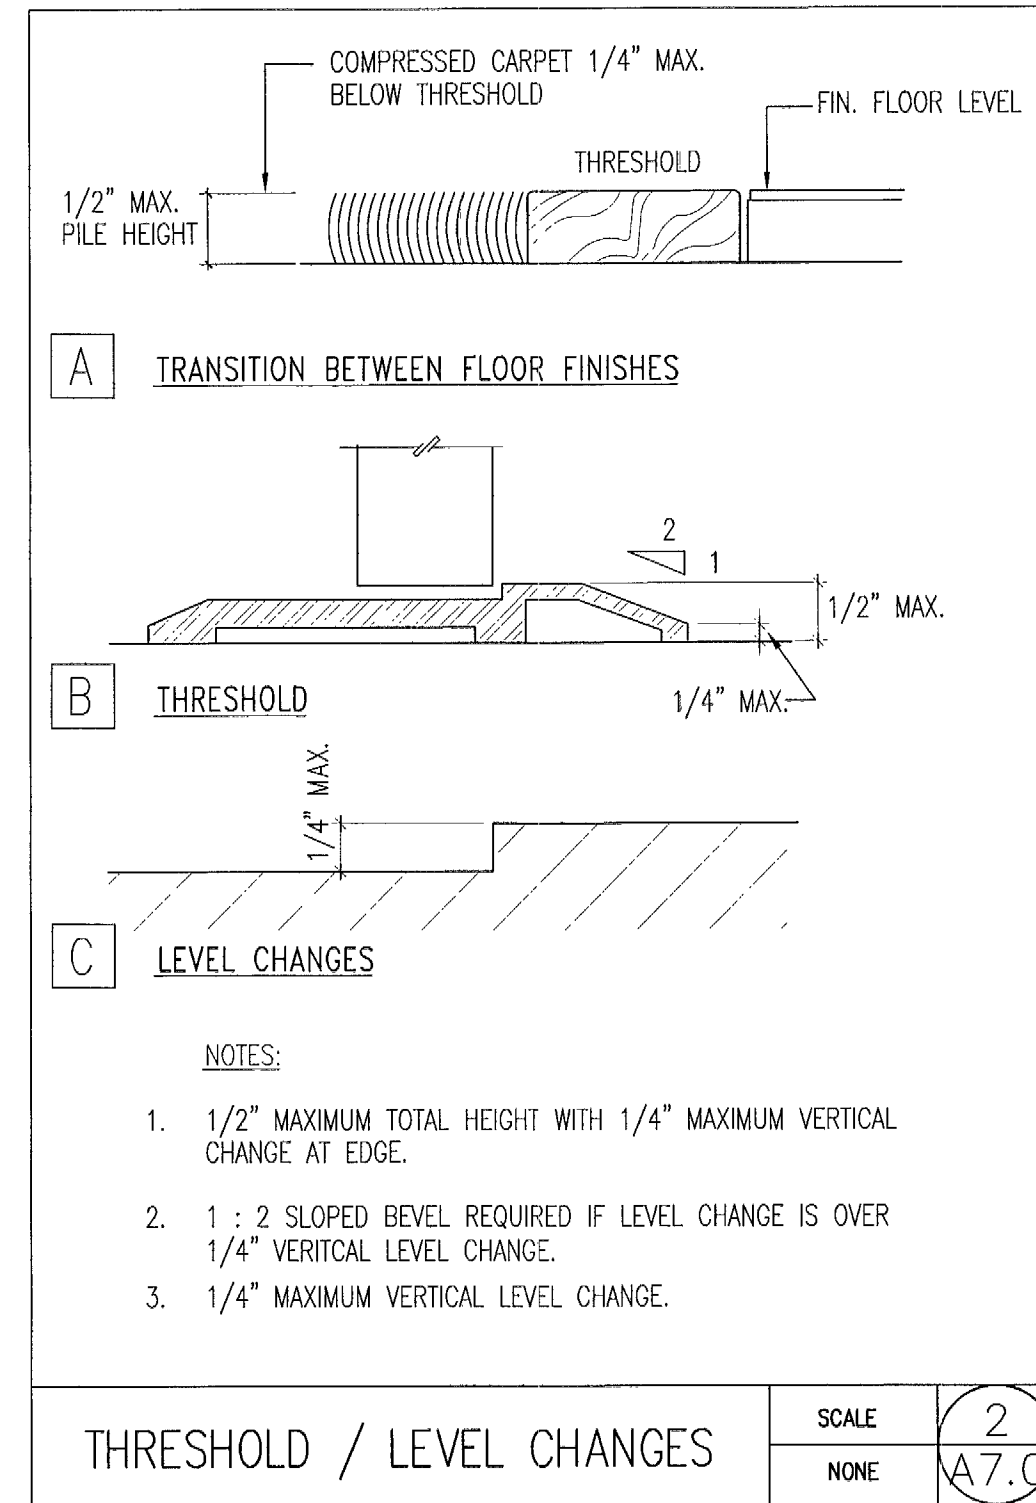

THRESHOLD / LEVEL CHANGES
SCALE: NONE
A7.0

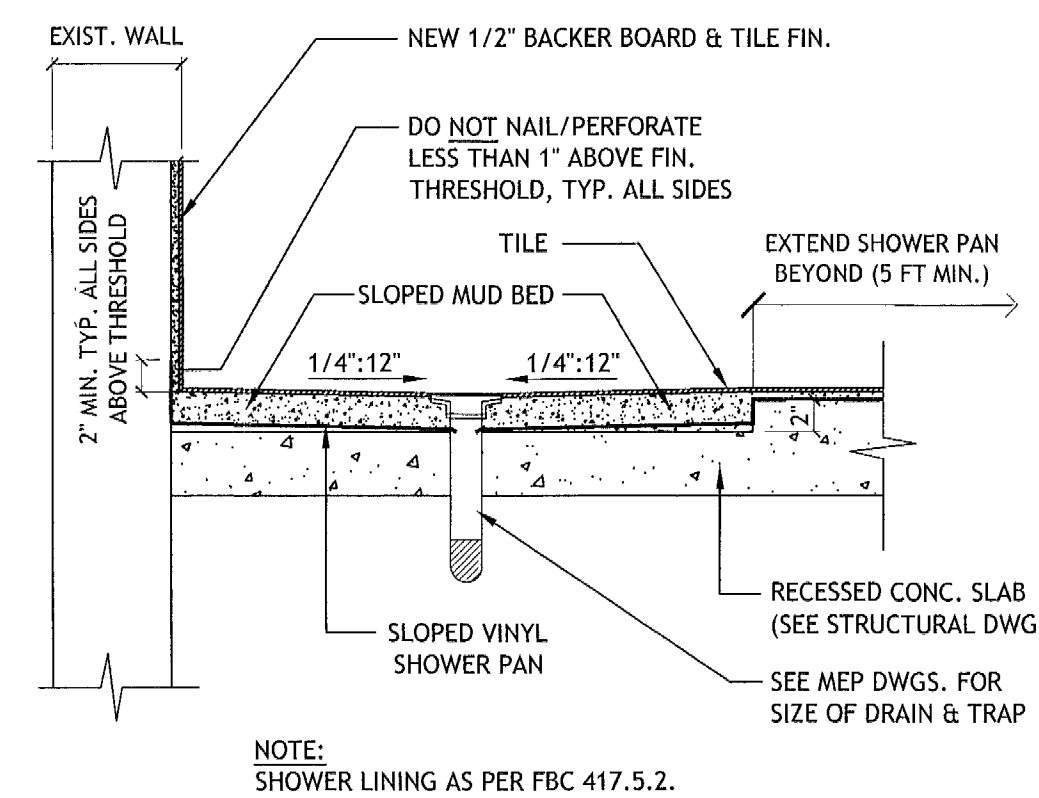

1 TYP. SHOWER PAN DETAIL
SCALE: 1" = 1'-0"

TYPICAL PARTITION NOTES:

- PROVIDE A HORIZONTAL MEMBER (20 GA MIN.) SECURELY FASTENED TO MIN. (2) 20 GA STUDS BEHIND ANY/CABINETS, WALL HUNG ACCESSORIES, & PLUMBING FIXTURES.
- REFER TO I.D. DRAWINGS FOR WALL FINISHES AND PAINT COLORS.
- COORDINATE W/ I.D. DRAWINGS FOR BASEBOARD LOCATIONS, HEIGHTS, & TYPE.
- PROVIDE PLYWOOD BACKING @ ALL BATHROOM ACCESSORIES, WALL HUNG TV, BUILT IN FURNITURE, HEAVY ARTWORK, WALL HUNG MIRRORS, ETC. G.C. TO COORDINATE W/ OWNER.
- FIRE BLOCKING SHALL BE PROVIDED IN WALLS EVERY 8'-0", AT INTERCONNECTIONS, BETWEEN STAIR STRINGERS AT OPENINGS, AT CHIMNEYS, AT FLOOR JOISTS, AND AROUND DOOR POCKETS.
- PROVIDE 5/8" GREENBOARD IN BATHROOMS AND KITCHEN.
- PROVIDE 5/8" CEMENTITIOUS BACKERBOARD IN SHOWERS & TUBS.
- PROVIDE SOUND ATTENUATION BATT INSULATION @ PARTITIONS (WHERE INDICATED).
- REFER TO OWNER AND/OR I.D. DRAWINGS FOR WALL FINISHES AND PAINT COLORS.
- SEE FLOOR PLANS FOR WALL TYPE DESIGNATIONS.
- SEE REFLECTED CEILING PLANS FOR CEILING TYPES & HEIGHTS.

FLAME SPREAD INDEX: (FBC R302.9.1, R302.10.1)

- WALL & CEILING FINISHES SHALL HAVE A FLAME SPREAD INDEX OF NOT GREATER THAN 200.
- INSULATION MATERIALS, INCLUDING FACINGS, SUCH AS VAPOR RETARDERS & VAPOR-PERMEABLE MEMBRANES INSTALLED WITHIN FLOOR-CEILING ASSEMBLIES, ROOF-CEILING ASSEMBLIES, WALL ASSEMBLIES, CRAWL SPACES & ATTICS SHALL HAVE A FLAME SPREAD INDEX NOT TO EXCEED 25.


SMOKE DEVELOPED INDEX: (FBC R302.9.2, R302.10.1)

- WALL & CEILING FINISHES SHALL HAVE A SMOKE DEVELOPED INDEX OF NOT GREATER THAN 450.
- INSULATION MATERIALS INCLUDING FACINGS, SUCH AS VAPOR RETARDERS & VAPOR-PERMEABLE MEMBRANES INSTALLED WITHIN FLOOR-CEILING ASSEMBLIES, ROOF-CEILING ASSEMBLIES, WALL ASSEMBLIES, CRAWL SPACES & ATTICS SHALL HAVE A SMOKE-DEVELOPED INDEX NOT TO EXCEED 450 WHEN TESTED IN ACCORDANCE WITH ASTM E84 OR UL 723.

R-VALUE CHART

Table R402.1.1, FBC Energy conservation

CLIMATE ZONE: 1		
COMPONENT	R-VALUE REQD. (MIN.)	R-VALUE PROVIDED
CEILING	R-30	R-30
EXTERIOR WALL	R-4	R-4.2

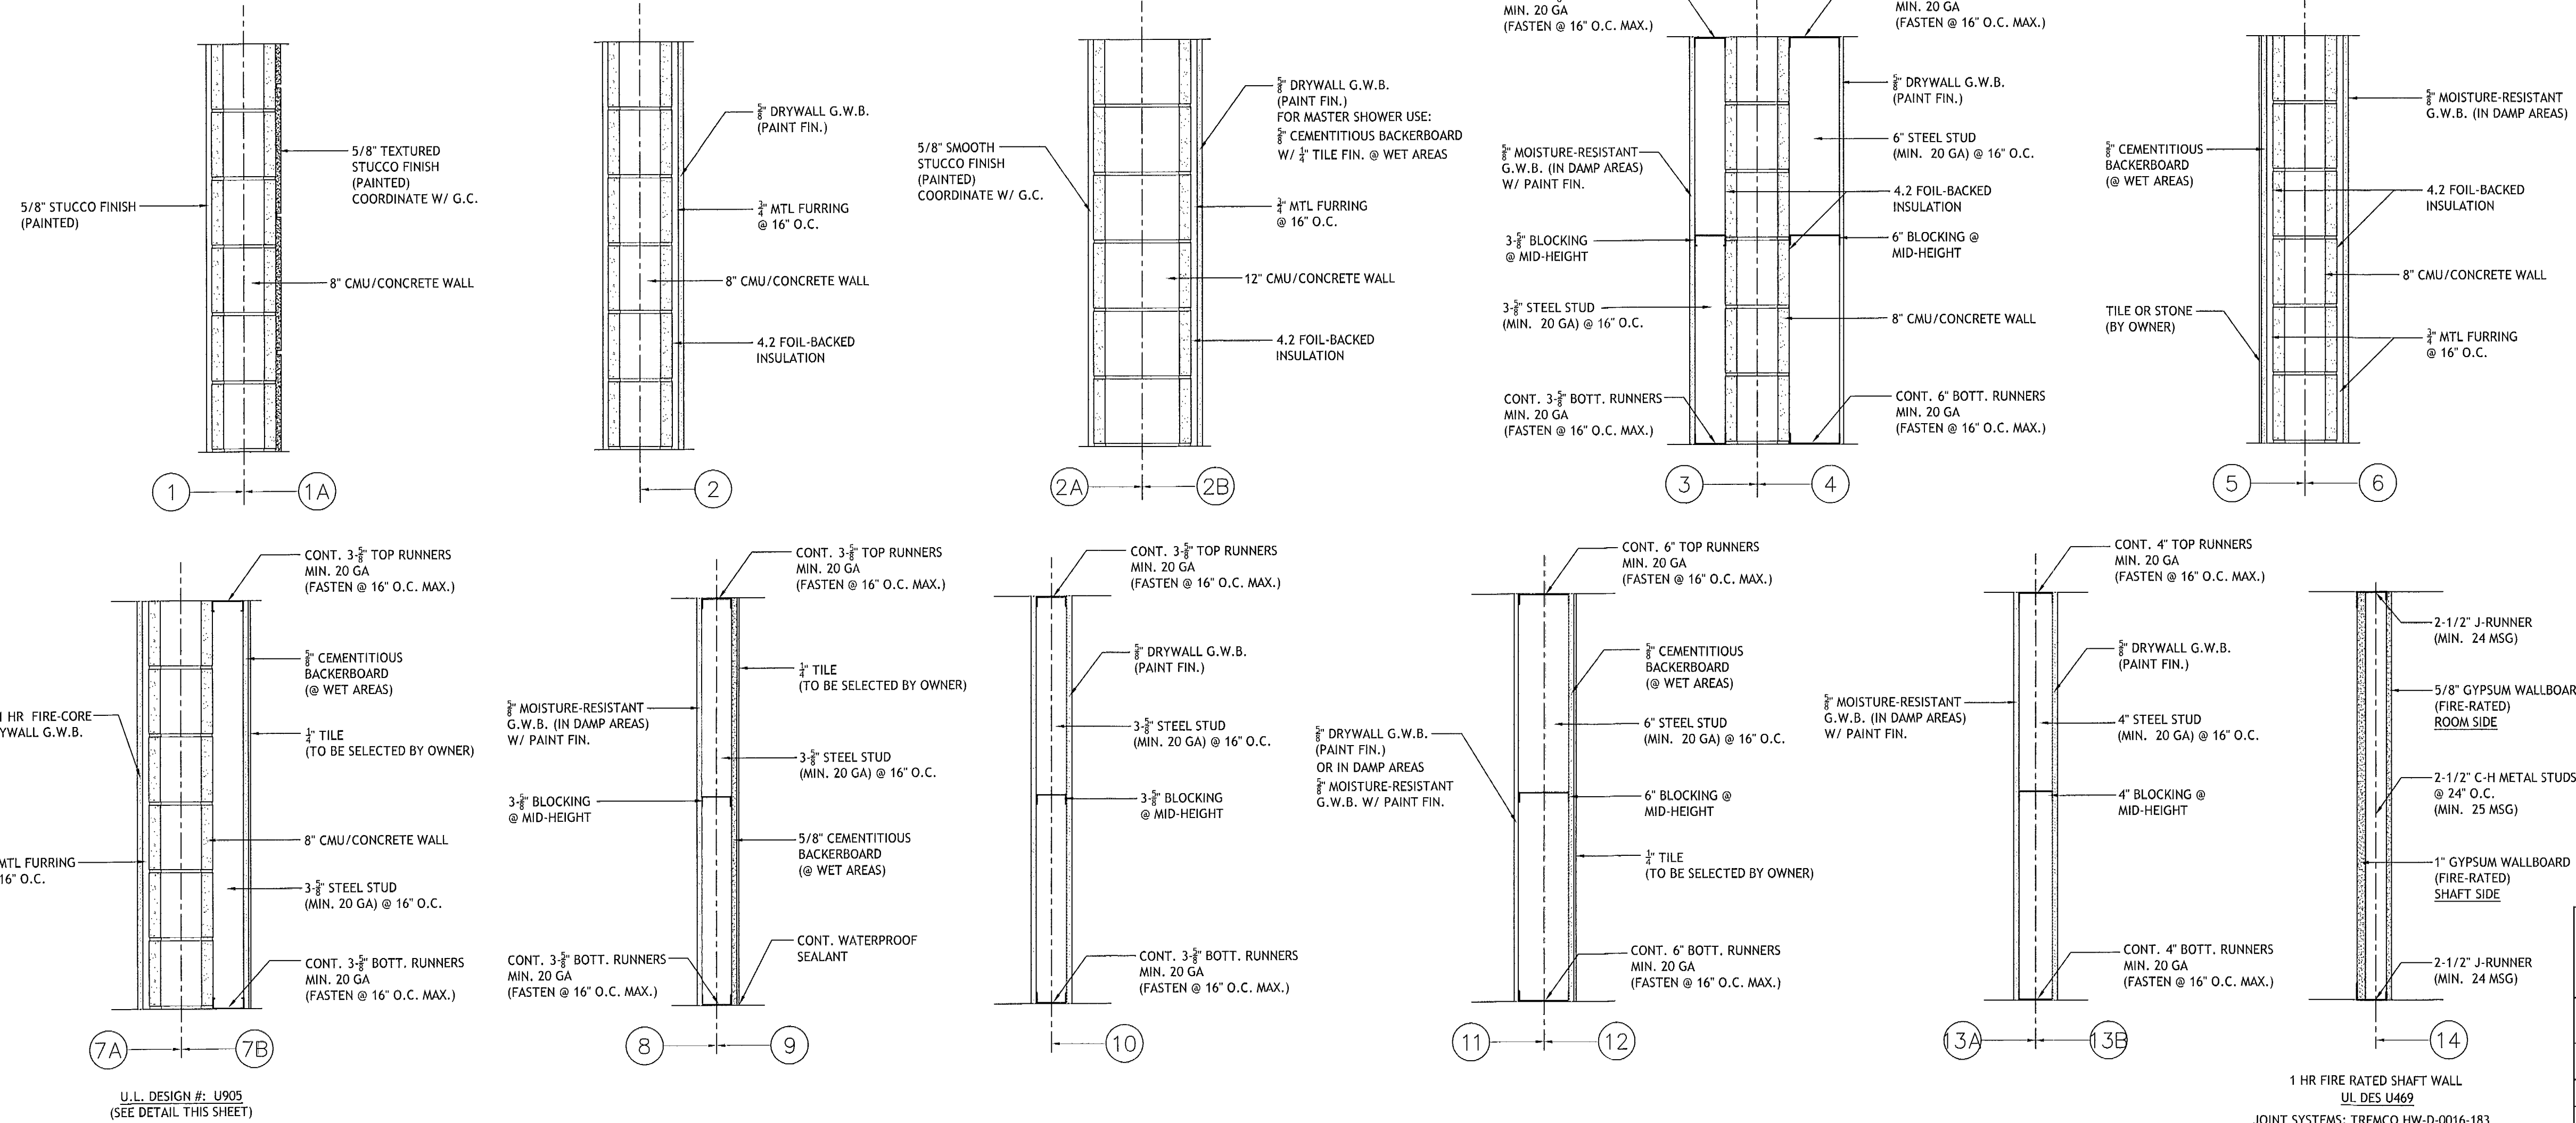


WALL TYPES
SCALE: 1" = 1'-0"

DRAWN BY:
REVISIONS:
11-01-15
0-14-15


AA0003569
ANTHONY LEON
0016752
DESIGN ARCHITECTURE
4300 Biscayne Blvd. #G-04, Miami, FL 33137
P: 305.438.9377 | F: 305.438.9379

NEW RESIDENCE AT:
4354 ALTON ROAD
MIAMI BEACH, FL 33139
NOV 20 2015
SEAL


THESE PLANS ARE FOR BUILDING DEPARTMENT REVIEW ONLY. THEY ARE NOT TO BE CONSIDERED AS CONSTRUCTION DOCUMENTS UNTIL ALL BUILDING DEPARTMENT APPROVALS ARE OBTAINED.
A.7.0
WALL TYPES & DETAILS

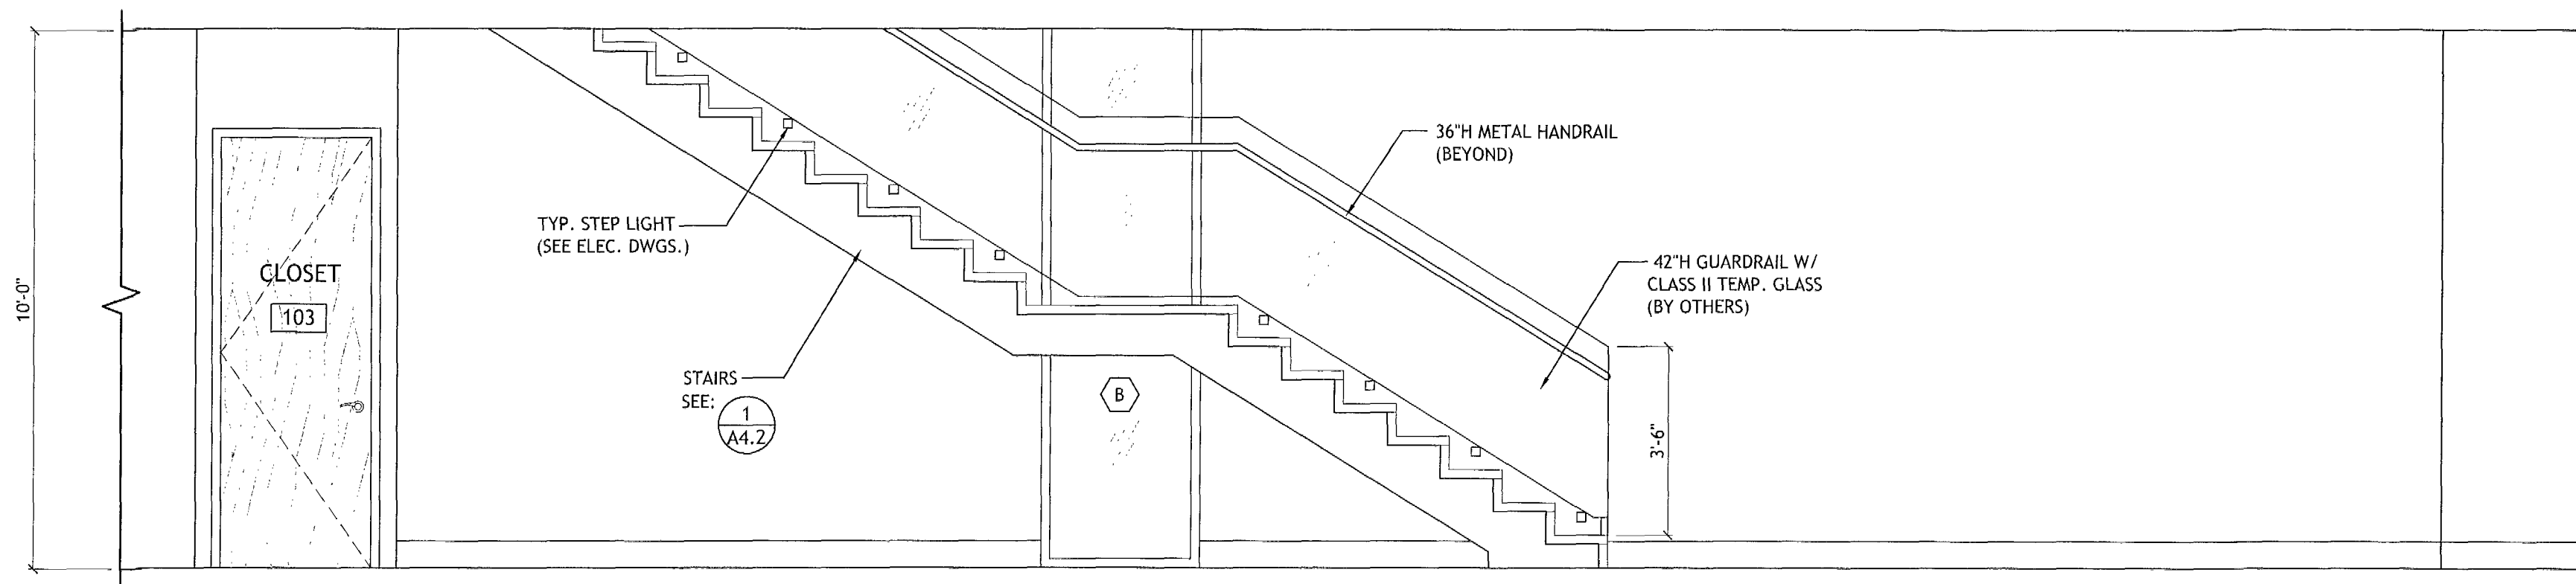


B
A8.0 INTERIOR ELEV. - HALLWAY
SCALE: 3/8" = 1'-0"

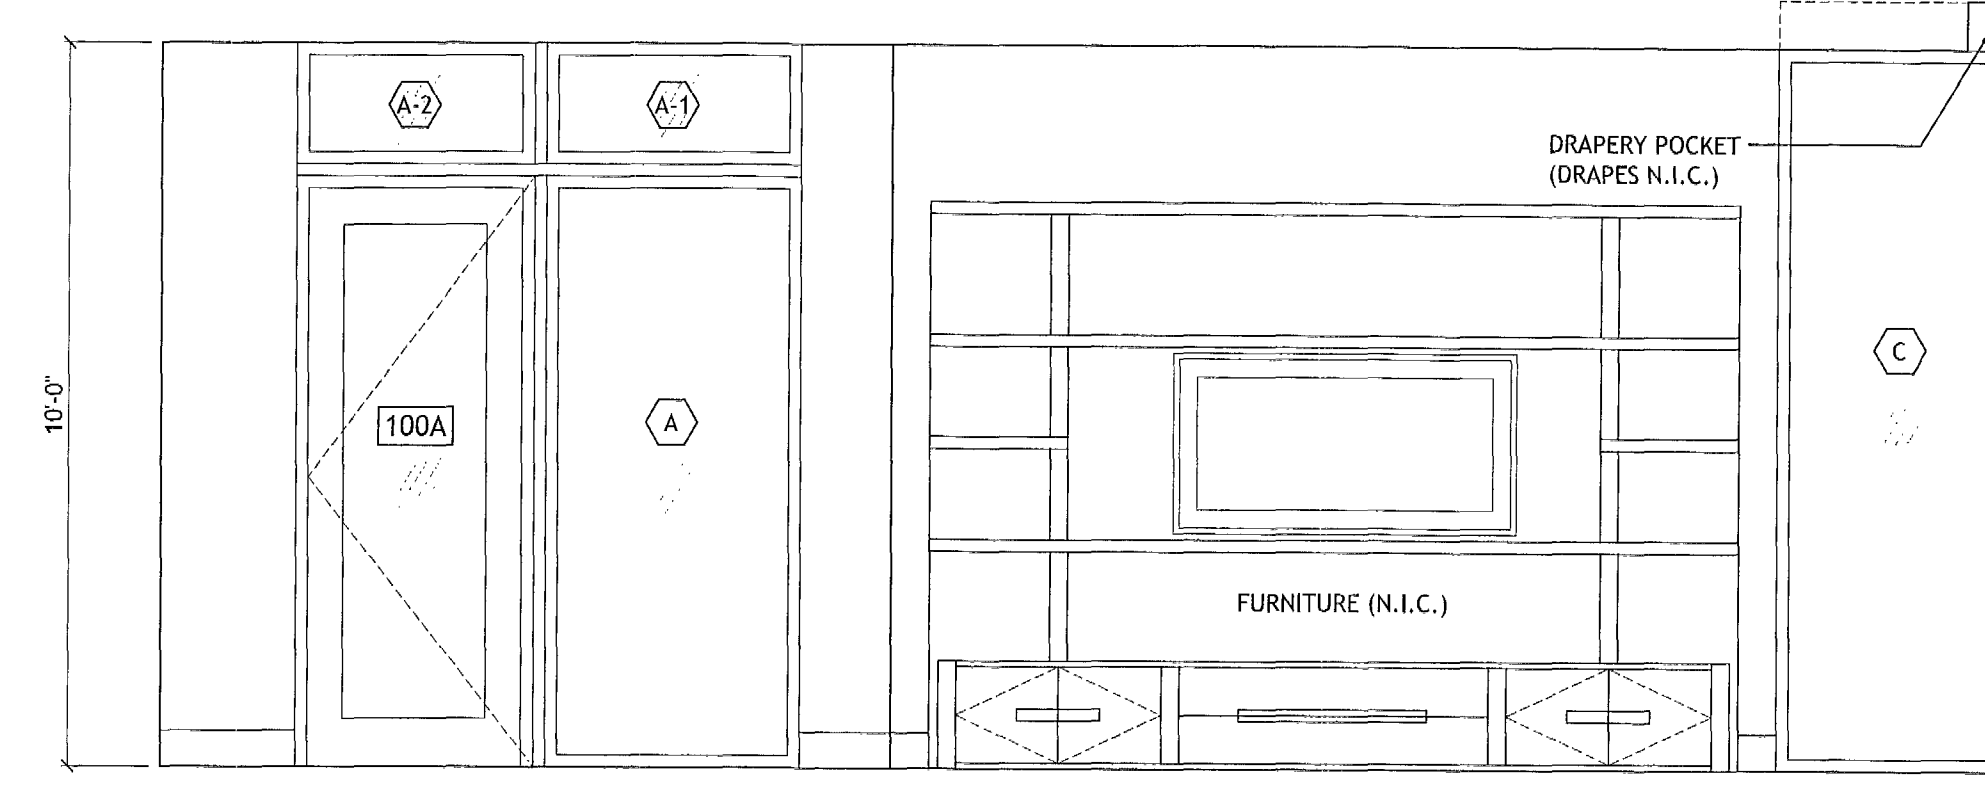


A
A8.0 INTERIOR ELEV. - LIVING AREA
SCALE: 3/8" = 1'-0"

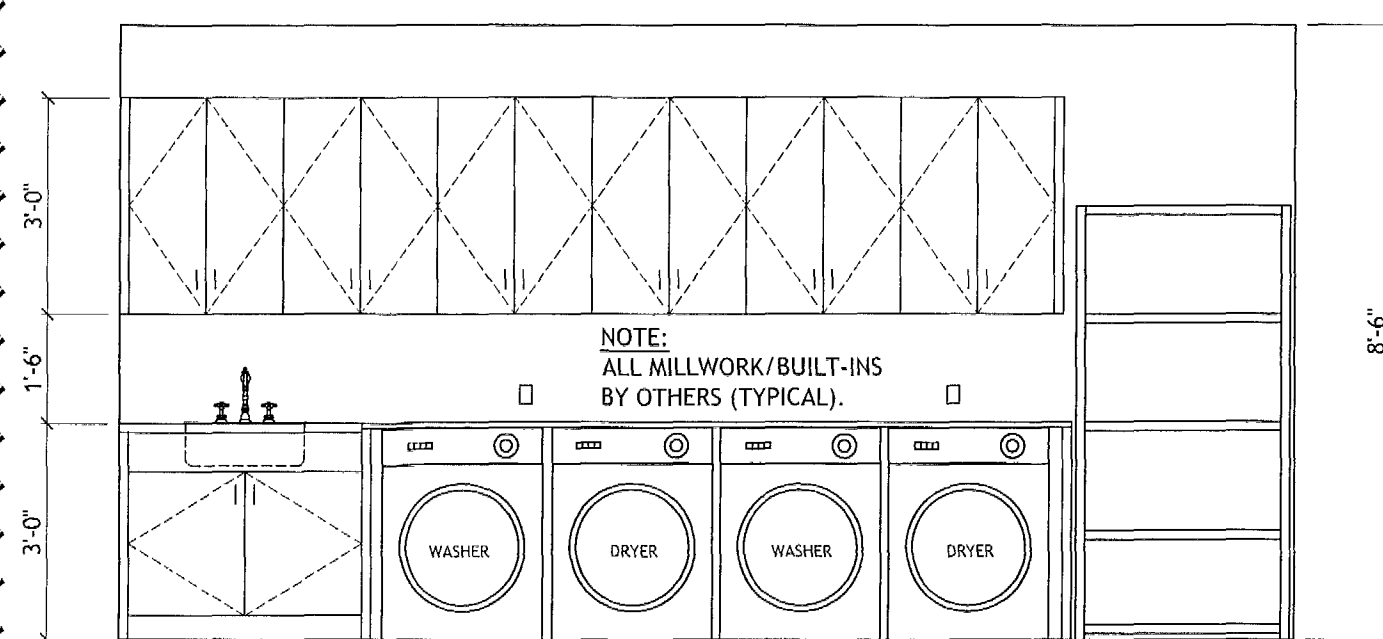


G
A8.0 INTERIOR ELEV. - LAUNDRY
SCALE: 3/8" = 1'-0"

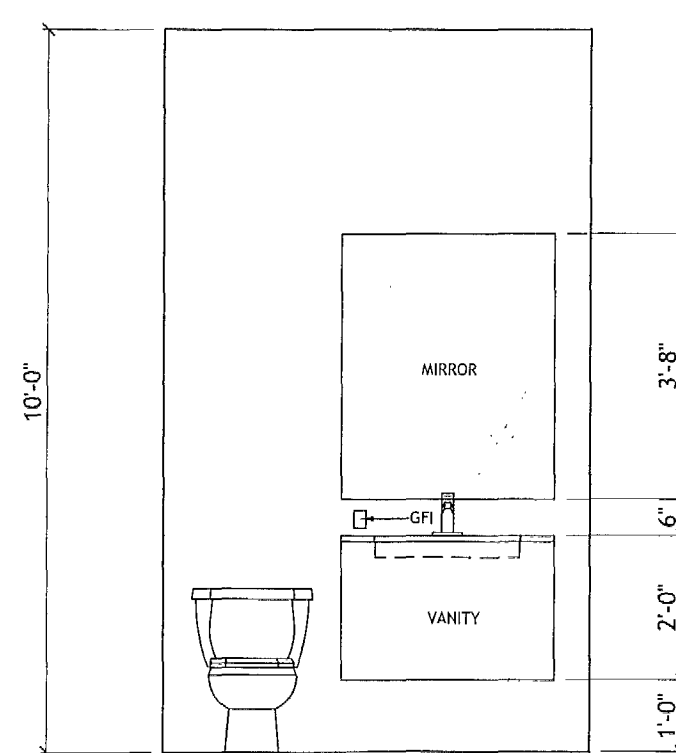


F
A8.0 INT. ELEV. - POWDER ROOM
SCALE: 3/8" = 1'-0"

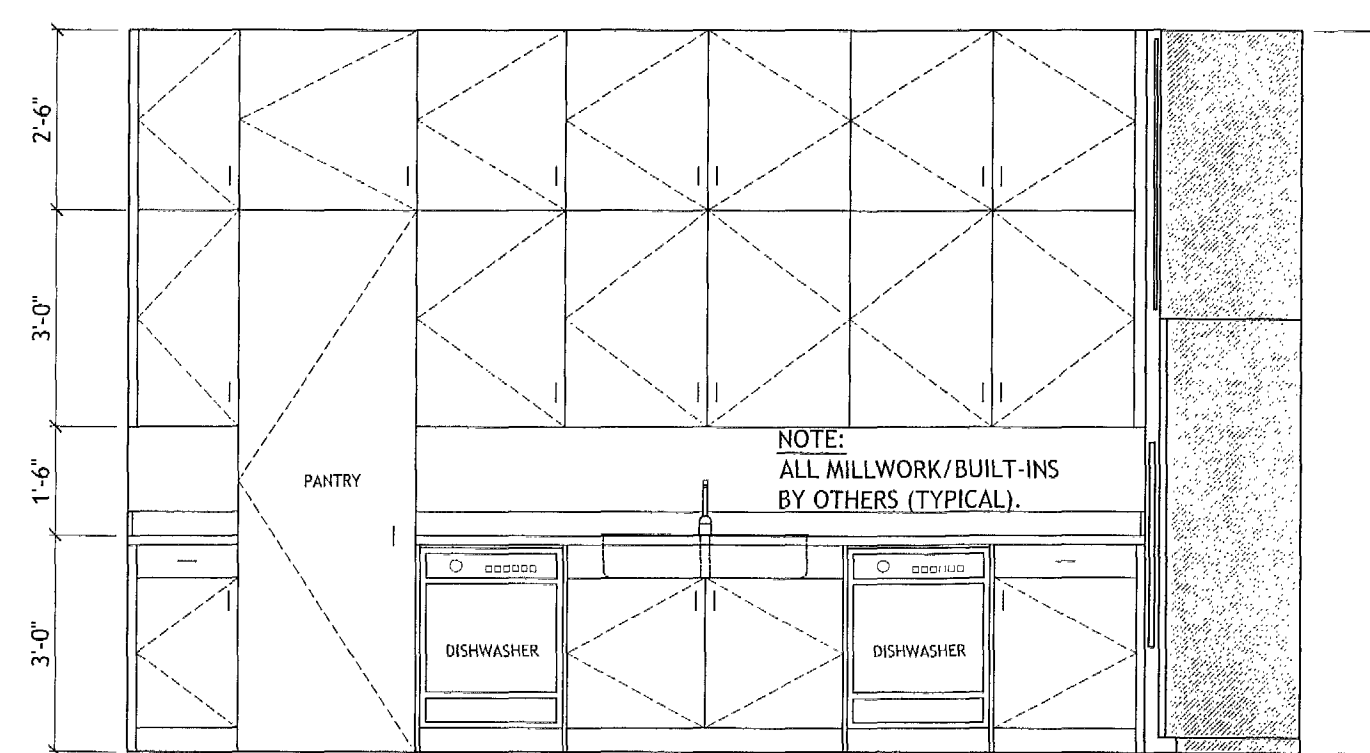


E
A8.0 INTERIOR ELEV. - KITCHEN
SCALE: 3/8" = 1'-0"

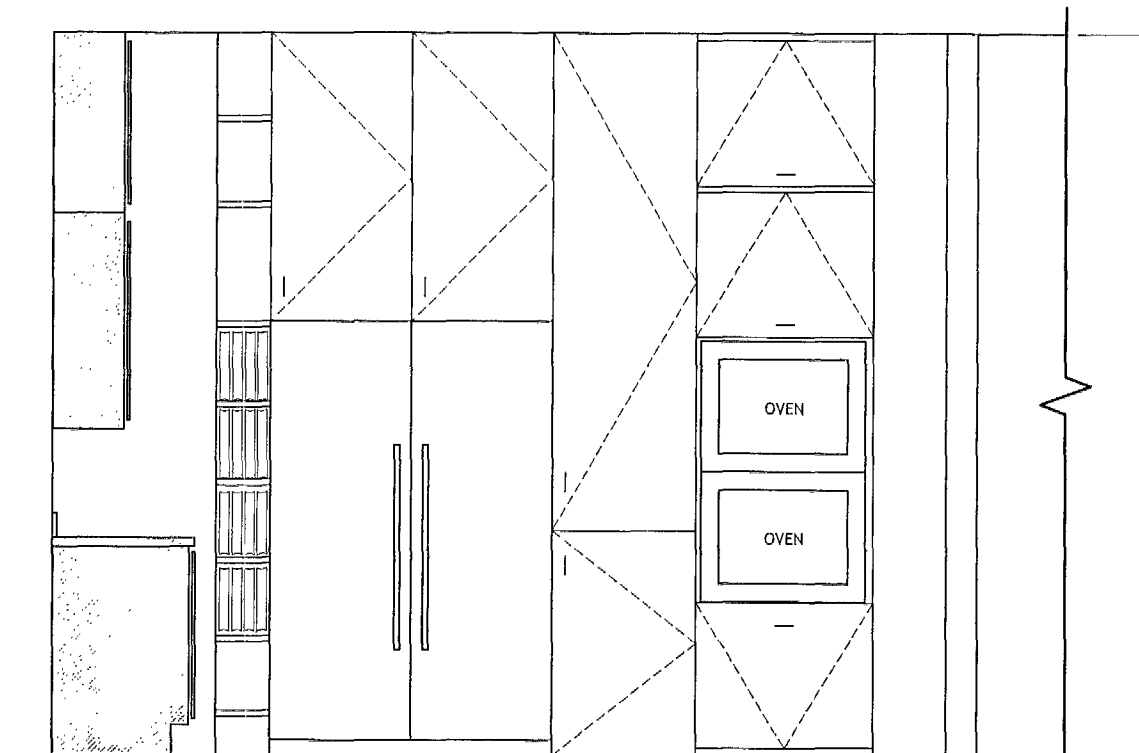


D
A8.0 INTERIOR ELEV. - KITCHEN
SCALE: 3/8" = 1'-0"

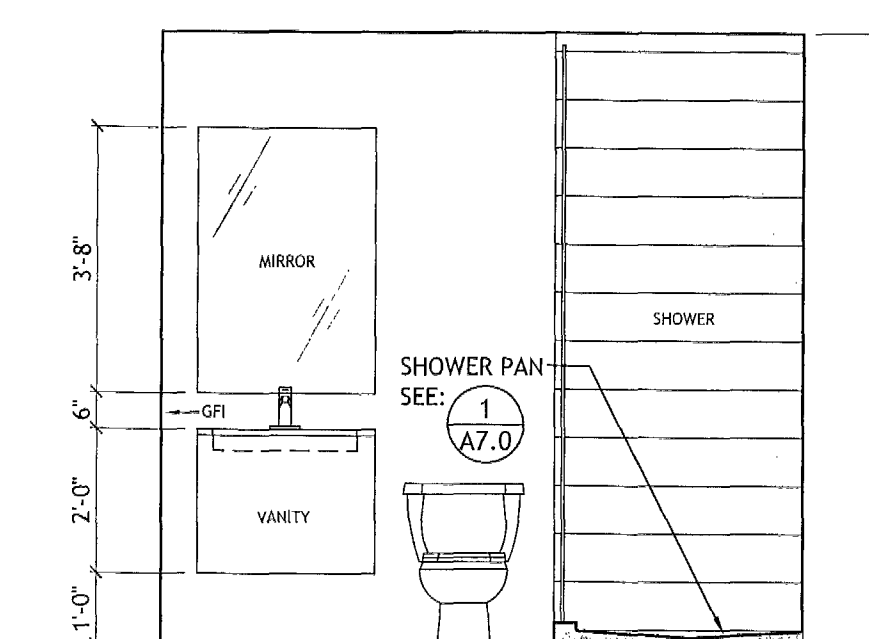


C
A8.0 INTERIOR ELEV. - GUEST BATH
SCALE: 3/8" = 1'-0"

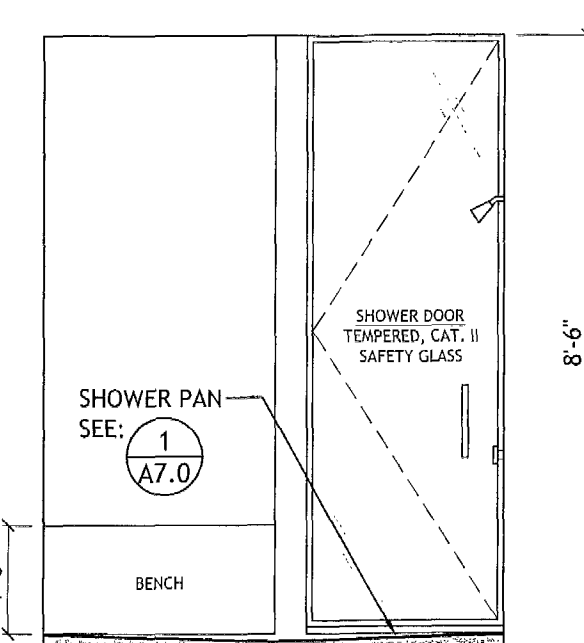


K
A8.0 INT. ELEV. - SHOWER
SCALE: 3/8" = 1'-0"

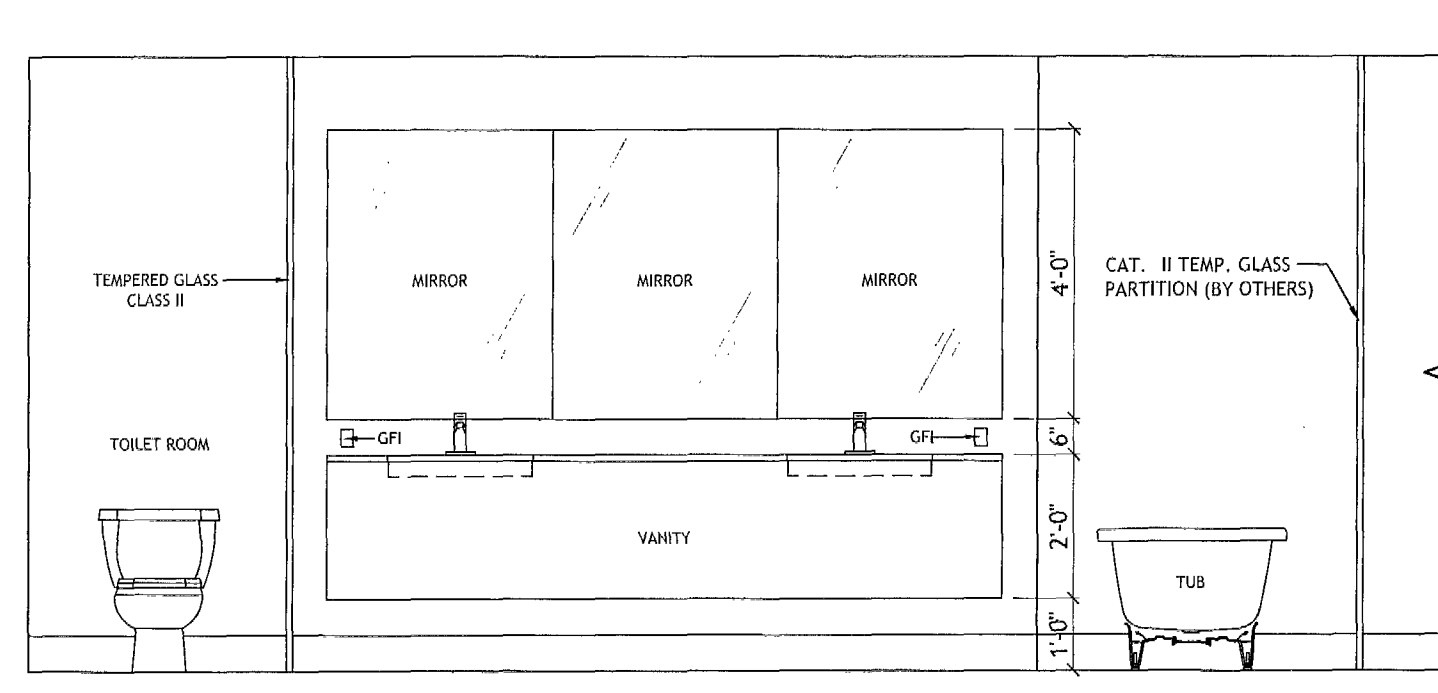

J
A8.0 INTERIOR ELEV. - MASTER BATHROOM
SCALE: 3/8" = 1'-0"

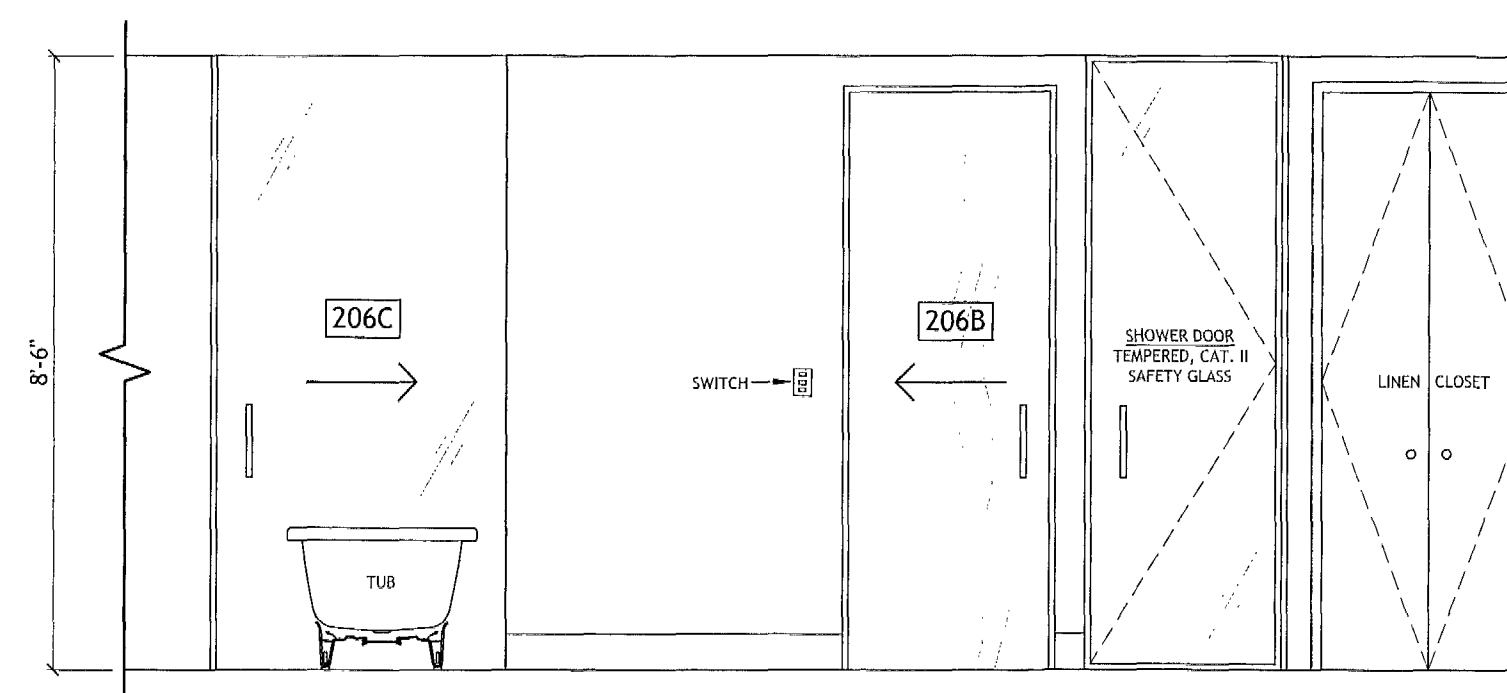

I
A8.0 INTERIOR ELEV. - MASTER BATHROOM
SCALE: 3/8" = 1'-0"

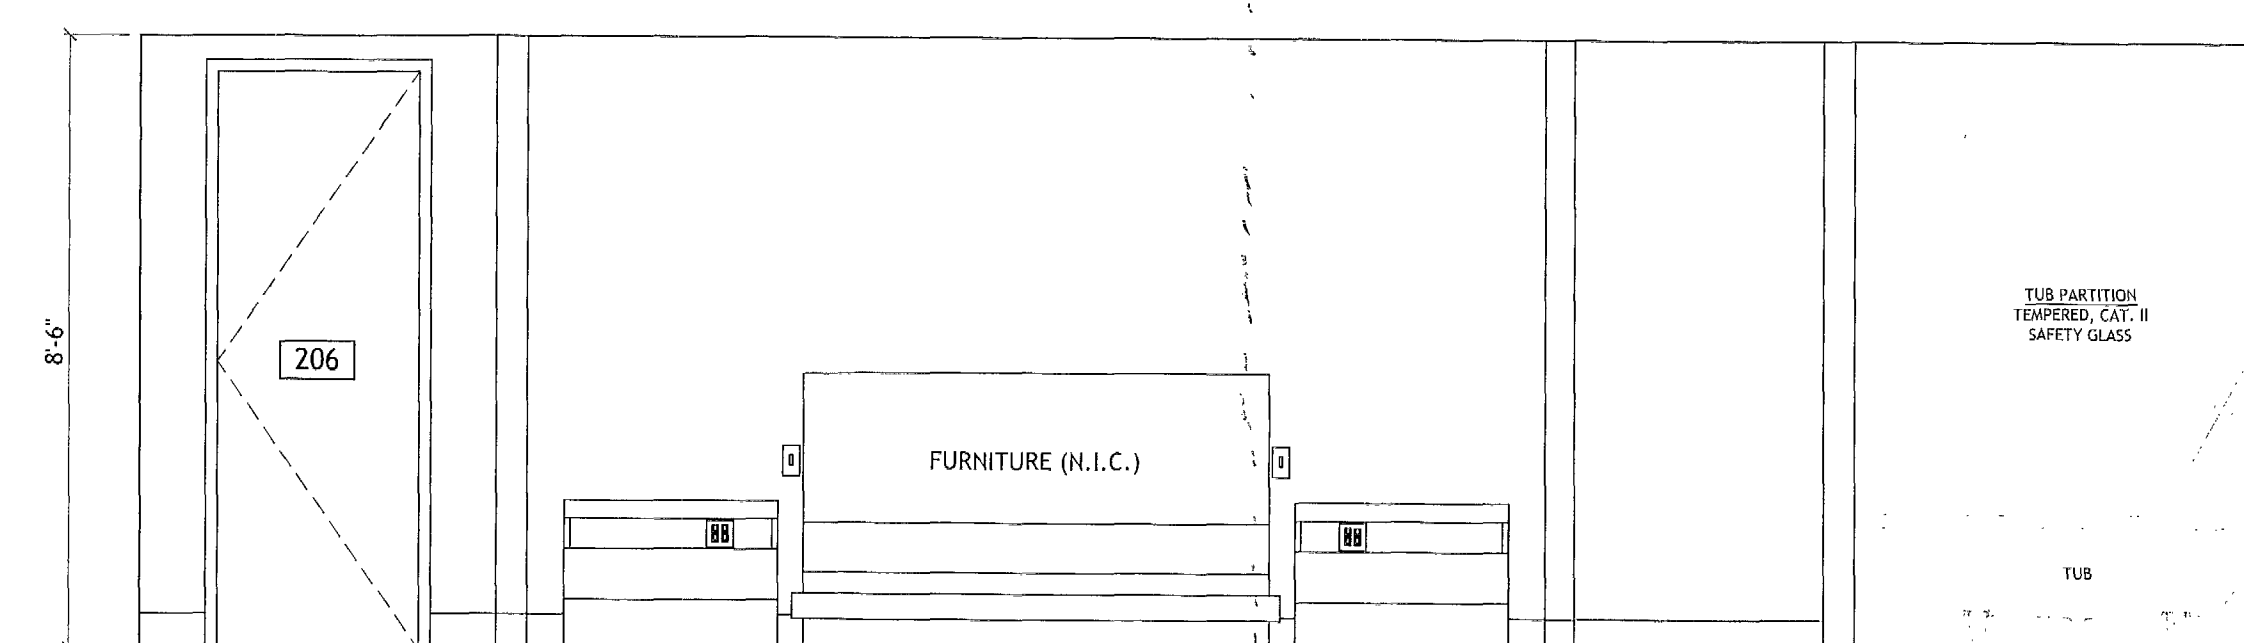

H
A8.0 INTERIOR ELEV. - MASTER BEDROOM
SCALE: 3/8" = 1'-0"

DRAWN BY:
REVISIONS:
1 8-14-15

AA0003669
ANTHONY LEON
0016752

3 DESIGN
ARCHITECTURE
4300 Biscayne Blvd. #G-04, Miami, FL 33137
P: 305.438.9377 | F: 305.438.9379

Anthony Leon
AUG 24 2015
SEAL

NEW RESIDENCE
AT:
4354 ALTON ROAD
MIAMI BEACH, FL 33139

THESE PLANS ARE FOR BUILDING
DEPARTMENT REVIEW ONLY. THEY ARE NOT
TO BE CONSTRUED AS CONSTRUCTION
DOCUMENTS UNTIL ALL BUILDING
DEPARTMENT APPROVALS ARE OBTAINED.

A.8.0
INTERIOR
ELEVATIONS

REVISIONS:	
1-3-2015	BLOG DEPT. COMMENTS
2-3-2015	BLOG DEPT. COMMENTS

AAD003569
ANTHONY LEON
0016732

3 DESIGN
ARCHITECTURE
4300 Biscayne Blvd., 4G-04, Miami, FL 33137
P: 305.438.9377 | F: 305.438.9379


NEW RESIDENCE
FOR:
4354 ALTON RD.
MIAMI BEACH, FL 33139
JUAN FERNANDEZ-BARQUIN, P.E.
40114

DATE: 10-20-2014

JUAN FERNANDEZ-BARQUIN, P.E.
STRUCTURAL ENGINEER P.E. # 40114
THRESHOLD INSPECTOR # 0947
2520 N.W. 87th AVENUE, SUITE #240
DORAL, FLORIDA 33172
PHONE: 786-336-0881, FAX: 786-336-0884
E-MAIL: jfbeng@belsouth.net
www.juanfernandezbarquinpe.com

THESE PLANS ARE FOR BUILDING DEPARTMENT REVIEW ONLY. THEY ARE NOT TO BE CONSTRUED AS CONSTRUCTION DOCUMENTS UNTIL ALL BUILDING DEPARTMENT APPROVALS ARE OBTAINED.

S-1
FOUNDATION
FRAMING PLAN

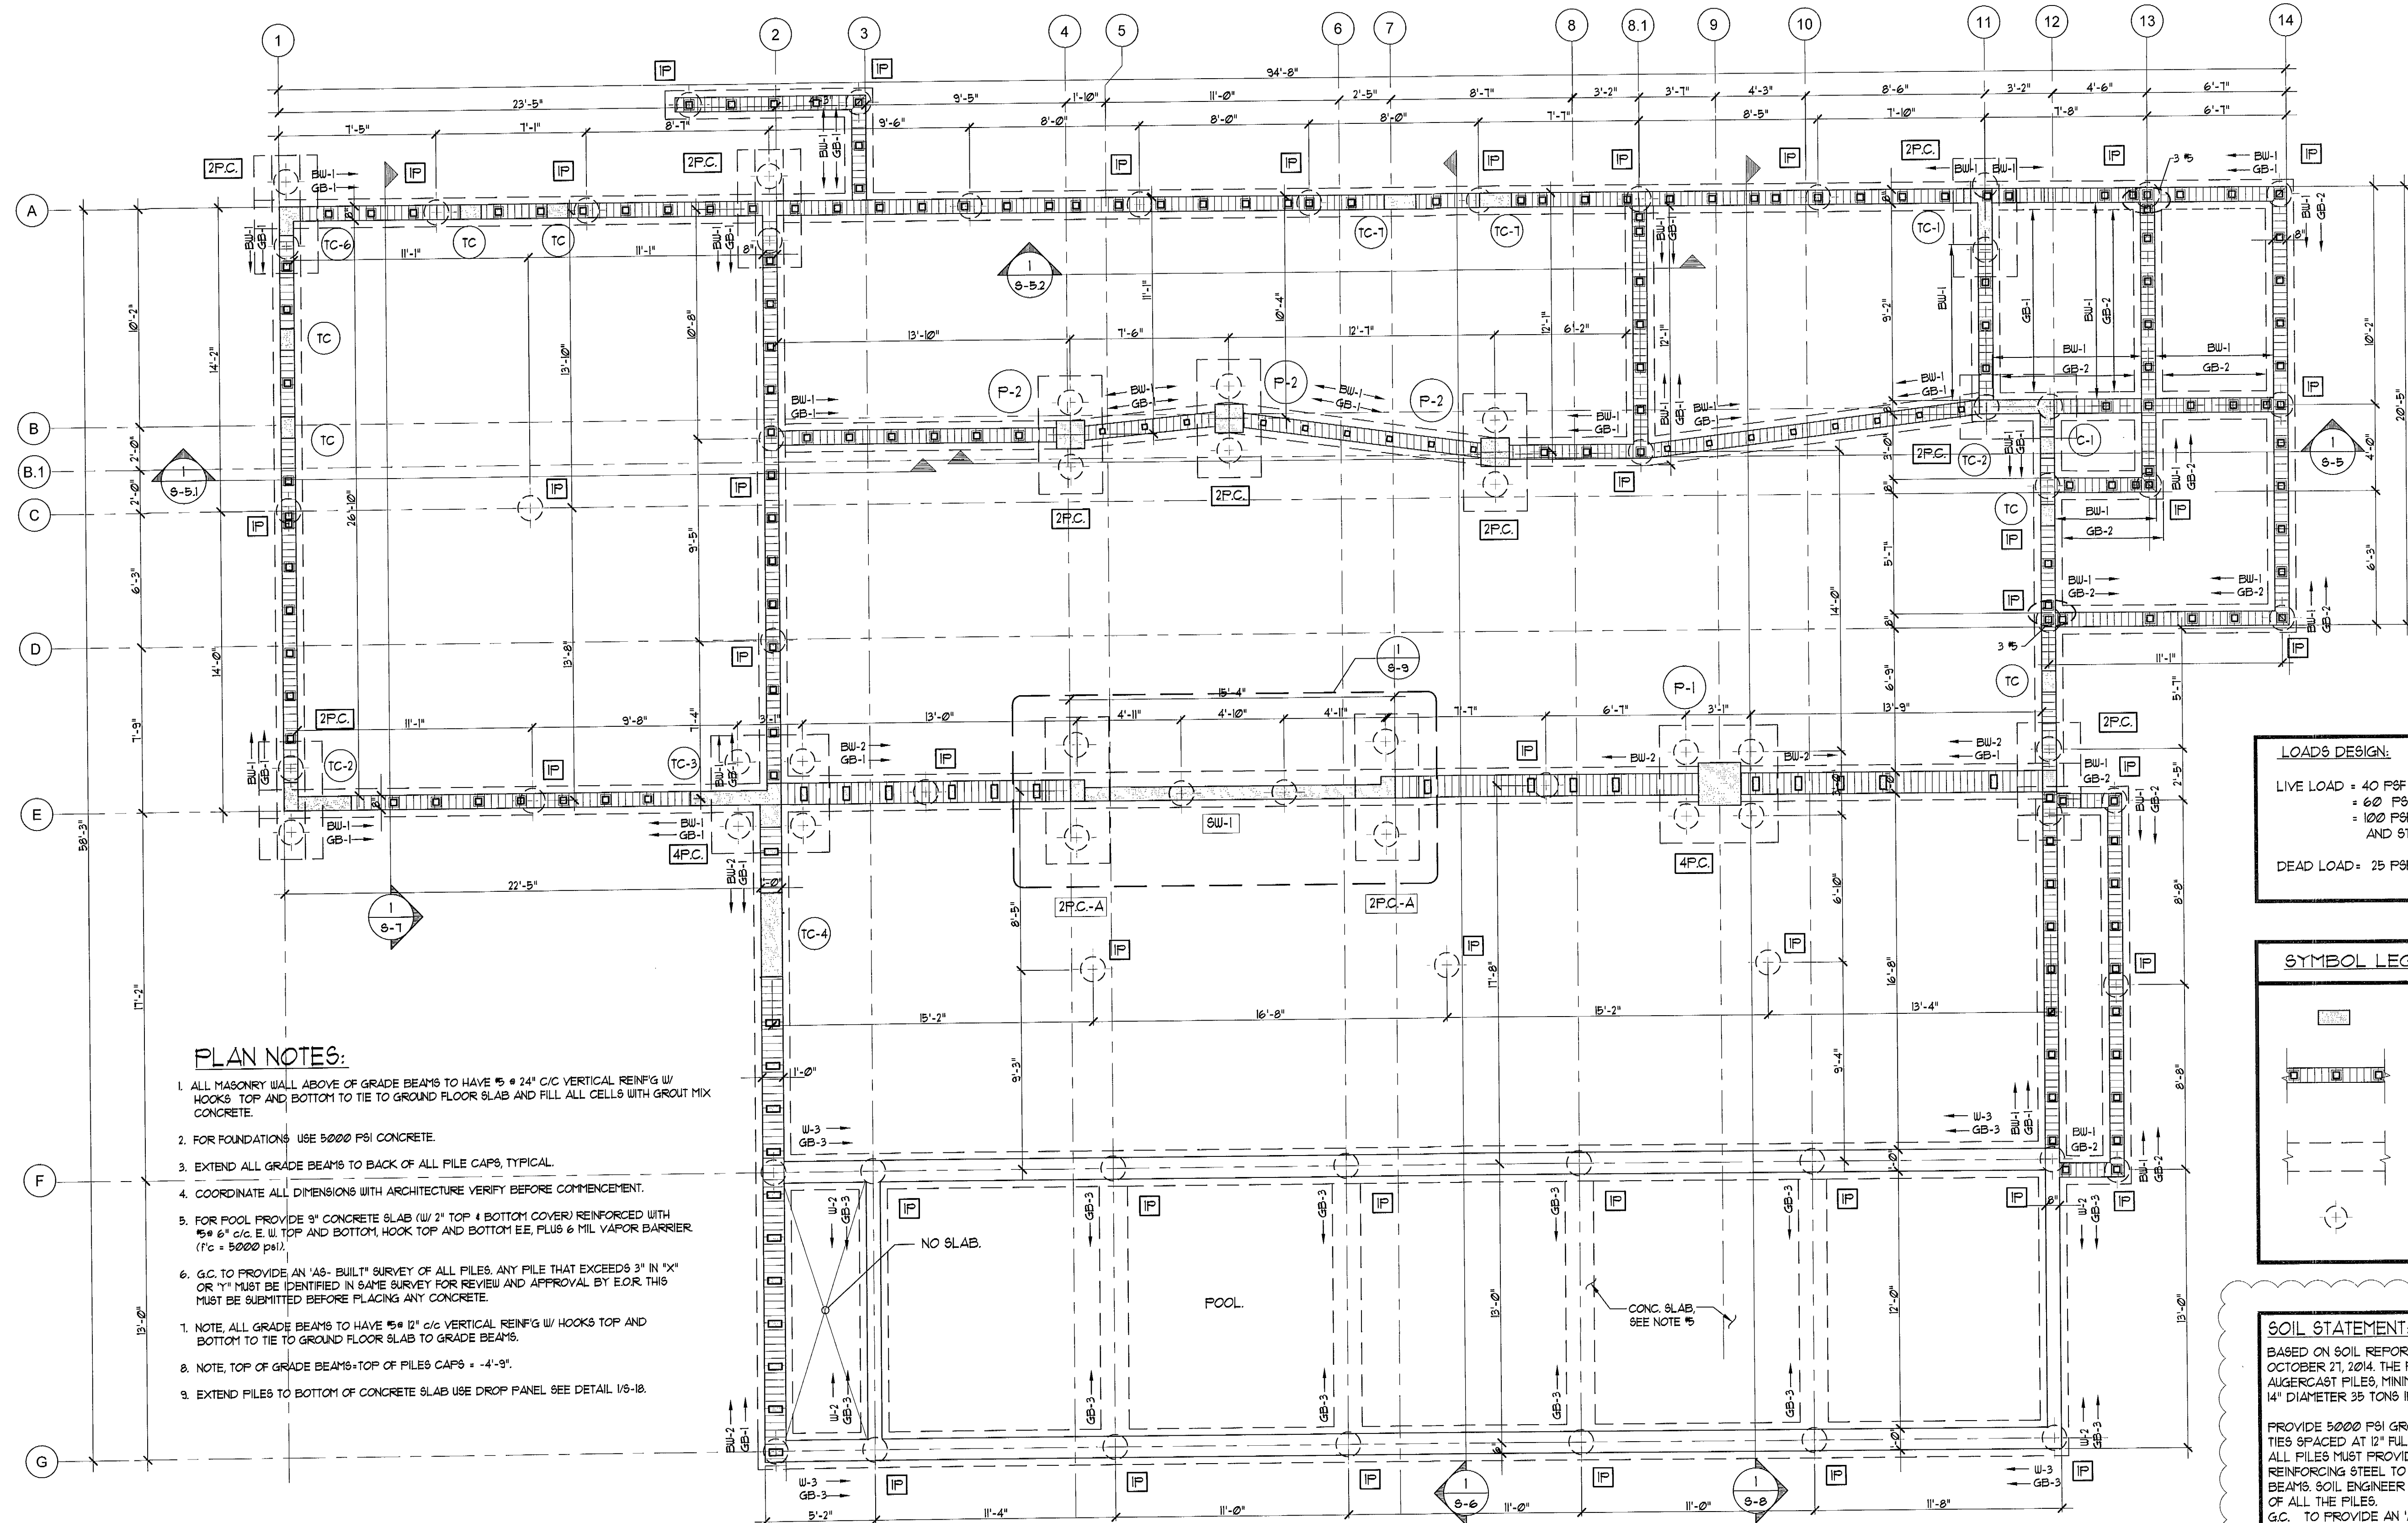

FOUNDATION FRAMING PLAN

SCALE: 1/4"=1'-0"

LOADS DESIGN:

LIVE LOAD = 40 PSF (RESIDENCE)
= 60 PSF (BALCONY)
= 100 PSF (TERRACE AND STAIRS)

DEAD LOAD = 25 PSF


SYMBOL LEGEND:

	CONCRETE COLUMN
	CMU WALL
	GRADE BEAM
	AUGERCAST PILE

SOIL STATEMENT:

BASED ON SOIL REPORT BY DYNATECH ENGINEERS CORP DATED OCTOBER 27, 2014. THE FOUNDATIONS HAVE BEEN DESIGNED WITH AUGERCAST PILES, MINIMUM PILE LENGTH 32'-0". 14" DIAMETER 25 TONS IN COMPRESSION, AND 15 TONS IN TENSION.

PROVIDE 5000 PSI GROUT WITH 6" x 1" FULL LENGTH REINFORCING #3 TIES SPACED AT 12" FULL LENGTH OF PILES. ALL PILES MUST PROVIDE A MINIMUM 18" LENGTH OF EXPOSED PILE REINFORCING STEEL TO BE EMBEDDED IN THE PILE CAPS OR GRADE BEAMS. SOIL ENGINEER TO WITNESS AND CERTIFY THE INSTALLATION OF ALL THE PILES. G.C. TO PROVIDE AN 'AS-BUILT' SURVEY OF ALL PILES. ANY PILE THAT EXCEEDS 3" IN 'X' OR 'Y' MUST BE IDENTIFIED IN SAME SURVEY FOR RELIEF BY E.O.R. THIS MUST BE SUBMITTED BEFORE PLACING ANY CONCRETE.

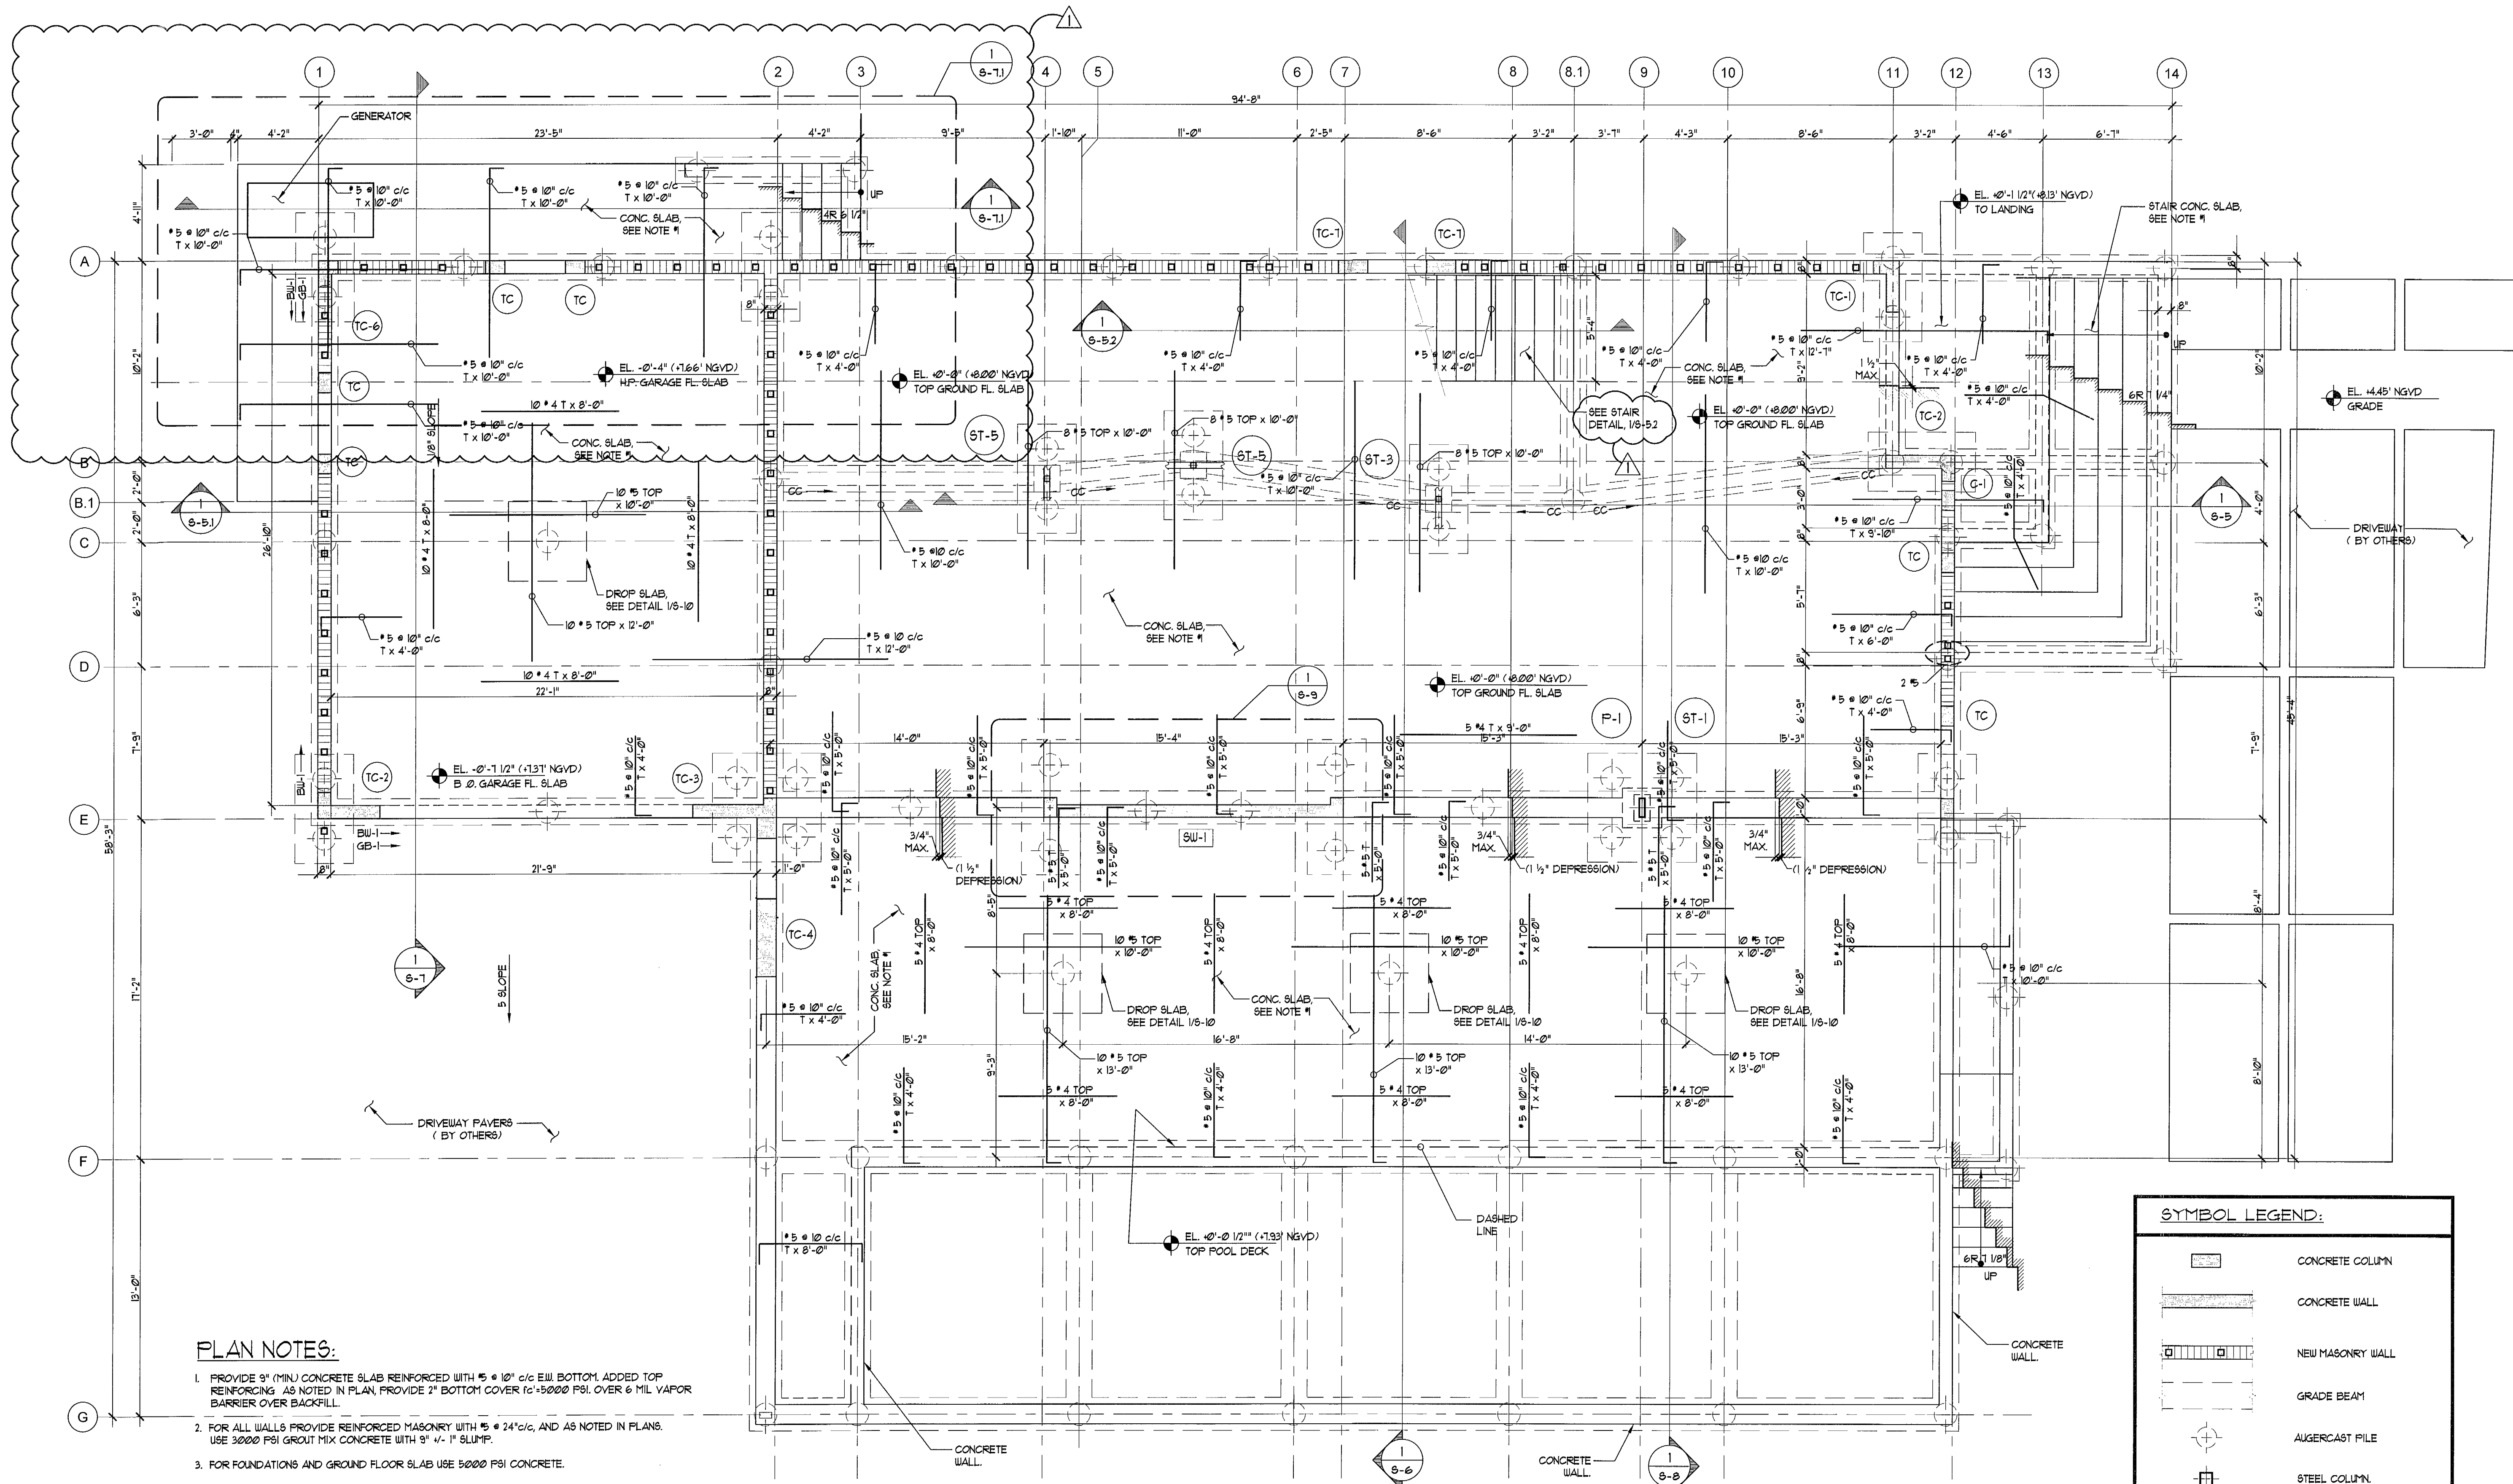

PLAN NOTES:

1. PROVIDE 3" (MIN) CONCRETE SLAB REINFORCED WITH 5 #10 c/c E.W. BOTTOM, ADDED TOP REINFORCING. AS NOTED IN PLAN, PROVIDE 2" BOTTOM COVER TO 5000 PSI OVER 6 MIL VAPOR BARRIER OVER BACKFILL.
2. FOR ALL WALLS PROVIDE REINFORCED MASONRY WITH 5 #10 c/c, AND AS NOTED IN PLANS. USE 3000 PSI GROUT MIX CONCRETE WITH 9" V-1" SLUMP.
3. FOR FOUNDATIONS AND GROUND FLOOR SLAB USE 5000 PSI CONCRETE.
4. PROVIDE 3/8" x 10" x 10" EMBEDDED PLATE W/4-5/8" WELDED HEADED STUDS x 6" LONG.
5. PROVIDE 3/4" DEPRESSION AT ALL EXTERIOR MASONRY WALLS.
6. WHERE NOTED IN PLAN, DROP SLAB SOFFIT 2", PROVIDE SAME BOTTOM MAT.
7. PROVIDE 3" (MIN) CONCRETE SLAB REINFORCED WITH 5 #10 c/c E.W. TOP AND BOTTOM, ADDED TOP REINFORCING. AS NOTED IN PLAN, PROVIDE 2" BOTTOM COVER TO 5000 PSI OVER 6 MIL VAPOR BARRIER OVER BACKFILL.
8. FOR ALL WALLS PROVIDE REINFORCED MASONRY WITH 5 #10 c/c, AND AS NOTED IN PLANS. USE 3000 PSI GROUT MIX CONCRETE WITH 9" V-1" SLUMP.
9. FOR FOUNDATIONS AND GROUND FLOOR SLAB USE 5000 PSI CONCRETE.

GROUND FLOOR FRAMING PLAN
SCALE: 1/4"=1'-0"

SYMBOL LEGEND:

	CONCRETE COLUMN
	CONCRETE WALL
	NEW MASONRY WALL
	GRADE BEAM
	AUGERCAST PILE
	STEEL COLUMN

LOADS DESIGN:

LIVE LOAD = 40 PSF (RESIDENCE)
 = 60 PSF (BALCONY)
 = 100 PSF (TERRACE AND STAIRS)

DEAD LOAD = 25 PSF

REVISIONS:

1-24-2014	BLDG. DEPT. COMMENTS
2-18-2015	BLDG. DEPT. COMMENTS

AA0003569
ANTHONY LEON
0016/52

3 DESIGN ARCHITECTURE

4300 Biscayne Blvd. #G-04, Miami, FL 33137
P: 305.438.9377 | F: 305.438.9379

JUAN FERNANDEZ-BARQUIN, P.E.
#40114

DEC 15 2015


NEW RESIDENCE
FOR:
4354 ALTON RD.
MIAMI BEACH, FL 33139

DATE: 10-20-2014

JUAN FERNANDEZ-BARQUIN, P.E.
STRUCTURAL INSPECTOR P.E. # 40114
2520 N.W. 97th AVENUE, SUITE #240
DORAL, FLORIDA 33172
PHONE: 786.881.1000
E-MAIL: jfb@jbarquine.com
www.juanfernandezbarquine.com

THESE PLANS ARE FOR BUILDING DEPARTMENT REVIEW ONLY. THEY ARE NOT TO BE CONSTRUED AS CONSTRUCTION DOCUMENTS UNTIL ALL BUILDING DEPARTMENT APPROVALS ARE OBTAINED.

S-2
GROUND FLOOR FRAMING PLAN

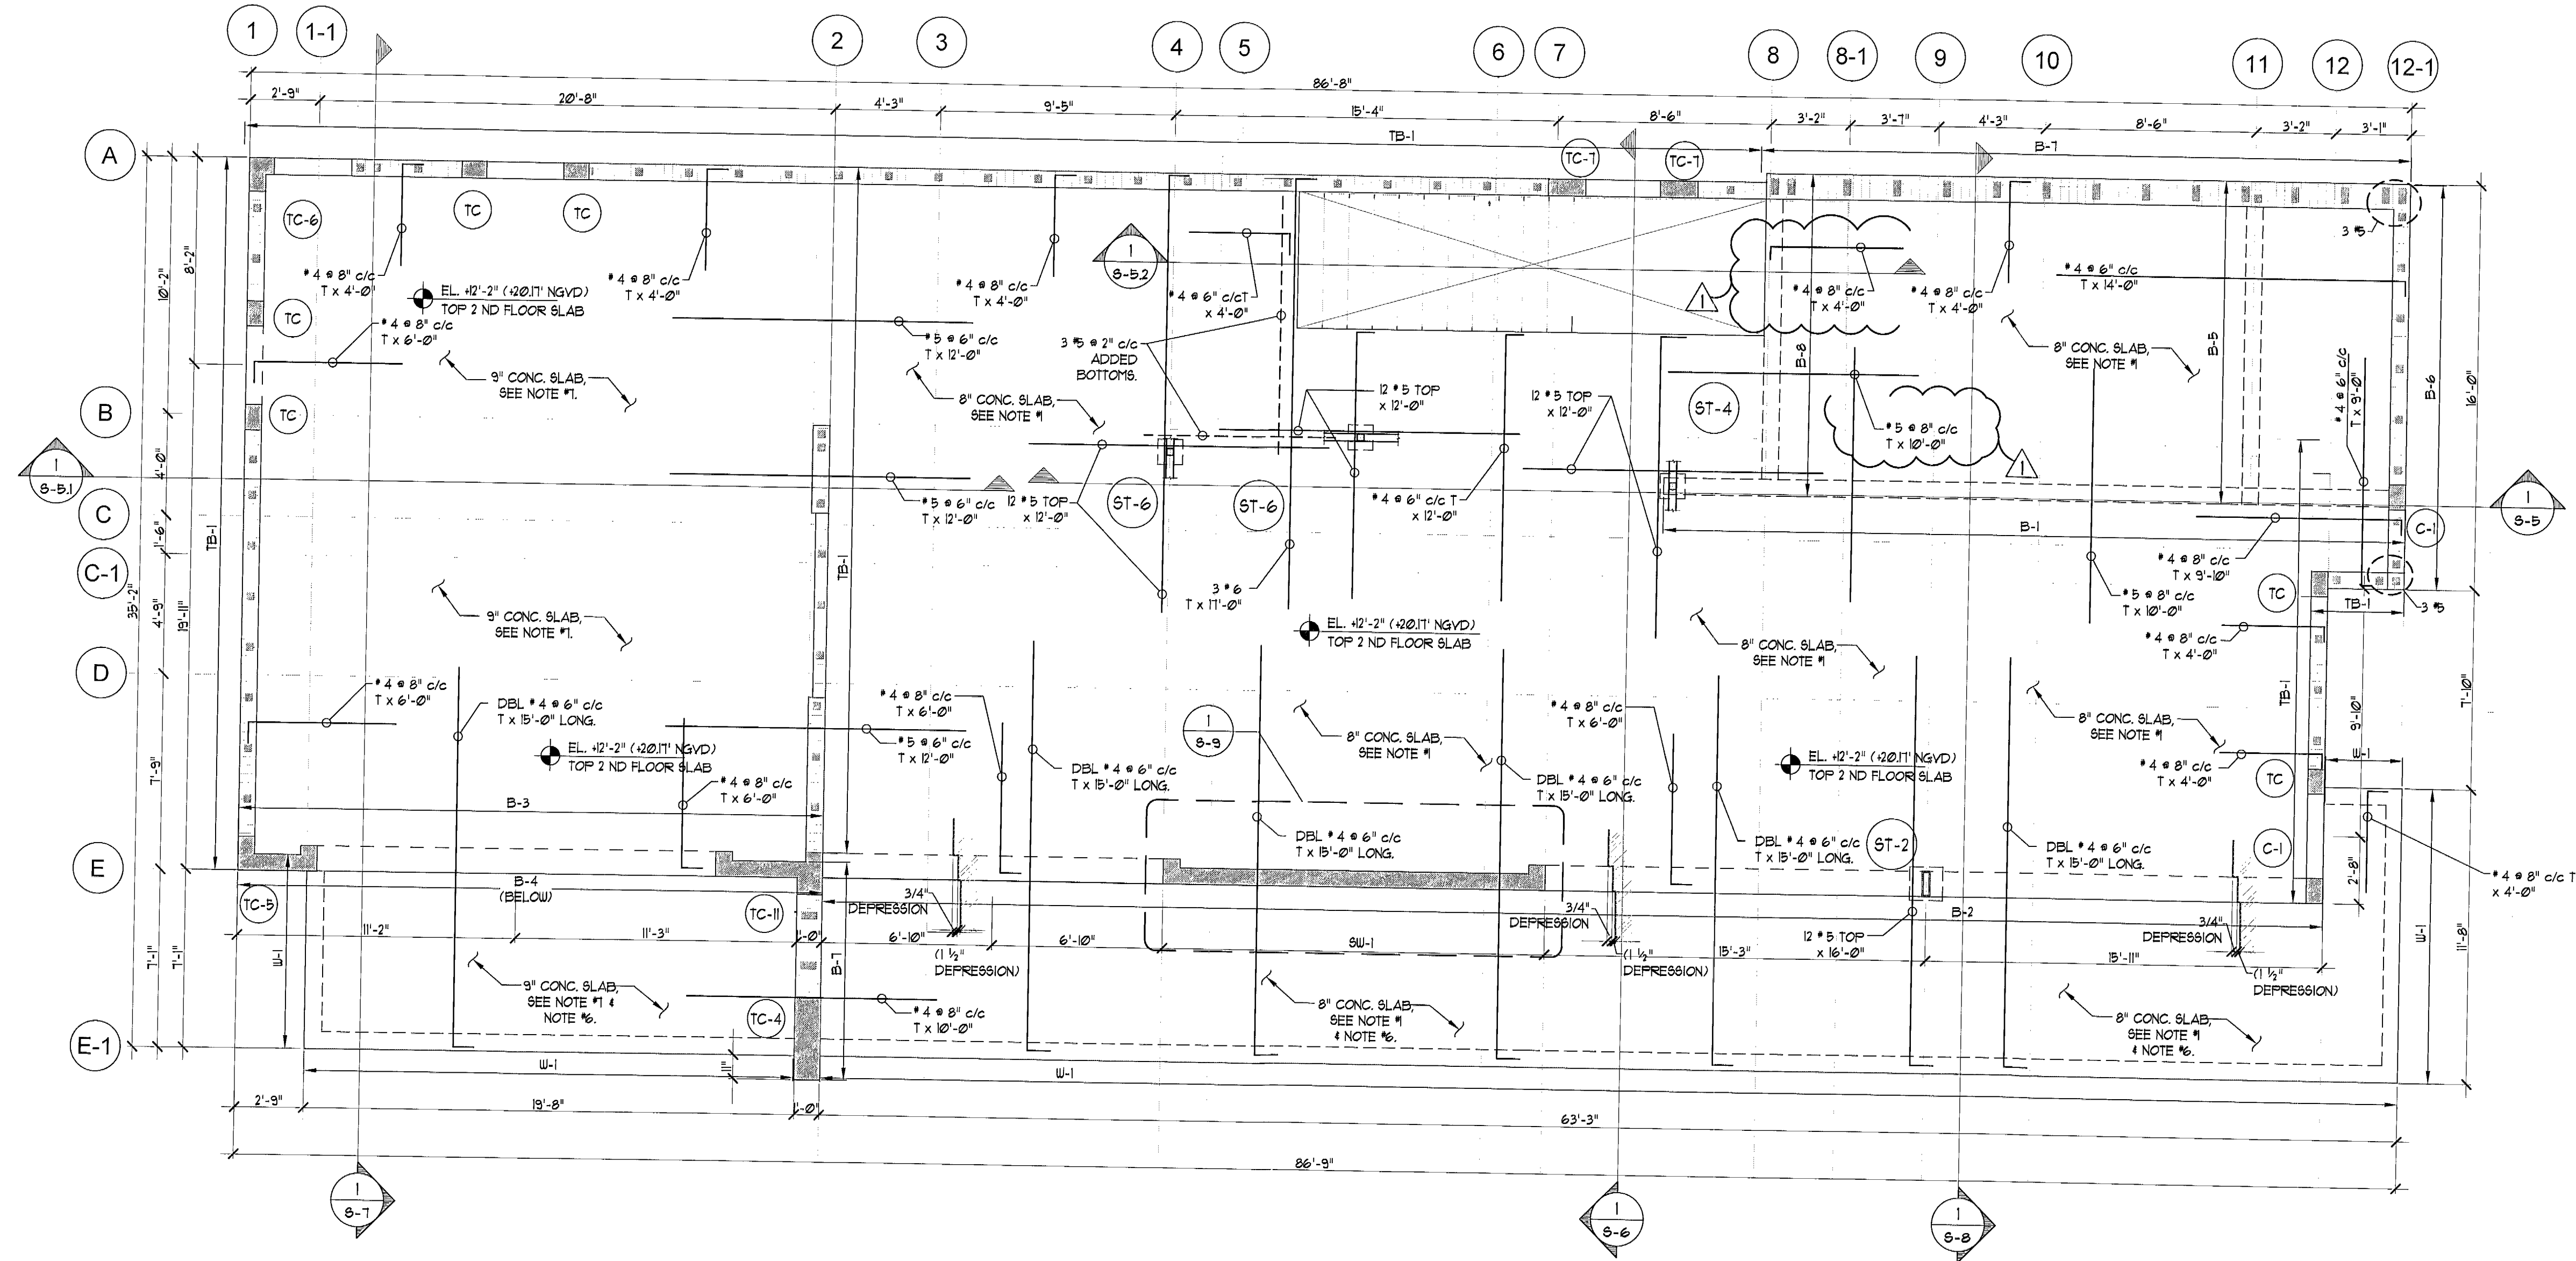

SECOND FLOOR FRAMING PLAN

SCALE: 1/4"=1'-0"

PLAN NOTES:

- PROVIDE 8" MINIMUM CONCRETE SLAB REINFORCED WITH #4 @ 8" c/c E.W. BOTTOM, ADDED TOP REINFORCING ARE NOTED IN PLAN (FC = 5000 PSI).
- PROVIDE 3/4" DEPRESSION AT ALL EXTERIOR PERIMETER FOR WALLS.
- ALL EXTERIOR MASONRY TO BE REINFORCED WITH #4 @ 8" c/c, UNLESS OTHERWISE NOTED. FILL CELLS WITH 3000 PSI GROUT MIX CONCRETE W/ 3" SLUMP (+/- 1").
- PROVIDE 8" TO 6" CONCRETE SLAB W/ #4 @ 8" c/c E.W. BOTTOM ADDED TOP REINFORCING ARE NOTED IN PLAN. (FC = 5000 PSI).
- G.C. TO COORDINATE WITH ARCHITECTURE ALL DIMENSIONS.
- DROP SLAB SOFFIT 2", SEE SECTIONS.
- PROVIDE 8" MINIMUM CONCRETE SLAB REINFORCED WITH #5 @ 6" c/c E.W. BOTTOM, ADDED TOP REINFORCING ARE NOTED IN PLAN (FC = 5000 PSI).

SYMBOL LEGEND:

	CONCRETE COLUMN
	CONCRETE WALL
	NEW MASONRY WALL
	STEEL COLUMN

LOADS DESIGN:

LIVE LOAD = 40 PSF (RESIDENCE)
= 60 PSF (BALCONY)
= 100 PSF (TERRACE AND STAIRS)

DEAD LOAD = 25 PSF

DRAWN BY:
REVISIONS:

AA0003569
ANTHONY LEON
0006/25

3 DESIGN
ARCHITECTURE
4300 Biscayne Blvd. #G-04, Miami, FL 33137
P: 305.438.9377 | F: 305.438.9379

JUAN FERNANDEZ-BARQUIN, P.E.
#40114

NEW RESIDENCE
FOR:
4354 ALTON RD.
MIAMI BEACH, FL 33139

DATE: 10-20-2014

JUAN FERNANDEZ-BARQUIN, P.E.
STRUCTURAL ENGINEER, P.E. #40114
THRESHOLD INSPECTOR #10947
2520 N.W. 97th AVENUE, SUITE #240
DORAL, FLORIDA 33172
PHONE: 786-336-0881, FAX: 786-336-0884
E-MAIL: jfbarquin@bellsouth.net
www.juanfernandezbarquin.com

THESE PLANS ARE FOR BUILDING DEPARTMENT REVIEW ONLY. THEY ARE NOT TO BE CONSIDERED AS CONSTRUCTION DOCUMENTS UNTIL ALL BUILDING DEPARTMENT APPROVALS ARE OBTAINED.

S-3
SECOND FLOOR
FRAMING PLAN

11-24-2015 BLDG. DEPT. COMMENTS

C:\30design Inc\TONY LEON\4354 ALTON RD\STRUCTURE\S-3 Second Floor Framing.dwg