



Location Plan

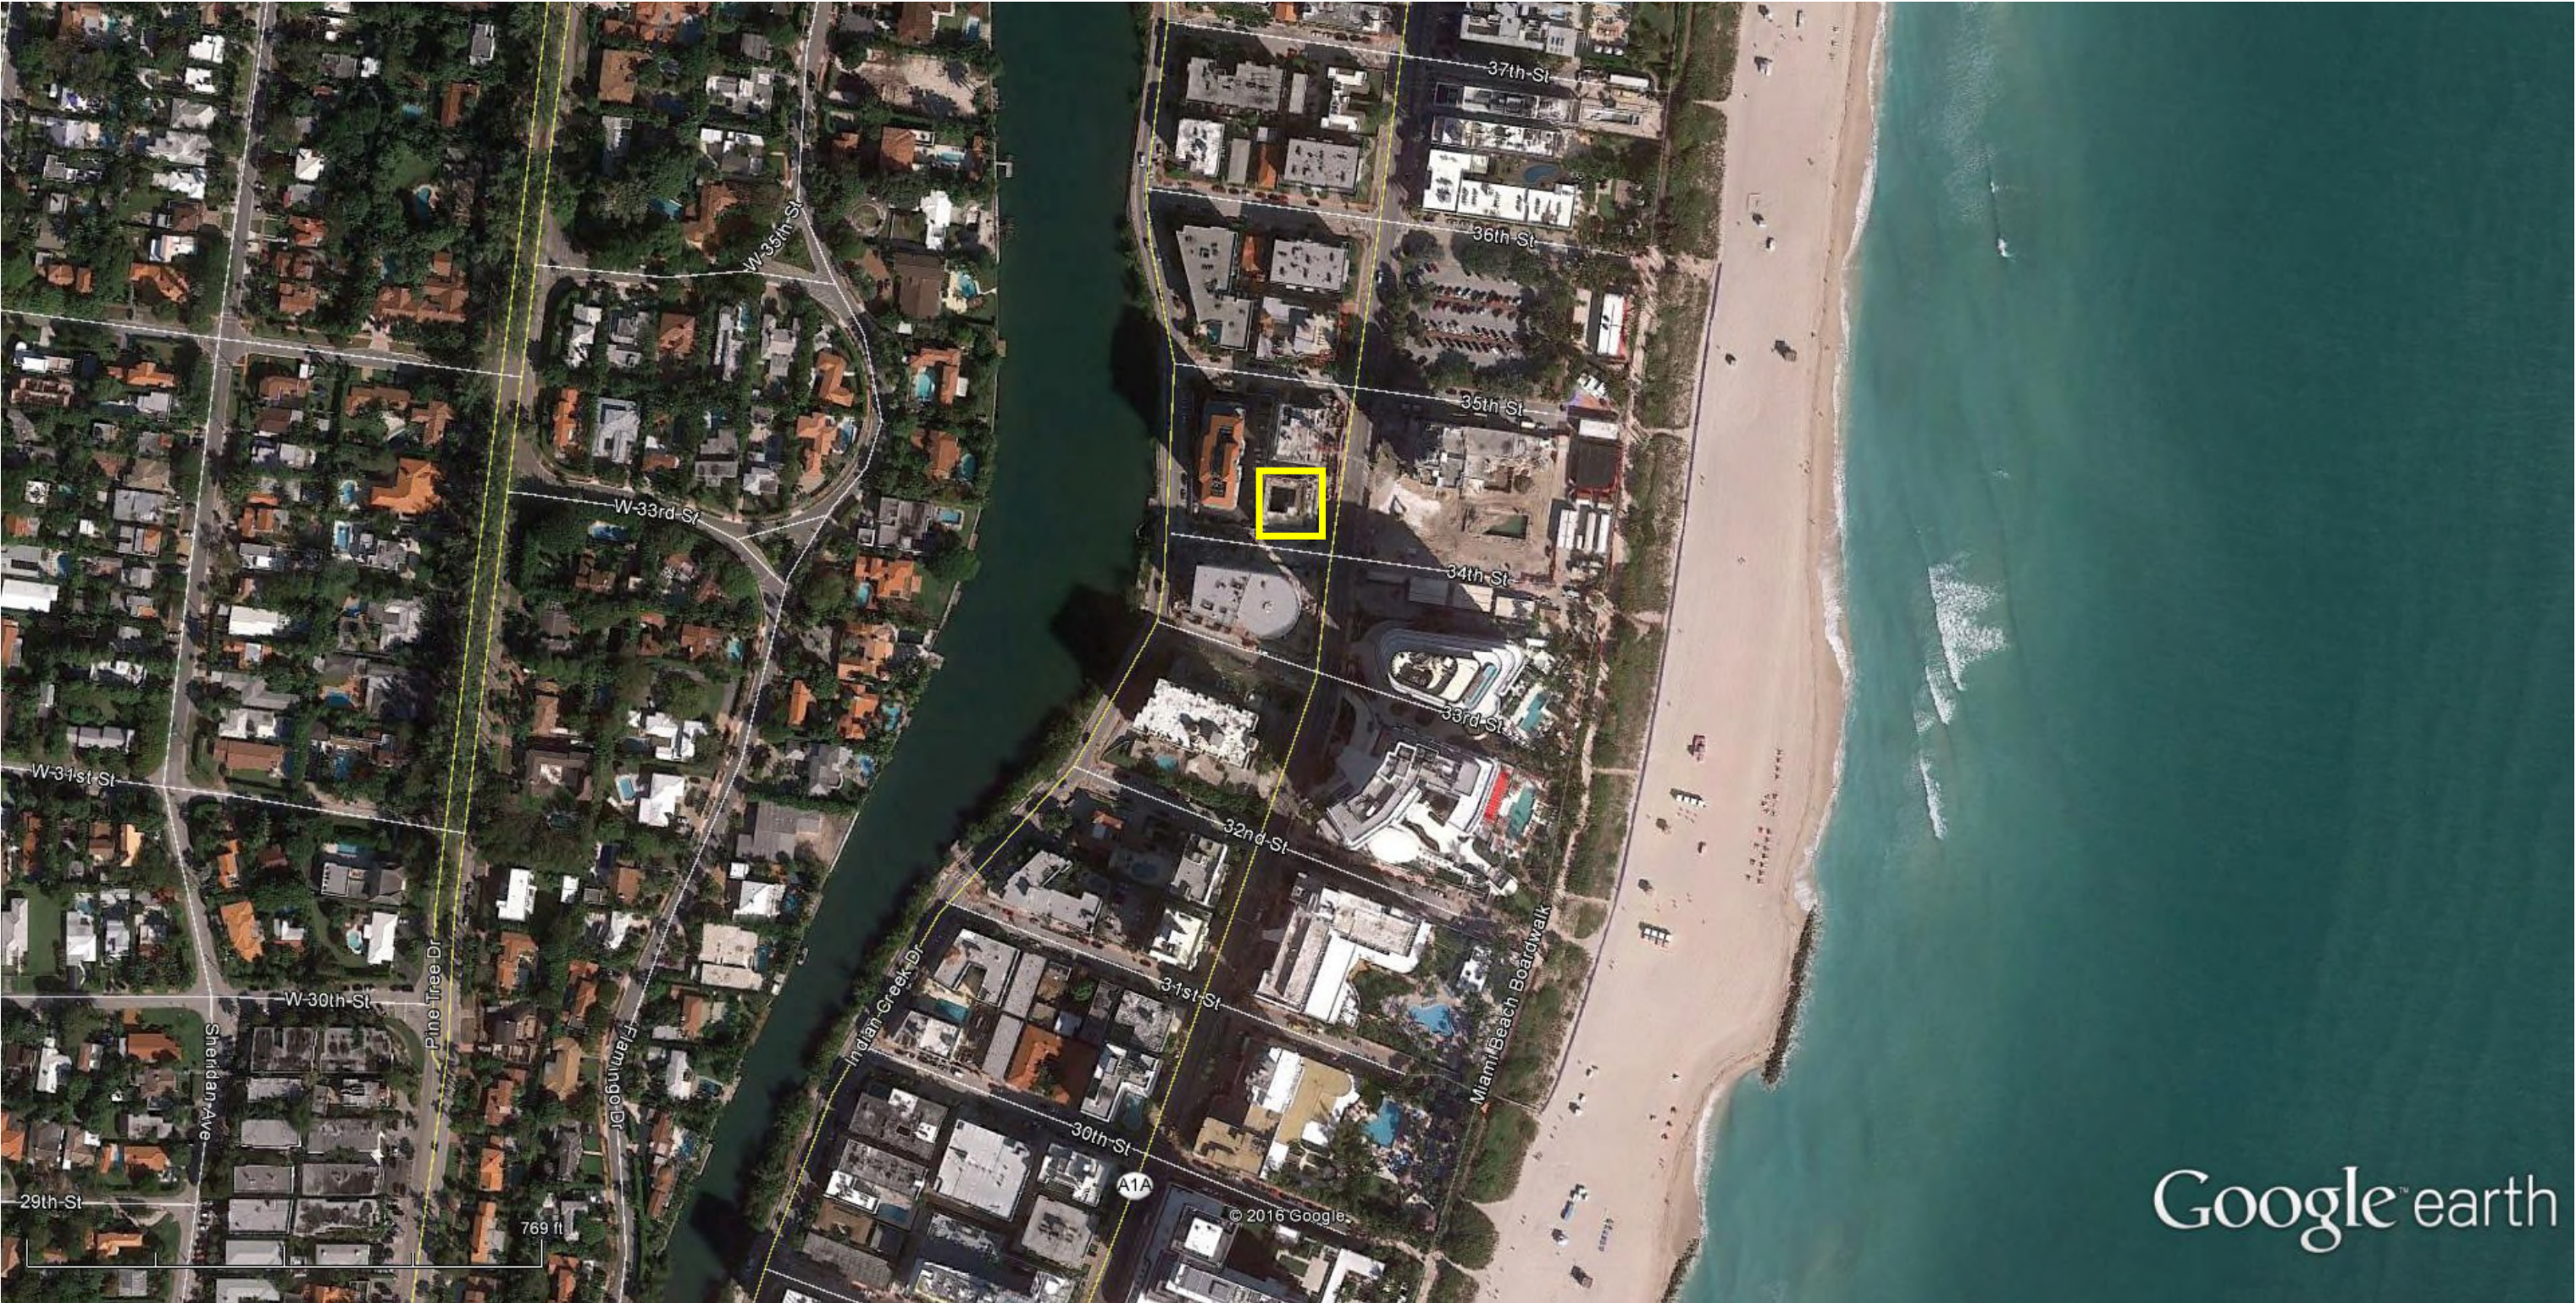

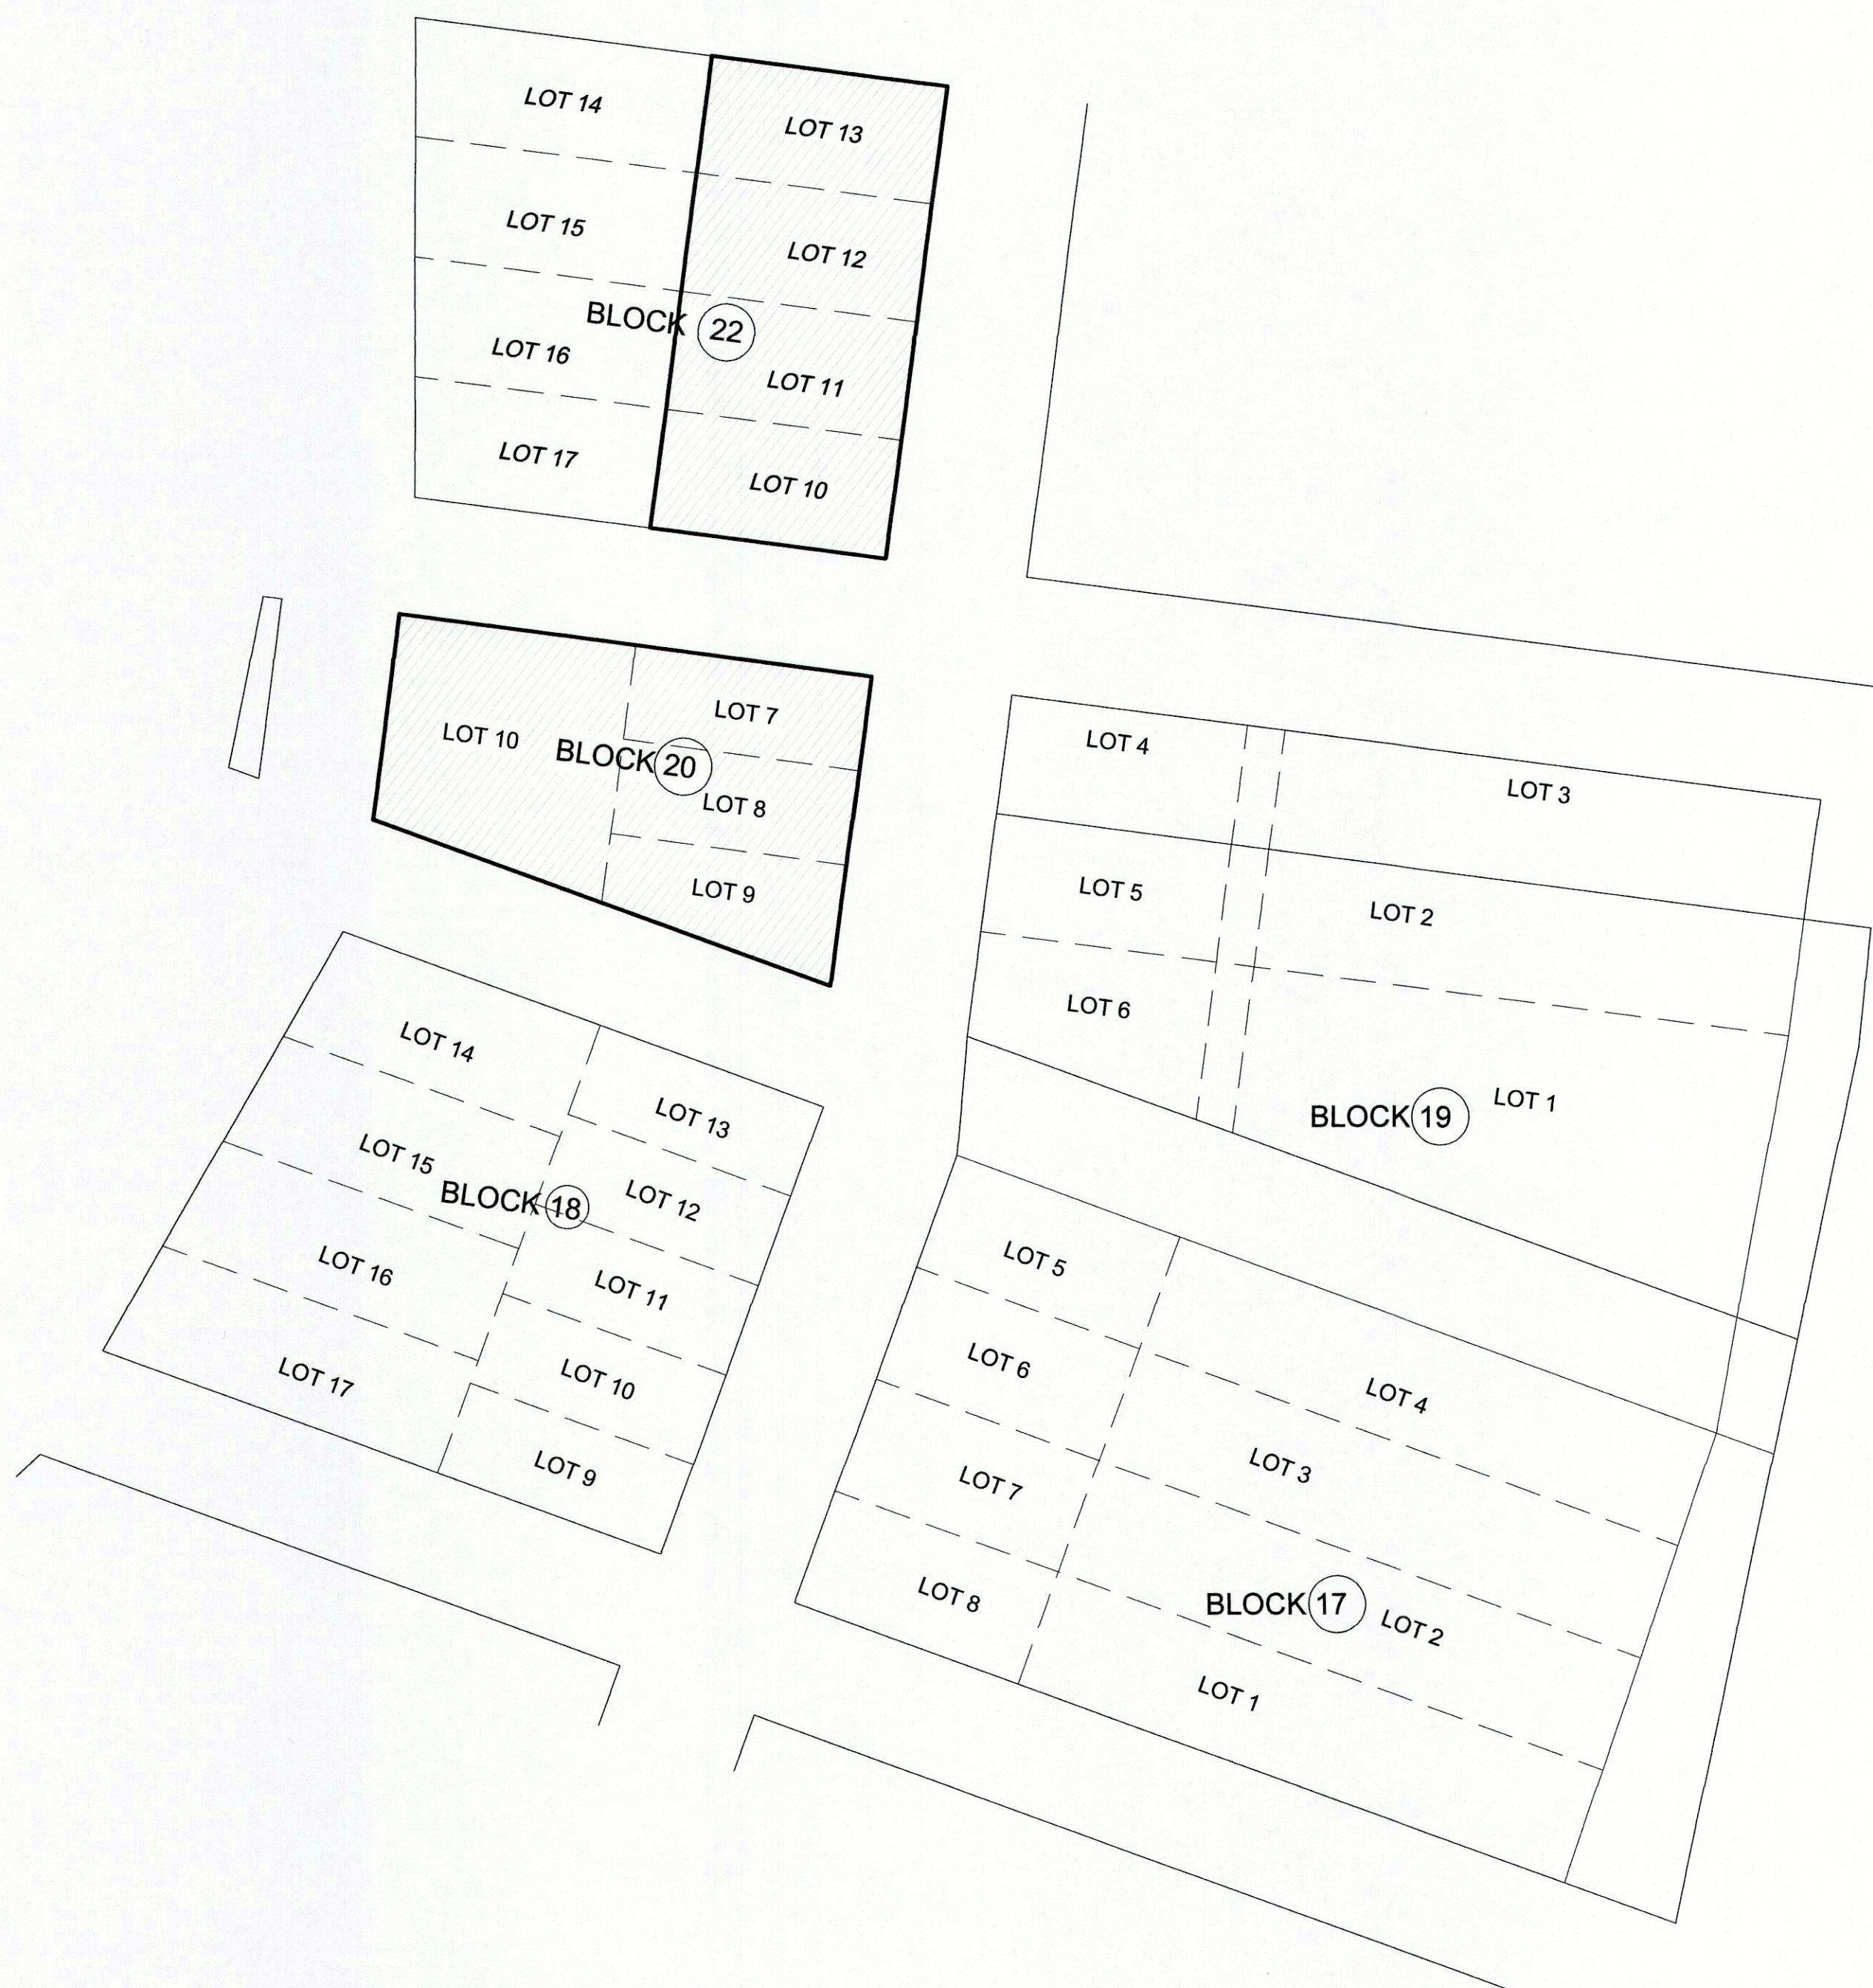

2	05/25/16	Update building dimensions	NA
1	05/11/16	As-Built Survey	NA

ATLANTIC HOTEL
FAENA GROUP

This document is intended only for the specific purpose and client for which it was prepared.

Not valid without the signature and original raised seal of a Florida licensed surveyor and mapper.

Date: 07/11/13	Project: 2605
Scale: 1:30	Checked by: ADR
F.B. 370-63	Drawn by: NA
Sheet: 1 of 1	Sketch: 2605-24
Ref:	

Pictures of surrounding properties, key plan

