



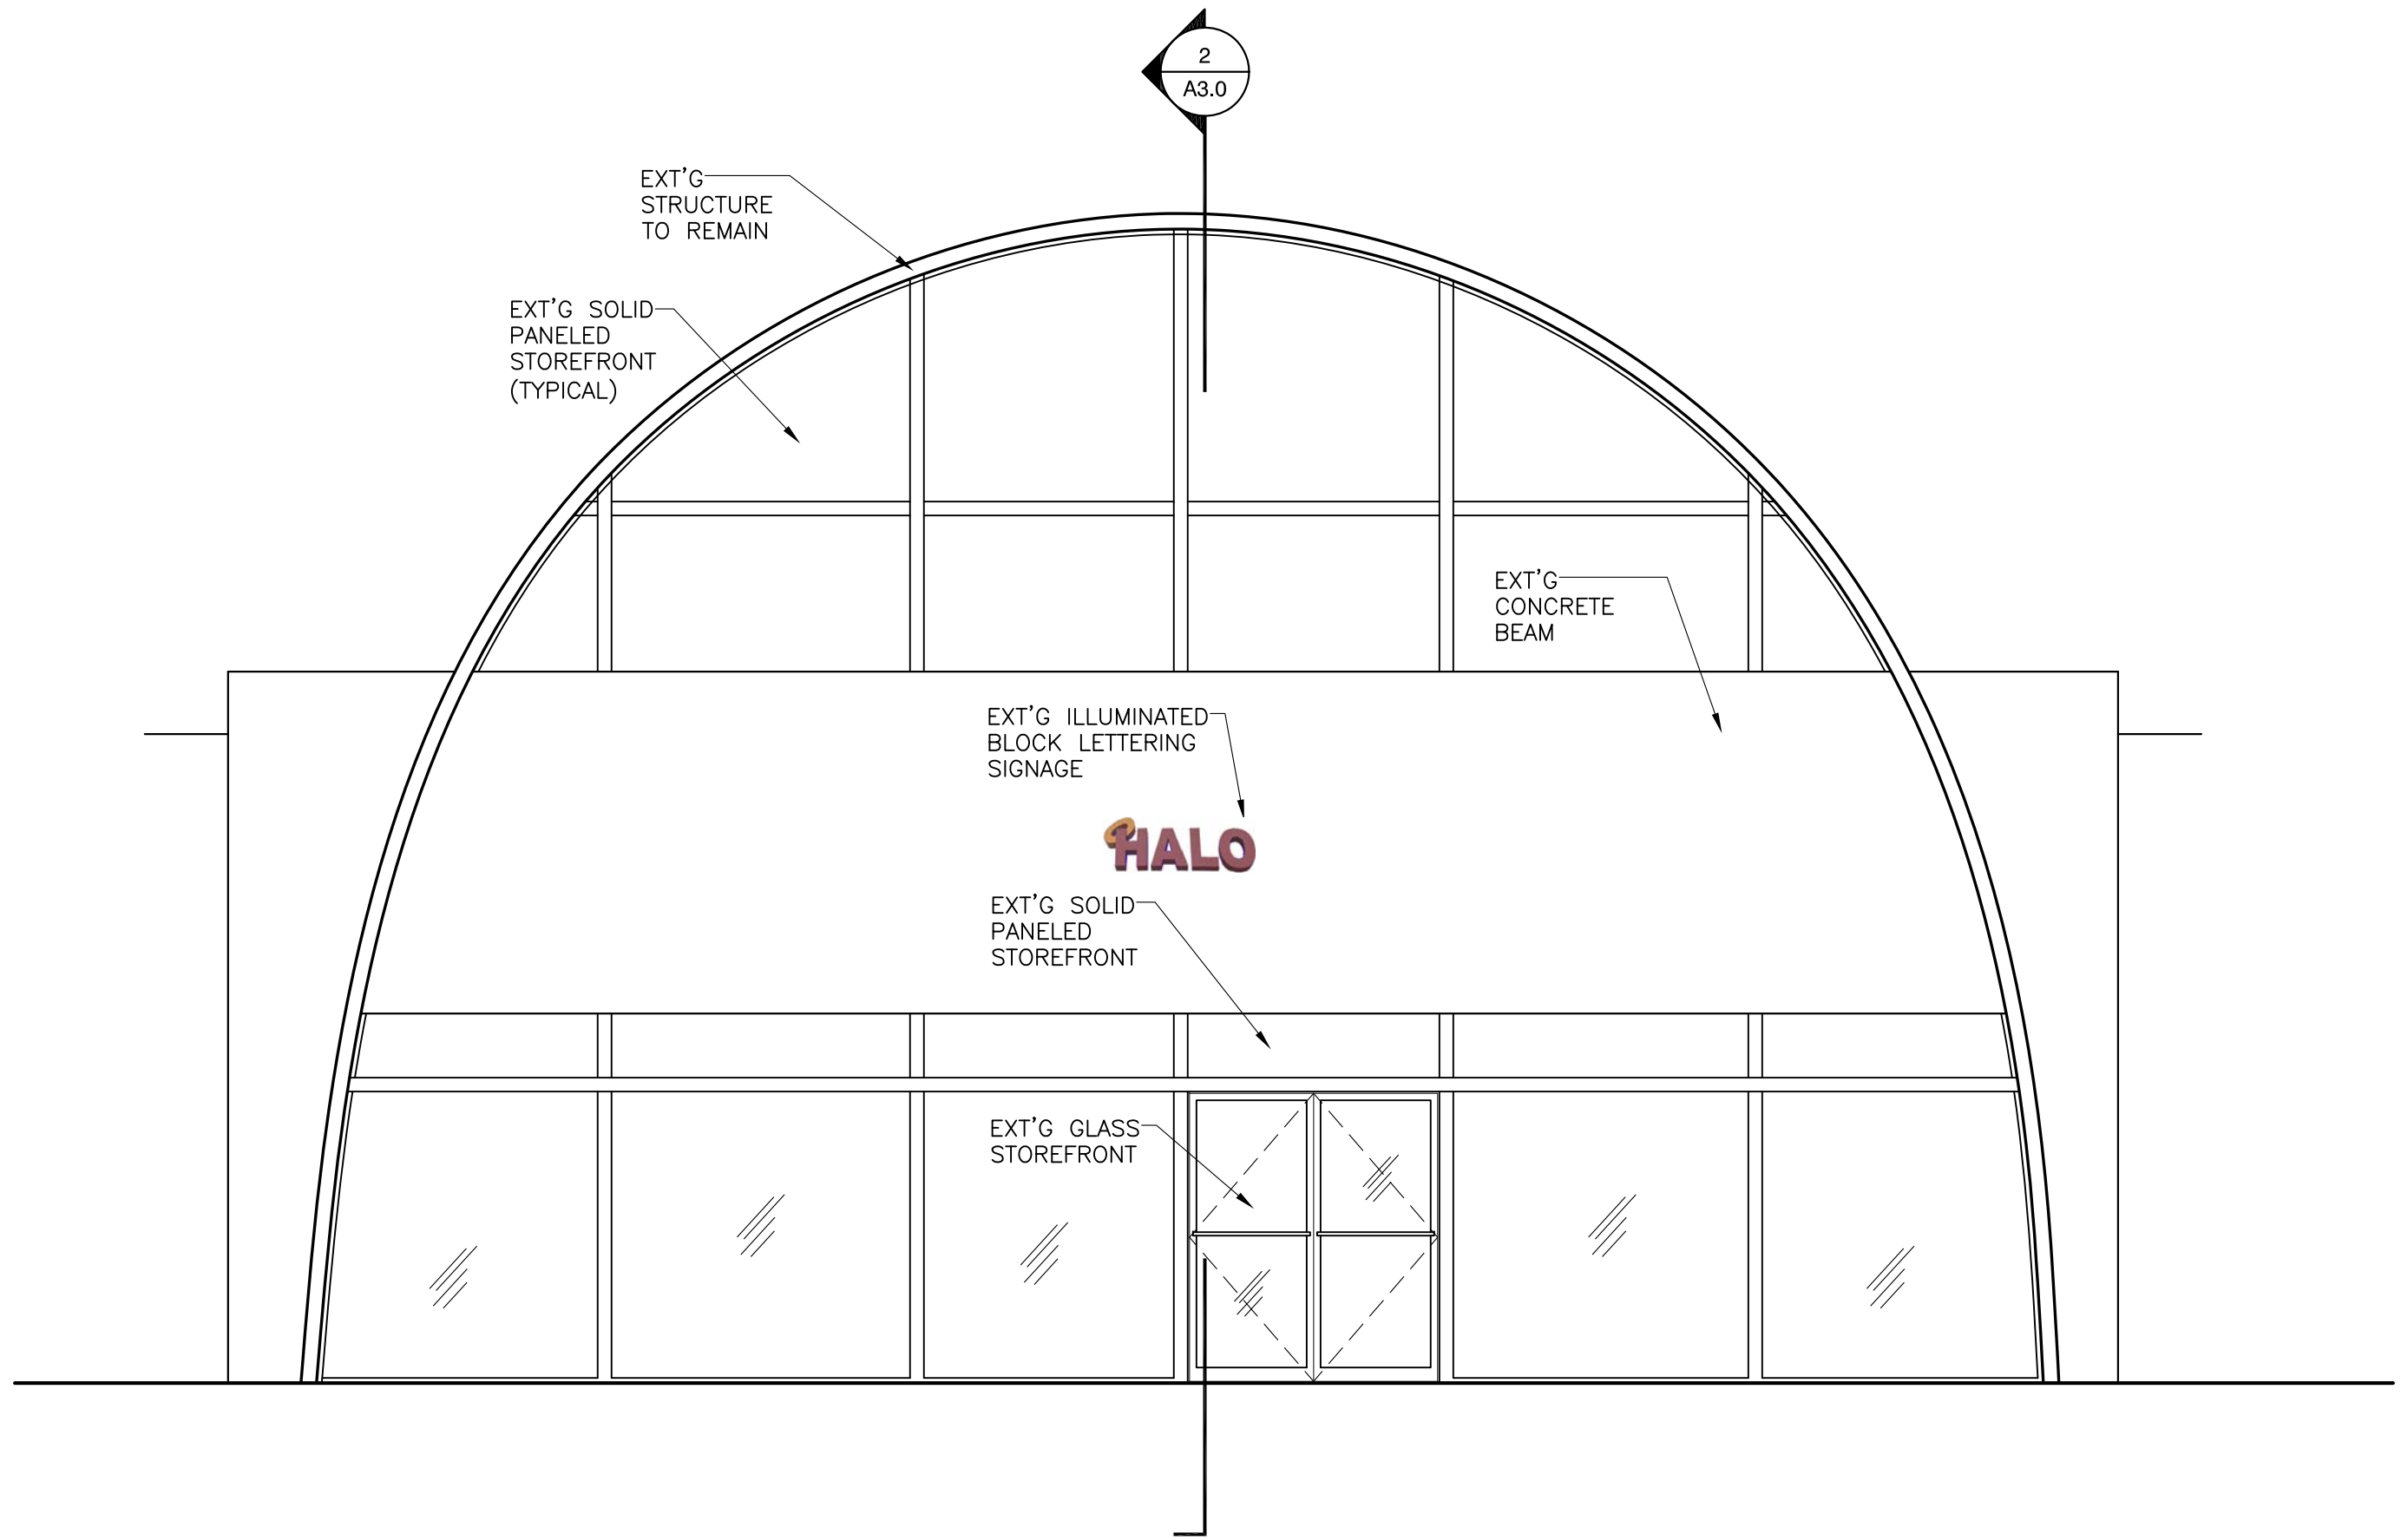

As-Built Elevation (East)

Scale: 1/4"=1'-0"


1
A3.0

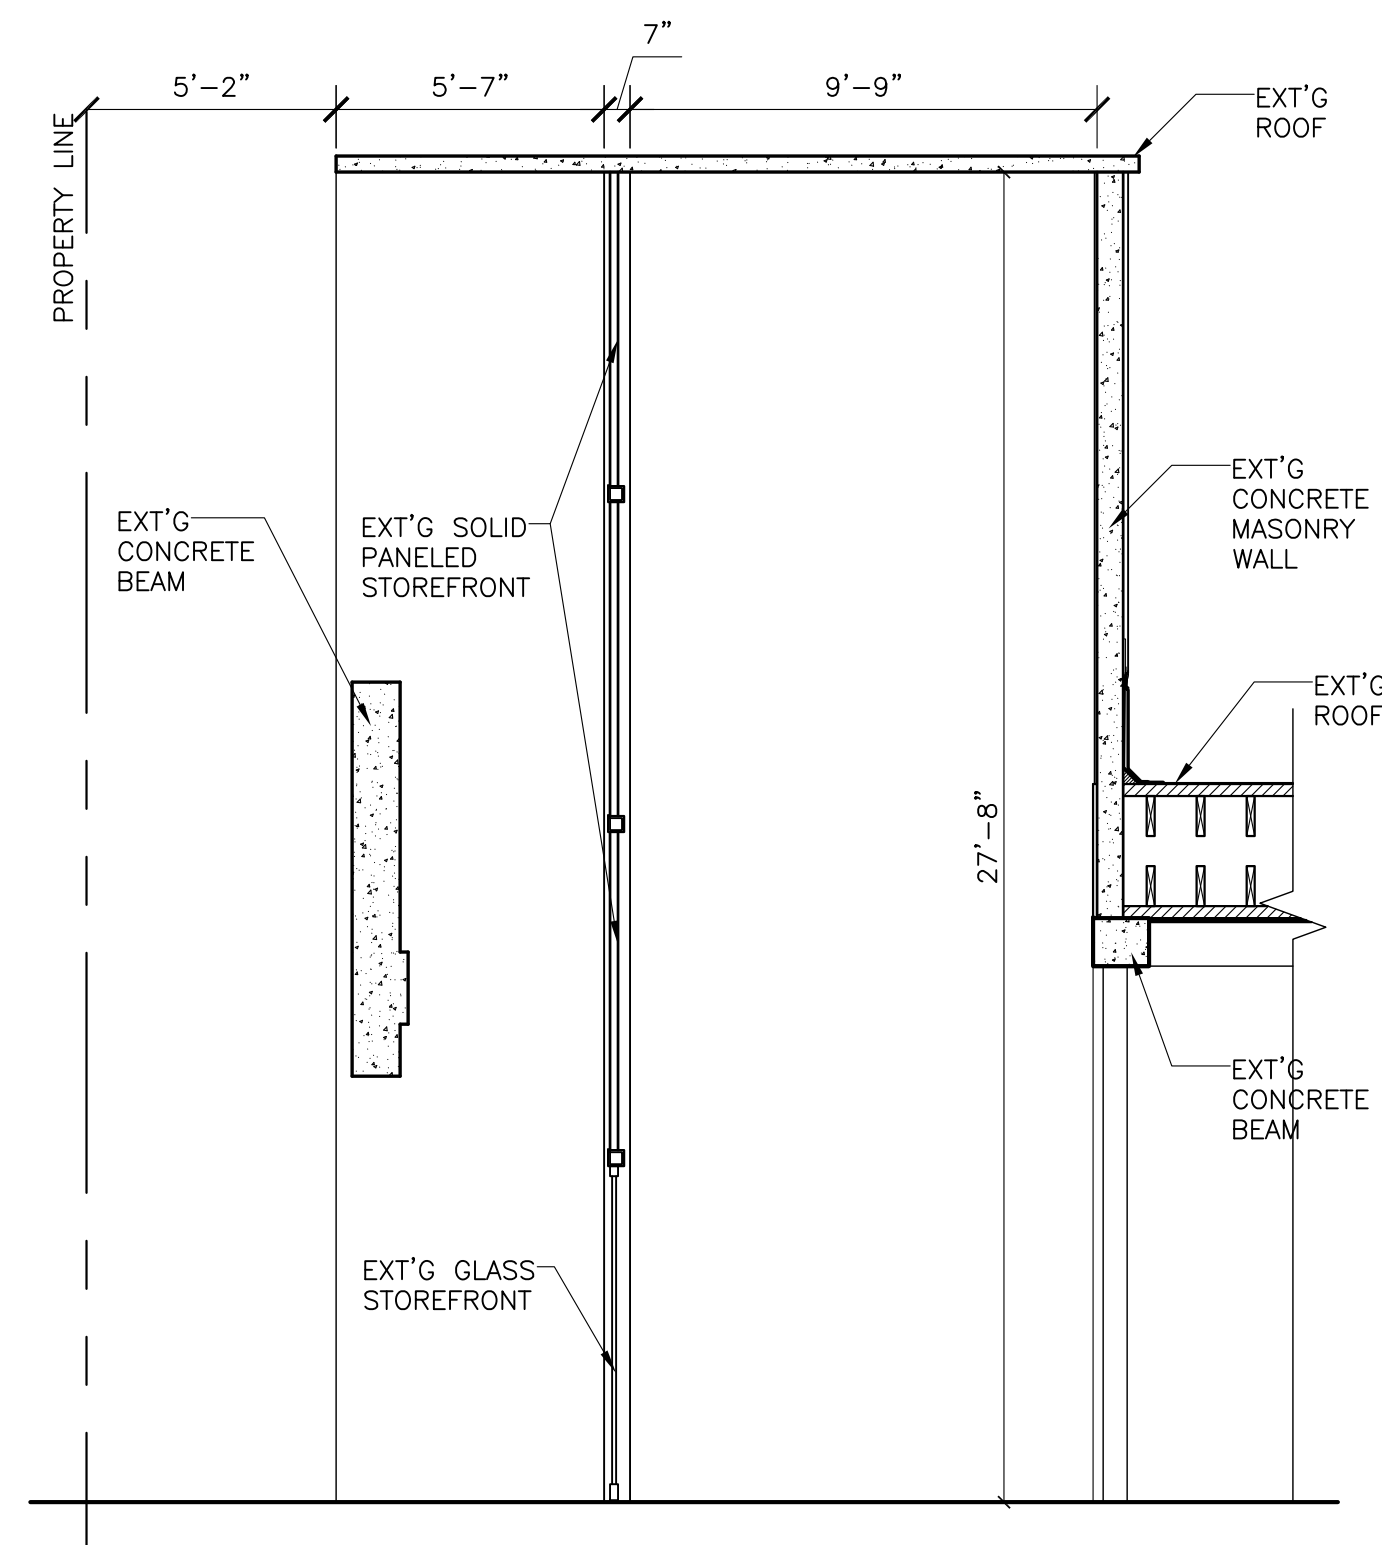

As-Built Section

Scale: 1/4"=1'-0"


2
A3.0

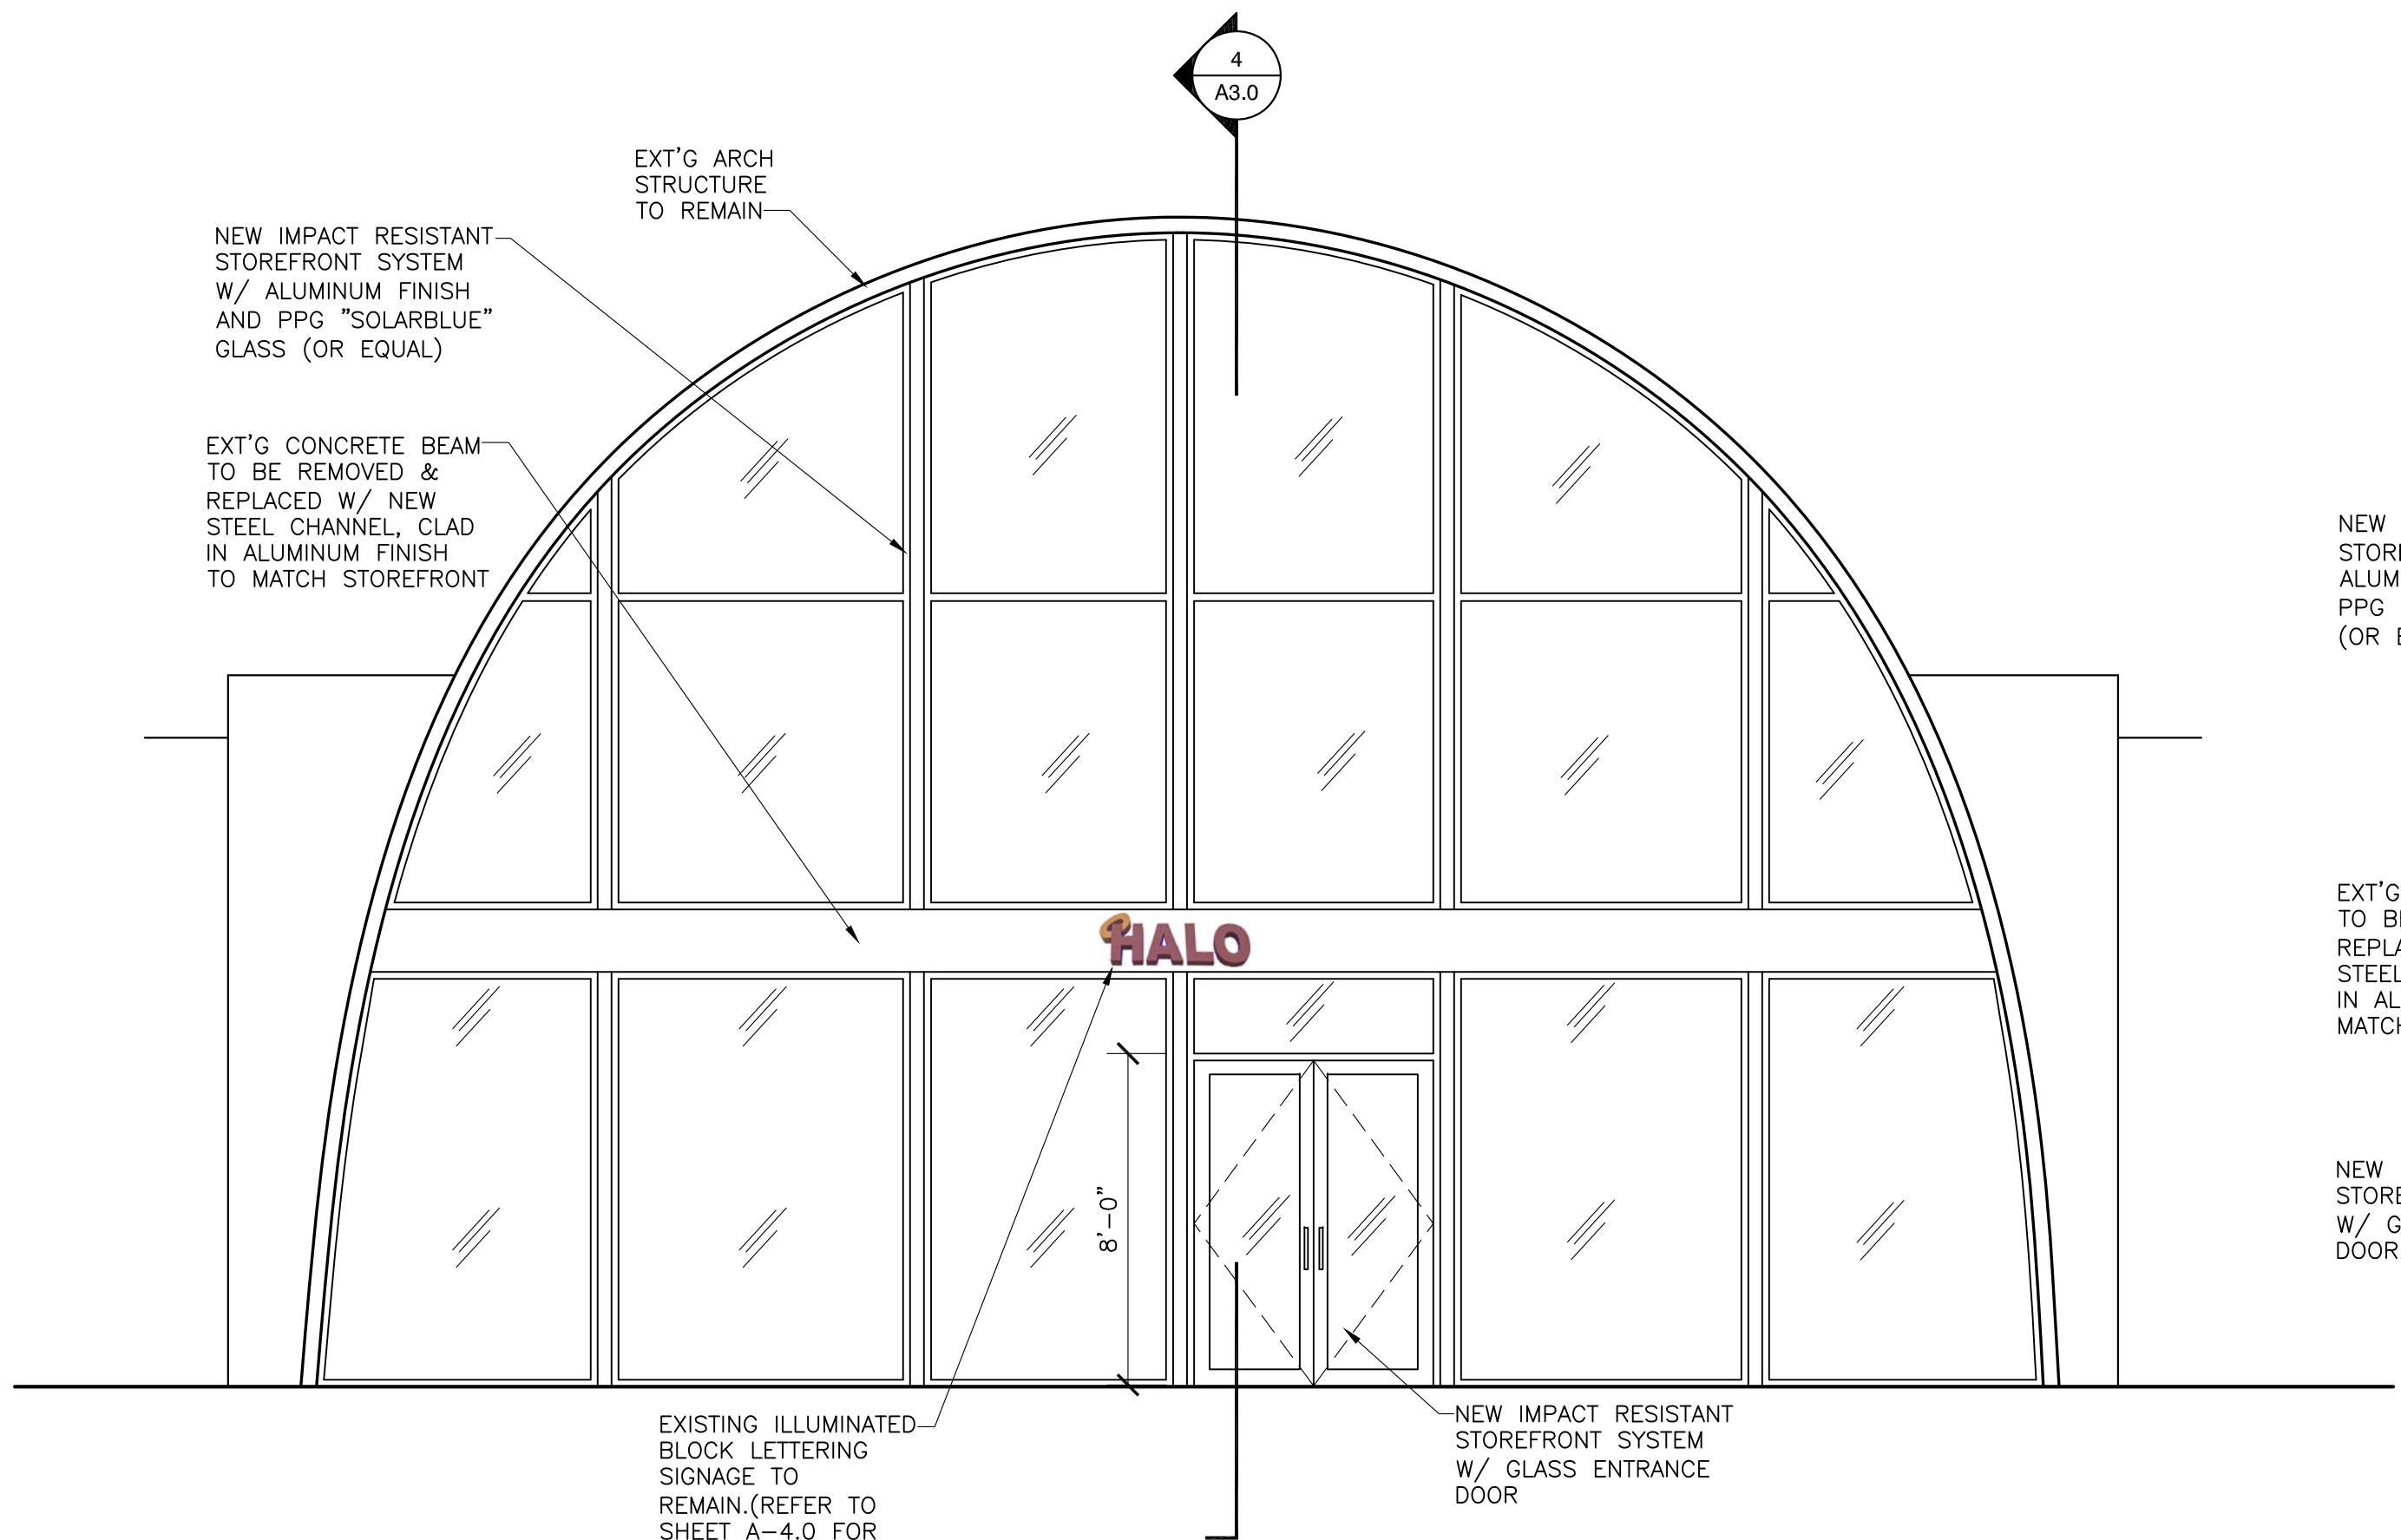

Proposed Elevation (East)

Scale: 1/4"=1'-0"

3
A3.0

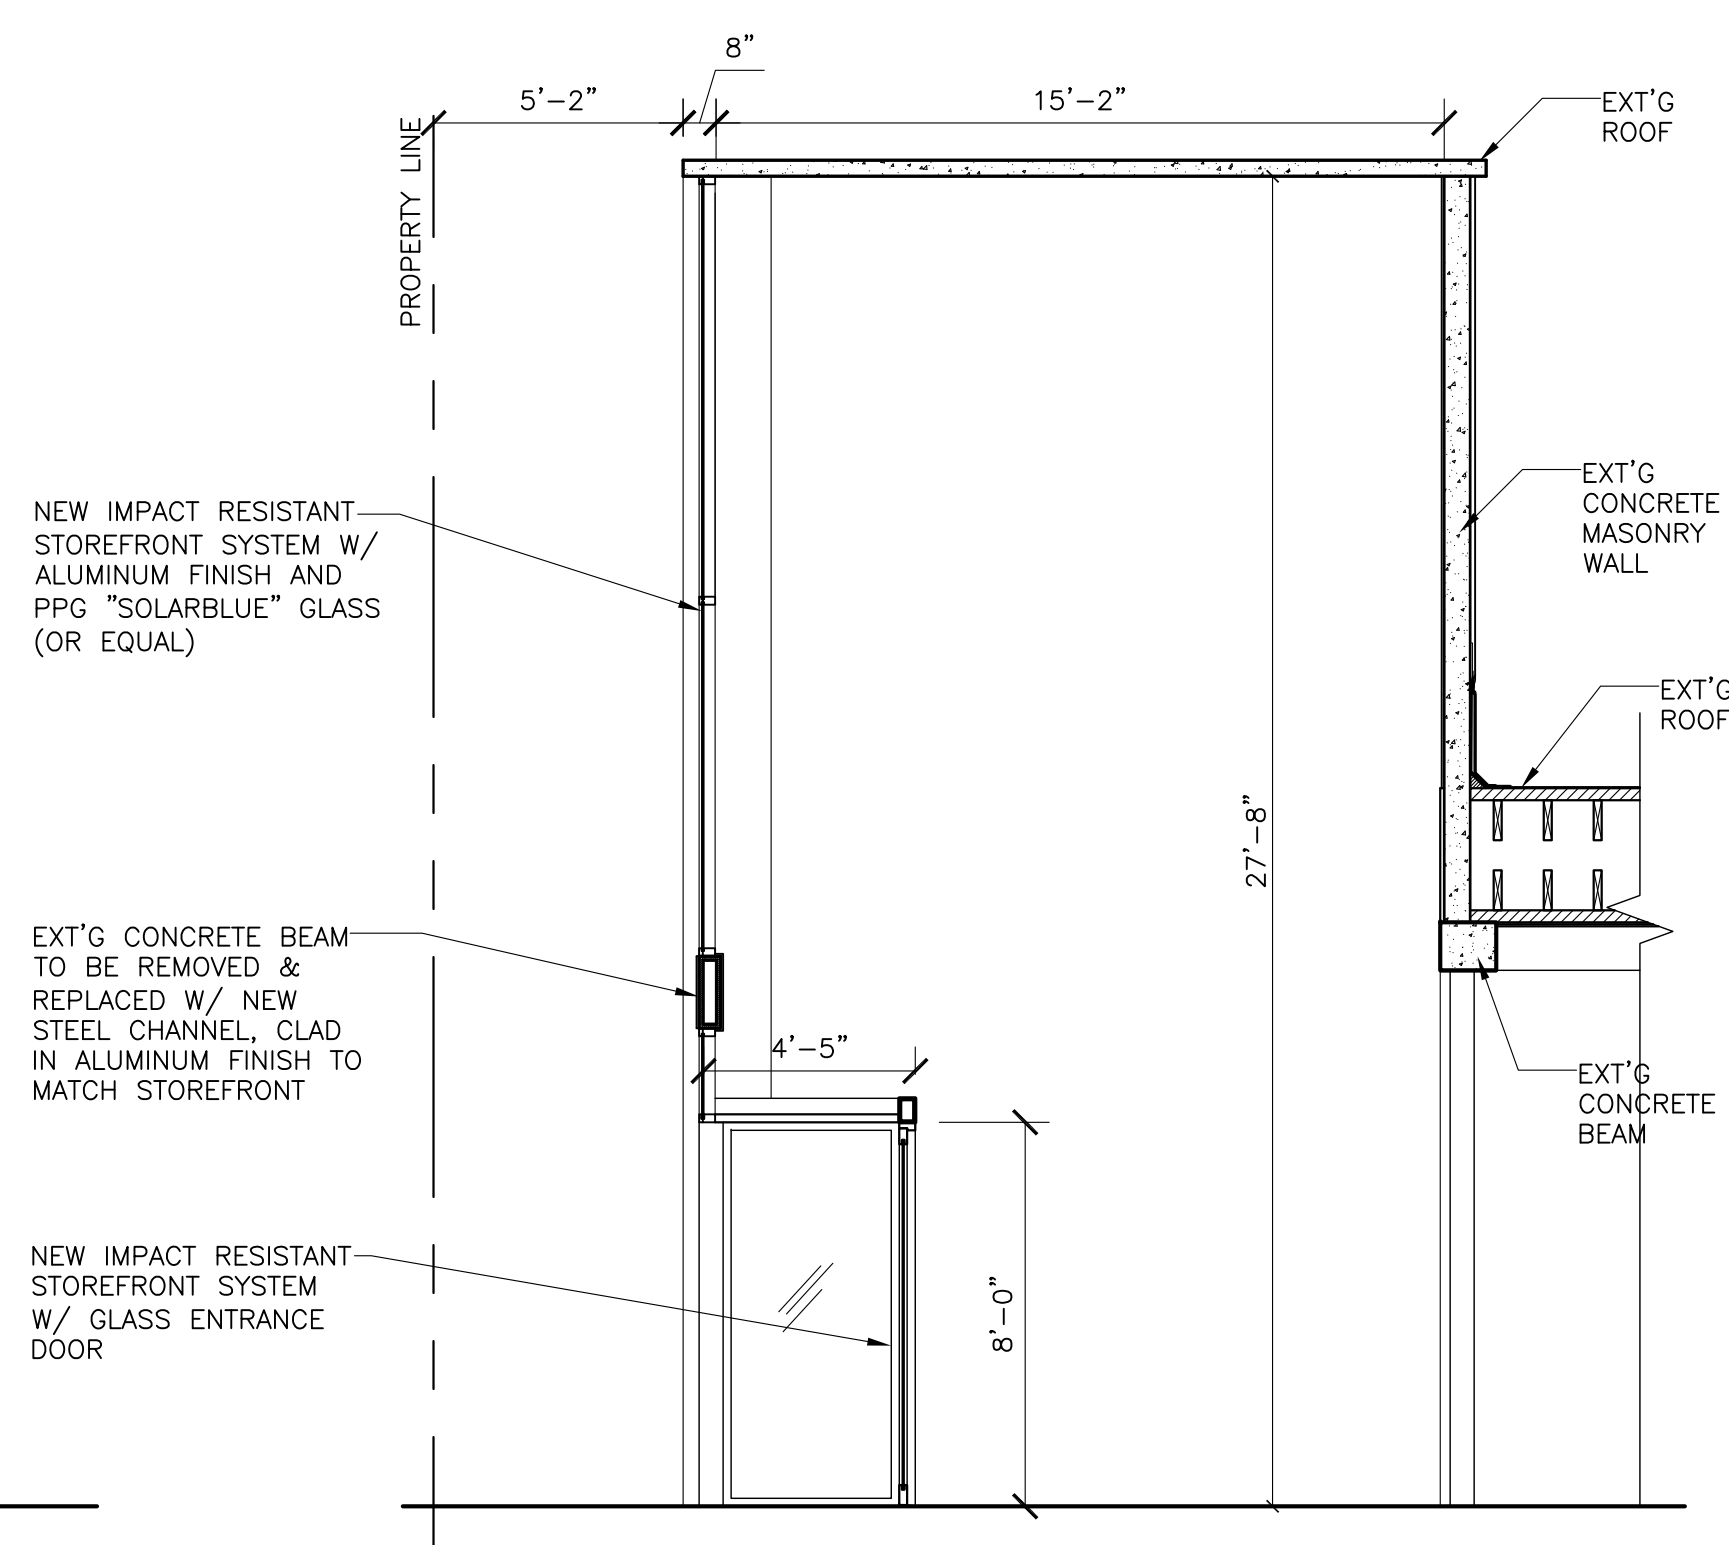

Proposed Section

Scale: 1/4"=1'-0"

4
A3.0

SEAL:
Steven L. Cohen and Associates, P.A.
License No. 4819
Signature:

ALL LEGAL ARRANGEMENTS AND PLAN INDICATED OR REFERRED TO IN THESE DRAWINGS ARE THE SOLE RESPONSIBILITY OF THE ARCHITECT. NO PART OF THESE DRAWINGS SHALL BE REPRODUCED OR TRANSMITTED IN ANY FORM OR BY ANY MEANS, ELECTRONIC OR MECHANICAL, INCLUDING PHOTOCOPYING, RECORDING, OR BY ANY INFORMATION STORAGE AND RETRIEVAL SYSTEM, WITHOUT THE WRITTEN PERMISSION OF THE ARCHITECT. THE ARCHITECT'S OFFICE SHALL BE RESPONSIBLE FOR THE ACCURACY OF THE INFORMATION PROVIDED IN THESE DRAWINGS. NO PART OF THESE DRAWINGS SHALL BE USED FOR ANY OTHER PROJECT WITHOUT THE WRITTEN PERMISSION OF THE ARCHITECT. THE ARCHITECT'S OFFICE SHALL BE RESPONSIBLE FOR THE ACCURACY OF THE INFORMATION PROVIDED IN THESE DRAWINGS. NO PART OF THESE DRAWINGS SHALL BE USED FOR ANY OTHER PROJECT WITHOUT THE WRITTEN PERMISSION OF THE ARCHITECT.

**STEVEN L. COHEN
AND ASSOCIATES, P.A.**
ARCHITECTS - INTERIOR DESIGNERS
2941 W. GYPRESS CREEK RD. SUITE 102
FORT LAUDERDALE, FLORIDA 33309
PHONE (954) 971-1010

**STEVEN L. COHEN
AND ASSOCIATES, P.A.**
ARCHITECTS - INTERIOR DESIGNERS
2941 W. GYPRESS CREEK RD. SUITE 102
FORT LAUDERDALE, FLORIDA 33309
PHONE (954) 971-1010

6618 COLLINS AVENUE
EXTERIOR FACADE RENOVATION

6618 COLLINS AVENUE
MIAMI BEACH, FL

Revisions:

No.	Date:	Description:

Date: 08.15.16
Project Number: 14316
Principal: SLC
Project Manager: NVP
Drawn by: AG

Drawing Name:

**AS-BUILT AND
PROPOSED ELEVATIONS**

Drawing No:

A3.0

Total Sheets:

#

Issue Date:

09.09.2016