


SITE PLAN
SCALE: 1" = 20'-0"

ZONING ANALYSIS

LOT AREA	65,070 S.F.
ZONING	CD-3
ALLOWABLE F.A.R.	15
TOTAL FLOOR AREA	149,154 S.F.
ACTUAL F.A.R.	2.29
SET BACKS	REQUIRED
FRONT	0'-0"
REAR	0'-0" (BY VARIANCE)
SIDE	0'-0"
PARKING REQUIRED	
OFFICE 120,235 S.F.	300 SPACES
1 SPACE/400 S.F.	
RETAIL 20,549 S.F.	64 SPACES
1 SPACE/300 S.F.	
RESTAURANT 200 SEATS	29 SPACES
1 SPACE/7 SEATS	
TOTAL	397 SPACES
PARKING PROVIDED	
HANDICAP SPACES (12'-0" X 18'-0")	12 SPACES
STANDARD SPACES (10'-0" X 18'-0")	529 SPACES
TOTAL	541 SPACES

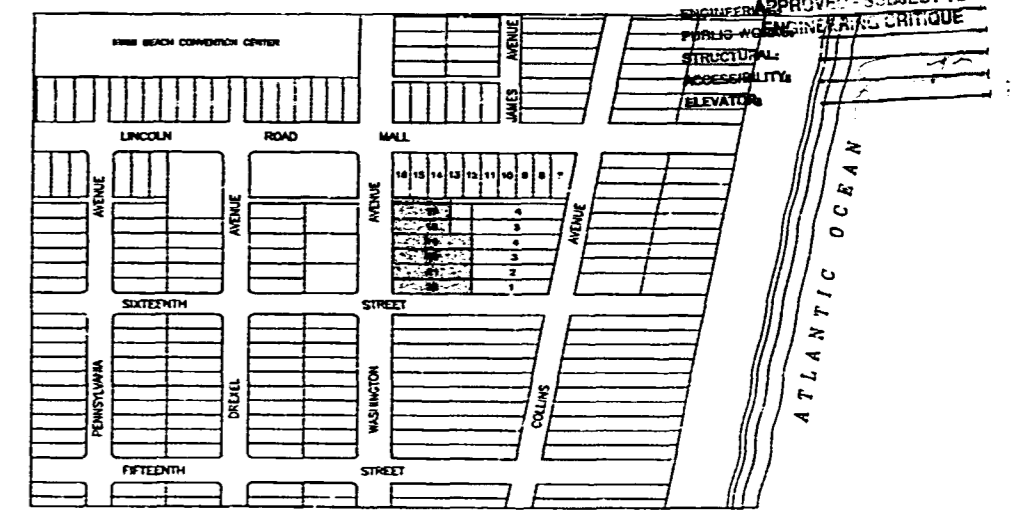

LOCATION PLAN
SCALE: 1" = 300'-0"

LEGAL DESCRIPTION:

Parcel 1: Lots 19 and 20; less the western 94 feet thereof, and all of Lots 21 and 22, Block 54, FISHERS 1ST (OF ALTON BEACH), as recorded in Plat Book 2, Page 77 of the Public Records of Miami-Dade County, Florida.

Parcel 2: The westerly portions of Lots 19 and 20, Block 54, FISHERS 1ST (OF ALTON BEACH), according to the Plat thereof, recorded in Plat Book 2, Page 77 of the Public Records of Miami-Dade County, Florida, more particularly described as follows: Commencing at the point where the north lot line of Lot 19 meets the west lot line of Lot 19, then proceed along the westerly lot lines of Lots 19 and 20 for a distance of 100 feet; thence east, parallel to the north lot line of Lot 21, a distance of 94 feet; thence north, parallel to the westerly lot lines of Lots 19 and 20 a distance of 100 feet to the north line of Lot 19; thence west along the north lot line of Lot 19 to the POINT OF BEGINNING.

Parcel 3: Lots 17 and 18 plus 20 feet of ALLEY NOW CLOSED LYING north of Lot 17 all in Block 54 of FISHERS FIRST ADDITION OF ALTON BEACH, according to the Plat thereof, as recorded in Plat Book 2, Page 77 of the Public Records of Miami-Dade County, Florida LESS AND EXCEPT THE FOLLOWING: (a) The east 60 feet of all said parcels; and (b) all portions of the west 85 feet of said parcels which lie below a plane which is 25 feet above the existing grade (it being understood that only the air rights above said 25 foot plane are included as to the west 85 feet of the subject parcels).

Property contains 65,097 square feet, or 1.494 acres.

NOTE: ALL ELEVATION MARKS REFER TO N.G.V.D.

ROAD, FIRE, SCHOOL
IMPACT FEES PAID
AUG 9 9 2000
MIAMI-DADE COUNTY
APPROVED: [Signature]


OFFICE COPY
CITY OF MIAMI BEACH
APPROVED FOR PERMIT BY:
THE FOLLOWING:

- The following shop drawings are not part of this permit. Must provide shop drawings under separate permit for:
- Bar Joist
 - Ext. Doors
 - Glass Block
 - Hand Rail
 - Membrane Structures
 - Over Head Doors
 - T-rod
 - Precast Members
 - Stairs
 - Skylights
 - Structural Steel
 - Trusses
 - Walkways
 - Others

BUILDING: [Signature]
ZONING: [Signature]
PLUMBING: [Signature]
ELECTRICAL: [Signature]
MECHANICAL: [Signature]
FIRE PREVENTION: [Signature]
ENGINEERING: [Signature]
ARCHITECTURAL: [Signature]
ELEVATOR: [Signature]

NICHOLSON
BROSCH
SANDOZ
& ASSOCIATES
Architects & Planners
1901 LINCOLN PLACE
MIAMI BEACH, FLORIDA 33139
954-351-1111

9806
A1.0

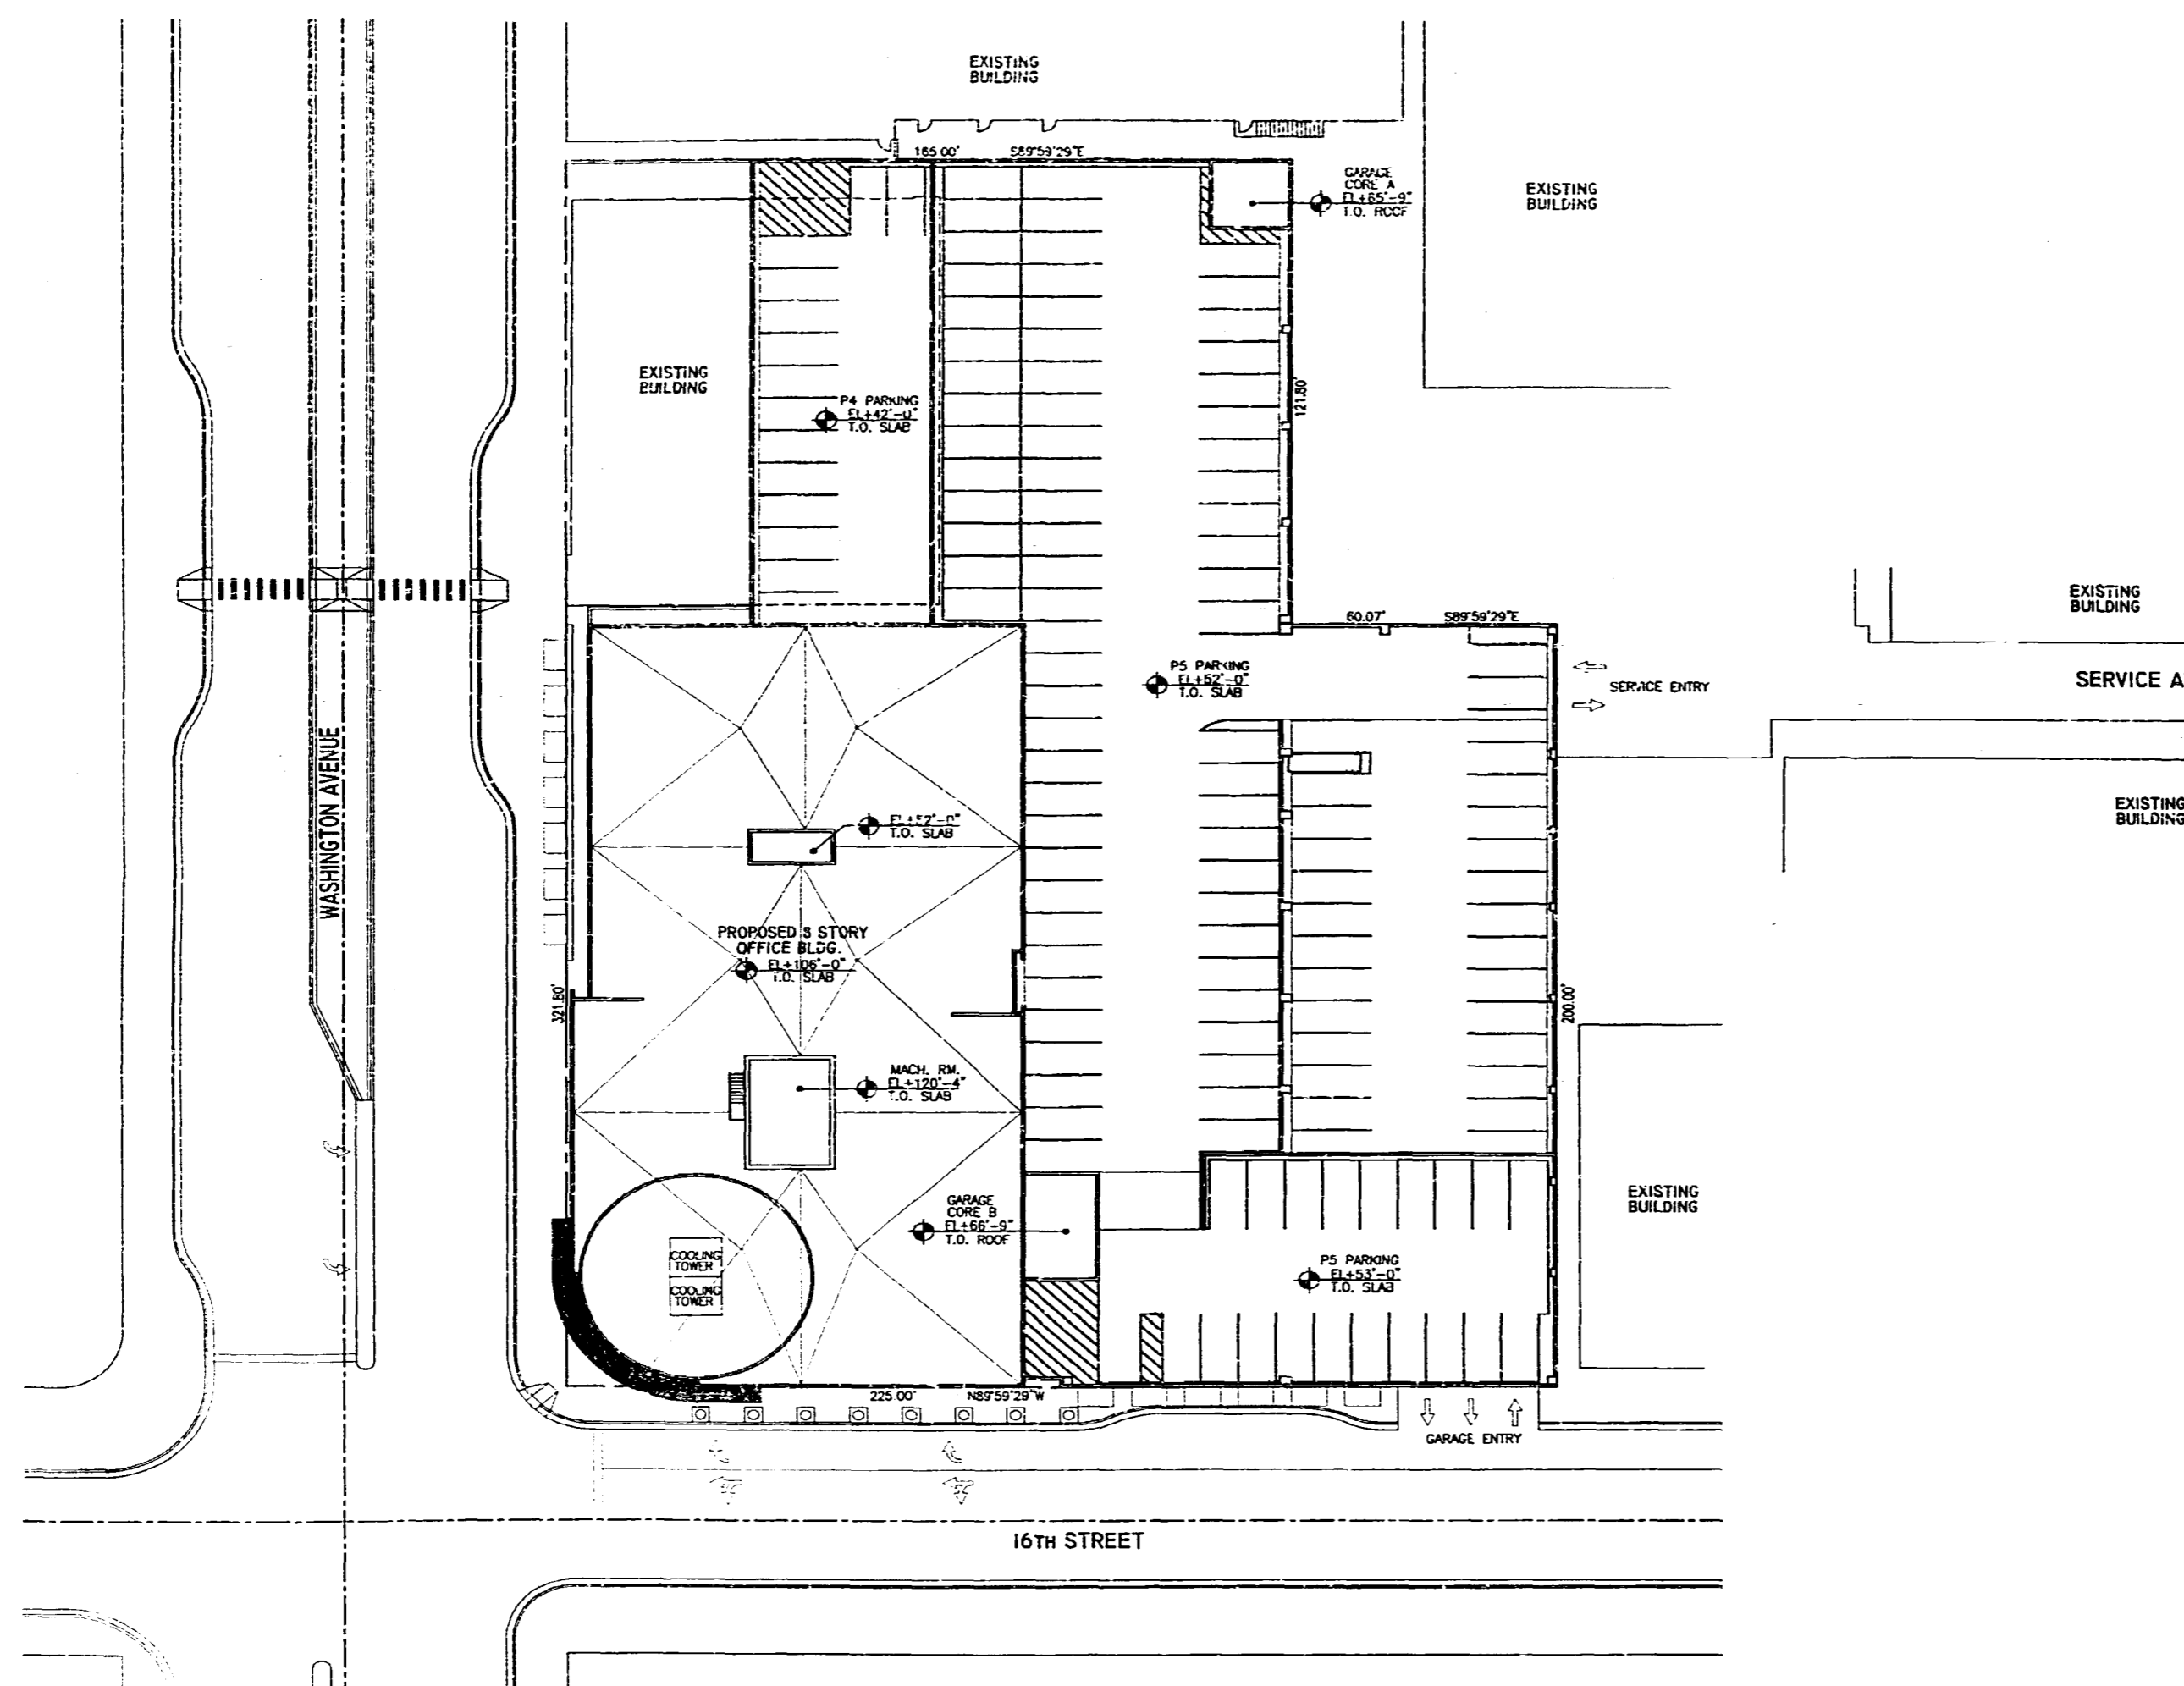

SITE PLAN
SCALE: 1" = 20'-0"



LOCATION PLAN
SCALE: 1" = 300'-0"

LEGAL DESCRIPTION:


Parcel 1: Lots 19 and 20; less the western 94 feet thereof, and all of Lots 21 and 22, Block 54, FOWERS 151 (OF ALTON BEACH), as recorded in Plat Book 2, Page 77 of the Public Records of Miami-Dade County, Florida.

Parcel 2: The westerly portions of Lots 19 and 20, Block 54, FOWERS 151 (OF ALTON BEACH), according to the Plat thereof, recorded in Plat Book 2, Page 77 of the Public Records of Miami-Dade County, Florida, more particularly described as follows: Commencing at the point where the north lot line of Lot 19 meets the west lot line of Lot 18, then proceed along the westerly lot line of Lots 19 and 20 for a distance of 100 feet, thence west, parallel to the north lot line of Lot 21, a distance of 94 feet, thence north, parallel to the westerly lot lines of Lots 19 and 20 a distance of 100 feet to the north lot line of Lot 19, thence west along the north lot line of Lot 19 to the POINT OF BEGINNING.

Parcel 3: Lots 17 and 18 plus 20 feet of ALLEY NOW CLOSED LYING north of Lot 17 as recorded in Plat Book 2, Page 77 of the Public Records of Miami-Dade County, Florida, as shown on FOWERS FIRST ADDITION OF ALTON BEACH, recorded in the Plat thereof, as recorded in Plat Book 2, Page 77 of the Public Records of Miami-Dade County, Florida LESS AND EXCEPT THE FOLLOWING: (a) the west 80 feet of an easement and (b) all portions of the west 20 feet lot area which do not have a sewer which is 25 feet above the existing grade (it being understood that only the air rights above said 25 feet area are included as to the west 80 feet of the subject parcel).

Property contains 63,097 square feet, or 1.464 acres.

APPROVED FOR THE CITY OF MIAMI BEACH
 COMMUNITY DEVELOPMENT DEPARTMENT
 1001 WASHINGTON AVENUE
 MIAMI BEACH, FLORIDA 33139
 DATE: 08/11/09
 BY: [Signature]

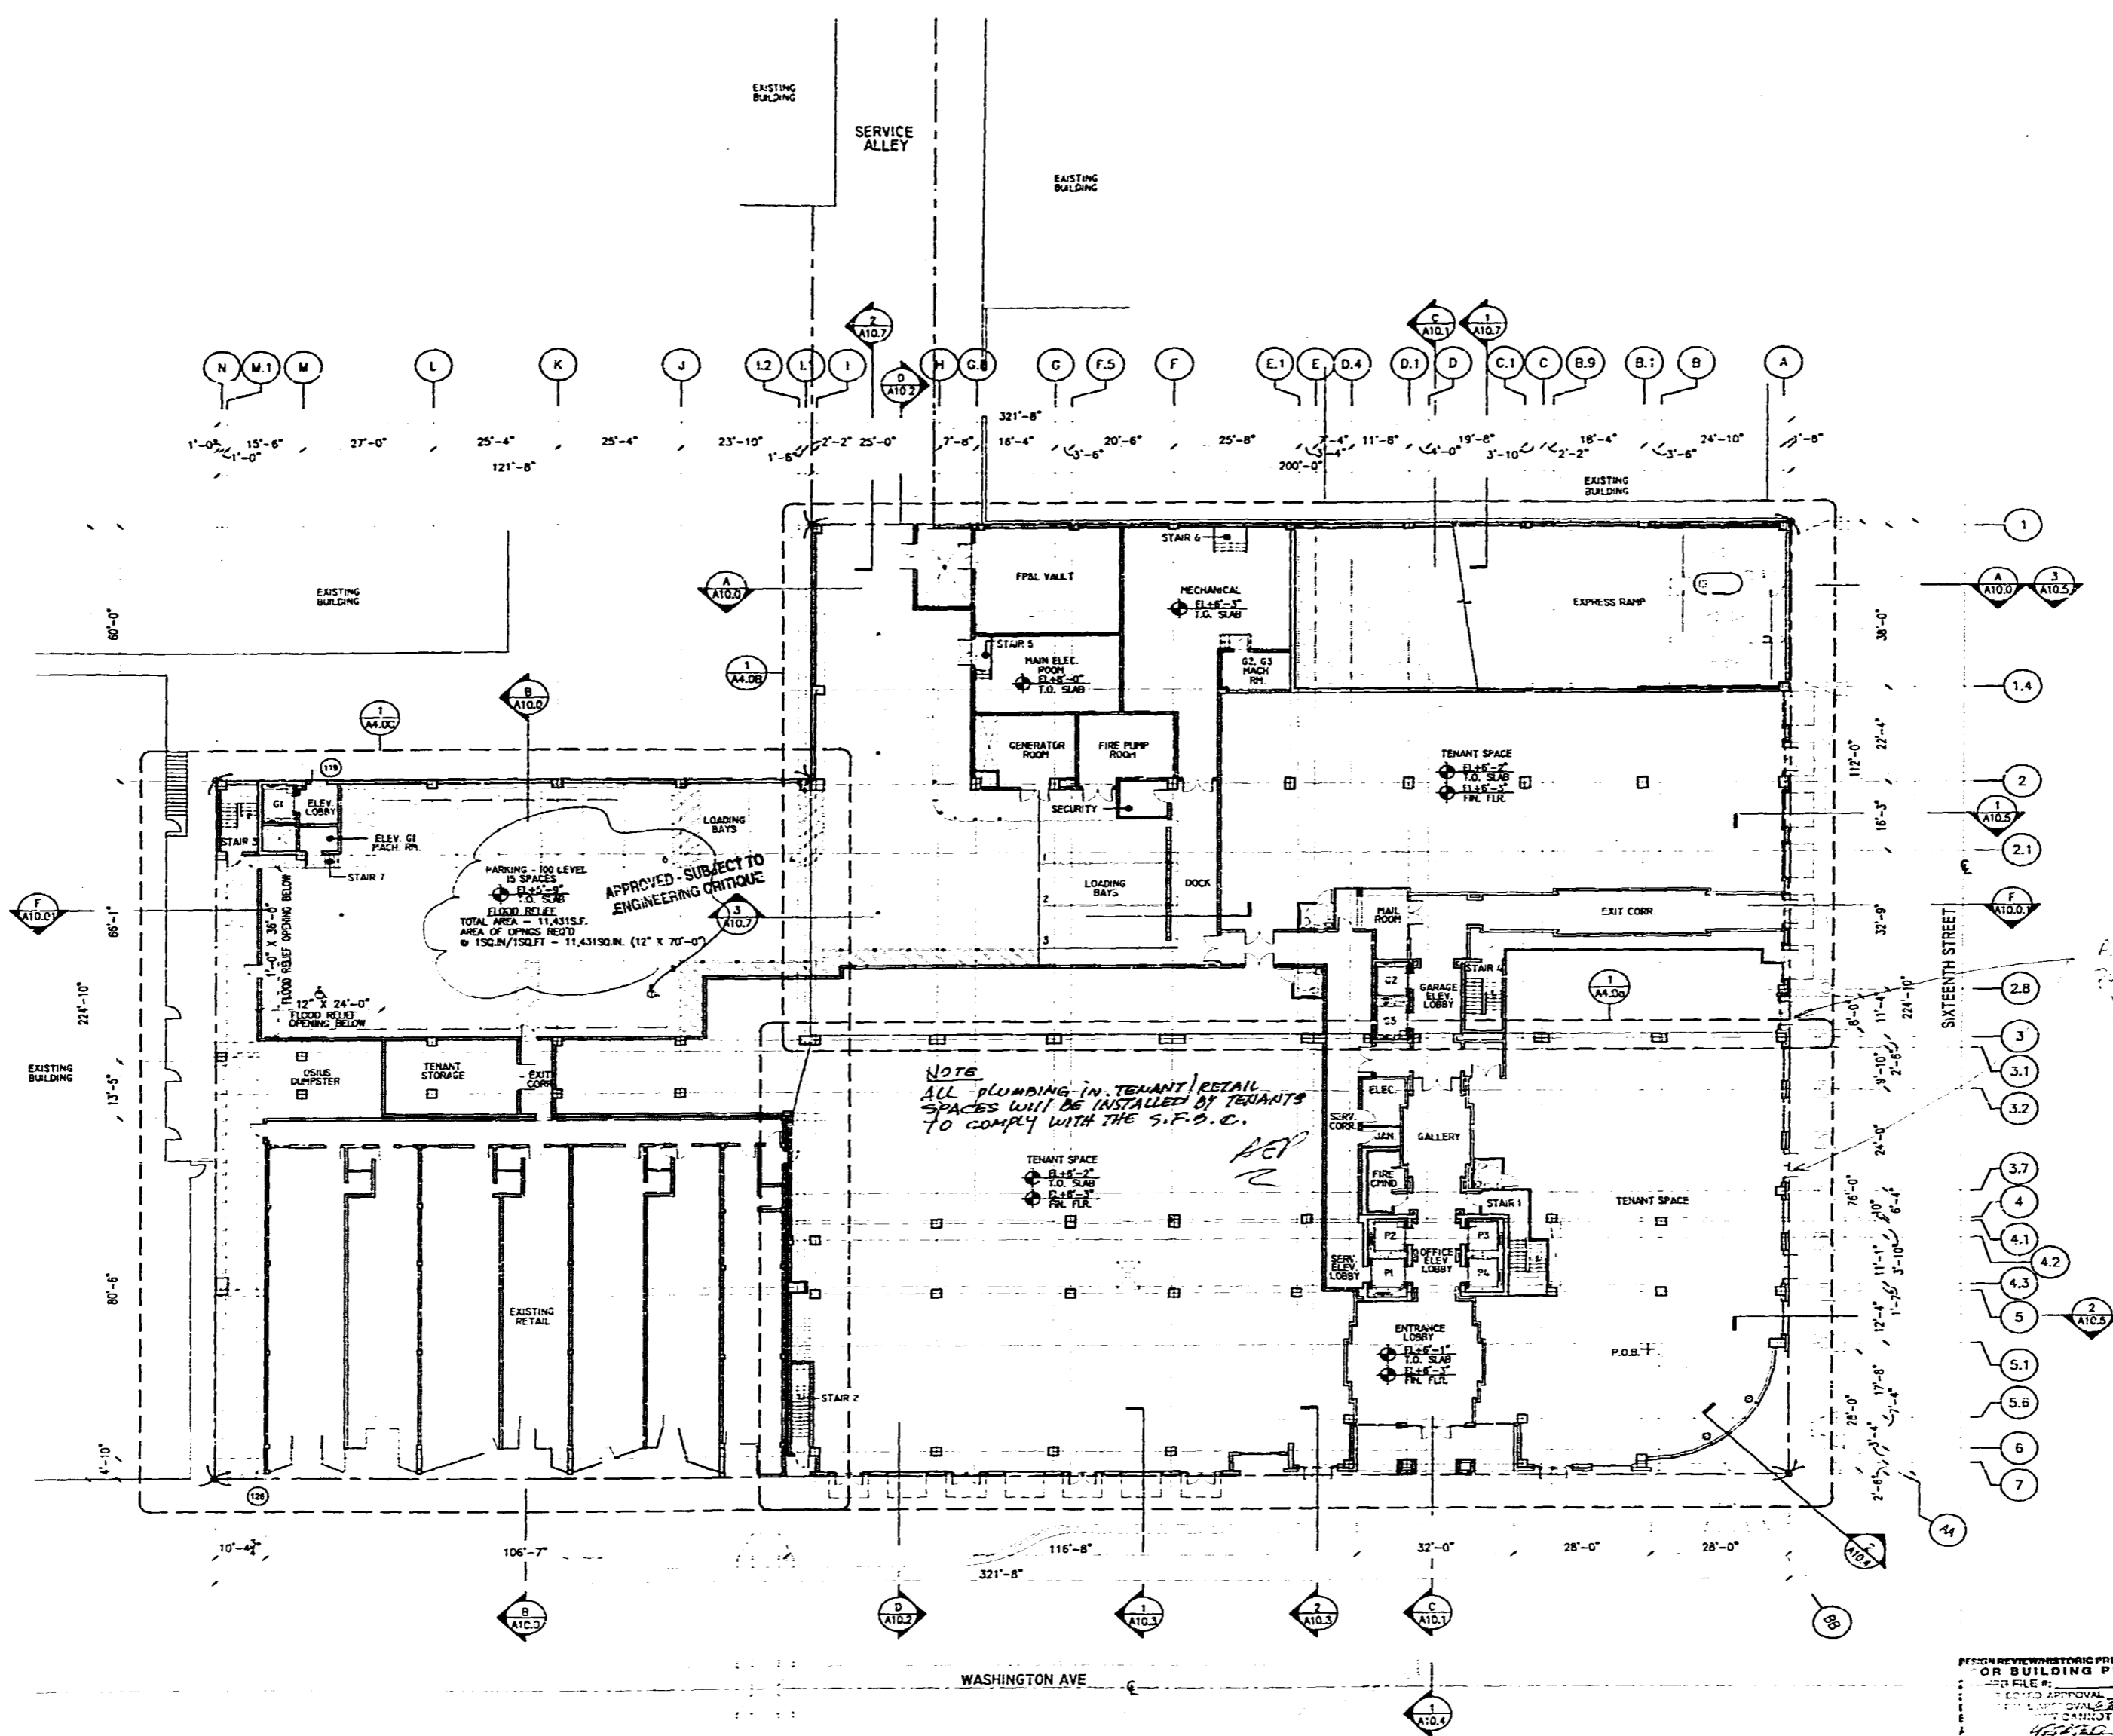

*All doors swing into the
Public Right of Way, must
be approved by the City
Engineer
Please Make Appropriate
Changes
10/20/00*

100 LEVEL FLOOR PLAN
SCALE: 1/16" = 1'-0"

- LEGEND**
- NEW CMU
 - EXISTING CMU TO REMAIN
 - EXISTING CMU TO BE REMOVED

OFFICE COPY
CITY OF MIAMI BEACH
APPROVED FOR PERMIT BY THE FOLLOWING:

PERSON REVIEWING HISTORIC PRESERVATION OR BUILDING PERMIT

FILE # _____

DATE OF APPROVAL _____

DATE OF ISSUE _____

DATE: 10/20/00

PROJECT: 9808

DESIGNED BY: [Signature]

DRAWN BY: [Signature]

CHECKED BY: [Signature]


APPROVED BY: [Signature]

DATE: 10/20/00

NOTE: ALL ELEVATION MARKS REFER TO N.G.V.D.

LINCOLN PLACE
1801 WASHINGTON AVENUE
MIAMI BEACH, FLORIDA

9808
A3.0

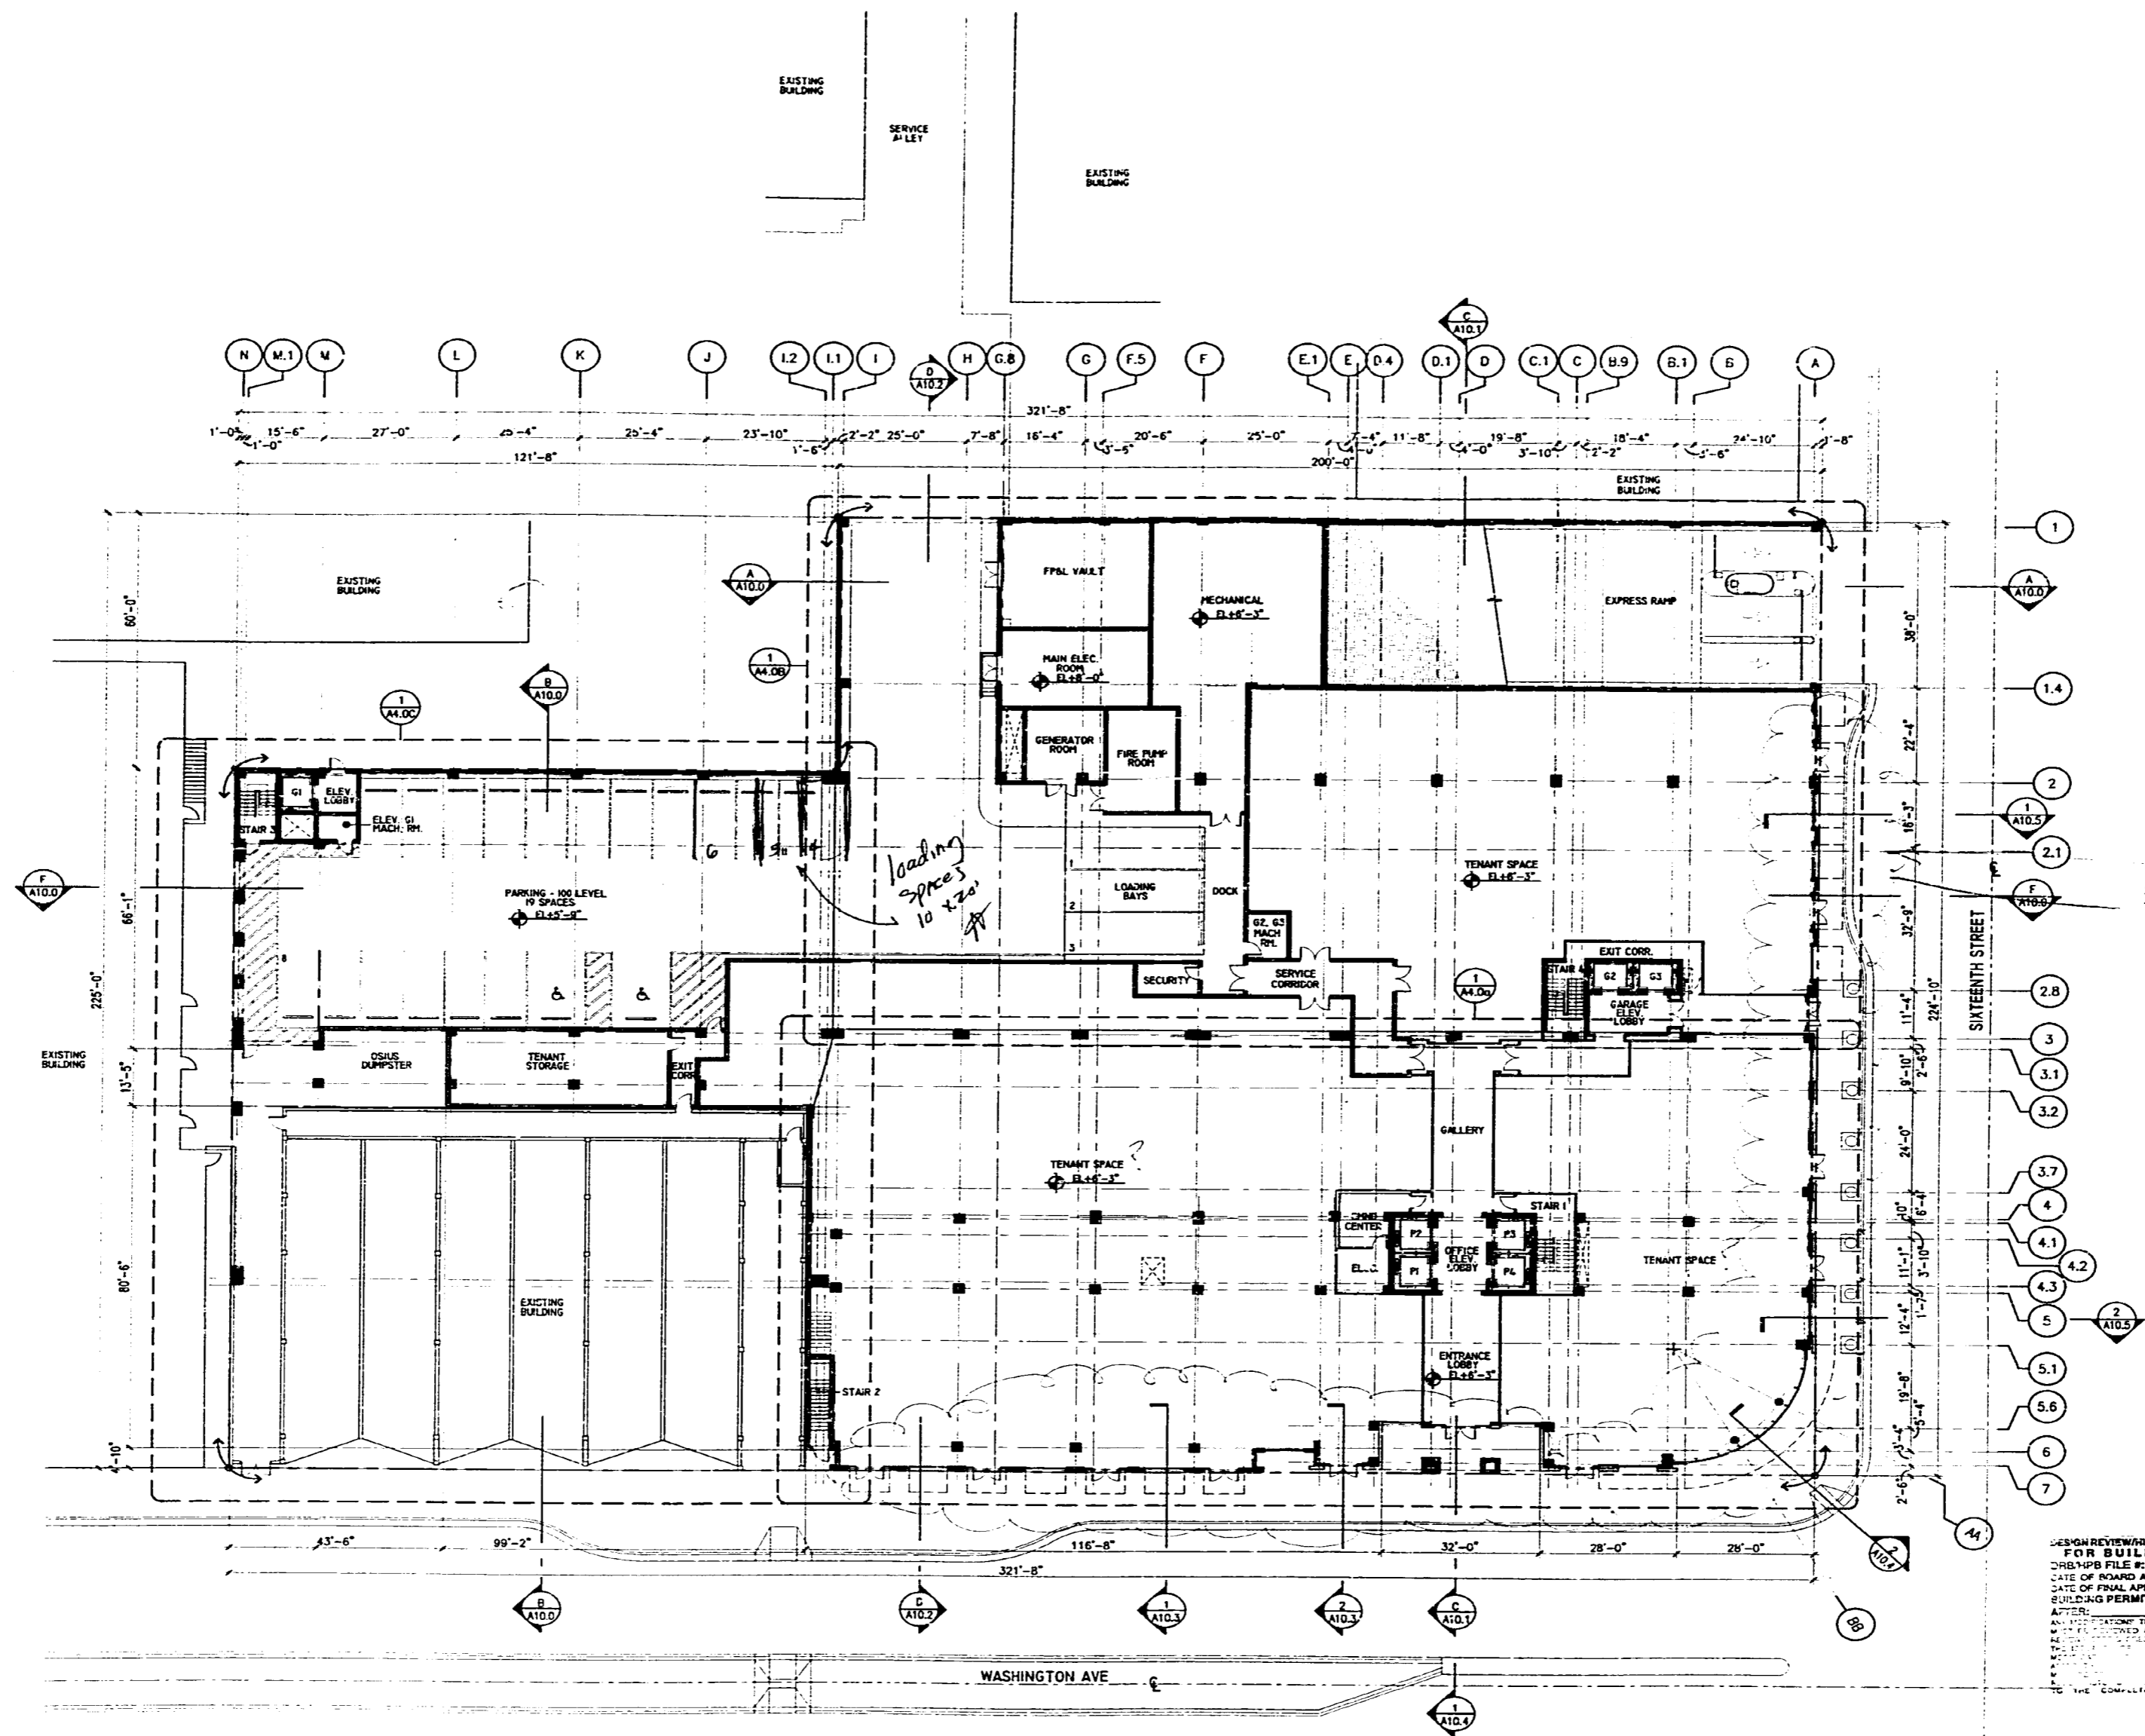

*loading spaces
10 x 20*


*STREET LEVEL DOORS
TO BE RECORDED BACK
OF PROPERTY LINE - ON
SOUTH SIDE SUBJECT TO
FOR APPROVAL
OF CITY
APPROVED AS NOTED
10/10/2000*

REVISIONS

NO.	DESCRIPTION
1	...
2	...
3	...
4	...
5	...
6	...
7	...

**DESIGN REVIEW/HISTORIC PRESERVATION
FOR BUILDING PERMIT**
DRB/HPB FILE # _____
DATE OF BOARD APPROVAL _____ BY _____
BUILDING PERMIT CANNOT BE ISSUED
UNTIL _____
APPLICANT'S ATTENTION TO THESE FRAMING
REQUIREMENTS AND APPROVED BY THE
COMMISSIONER OF THE DEPARTMENT OF
CITY PLANNING AND DEVELOPMENT

100 LEVEL FLOOR PLAN
SCALE: 1/16" = 1'-0"

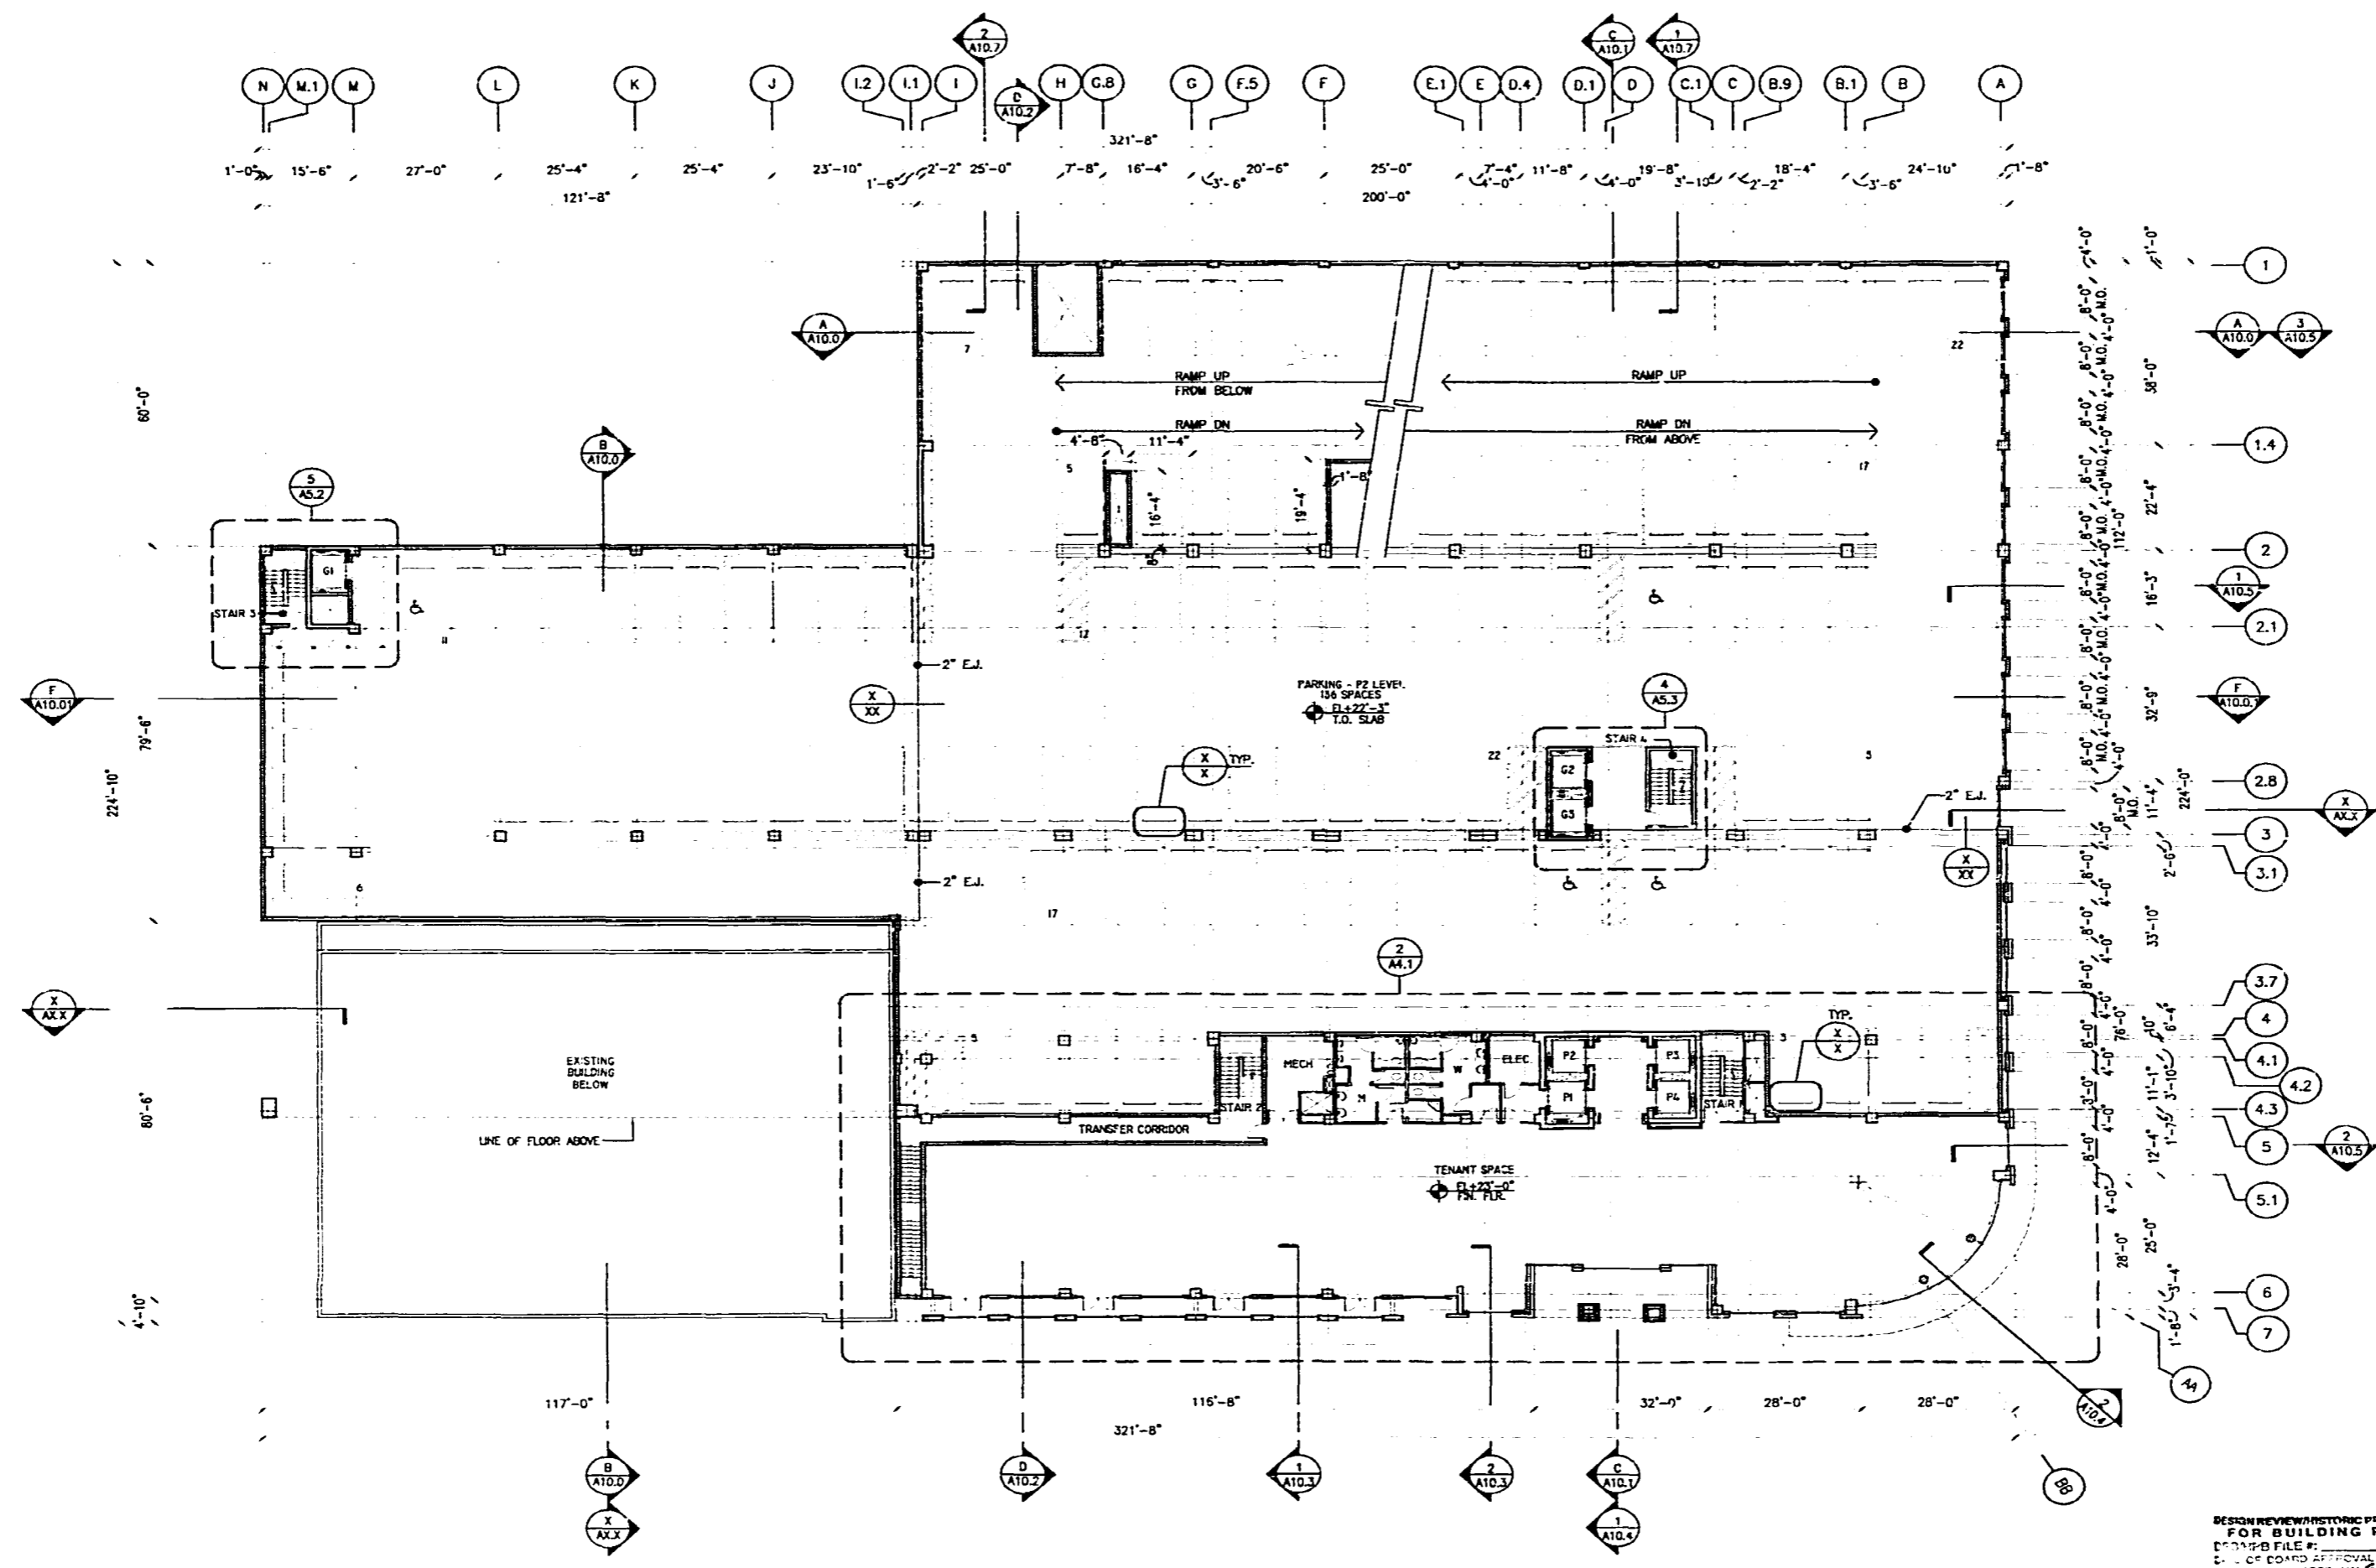

200 LEVEL FLOOR PLAN
SCALE: 1/16" = 1'-0"

**DESIGN REVIEW AND RECORD PRESERVATION
FOR BUILDING PERMIT**
BY: [Signature]
DATE: 8/20/2000

OFFICE COPY
CITY OF MIAMI BEACH
APPROVED FOR PERMIT BY THE FOLLOWING:

BLDG. REVIEW	[Signature]
ZONING	[Signature]
PLANNING	[Signature]
ELECTRICAL	[Signature]
MUNICIPAL	[Signature]
FIRE PREVENTION	[Signature]
ENGINEERING	[Signature]
PUBLIC WORKS	[Signature]
STRUCTURAL	[Signature]
ACCESSIBILITY	[Signature]
ELEVATOR	[Signature]


NOTE: ALL ELEVATION MARKS REFER TO N.G.V.D.

LINCOLN PLACE
1801 WASHINGTON AVENUE
MIAMI BEACH, FLORIDA

PROJECT NO. 00-02-02

9808

A3.1

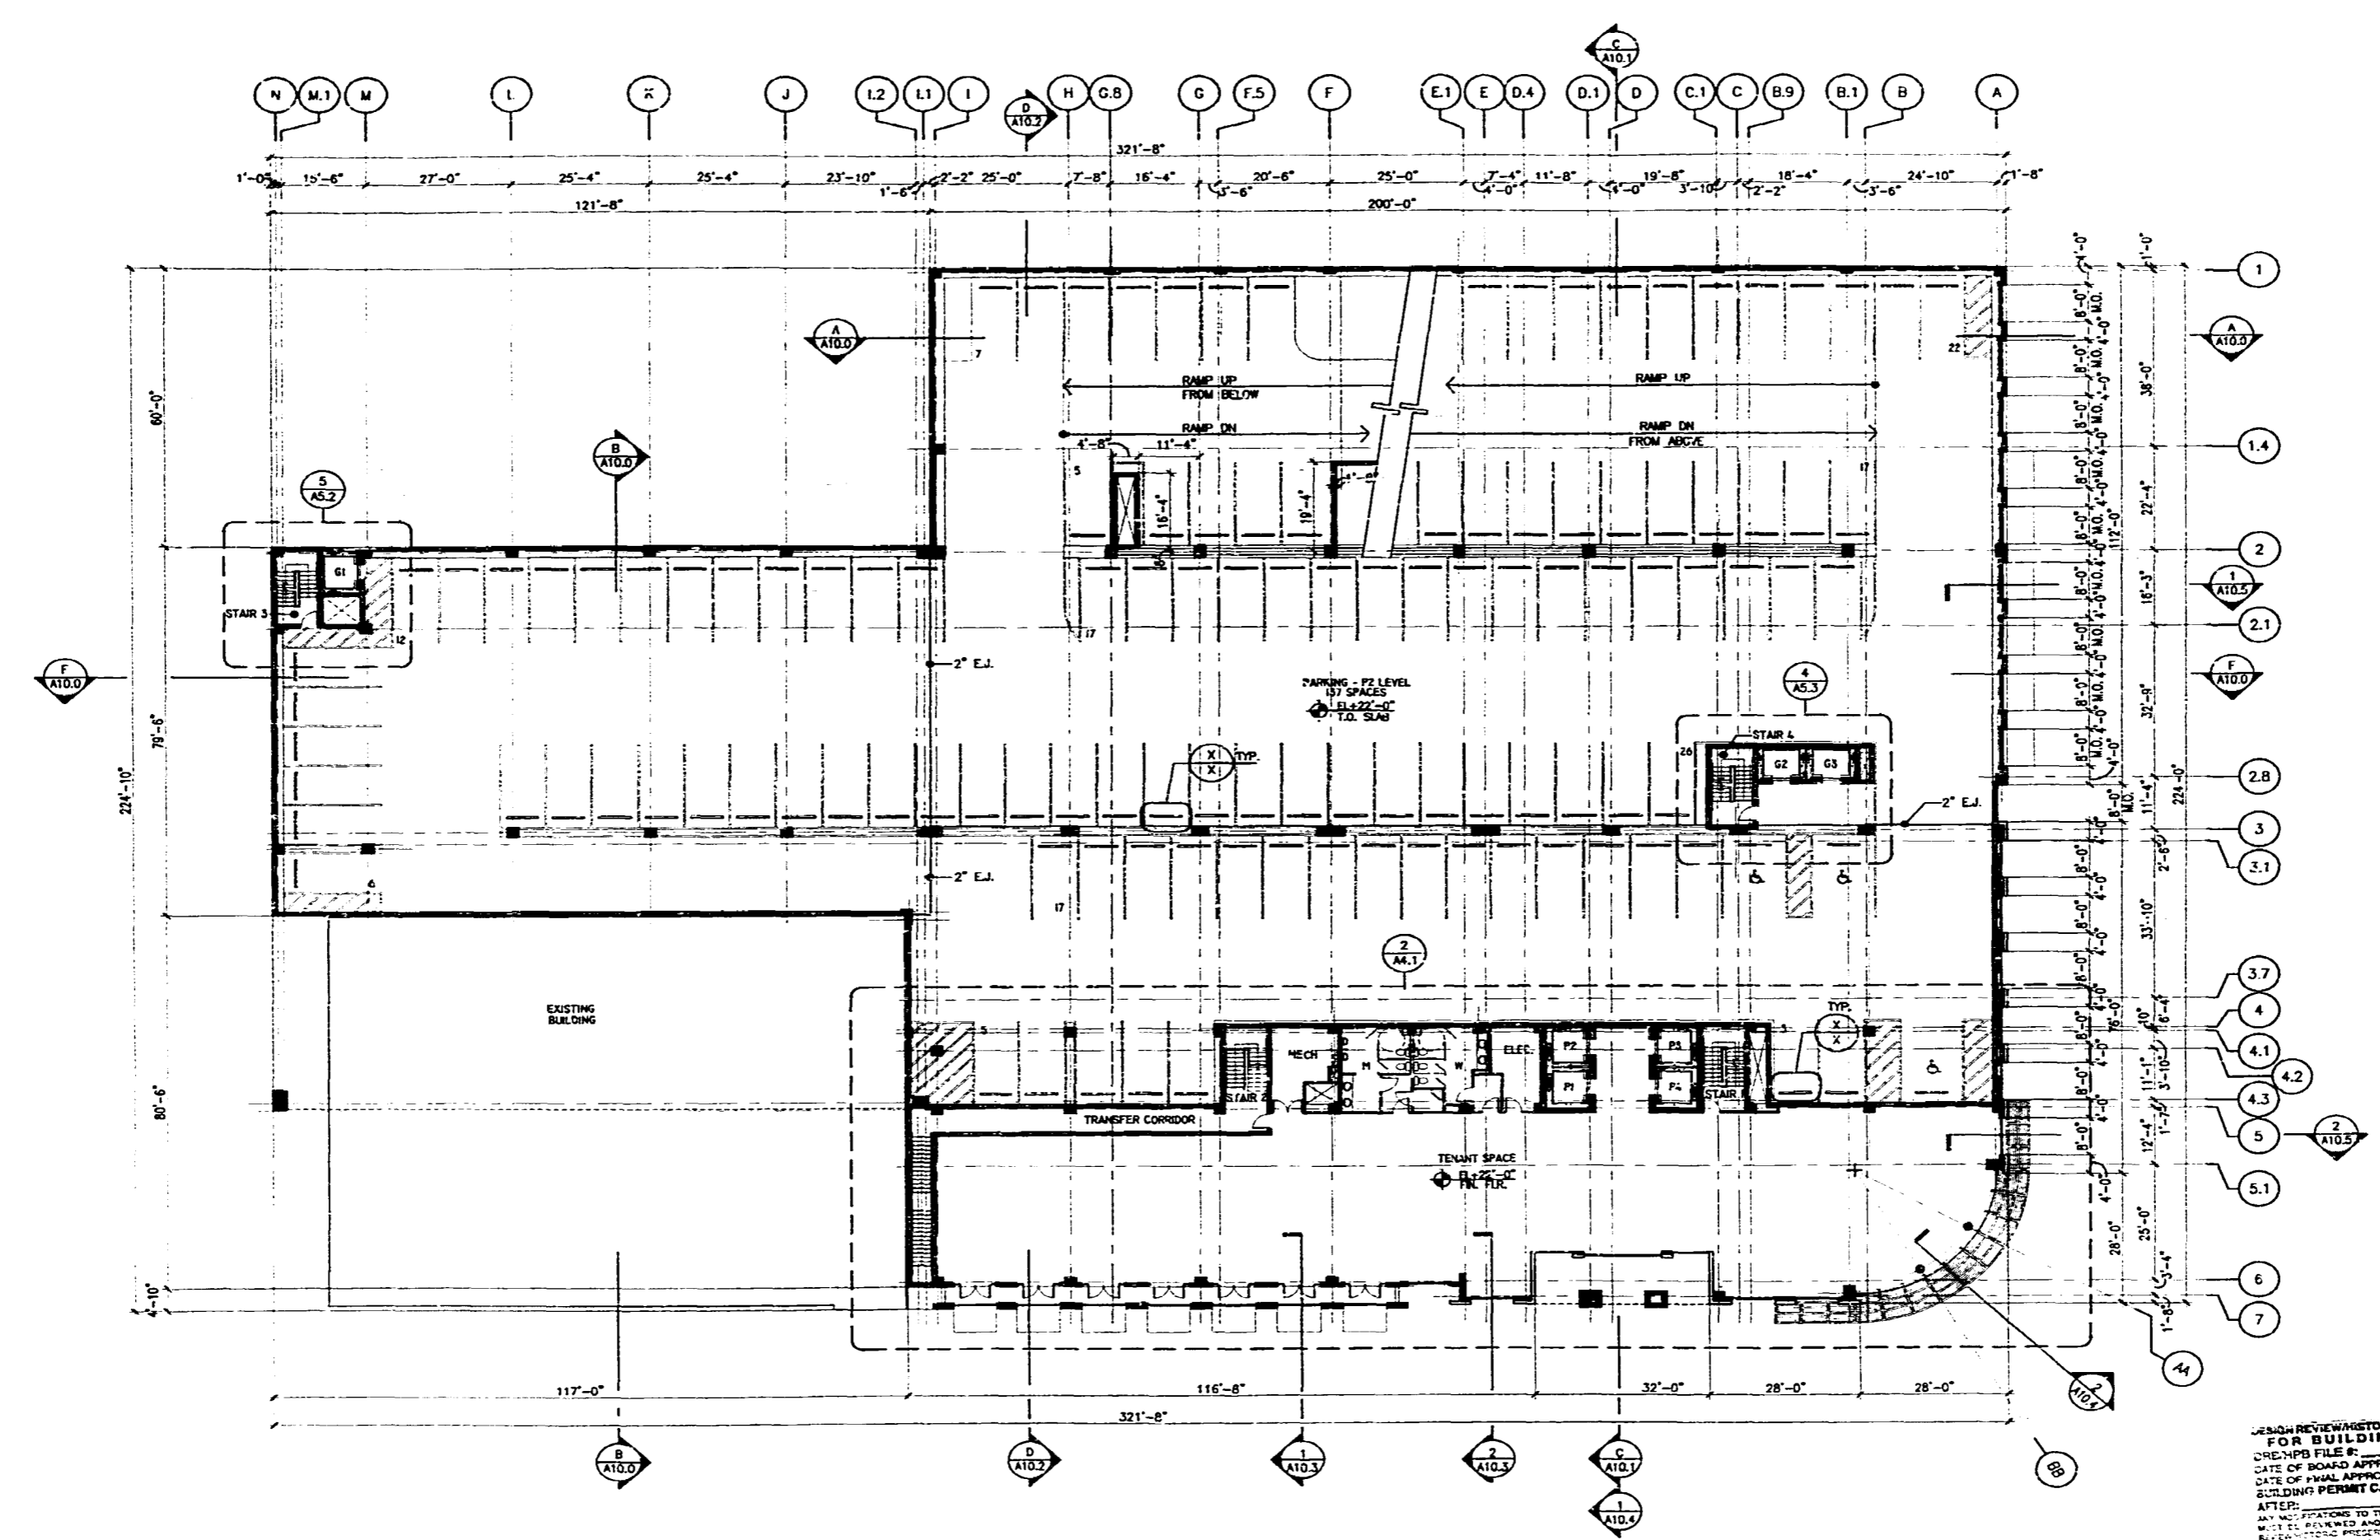

200 LEVEL FLOOR PLAN
SCALE: 1/16" = 1'-0"

OFFICE COPY


APPROVED FOR PERMIT BY
 PROFESSIONAL ENGINEER
 DATE: 11/11/11
 PROJECT NO. 1111111111
 ENGINEER: [Signature]
 APPROVED SUBJECT TO
 PUBLIC ENGINEERING CRITIQUE

**RECORD REVIEWING ENGINEER'S PRESERVATION
FOR BUILDING PERMIT**
 ORIGINAL FILE #:
 DATE OF BOARD APPROVAL: _____
 DATE OF FINAL APPROVAL: _____
 BUILDING PERMIT CANNOT BE ISSUED
 AFTER:
 ANY MODIFICATIONS TO THESE PERMIT DRAWINGS
 ARE MADE, UNLESS THEY ARE APPROVED BY THE
 RECORD REVIEWING ENGINEER. THESE PERMIT
 DRAWINGS ARE NOT TO BE USED FOR ANY OTHER
 PROJECTS WITHOUT THE WRITTEN CONSENT OF
 THE ENGINEER OF RECORD.

LINCOLN PLACE
 1801 WASHINGTON AVENUE
 MIAMI BEACH, FLORIDA

9808

A3.1

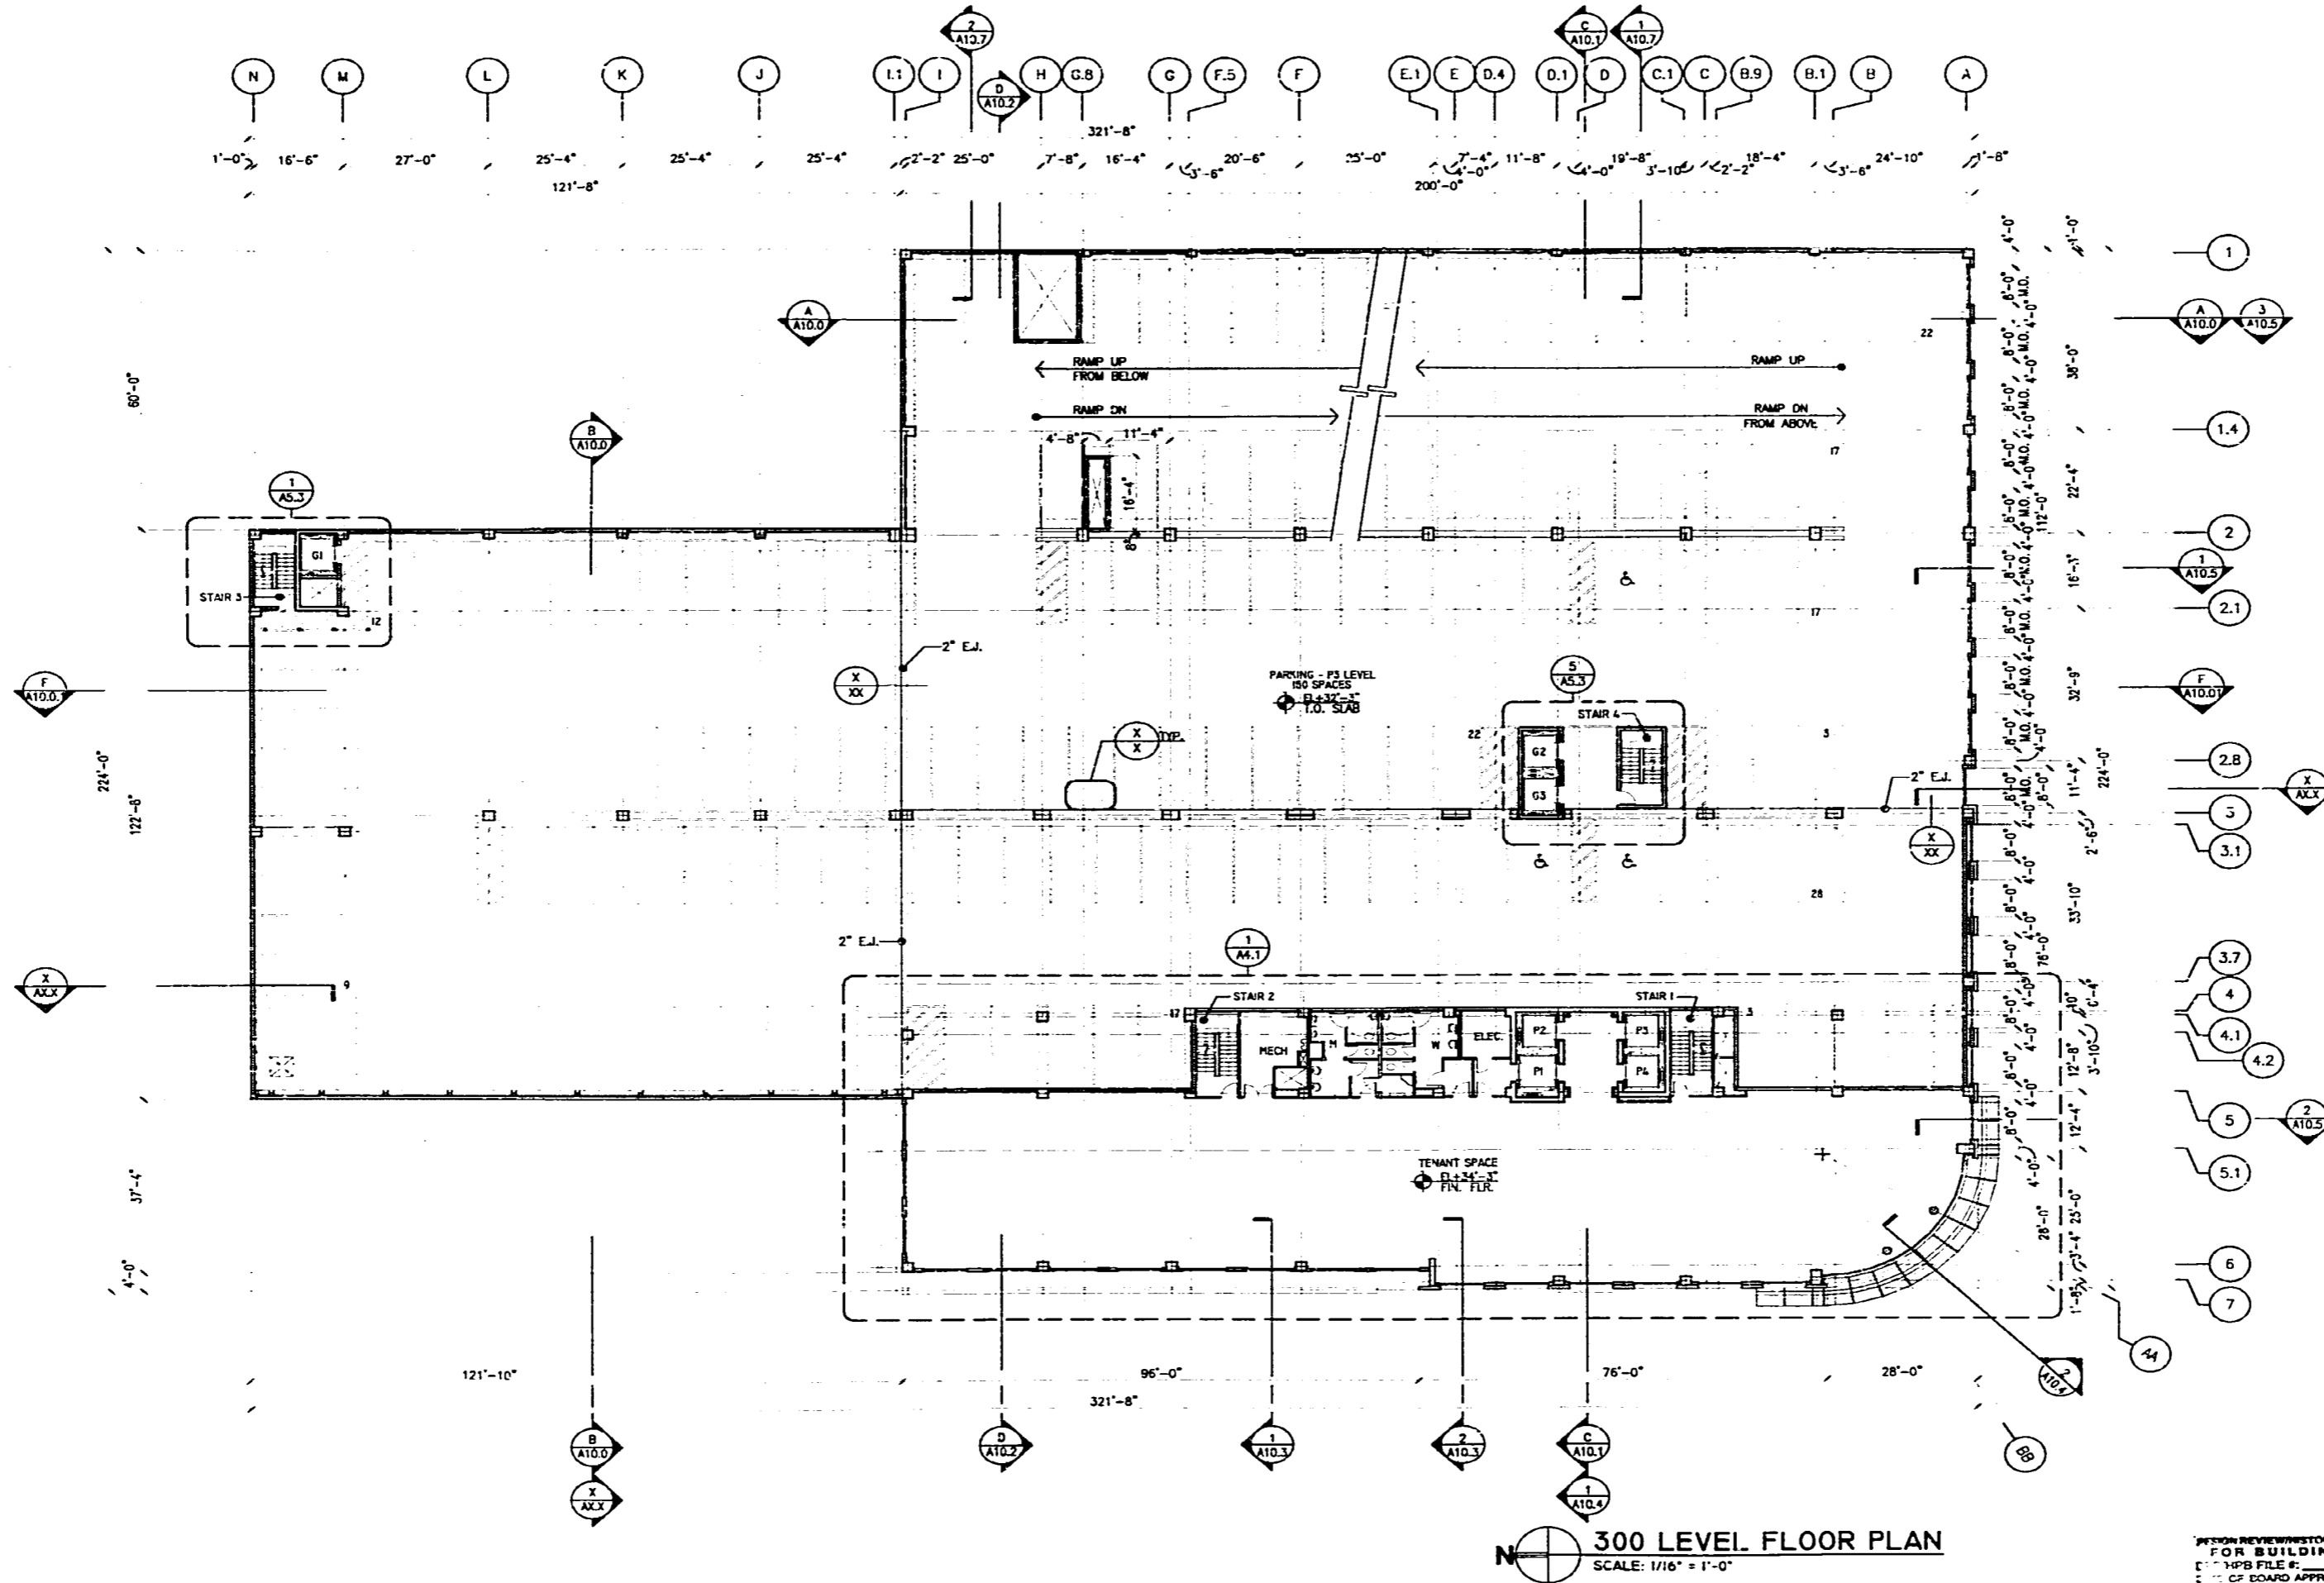

300 LEVEL FLOOR PLAN
SCALE: 1/16" = 1'-0"

PERFORM REVIEW WITHIN 30 DAYS OF RECEIPT FOR BUILDING PERMIT
FOR BUILDING PERMIT APPROVAL
IF ALL APPROVALS ARE NOT RECEIVED WITHIN 30 DAYS, THE PERMIT SHALL BE WITHDRAWN AND A RE-APPROVAL FEE SHALL BE REQUIRED.
IF THE PERMIT IS WITHDRAWN, THE APPLICANT SHALL BE RESPONSIBLE FOR RE-APPROVAL AND ALL FEES ASSOCIATED THEREWITH.
IF THE PERMIT IS WITHDRAWN, THE APPLICANT SHALL BE RESPONSIBLE FOR RE-APPROVAL AND ALL FEES ASSOCIATED THEREWITH.


OFFICE COPY
CITY OF MIAMI BEACH
APPROVED FOR PERMIT BY THE FOLLOWING:
APPROVED FOR PERMIT BY THE FOLLOWING:
PROJECT TITLE	
DATE	08-07-02
NO.	
NO.	
9808

A3.2

NOTE: ALL ELEVATION MARKS REFER TO N.G.V.D.

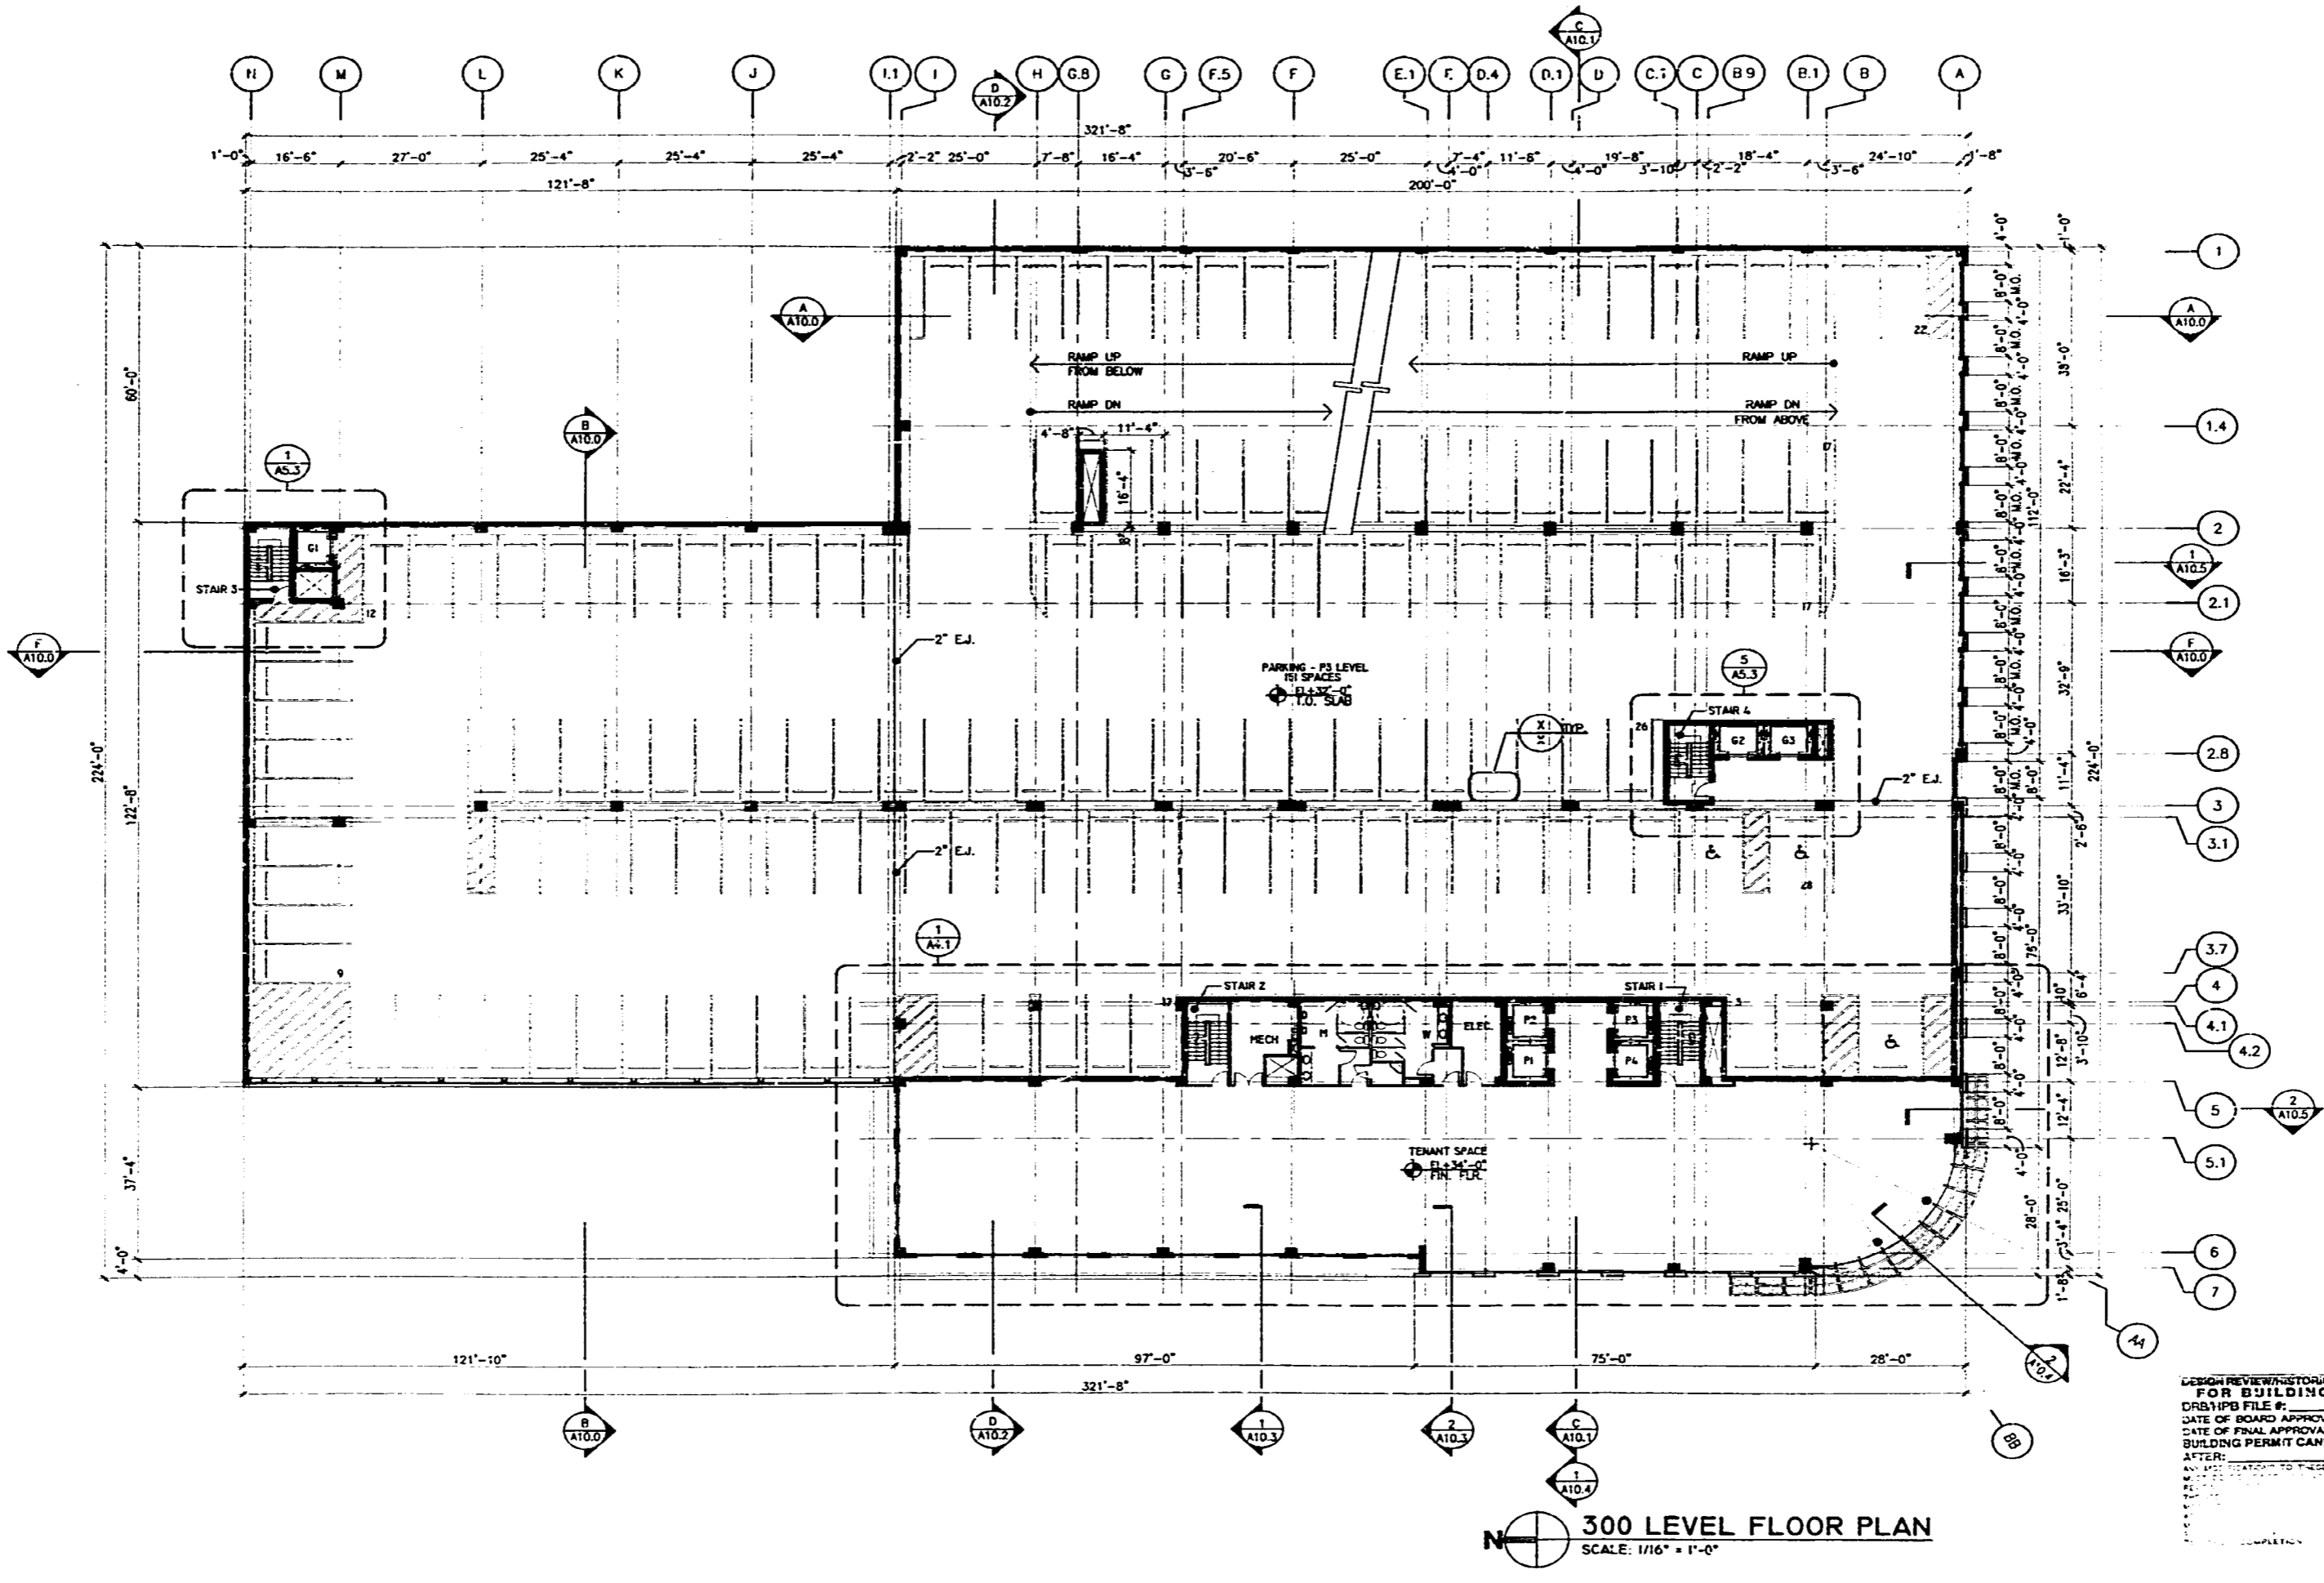


300 LEVEL FLOOR PLAN
SCALE: 1/16" = 1'-0"

DESIGN REVIEW HISTORIC PRESERVATION
FOR BUILDING PERMIT
DRAWING FILE #:
DATE OF BOARD APPROVAL:
DATE OF FINAL APPROVAL: _____ BY _____
BUILDING PERMIT CANNOT BE ISSUED
AFTER:
EXPIRES: _____
REVISIONS TO THESE CONDITIONS: _____
DATE: _____

APPROVED FOR SUBMITTAL
[Signature]
ARCHITECT SUBJECT TO
ENGINEER'S CRITIQUE

LINCOLN PLACE
1601 WASHINGTON AVENUE
MIAMI BEACH FLORIDA

9808
A3.2

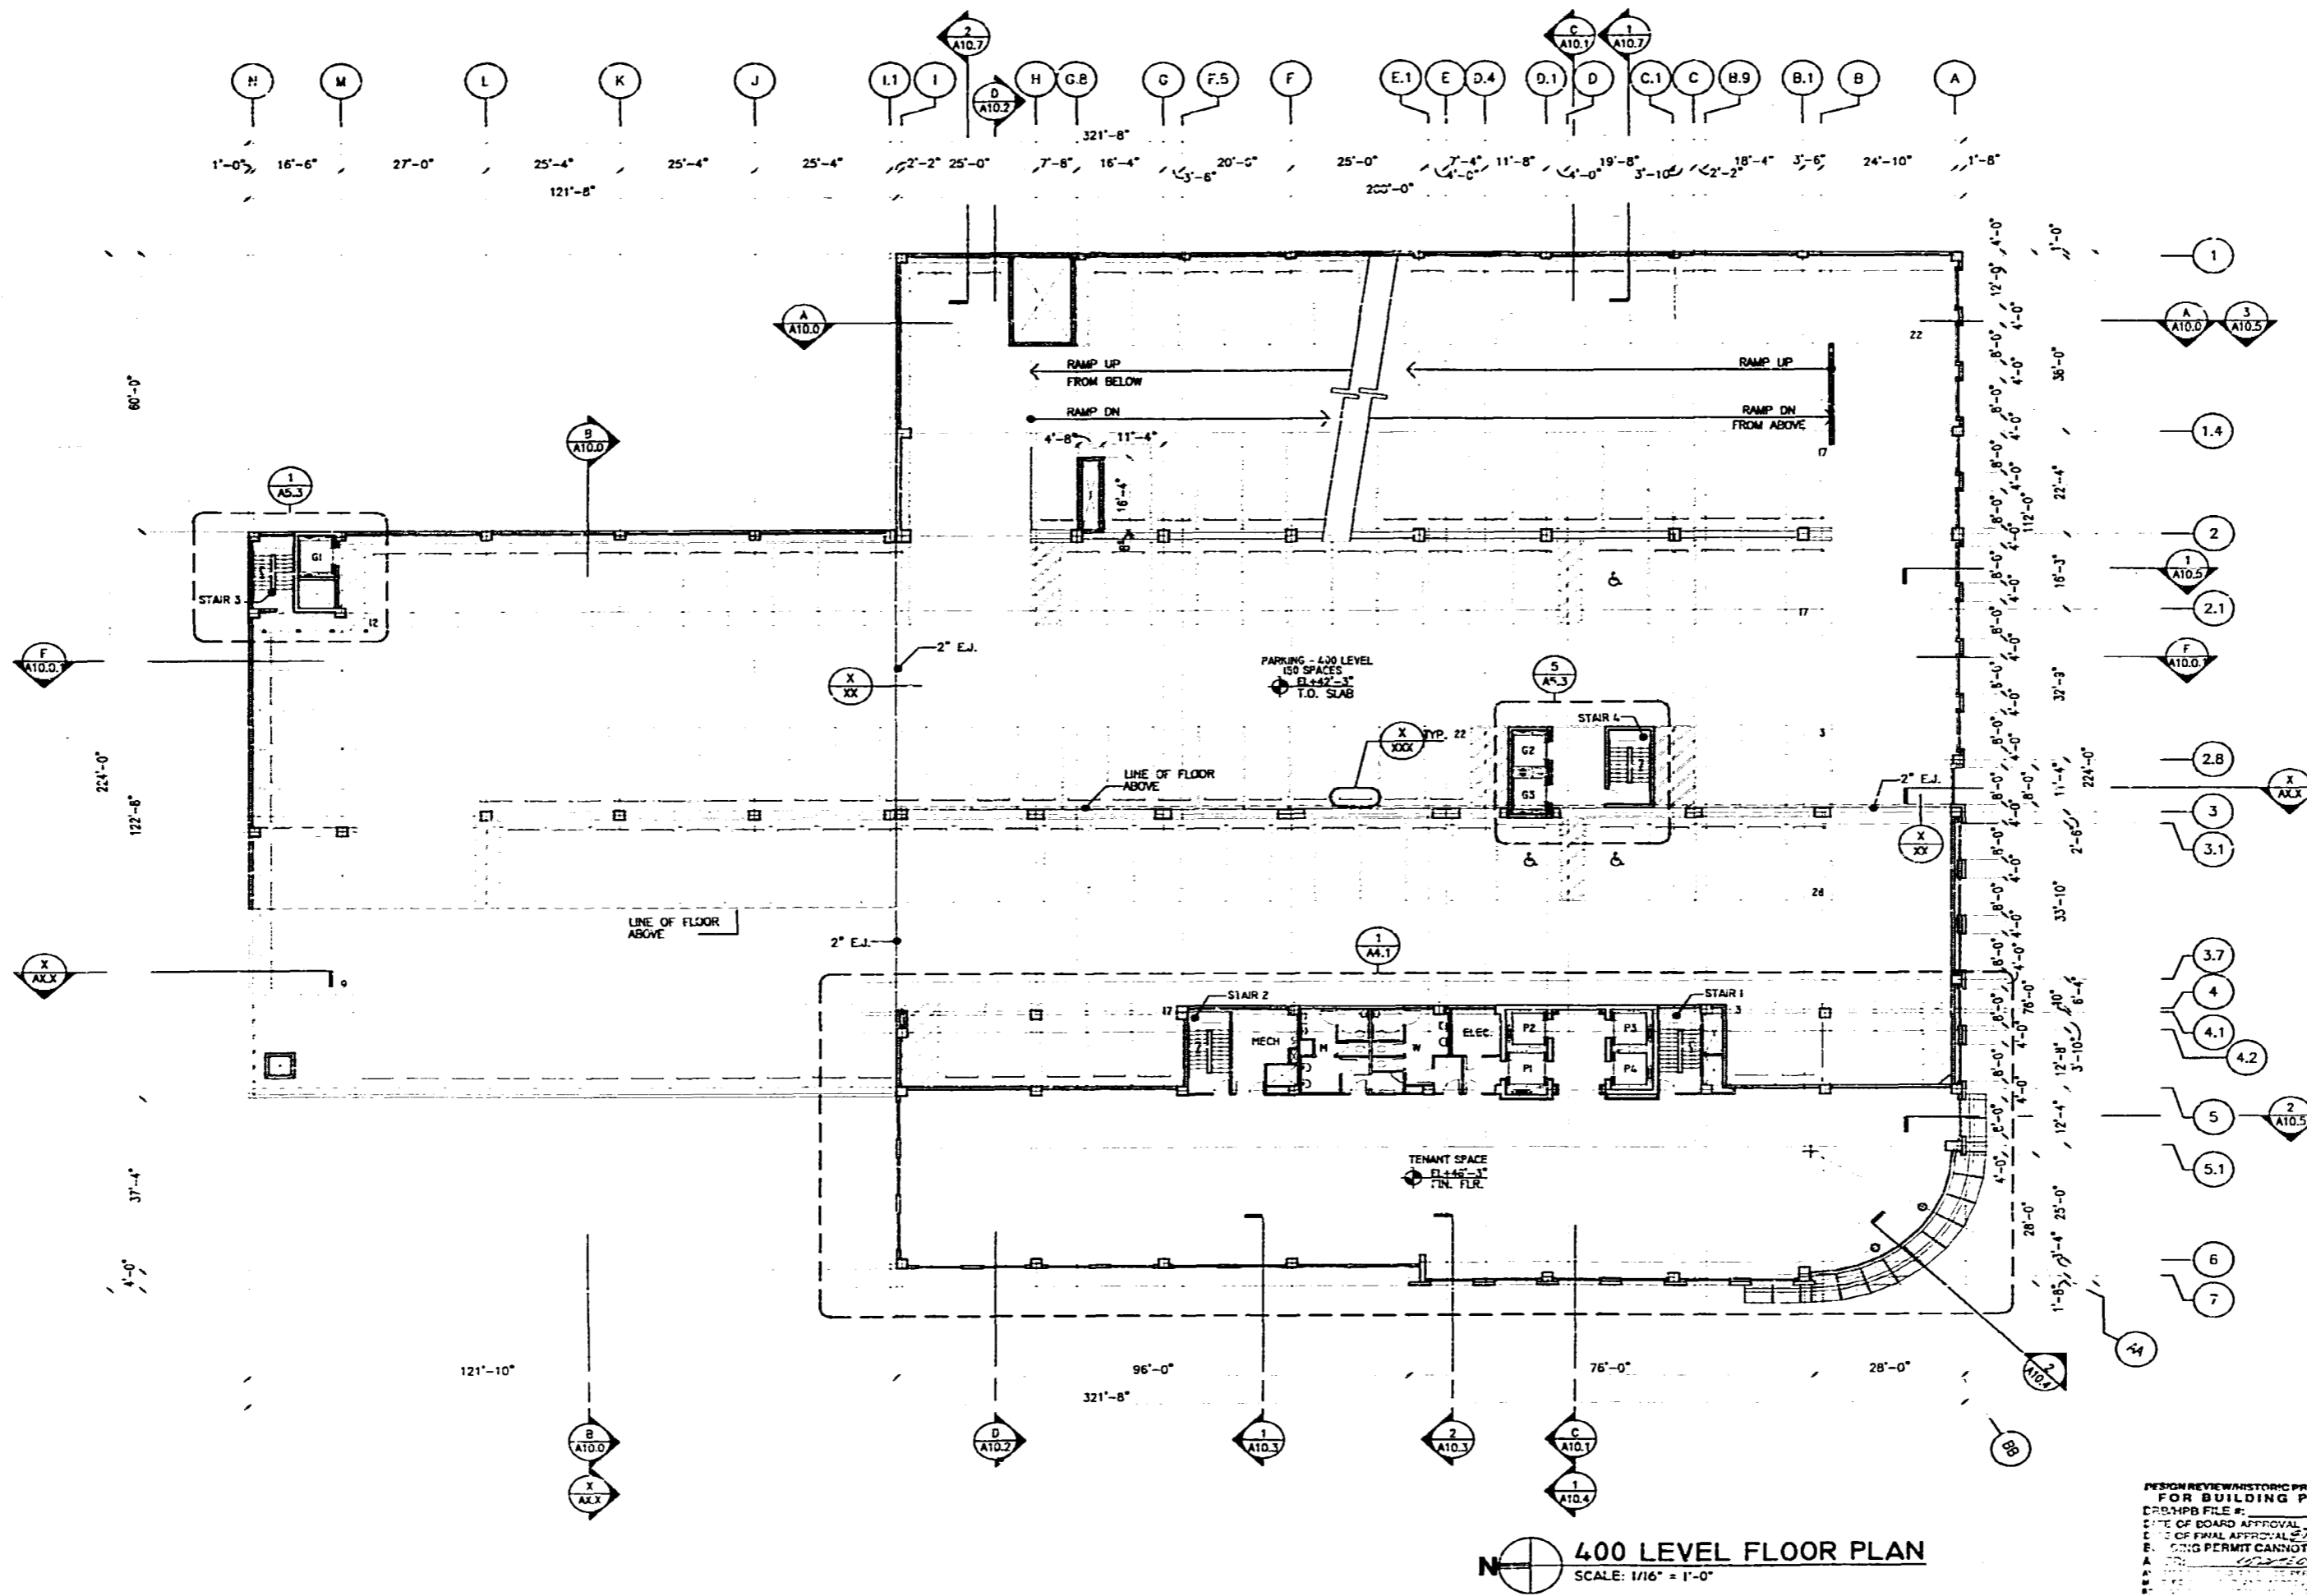


400 LEVEL FLOOR PLAN
SCALE: 1/16" = 1'-0"

**PERSON REVIEW HISTORIC PRESERVATION
FOR BUILDING PERMIT**
DRAWING FILE #:
DATE OF BOARD APPROVAL: 2/22/2007
DATE OF FINAL APPROVAL: 2/22/2007
BUILDING PERMIT CANNOT BE ISSUED
A. [Signature]
B. [Signature]
C. [Signature]
D. [Signature]
E. [Signature]
F. [Signature]
G. [Signature]
H. [Signature]
I. [Signature]
J. [Signature]
K. [Signature]
L. [Signature]
M. [Signature]

OFFICE COPY
CITY OF MIAMI BEACH
APPROVED FOR PERMIT BY THE FOLLOWING:
SEAL: [Signature]
DATE: 2/22/2007
APPROVED FOR PERMIT BY THE FOLLOWING:
ENGINEER: [Signature]
ARCHITECT: [Signature]
PLUMBING: [Signature]
ELECTRICAL: [Signature]
MECHANICAL: [Signature]
ELEVATOR: [Signature]

NOTE: ALL ELEVATION MARKS REFER TO N.G.V.D.

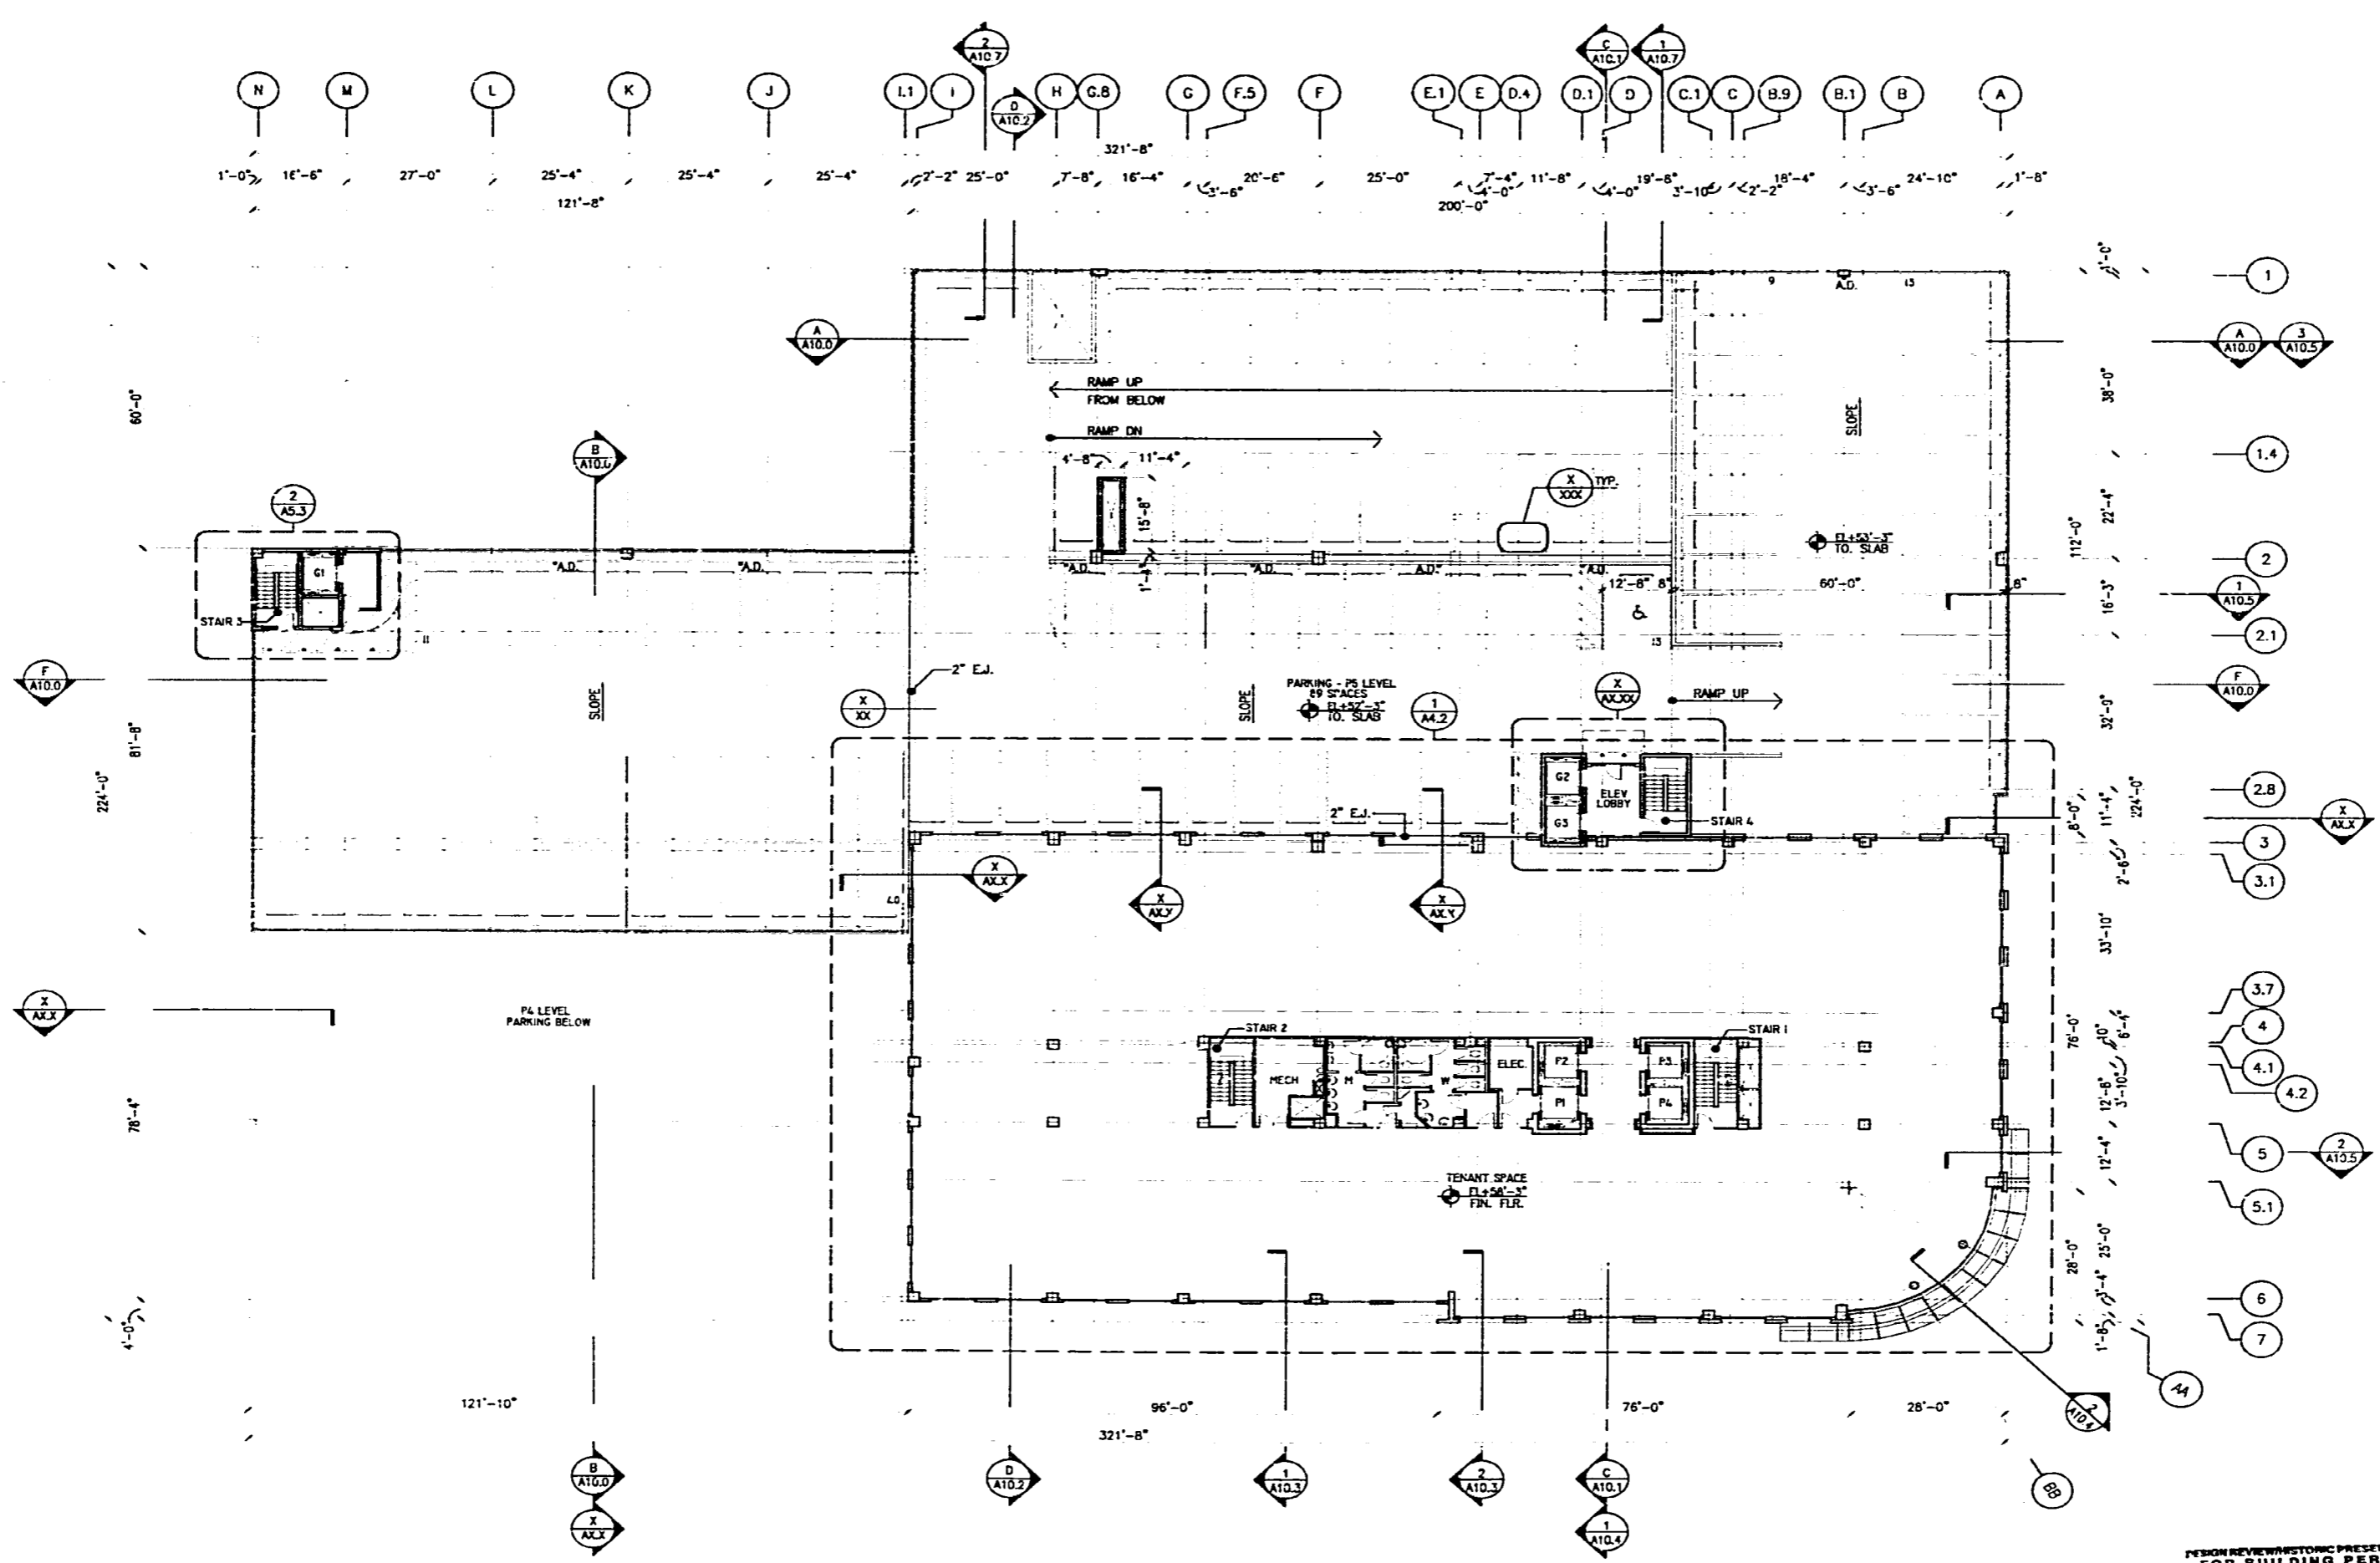

500 LEVEL FLOOR PLAN
SCALE: 1/16" = 1'-0"

**NEIGH REVEREHISTORIC PRESERVATION
FOR BUILDING PERMIT**
DESIGNER FILE #
DATE OF BOARD APPROVAL
DATE OF FINAL APPROVAL
BUILDING PERMIT CANNOT BE ISSUED
A: []
B: []
C: []
D: []
E: []
F: []
G: []
H: []
I: []
J: []
K: []
L: []
M: []
N: []
O: []
P: []
Q: []
R: []
S: []
T: []
U: []
V: []
W: []
X: []
Y: []
Z: []


OFFICE COPY
CITY OF MIAMI BEACH
APPROVED FOR PERMIT BY
THE FOLLOWING:

BUILDING	[Signature]
ZONING	[Signature]
PLANNING	[Signature]
ENVIRONMENTAL	[Signature]
PUBLIC WORKS	[Signature]
STRUCTURAL	[Signature]
ACCESSIBILITY	[Signature]
ELEVATOR	[Signature]

LINCOLN PLACE
1601 WASHINGTON AVENUE
MIAMI BEACH FLORIDA

9808
A3.4

NOTE: ALL ELEVATION MARKS REFER TO N.G.V.D.

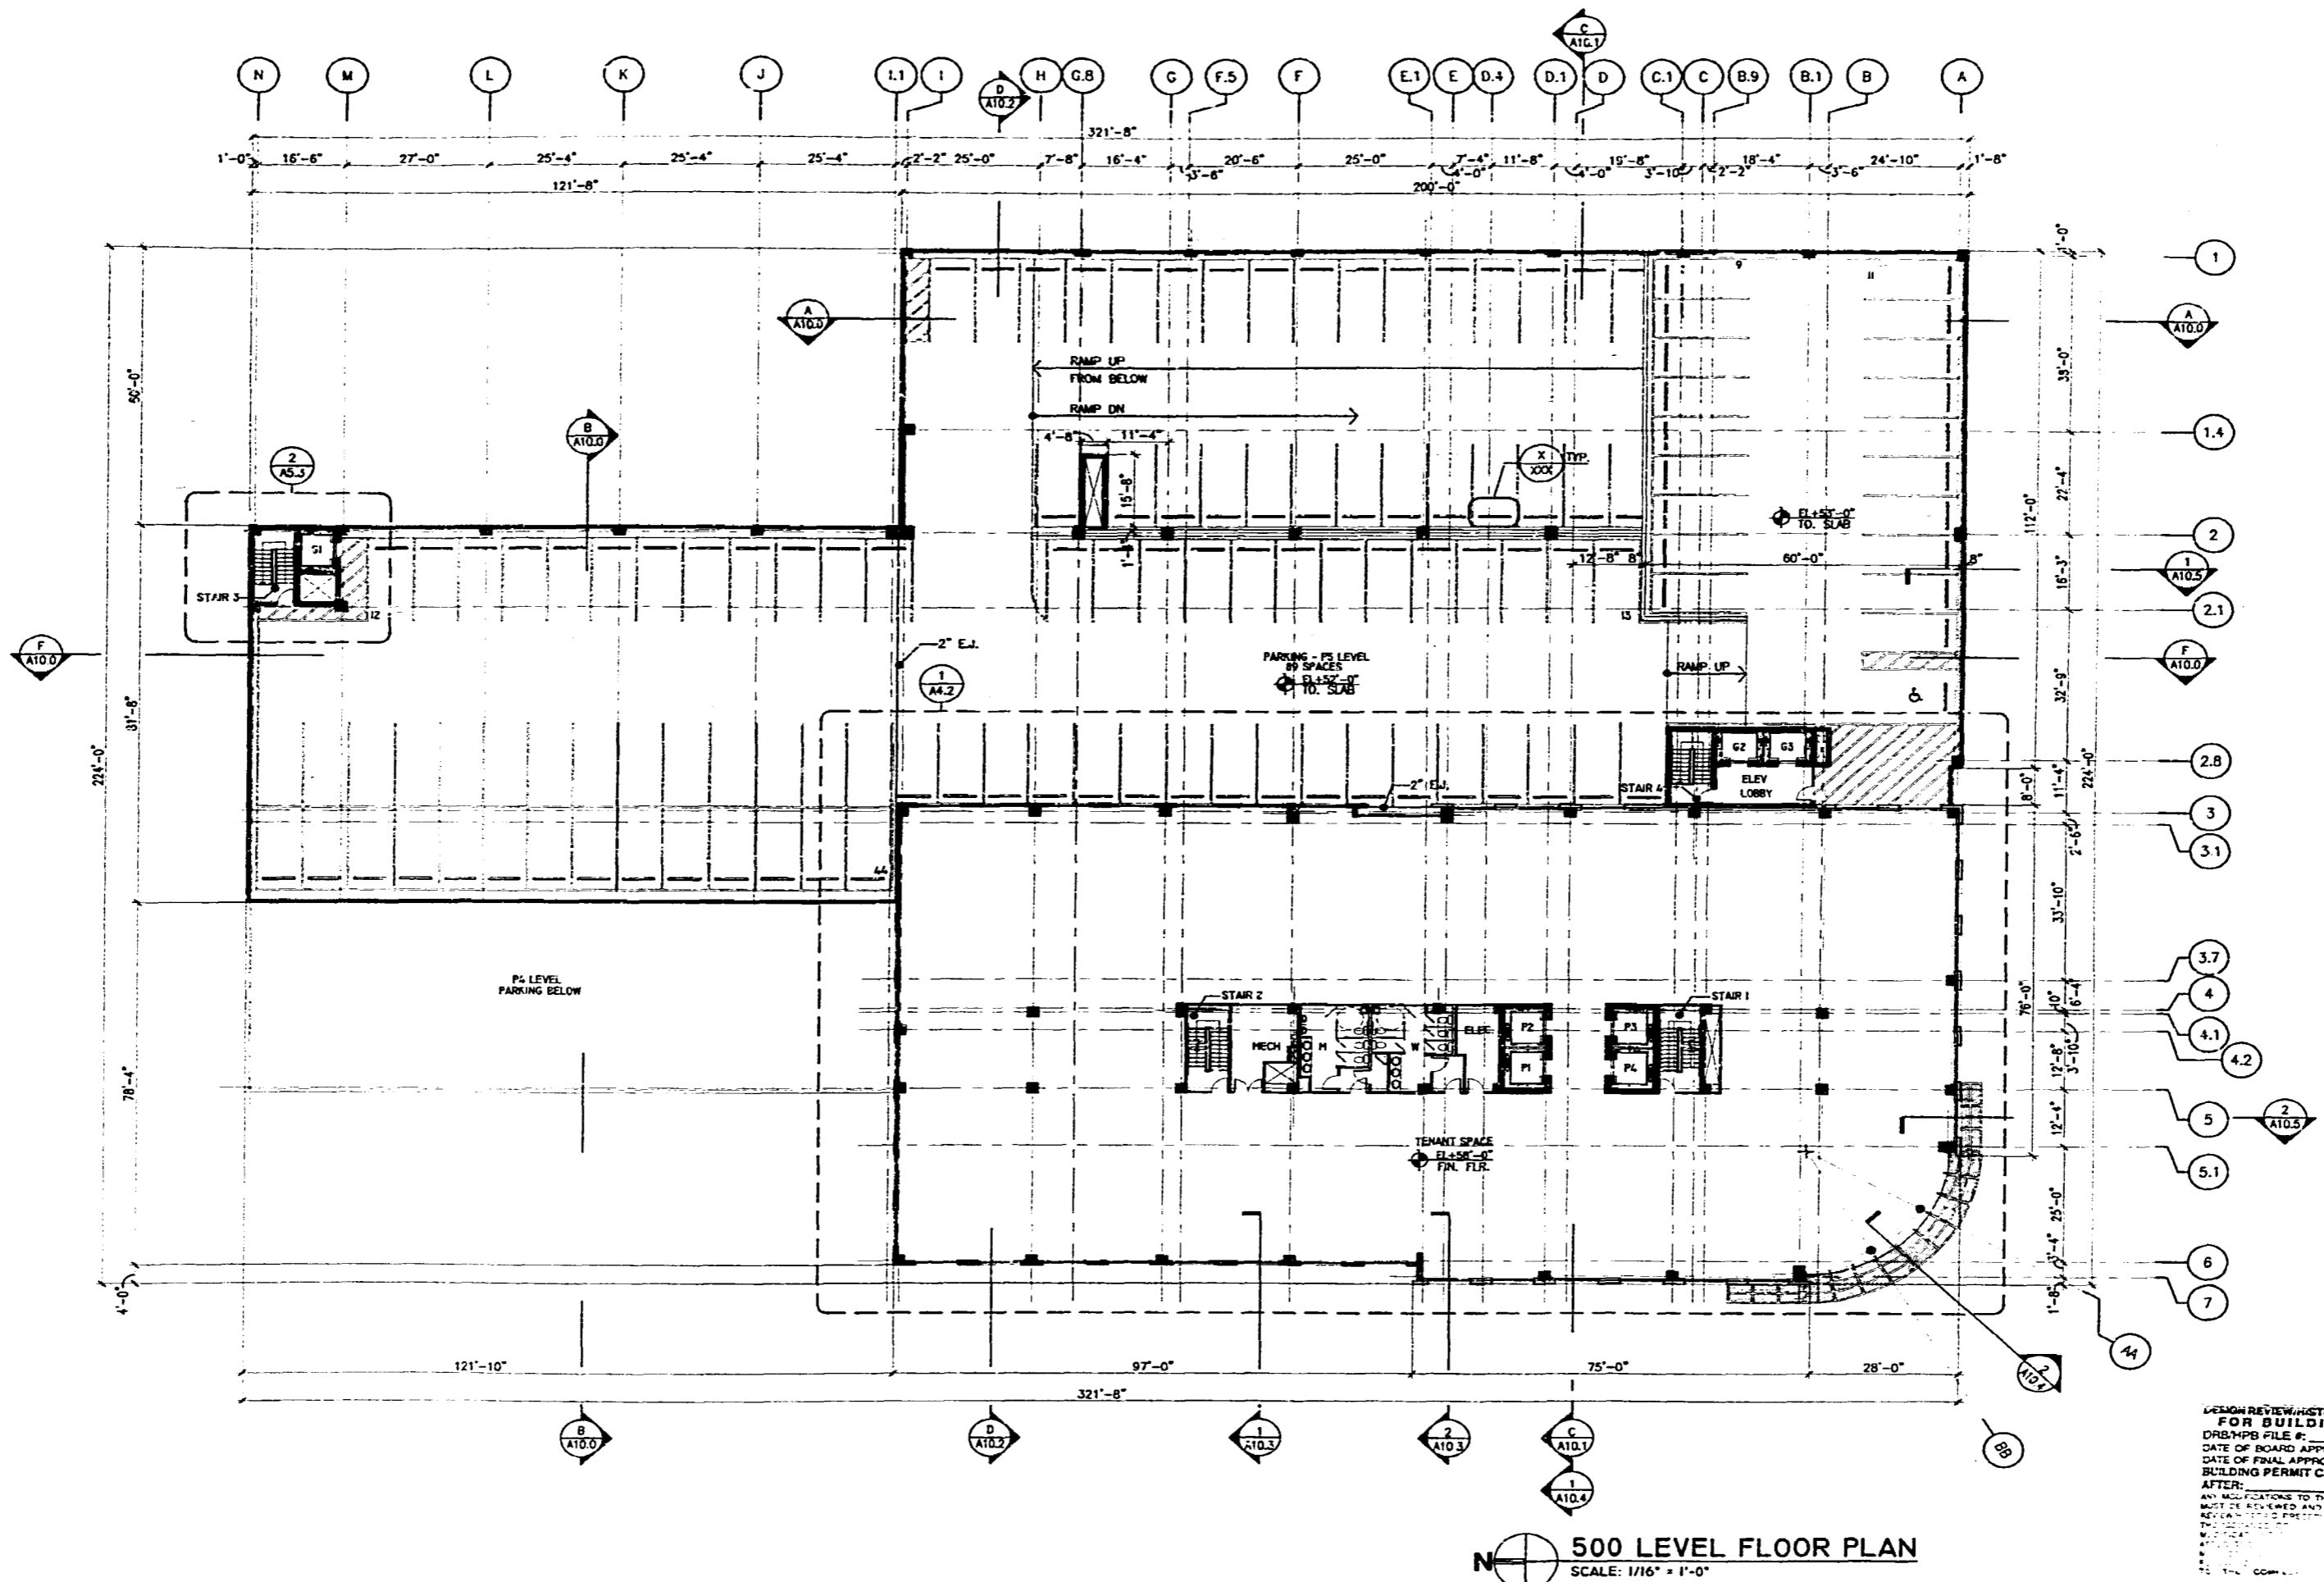


500 LEVEL FLOOR PLAN
SCALE: 1/16" = 1'-0"

**DESIGN REVIEW/HISTORIC PRESERVATION
FOR BUILDING PERMIT**
DRAWING FILE #:
DATE OF BOARD APPROVAL:
DATE OF FINAL APPROVAL: CHECK BY:
BUILDING PERMIT CANNOT BE ISSUED
AFTER:
ANY MODIFICATIONS TO THESE PLANS OBTAINED
MUST BE REVIEWED AND APPROVED BY DESIGN
REVIEW/HISTORIC PRESERVATION DIVISION
DATE: 11/11/03

APPROVED FOR PERMIT TO
ENGINEER/ARCHITECT

LINCOLN PLACE
1801 WASHINGTON AVENUE
MIAMI BEACH FLORIDA

9808
A3.4

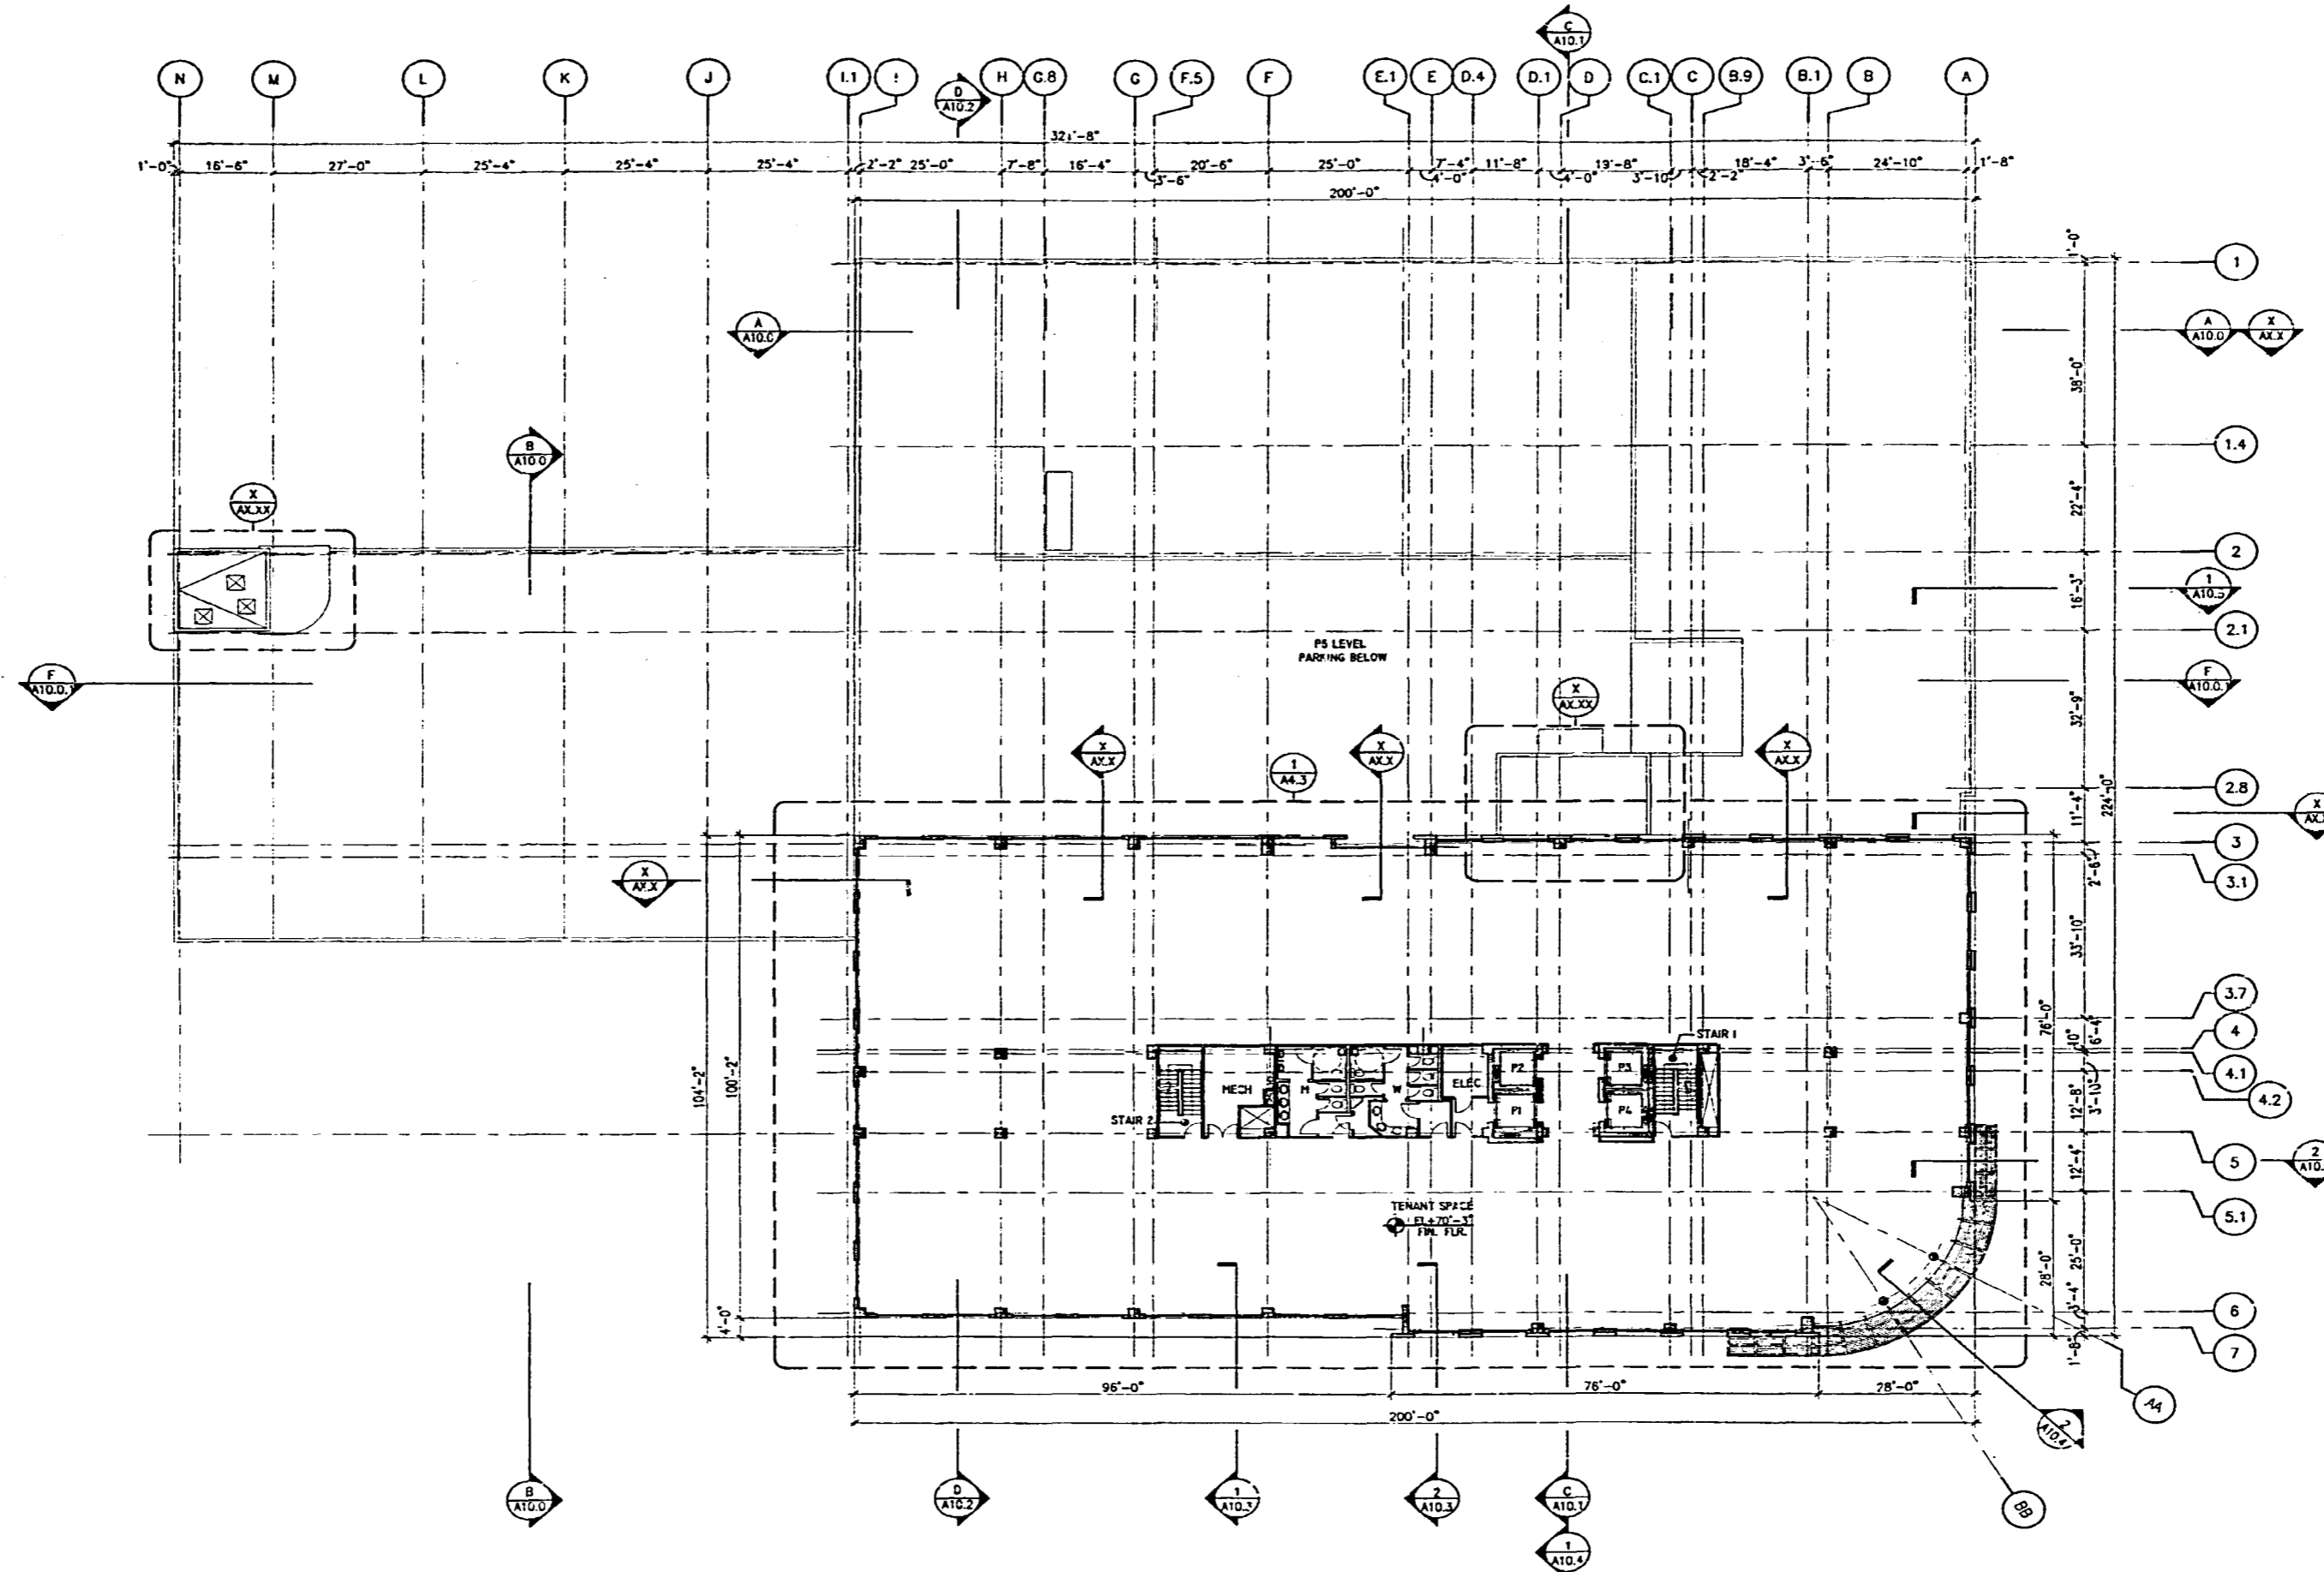

LEVEL 600 FLOOR PLAN
SCALE: 1/16" = 1'-0"

OFFICE COPY
CITY OF MIAMI BEACH

APPROVED FOR PERMIT BY
THE FOLLOWING:

BUILDING: W. J. [Signature]
ZONING: SR
PLUMBING: [Signature]
ELECTRICAL: [Signature]
MECHANICAL: [Signature]
FIRE: [Signature]
ELEVATOR: [Signature]
APPROVED SUBJECT TO
ENGINEERING FEE


**PERSON REVIEWING HISTORIC PRESERVATION
FOR BUILDING PERMIT**
DATE OF REVIEW: 11/10/00
DATE OF FINAL APPROVAL: 11/10/00
IF NO PERMIT CANNOT BE ISSUED

NOTE: ALL ELEVATION MARKS REFER TO N.G.V.D.

LINCOLN PLACE
1601 WASHINGTON AVENUE

980

A3.

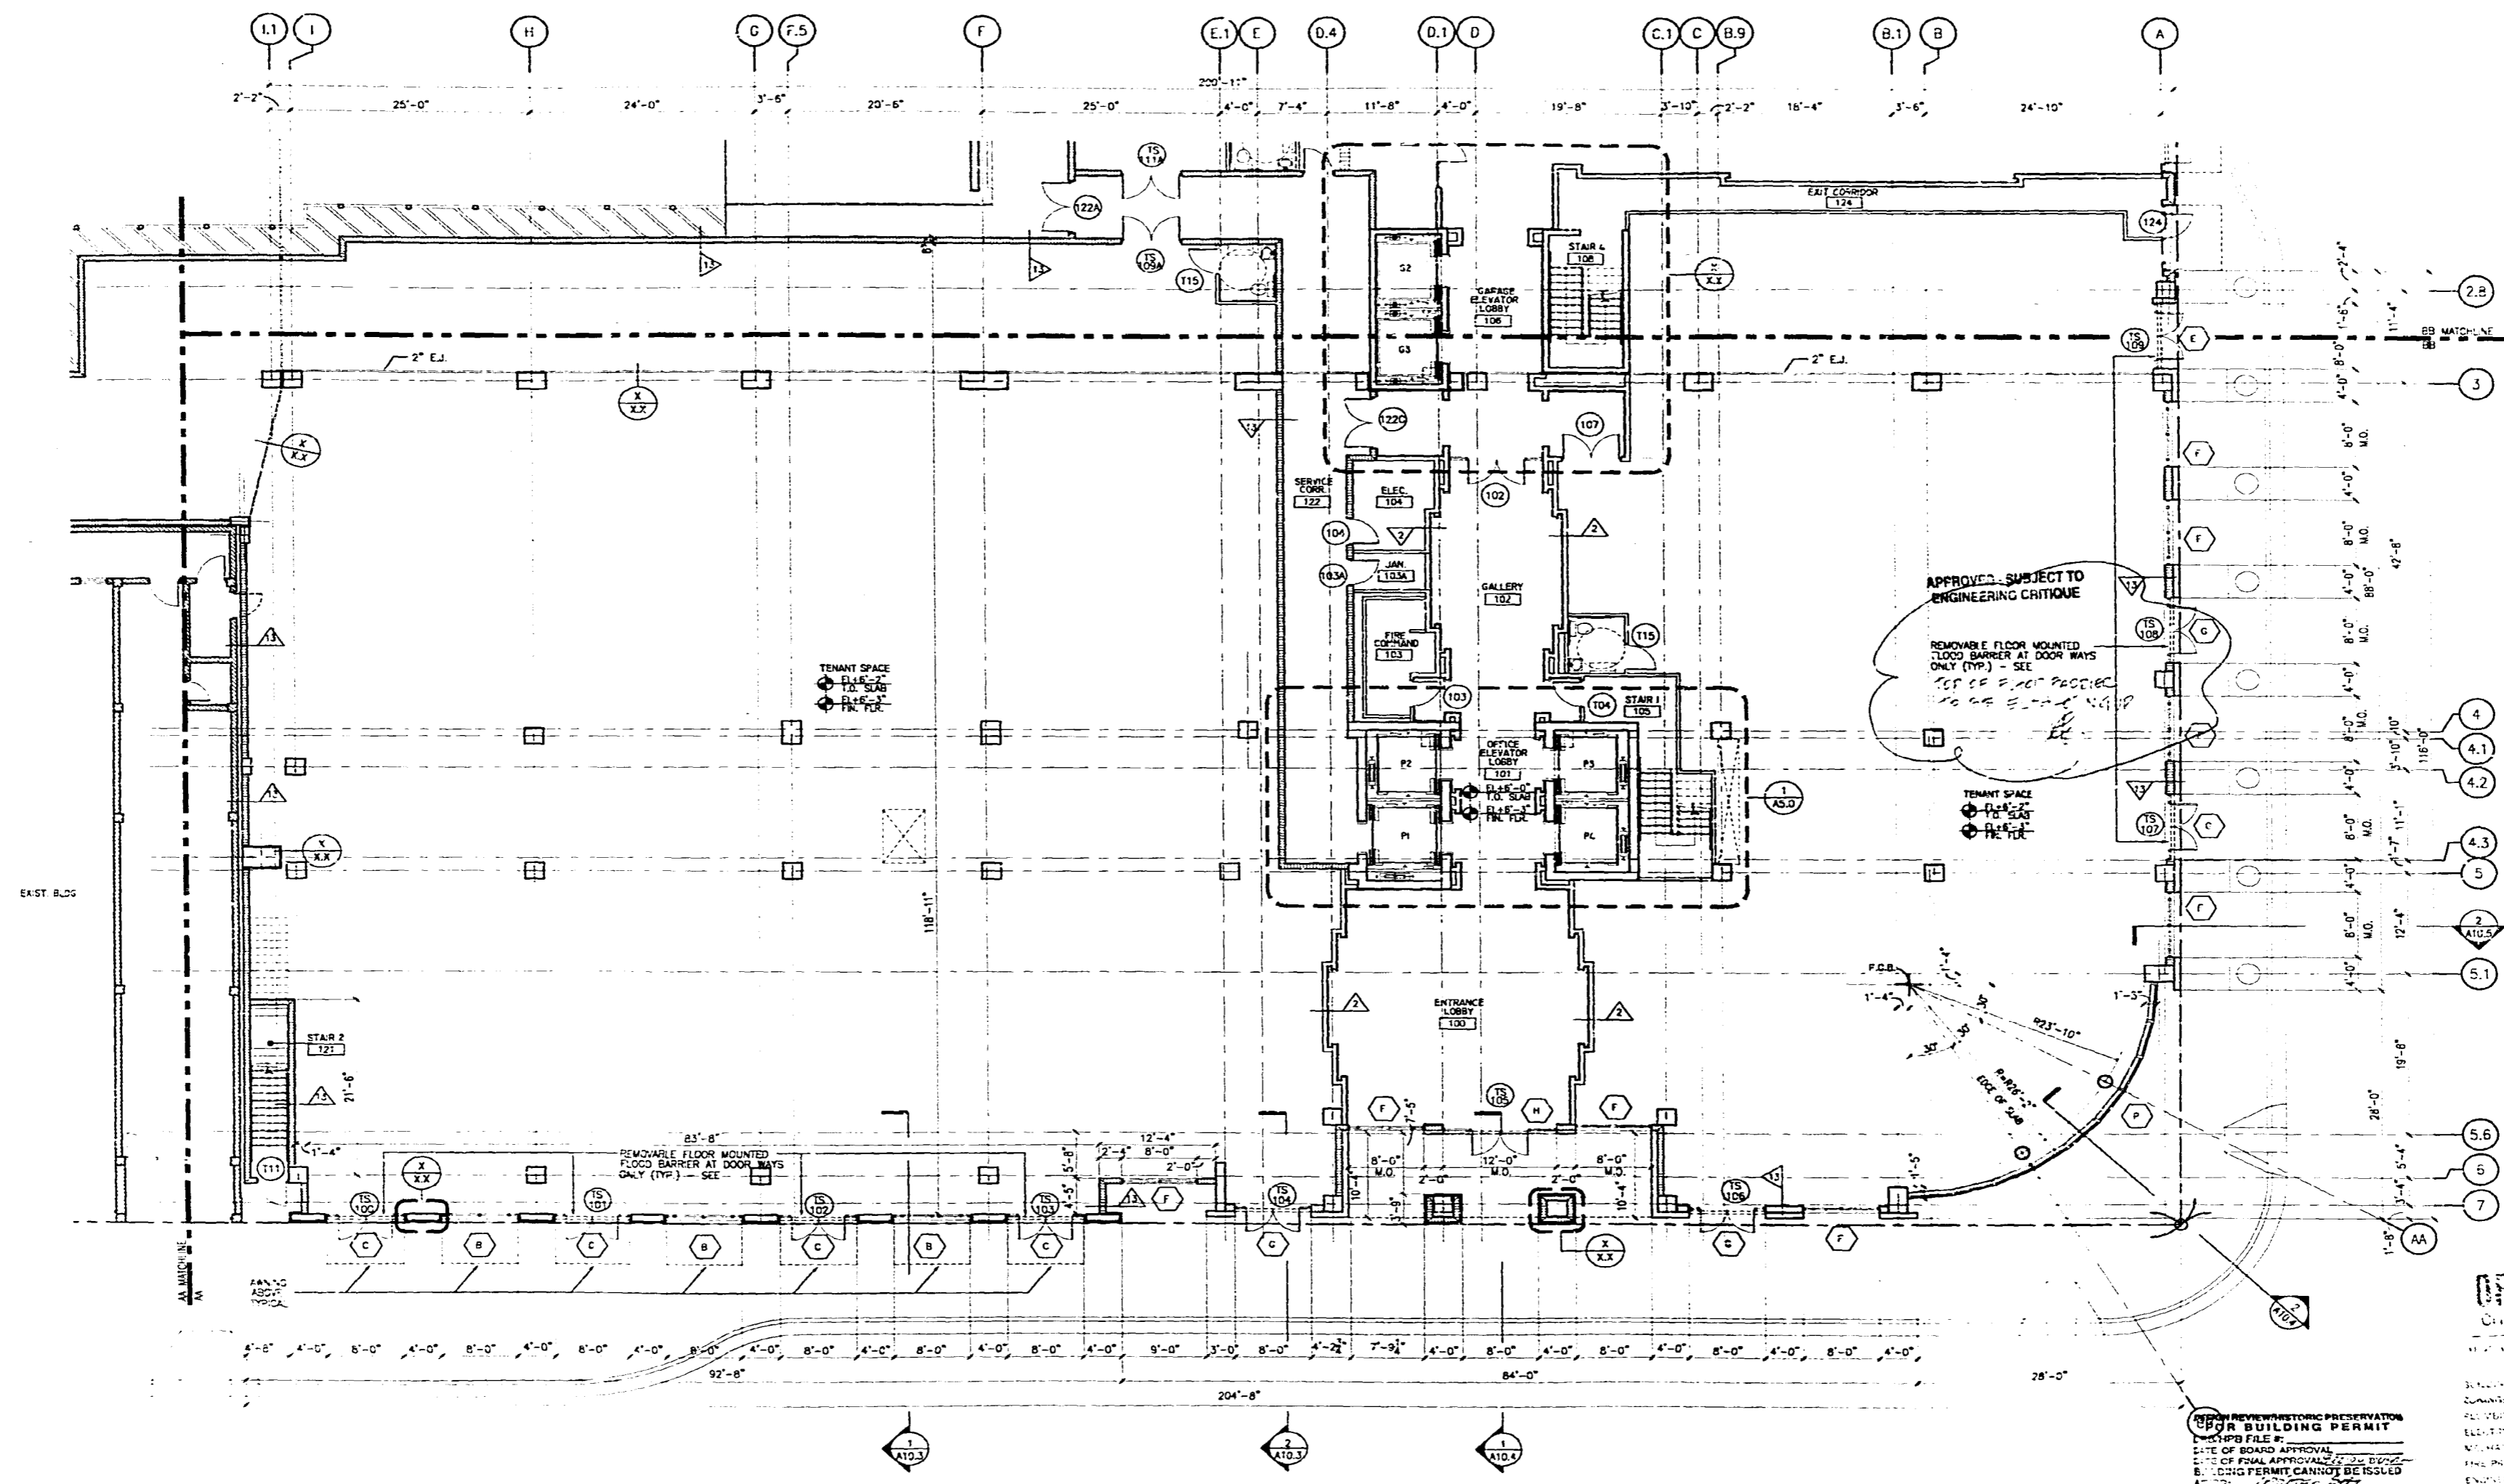

PARTIAL 100 LEVEL FLOOR PLAN
SCALE: 1/8" = 1'-0"

OFFICE COPY
CITY OF MIAMI BEACH
APPROVED FOR PERMIT BY THE FOLLOWING:

PLANNING	
COMMUNITY DEVELOPMENT	
ENVIRONMENTAL SERVICES	
FINANCIAL SERVICES	
GENERAL SERVICES	
INSPECTION	
LEGAL SERVICES	
OPERATIONS	
PERMITTING	
RECORDS MANAGEMENT	
STREETS	
WATER UTILITIES	
WASTE MANAGEMENT	


REVIEW FOR HISTORIC PRESERVATION
FOR BUILDING PERMIT
DATE OF BOARD APPROVAL: 12/15/10
DATE OF FINAL APPROVAL: 12/15/10
BUILDING PERMIT CANNOT BE ISSUED
UNTIL ALL REVIEW COMMENTS ARE RESOLVED
DATE OF RESOLUTION: 12/15/10
DATE OF PERMIT ISSUANCE: 12/15/10

NOTE: ALL ELEVATION MARKS REFER TO N.G.V.D.

LINCOLN PLACE
1601 WASHINGTON AVENUE
MIAMI BEACH, FLORIDA

9808

A4.0a

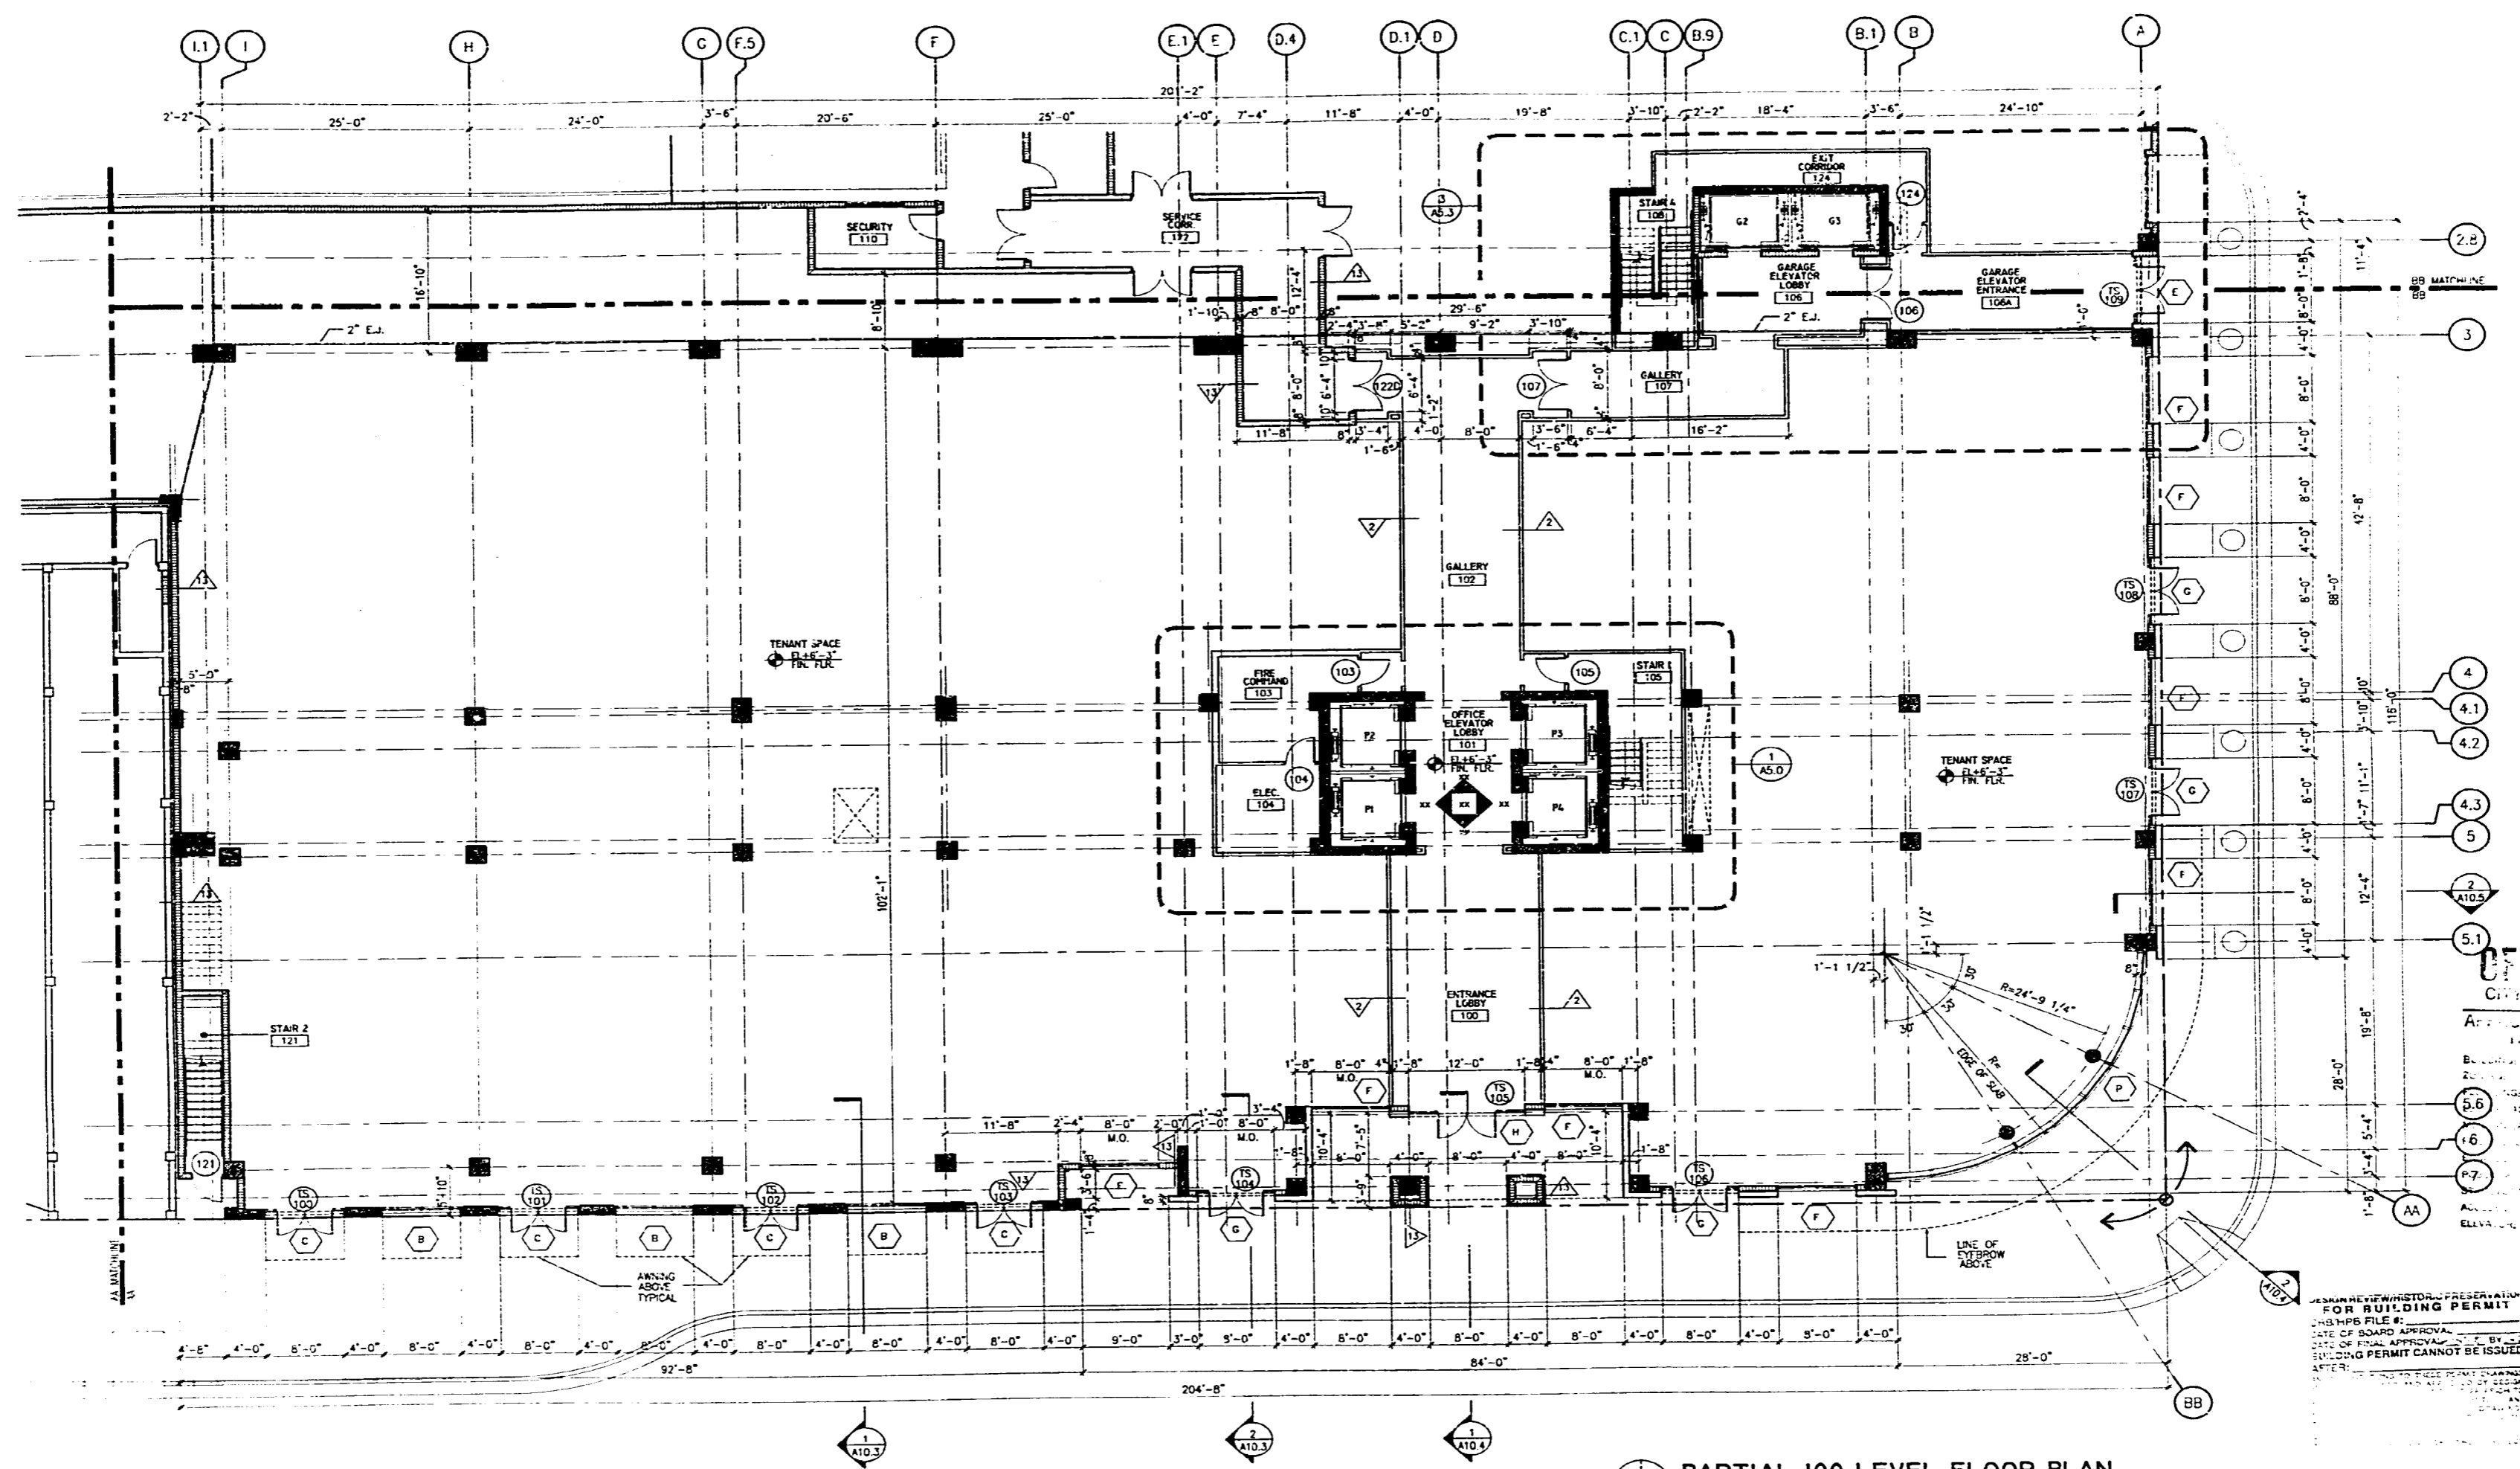

PERMIT COPY
City of Miami
Approved for the City by
[Signature]
DATE: 8/27/08


DESIGN REVIEW/HISTORIC PRESERVATION
FOR BUILDING PERMIT
THIS PERMIT IS SUBJECT TO THE FOLLOWING:
DATE OF FINAL APPROVAL: 8/27/08
DATE OF PERMIT ISSUANCE: 8/27/08
BUILDING PERMIT CANNOT BE ISSUED
AFTER: [Signature]

PARTIAL 100 LEVEL FLOOR PLAN
SCALE: 1/8" = 1'-0"

LINCOLN PLACE
1601 WASHINGTON AVENUE
MIAMI BEACH, FLORIDA

9808

A4.0a

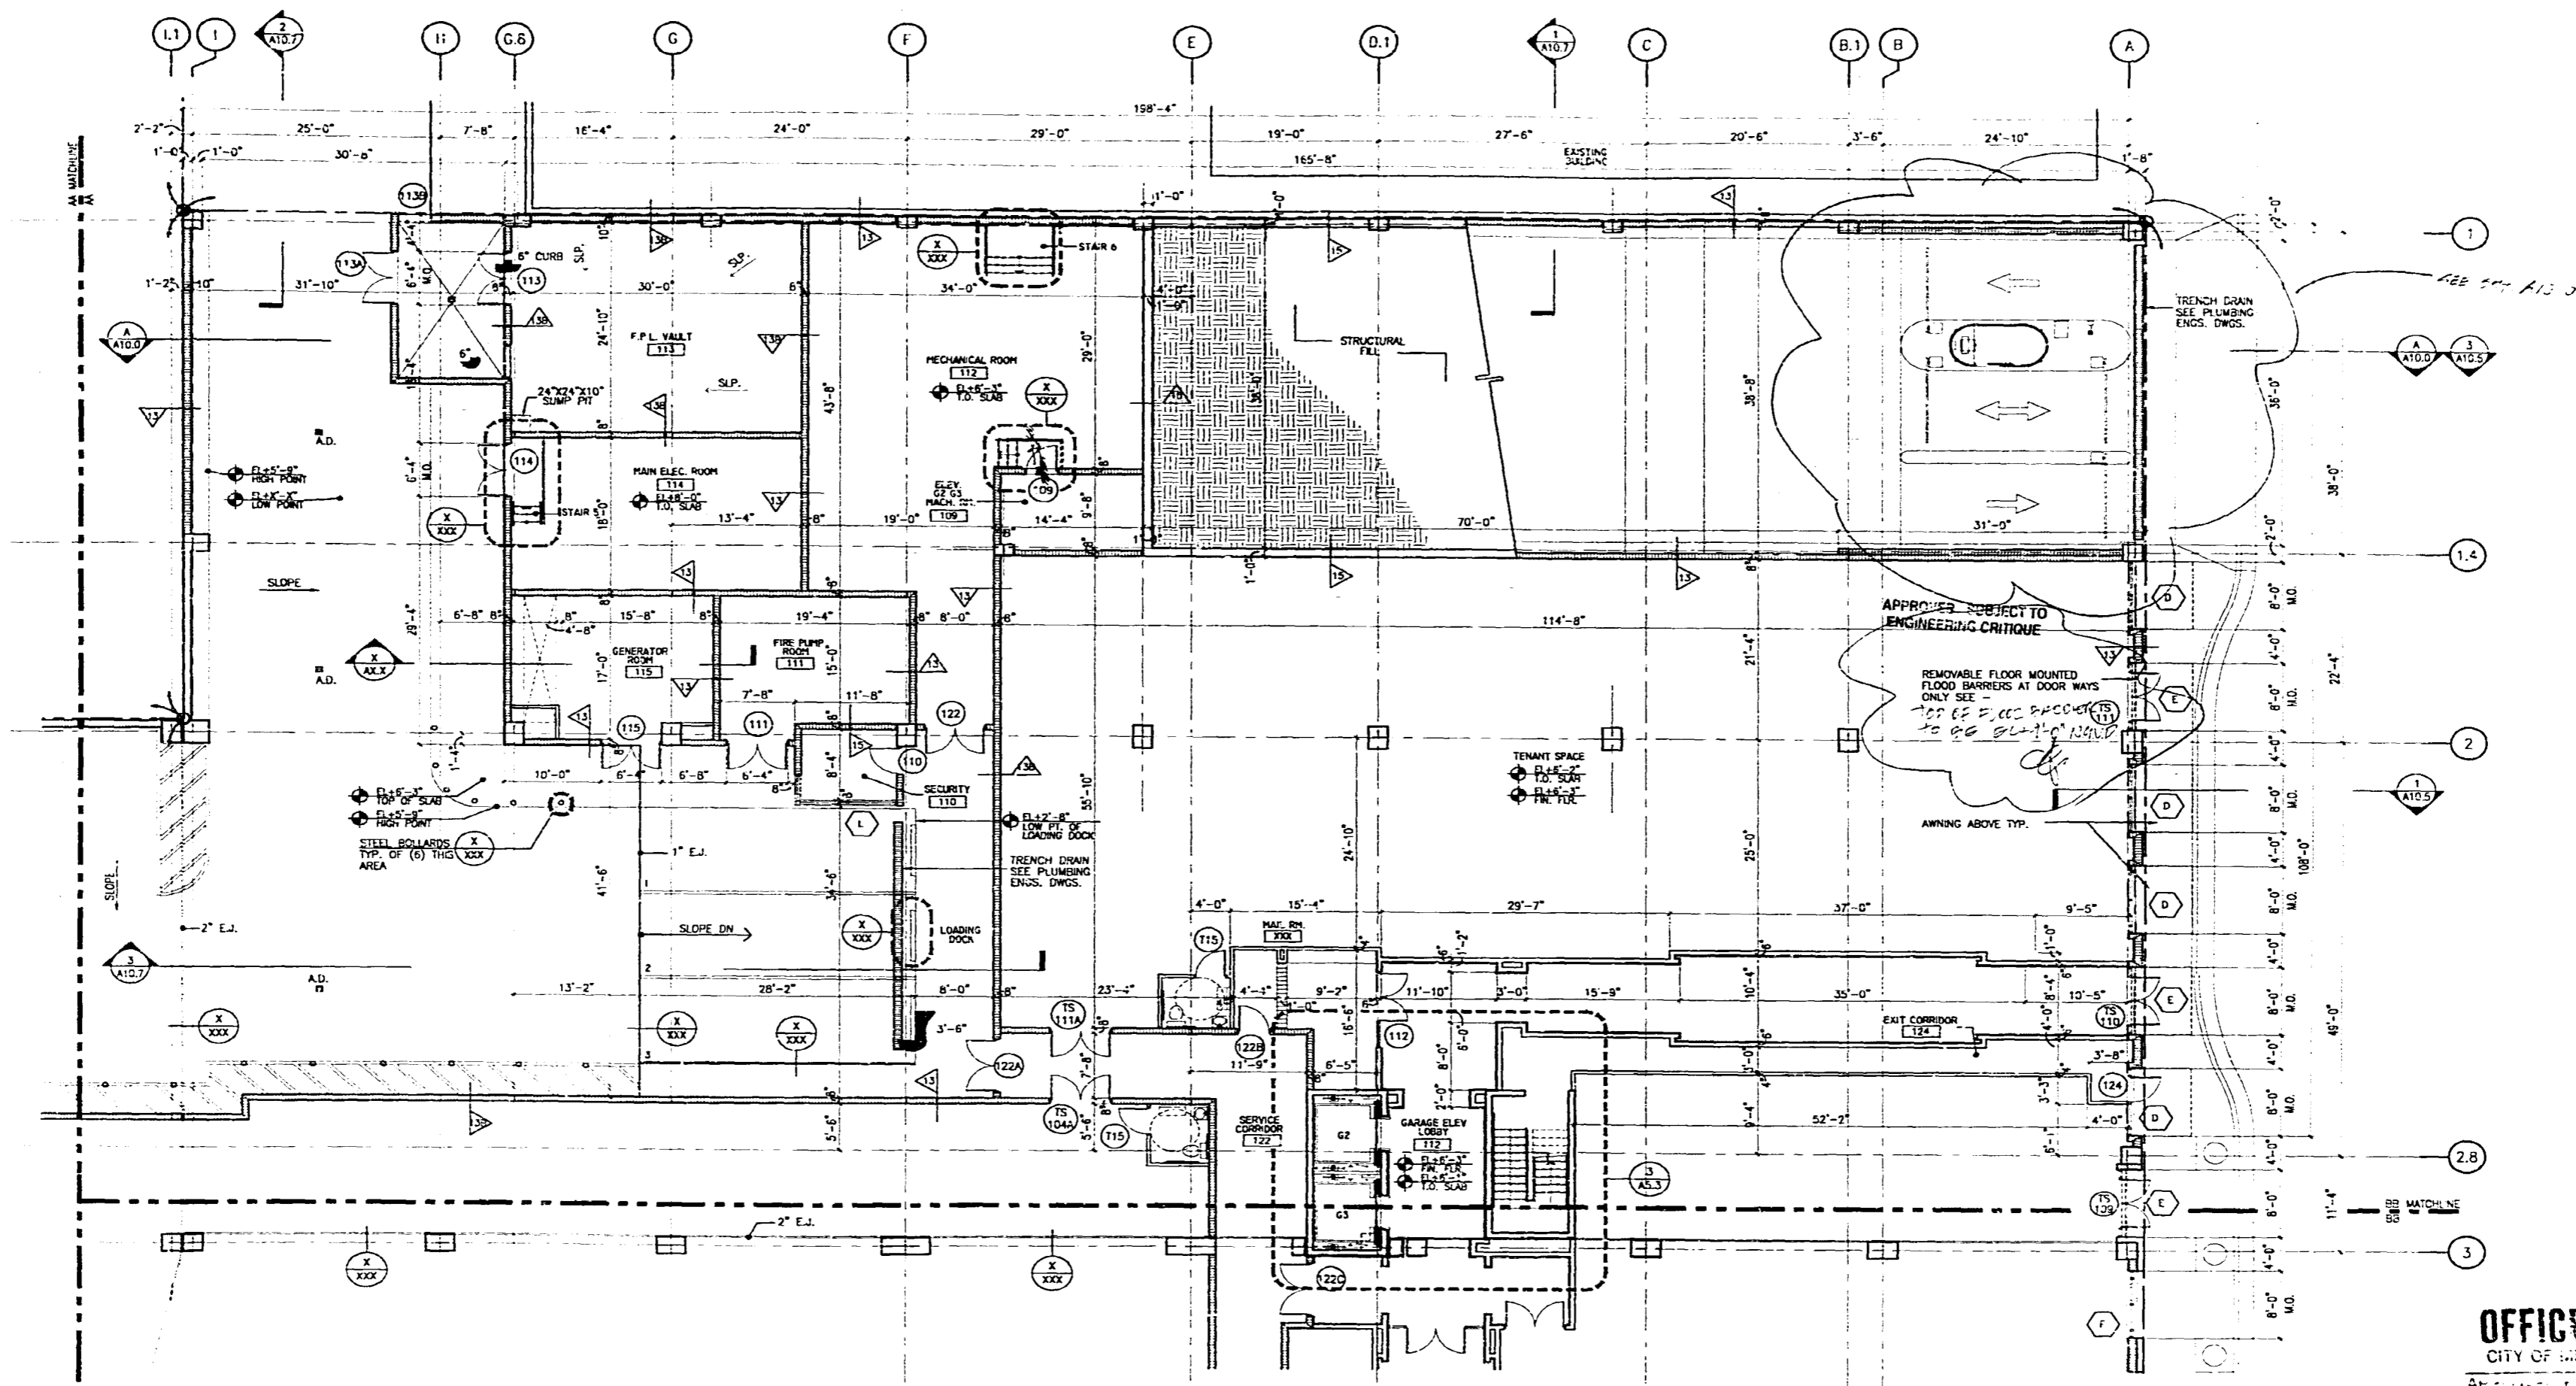

PARTIAL 100 LEVEL FLOOR PLAN
SCALE: 1/8" = 1'-0"


**PERSON NEVER HISTORIC PRESERVATION
FOR BUILDING PERMIT**
 DESIGNER: [Signature]
 DATE OF BOARD APPROVAL: [Date]
 DATE OF FINAL APPROVAL: [Date]
 BUILDING PERMIT CANNOT BE ISSUED
 AFTER: [Date]
 ALL SPECIFICATIONS TO THESE PERMIT DRAWINGS
 MUST BE REVIEWED AND APPROVED BY DESIGN
 REVIEWER PRIOR TO CONSTRUCTION START PRIOR TO
 THE ISSUANCE OF THE PERMIT AND
 THE CONTRACTOR SHALL BE RESPONSIBLE FOR
 THE COMPLETION OF THE PROJECT

OFFICE COPY
 CITY OF MIAMI BEACH
 APPROVED FOR PERMIT BY
 THE FOLLOWING:
 ZONING: [Signature]
 PLUMBING: [Signature]
 ELECTRICAL: [Signature]
 MECHANICAL: [Signature]
 FIRE PREVENTION: [Signature]
 ENVIRONMENTAL: [Signature]
 PUBLIC WORKS: [Signature]
 STRUCTURAL: [Signature]
 ACCESSIBILITY: [Signature]
 ELEVATOR: [Signature]

NOTE: ALL ELEVATION MARKS REFER TO N.G.V.D.

LINCOLN PLACE
 1001 WASHINGTON AVENUE
 MIAMI BEACH, FLORIDA


9808
A4.0b

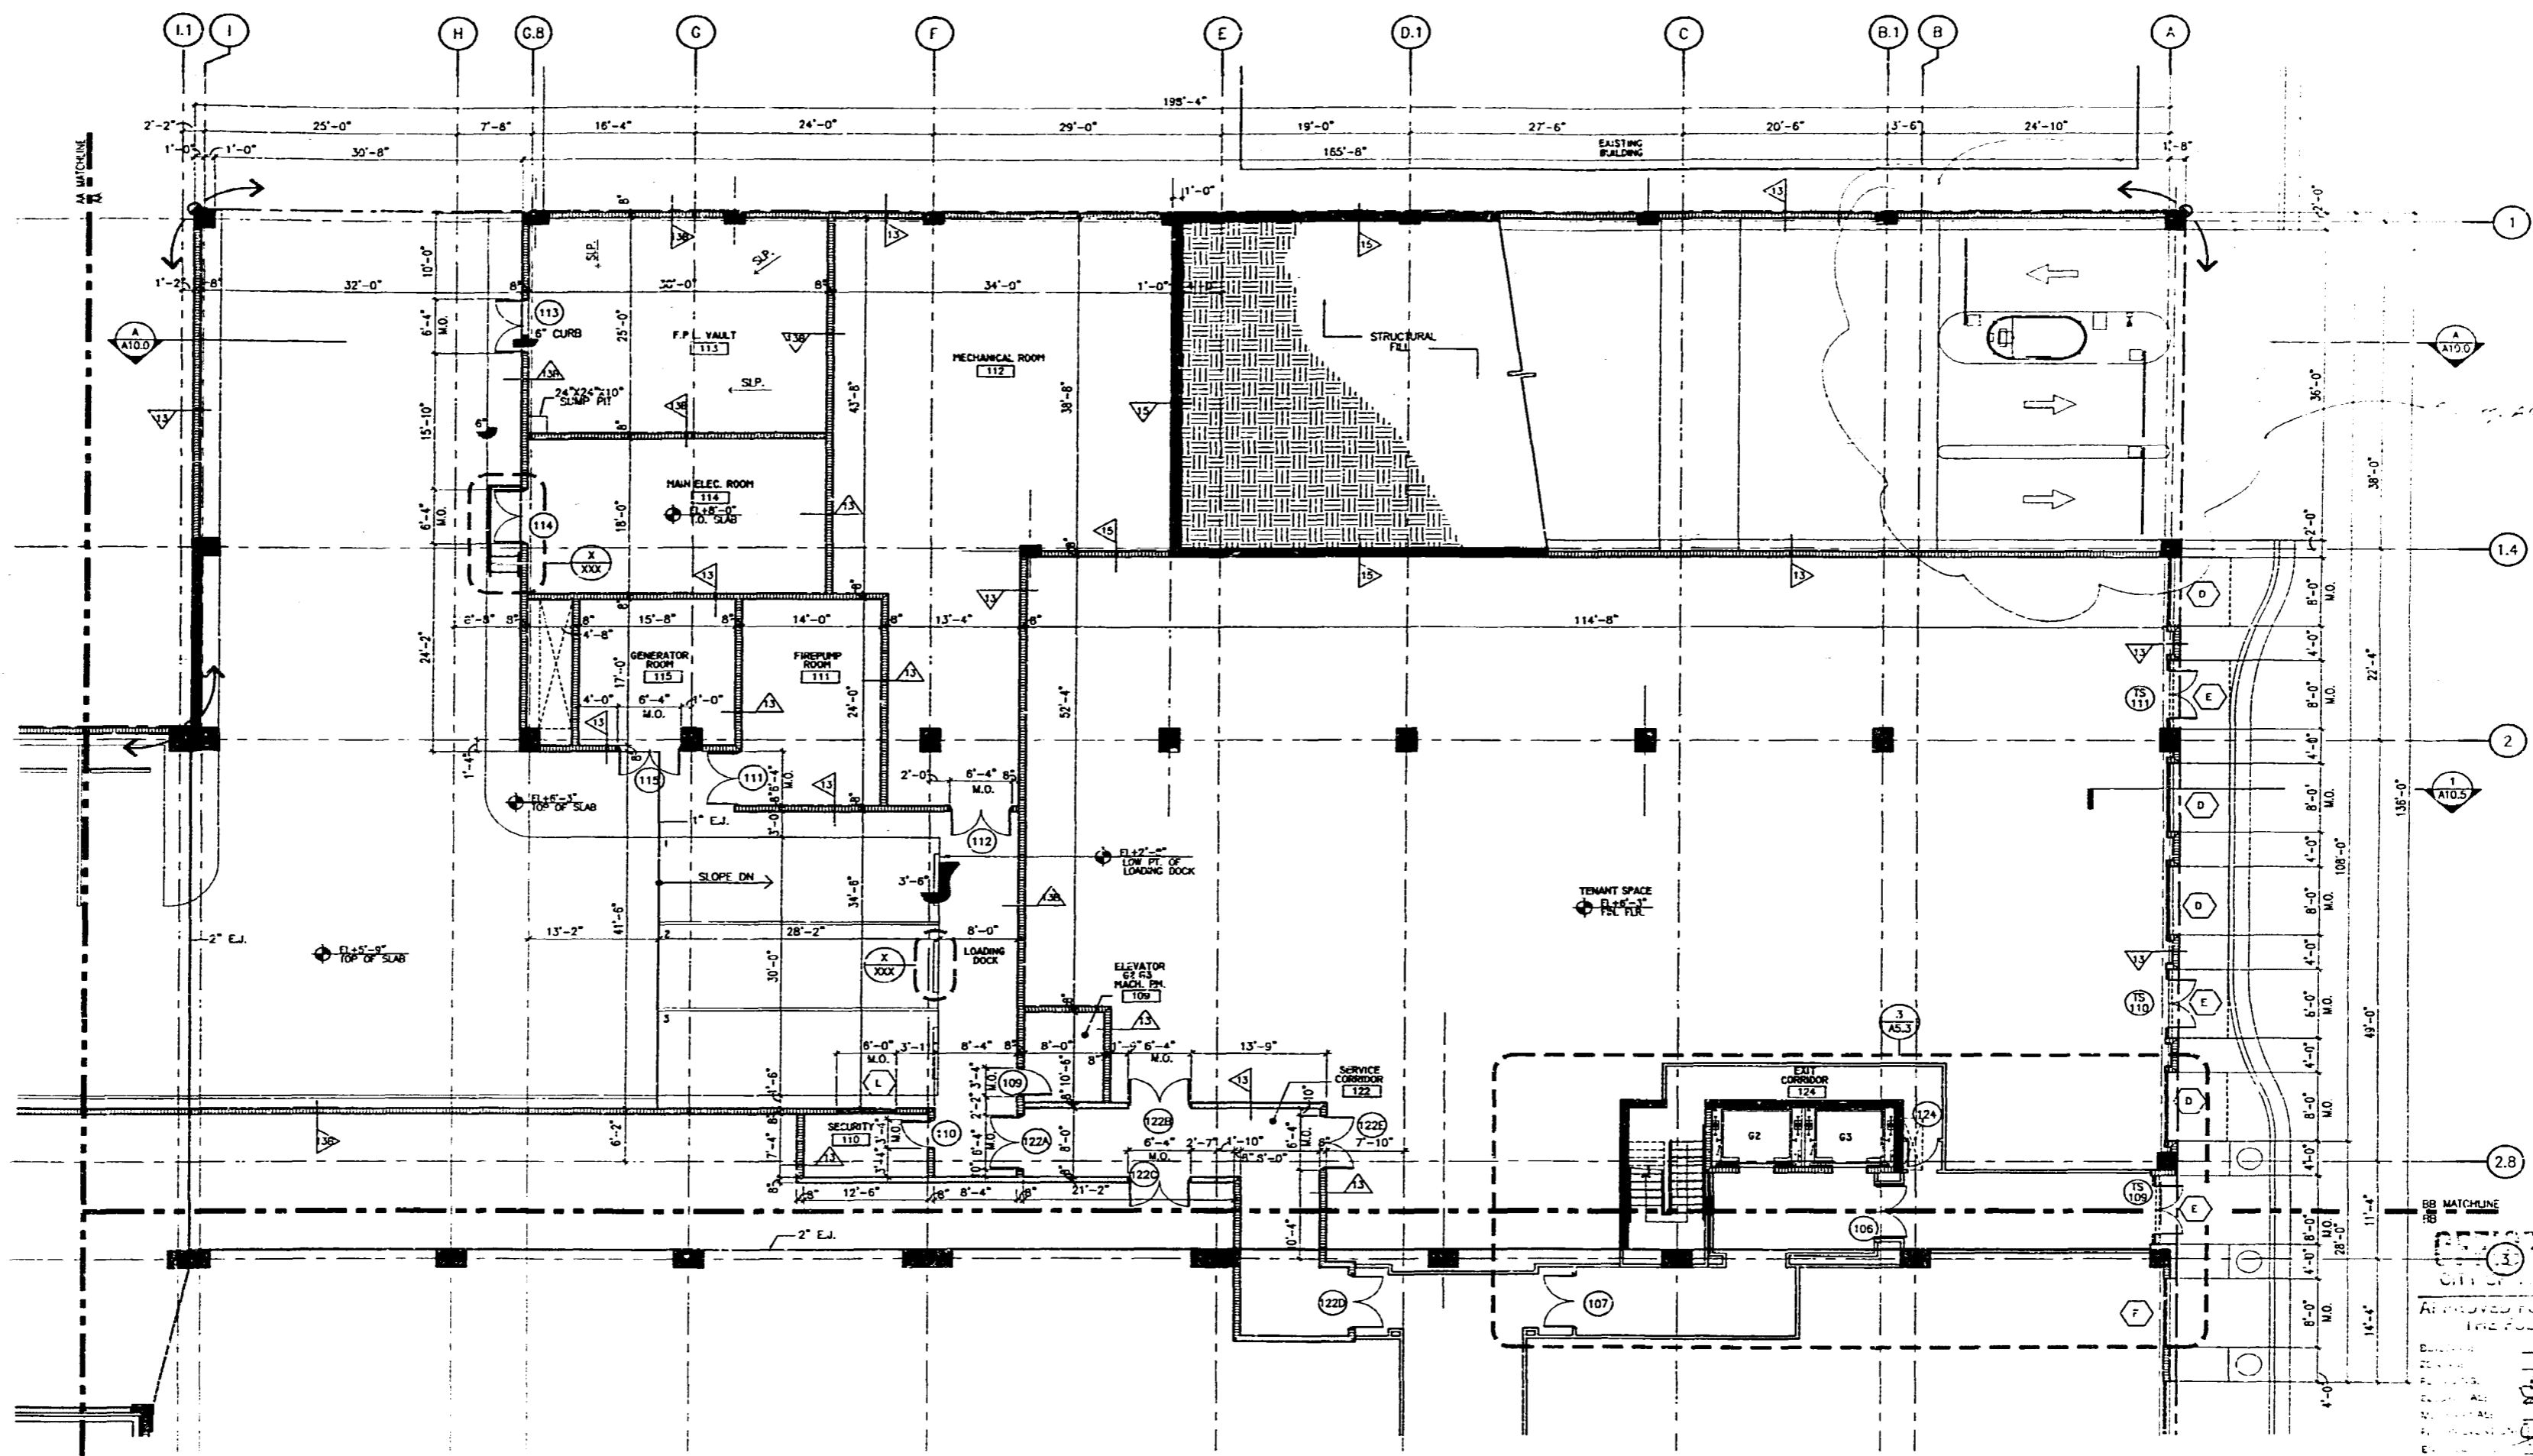

PARTIAL 100 LEVEL FLOOR PLAN
SCALE: 1/8" = 1'-0"

SECTION REVIEW HISTORIC PRESERVATION
FOR BUILDING PERMIT
DRBHP'S FILE #:
DATE OF BOARD APPROVAL:
DATE OF FINAL APPROVAL: *12/1/2010*
BUILDING PERMIT CANNOT BE ISSUED
AFTER
ANY MODIFICATIONS TO THESE PLANS
HAVE BEEN FORWARDED AND APPROVED BY
NICHOLS BROSCH SANDOVAL & ASSOCIATES, INC.
DATE: *11/15/10*
BY: *[Signature]*

PERMIT COPY
CITY OF MIAMI
APPROVED FOR PERMIT BY
THE FOLLOWING:
DATE: *11/15/10*
BY: *[Signature]*

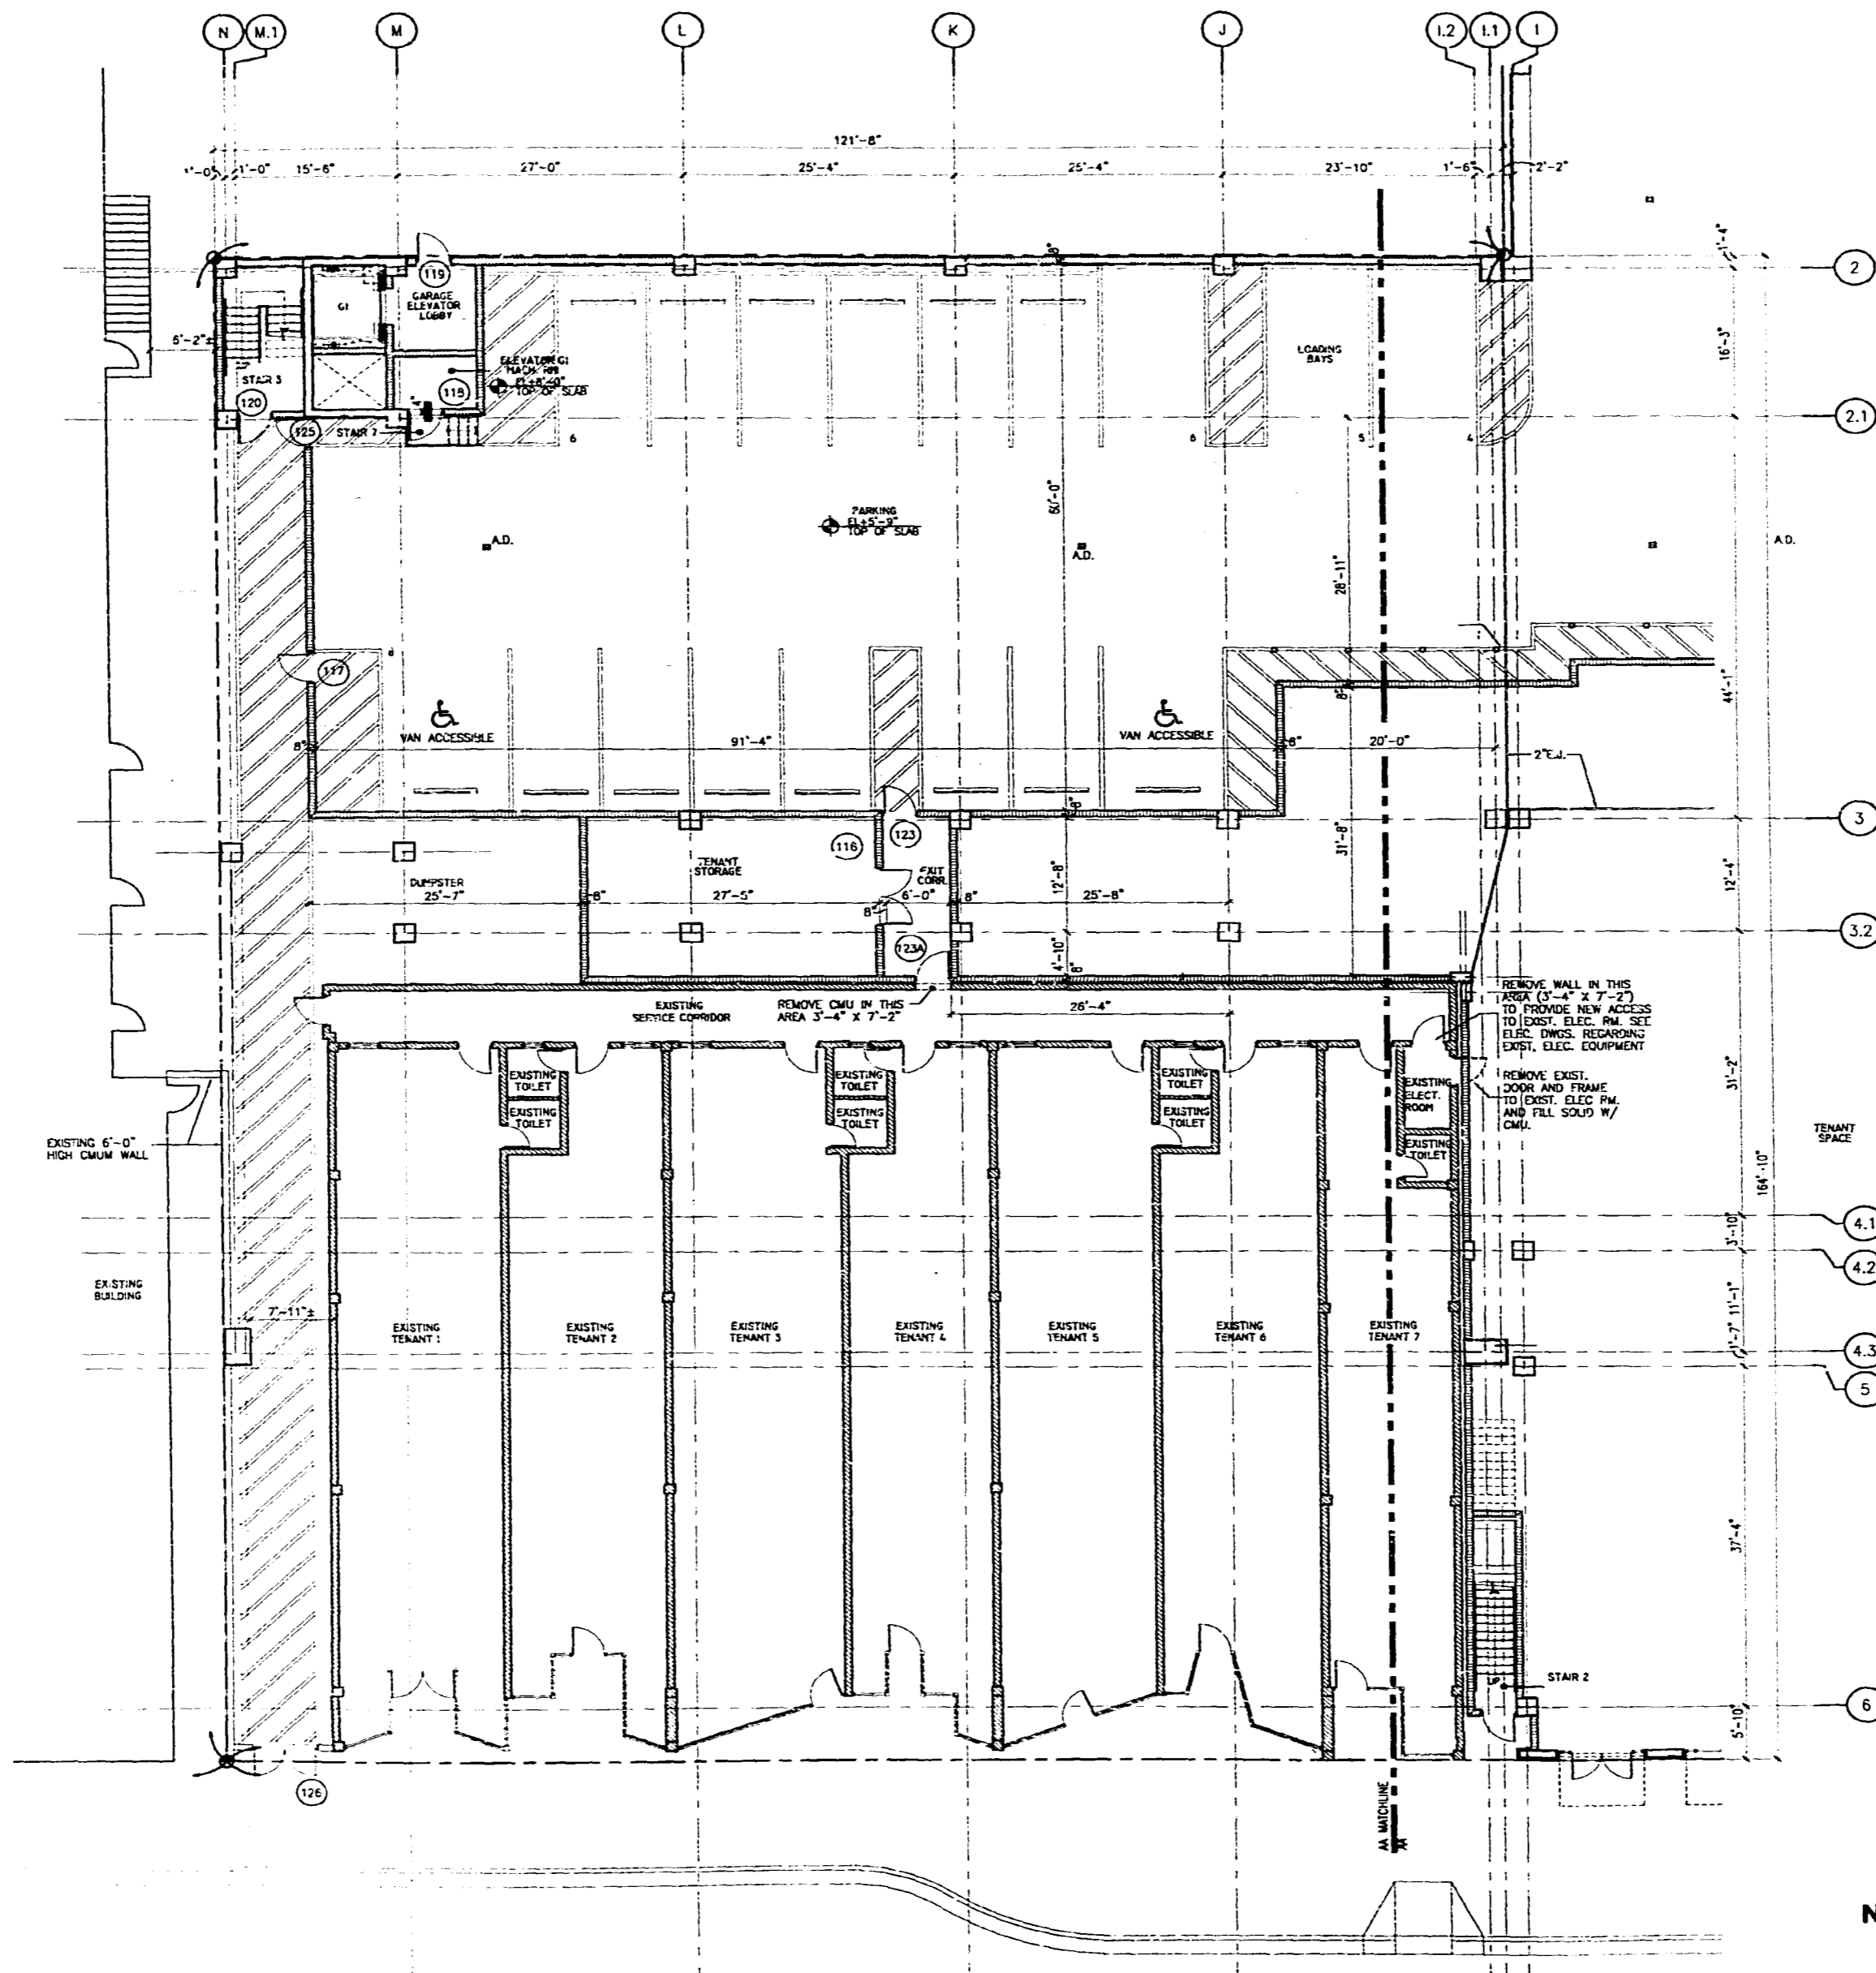

OFFICE COPY
CITY OF MIAMI BEACH
APPROVED FOR PERMIT BY
THE FOLLOWING:


BUILDING	APPROVED
ZONING	APPROVED
PLUMBING	APPROVED
ELECTRICAL	APPROVED
Mechanical	APPROVED
MECHANICAL	APPROVED
ENGINEERING	APPROVED
PLUMBING	APPROVED
STRUCTURAL	APPROVED
ACCESSIBILITY	APPROVED
ELEVATOR	APPROVED

APPROVED SUBJECT TO ENGINEER'S SIGNATURE
DATE: 8/14/2000


DESIGN REVIEW HISTORIC PRESERVATION
DATE: 8/14/2000
SIGNATURE: [Signature]

PARTIAL 100 LEVEL FLOOR PLAN
SCALE: 1/8" = 1'-0"

NOTE: ALL ELEVATION MARKS REFER TO N.G.V.D.

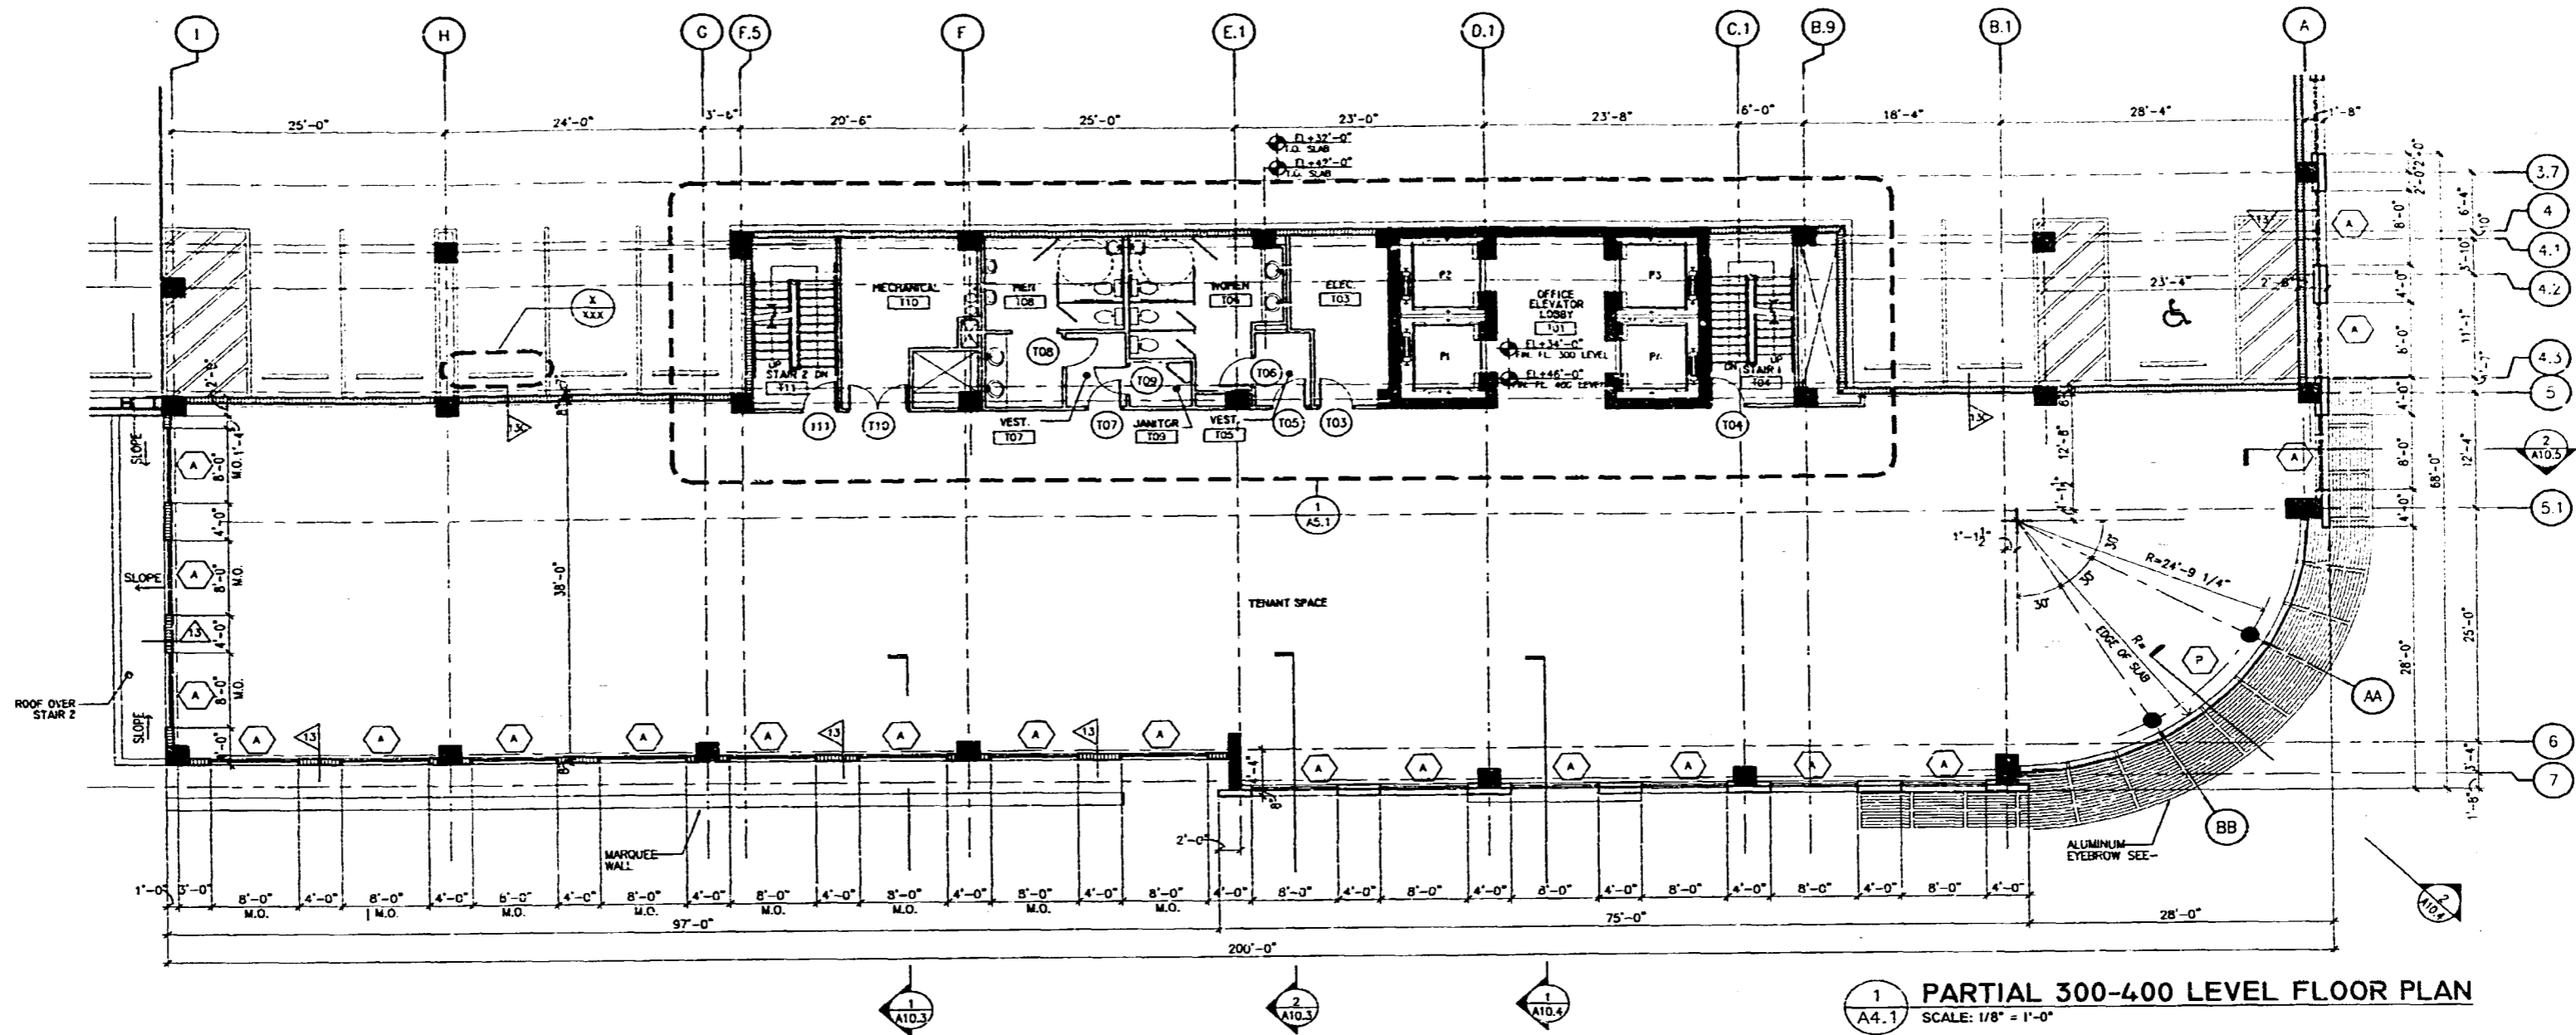

1 PARTIAL 300-400 LEVEL FLOOR PLAN
SCALE: 1/8" = 1'-0"

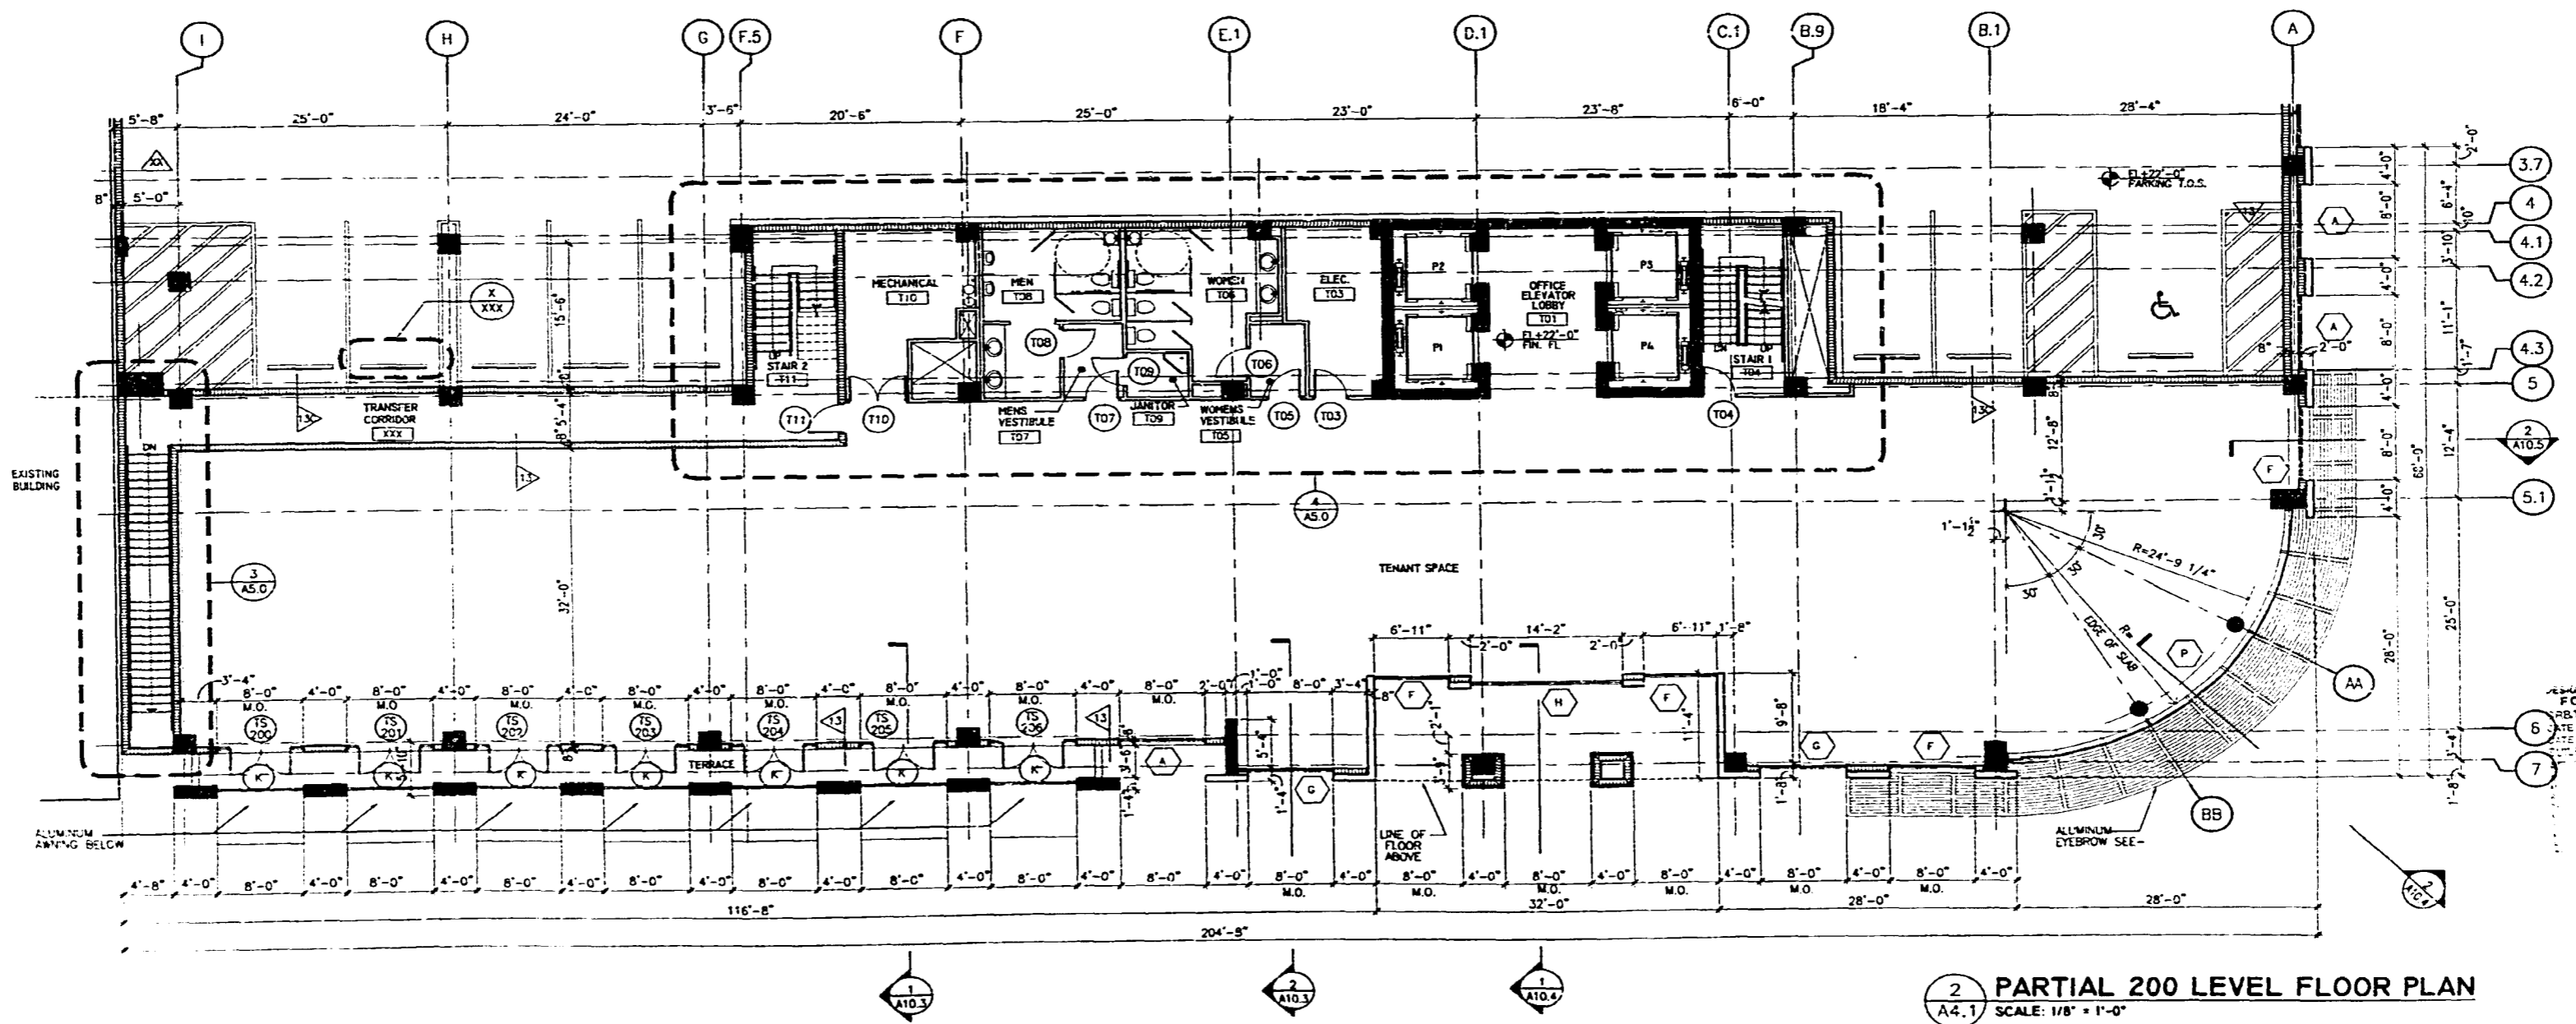

2 PARTIAL 200 LEVEL FLOOR PLAN
SCALE: 1/8" = 1'-0"

CITY OF MIAMI
APPROVED FOR THE CITY OF MIAMI
DATE: 5/2/21
APPROVED BY: [Signature]
ENGINEER: [Signature]

DESIGN REVIEW INSTRUCTIONS FOR BUILDING PERMIT
FOR BOARD APPROVAL
DATE OF FINAL APPROVAL: [Blank]
DATE PERMIT CANNOT BE ISSUED: [Blank]

LINCOLN PLACE
1801 WASHINGTON AVENUE
MIAMI BEACH, FLORIDA


9608

A4.1



**NICHOLS
BROSCH
SANDOVAL
& ASSOCIATES, P.A.**

Architecture & Planning
1400 Biscayne Avenue
12th Floor, Suite 1200
Miami, Florida 33132
Tel: 305.375.1100
Fax: 305.375.1101

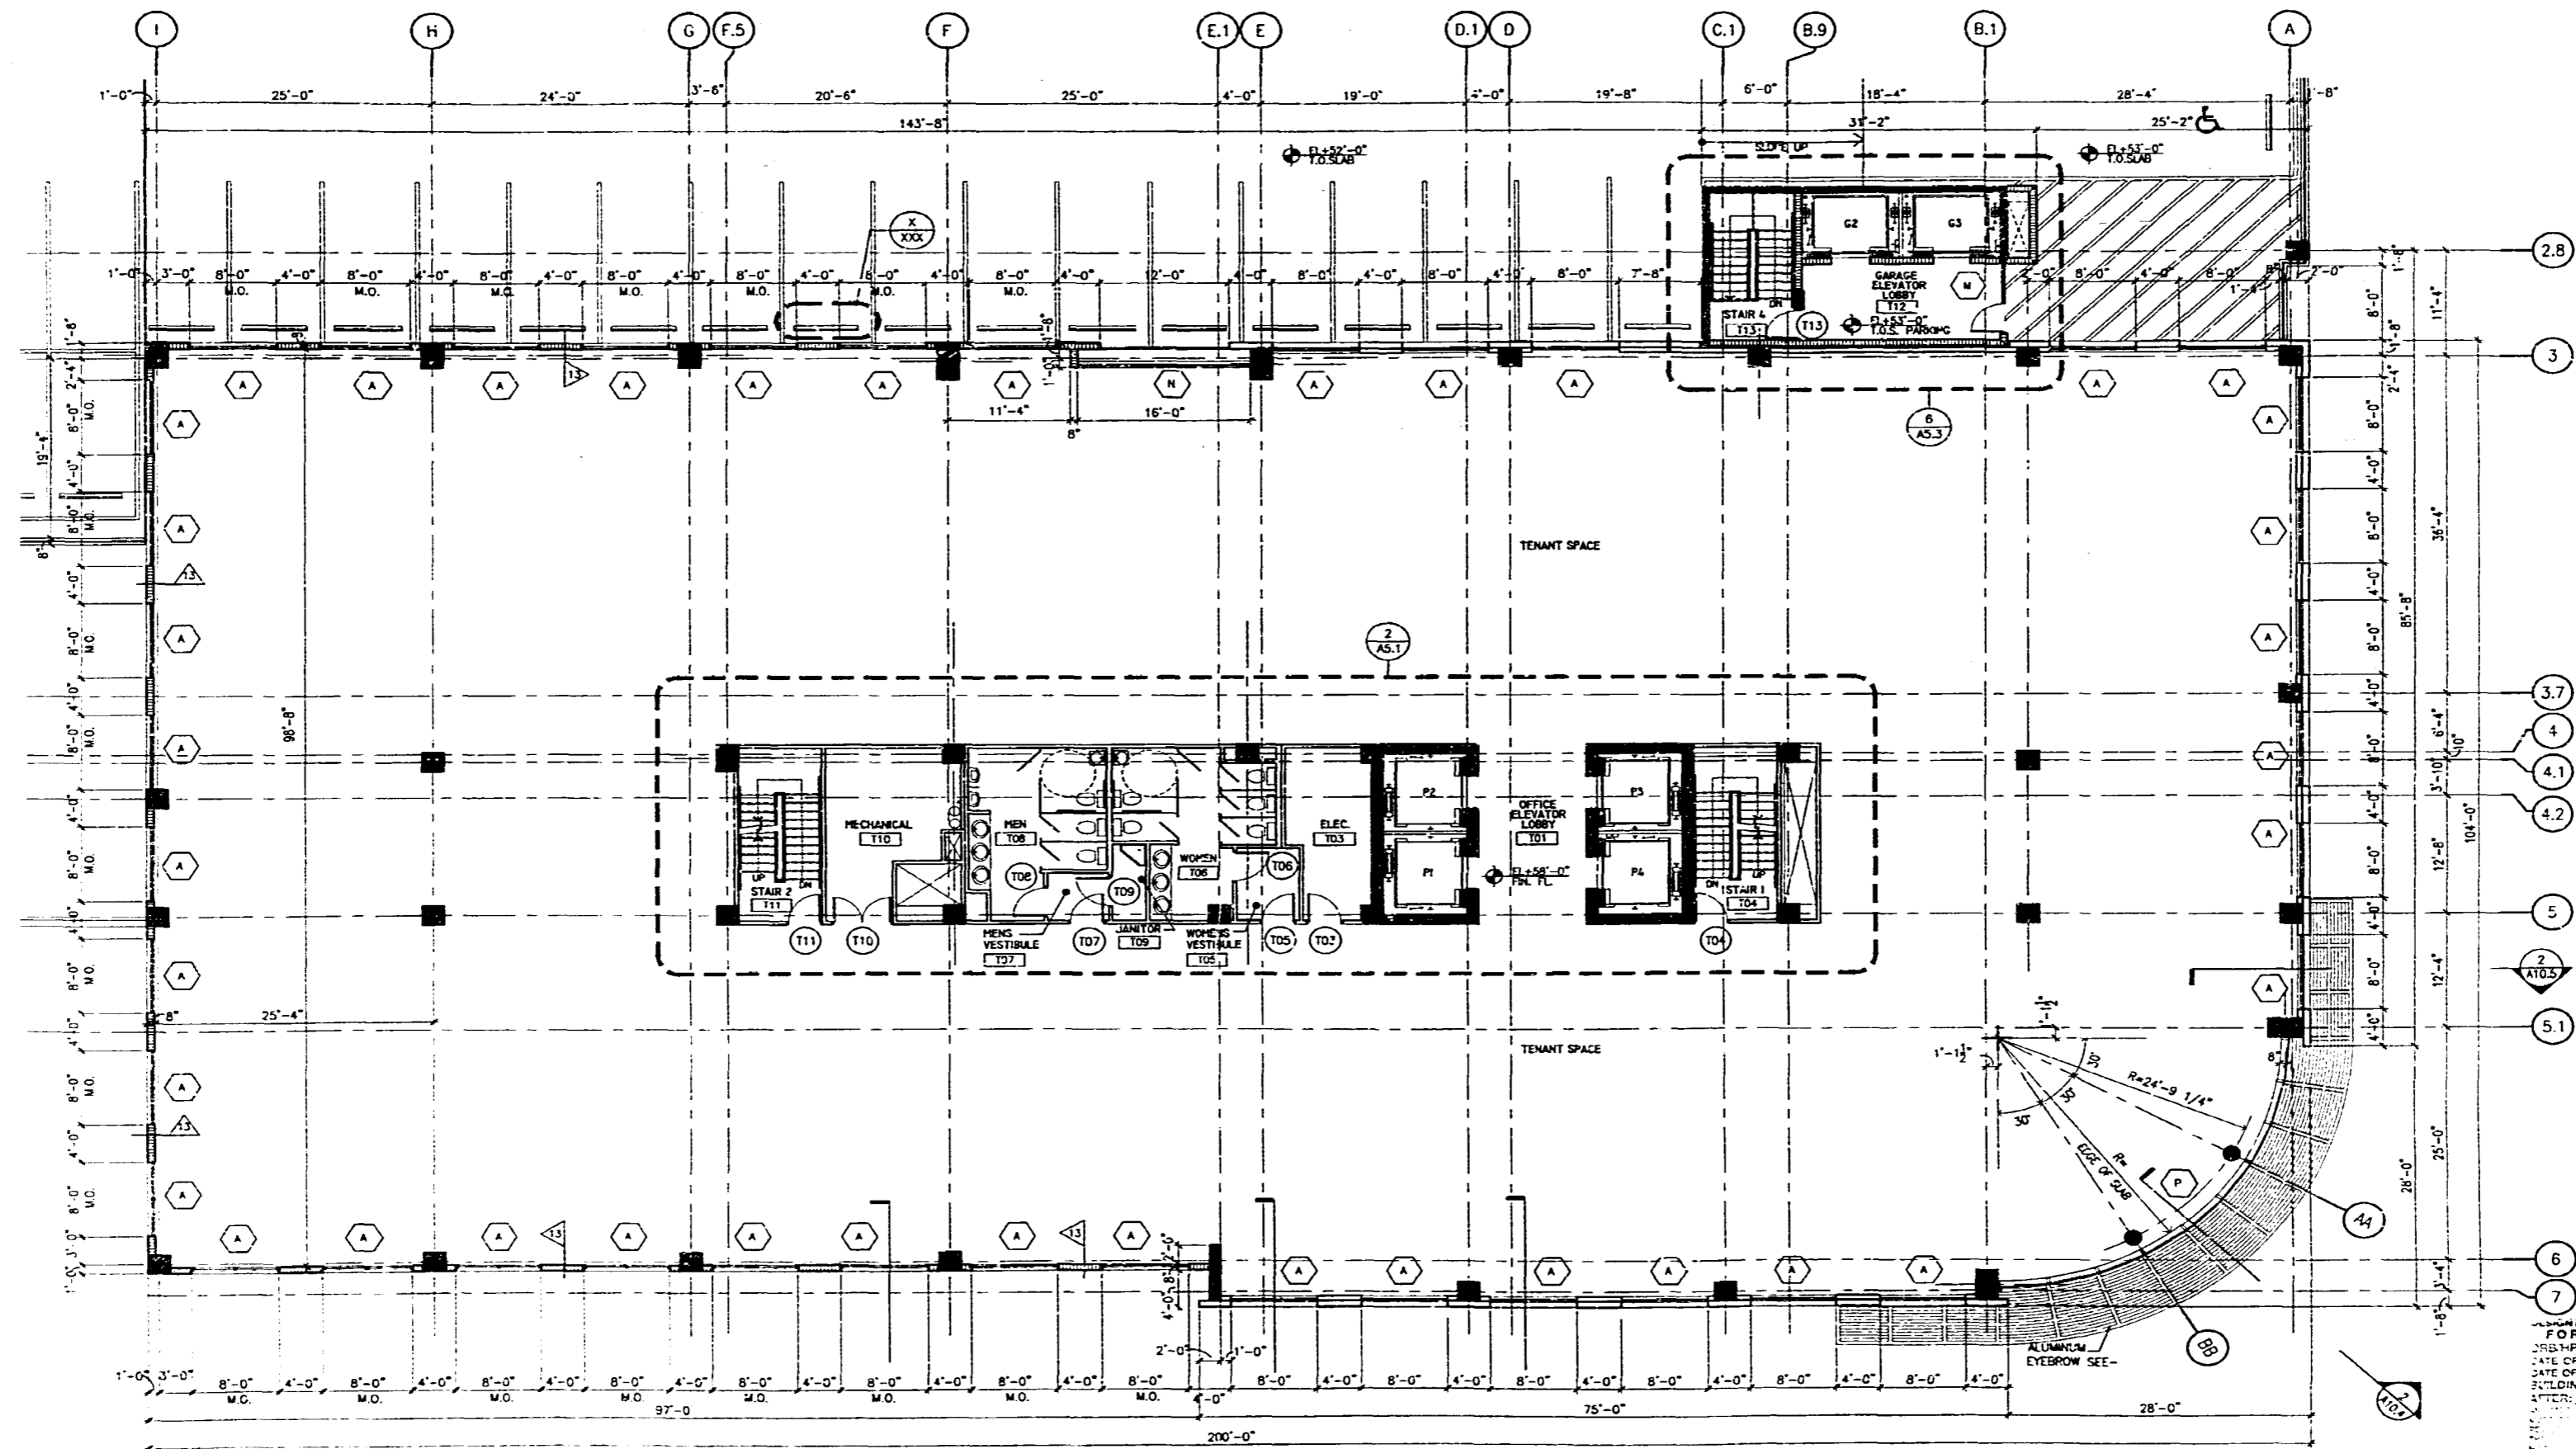

PARTIAL 500 LEVEL FLOOR PLAN
SCALE: 1/8" = 1'-0"

APPROVED SUBJECT TO
ENGINEER'S REVIEW
ELEVATION

W. J. [Signature]
[Signature]

NO REVIEW OR RESERVATION
FOR BUILDING PERMIT
OR SHPB FILE #.
DATE OF BOARD APPROVAL
DATE OF FINAL APPROVAL BY THE
BUILDING PERMIT CANNOT BE ISSUED
UNLESS THESE ITEMS CHANGE
ARE NOT TO BE USED FOR ANY OTHER
PROJECTS


LINCOLN PLACE
1801 WASHINGTON AVENUE
MIAMI BEACH FLORIDA

9808
A4.2



**NICHOLS
BROSCH
SANDOVAL
& ASSOCIATES, INC.**
Architects & Planners

1250 Brickell Avenue
Miami, Florida 33131
Tel: (305) 372-1100
Fax: (305) 372-1101

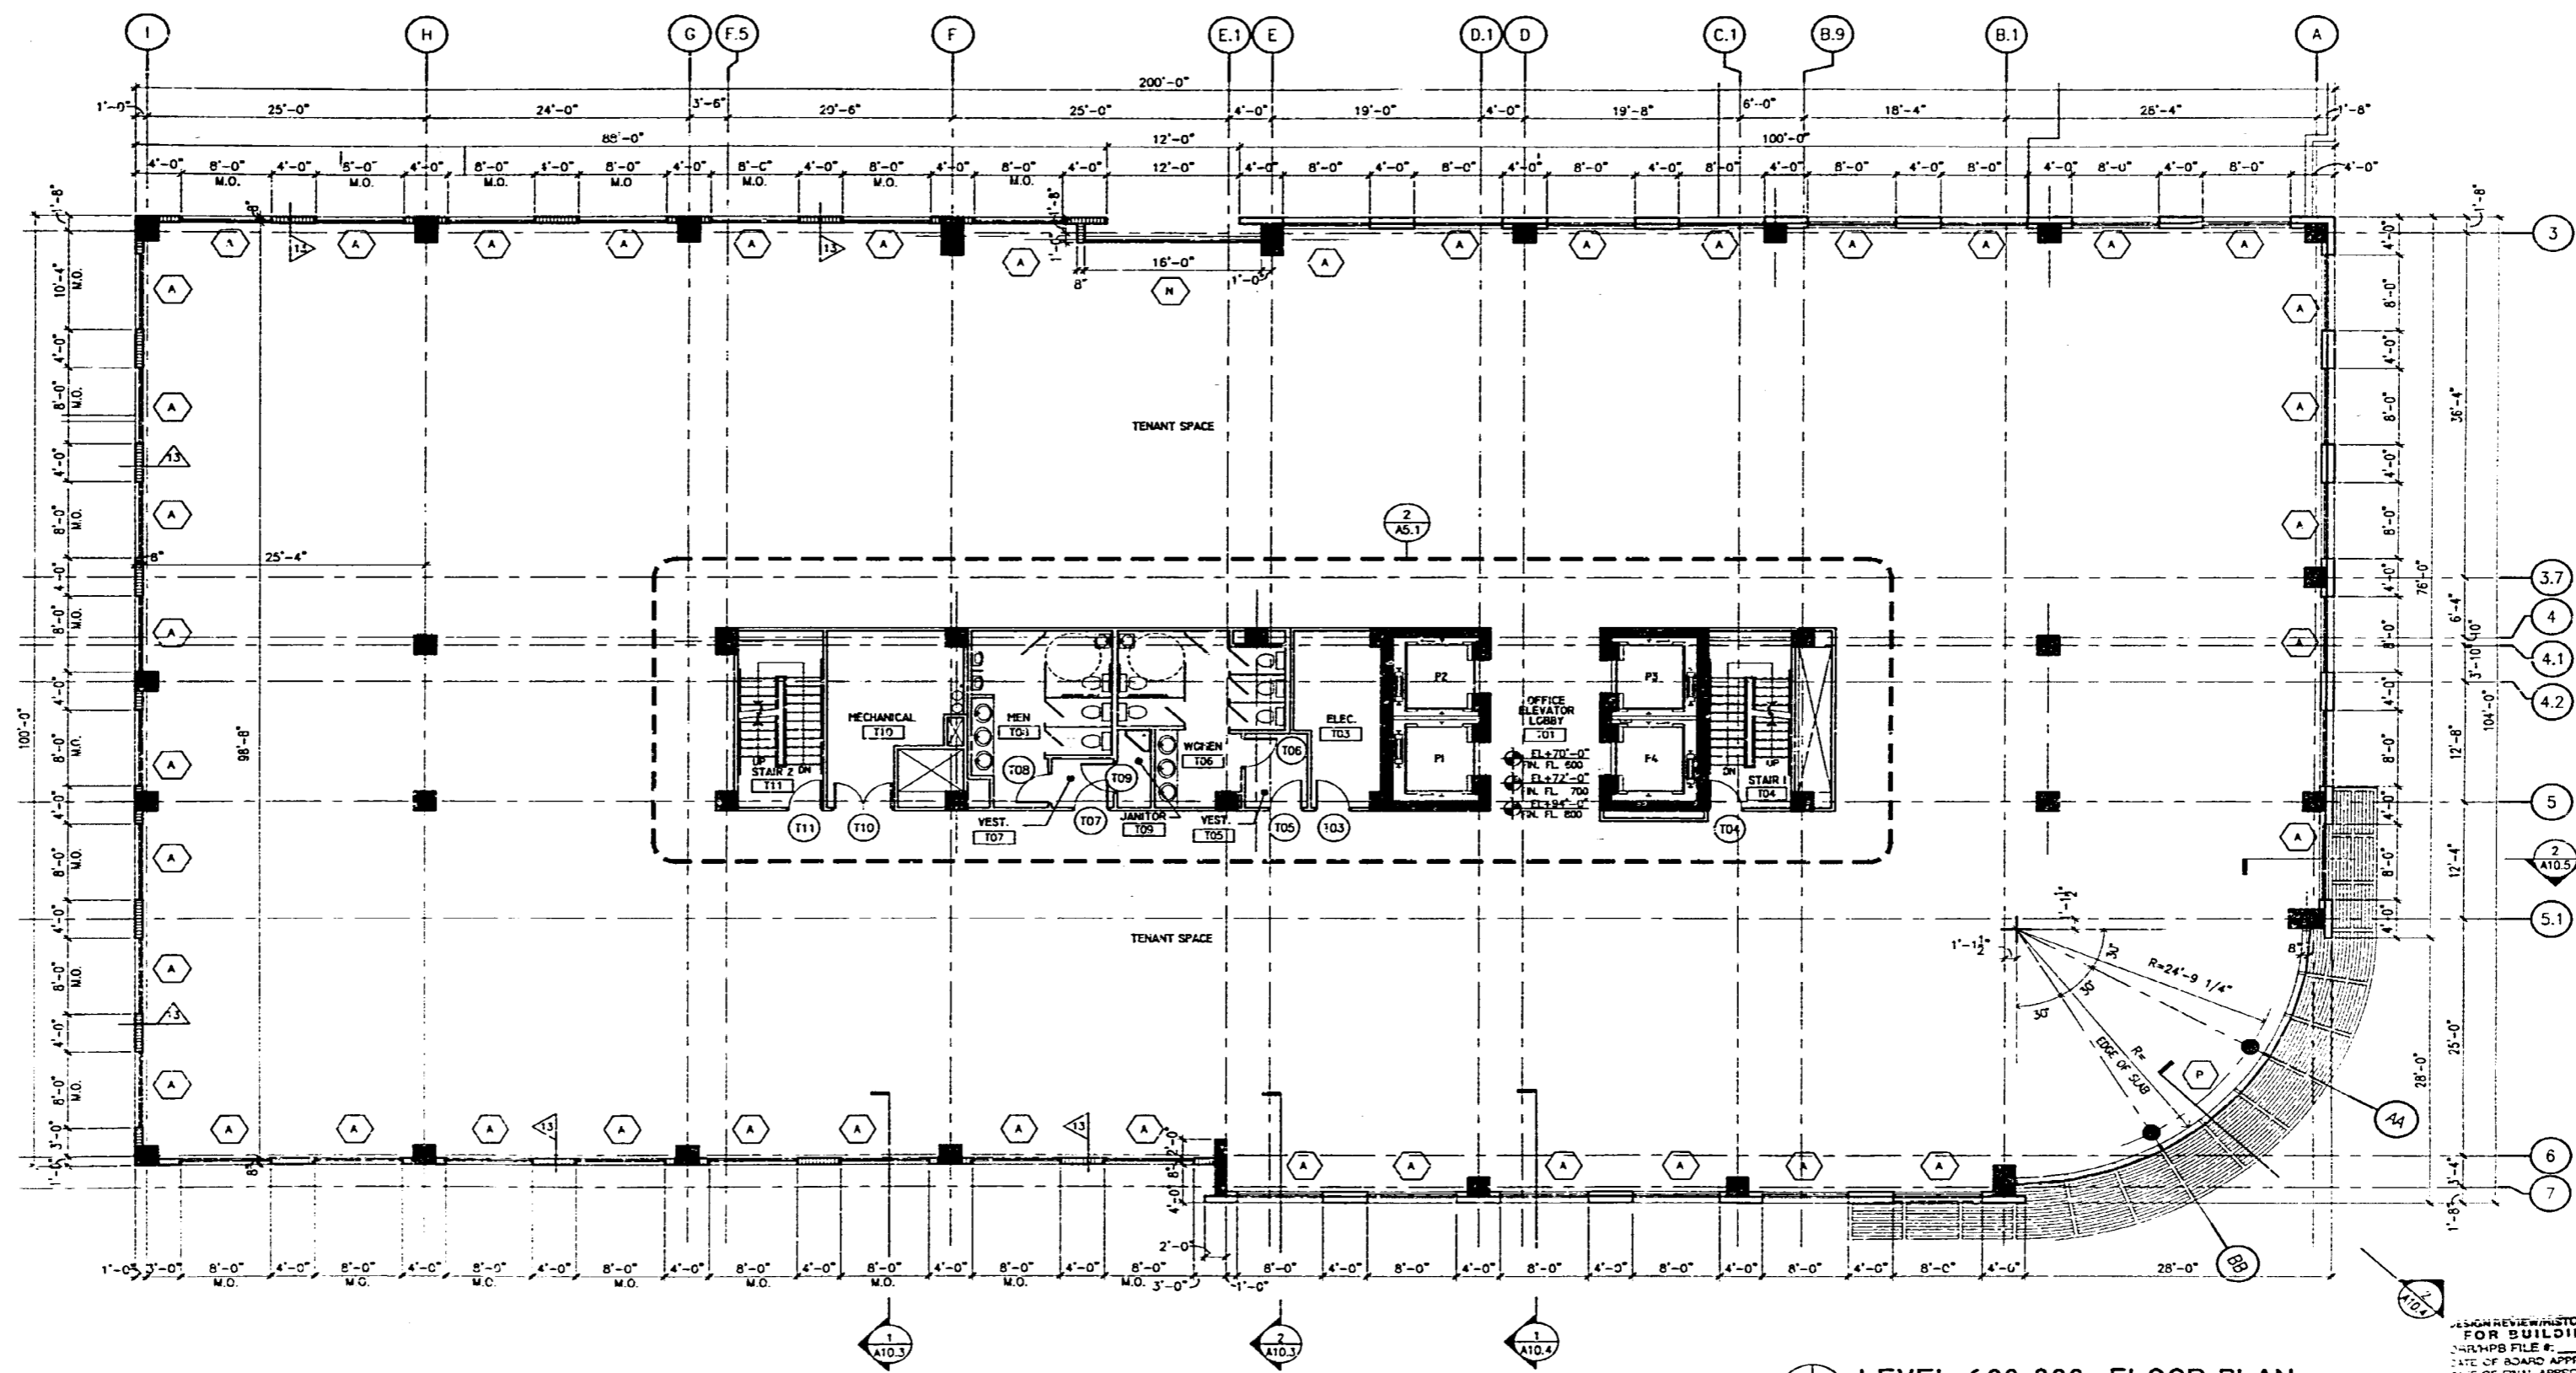


LEVEL 600-800 FLOOR PLAN
SCALE: 1/8" = 1'-0"

Handwritten signature
APPROVED FOR THE CITY OF MIAMI
ENGINEER

SEAL REVIEW/HISTORIC PRESERVATION
FOR BUILDING PERMIT
SHEETS FILE #:
DATE OF BOARD APPROVAL: _____ BY: _____
BUILDING PERMIT CANNOT BE ISSUED
UNTIL THIS SEAL IS OBTAINED

LINCOLN PLACE
1801 WASHINGTON AVENUE
MIAMI BEACH, FLORIDA

9808
A4.3

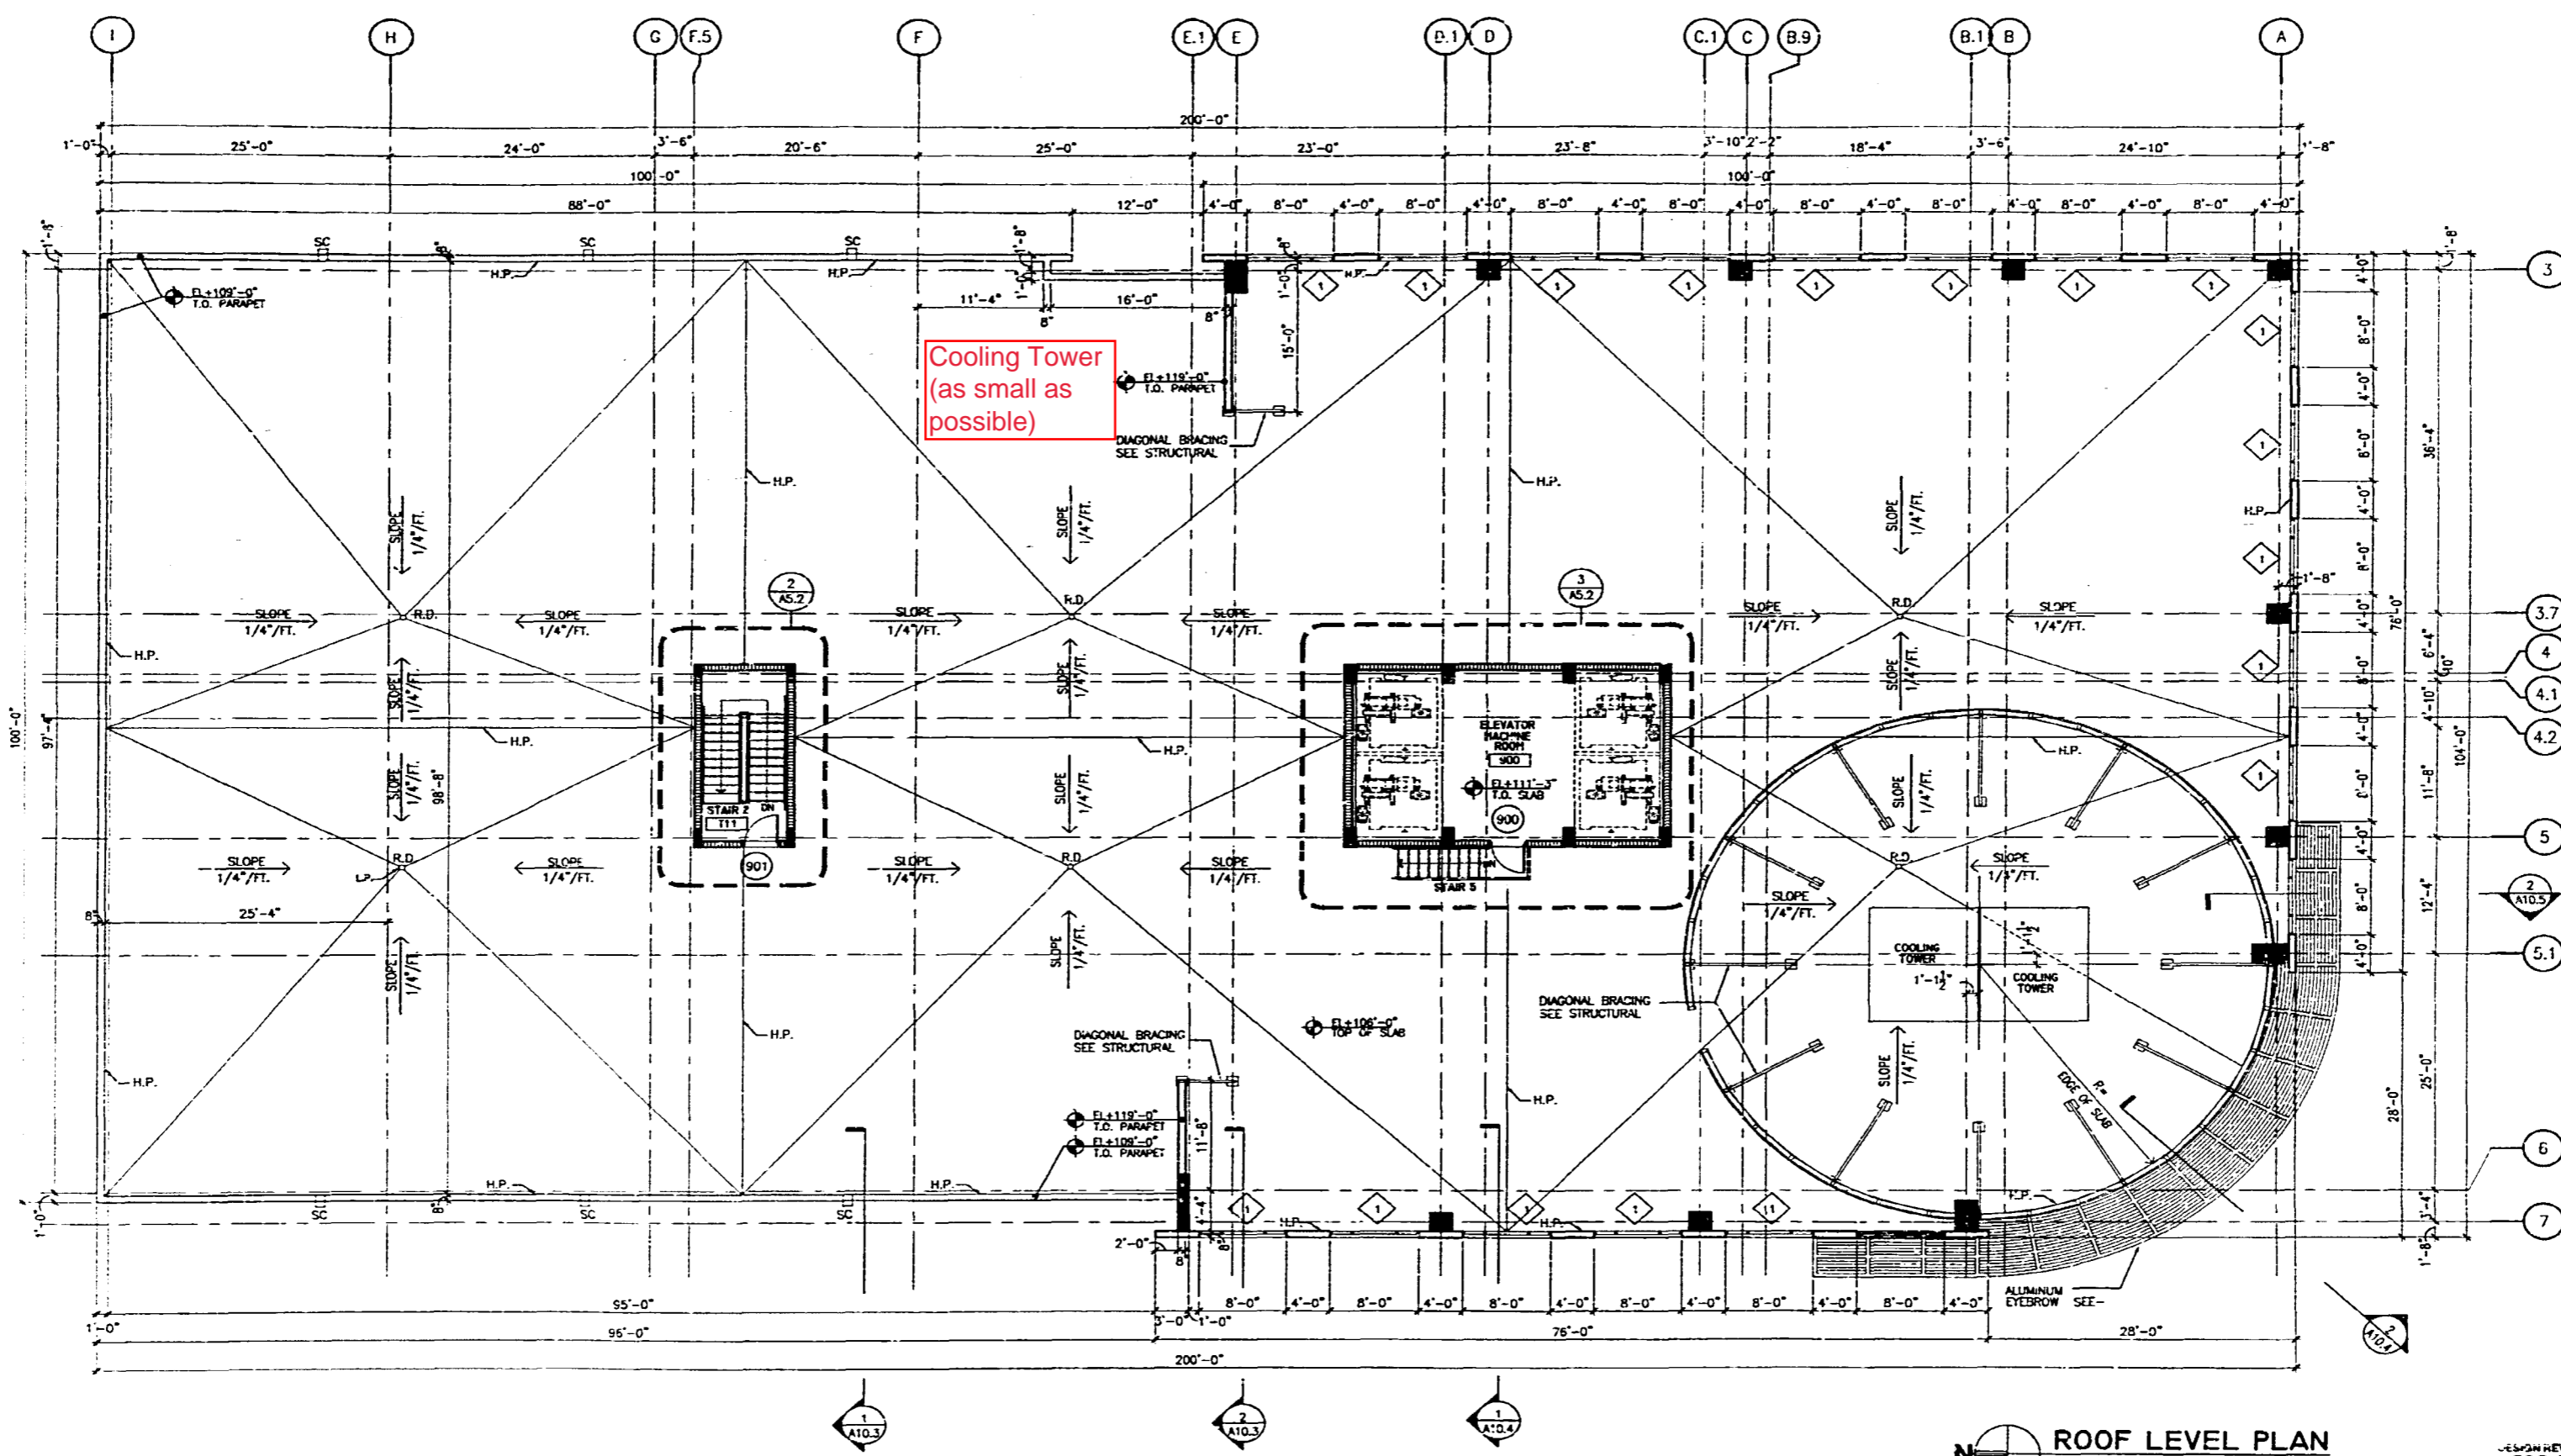

ROOF LEVEL PLAN
SCALE: 1/8" = 1'-0"

APPROVED FOR BUILDING PERMIT
DATE OF BOARD APPROVAL: 8/17/2008
DATE OF FINAL APPROVAL: 8/17/2008
BY: [Signature]
FOR: [Signature]

FOR HISTORIC PRESERVATION
FOR BUILDING PERMIT
DATE OF BOARD APPROVAL: 8/17/2008
DATE OF FINAL APPROVAL: 8/17/2008
BY: [Signature]
FOR: [Signature]

LINCOLN PLACE
1601 WASHINGTON AVENUE
MIAMI BEACH FLORIDA

9808
A4.4