

HPB23-0572

7801 Atlantic Way

Certificate of Appropriateness for
Demolition and Design

Historic Preservation Board

September 12, 2023

SDH_STUDIO
ARCHITECTURE+DESIGN

HERITAGE



BERCOW RADELL FERNANDEZ LARKIN + TAPANES
ZONING, LAND USE AND ENVIRONMENTAL LAW

Historic District – 1987

- State was acquiring lots to expand ocean front park, but many owners refused to sell.
- The City initiated the designation of ADM to preserve the single-family character of the neighborhood.



Fig. 5. Sanborn Map showing future Altos Del Mar Historic District, 1951.

(Sanborn Map, 1921-Nov 1951)

Historic District – 1987

- 36 total lots.
- 20 were vacant at the time of designation.
- Of the 7 waterfront structures that existed when the District was created, 3 remain.



Altos Del Mar Historic District Designation Report

- Characteristics:
 - Interior courtyards
 - Wide, overhung porches and terraces
 - Thick masonry walls
 - Generous use of indigenous materials



Altos Del Mar Historic District Designation Report

- New construction shall be compatible with the existing structures in terms of:
 - Site
 - Scale
 - Setbacks
 - Use of materials
 - Site lines
- “Imitative architecture is not encouraged, while contemporary design utilizing those characteristics listed above is recommended.” (Pg. 13)



Altos Del Mar – Design Guidelines


**CITY OF
MIAMI BEACH**

**ALTOS DEL MAR
DESIGN GUIDELINES**

Exhibit 2
Adopted by the Historic Preservation Board

August 10, 2000

CITY OF MIAMI BEACH
1700 Convention Center Drive, Miami Beach, Florida 33139
<http://ci.miami-beach.fl.us>



Office of the City Manager Telephone (305) 673-7010
Facsimile (305) 673-7782


COMMISSION MEMORANDUM NO. *146-01*

TO: Mayor Neisen O. Kasdin and
Members of the City Commission Date: March 14, 2001

FROM: Jorge M. Gonzalez *Jorge* SECOND READING
City Manager

- “This blending of new and old must respect the history and character or neighborhood, maintaining the casual beachfront atmosphere and modest scale of buildings, while adapting to realities of modern times.”
- “A much greater challenge is presented by the State of Florida’s coastal flood protection laws.”

Context Aerial

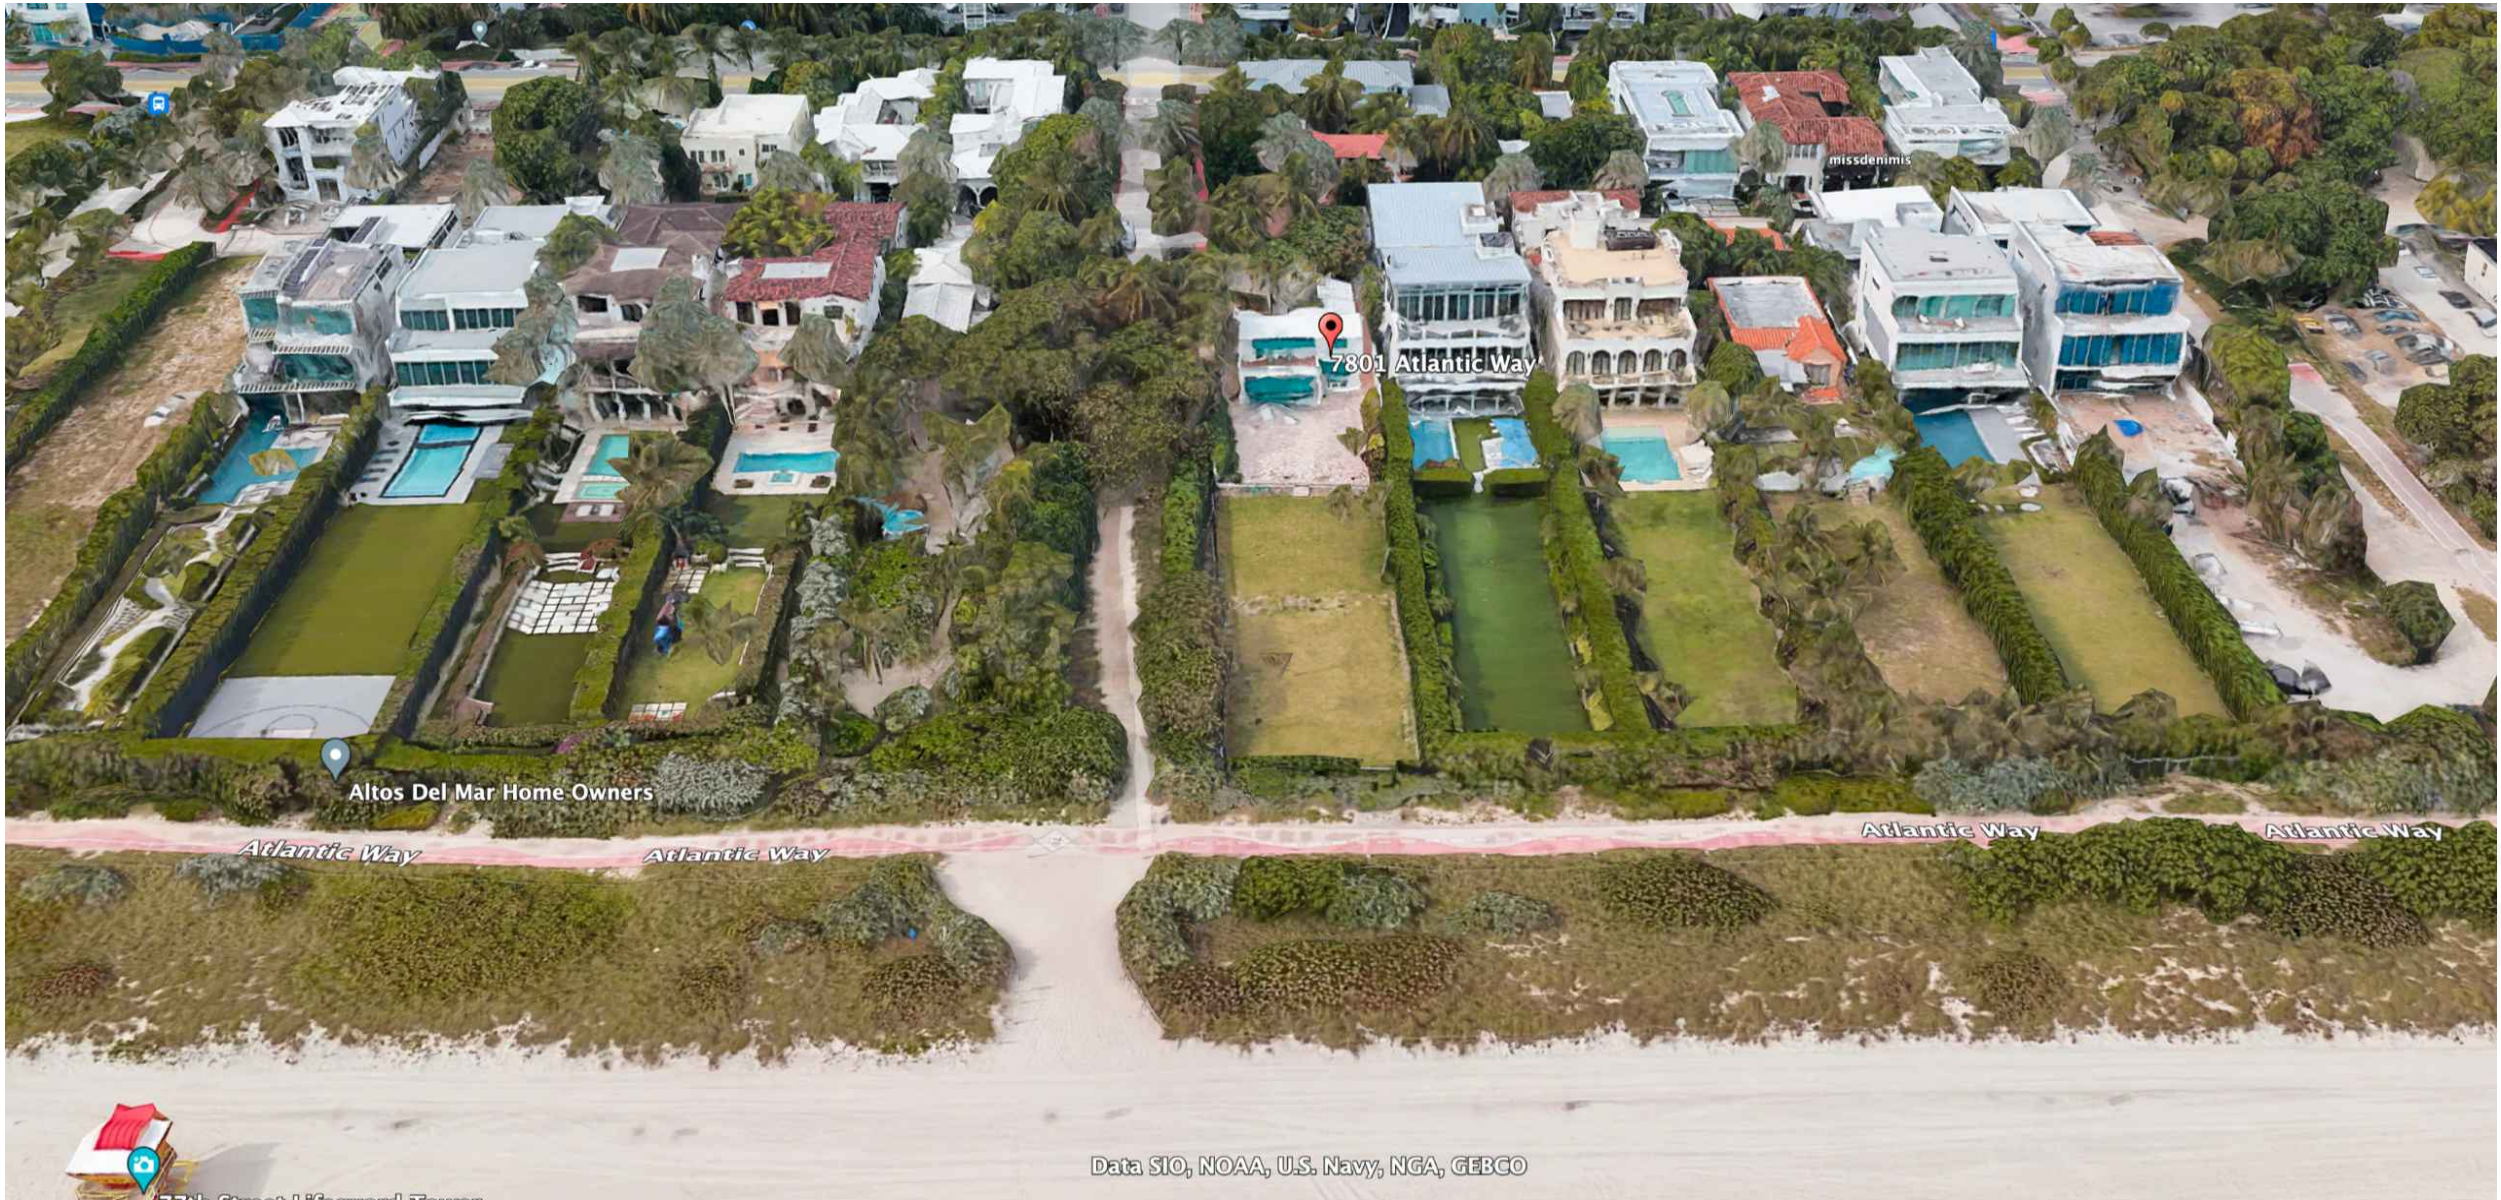

Northern Half of ADM



Data SIO, NOAA, U.S. Navy, NGA, GEBCO

Southern Half of ADM



House No.	Year Built	Existing at the Time of Designation	Demolition approval
7845	Under Construction	YES- 1956 Privately Owned	HPB18-0186 on April 10, 2018. Total demolition.
7833	2019	No	HPB7438 May 28, 2014. New single family home.
7837	1925	YES	
7825	2015	YES- 1932 State-owned	Demolition pursuant to Unsafe Structures Violation No. BV03000419. HPB3474, Vacant at the time of HPB approval on March 14, 2006.
7815	2015	YES- 1936 State-owned	Demolition pursuant to Unsafe Structures Violation No. BV04000629. HPB2968, Vacant at the time of HPB approval on September 13, 2005.
7801	1935	YES	
7747	1948	YES	
7737	2012	YES- 1935 State-owned	HPB551 on December 7, 2007. Total demolition.
7725	2012	No	HPB4172 December 6, 2012. New single family home.
7717	2017	No	HPB7363 May 14, 2013. New single family home.
7709	2019	No	HPB7415 December 18, 2015. New single family home.
7701	Vacant	No	HPB3678 June 13, 2006. New single family home.



7801 Atlantic Way

- 1936
- Schoeppl and Southwell

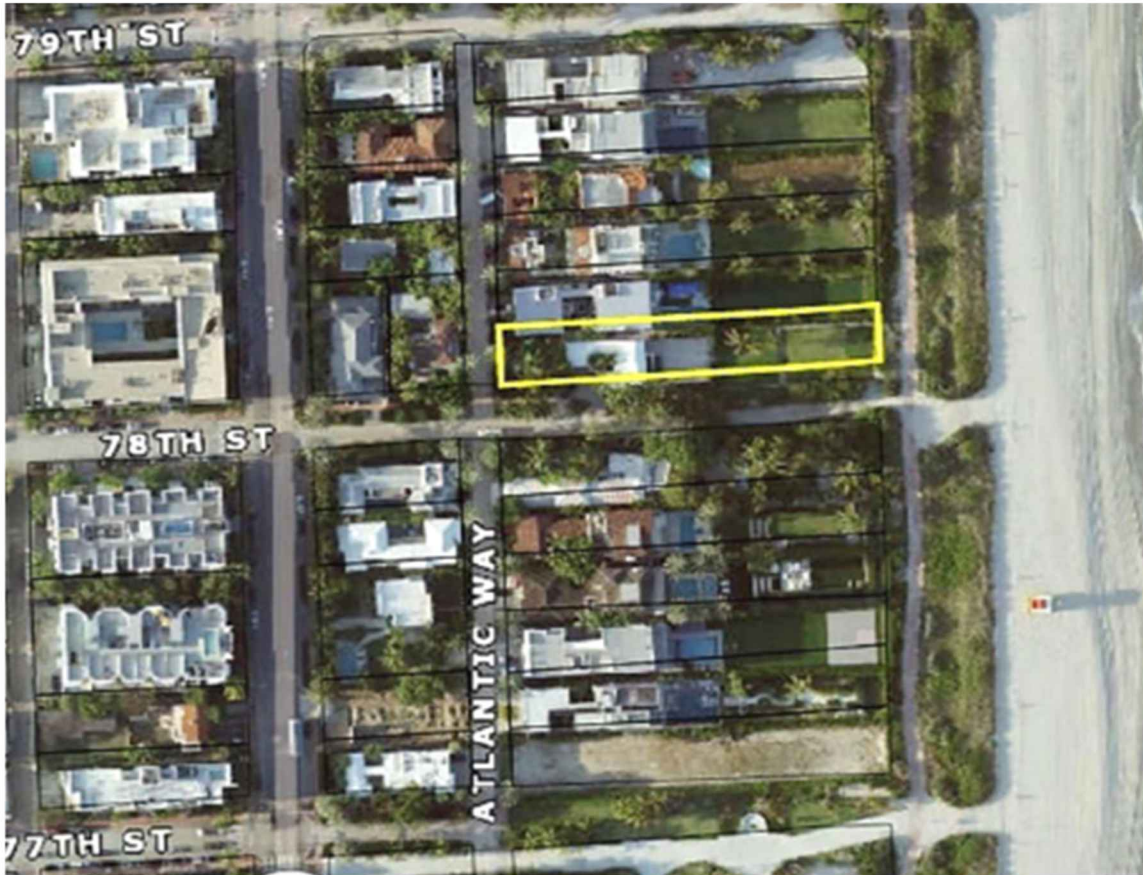


Figure 42. View of east elevation showing enclosed porch, February 1995.
(Office of the Property Appraiser, Miami-Dade County)



Figure 43. View of front façade of 7801 Atlantic Way, February 1995.
(Office of the Property Appraiser, Miami-Dade County)

Current Photos



CONTEXTUAL IMAGE - 1



CONTEXTUAL IMAGE - 4




CONTEXTUAL IMAGE - 5

Structural Noncompliance Summary

Requirement	Existing
Department of Environmental Protection: Habitable Space must be elevated to +18.2' NGVD	First floor is at 13' NGVD elevation, which is deficient by 5'
Florida Building Code §3109.3.3/ASCE 24: Home must be elevated and supported on piles or column	Existing concrete block foundation (walls of the home) evenly distribute weight into the ground. No independent support system
Florida Building Code §3109.3.4/ASCE 24 § 4.6: Area of the home that is below wave crest height must provide breakaway walls and non-load bearing elements	Current home does not have breakaway walls and the load-bearing walls include living spaces below 18.2' NGVD. A load bearing masonry wall cannot become breakaway
Florida Building Code §1612: Finish Floor and all mechanical and electrical equipment elevated 1' above BFE of 8' NGVD	Finished floor is at 13' NGVD, however all mechanical and electrical equipment is at or below 9' NGVD
ASCE 7-16: Specific Design Standards for roofs established in 2018	Roof is approximately 21-years old and does not meet the newest design standards high velocity hurricane storms

Why Can't Breakaway Walls be Introduced?

- Walls evenly distribute load to the foundation, stacked in layers
- Load-bearing masonry walls, beams, and columns cannot be reconfigured to breakaway walls
- Current walls are not reinforced
- Current walls are not built to withstand 175 miles per hour wind speed

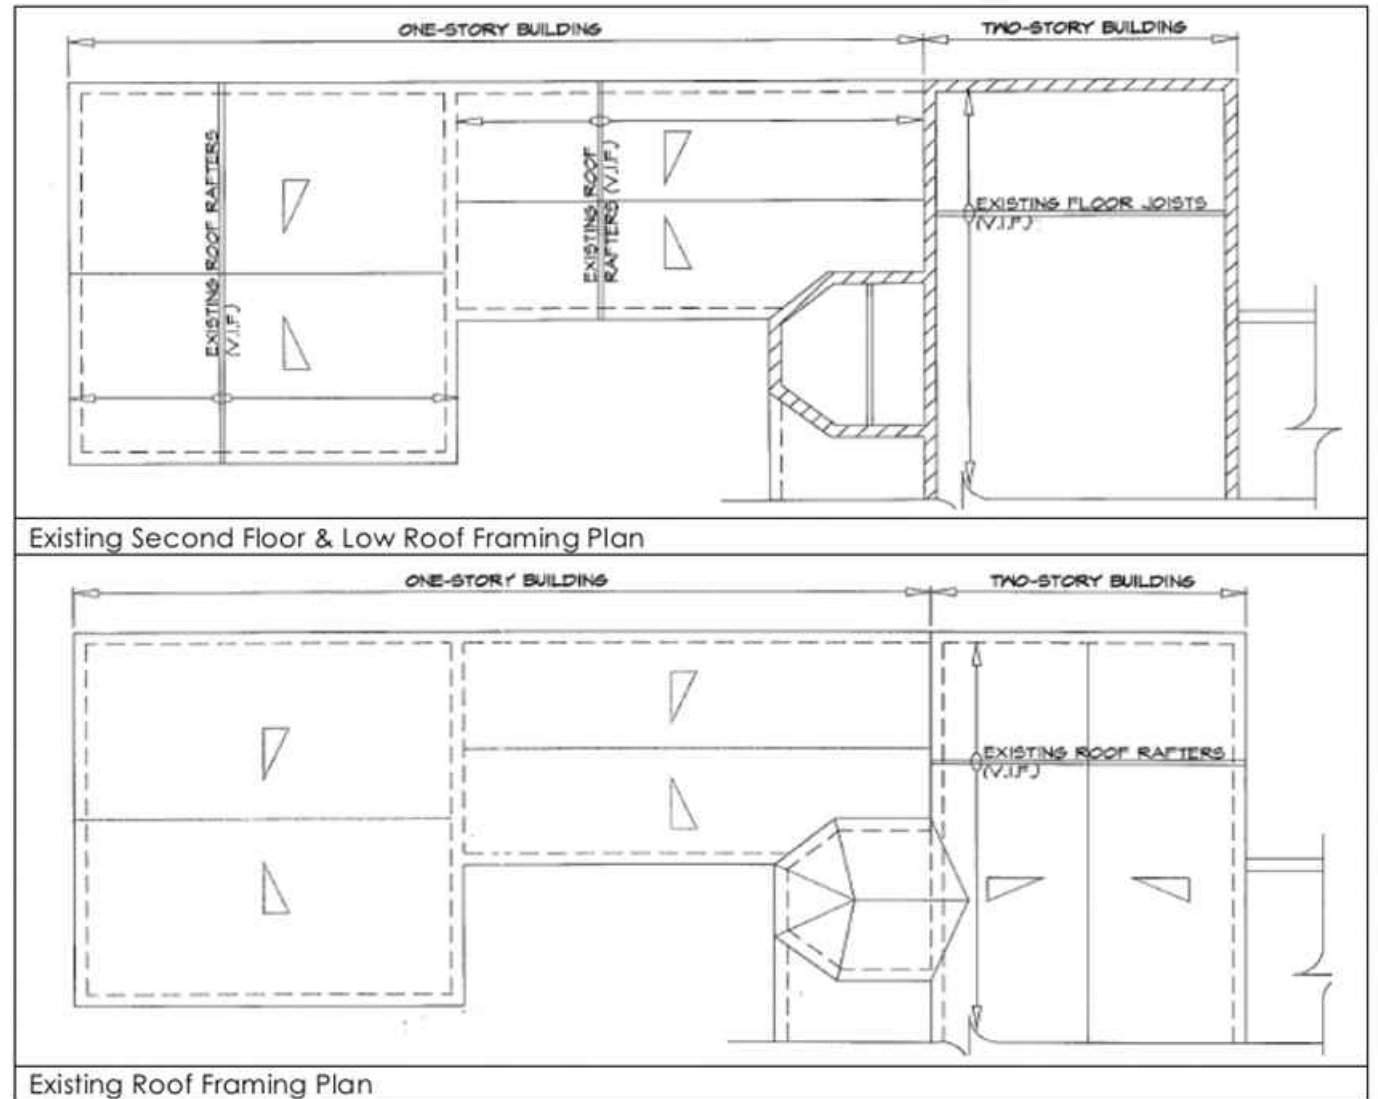

Structural Diagram

Structural Integrity Issues

- Concrete lintel beams have several critical linear cracking and corroding of rebar
- Once concrete cracks, the integrity and design capacity of the structural elements are not guaranteed
- Crawl space shows wood framing deterioration



Concrete Testing

- 26 out of 31 samples failed minimum standards required pursuant to ACI 318 Table 4.3.1
- **Result:** the home is compromised to resist future substantial flood, wind, or storm event (i.e. hurricane), safely and without danger of collapse
- It is not possible to increase the strength of hardened concrete




Roof

- Approximately 21-years old
- Inconsistent with ASCE 7-16 wind load requirements
- Additional ties will not make it more resistant to wind pressure because the masonry walls are not reinforced
- The walls and foundation would not guarantee resistance to uplift loads

ASCE 7-16

Figure 26.5-1B

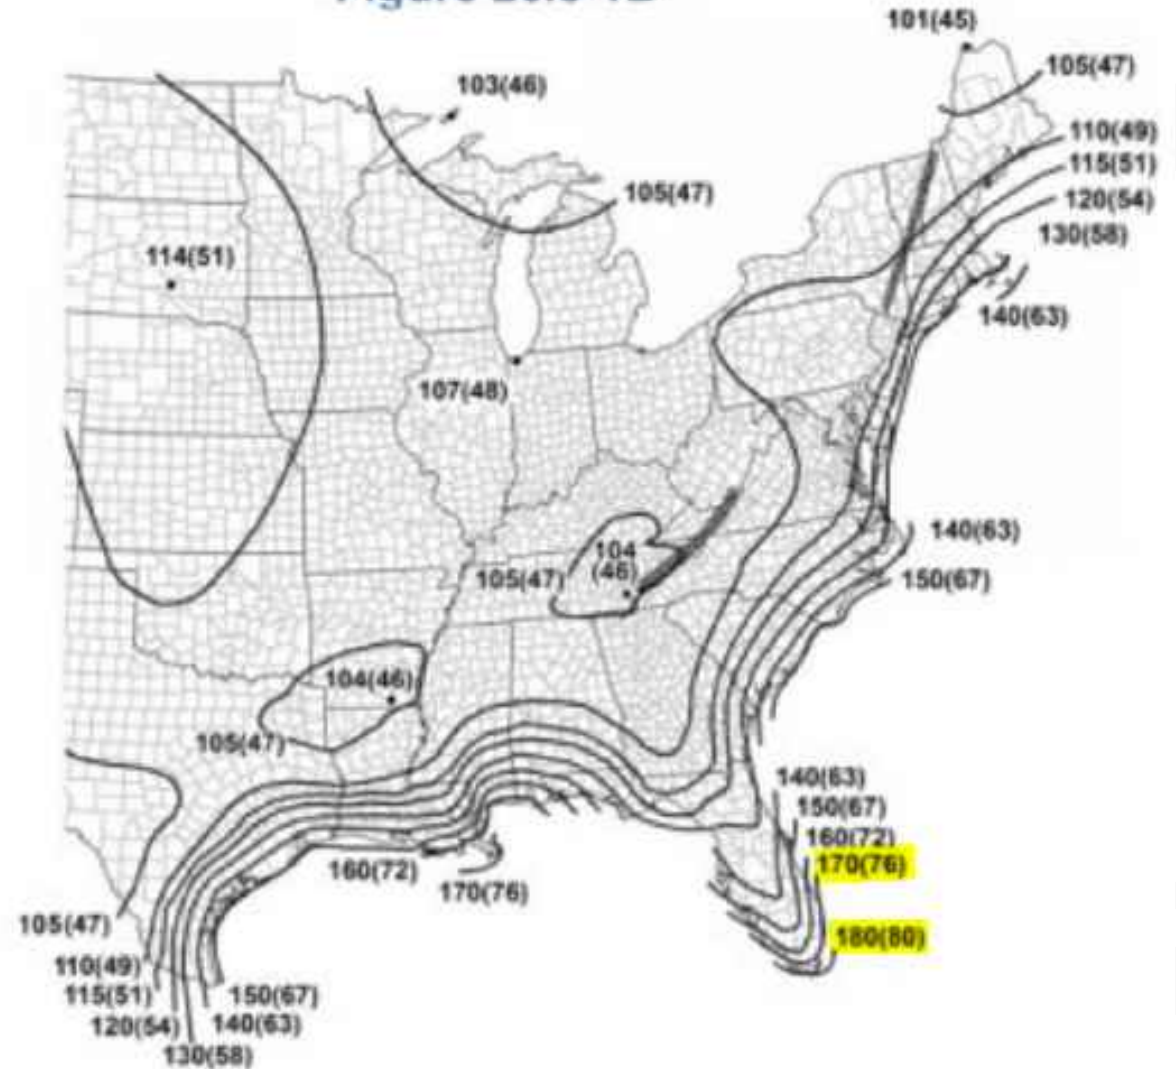

V = 175 mph (Miami Area)

Raising the home to Wave Crest would require the following actions:

1. Demolish and rebuild foundation system for new loads from wave crest
2. Demolish walls and change support system to beam and column framings, and reinforce
3. Demolish all framing of second level and rebuild at necessary elevation
4. Demolish and rebuild roof and reinforce to new framing
5. Reconfiguration of all plumbing and electrical above required elevations to prevent water intrusion

Can it last another 100 years?

- Increased maintenance required
- Florida Building Code and DEP Regulations anticipate worst case scenario the 100-year storm
- It is readily apparent that Global Warming is causing disastrous flood and fire events throughout the world
- There is no reason to believe that the City of Miami Beach will be spared from future catastrophic events
- In fact, the City has adopted the **Resiliency Code** in recognition of the fragility of this coastal city

Flood Risks – Vermont Example



Vermont flooding: Rising waters in Montpelier visible from space

A photo taken by satellite imagery company BlackSky shows the widespread destruction on Tuesday, July 11

Share



Updated: 2:09 PM EDT Jul 17, 2023

Flood Risks – Fort Lauderdale Example

Florida mops up after floods close Fort Lauderdale airport

Freida Frisaro and Daniel Kozin

[The Associated Press](#) Staff
Contact

Published Thursday, April 13, 2023 6:25AM EDT
Last Updated Friday, April 14, 2023 6:46AM EDT



A flooded runway at Fort Lauderdale- Hollywood International Airport, on April 13, 2023. (Marta Lavandier / AP)

Record Breaking Water Temperatures



CLIMATE

Climate scientists are alarmed by record water temperatures off Florida's coast

July 17, 2023 · 5:10 AM ET

Heard on Morning Edition

By Jenny Staletovich



3-Minute Listen

+ PLAYLIST



Some climate scientists are alarmed by the high ocean temperatures off Florida's coast. Coral reefs and fish are at risk.

Stronger Hurricanes

Florida ocean temperatures at ‘downright shocking’ levels

The extreme heat around Florida is further intensifying the state’s ongoing heat wave and could make hurricanes worse



By [Dan Stillman](#)

Updated July 10, 2023 at 2:16 p.m. EDT | Published July 10, 2023 at 2:06 p.m. EDT



**2005
Hurricane Dennis
Walton County**



The structure along the left edge of the photo appears to have been built in compliance with FDEP criteria. The pile foundations appear to have been designed to withstand 100 year storm conditions. Little to no impacts are seen at that site. The thickness of piles is greater than other structures.



Figure 17a. Timber seawall and single-family dwelling destroyed in South Ponte Vedra, St. Johns County (R088+250').

**2017
Hurricane Irma
St. John's County**



Figure 91. Single-family dwelling destroyed, Long Beach, Big Pine Key.

**2017
Hurricane Irma
Big Pine Key**

**2018
Hurricane Michael
Mexico Beach**

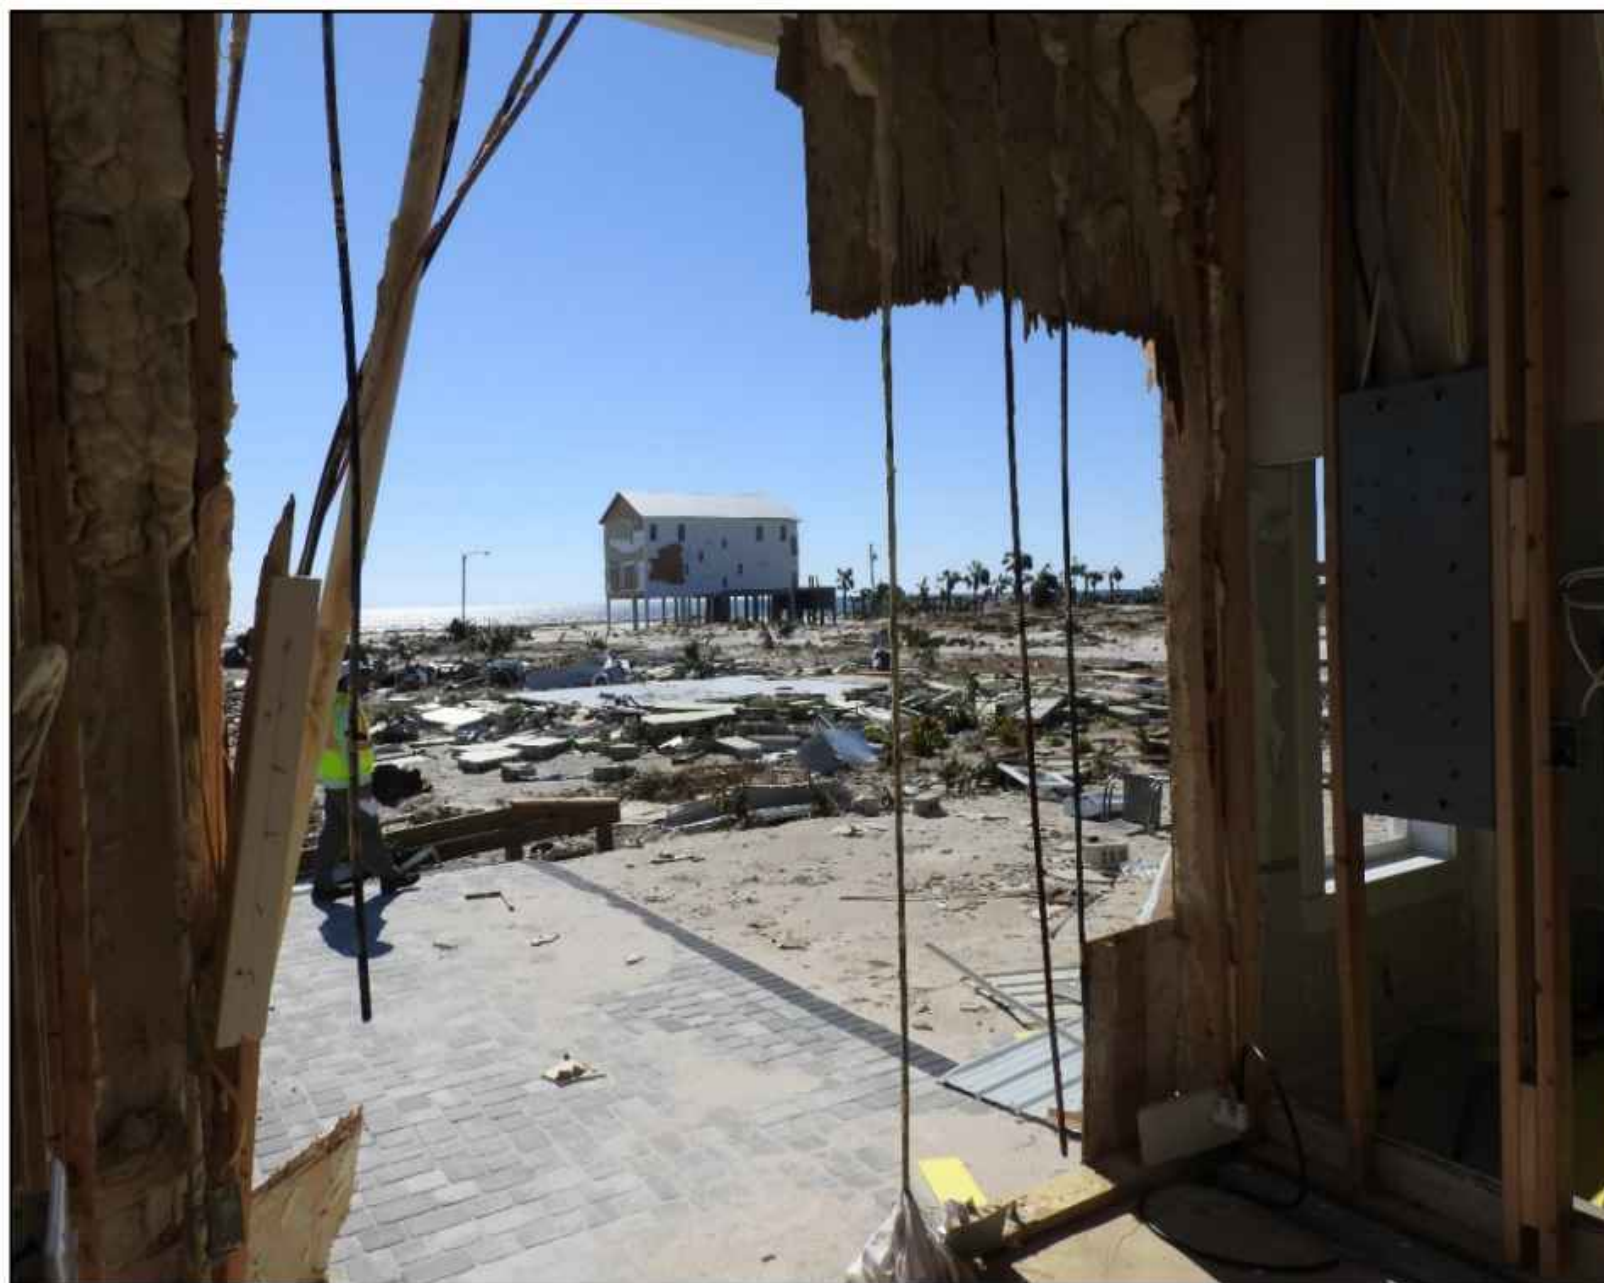


Figure 36. Dwellings destroyed by storm surge near R132, Mexico Beach.

**2022
Hurricane Ian
Cape Coral**



Figure 101. Dwelling destroyed near R211, Southwest Cape.

Coastal Permitting Compliance

Requirement	Proposed
<p>DEP 100-year Storm and FBC §3109.3.3: Habitable Space elevated +18.2' NGVD (Wave Crest Elevation)</p>	<p>Main living space will be located at 21'-5" NGVD</p>
<p>FBC §3109.3.3/ASCE 24: Home must be elevated and supported on piles or column</p>	<p>Home will be built on structural piles and columns</p>
<p>FBC §3109.3.4/ASCE 24 § 4.6: Below wave crest height must provide breakaway walls and non-load bearing elements</p>	<p>Home will provide breakaway walls under base flood conditions</p>
<p>FBC §1612: Finish Floor and all mechanical and electrical equipment elevated 1' above BFE of 8' NGVD</p>	<p>Siting of mechanical and electrical equipment elevated</p>



7825 ATLANTIC WAY



7815 ATLANTIC WAY



7801 ATLANTIC WAY



BEACH ACCESS



7747 ATLANTIC WAY

SDH_STUDIO
ARCHITECTURE+DESIGN

AA26002883
18200 NE 19TH AVE, SUITE 100
NORTH MIAMI BEACH, FL 33162
(305) 501-5013
INFO@SDHSTUDIO.COM



STEPHANIE D. DE HALFEN
ARCHITECT P.A.
ARCH REG # 9955

7801
ATLANTIC

7801 ATLANTIC WAY, MIAMI
BEACH, FL. 33141

OWNER

Stephanie Dombusch de Halfen
Digitally signed by
Stephanie Dombusch de Halfen
DN: cn=Stephanie
Dombusch de Halfen
c=US, o=SDH Studio
Reason: I am the
author of this document
Location:
Date: 2023-04-07
17:33:04-00

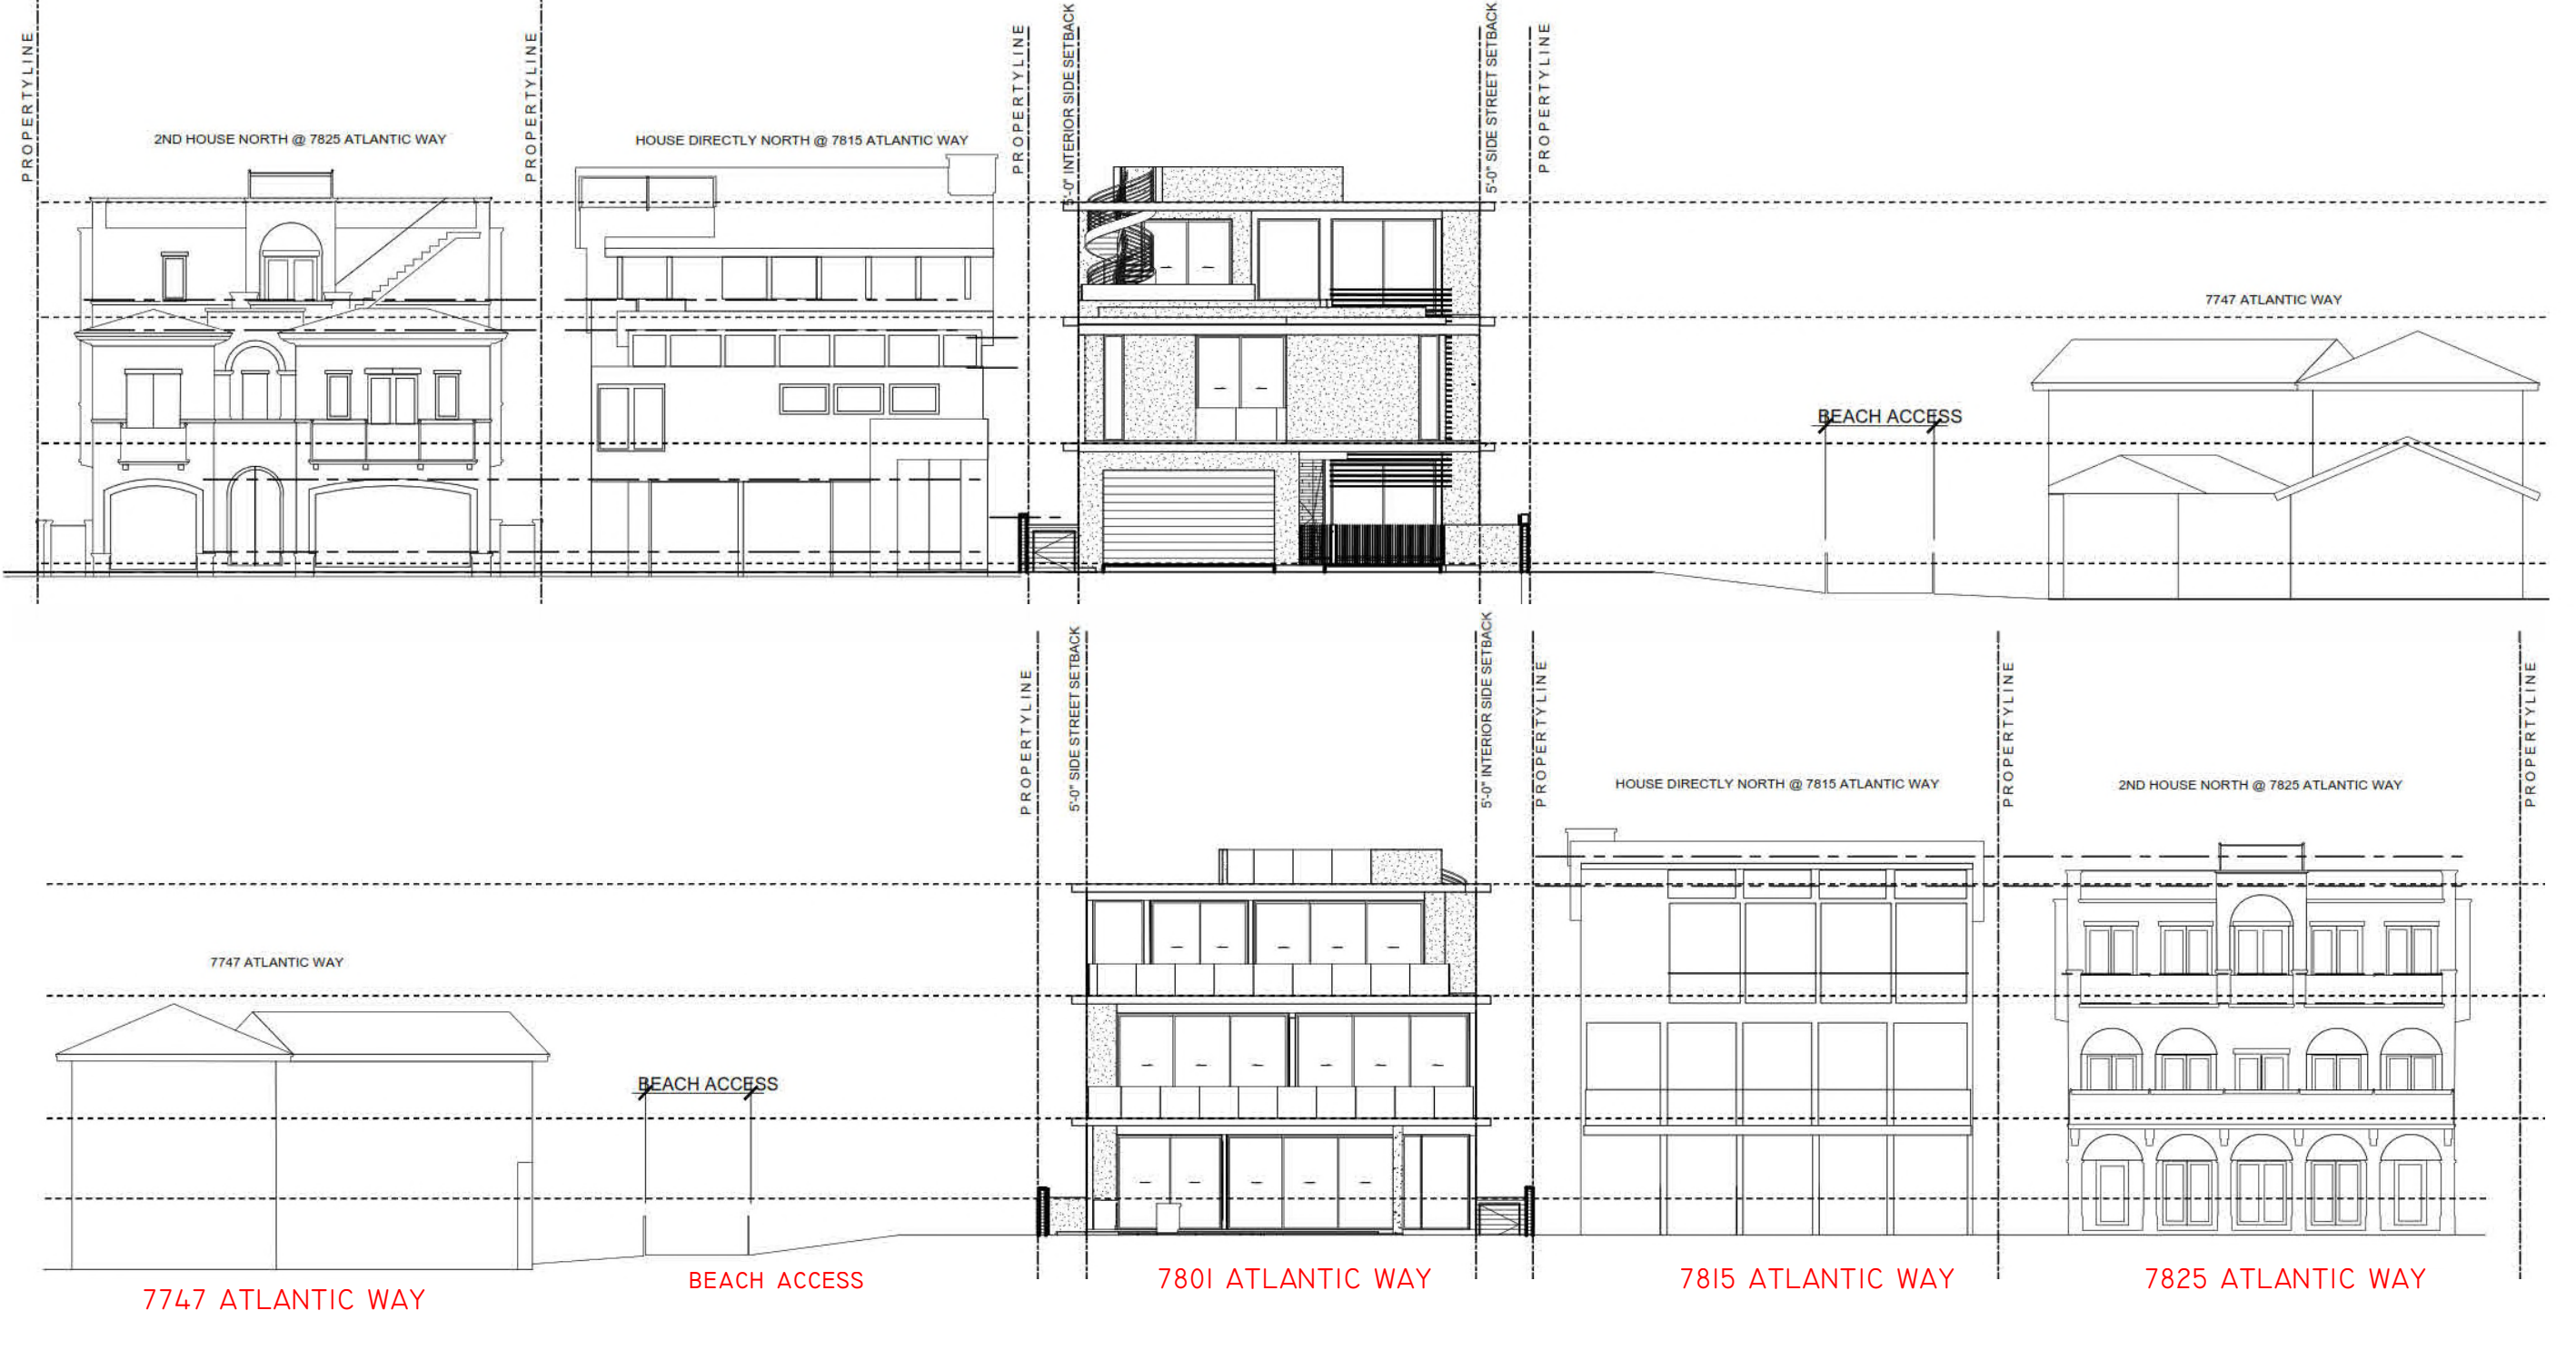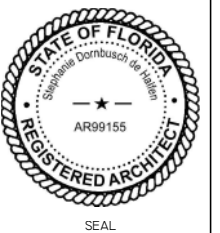

NOTES/COMMENTS

REVISIONS / SUBMISSIONS

I REVISION I 04-07-23

CONTEXTUAL ELEVATION

ALL DRAWINGS AND WRITTEN MATERIAL APPEARING
HEREIN CONSTITUTE THE ORIGINAL AND UNPUBLISHED
WORK OF SDH STUDIO, AND MAY NOT BE REPRODUCED,
USED, OR DISCLOSED WITHOUT THE EXPRESS WRITTEN
CONSENT OF STEPHANIE D. HALFEN

DRAWN BY: SDH
CHECKED BY: RB
INITIAL DRAWING ISSUE DATE
RELEASE DATE:

A-008



SDH STUDIOS

AA26002883
 18200 NE 19TH AVE, SUITE 100
 NORTH MIAMI BEACH, FL 33162
 (305) 501-5015
 INFO@SDHSTUDIO.COM

STEPHANE D. DE HALFEN
 ARCHITECT P.A.
 ARCH REG# 99155

7801
 ATLANTIC

7801 ATLANTIC WAY, MIAMI
 BEACH, FL. 33141

OWNER



NOTES/COMMENTS

REVISIONS / SUBMISSIONS

RENDERINGS

ALL DRAWINGS AND WRITTEN MATERIAL APPEARING
 HEREIN CONSTITUTE THE ORIGINAL AND UNPUBLISHED
 WORK OF SDH STUDIO, AND MAY NOT BE REPLICATED,
 USED, OR DISCLOSED WITHOUT THE EXPRESS WRITTEN
 CONSENT OF STEPHANE D. HALFEN

DRAWN BY: SDH
 CHECKED BY: RB
 INITIAL DRAWING ISSUE DATE
 RELEASE DATE:

A-010



SDH STUDIOS

AA26002883
 18200 NE 19TH AVE, SUITE 100
 NORTH MIAMI BEACH, FL 33162
 (305) 501-5015
 INFO@SDHSTUDIO.COM

STEPHANE D. DE HALFEN
 ARCHITECT P.A.
 ARCH REG# 99155

7801
 ATLANTIC

7801 ATLANTIC WAY, MIAMI
 BEACH, FL. 33141

OWNER



NOTES/COMMENTS

REVISIONS / SUBMISSIONS

RENDERINGS COPY 1

ALL DRAWINGS AND WRITTEN MATERIAL APPEARING
 HEREIN CONSTITUTE THE ORIGINAL AND UNPUBLISHED
 WORK OF SDH STUDIO, AND MAY NOT BE REPLICATED,
 USED, OR DISCLOSED WITHOUT THE EXPRESS WRITTEN
 CONSENT OF STEPHANE D. HALFEN

DRAWN BY: SDH
 CHECKED BY: RB
 INITIAL DRAWING ISSUE DATE
 RELEASE DATE:

A-011



SDH STUDIOS

AA26002883
 18200 NE 19TH AVE, SUITE 100
 NORTH MIAMI BEACH, FL 33162
 (305) 501-5015
 INFO@SDHSTUDIO.COM

STEPHANE D. DE HALFEN
 ARCHITECT P.A.
 ARCH REG# 99155

7801
 ATLANTIC

7801 ATLANTIC WAY, MIAMI
 BEACH, FL. 33141

OWNER



NOTES/COMMENTS

REVISIONS / SUBMISSIONS

RENDERINGS COPY 1 COPY 1

ALL DRAWINGS AND WRITTEN MATERIAL APPEARING
 HEREIN CONSTITUTE THE ORIGINAL AND UNPUBLISHED
 WORK OF SDH STUDIO, AND MAY NOT BE REPLICATED,
 USED, OR DISCLOSED WITHOUT THE EXPRESS WRITTEN
 CONSENT OF STEPHANE D. HALFEN

DRAWN BY: SDH
 CHECKED BY: RB
 INITIAL DRAWING ISSUE DATE
 RELEASE DATE:

A-012



SDH STUDIOS

AA26002883
 18200 NE 19TH AVE, SUITE 100
 NORTH MIAMI BEACH, FL 33162
 (305) 501-5015
 INFO@SDHSTUDIO.COM

STEPHANE D. DE HALFEN
 ARCHITECT P.A.
 ARCH REG# 99155

**7801
 ATLANTIC**

7801 ATLANTIC WAY, MIAMI
 BEACH, FL. 33141

OWNER



NOTES/COMMENTS

REVISIONS / SUBMISSIONS

RENDERINGS COPY 1 COPY 1
 COPY 1

ALL DRAWINGS AND WRITTEN MATERIAL APPEARING
 HEREIN CONSTITUTE THE ORIGINAL AND UNPUBLISHED
 WORK OF SDH STUDIO, AND MAY NOT BE REPLICATED,
 USED, OR DISCLOSED WITHOUT THE EXPRESS WRITTEN
 CONSENT OF STEPHANE D. HALFEN

DRAWN BY: SDH
 CHECKED BY: RB
 INITIAL DRAWING ISSUE DATE
 RELEASE DATE:

A-013



SDH STUDIOS

AA26002883
 18200 NE 19TH AVE, SUITE 100
 NORTH MIAMI BEACH, FL 33162
 (305) 501-5015
 INFO@SDHSTUDIO.COM

STEPHANE D. DE HALFEN
 ARCHITECT P.A.
 ARCH REG# 99155

**7801
 ATLANTIC**

7801 ATLANTIC WAY, MIAMI
 BEACH, FL. 33141

OWNER



NOTES/COMMENTS

REVISIONS / SUBMISSIONS

RENDERINGS COPY 1 COPY 1
 COPY 1 COPY 1

ALL DRAWINGS AND WRITTEN MATERIAL APPEARING
 HEREIN CONSTITUTE THE ORIGINAL AND UNPUBLISHED
 WORK OF SDH STUDIO, AND MAY NOT BE REPLICATED,
 USED, OR DISCLOSED WITHOUT THE EXPRESS WRITTEN
 CONSENT OF STEPHANE D. HALFEN

DRAWN BY: SDH
 CHECKED BY: RB
 INITIAL DRAWING ISSUE DATE
 RELEASE DATE:

A-014



SDH-STUDIO

AA26002883
 18200 NE 19TH AVE, SUITE 100
 NORTH MIAMI BEACH, FL 33162
 (305) 501-5015
 INFO@SDHSTUDIO.COM

STEPHANE D. DE HALFEN
 ARCHITECT P.A.
 ARCH REG# 99155

**7801
 ATLANTIC**

7801 ATLANTIC WAY, MIAMI
 BEACH, FL. 33141

OWNER



NOTES/COMMENTS

REVISIONS / SUBMISSIONS

RENDERINGS COPY 1 COPY 1
 COPY 1 COPY 1 COPY 1

ALL DRAWINGS AND WRITTEN MATERIAL APPEARING
 HEREIN CONSTITUTE THE ORIGINAL AND UNPUBLISHED
 WORK OF SDH STUDIO, AND MAY NOT BE REPLICATED,
 USED, OR DISCLOSED WITHOUT THE EXPRESS WRITTEN
 CONSENT OF STEPHANE D. HALFEN

DRAWN BY: SDH
 CHECKED BY: RB
 INITIAL DRAWING ISSUE DATE
 RELEASE DATE:

A-015

BUILDING CONFIGURATION (ALTOS DEL MAR)		
FRONT SETBACK	PERMITTED	PROVIDED
UP TO 25' IN BUILDING HEIGHT	12'-0"	12'-0"
GREATER THAN 25' IN BUILDING HEIGHT	75'-0"	76'-5"
REAR SETBACK		
UP TO 25' IN BUILDING HEIGHT	130'-0"	130'-0"
GREATER THAN 25' IN BUILDING HEIGHT	140'-0"	140'-7"
SIDE YARD (STREET)	5'-0"	5'-1"
SIDE YARD (INTERIOR)	5' OR 10% OF LOT WIDTH, WHATEVER IS GREATER.	5'-1"
POOL SETBACK	80'-0"	80'-0"
HEIGHT LIMITATION	37'-0" MEASURED FROM GRADE	37'-0" MEASURED FROM GRADE
FLOOD DESIGN		
FLOOD ZONE	AE = 8'-0" NGVD	N/A
DESIGN FLOOD ELEVATION (DFE)	8'-0"+ 1'-0" = 9'-0" NGVD	9'-10" NGVD
LOWEST TOS OF HABITABLE SPACE (BFE)	N/A	21'-5" NGVD
HIGHEST ADJACENT GRADE ELEV.	N/A	9'-3" NGVD
LOWEST TOS ELEV. OF EQ. SERVICING THE BUILDING	9'-0" NGVD	9'-10" NGVD
LOWEST ADJACENT GRADE ELEV.	6.56' NGVD	7'-6" NGVD
ADJUSTED GRADE ELEV.	GRADE + MIN DFE/2	8.25'+9'/2 = 8.62' NGVD
FIRM MAP NUMBER	N/A	12086C0326L
FLOOD DESIGN CLASS AS PER ASCE/SEI 24-14, TABLE I-1	N/A	2

SINGLE FAMILY RESIDENTIAL - ZONING DATA SHEET			
1	Address:	7801 ATLANTIC WAY, MIAMI BEACH, FLORIDA, 33141	
2	Folio number(s):	02-3202-004-0230	
3	Board and file numbers:		
4	Year built:	1935	Zoning District: RS-3
5	Base Flood Elevation:	8' NGVD	Grade value in NGVD: 8'-3" NGVD
6	Adjusted grade (Flood+Grade/2):	8.00'+8.25'/2 = 8.12'	Free board: N/A
7	Lot Area:	15,995	
8	Lot width:	50'	Lot Depth: 320'(M)/245' PER PLAT
9	Max Lot Coverage SF and %:	30% = 4,799 SF	Proposed Lot Coverage SF and %: 17.88% = 2,860 SF
10	Existing Lot Coverage SF and %:	11.22% = 1,795 SF	Lot coverage deducted (garage-storage) SF: = 500 SF
11	Front Yard Open Space SF and %:	51.33% = 308 SF	Rear Yard Open Space SF and %: 83.60% = 7942 SF
12	Max Unit Size SF:	4,700 SF	Proposed Unit Size SF: = 4,673 SF
13	Existing First Floor Unit Size:	N/A SF	Proposed Main Floor Unit Size: = 3,205 SF
14	Existing Second Floor Unit Size:	N/A	Proposed Second Floor volumetric Unit Size SF and %: N/A
15			Proposed Second Floor Unit Size SF: 1,461 SF
16			Proposed Roof Deck Area SF and % (Note: Maximum is 25% of the enclosed floor area immediately below): 345 SF

Zoning Information / Calculations	Required	Existing	Proposed	Deficiencies
17 Accessory Structure Side 1:	N/A	N/A	N/A	N/A
18 Accessory Structure Side 2 or (facing street):	N/A	N/A	N/A	N/A
19 Accessory Structure Rear:	N/A	N/A	N/A	N/A
20 Located within a Local Historic District?				Yes
21 Designated as an individual Historic Single Family Residence Site?				Yes
22 Determined to be Architecturally Significant?				No
23 Additional data or information must be presented in the format outlined in this section				No

SDH_STUDIO
ARCHITECTURE+DESIGN

AA26002883

18200 NE 19TH AVE, SUITE 100
NORTH MIAMI BEACH, FL 33162
(305) 501 5013
INFO@SDHSTUDIO.COM

STEPHANIE D. DE HALFEN
ARCHITECT P.A.
ARCH REG # 9955


7801 ATLANTIC

7801 ATLANTIC WAY, MIAMI BEACH, FL. 33141

OWNER

Digitally signed by Stephanie Dornbusch de Halfen
DN: cn=Stephanie Dornbusch de Halfen, c=US, ou=SDH Studio
Reason: I am the author of this document
Location: Date: 2023-04-07 17:33:04-00


Stephanie Dornbusch de Halfen

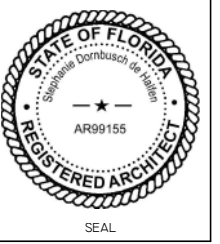

NOTES/COMMENTS

REVISIONS / SUBMISSIONS

I REVISION I 04-07-23

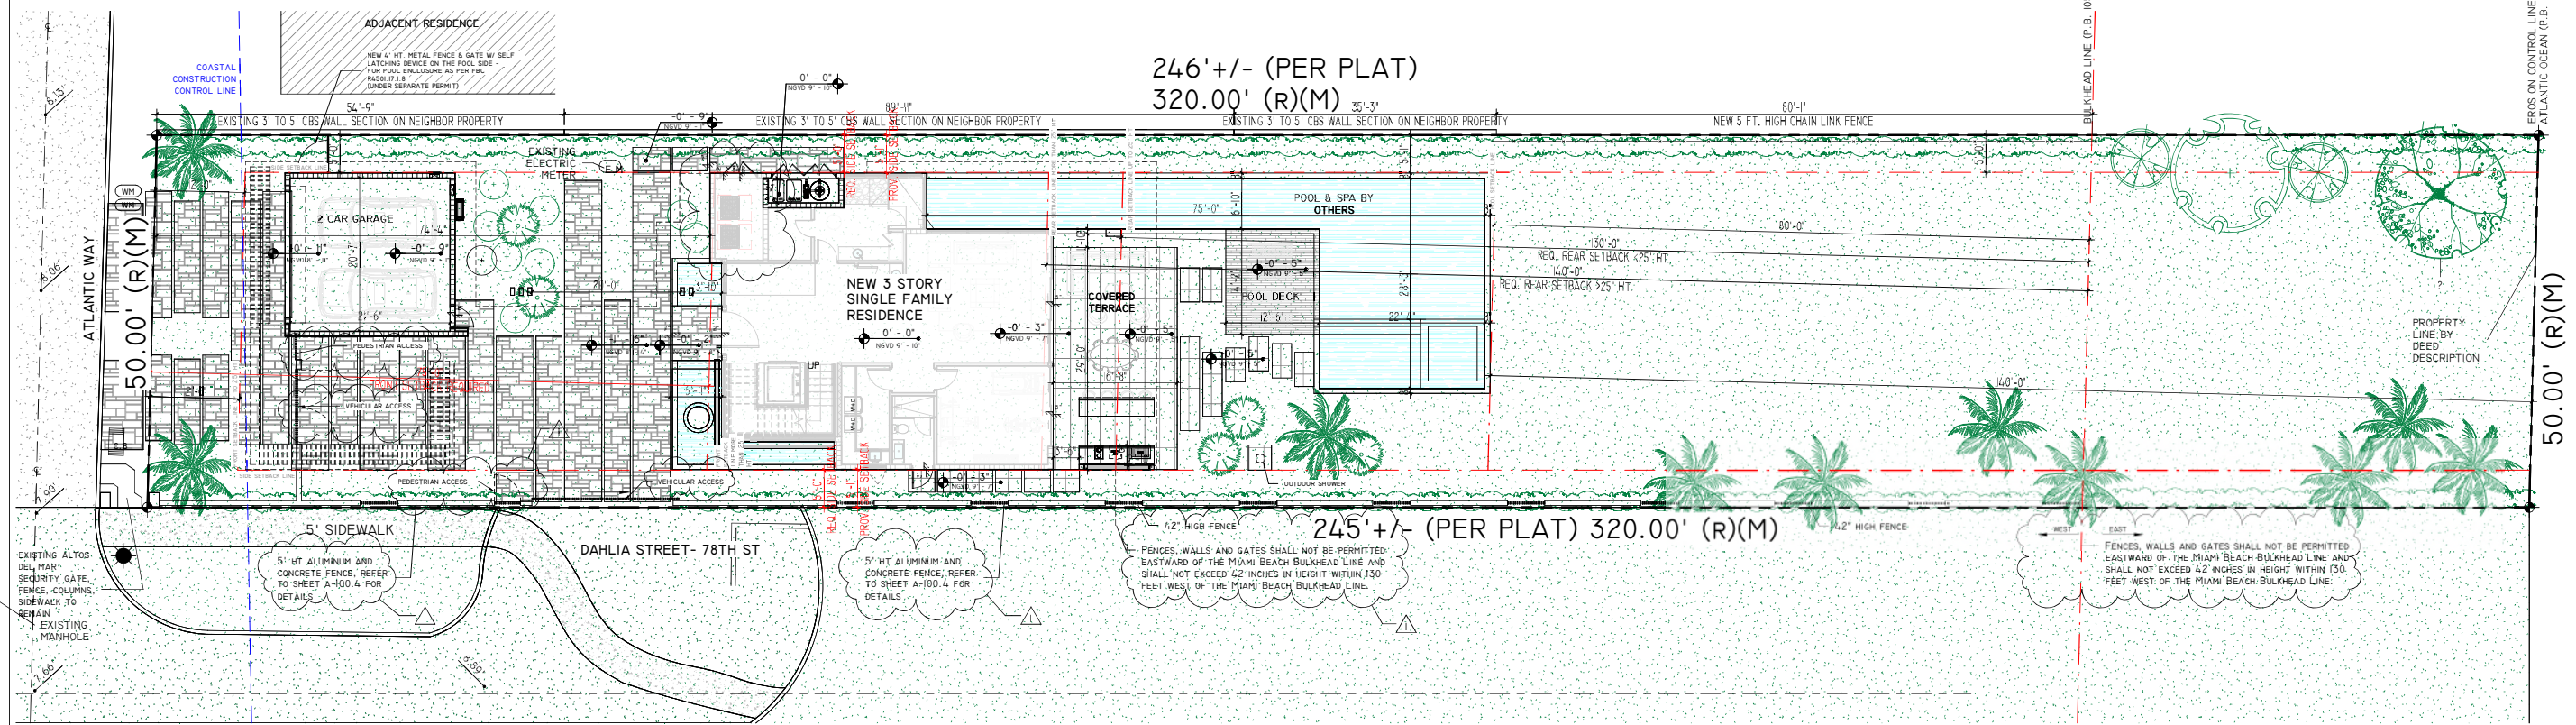

SITE PLAN
3/32" = 1'-0"

APPLICABLE CODES

FLORIDA BUILDING CODE 2020 EDITION
FLORIDA RESIDENTIAL CODE 2020
NATIONAL ELECTRICAL CODE 2020
FLORIDA PLUMBING CODE 2020
FLORIDA MECHANICAL CODE 2020
FLORIDA ENERGY CODE 2020

SCOPE OF WORK

I. NEW 3 STORY SINGLE FAMILY RESIDENCE

SITE DESCRIPTION

LEGAL DESCRIPTION

ADDRESS: 7801 ATLANTIC WAY, MIAMI BEACH, FL 33141

LOT: 6 BLOCK: 5 PLAT BOOK: 31 PAGE: 60

HIGHEST CROWN OF ROAD ELEVATION: 8' - 11" FLOOD ZONE: X/ AE
AVERAGE OF CROW OF ROAD ELEVATION: 8' - 3" BASE FLOOD: N/A / 8

ALL SITE INFORMATION WAS TAKEN FROM THE ATTACHED CERTIFIED SURVEY, OR A CERTIFIED PREPARED BY:

SURVEYOR'S NAME: JORGE L. CABRERA PLS LIC.: 6487 FIELD WORK DATE: 11/01/19

	LOWEST FLOOR ELEVATION	GARAGE/STORAGE ELEV.	ADJACENT GRADE ELEV.
PROPOSED	21' - 5" NGVD	9' - 0" NGVD	9' - 0" NGVD(AVG)
MINIMUM	9'-0" NGVD		

AS-BUILT ELEVATION SURVEY IS REQUIRED BEFORE MAKING ANY INSPECTION ABOVE LOWEST FLOOR AND AS-BUILT ELEVATION CERTIFICATE IS REQUIRED BEFORE ISSUANCE OF CERTIFICATE OF OCCUPANCY OR COMPLETION (IIC3-3D3)

SITE PLAN

ALL DRAWINGS AND WRITTEN MATERIAL APPEARING HEREIN CONSTITUTE THE ORIGINAL AND UNALtered WORK OF SDH STUDIO, AND MAY NOT BE REPRODUCED, USED, OR DISCLOSED WITHOUT THE EXPRESS WRITTEN CONSENT OF SDH STUDIO.

DRAWN BY: SDH
CHECKED BY: RB
INITIAL DRAWING ISSUE DATE
RELEASE DATE:

A-100


7801
ATLANTIC

7801 ATLANTIC WAY, MIAMI
BEACH, FL. 33141

OWNER

Stephanie Dornbusch
h de Halfen

Digitally signed by
Stephanie Dornbusch
dn: cn=Stephanie
Dornbusch de Halfen
c=US o=SDH Studio
Reason: I am the
author of this document
Date: 2023.04.07
17:35:04.00

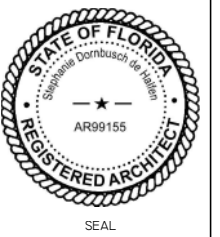

NOTES/COMMENTS

REVISIONS / SUBMISSIONS


1 REVISION I 04-07-23

GROUND FLOOR PLAN

ALL DRAWINGS AND WRITTEN MATERIAL APPEARING
HEREIN CONSTITUTE THE ORIGINAL AND UNALtered
WORK OF SDH STUDIO, AND MAY NOT BE REPRODUCED,
USED, OR DISCLOSED WITHOUT THE EXPRESS WRITTEN
CONSENT OF SDH STUDIO.

DRAWN BY: SDH
CHECKED BY: RB
INITIAL DRAWING ISSUE DATE
RELEASE DATE:

A-101

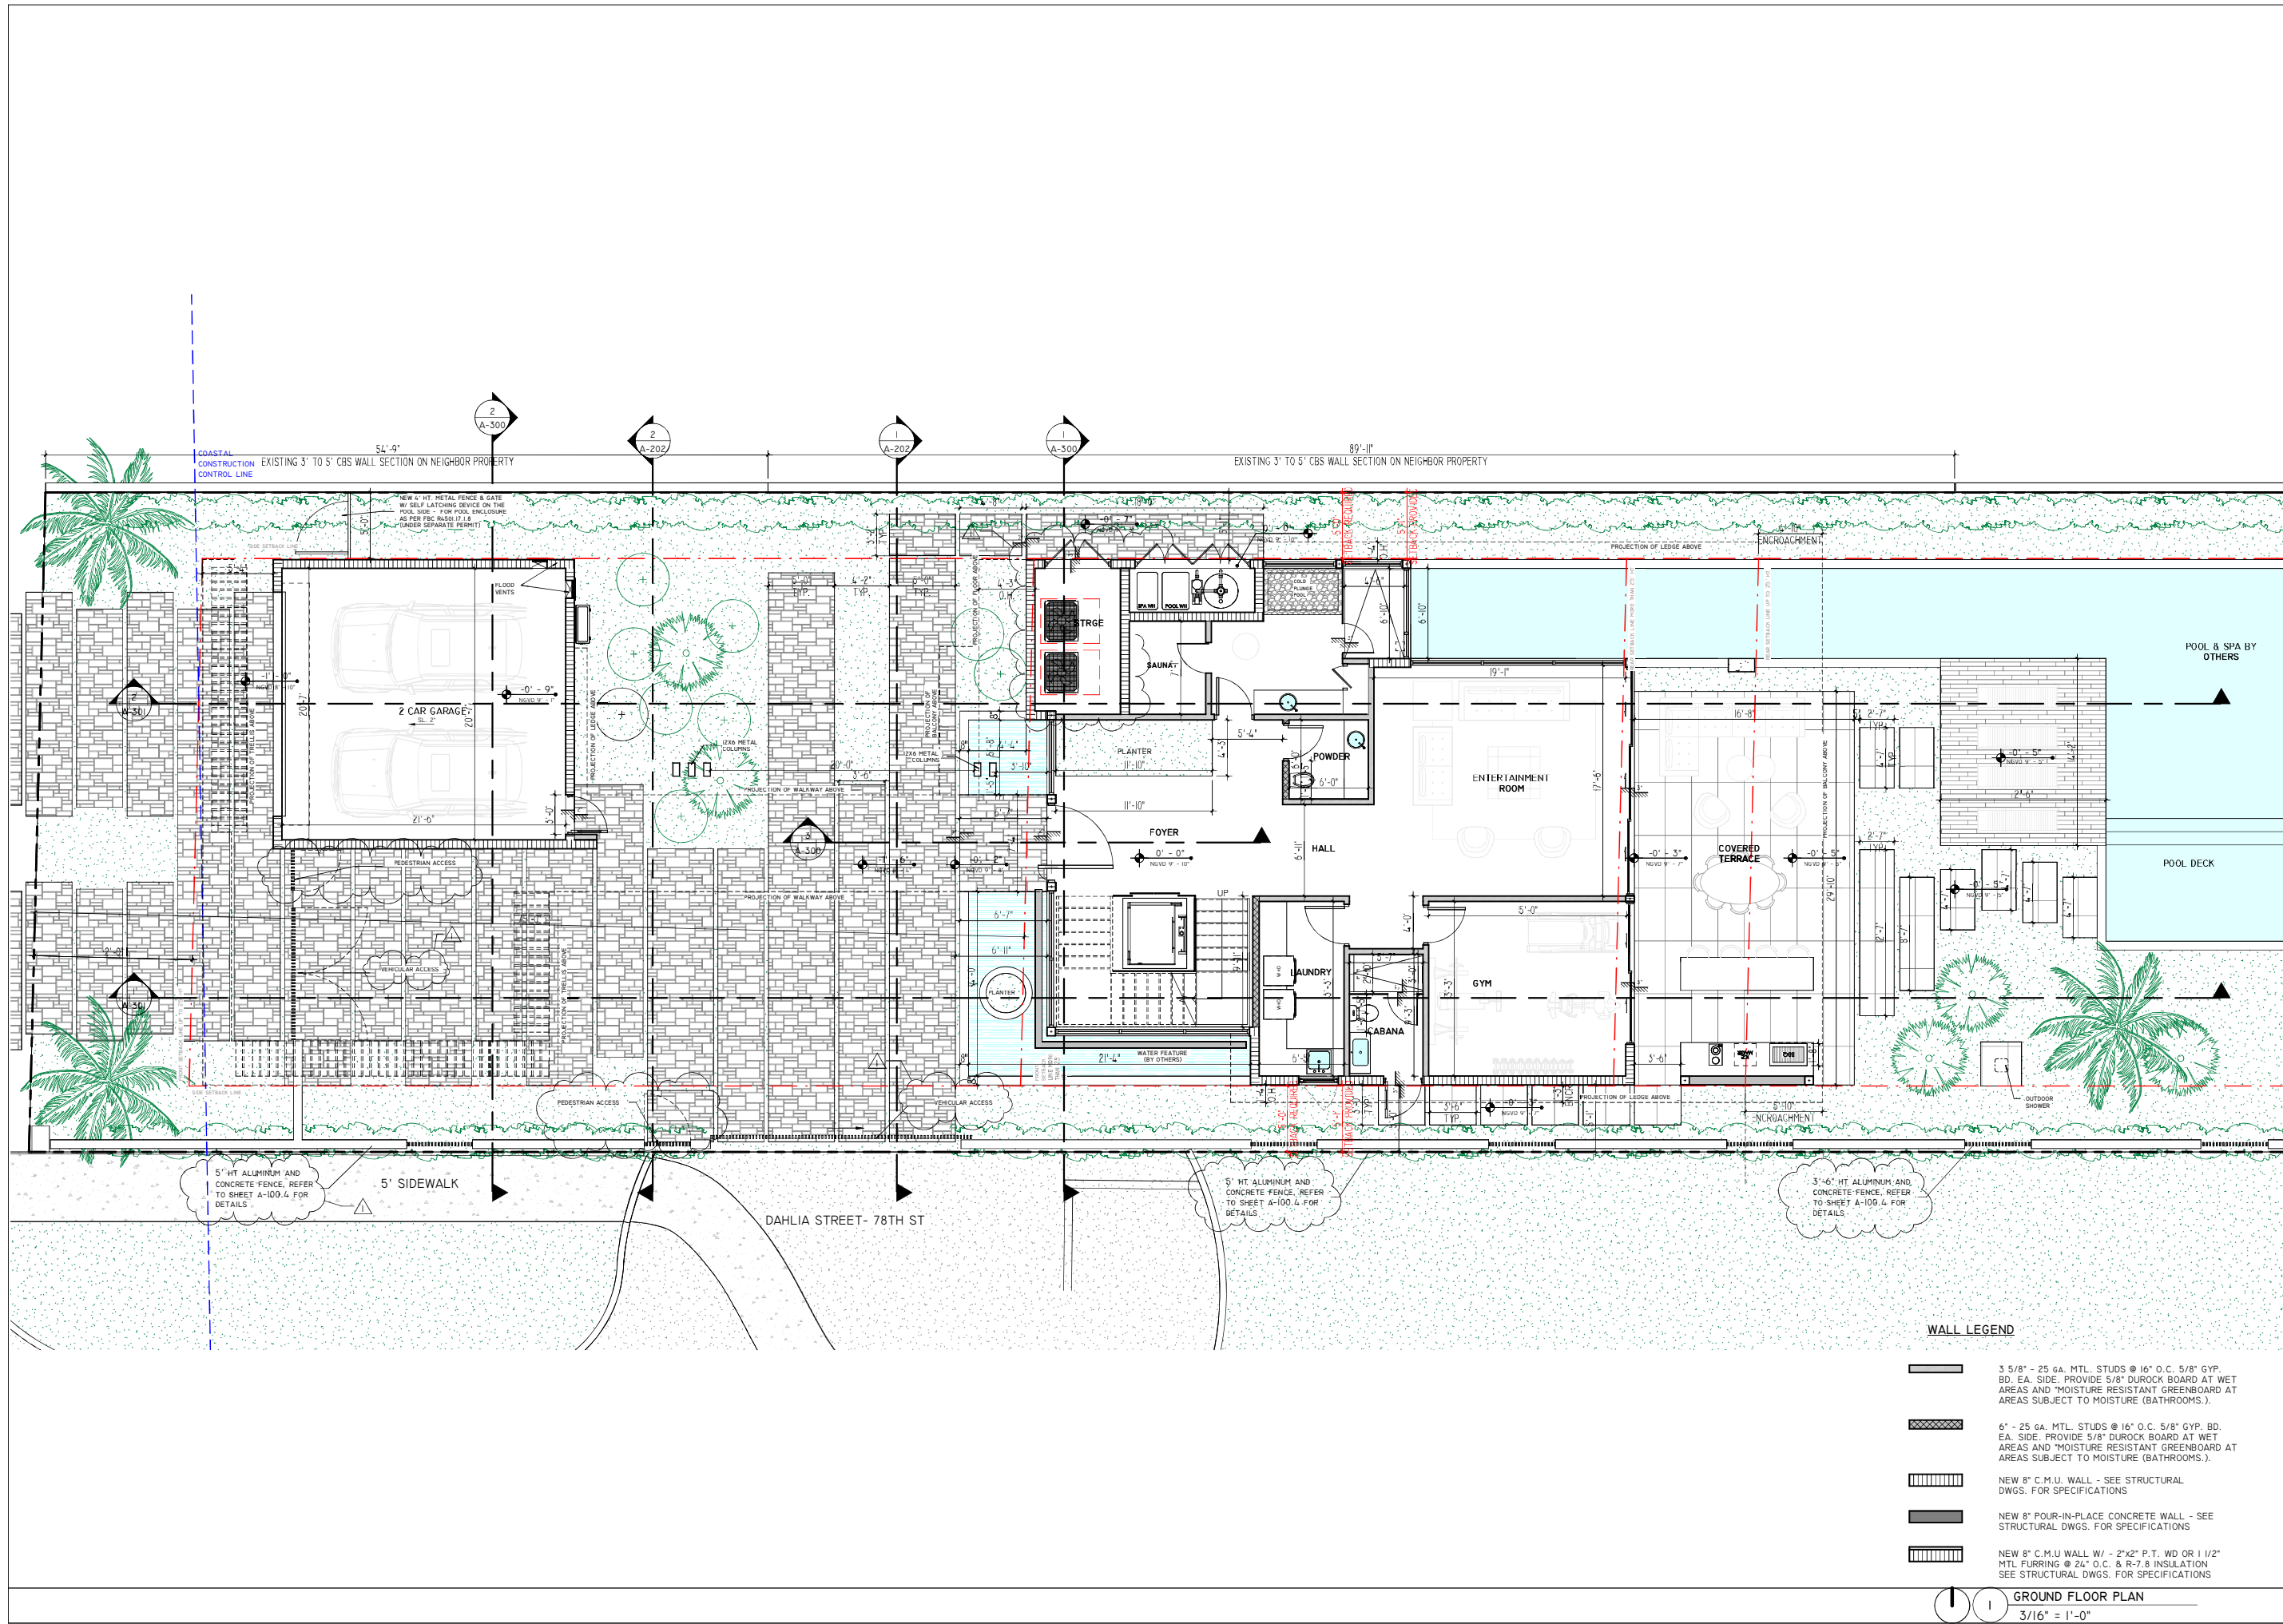

WALL LEGEND

	3 5/8" - 25 GA. MTL. STUDS @ 16" O.C. 5/8" GYP. BD. EA. SIDE. PROVIDE 5/8" DUROCK BOARD AT WET AREAS AND "MOISTURE RESISTANT" GREENBOARD AT AREAS SUBJECT TO MOISTURE (BATHROOMS).
	6" - 25 GA. MTL. STUDS @ 16" O.C. 5/8" GYP. BD. EA. SIDE. PROVIDE 5/8" DUROCK BOARD AT WET AREAS AND "MOISTURE RESISTANT" GREENBOARD AT AREAS SUBJECT TO MOISTURE (BATHROOMS).
	NEW 8" C.M.U. WALL - SEE STRUCTURAL DWGS. FOR SPECIFICATIONS
	NEW 8" POUR-IN-PLACE CONCRETE WALL - SEE STRUCTURAL DWGS. FOR SPECIFICATIONS
	NEW 8" C.M.U. WALL W/ - 2"x2" P.T. WD OR 1 1/2" MTL. FLOORING @ 24" O.C. & R-7.8 INSULATION SEE STRUCTURAL DWGS. FOR SPECIFICATIONS

1 GROUND FLOOR PLAN
3/16" = 1'-0"


7801
ATLANTIC

7801 ATLANTIC WAY, MIAMI
BEACH, FL. 33141

OWNER

Stephanie
Dornbusch
de
Halfen

Digitally signed by
Stephanie Dornbusch
de Halfen
DN: cn=Stephanie
Dornbusch de Halfen
o=US-SDH Studio
Reason: I am the
author of this
document
Date: 2023-04-07
17:35:04-00

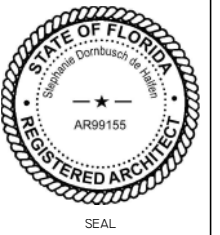

NOTES/COMMENTS

REVISIONS / SUBMISSIONS


1 REVISION 1 04-07-23

MAIN FLOOR PLAN






ALL DRAWINGS AND WRITTEN MATERIAL APPEARING
HEREIN CONSTITUTE THE ORIGINAL AND UNPUBLISHED
WORK OF SDH STUDIO, AND MAY NOT BE REPRODUCED,
USED, OR DISCLOSED WITHOUT THE EXPRESS WRITTEN
CONSENT OF STEPHANIE D. HALFEN

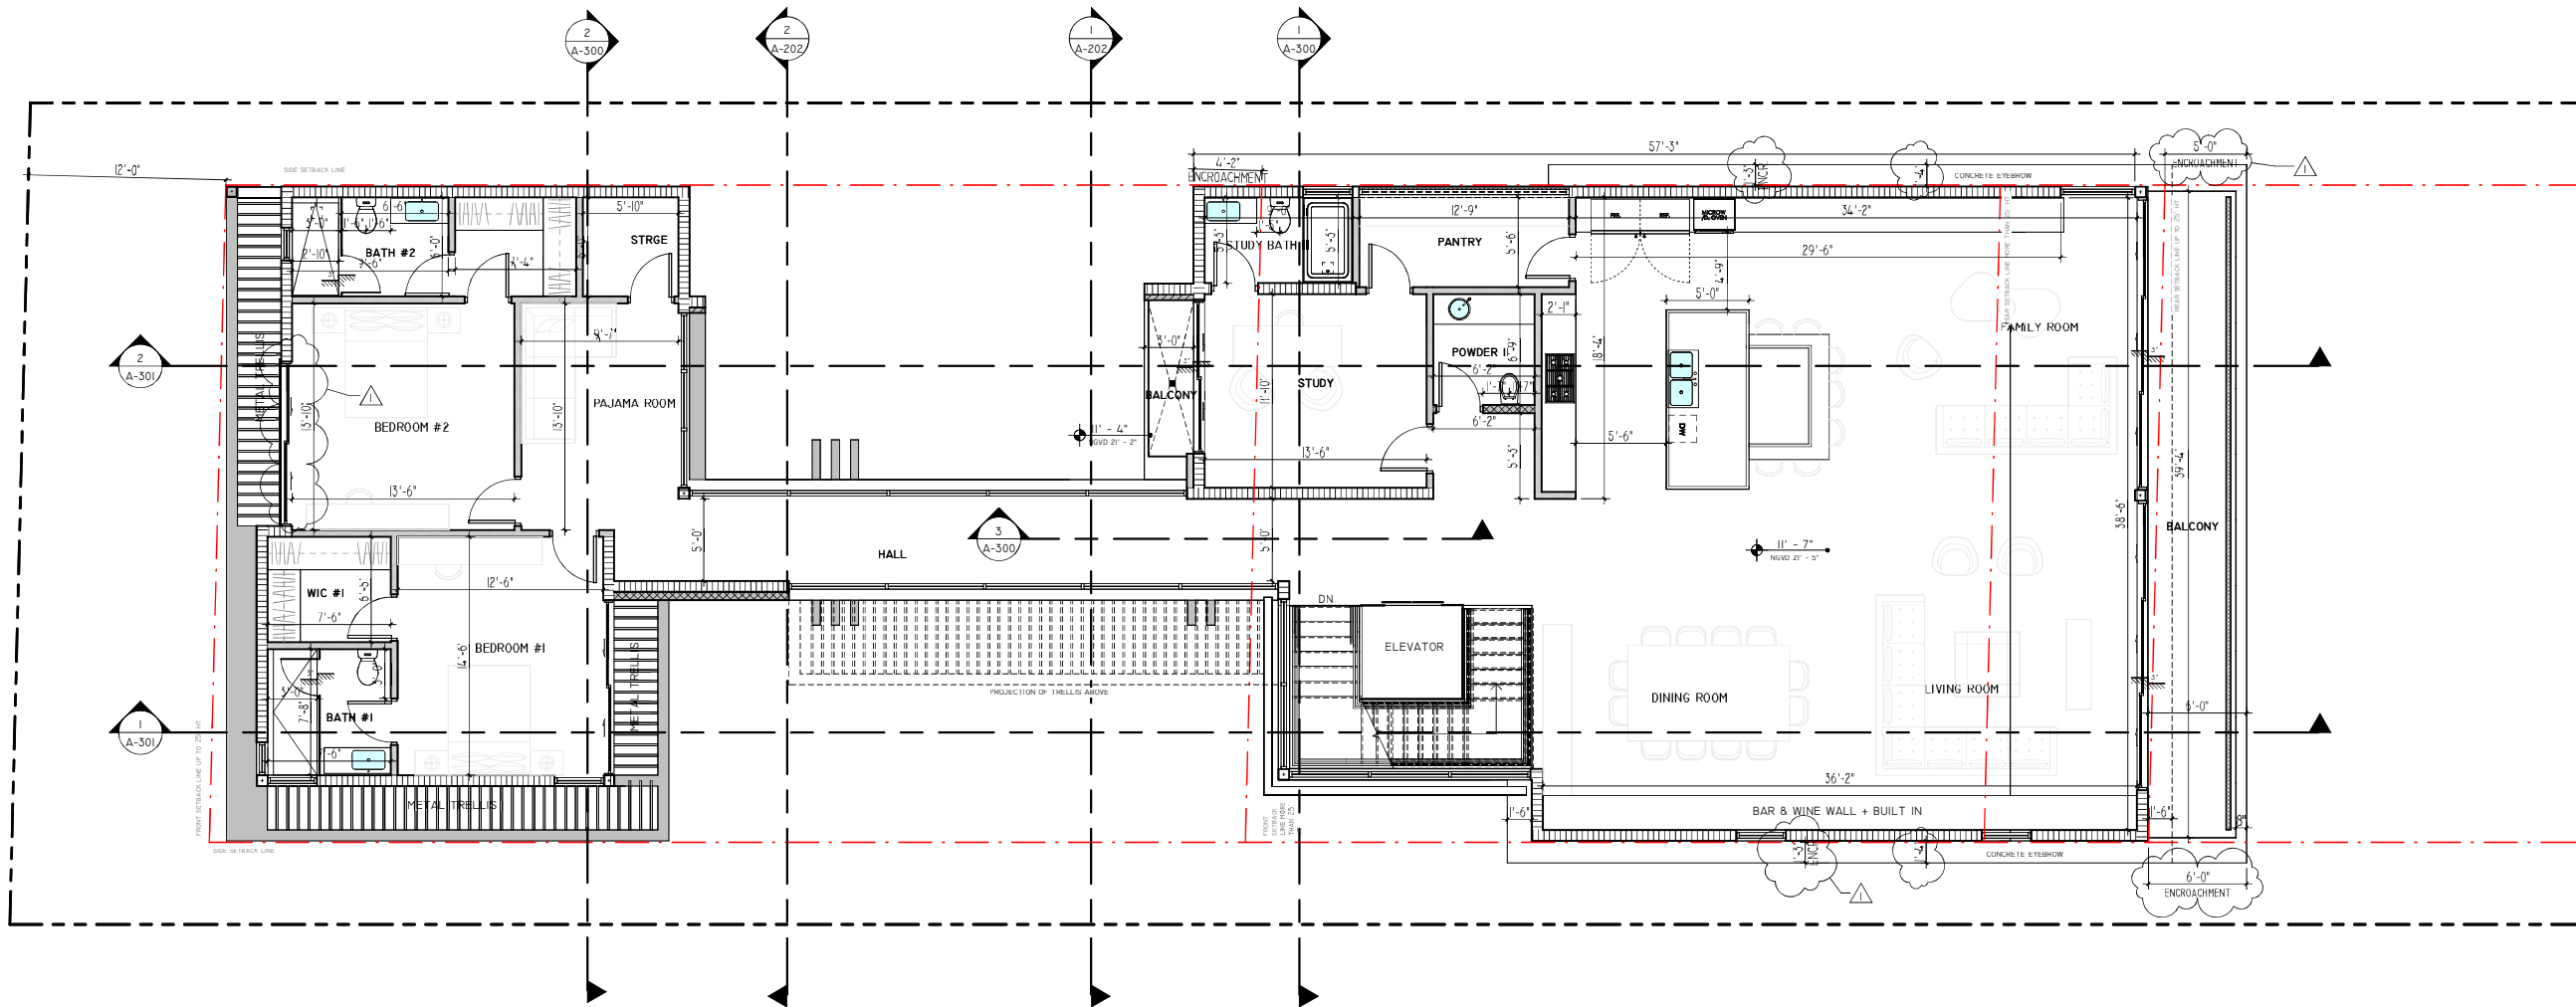DRAWN BY: SDH
CHECKED BY: RB
INITIAL DRAWING ISSUE DATE
RELEASE DATE:

A-102



WALL LEGEND

-  3 5/8" - 25 GA. MTL. STUDS @ 16" O.C. 5/8" GYP. BD. EA. SIDE. PROVIDE 5/8" DUROCK BOARD AT WET AREAS AND "MOISTURE RESISTANT GREENBOARD AT AREAS SUBJECT TO MOISTURE (BATHROOMS.).
-  6" - 25 GA. MTL. STUDS @ 16" O.C. 5/8" GYP. BD. EA. SIDE. PROVIDE 5/8" DUROCK BOARD AT WET AREAS AND "MOISTURE RESISTANT GREENBOARD AT AREAS SUBJECT TO MOISTURE (BATHROOMS.).
-  NEW 8" C.M.U. WALL - SEE STRUCTURAL DWGS. FOR SPECIFICATIONS
-  NEW 8" POUR-IN-PLACE CONCRETE WALL - SEE STRUCTURAL DWGS. FOR SPECIFICATIONS
-  NEW 8" C.M.U. WALL W/ - 2"x2" P.T. WD OR 1 1/2" MTL FURRING @ 24" O.C. & R-7.8 INSULATION SEE STRUCTURAL DWGS. FOR SPECIFICATIONS


7801
ATLANTIC

7801 ATLANTIC WAY, MIAMI
BEACH, FL. 33141

OWNER

Stephani
e
Dornbusch
h de
Halfen

Digitally signed by
Stephanie Dornbusch
de Halfen
DN: cn=Stephanie
Dornbusch de Halfen
c=US o=SDH Studio
Reason: I am the
author of this
document
Location:
Date: 2023-04-07
17:35:04.00

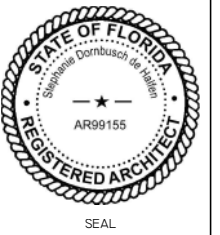

NOTES/COMMENTS

REVISIONS / SUBMISSIONS


1 REVISION 1 04-07-23

SECOND FLOOR PLAN

ALL DRAWINGS AND WRITTEN MATERIAL APPEARING
HEREIN CONSTITUTE THE ORIGINAL AND UNPUBLISHED
WORK OF SDH STUDIO, AND MAY NOT BE REPRODUCED,
USED, OR DISCLOSED WITHOUT THE EXPRESS WRITTEN
CONSENT OF STEPHANIE D. HALFEN

DRAWN BY: SDH
CHECKED BY: RB
INITIAL DRAWING ISSUE DATE
RELEASE DATE:

A-103

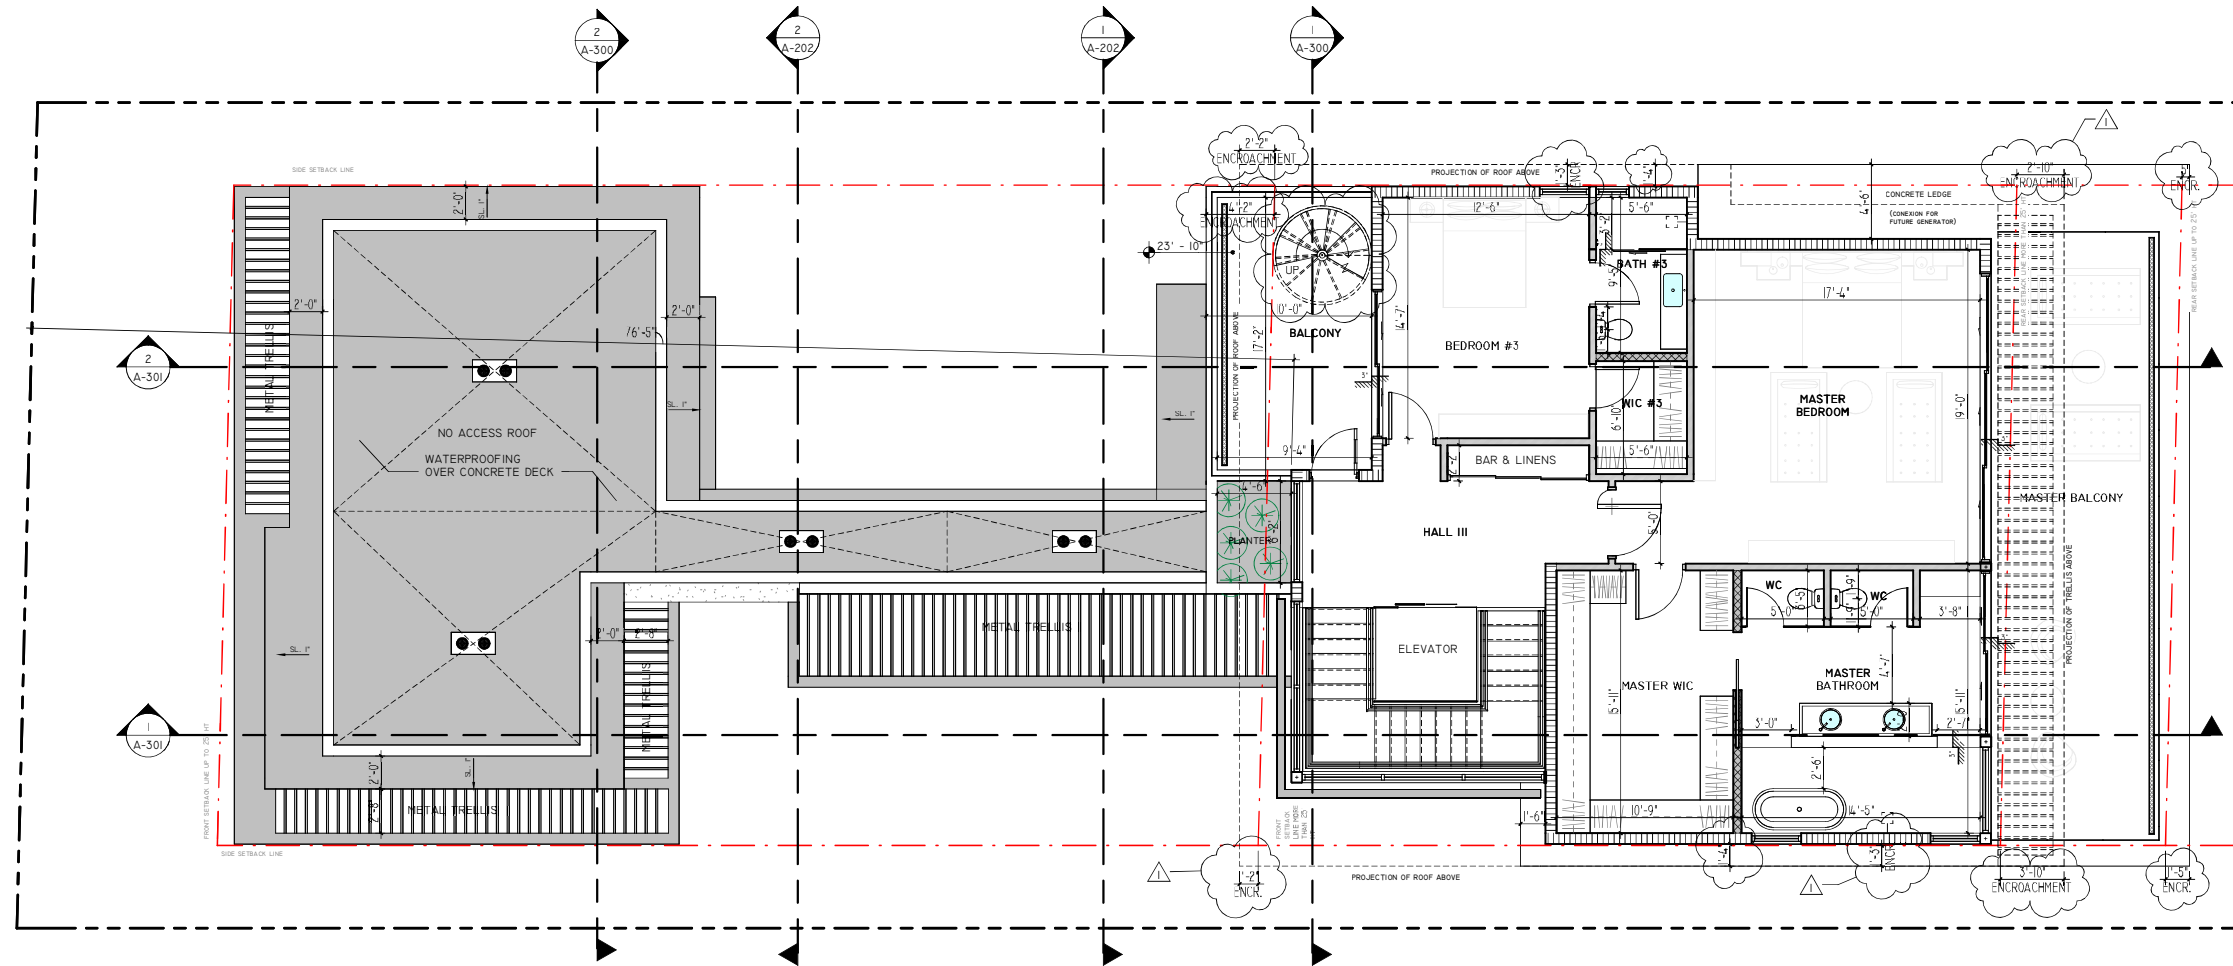

WALL LEGEND

- 3 5/8" - 25 GA. MTL. STUDS @ 16" O.C. 5/8" GYP. BD. EA. SIDE, PROVIDE 5/8" DUROCK BOARD AT WET AREAS AND MOISTURE RESISTANT GREENBOARD AT AREAS SUBJECT TO MOISTURE (BATHROOMS).
- 6" - 25 GA. MTL. STUDS @ 16" O.C. 5/8" GYP. BD. EA. SIDE, PROVIDE 5/8" DUROCK BOARD AT WET AREAS AND MOISTURE RESISTANT GREENBOARD AT AREAS SUBJECT TO MOISTURE (BATHROOMS).
- NEW 8" C.M.U. WALL - SEE STRUCTURAL DWGS. FOR SPECIFICATIONS
- NEW 8" POUR-IN-PLACE CONCRETE WALL - SEE STRUCTURAL DWGS. FOR SPECIFICATIONS
- NEW 8" C.M.U. WALL W/ - 2"x2" P.T. WD OR 1 1/2" MTL. FLURRING @ 24" O.C. & R-7.5 INSULATION SEE STRUCTURAL DWGS. FOR SPECIFICATIONS

1 SECOND FLOOR PLAN
3/16" = 1'-0"


7801
ATLANTIC

7801 ATLANTIC WAY, MIAMI
BEACH, FL. 33141

OWNER

Stephanie
Dornbusch
de Halfen

Digitally signed by
Stephanie Dornbusch
de Halfen
DN: cn=Stephanie
Dornbusch de Halfen
c=US ou=SDH Studio
Reason: I am the
author of this
document
Date: 2023-04-07
17:35:04-00

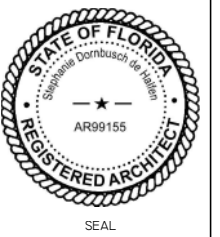

NOTES/COMMENTS

REVISIONS / SUBMISSIONS


1 REVISION 1 04-07-23

ROOF PLAN

ALL DRAWINGS AND WRITTEN MATERIAL APPEARING
HEREIN CONSTITUTE THE ORIGINAL AND UNPUBLISHED
WORK OF SDH STUDIO, AND MAY NOT BE REPRODUCED,
USED, OR DISCLOSED WITHOUT THE EXPRESS WRITTEN
CONSENT OF SDH STUDIO.

DRAWN BY: SDH
CHECKED BY: RB
INITIAL DRAWING ISSUE DATE
RELEASE DATE:


A-104

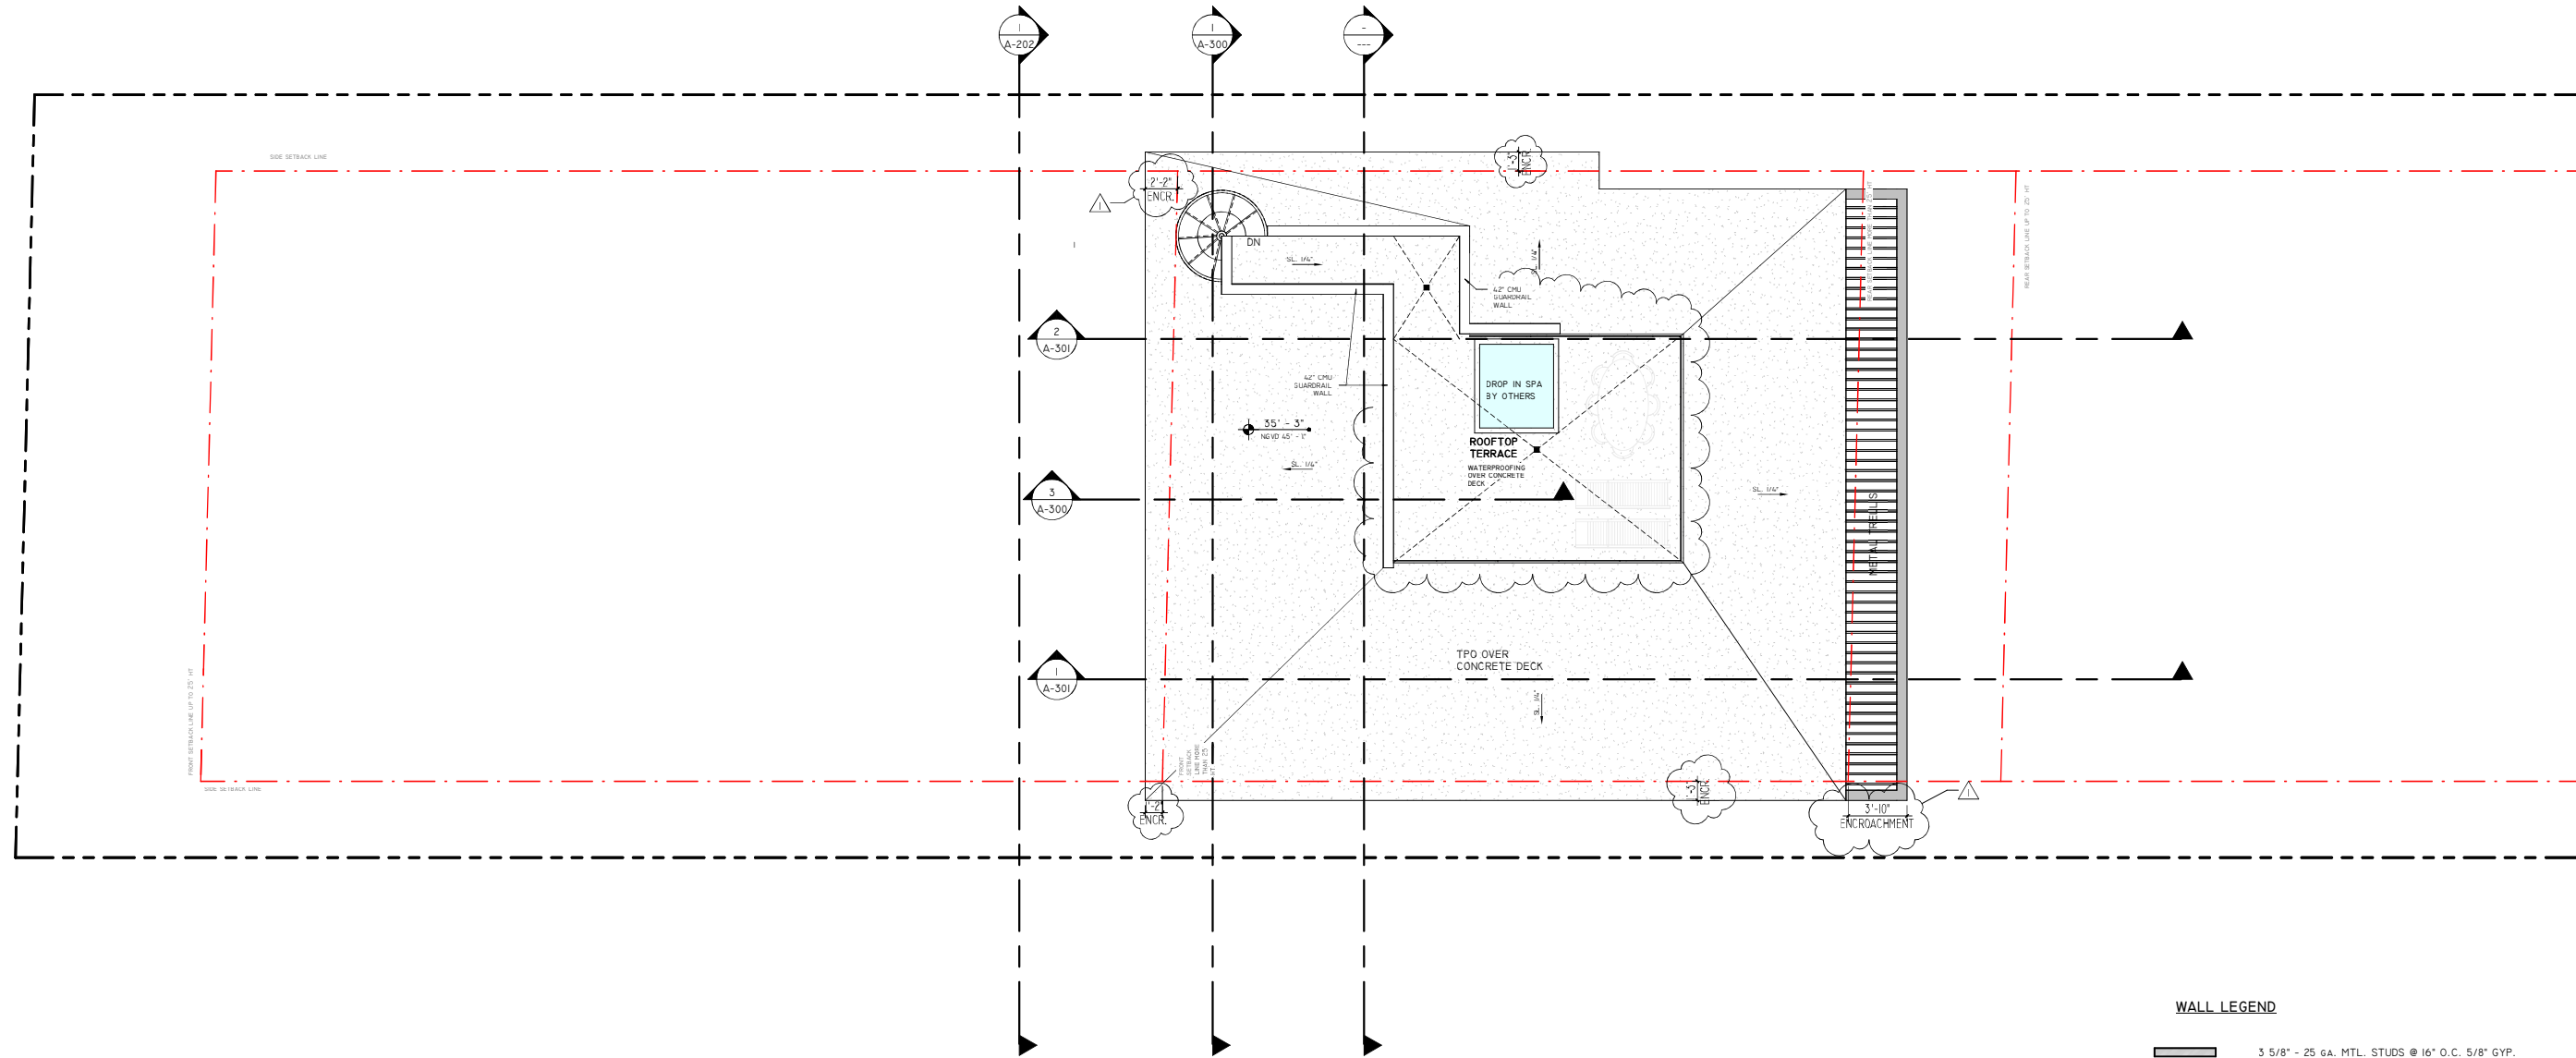


WALL LEGEND

-
-
FINISH MATERIALS		
MATERIAL MARK	MATERIAL NAME	MATERIAL DESCRIPTION
01	SMOOTH STUCCO	BENJAMIN MOORE, SUPER WHITE
03	CONCRETE	F 202
07	ALUMINUM	DARK BRONZE

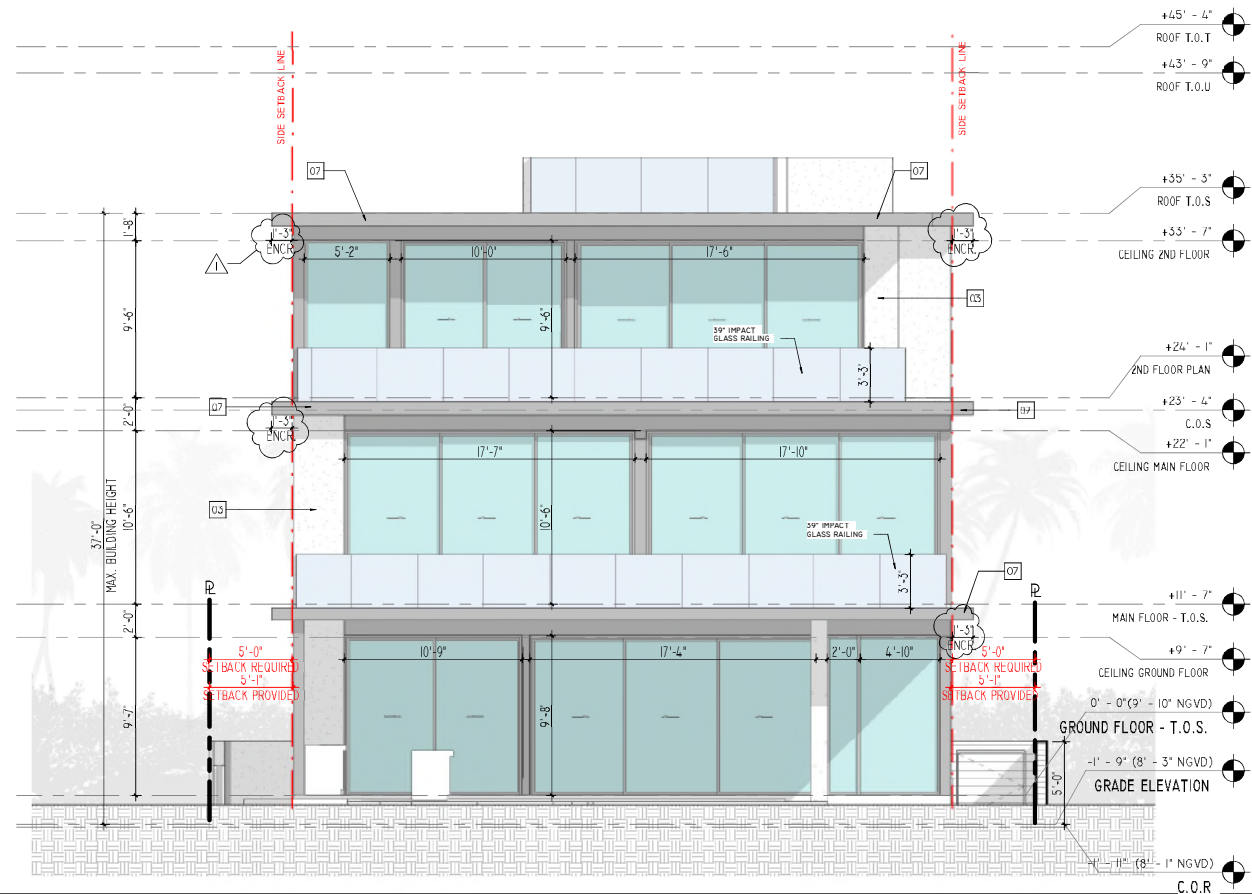

1 REAR
3/16" = 1'-0"

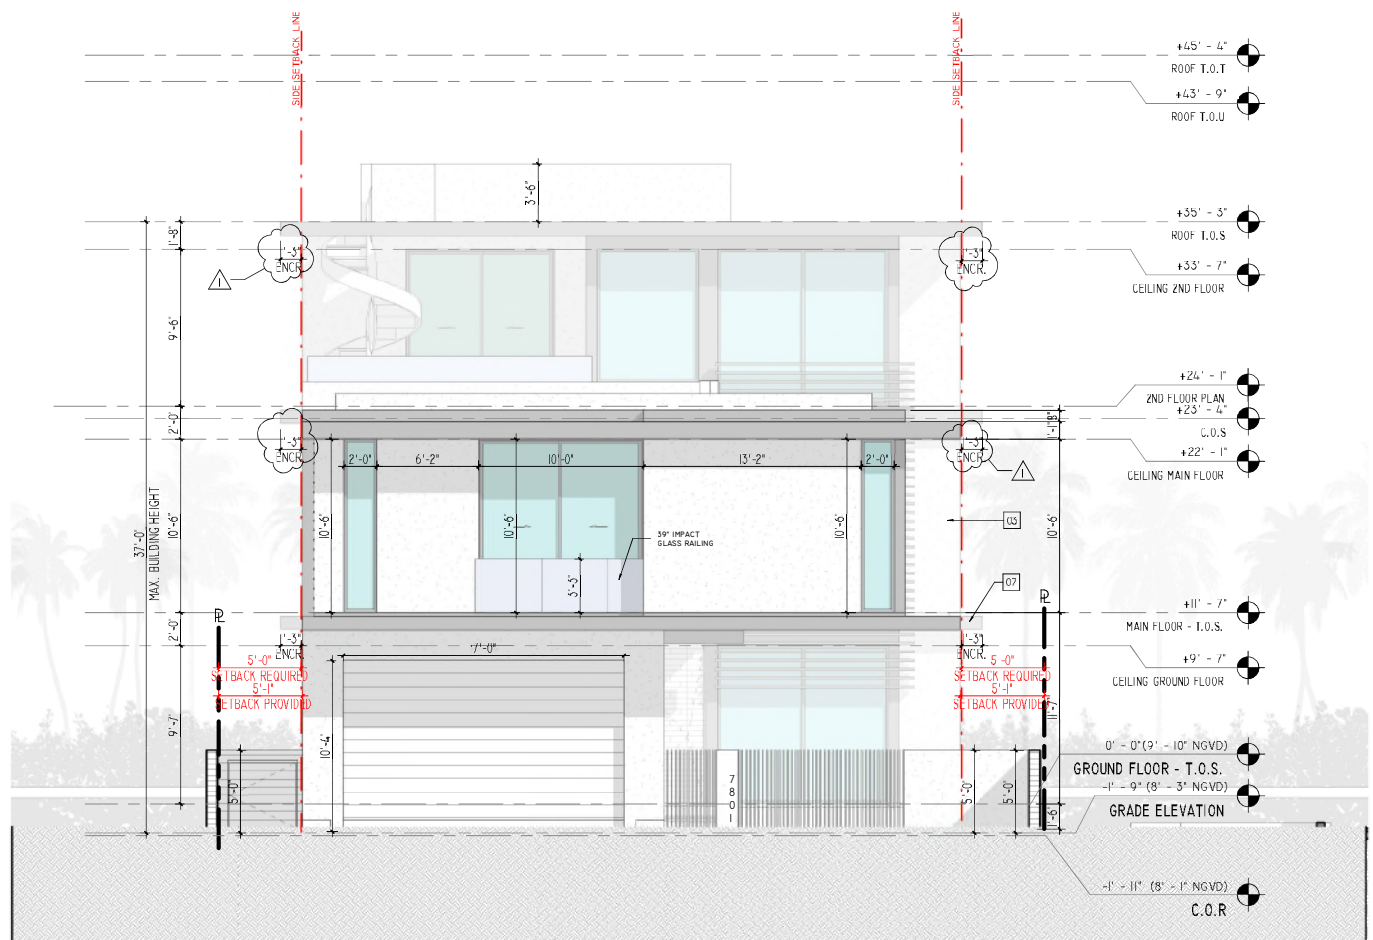

2 FRONT
3/16" = 1'-0"

SDH_STUDIO
ARCHITECTURE+DESIGN

AA26002883

18200 NE 19TH AVE, SUITE 100
NORTH MIAMI BEACH, FL 33162
(305) 501 5013
INFO@SDHSTUDIO.COM


STEPHANIE D. DE HALFEN
ARCHITECT P.A.
ARCH REG # 9955

7801 ATLANTIC

7801 ATLANTIC WAY, MIAMI BEACH, FL. 33141

OWNER

Stephanie Dornbusch de Halfen
Digitally signed by Stephanie Dornbusch de Halfen
DN: cn=Stephanie Dornbusch de Halfen
Reason: I am the author of this document
Location: Date: 2023-04-07 17:35:04.00

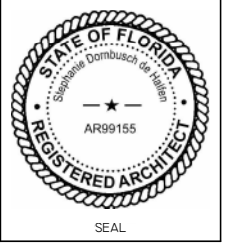

NOTES/COMMENTS

REVISIONS / SUBMISSIONS

1	REVISION 1	04-07-23
---	------------	----------


ELEVATIONS

ALL DRAWINGS AND WRITTEN MATERIAL APPEARING HEREIN CONSTITUTE THE ORIGINAL AND UNPUBLISHED WORK OF SDH STUDIO, AND MAY NOT BE REPRODUCED, USED, OR DISCLOSED WITHOUT THE EXPRESS WRITTEN CONSENT OF STEPHANIE D. HALFEN


DRAWN BY: SDH
CHECKED BY: RB
INITIAL DRAWING ISSUE DATE
RELEASE DATE:

A-200

FINISH MATERIALS		
MATERIAL MARK	MATERIAL NAME	MATERIAL DESCRIPTION
01	SMOOTH STUCCO	BENJAMIN MOORE, SUPER WHITE
03	CONCRETE	F202
07	ALUMINUM	DARK BRONZE

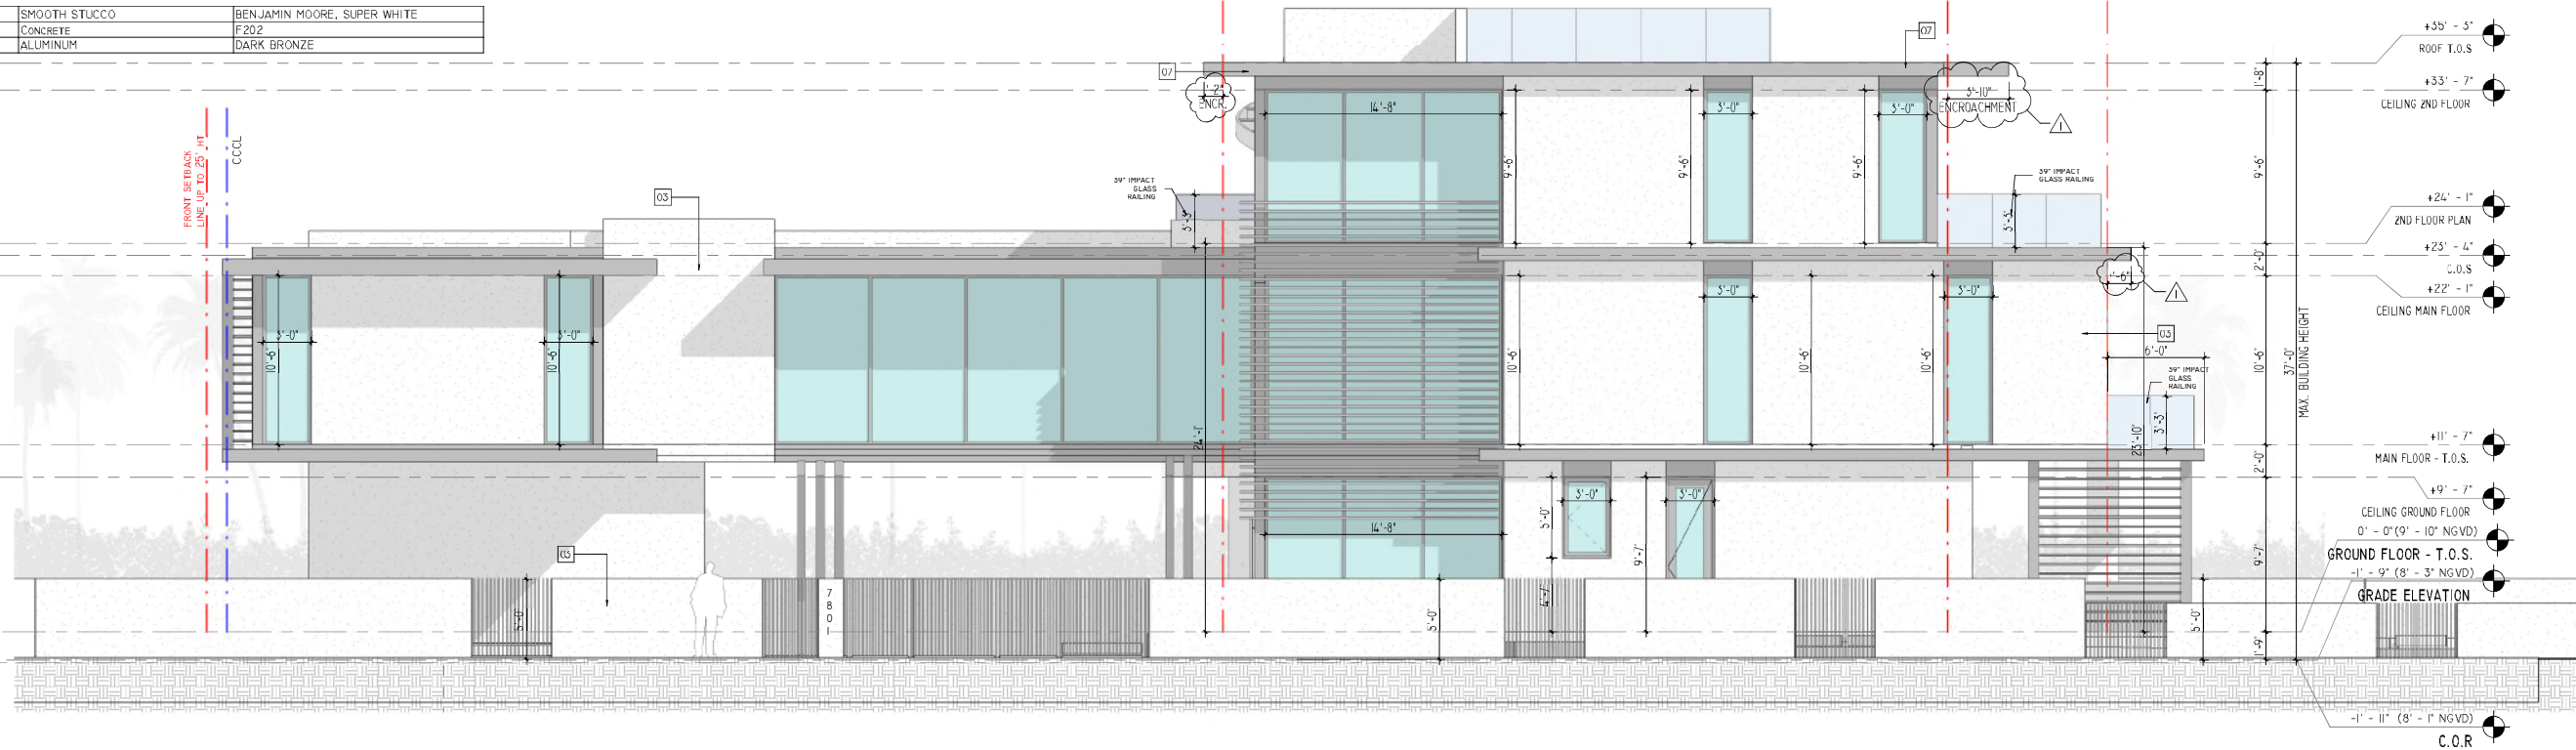

1 RIGHT
3/16" = 1'-0"

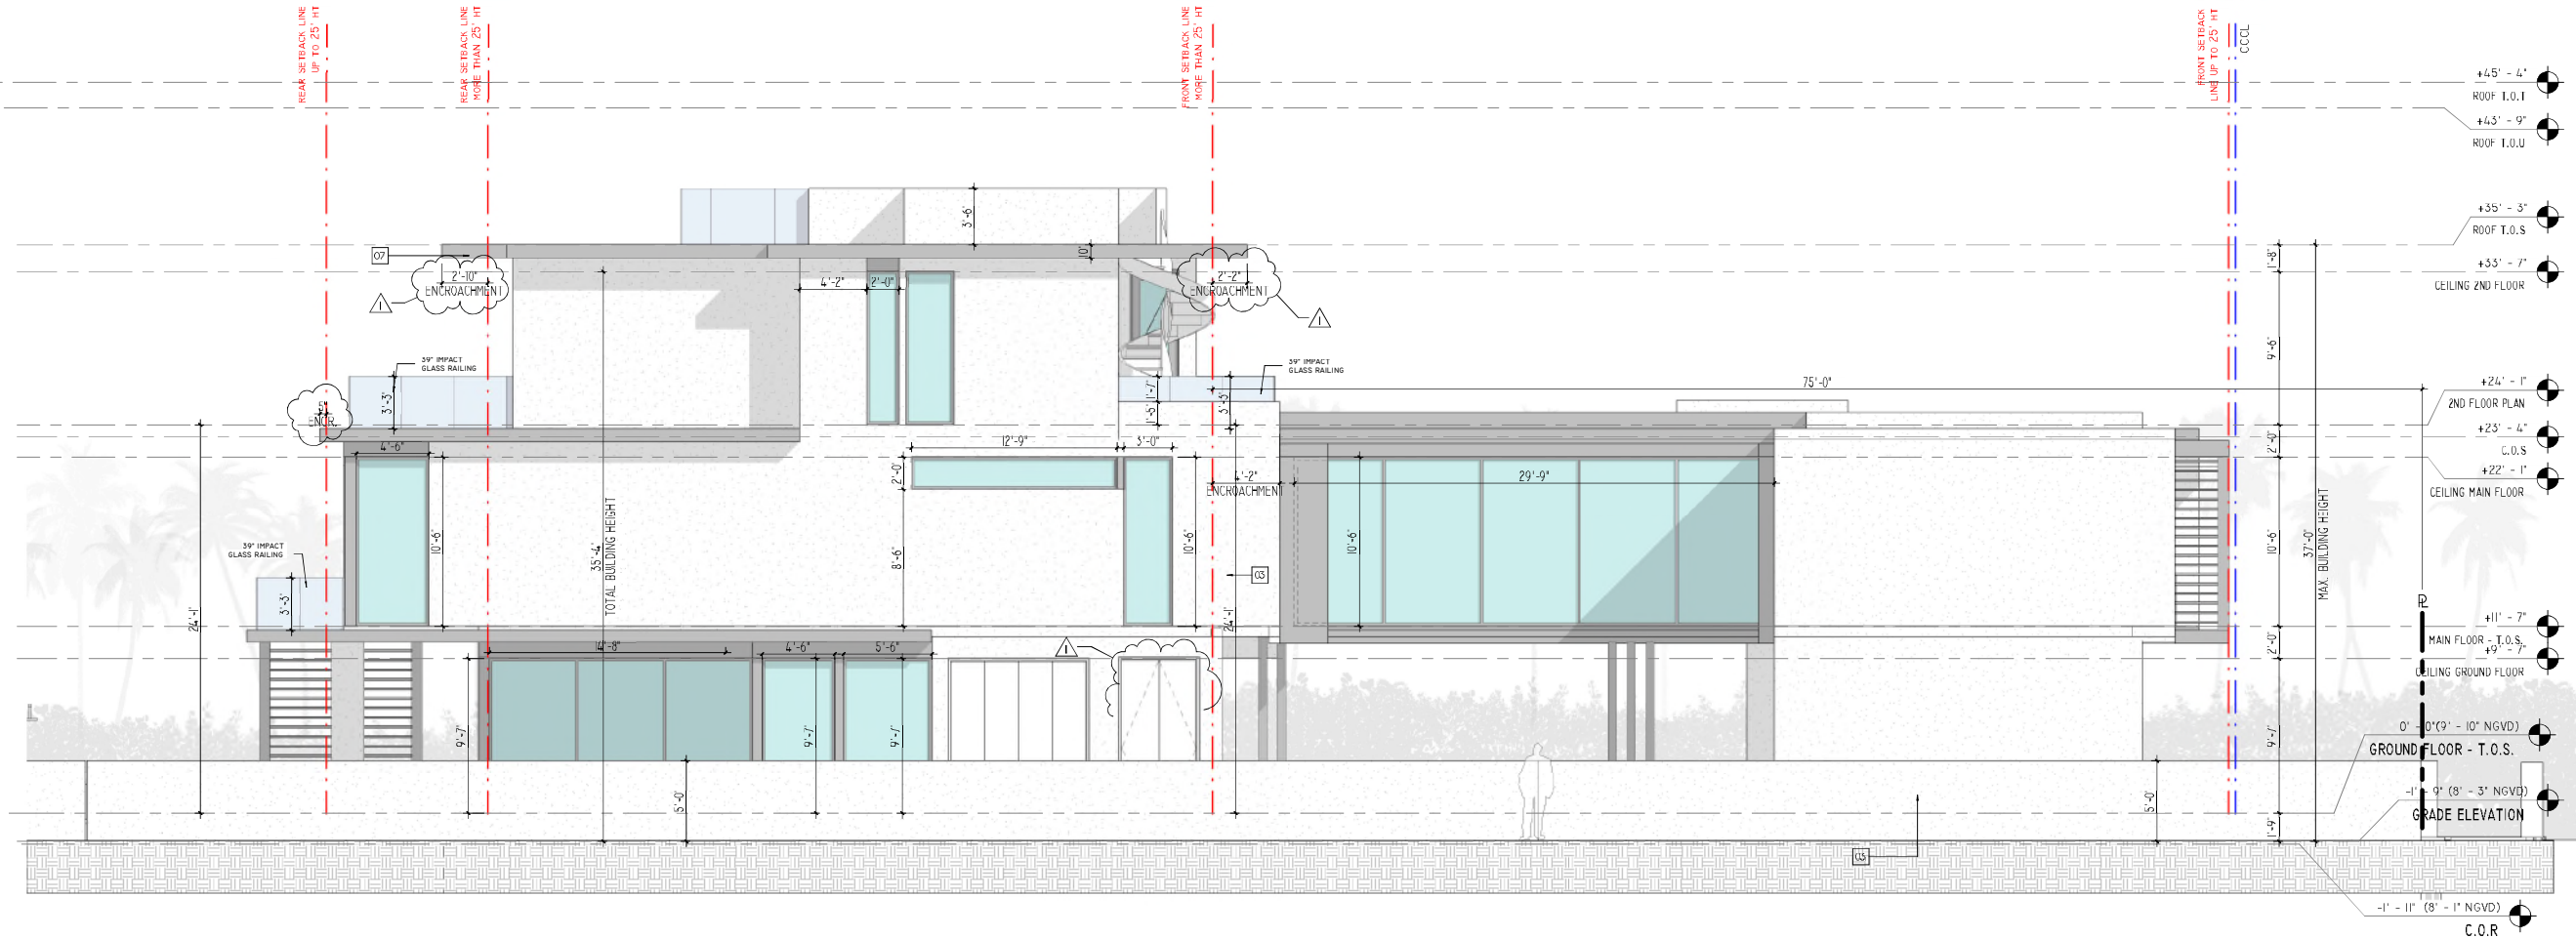

2 LEFT
3/16" = 1'-0"

SDH_STUDIO
ARCHITECTURE+DESIGN

AA26002883
18200 NE 19TH AVE, SUITE 100
NORTH MIAMI BEACH, FL 33162
(305) 501.5013
INFO@SDHSTUDIO.COM


STEPHANIE D. DE HALFEN
ARCHITECT P.A.
ARCH REG # 9955

7801 ATLANTIC

7801 ATLANTIC WAY, MIAMI BEACH, FL. 33141

OWNER

Stephanie Dornbusch h de Halphen
Digitally signed by Stephanie Dornbusch de Halphen
DN: cn=Stephanie Dornbusch de Halphen, o=US, ou=SDH Studio
Reason: I am the author of this document
Date: 2023.04.07 17:35:54.00

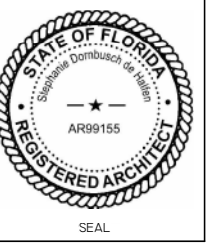

NOTES/COMMENTS

REVISIONS / SUBMISSIONS
1 REVISION I 04-07-23

ELEVATIONS

ALL DRAWINGS AND WRITTEN MATERIAL APPEARING HEREIN CONSTITUTE THE ORIGINAL AND UNPUBLISHED WORK OF SDH STUDIO, AND MAY NOT BE REPRODUCED, USED, OR DISCLOSED WITHOUT THE EXPRESS WRITTEN CONSENT OF SDH STUDIO.

DRAWN BY: SDH
CHECKED BY: RB
INITIAL DRAWING ISSUE DATE
RELEASE DATE:

A-201



SDH_STUDIO
ARCHITECTURE+DESIGN

AA26002883

18200 NE 19TH AVE, SUITE 100
NORTH MIAMI BEACH, FL 33162
(305) 501-5013
INFO@SDHSTUDIO.COM


STEPHANIE D. DE HALFEN
ARCHITECT P.A.
ARCH REG # 9955

7801 ATLANTIC

7801 ATLANTIC WAY, MIAMI
BEACH, FL. 33141

OWNER

Stephanie Dornbusch de Halfen
Digitally signed by
Stephanie Dornbusch de Halfen
DN: cn=Stephanie
Dornbusch de Halfen
o=SDH Studio
Reason: I am the
author of this document
Location:
Date: 2023-04-07
17:34:04-00

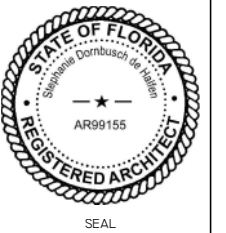

NOTES/COMMENTS

REVISIONS / SUBMISSIONS

I REVISION I 04-07-23

RENDERINGS

ALL DRAWINGS AND WRITTEN MATERIAL APPEARING
HEREIN CONSTITUTE THE ORIGINAL AND UNPUBLISHED
WORK OF SDH STUDIO, AND MAY NOT BE REPRODUCED,
USED, OR DISCLOSED WITHOUT THE EXPRESS WRITTEN
CONSENT OF STEPHANIE D. HALFEN

DRAWN BY: SDH
CHECKED BY: RB
INITIAL DRAWING ISSUE DATE
RELEASE DATE:

A-100.6

HOA Support



Altos Del Mar Association, Inc.
7732 Atlantic Way,
Miami Beach, FL 33141

August 2, 2023

Historic Preservation Board Members

c/o Deborah Tackett, Historic Preservation & Architecture Officer
Planning Department
City of Miami Beach
1700 Convention Center Drive, 2nd Floor
Miami Beach, Florida 33139

Re: *HPB23-0572 – 7801 Atlantic Way, Miami Beach*
Letter of Support

Dear Board Members:

We represent the Homeowners Association of Altos del Mar Association, Inc.

We have spoken with the applicant and reviewed the plans for the property. Altos del Mar has variety of architectural styles and most of the homes, especially on the ocean front side, are new construction. The new design that the applicant is proposing is beautiful and complies with all the Altos Del Mar requirements and like all of the other new homes delivers a major tax benefit to the City.

Our homes are at the highest risk for storm surge and flooding. As you know, we are the only single-family, ocean front neighborhood in the city. We are grateful that this new home will be resilient and minimize any potential negative impacts to the rest of the community.

Based on the foregoing, we fully support the applicant's request for demolition and the proposed new design for 7801 Atlantic Way. In turn, we urge you to support the requests and allow them to move forward with a resilient home that is consistent with the Altos del Mar requirements.

Sincerely,

A handwritten signature in black ink, appearing to be "C. [unclear]".

The Board of Directors
Altos del Mar Association, Inc.




Recycling Plan

PROJECT

7801 Atlantic Way Miami Bch

DATE

07/18/2023 

TOTAL CONSTRUCTION WASTE

TOTAL DIVERTED WASTE

PERCENT OF WASTE DIVERTED

96.09908 %



Architectural Salvage Plan

• Exterior:

- Title pavers
- Wood gate
- Screen door
- Stained glass window
- Trims
- Breeze block

• Interior:

- Wood doors
- Hinges and doorknobs
- Base boards and flooring
- Bathroom tiles
- Handrails

• Removal:

- Prior to demolition
- Hand labor
- Maintain a complete record of all salvaged materials, including condition before and after salvage operations

Voluntary Proffers

1. Historic plaque describing the district and home, visible from the public beach access.
2. Careful removal and storage of all listed materials in the architectural salvage plan.
3. Donation of pavers to the Altos Del Mar Homeowners Association.
4. Submit as-built architectural drawings to the Historic American Buildings Survey (HABS) collection.

Thank You

200 S. Biscayne Boulevard
Suite 300, Miami, FL 33131

www.brzoninglaw.com

305.374.5300 office

305.377.6222 fax

Info@brzoninglaw.com

Demolition Criteria – 2.13.7(d)(vi)(4)

- a. Classified as a contributing structure at the local level, not national or state level.
- b. Could only be reproduced with great difficulty or expense.
- c. Contains characteristic of Mediterranean Revival, but is not wholly consistent with the style of architecture or district.
- d. Classified as a contributing structure because it existed at the time the district was designated.
- e. Retention of the structure will not promote the general welfare of the City. It is a private residence, in a gated community, and cannot be studied.
- f. N/A. The existing home will be replaced with a single-family home.
- g. Definite plans submitted
- h. N/A. No demolition order.

Modifications

- Major changes in 1994:
 - Living room enclosed
 - New shingle roof and windows
 - New kitchen, electrical, plumbing, floors
- Additional changes in 2014:
 - Single impact window
 - Demolition of failing site wall along north property line
 - Helical piles to reinforce existing footings
- Cosmetic improvements between 2016 – 2021:
 - Fencing
 - Driveways and walkways

Historic Resources

- 54% of the homes in ADM have been demolished and replaced
- Over 72% of the homes in ADM were built in the last 25 years
- At the time of designation, only 37.5% of the lots had a contributing structure

Current Elevation

FDEP (FLORIDA DEPARTMENT OF ENVIRONMENTAL PROTECTION) Evaluation Criteria:


Considerations based on elevation flood levels were analyzed and the following assessment has been made.

"The one-hundred-year storm elevation requirements for habitable structures located seaward of the coastal construction control line ensure that the lowest horizontal structural member of the building is placed at an elevation above the predicted breaking wave crest."


The existing house has a current elevation of +13'-0". The recommended elevation for the area per FDEP 100 year flood is +18.2'. The current house does not comply with these guidelines.

* Compliance would require raising the existing house 5'


FINISH MATERIALS		
MATERIAL MARK	MATERIAL NAME	MATERIAL DESCRIPTION
01	SMOOTH STUCCO	BENJAMIN MOORE, SUPER WHITE
03	CONCRETE	F202
07	ALUMINUM	DARK BRONZE

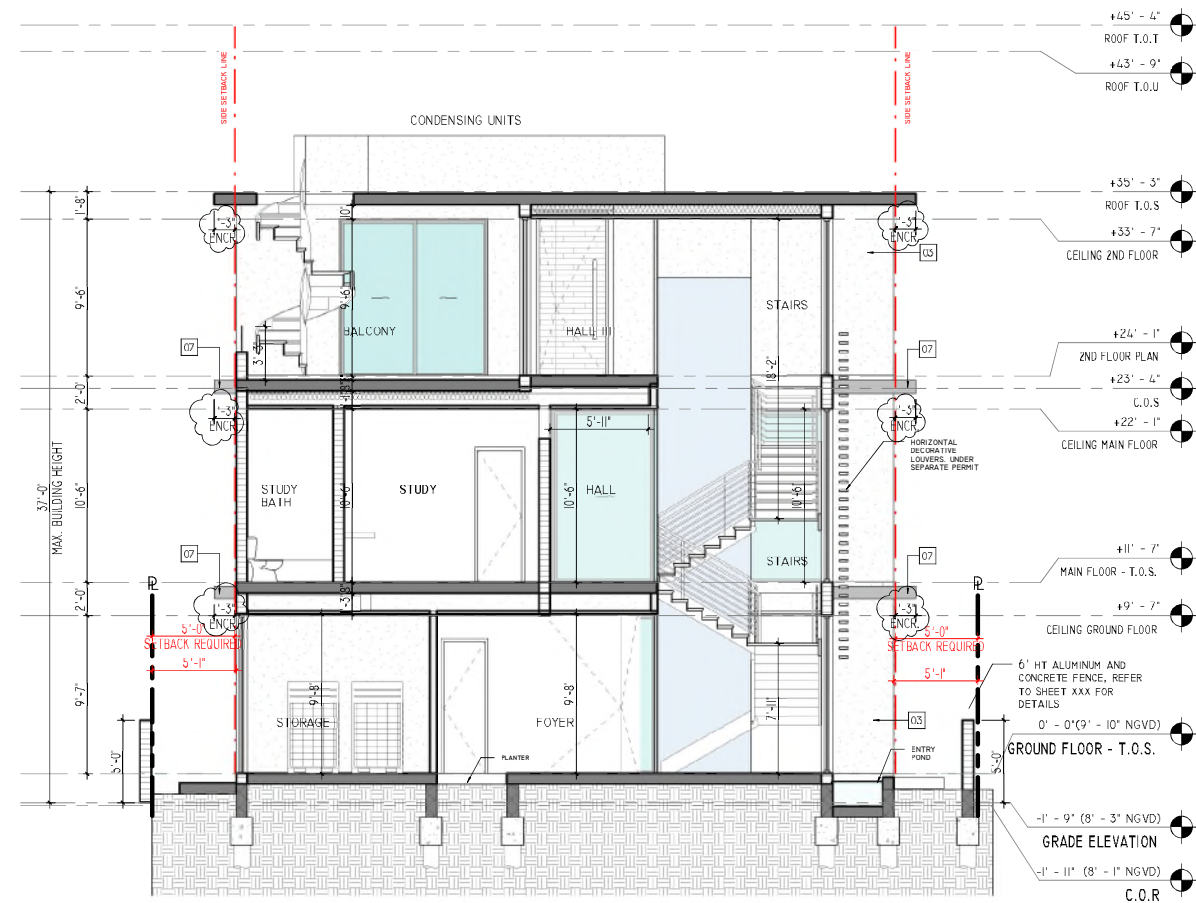

SECTION 1
3/16" = 1'-0"

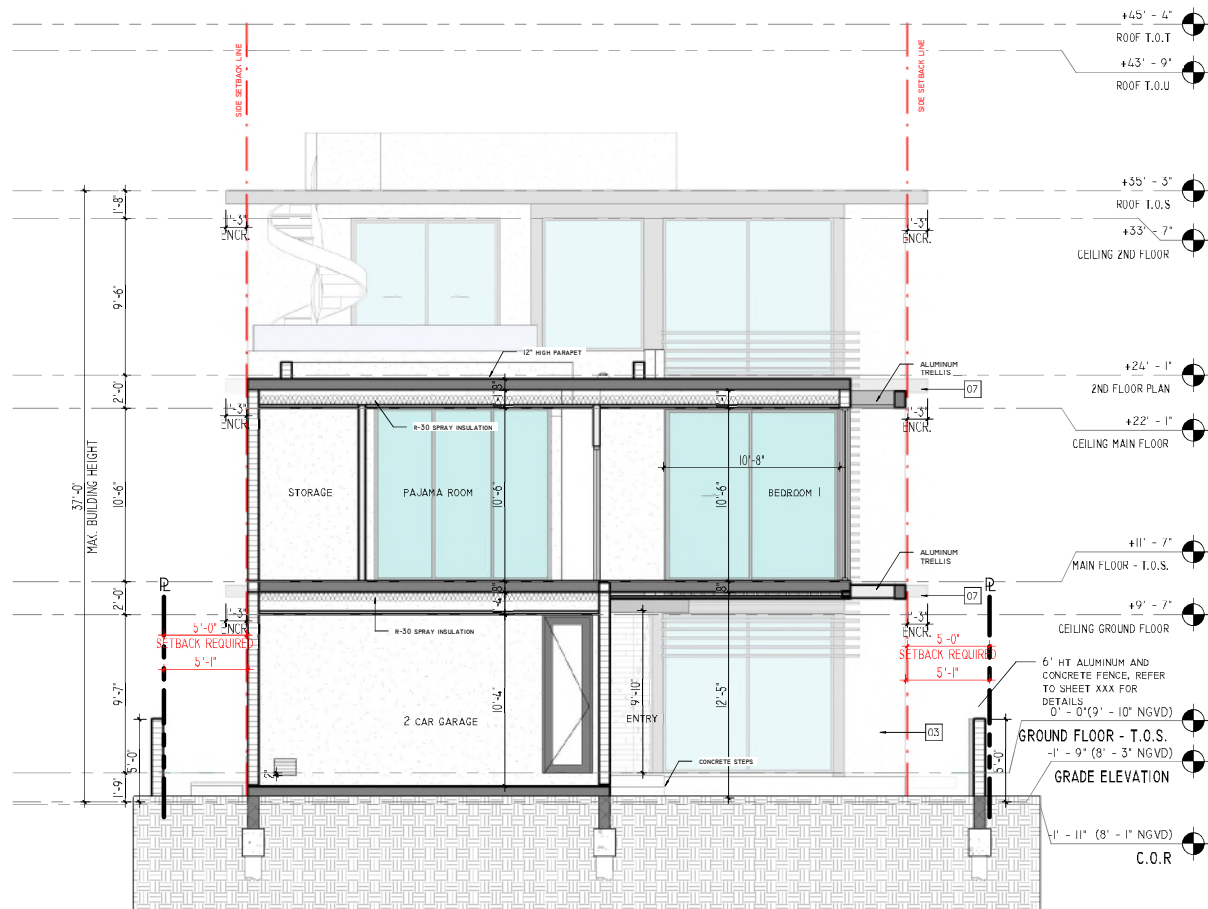

SECTION 2
3/16" = 1'-0"

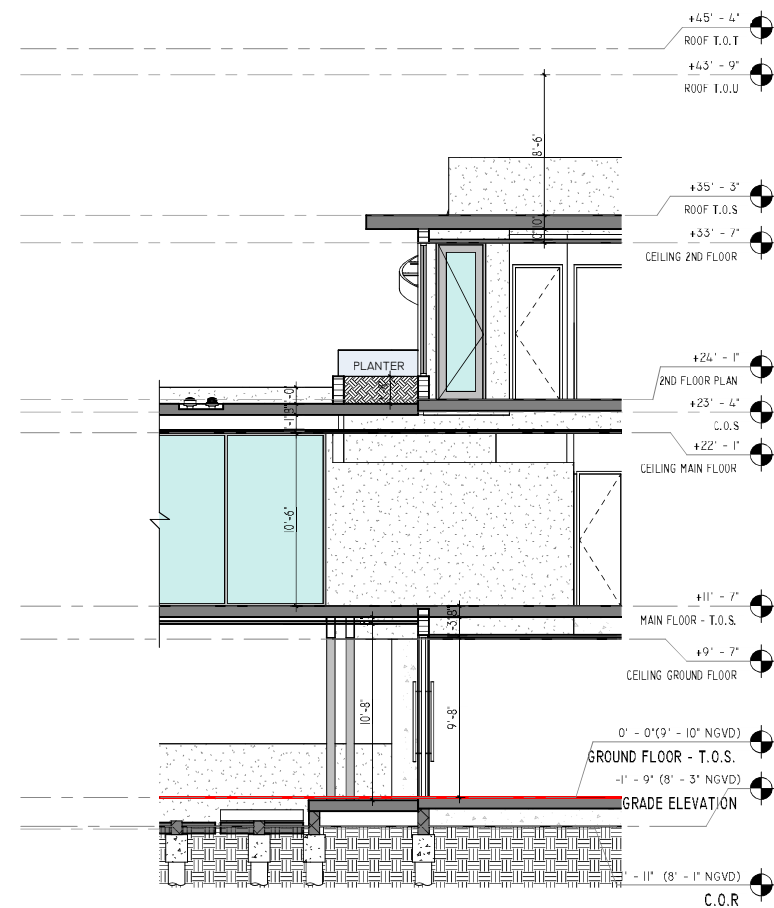

SECTION 3
3/16" = 1'-0"

SDH_STUDIO
ARCHITECTURE+DESIGN

AA26002883
18200 NE 19TH AVE, SUITE 100
NORTH MIAMI BEACH, FL 33162
(305) 501 5013
INFO@SDHSTUDIO.COM


STEPHANIE D. DE HALFEN
ARCHITECT P.A.
ARCH REG # 9655

7801
ATLANTIC

7801 ATLANTIC WAY, MIAMI
BEACH, FL. 33141

OWNER

Stephanie Dornbusch de Halphen
Digitally signed by Stephanie Dornbusch de Halphen
DN: cn=Stephanie Dornbusch de Halphen, o=SDH Studio
Reason: I am the author of this document
Location: Date: 2023-04-07 17:36:04-00

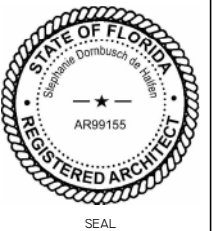

NOTES/COMMENTS

REVISIONS / SUBMISSIONS

1 REVISION I 04-07-23


SECTIONS

ALL DRAWINGS AND WRITTEN MATERIAL APPEARING HEREIN CONSTITUTE THE ORIGINAL AND UNPUBLISHED WORK OF SDH STUDIO, AND MAY NOT BE REPRODUCED, USED, OR DISCLOSED WITHOUT THE EXPRESS WRITTEN CONSENT OF STEPHANIE D. HALFEN


DRAWN BY: SDH
CHECKED BY: RB
INITIAL DRAWING ISSUE DATE
RELEASE DATE:

A-300

FINISH MATERIALS		
MATERIAL MARK	MATERIAL NAME	MATERIAL DESCRIPTION
01	SMOOTH STUCCO	BENJAMIN MOORE, SUPER WHITE
03	CONCRETE	F 202
07	ALUMINUM	DARK BRONZE

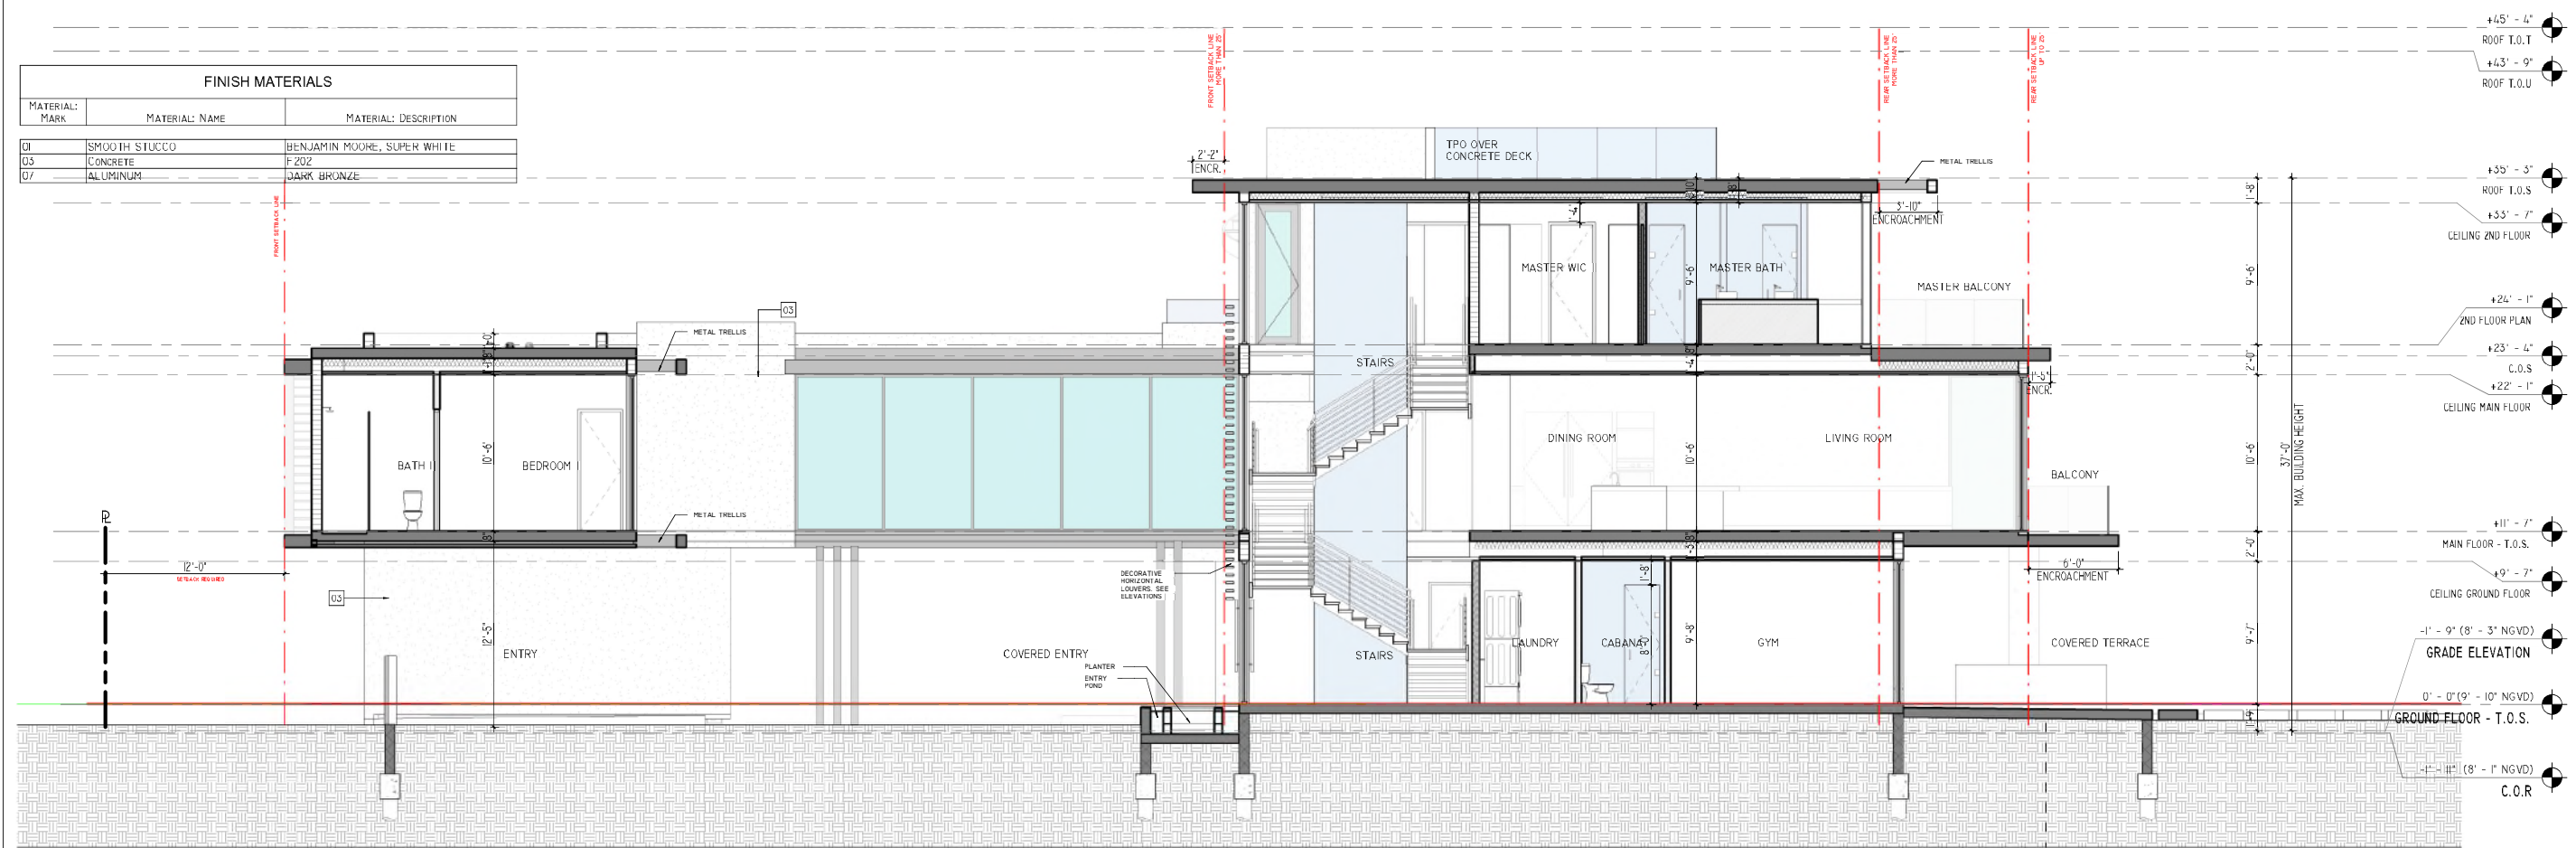

SECTION 3
3/16" = 1'-0"

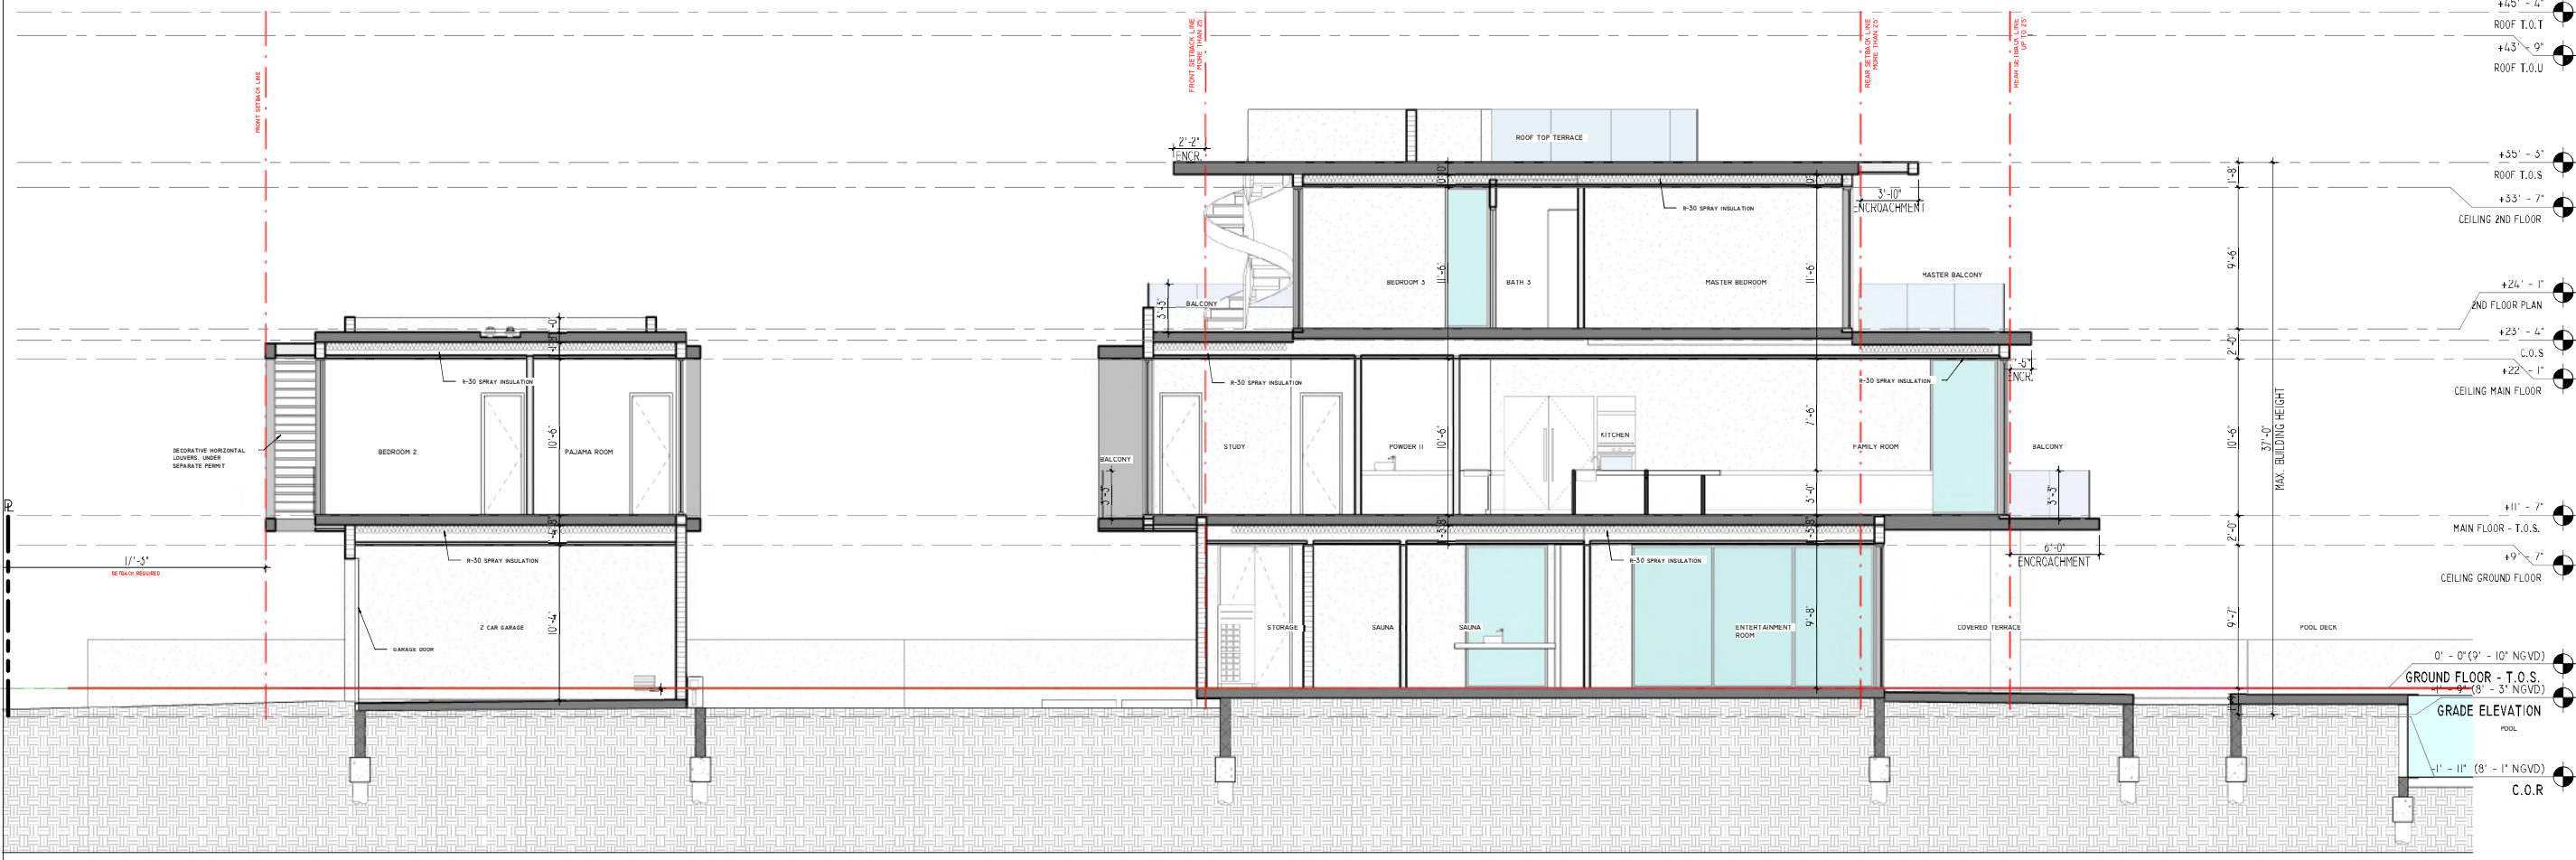

SECTION 5
3/16" = 1'-0"

SDH_STUDIO
ARCHITECTURE+DESIGN

AA26002883

18200 NE 19TH AVE, SUITE 100
NORTH MIAMI BEACH, FL 33162
(305) 501 5013
INFO@SDHSTUDIO.COM

STEPHANIE D. DE HALFEN
ARCHITECT P.A.
ARCH REG # 9155


7801 ATLANTIC

7801 ATLANTIC WAY, MIAMI BEACH, FL. 33141

OWNER

Stephanie Dornbusch de Halfen

Digitally signed by Stephanie Dornbusch de Halfen
DN: cn=Stephanie Dornbusch de Halfen, o=SDH Studio
Reason: I am the author of this document
Location: Miami, FL
Date: 2023.04.07 17:36:04.00

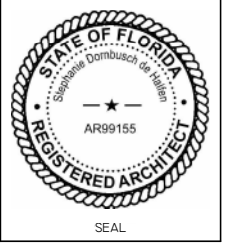

NOTES/COMMENTS

REVISIONS / SUBMISSIONS

SECTIONS

ALL DRAWINGS AND WRITTEN MATERIAL APPEARING HEREIN CONSTITUTE THE ORIGINAL AND UNPUBLISHED WORK OF SDH STUDIO, AND MAY NOT BE REPRODUCED, USED, OR DISCLOSED WITHOUT THE EXPRESS WRITTEN CONSENT OF STEPHANIE D. HALFEN

DRAWN BY: SDH
CHECKED BY: RB
INITIAL DRAWING RELEASE DATE:
ISSUE DATE:

A-301