


SITE PICTURES





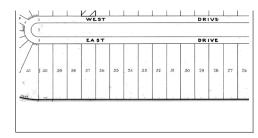

NTS = NOT TO SCALE D.B.H DIAMETER OF BREAST HEIGHT		. – 320	11011	LINE	
SURVEYOR'S LEGEND (IF ANY APPLIED)					
	BOUNDARY LINE]	CATCH BASIN	
	STRUCTURE (BLDG.)	С)	MANHOLE	
	CONCRETE BLOCK WALL	0.1	E.	OVERHEAD EL	
	METAL FENCE	Ø		POWER POLE	
	WOODEN FENCE	ф) -	LIGHT POLE	
	CHAIN LINK FENCE	R	1	HANDICAP SP	
	WOOD DECK/DOCK	C	<i>M</i>	THE STATE OF THE S	
	ASPHALTED AREAS	2	1	HANDICAP SP	
4	CONCRETE		_	EASEMENT LIN	
\mathbb{K}	BRICKS OR PAVERS	•	4	WATER VALVE	
\sim	ROOFED AREAS	tv	/	TV-CABLE BO)	
Jan Jan	WATER (EDGE OF WATE	R) V	VΜ	WATER METER	

U.E. = UTIL. EASEMENT W.P. = WOODEN POLE

CERTIFIED TO:
BRIAN L BILZIM
C/O BILZIM SUMBERG ETALS

JOB SPECIFIC SURVEYOR NOTES:

- ① THE PROPERTY DESCRIBED ON THIS SURVEY DOES LIE WITHIN A SPECIAL HAZARD AREA AS DEFINED BY THE FEDERAL EMERGENCY MANAGEMENT AGENCY; THE PROPERTY LIES WITHIN A FLOOD ZONE "AE" OF THE FLOOD INSURANCE RATE MAP IDENTIFIED AS COMMUNITY PANEL No. 120651-0319L, WITH AN EFFECTIVE DATE OF SEPTEMBER 11, 2009. BASE FLOOD ELEVATION OF 10.00 FEET (NGVD)
- (2) LAND AREA OF SUBJECT PROPERTY: 40,000 SF (+/-)
- 3 ELEVATIONS ARE BASED ON THE NATIONAL GEODETIC VERTICAL DATUM (NGVD) OF 1929, AS PER MIAMI DADE COUNTY BENCH MARK No. E-03, WITH AN ELEVATION OF 9.47 FEET.
- (4) BEARINGS SHOWN HEREON ARE BASED ON AN ASSUME MERIDIAN OF N.07°56'00"W., BEING THE RECORDED BEARING FOR THE CENTERLINE OF STAR ISLAND DR., AS SHOWN ON PLAT BOOK 31 AT PAGE 60 OF THE PUBLIC RECORD OF MIAMI DADE COUNTY FLORIDA,

GENERAL SURVEYOR NOTES:

NOT VALID WITHOUT THE SIGNATURE AND RAISED SEAL OF A FLORIDA LICENSED SURVEYOR AND MAPPER

THE SHOWN LEGAL DESCRIPTION USED TO PERFORM THIS BOUNDARY SURVEY WAS PROVIDED BY THE CLIENT.

SURVEY IS BASED ON RECORDED INFORMATION PROVIDED BY CLIENT. NO SPECIFIC SEARCH OF THE PUBLIC RECORD HAS BEEN MADE BY OUR OFFICE.

UNLESS OTHERWISE NOTED, AN EXAMINATION OF THE ABSTRACT OF TITLE WAS NOT DONE BY THE SIGNING SURVEYOR TO DETERMINE WHICH INSTRUMENTS, IF ANY ARE AFFECTING THE SUBJECT PROPERTY.

THIS SURVEY IS EXCLUSIVELY FOR THE USE OF THE PARTIES TO WHOM IT WAS CERTIFIED.

PURSUANT TO RULE 61G17-6 OF THE FLORIDA ADMINISTRATIVE CODE THE EXPECTED USE OF LAND IS SUBURBAN, THE MINIMUM RELATIVE DISTANCE ACCURACY FOR THIS TYPE OF SURVEY IS 1 FOOT IN 5,500 FEET. THE ACCURACY OBTAINED BY MEASUREMENT AND CALCULATIONS OF CLOSED GEOMETRIC FIGURES WAS FOUND TO EXCEED THIS REQUIREMENT.

THERE ARE NO VISIBLE, ABOVE GROUND ENCROACHMENTS (a) BY THE IMPROVEMENTS OF THE SUBJECT PROPERTY UPON ADJOINING PROPERTIES, STREETS OR ALLEYS, OR (b) BY THE IMPROVEMENTS OF THE ADJOINING PROPERTIES, STREETS OR ALLEYS UPON THE SUBJECT PROPERTY OTHER THAN THOSE SHOWN ON THIS BOUNDARY SURVEY.

THERE ARE NO VISIBLE EASEMENTS OR RIGHT-OF-WAY OF WHICH THE UNDERSIGNED HAS BEEN ADVISED OTHER THAN THOSE SHOWN ON THIS SURVEY.

THE MAP OF SURVEY IS INTENDED TO BE DISPLAYED AT THE SHOWN GRAPHIC SCALE IN ENGLISH UNITS OF MEASUREMENT. IN SOME CASES GRAPHIC REPRESENTATION HAVE BEEN EXAGERATED TO MORE CLEARLY ILLUSTRATE A PARTICULAR AREA WHERE DIMENSIONS SHALL HAVE PREFERENCE OVER GRAPHIC LOCATION.

THE ELEVATIONS (IF ANY) OF WELL-IDENTIFIED FEATURES AS DEPICTED ON THIS SURVEY AND MAP WERE MEASURED TO AN ESTIMATED VERTICAL POSITIONAL ACCURACY OF $\frac{1}{10}$ FOOT FOR NATURAL GROUND SURFACES AND $\frac{1}{100}$ FOOT FOR HARDSCAPE SURFACES, INCLUDING PAVEMENT, CURBS, SIDEWALKS AND OTHER MANMADE STRUCTURES.

 $\textit{THE SURVEYOR MAKES NO REPRESENTATION AS TO OWNERSHIP, POSSESSION OR OCCUPATION OF THE SUBJECT PROPERTY BY ANY ENTITY OR INDIVIDUAL. \\$

ANY FEMA FLOOD ZONE INFORMATION PROVIDED ON THIS SURVEY IS FOR INFORMATIONAL PURPOSE ONLY AND IT WAS OBTAINED AT WWW.FEMA.COM.

IF YOU ARE READING THIS BOUNDARY SURVEY IN AN ELECTRONIC FORMAT, THE INFORMATION CONTAINED ON THIS DOCUMENT IS ONLY VALID IF THIS DOCUMENT IS ELECTRONICALLY SIGNED AS SPECIFIED IN CHAPTER 5J-17.062 (3) OF THE FLORIDA ADMINISTRATIVE CODE. IF THIS DOCUMENT IS IN PAPER FORMAT, IT IS NOT VALID WITHOUT THE SIGNATURE AND ORIGINAL RAISED SEAL OF THE PROFESSIONAL LAND SURVEYOR AND MAPPER OF RECORD.

LEGAL DESCRIPTION:

LOT 6 , OF CORRECTED PLAT STAR ISLAND , ACCORDING TO THE PLAT THEREOF AS RECORDED IN PLAT BOOK 31 AT PAGE 60, OF THE PUBLIC RECORDS OF MIAMI-DADE COUNTY, FLORIDA.

I HEREBY CERTIFY THAT THE ATTACHED SKETCH OF "BOUNDARY SURVEY" AND THE SURVEY MAP RESULTING THEREFROM OF THE ABOVE DESCRIBED PROPERTY IS A TRUE AND CORRECT REPRESENTATION OF A FIELD SURVEY MADE UNDER MY DIRECTION AND MEETS THE INTENT OF THE APPLICABLE PROVISIONS OF THE "MINIMUM TECHNICAL STANDARDS FOR LAND SURVEYING IN THE STATE OF FLORIDA" PURSUANT TO RULE 53-17 OF THE FLORIDA ADMINISTRATIVE CODE AND ITS IMPLEMENTED LAW, CHAPTER 472.027, OF THE FLORIDA STATUTES.

SITE ADDRESS: 6 STAR ISLAND DRIVE, MIAMI BEACH, FLORIDA 33139

JOB NUMBER: 15-606

DATE OF SURVEY: June 3, 2015 / JULY 27, 2016 (SPOT SURVEY)

FOLIO NUMBER: 02-4204-001-0060

ENCROACHMENTS AND OTHER POINTS OF INTEREST:
-THERE ARE NO VISIBLE ENCROACHMENT OF THE SUBJECT PROPERTY

-THE SUBJECT PROPERTY IS WITHIN A FLOOD ZONE AE (SEE NOTE 1)
-THERE ARE NOT PLATTED UTIL. EASEMENT ON THE SUBJECT PROPERTY



American Services of Miami, Corp Consulting Engineers . Planners . Surveyors

9370 S.W. 72nd Street, Suite A-102 Miami, Florida, 33173 PH: (305) 598-5101 FAX: (305) 598-8627 PROISSIONANE LAND STRVEY
MARRHEY NO 7771


AND MARRHEY NO 7771

AND MARRHEY NO 7771

AND MARRHEY NO 7771

AND MARRHEY NO 7771

DATE: <u>AUGUSY 2, 2016</u>

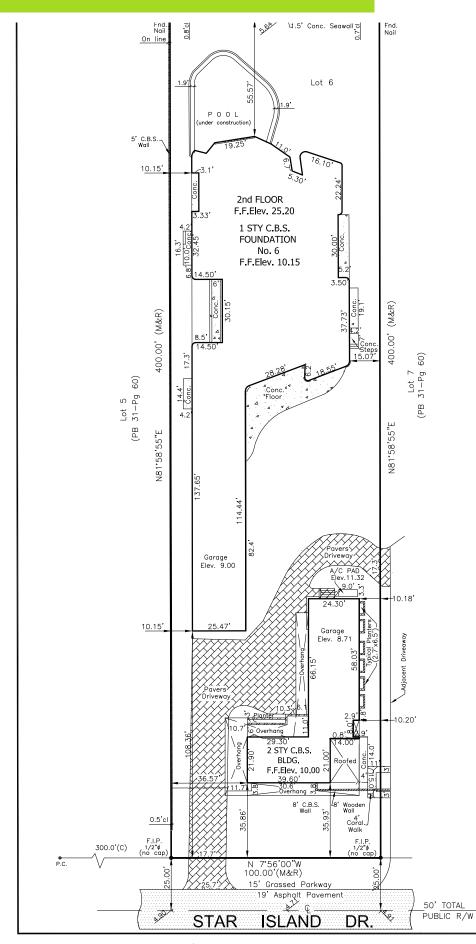












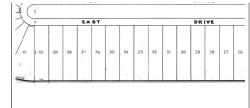

M. = MONUMENT LINE NTS = NOT TO SCALE D.B.H DIAMETER OF BREAST HEIGHT SURVEYOR'S LEGEND (IF ANY APPLIED) BOUNDARY LINE STRUCTURE (BLDG.) MANHOLE CONCRETE BLOCK WALL O.E. OVERHEAD EL POWER POLE - METAL FENCE - WOODEN FENCE CHAIN LINK FENCE HANDICAP SP WOOD DECK/DOCK HANDICAP SPA EASEMENT LIN BRICKS OR PAVERS ■ WATER VALVE ROOFED AREAS tv TV-CABLE BOX

WATER (EDGE OF WATER) WM WATER METER

CERTIFIED TO: BRIAN L BILZIM C/O BILZIM SUMBERG ETALS

JOB SPECIFIC SURVEYOR NOTES

- THE PROPERTY DESCRIBED ON THIS SURVEY DOES LIE WITHIN A SPECIAL HAZARD AREA AS DEFINED BY THE FEDERAL EMERGENCY MANAGEMENT AGENCY; THE PROPERTY LIES WITHIN A FLOOD ZONE "AE" OF THE FLOOD INSURANCE RATE MAP IDENTIFIED AS COMMUNITY PANEL No. 120651-0319L, WITH AN EFFECTIVE DATE OF SEPTEMBER 11, 2009. BASE FLOOD ELEVATION OF 10.00 FEET (NGVD)
- 2 LAND AREA OF SUBJECT PROPERTY: 40,000 SF (+/-)
- 3 ELEVATIONS ARE BASED ON THE NATIONAL GEODETIC VERTICAL DATUM (NGVD) OF 1929, AS PER MIAMI DADE COUNTY BENCH MARK No. E-03, WITH AN ELEVATION OF 9.47 FEET.
- (4) BEARINGS SHOWN HEREON ARE BASED ON AN ASSUME MERIDIAN OF N.07°56'00"W., BEING THE RECORDED BEARING FOR THE CENTERLINE OF STAR ISLAND DR., AS SHOWN ON PLAT BOOK 31 AT PAGE 60 OF THE PUBLIC RECORD OF MIAMI DADE COUNTY FLORIDA.

CENERAL SURVEYOR NOTES:
NOT VALID WITHOUT THE SIGNATURE AND RAISED SEAL OF A FLORIDA LICENSED SURVEYOR AND MAPPER

THE SHOWN LEGAL DESCRIPTION USED TO PERFORM THIS BOUNDARY SURVEY WAS PROVIDED BY THE CLIENT.

SURVEY IS BASED ON RECORDED INFORMATION PROVIDED BY CLIENT. NO SPECIFIC SEARCH OF THE PUBLIC RECORD HAS BEEN MADE BY OUR OFFICE.

UNLESS OTHERWISE NOTED, AN EXAMINATION OF THE ABSTRACT OF TITLE WAS NOT DONE BY THE SIGNING SURVEYOR TO DETERMINE WHICH INSTRUMENTS, IF ANY ARE AFFECTING THE SUBJECT PROPERTY.

THIS SURVEY IS EXCLUSIVELY FOR THE USE OF THE PARTIES TO WHOM IT WAS CERTIFIED.

PURSUANT TO RULE 61G17-6 OF THE FLORIDA ADMINISTRATIVE CODE THE EXPECTED USE OF LAND IS SUBURBAN. THE MINIMUM RELATIVE DISTANCE ACCURACY FOR THIS TYPE OF SURVEY IS 1 FOOT IN 7,500 FEET. THE ACCURACY OBTAINED BY MEASUREMENT AND CALCULATIONS OF CLOSED GEOMETRIC FIGURES WAS FOUND TO EXCEED THIS REQUIREMENT.

THERE ARE NO VISIBLE, ABOVE GROUND ENCROACHMENTS (a) BY THE IMPROVEMENTS OF THE SUBJECT PROPERTY UPON ADJOINING PROPERTIES, STREETS OR ALLEYS, OR (b) BY THE IMPROVEMENTS OF THE ADJOINING PROPERTIES, STREETS OR ALLEYS UPON THE SUBJECT PROPERTY OTHER THAN THOSE SHOWN ON THIS

THERE ARE NO VISIBLE EASEMENTS OR RIGHT-OF-WAY OF WHICH THE UNDERSIGNED HAS BEEN ADVISED OTHER THAN THOSE SHOWN ON THIS SURVEY.

THE MAP OF SURVEY IS INTENDED TO BE DISPLAYED AT THE SHOWN GRAPHIC SCALE IN ENGLISH UNITS OF MEASUREMENT. IN SOME CASES GRAPHIC REPRESENTATION HAVE BEEN EXAGERATED TO MORE CLEARLY ILLUSTRATE A PARTICULAR AREA WHERE DIMENSIONS SHALL HAVE PREFERENCE OVER GRAPHIC

THE ELEVATIONS (IF ANY) OF WELL-IDENTIFIED FEATURES AS DEPICTED ON THIS SURVEY AND MAP WERE MEASURED TO AN ESTIMATED VERTICAL POSITIONAL ACCURACY OF $\frac{1}{10}$ FOOT FOR NATURAL GROUND SURFACES AND $\frac{1}{100}$ FOOT FOR HARDSCAPE SURFACES, INCLUDING PAVEMENT, CURBS, SIDEWALKS AND OTHER MANMADE STRUCTURES.

THE SURVEYOR MAKES NO REPRESENTATION AS TO OWNERSHIP, POSSESSION OR OCCUPATION OF THE SUBJECT PROPERTY BY ANY ENTITY OR INDIVIDUAL.

ANY FEMA FLOOD ZONE INFORMATION PROVIDED ON THIS SURVEY IS FOR INFORMATIONAL PURPOSE ONLY AND IT WAS OBTAINED AT WWW.FEMA.COM.

IF YOU ARE READING THIS BOUNDARY SURVEY IN AN ELECTRONIC FORMAT. THE INFORMATION CONTAINED ON THIS DOCUMENT IS ONLY VALID IF THIS DOCUMENT IS ELECTRONICALLY SIGNED AS SPECIFIED IN CHAPTER 5J-17.062 (3) OF THE FLORIDA ADMINISTRATIVE CODE. IF THIS DOCUMENT IS IN PAPER FORMAT, IT IS NOT VALID WITHOUT THE SIGNATURE AND ORIGINAL RAISED SEAL OF THE PROFESSIONAL LAND SURVEYOR AND MAPPER OF RECORD.

LOT 6 , OF CORRECTED PLAT STAR ISLAND , ACCORDING TO THE PLAT THEREOF AS RECORDED IN PLAT BOOK 31 AT PAGE 60, OF THE PUBLIC RECORDS OF MIAMI-DADE COUNTY, FLORIDA.

I HERERY CERTIFY THAT THE ATTACHED SKETCH OF "BOLINDARY SLIRVEY" AND THE SLIRVEY MAP RESULTING THEREROM OF THE AROVE DESCRIRED PROPERTY IS A TRUE AND CORRECT REPRESENTATION OF A FIELD SURVEY MADE UNDER MY DIRECTION AND MEETS THE INTENT OF THE APPLICABLE PROVISIONS OF THE "MINIMUM TECHNICAL STANDARDS FOR LAND SURVEYING IN THE STATE OF FLORIDA" PURSUANT TO RULE 5J-17 OF THE FLORIDA ADMINISTRATIVE CODE AND ITS IMPLEMENTED LAW, CHAPTER 472.027, OF THE FLORIDA STATUTES

SITE ADDRESS: 6 STAR ISLAND DRIVE, MIAMI BEACH, FLORIDA 33139 JOB NUMBER: 15-606 DATE OF SURVEY: June 3, 2015 / JULY 27, 2016 (SPOT SURVEY) / AUG,15,2016/ JANUARY 3, 2017

ENCROACHMENTS AND OTHER POINTS OF INTEREST:

THERE ARE NO VISIBLE ENCROACHMENT OF THE SUBJECT PROPERTY THE SUBJECT PROPERTY IS WITHIN A FLOOD ZONE AF (SEE NOTE 1). THERE ARE NOT PLATTED UTIL. EASEMENT ON THE SUBJECT PROPERTY



FOLIO NUMBER: 02-4204-001-0060


American Services of Miami, Corp Consulting Engineers . Planners . Surveyors

9370 S.W. 72nd Street, Suite A-102 Miami, Florida, 33173


PH: (305) 598-5101 FAX: (305) 598-8627 ASOMIAMI.COM




LOCATION PLAN

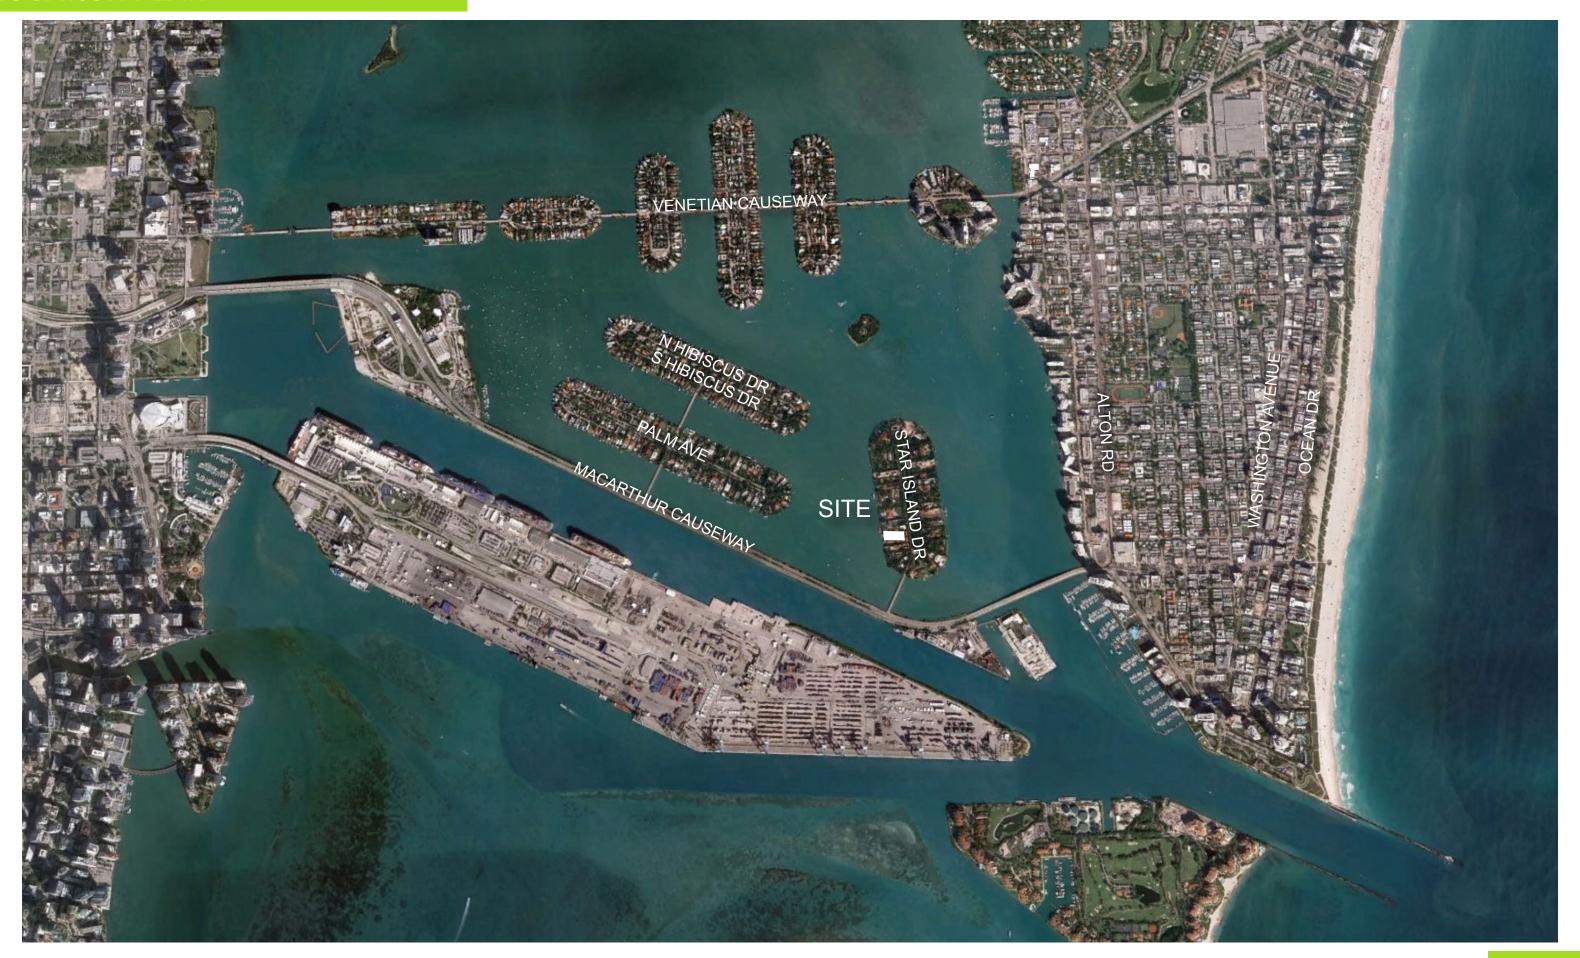


NEIGHBORHOOD ANALYSIS - LOCATION

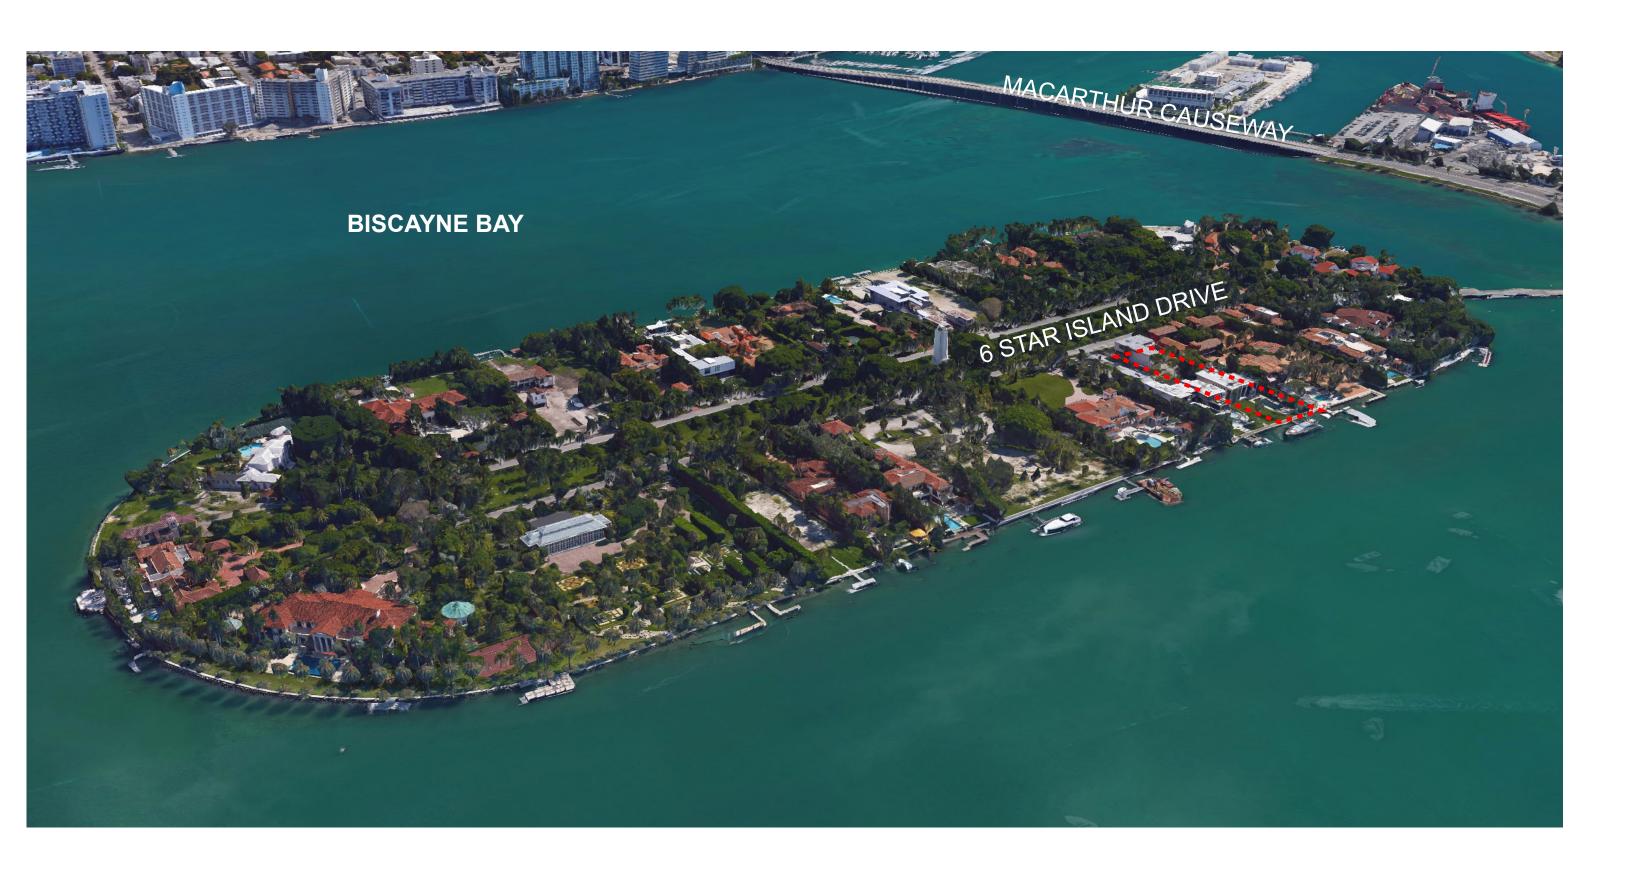

NEIGHBORHOOD ANALYSIS - STREETSCAPE

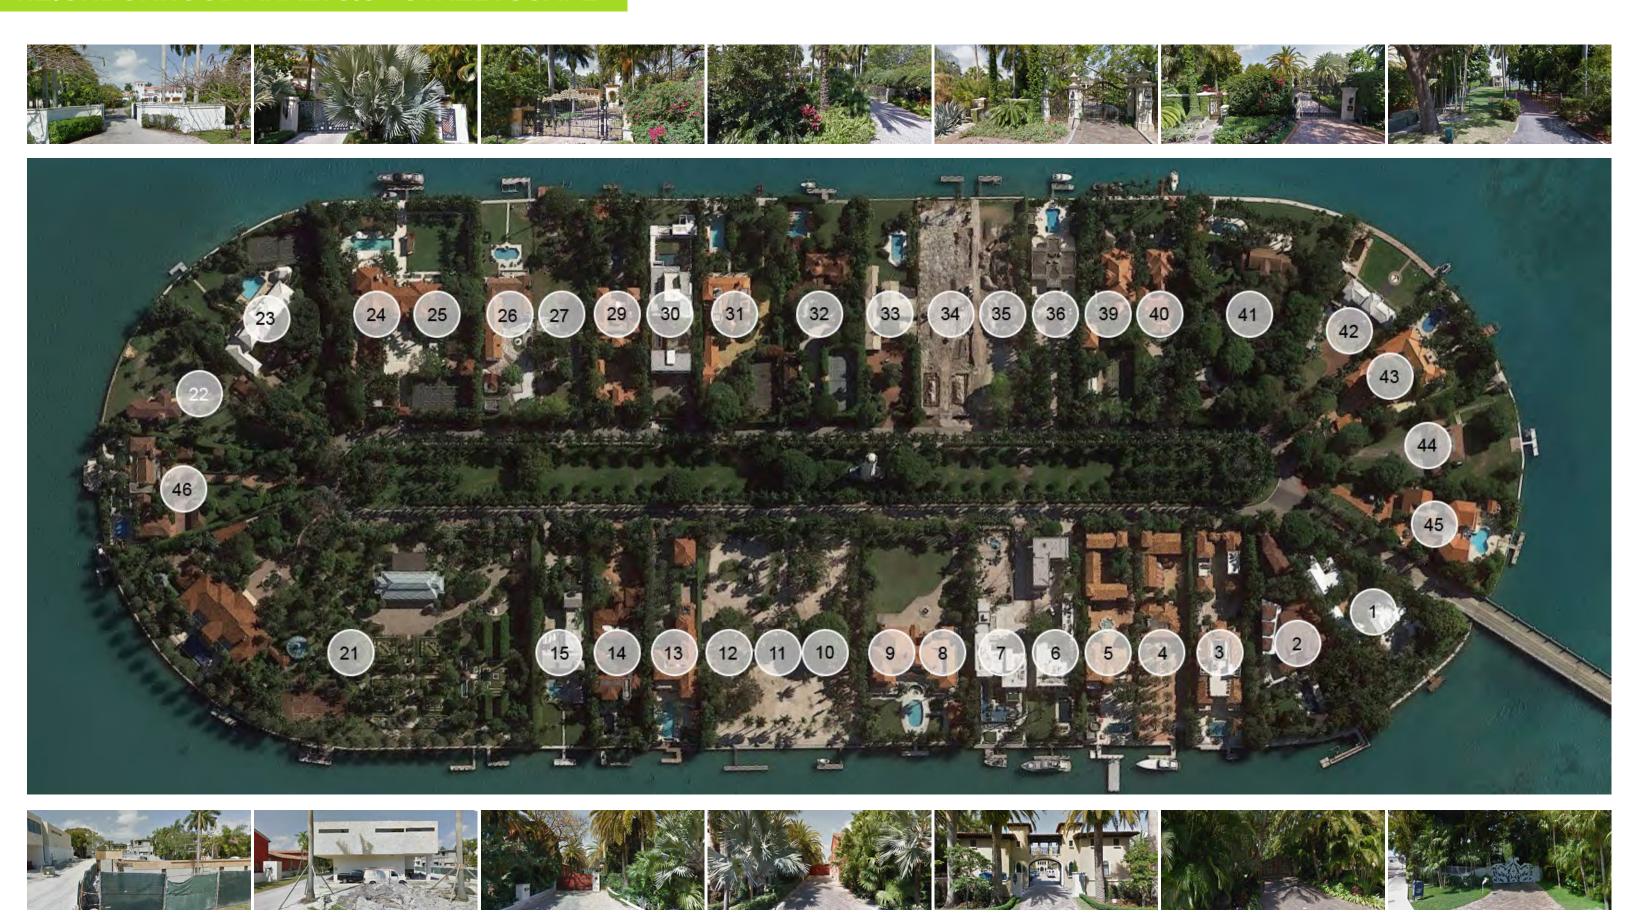


NEIGHBORHOOD ANALYSIS - STREETSCAPE

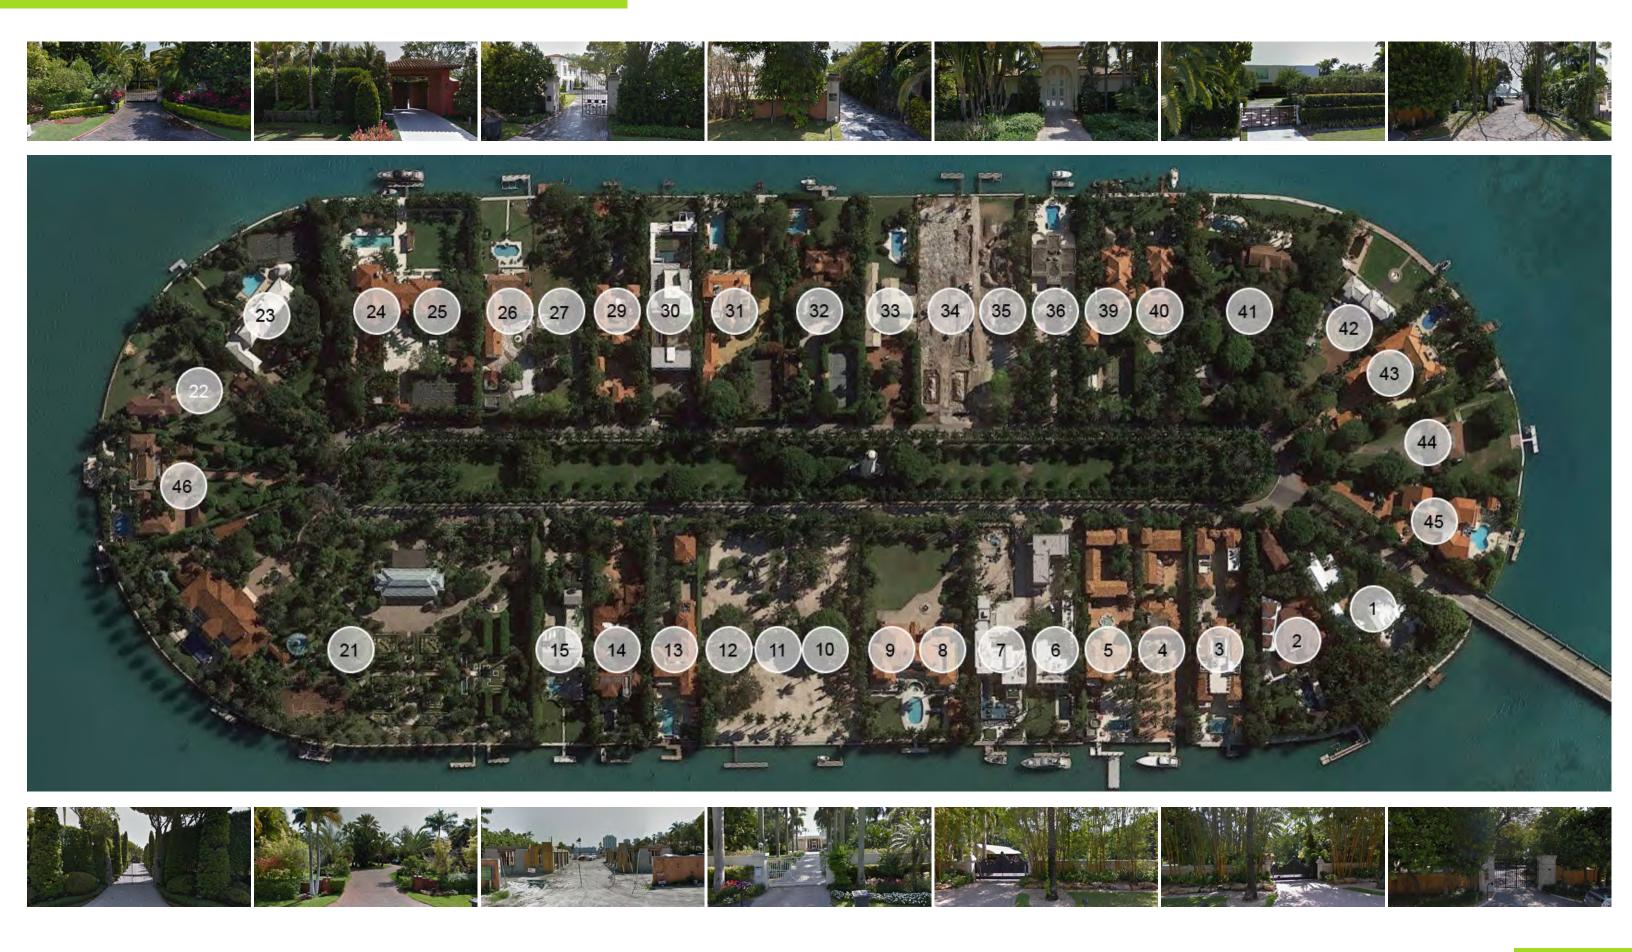



NEIGHBORHOOD ANALYSIS - EXISTING RESIDENCE

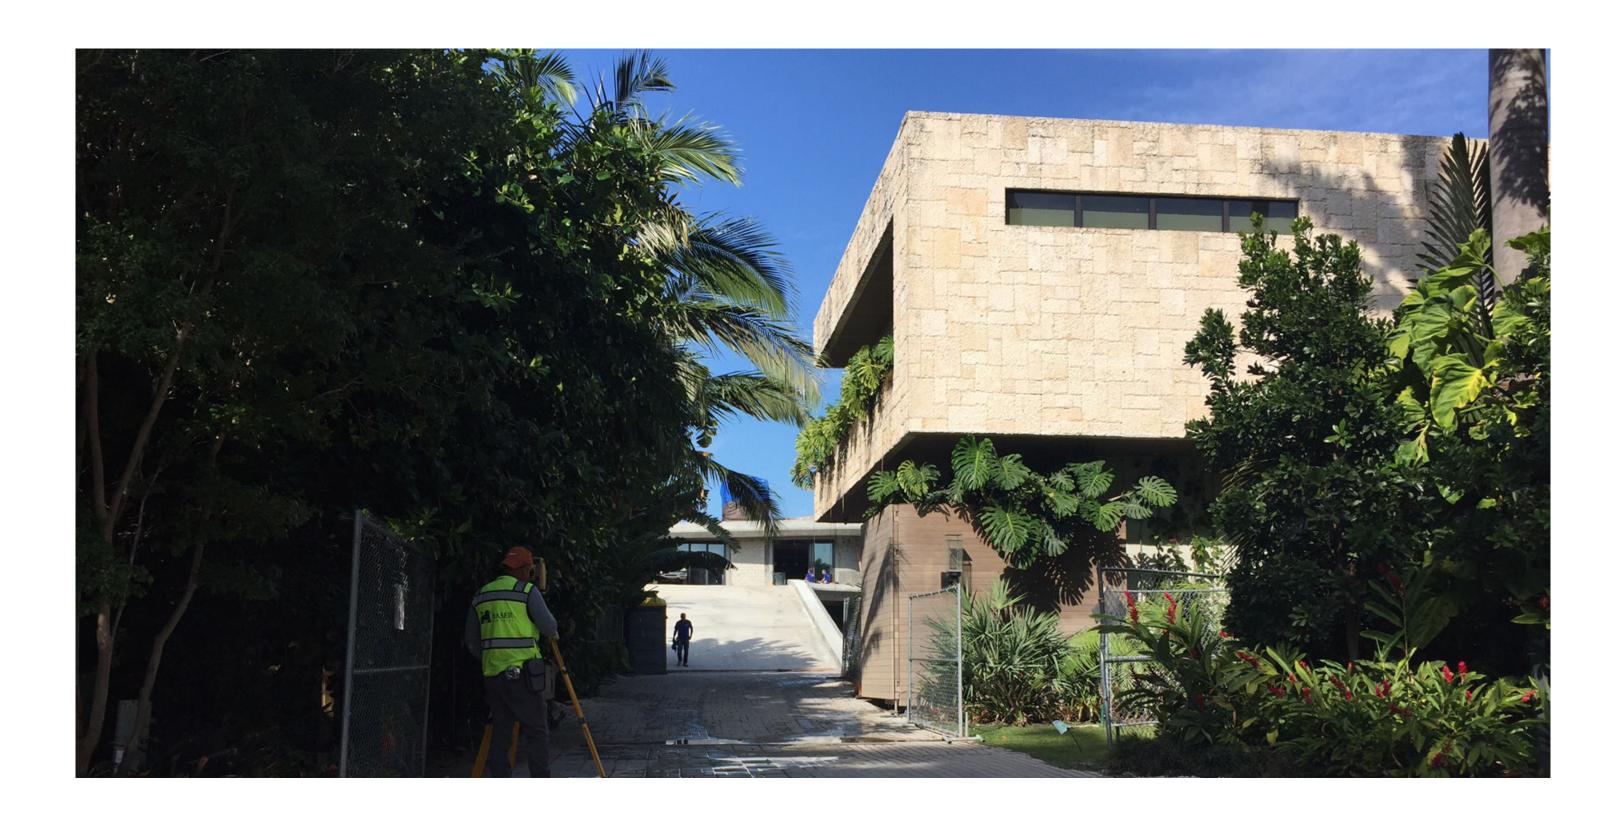

NEIGHBORHOOD ANALYSIS - EXISTING RESIDENCE

