


SCOPE OF WORK IS SHOWN WITHIN DASHED LINE. ALL ADJACENT AREAS ARE SHOWN FOR REFERENCE AND ARE PART OF THE BASE BUILDING PERMIT.

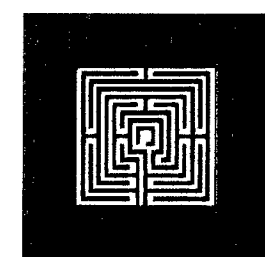

 **FIRE PROTECTION PARTIAL GROUND FLOOR PLAN**
SCALE: 1/4"=1'-0"

REFER TO BASE BLDG PERMIT DRAWINGS FOR CONTINUATION OF ALL UTILITIES.

Handwritten signature/initials




ALLAN T. SHULMAN ARCHITECT, P.A.
(AR 0012783)
100 NE 38TH STREET, NO. 2 MIAMI, FL 33137
TEL: 305.438.0609 FAX: 305.438.0170

REVISIONS		REVISIONS	
	10.29.09 CMB COMMENTS		
	12.10.09 CMB COMMENTS		

Handwritten signature/initials
12/14/09


SOHO BEACH HOUSE
4385 COLLINS AVENUE, MIAMI BEACH, FL, 33140
JOB NO. 05035
1ST & 7TH FLR KITCHENS
CONSTRUCTION DOCUMENTS

F-1.0
09.15.2009

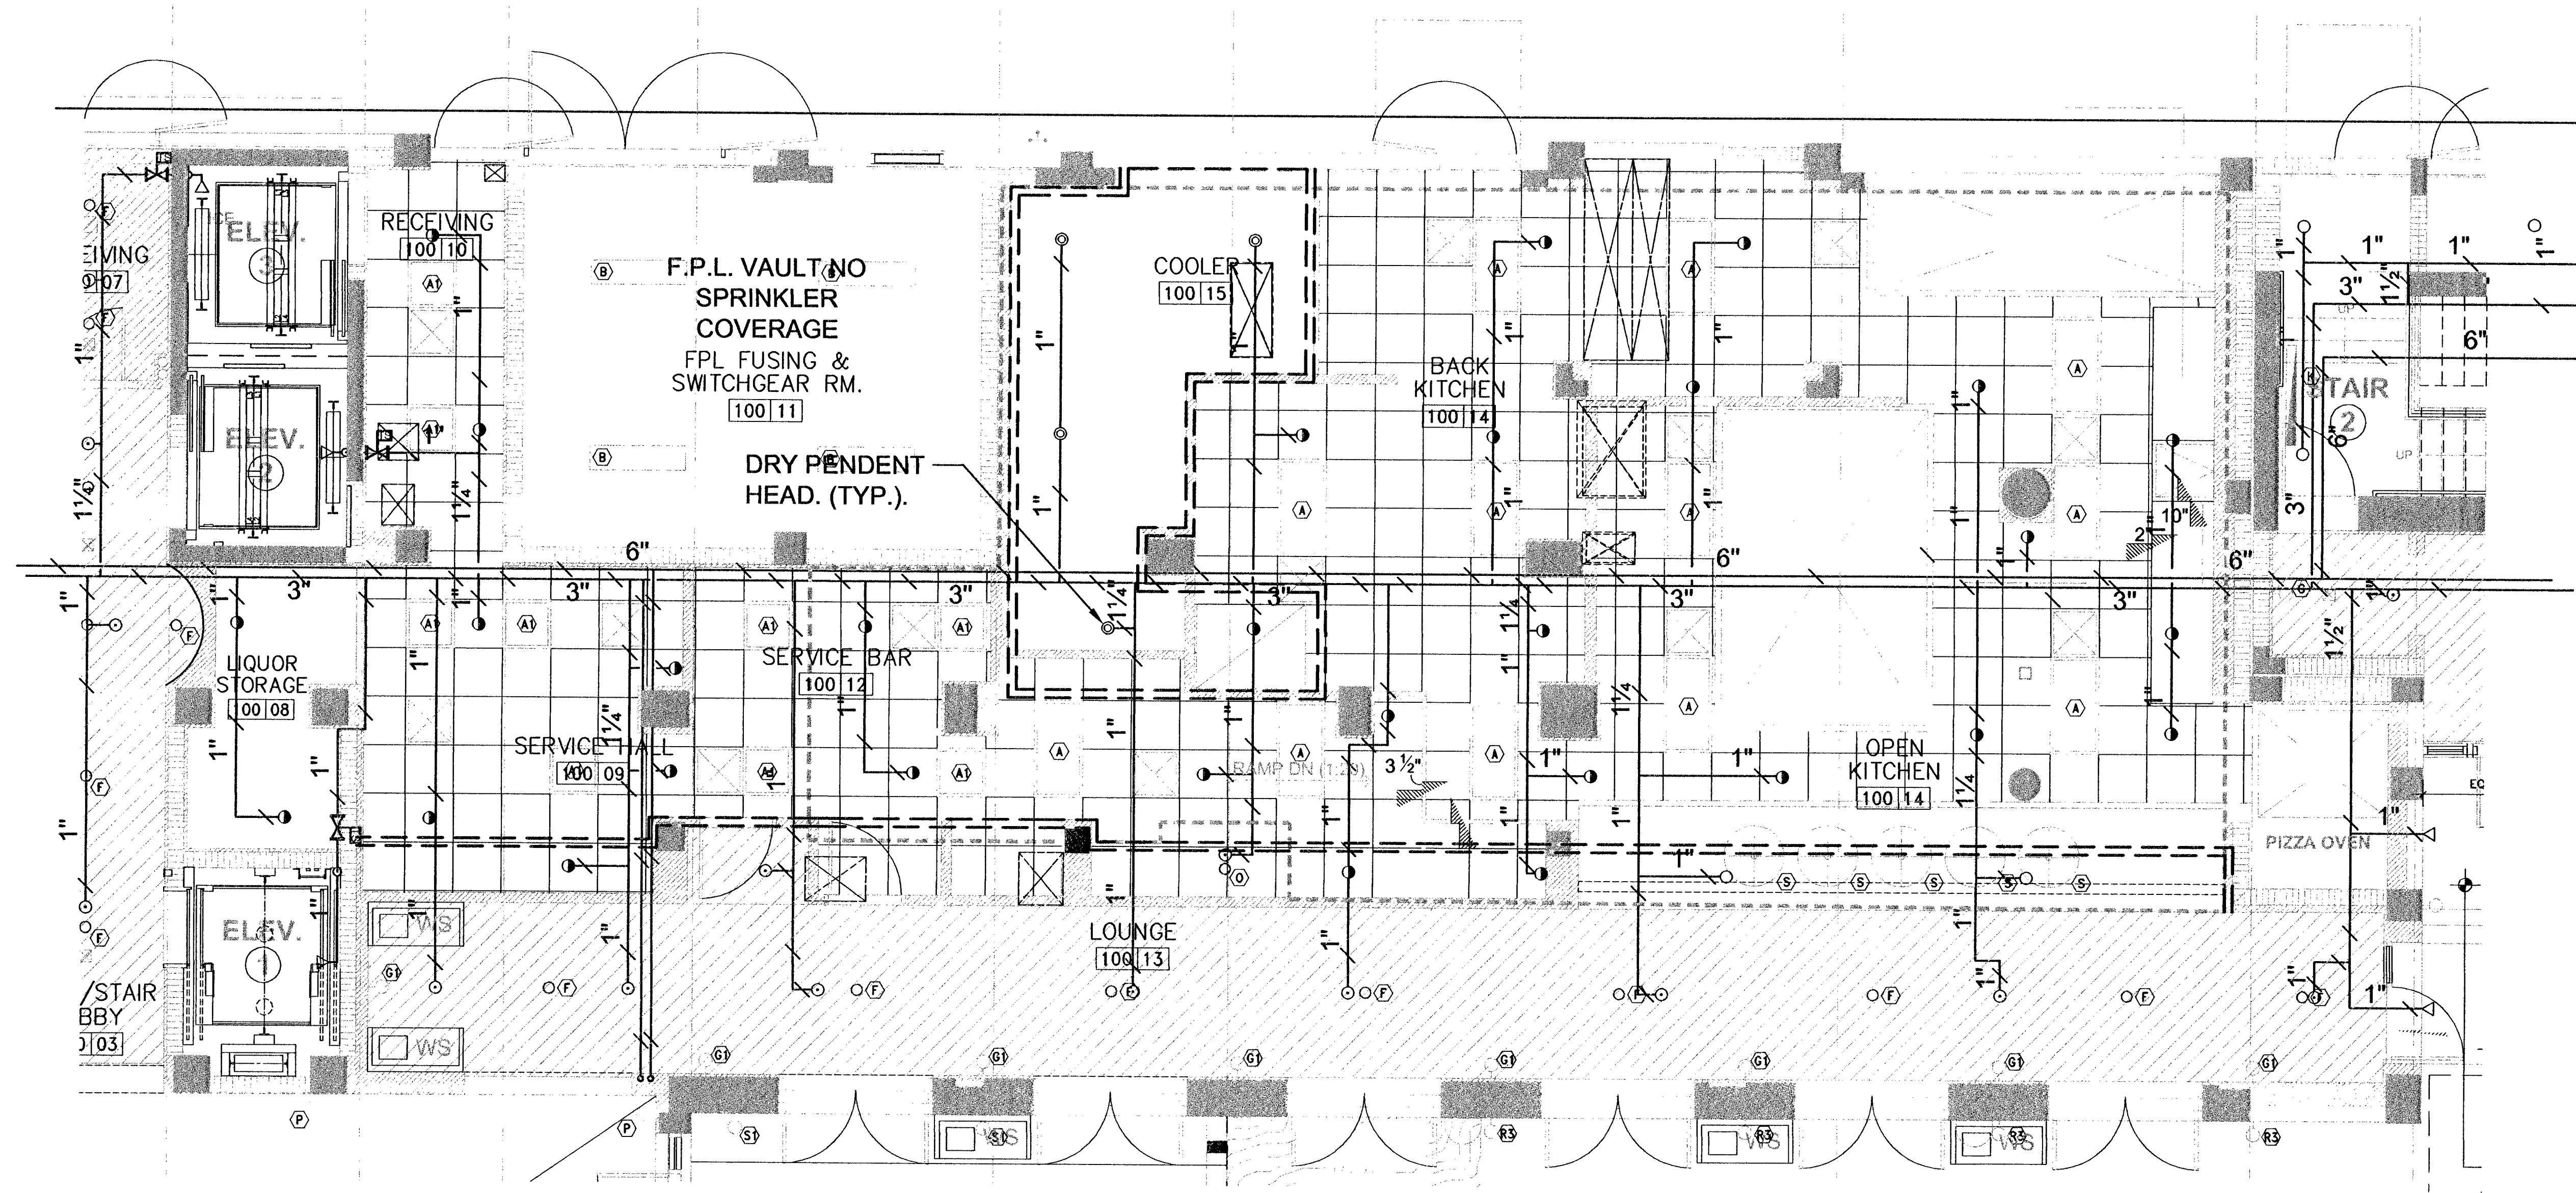

REFER TO BASE BLDG PERMIT
DRAWINGS FOR CONTINUATION
OF ALL UTILITIES.

FIRE PROTECTION GROUND FLOOR PLAN
SCALE: 1/4"=1'-0"

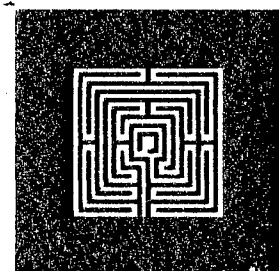

ALLAN T. SHULMAN ARCHITECT, P.A.
(AR 0012763)

100 NE 38TH STREET, NO. 2 MIAMI, FL 33137
TEL: 305.438.0609 FAX: 305.438.0170

REVISIONS	REVISIONS

SOHO BEACH HOUSE
4385 COLLINS AVENUE, MIAMI BEACH, FL 33140
JOB NO. 05035


1ST & 7TH FLOOR KITCHENS
CONSTRUCTION DOCUMENTS

9.15.09

VIDAL & ASSOCIATES INC.
CONSULTING ENGINEERS
2234 N.E. 2ND AVENUE
MIAMI, FL 33137
HENRY VIDAL P.E., PER 56204
CERTIFICATION OF AUTHORIZATION #9956
PHONE: (305) 571-1860 FAX: (305) 571-1861
EMAIL: VIDAL1961@AOL.COM

F-1.0

09.15.2009

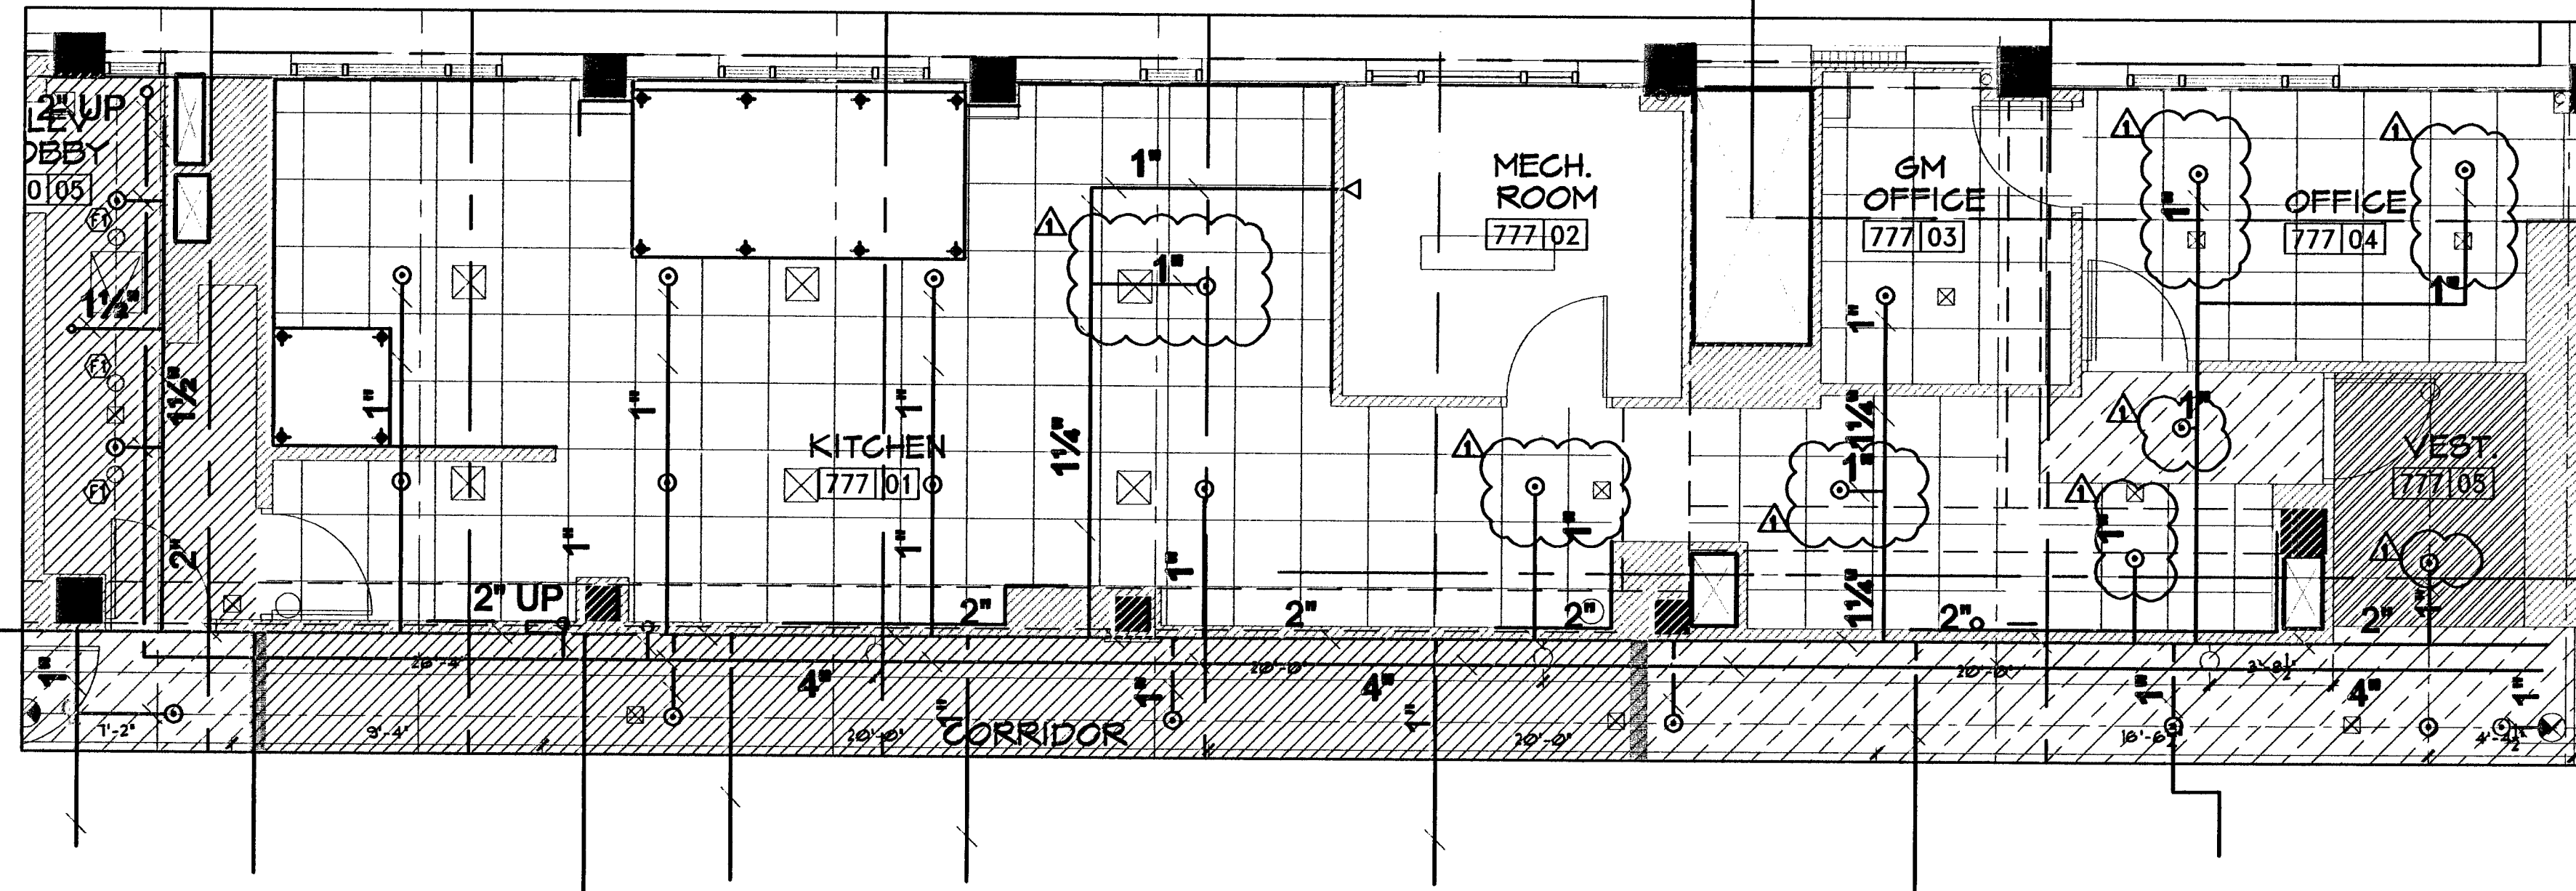


 **FIRE PROTECTION 7TH FLOOR PLAN**
SCALE: 1/4"=1'-0"

REFER TO BASE BLDG PERMIT
DRAWINGS FOR CONTINUATION
OF ALL UTILITIES.

Handwritten signature

Handwritten signature

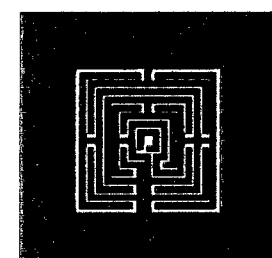


ALLAN T. SHULMAN ARCHITECT, P.A.
(AR 0012783)

100 NE 38TH STREET, NO. 2 MIAMI, FL 33137
TEL: 305.438.0809 FAX: 305.438.0170

REVISIONS	
10.08.09	CMS COMMENTS






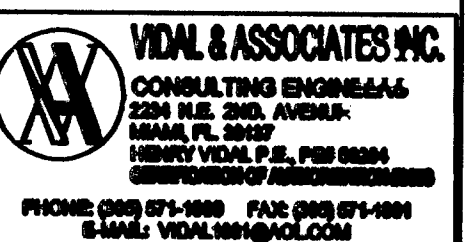









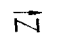

REVISIONS	

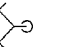SOHO BEACH HOUSE
4385 COLLINS AVENUE, MIAMI BEACH, FL, 33140
JOB NO. 06035
1ST & 7TH FLOOR KITCHENS
CONSTRUCTION DOCUMENTS

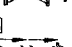

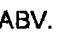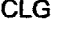


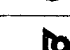


F-2.0

08.15.2009


FIRE PROTECTION LEGEND	
SYMBOL	DESCRIPTION
	FIRE PROTECTION PIPE
	CHECK VALVE
	CAPPED PIPE
	GATE VALVE
	GATE VALVE IN VERTICAL
	PIPE DOWN
	PIPE UP
	FIRE DEPARTMENT CONNECTION
	FLOW SWITCH
	POST INDICATOR VALVE WITH TAMPER SWITCH
	TAMPER SWITCH
	BACK FLOW PREVENTER
	HYDRAULIC CALC. REFERENCE POINT
	UNDERGROUND
	ABOVE
	CEILING
	TYPICAL

SPECIFICATIONS:

1. A FULL COVERAGE FIRE SPRINKLER SYSTEM SHALL BE INSTALLED IN ACCORDANCE WITH THE REQUIREMENTS OF NFPA13, FLORIDA BUILDING CODE & UNDERWRITERS INSURANCE COMPANY.
2. ALL SPRINKLER SYSTEM EQUIPMENT AND DEVICES SHALL BE LISTED BY FM & UL FOR SERVICE INTENDED. FOR SPRINKLER HEADS CHARACTERISTICS REFER TO FIRE SPRINKLER SCHEDULE THIS SHEET.
3. CONTRACTOR TO OBTAIN APPROVAL FROM OWNER REP. FOR SPRINKLER HEAD STYLE TO BE INSTALLED IN COVERED AREAS PRIOR TO INSTALLATION. SEE SCHEDULE.
4. ARRANGEMENT AND LOCATION OF SPRINKLER HEAD & EQUIPMENT SHALL BE AS INDICATED ON DRAWINGS AND SUBJECT TO CONTRACTOR SUBMITTALS.
5. DETAILED DRAWINGS OF PROPOSED DEPARTURES DUE TO ACTUAL FIELD CONDITIONS OR OTHER CAUSES SHALL BE SUBMITTED TO THE ARCHITECT/ENGINEER FOR APPROVAL.
6. PIPING: INTERIOR ABOVE GROUND SHALL BE ASTM A 53-73 OR A-106 STANDARD WEIGHT, SCHEDULE 10 BLACK STEEL PIPE WITH ROLLED MECHANICAL COUPLINGS OR XL BLACK STEEL PIPE AS PER NFPA 13 AND UL APPROVED FOR FIRE SPRINKLER SERVICE. UNDERGROUND PIPING: SHALL BE DUCTILE IRON TO MEET AWWAC-900 STANDARDS OR PVC PRESSURE PIPES CLASS 150DR-18 AS MFG. BY J-M BLUE BRUTE. CONFIRM WITH CIVIL ENGINEER'S SPECIFICATIONS.
7. MAXIMUM DISTANCE BETWEEN HANGERS SHALL BE AS PER NFPA-13 TABLE 6-2.2..
8. FIRE SPRINKLER SYSTEM TO BE HYDROSTATIC ALLY TESTED AT 200 PSI FOR 2 HRS MINIMUM.
9. HYDRAULIC CALCULATIONS AND PIPE SIZES ARE BASED ON THE PRELIMINARY FLOW TEST: STATIC PRESSURE: 50 PSI; RESIDUAL PRESSURE: 40 PSI AT 1200 GPM WATER FLOW. CONTRACTOR SHALL CONFIRM WATER FLOW TEST DATA BEFORE COMMENCING ANY WORK AND MAY VARY PIPE SIZES IN ACCORDANCE WITH ACTUAL FLOW TEST OBTAINED.
10. BEFORE COMMENCING ANY WORK CONTRACTOR SHALL COORDINATE EXACT LOCATION AND POINT OF CONNECTION TO STREET WATER MAIN. REFER TO CIVIL DRAWINGS AND OBTAIN APPROVAL FROM FIRE MARSHALL OFFICE AND LOCAL AUTHORITIES HAVING JURISDICTION.
11. BACK FLOW PREVENTOR TO THE BUILDING SHALL BE EXECUTED BY A FLORIDA STATE FIRE SPRINKLER INSTALLATION INCLUDING UNDERGROUND SUPPLY PIPING FROM CERTIFIED FIRE PROTECTION CONTRACTOR.
12. PROVIDE SPARE SPRINKLER HEADS IN BOX AS PER NFPA-13 PARAGRAPH (3-2.9) IN ACCESSIBLE LOCATION IN MAINTENANCE OFFICE.
13. CONTRACTOR TO SUBMIT SHOP DRAWINGS TO A/E OFFICES FOR APPROVAL.
14. SINCE THIS BUILDING IS LOCATED NEAR TO OCEAN ALL EXPOSED PIPING, HANGERS SHALL CORROSION PROTECTED WITH A PROTECTIVE COATING AS HOT DIP GALVANIC LAYER.
15. CONTRACTOR TO PROVIDE SPRINKLER SHOP DRAWINGS TO BE APPROVED BY AHJ AS A SEPARATE PERMIT.


FIRE SPRINKLER HEAD SCHEDULE							
SYMBOL	DESCRIPTION	SIZE	"K"	TEMP	FINISH	COVERAGE	REMARK
	PENDANT SPRINKLER HEAD	1/2"	5.6	155°F	WHITE	15'x15' LIGHT HAZARD	TYCO SERIES LFII DROP CEILING AREA, RESIDENTIAL QUICK RESPONSE (CONCEALED)
	SIDE WALL SPRINKLER HEAD	1/2"	5.6	165°F	WHITE	16'x20' MAXIMUM 23 GPM @ 30 PSI	SEMI RECESSED, QUICK RESPONSE RESIDENTIAL.
	UPRIGHT SPRINKLER HEAD	1/2"	5.6	165°F	BRONZE	15'x15' LIGHT HAZARD AREAS 13'x10' ORDINARY HAZARD AREAS	TYCO SERIES TY-FRB AREAS WITHOUT DROP CEILING, QUICK RESPONSE
	SEMI-RECESSED PENDANT SPRINKLER HEAD	1/2"	5.6	165°F	BRONZE	15'x15' LIGHT HAZARD AREAS 13'x10' ORDINARY HAZARD AREAS	TYCO SERIES TY-FRB SEMI RECESSED, QUICK RESPONSE
	WINDOW SPRINKLER	1/2"	5.6	165°F	BRONZE	8' MAXIMUM DISTANCE BETWEEN SPRINKLERS.	FINISH TO BE SLECTED BY ARCHITECT
	DRYPENDANT SPRINKLER HEAD	1/2"	5.6	155°F	BRONZE	13'x10' ORDINARY HAZARD	TYCO SERIES DS-1 AREAS WITHOUT DROP CEILING, QUICK RESPONSE

NOTE: FOR STYLE & COLOR REFER TO ARCHITECTURAL DWGS.

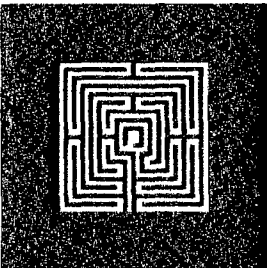

ALLAN T. SHULMAN ARCHITECT, P.A.
(AR 0012763)

100 NE 38TH STREET, NO. 2 MIAMI, FL 33137
TEL.: 305.438.0609 FAX: 305.438.0170

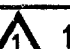REVISIONS	
	10.08.09
CWB	COMMENTS

REVISIONS	

SOHO BEACH HOUSE

4385 COLLINS AVENUE, MIAMI BEACH, FL, 33140

JOB NO. 05035
















1ST & 7TH FLOOR KITCHENS

CONSTRUCTION DOCUMENTS

F-3.0
09.15.2009



VIDAL & ASSOCIATES INC.
CONSULTING ENGRS/FFRS
2234 N.E. 2ND AVENUE
MIAMI, FL 33137
HENRY VIDAL P.E., PE# 56664
CERTIFICATION OF AUTHORIZATION #8858
PHONE: (305) 571-1880 FAX: (305) 571-1881
E-MAIL: VIDAL1961@AOL.COM


FIRE PROTECTION LEGEND	
SYMBOL	DESCRIPTION
	FIRE PROTECTION PIPE
	CHECK VALVE
	CAPPED PIPE
	GATE VALVE
	GATE VALVE IN VERTICAL
	PIPE DOWN
	PIPE UP
	FIRE DEPARTMENT CONNECTION
	FLOW SWITCH
	POST INDICATOR VALVE WITH TAMPER SWITCH
	TAMPER SWITCH
	BACK FLOW PREVENTER
	HYDRAULIC CALC. REFERENCE POINT
	UNDERGROUND
	ABOVE
	CEILING
	TYPICAL

SPECIFICATIONS:

- A FULL COVERAGE FIRE SPRINKLER SYSTEM SHALL BE INSTALLED IN ACCORDANCE WITH THE REQUIREMENTS OF NFPA13, FLORIDA BUILDING CODE & UNDERWRITERS INSURANCE COMPANY.
- ALL SPRINKLER SYSTEM EQUIPMENT AND DEVICES SHALL BE LISTED BY FM & UL FOR SERVICE INTENDED. FOR SPRINKLER HEADS CHARACTERISTICS REFER TO FIRE SPRINKLER SCHEDULE THIS SHEET.
- CONTRACTOR TO OBTAIN APPROVAL FROM OWNER REP. FOR SPRINKLER HEAD STYLE TO BE INSTALLED IN COVERED AREAS PRIOR TO INSTALLATION. SEE SCHEDULE.
- ARRANGEMENT AND LOCATION OF SPRINKLER HEAD & EQUIPMENT SHALL BE AS INDICATED ON DRAWINGS AND SUBJECT TO CONTRACTOR SUBMITTALS.
- DETAILED DRAWINGS OF PROPOSED DEPARTURES DUE TO ACTUAL FIELD CONDITIONS OR OTHER CAUSES SHALL BE SUBMITTED TO THE ARCHITECT/ENGINEER FOR APPROVAL.
- PIPING: INTERIOR ABOVE GROUND SHALL BE ASTM A 53-73 OR A-106 STANDARD WEIGHT, SCHEDULE 10 BLACK STEEL PIPE WITH ROLLED MECHANICAL COUPLINGS OR XL BLACK STEEL PIPE AS PER NFPA 13 AND UL APPROVED FOR FIRE SPRINKLER SERVICE. UNDERGROUND PIPING: SHALL BE DUCTILE IRON TO MEET AWWAC-900 STANDARDS OR PVC PRESSURE PIPES CLASS 150DR-18 AS MFG. BY J-M BLUE BRUTE. CONFIRM WITH CIVIL ENGINEER'S SPECIFICATIONS.
- MAXIMUM DISTANCE BETWEEN HANGERS SHALL BE AS PER NFPA-13 TABLE 6-2.2..
- FIRE SPRINKLER SYSTEM TO BE HYDROSTATIC ALLY TESTED AT 200 PSI FOR 2 HRS MINIMUM.
- HYDRAULIC CALCULATIONS AND PIPE SIZES ARE BASED ON THE PRELIMINARY FLOW TEST: STATIC PRESSURE: 50 PSI; RESIDUAL PRESSURE: 40 PSI AT 1200 GPM WATER FLOW. CONTRACTOR SHALL CONFIRM WATER FLOW TEST DATA BEFORE COMMENCING ANY WORK AND MAY VARY PIPE SIZES IN ACCORDANCE WITH ACTUAL FLOW TEST OBTAINED.
- BEFORE COMMENCING ANY WORK CONTRACTOR SHALL COORDINATE EXACT LOCATION AND POINT OF CONNECTION TO STREET WATER MAIN. REFER TO CIVIL DRAWINGS AND OBTAIN APPROVAL FROM FIRE MARSHALL OFFICE AND LOCAL AUTHORITIES HAVING JURISDICTION.
- BACK FLOW PREVENTOR TO THE BUILDING SHALL BE EXECUTED BY A FLORIDA STATE FIRE SPRINKLER INSTALLATION INCLUDING UNDERGROUND SUPPLY PIPING FROM CERTIFIED FIRE PROTECTION CONTRACTOR.
- PROVIDE SPARE SPRINKLER HEADS IN BOX AS PER NFPA-13 PARAGRAPH (3-2.9) IN ACCESSIBLE LOCATION IN MAINTENANCE OFFICE.
- CONTRACTOR TO SUBMIT SHOP DRAWINGS TO A/E OFFICES FOR APPROVAL.
- SINCE THIS BUILDING IS LOCATED NEAR TO OCEAN ALL EXPOSED PIPING; HANGERS SHALL CORROSION PROTECTED WITH A PROTECTIVE COATING AS HOT DIP GALVANIC LAYER.
- CONTRACTOR TO PROVIDE SPRINKLER SHOP DRAWINGS TO BE APPROVED BY AHJ AS A SEPARATE PERMIT.

FIRE SPRINKLER HEAD SCHEDULE								
SYMBOL	DESCRIPTION	SIZE	"K"	TEMP	FINISH	COVERAGE	MFG.-MODEL	REMARK
⊙	PENDANT SPRINKLER HEAD	½"	5.6	155°F	WHITE	15'x15' LIGHT HAZARD	TYCO SERIES LFII	DROP CEILING AREA, RESIDENTIAL QUICK RESPONSE (CONCEALED)
▷	SIDE WALL SPRINKLER HEAD	½"	5.6	165°F	WHITE	16'x20" MAXIMUM 23 GPM @ 30 PSI	TYCO SERIES LFII	SEMI RECESSED, QUICK RESPONSE RESIDENTIAL
○	UPRIGHT SPRINKLER HEAD	½"	5.6	165°F	BRONZE	15'x15' LIGHT HAZARD AREAS 13'x10' ORDINARY HAZARD AREAS	TYCO SERIES TY-FRB	AREAS WITHOUT DROP CEILING, QUICK RESPONSE
◐	SEMI-RECESSED PENDANT SPRINKLER HEAD	½"	5.6	165°F	BRONZE	15'x15' LIGHT HAZARD AREAS 13'x10' ORDINARY HAZARD AREAS	TYCO SERIES TY-FRB	SEMI RECESSED, QUICK RESPONSE
▷	WINDOW SPRINKLER	½"	5.6	165°F	BRONZE	8' MAXIMUM DISTANCE BETWEEN SPRINKLERS.	TYCO SERIES WS	FINISH TO BE SELECTED BY ARCHITECT
⊙	DRYPENDANT SPRINKLER HEAD	½"	5.6	155°F	BRONZE	13'x10' ORDINARY HAZARD	TYCO SERIES DS-1	AREAS WITHOUT DROP CEILING, QUICK RESPONSE

NOTE: FOR STYLE & COLOR REFER TO ARCHITECTURAL DWGS.

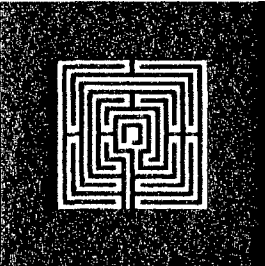

ALLAN T. SHULMAN ARCHITECT, P.A.
(AR 0012763)

100 NE 38TH STREET, NO. 2 MIAMI, FL 33137
TEL: 305.438.0609 FAX: 305.438.0170

REVISIONS

REVISIONS

SOHO BEACH HOUSE

4385 COLLINS AVENUE, MIAMI BEACH, FL, 33140

JOB NO. 05035

1ST & 7TH FLOOR KITCHENS

CONSTRUCTION DOCUMENTS



VIDAL & ASSOCIATES INC.
CONSULTING ENGINEERS
2234 N.E. 2ND AVENUE
MIAMI, FL 33137
HENRY VIDAL P.E., PE# 54004
CERTIFICATION OF AUTHORIZATION #008
PHONE: (305) 571-1880 FAX: (305) 571-1881
E-MAIL: VIDAL1961@AOL.COM

F-3.0


09.15.2009

ITEM	QTY	DESCRIPTION	MANUFACTURER	MODEL NUMBER	EQUIPMENT REMARKS	PROVIDED BY		EXISTING EQUIPMENT			ELECTRICAL					WATER		DRAIN		GAS		COOLING WATER		UTILITY REMARKS	ITEM
						BARING	OTHERS	REMAIN	RE-LOCATE	REMOVE	VOLTS	PHASE	AMPS	CONN TYPE	NEMA NUMBER	HOT	COLD	IN-DIRECT	DIRECT	SIZE	MBTU/HOUR	SUPPLY	RETURN		
© Copyright 2009 Baring Industries																									
1-001	1	MARBLE TOP PICK-UP COUNTER	FLORIDA STAINLESS FABRICATORS	CUSTOM	MARBLE TOP BY OTHERS; SEE SHOP DWG	X																		EC TO CONNECT POWER TO RECEPTACLES IN EQUIPMENT DEDICATED CIRCUIT W/ISOLATED GROUND; EC TO CONNECT POWER TO RECEPTACLES IN EQUIPMENT REFRIGERATION CONNECTED TO 1-208	1-001
	2	5-20R GFCI DUPLEX RECEPTACLE			CONVENIENCE																				
	2	5-20R GFCI DUPLEX RECEPTACLE			F/1-003																				
	2	2-DOOR REFRIGERATED BASE																							
	2	HEATED PLATE CABINET			W/SLIDING BI-PASS DOORS																				
	2	CATEGORY-5 DATA PORT			F/1-003																				
1-001A	1	KNEE WALL	GENERAL CONTRACTOR	CUSTOM			X																	1-001A	
1-001B	2	WASTE CONTAINER	RUBBERMAID	2957		X		X																1-001B	
1-002		SPARE																						1-002	
1-003	7	POS SYSTEM PRINTER					X				120	1	4	C/P	5-15P								REQUIRES EMPTY JB/CONDUIT F/CATEGORY-5 DATA INTERFACE; EC TO VERIFY UTILITY & CONNECTION REQUIREMENTS 1,200 CFM EXHAUST; LIGHTING ON SAME POWER CIRCUIT AS 1-016 SERVES 1-004 & 1-016	1-003	
1-004	1	EXHAUST HOOD	HALTON COMPANY	KVE	SEE SHOP DWG	X					120	1	2.1	JB										1-004	
1-005	1	FIRE SUPPRESSION SYSTEM	ANSUL	R-102	WALL MTD W/TOP OF CABINET AGAINST FINISHED CLG; SEE HALTON SHOP DWG	X																		1-005	
1-005A	1	REMOTE PULL STATION	ANSUL	4835	SURFACE MTD @ 48" AFF	X																	EC TO VERIFY LOCATION W/LOCAL FIRE OFFICIAL PRIOR TO ROUGH-IN	1-005A	
1-006	8	PENDANT-TYPE HEAT LAMP	MERCO/SAVORY	775-C	W/CLEAR BULB; CLG HUNG W/BOTTOM OF SHADE @ 18" ABOVE CTR TOP	X					120	1	2.1	DIRECT										1-006	
1-007	5	HAND SINK	ADVANCE TABCO	7-PS-81	W/K-175 ELECTRONIC FAUCET, SOAP & TOWEL DISPENSER; WALL MTD W/TOP @ 34" AFF	X					120	1	1	C/P	5-15P	1/2"	1/2"		1-1/2"				P-TRAP PROVIDED BY BARING/INSTALLED BY PC	1-007	
1-008		SPARE																						1-008	
1-009	1	COOKING SUITE	ELECTROLUX PROFESSIONAL	CUSTOM	SEE SHOP DWG	X					120/208	3	156	DIRECT			1/2"	(2) 2"		1-1/4"	230.4		PRE-WIRED TO LOAD CENTER; GAS PRV PROVIDED BY BARING/INSTALLED BY PC	1-009	
1-010																								1-010	
1-011	3	COUNTER TOP CHEESE MELTER	EQUIPEX	SEM-60		X					208	1	14	C/P	6-15P								POWER CONNECTED TO RECEPTACLES IN 1-009	1-011	
1-012	1	MOBILE 48" WOOD-BURNING CHAR-BROILER	JADE RANGE	JLB-48		X																		1-012	
1-013	1	EXHAUST HOOD	HALTON COMPANY	KVE	SEE SHOP DWG	X					120	1	5.0	JB									4,048 CFM EXHAUST; LIGHTING ON SAME POWER CIRCUIT AS 1-015 & 1-046	1-013	
1-014		SPARE																						1-014	
1-015	1	EXHAUST HOOD	HALTON COMPANY	KVE	SEE SHOP DWG	X					120	1	2.9	JB									2,821 CFM EXHAUST; LIGHTING ON SAME POWER CIRCUIT AS 1-013 & 1-046	1-015	
1-016	1	EXHAUST HOOD	HALTON COMPANY	KVE	SEE SHOP DWG	X					120	1	2.1	JB									2,844 CFM EXHAUST; LIGHTING ON SAME POWER CIRCUIT AS 1-004	1-016	
1-017		SPARE																						1-017	
1-018	1	MARBLE TOP PREP COUNTER	FLORIDA STAINLESS FABRICATORS	CUSTOM	MARBLE TOP BY OTHERS; SEE SHOP DWG	X					120	1	(4) 16	JB									(4) 5-20R GFCI RECEPTACLES PRE-WIRED TO (1) JB	1-018	
	2	2-DOOR REFRIGERATED BASE														1/2"					REFRIGERATION CONNECTED TO 1-208				
	2	REFRIGERATED INGREDIENT RAIL (RAISED, ANGLED)															1"				REFRIGERATION CONNECTED TO 1-208				
1-019	1	WALL SHELF	FLORIDA STAINLESS FABRICATORS	CUSTOM	WALL MTD @ 60" AFF	X																		1-019	
1-020	1	MARBLE TOP BAKER'S TABLE	FLORIDA STAINLESS FABRICATORS	CUSTOM	W/2-TIER OVERSHELF SUPERSTRUCTURE; MARBLE TOP BY OTHERS; SEE SHOP DWG	X					120	1	16	DIRECT									EC TO CONNECT POWER TO RECEPTACLE IN EQUIPMENT	1-020	
1-020A	5	WALL SHELF	FLORIDA STAINLESS FABRICATORS	CUSTOM	WALL MTD @ 12", 24", 36", 48", & 60" AFF; SEE SHOP DWG	X																		1-020A	
1-020B	4	WALL SHELF	FLORIDA STAINLESS FABRICATORS	CUSTOM	WALL MTD @ 12", 24", 36", & 48" AFF; SEE SHOP DWG	X																		1-020B	
1-021	1	MOBILE 2-COMPARTMENT COOK & HOLD OVEN	ALTO-SHAAM	1000-TH-I		X					120	1	(2) 16.8	(2) C/P	5-20P									1-021	
1-022	1	MARBLE TOP PREP COUNTER	FLORIDA STAINLESS FABRICATORS	CUSTOM	W/UTILITY SERVICE CHASE & 2-TIER OVERSHELF SUPERSTRUCTURE; MARBLE TOP BY OTHERS; SEE SHOP DWG	X					120	1	(2) 16	JB									EC TO CONNECT POWER TO RECEPTACLES IN EQUIPMENT	1-022	
	1	2-SECTION PASS-THROUGH REFRIGERATED BASE																							
	1	REFRIGERATED INGREDIENT RAIL (RAISED, FLAT)																1/2"				REFRIGERATION CONNECTED TO 1-208			
1-023	1	WOOD FIRED PIZZA OVEN	MUGNAINI	140 PA		X					120	1	4	JB										1-023	
1-024	1	FOOD WARMER	HATCO	GRA-48D3	W/INFINITE CONTROL	X					120	1	13.3	PIGTAIL									PRE-WIRED TO JB IN MECHANICAL SPACE OF 1-022	1-024	
1-025		SPARE																						1-025	
1-026	1	MICROWAVE OVEN	PANASONIC	NE-1054		X					120	1	13.4	C/P	5-15P									1-026	
1-027	1	WALL SHELF	FLORIDA STAINLESS FABRICATORS	CUSTOM	WALL MTD @ 60" AFF	X																		1-027	
1-027A	1	WALL SHELF	FLORIDA STAINLESS FABRICATORS	CUSTOM	WALL MTD @ 60" AFF	X																		1-027A	
1-028	1	MARBLE TOP WORK COUNTER	FLORIDA STAINLESS FABRICATORS	CUSTOM	MARBLE TOP BY OTHERS; SEE SHOP DWG	X					120	1	(2) 16	JB									5-20R GFCI RECEPTACLES PRE-WIRED TO (1) JB	1-028	
	1	2-DOOR REFRIGERATED BASE														1/2"					REFRIGERATION CONNECTED TO 1-208				
	1	1-DOOR FREEZER BASE														1/2"					REFRIGERATION CONNECTED TO 1-208				
	1	REFRIGERATED INGREDIENT RAIL (RAISED, ANGLED)														1"					REFRIGERATION CONNECTED TO 1-208				
1-029	1	DIPPERWELL W/FAUCET	FISHER MANUFACTURING	3041		X											3/8"	1-1/2"						1-029	
1-030		SPARE																						1-030	
1-031	1	PASS-THROUGH SHELF & FRAME	FLORIDA STAINLESS FABRICATORS	CUSTOM	SEE SHOP DWG	X																		1-031	
1-032	1	MARBLE TOP WORK COUNTER W/DROP-IN SINK	FLORIDA STAINLESS FABRICATORS	CUSTOM	MARBLE TOP BY OTHERS; SEE SHOP DWG	X					120	1	(2) 16	DIRECT				1-1/2"					EC TO CONNECT POWER TO RECEPTACLES IN EQUIPMENT	1-032	
	2	2-DOOR REFRIGERATED BASE				X					120	1	2.1	JB				1/2"					REFRIGERATION CONNECTED TO 1-208		
1-032A	1	DECK PRE-RINSE SPRAY	T & S BRASS & BRASS																						

THIS DRAWING AND ITS CONTENTS ARE THE PROPERTY OF BARING INDUSTRIES, INC. REPRODUCTION, DISTRIBUTION, MODIFICATION IN ANY FORM OR ANY OTHER UNAUTHORIZED USE OF THIS DRAWING WITHOUT THE EXPRESSED WRITTEN CONSENT OF BARING INDUSTRIES, INC. IS PROHIBITED. COPYRIGHT © 2024 BARING INDUSTRIES, INC. ALL RIGHTS RESERVED.


GENERAL NOTES



1. REFER TO THE PROJECT ARCHITECTURAL, ELECTRICAL, INTERIOR DESIGN, MECHANICAL & PLUMBING DRAWINGS FOR ACTUAL CONSTRUCTION CONDITIONS & DETAILS.
2. ALL MANUFACTURER'S SHOP DRAWINGS & SPECIFICATION SHEETS ARE PROVIDED BY BARRING INDUSTRIES & ARE TO BE CONSIDERED A PART OF THESE DRAWINGS.
3. BUILDING WALLS & DIMENSIONS MATCH THE ARCHITECTURAL DRAWINGS PROVIDED TO BARRING UNLESS OTHERWISE NOTED.
4. THESE DRAWINGS INDICATE THE EXTENT OF WORK INCLUDED IN BARRING INDUSTRIES' SCOPE OF WORK & DO NOT NECESSARILY INCLUDE WORK REQUIRED FOR THE FULL PERFORMANCE & COMPLETION OF THE PROJECT CONTRACT DOCUMENTS.
5. UTILITY & CONNECTION REQUIREMENTS & BUILDING SPECIAL CONDITIONS FOR EQUIPMENT NOT PROVIDED BY BARRING INDUSTRIES ARE TO BE VERIFIED WITH THE PROVIDER BY THE APPLICABLE GENERAL, ELECTRICAL, MECHANICAL & PLUMBING CONTRACTORS.
6. DIMENSIONS ARE FROM SURFACE OF FINISHED WALLS, FLOORS, CEILING & COLUMN CENTERLINES. DIMENSIONS ARE TO BE VERIFIED BY ALL CONTRACTORS PRIOR TO COMMENCING ANY WORK.
7. DIMENSIONS ARE CLEAR FINISHED SURFACE TO FINISHED SURFACE UNLESS OTHERWISE NOTED.
8. ALL WORK SHALL BE EXECUTED IN ACCORDANCE WITH APPLICABLE FEDERAL, STATE & LOCAL CODES & ANY GOVERNING OFFICIAL HAVING JURISDICTION.
9. IN THE EVENT IT IS NECESSARY TO DEVIATE FROM BARRING'S DRAWINGS, THE CONTRACTOR SHALL NOTIFY BARRING INDUSTRIES IN WRITING PRIOR TO MAKING THE DEVIATION.
10. ELECTRICAL & MECHANICAL UTILITY SERVICES & CONNECTIONS HAVE BEEN LOCATED TO SUIT THE REQUIREMENTS OF THE FOODSERVICE EQUIPMENT.
11. CONNECTION REQUIREMENTS, CONNECTED LOAD & CONSUMPTION VALUES IN THE EQUIPMENT SCHEDULE ARE FOR (1) UNIT. TO DETERMINE THE TOTAL REQUIREMENTS, MULTIPLY BY THE QUANTITY IN THE EQUIPMENT SCHEDULE.
12. ROUGH-IN SIZES & LOCATIONS SHOWN IN THESE DRAWINGS ARE BASED ON INFORMATION PROVIDED TO BARRING. ACTUAL SIZES & LOCATIONS MAY VARY DEPENDING ON PREVAILING CODES, STANDARDS & SITE CONDITIONS.
13. QUARRY TILE FLOORS SHALL BE ACID WASHED & THOROUGHLY FLUSHED WITH CLEAN WATER PRIOR TO THE DELIVERY & SET-IN-PLACE OF ANY FOODSERVICE EQUIPMENT. DAMAGE CAUSED BY ACID BASED CLEANING AGENTS ARE NOT COVERED UNDER ANY WARRANTY.
14. THE GENERAL CONTRACTOR SHALL PROVIDE PENETRATIONS & OPENINGS SIZED TO FIT EQUIPMENT SHOWN IN THESE DRAWINGS.
15. PRIOR TO DELIVERY & SET-IN-PLACE OF ANY FOODSERVICE EQUIPMENT, THE GENERAL CONTRACTOR SHALL PROVIDE THE FOLLOWING MINIMUM BUILDING READINESS ITEMS:
 - A. CEILING GRID INSTALLED.
 - B. LIGHTING FIXTURES INSTALLED & WIRED.
 - C. HVAC DUCTWORK & FLEXWORK INSTALLED.
 - D. FLOOR ACID WASHED & BROOM SWEEP.
 - E. WALL FINISHES INSTALLED ON EXPOSED WALL SURFACES.
 - F. ELECTRICAL WIRING RUALED TO ROUGH-IN LOCATIONS SHOWN IN THESE DRAWINGS.
 - G. PLUMBING PIPING INSTALLED TO ROUGH-IN LOCATIONS SHOWN IN THESE DRAWINGS.
 - H. GAS, STEAM & WATER PIPING PRESSURE TESTED & FLUSHED FREE OF FOREIGN MATTER.

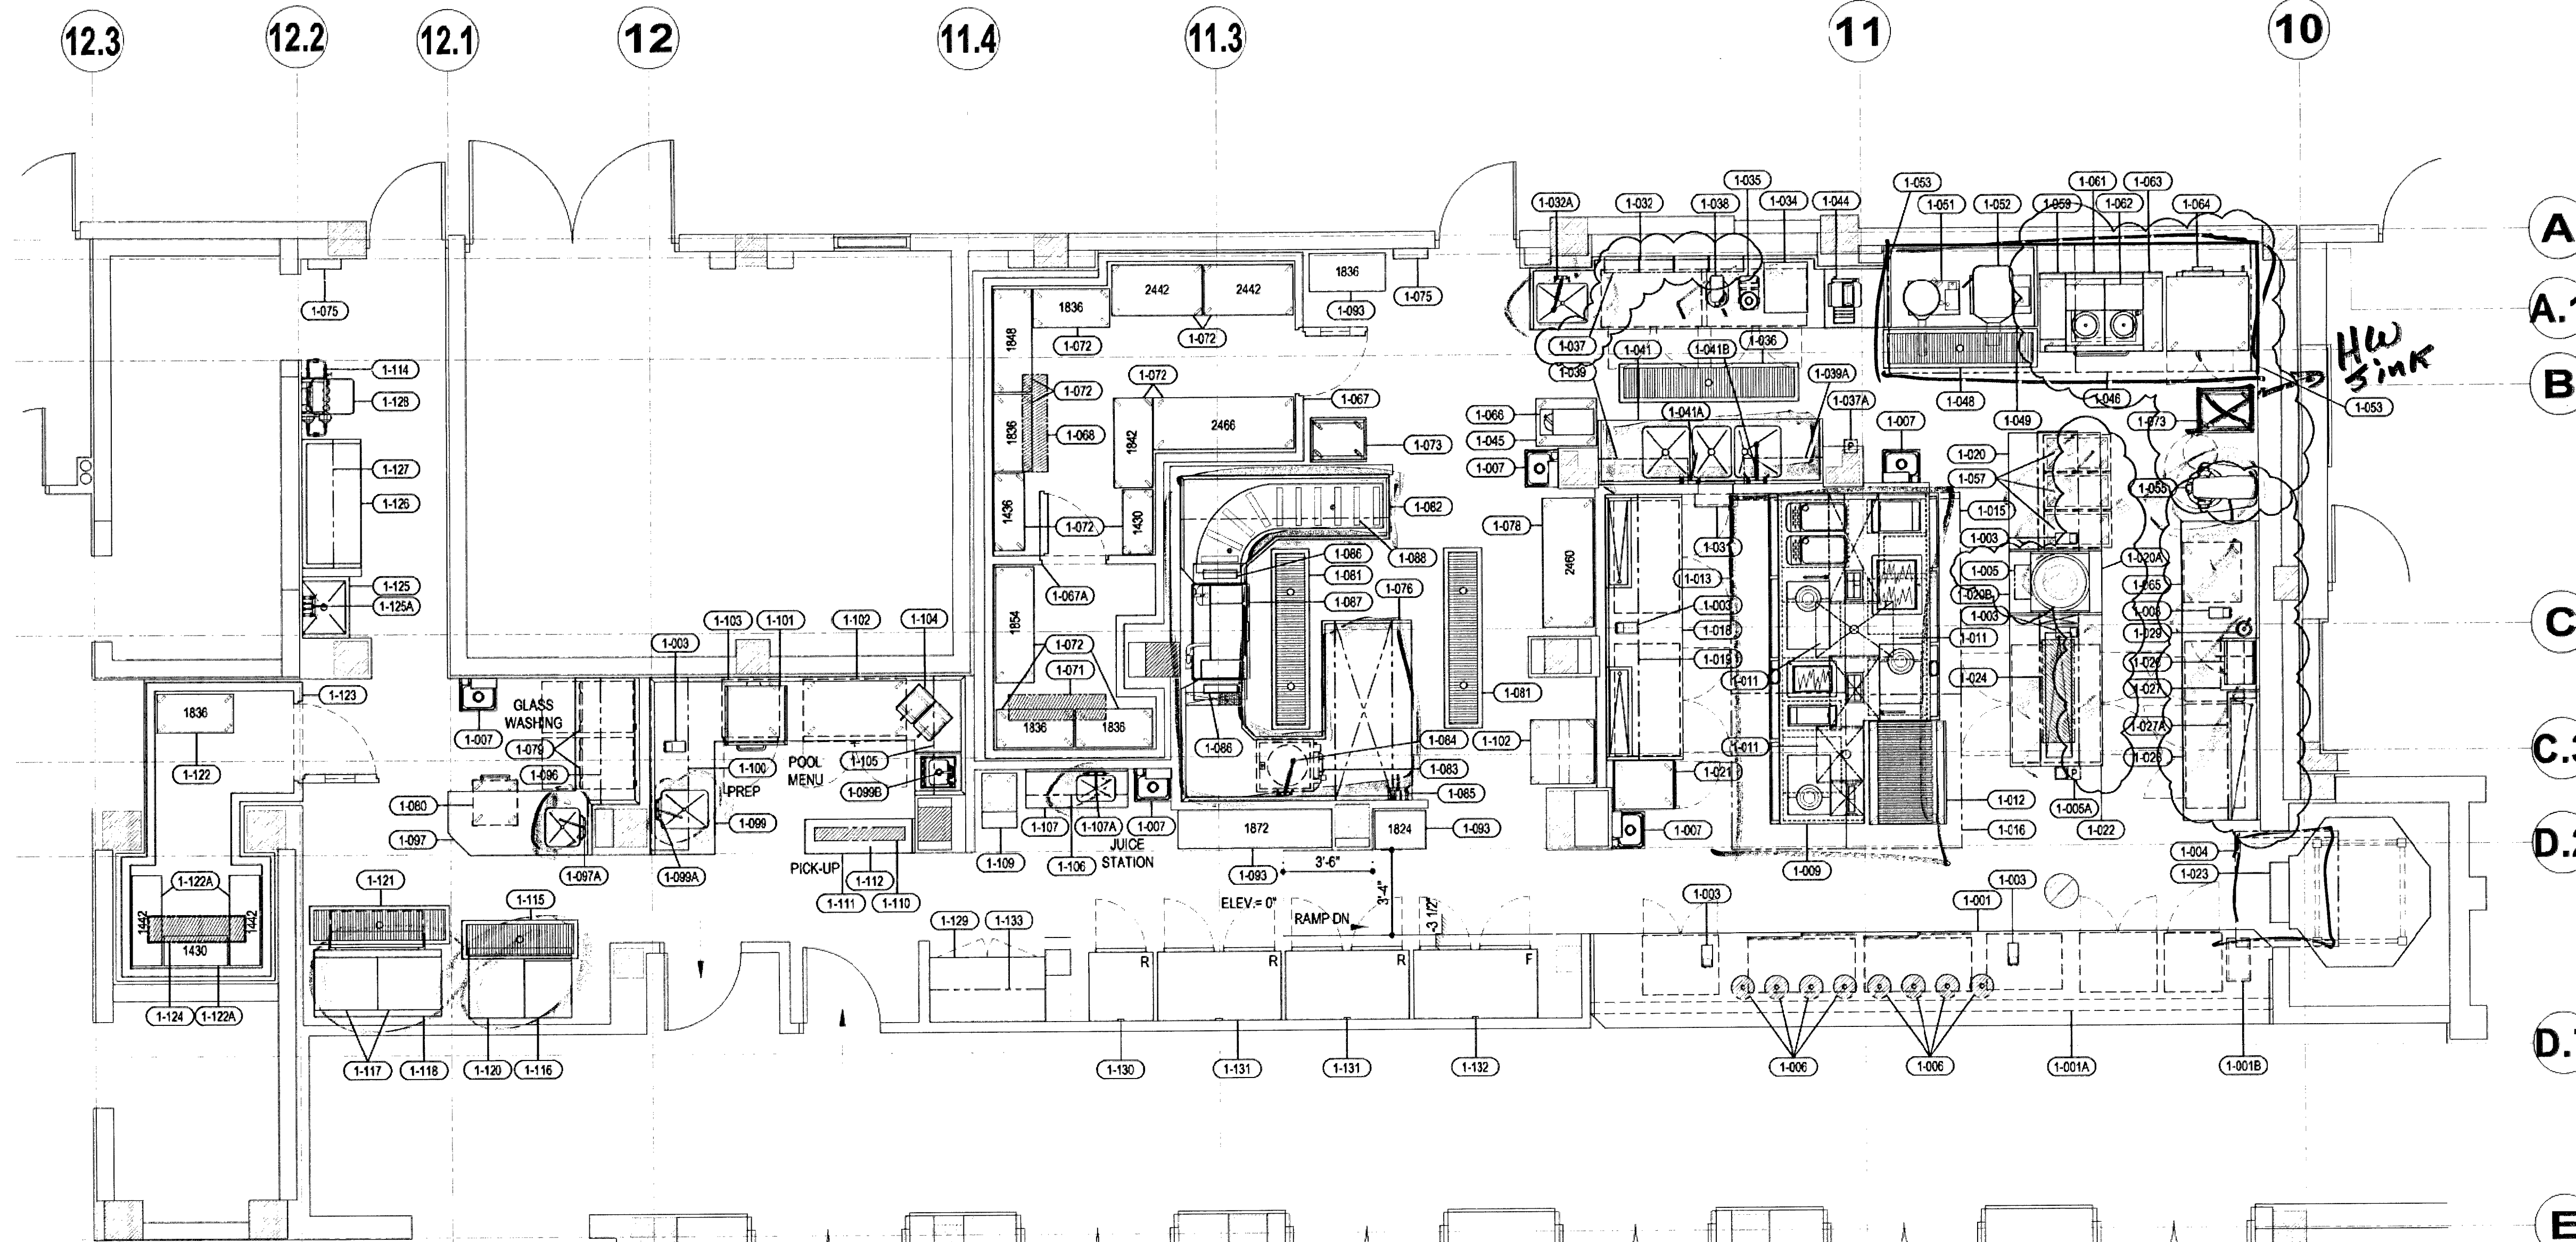

GENERAL NOTES

- REFER TO THE PROJECT ARCHITECTURAL, ELECTRICAL, INTERIOR DESIGN, MECHANICAL, & PLUMBING DRAWINGS FOR ACTUAL CONSTRUCTION CONDITIONS & DETAILS.
- MANUFACTURER'S SHOP DRAWINGS & SPECIFICATION SHEETS ARE PROVIDED BY BARRING INDUSTRIES & ARE TO BE CONSIDERED A PART OF THESE DRAWINGS.
- BUILDING WALLS & DIMENSIONS MATCH THE ARCHITECTURAL DRAWINGS PROVIDED TO BARRING UNLESS OTHERWISE NOTED.
- THESE DRAWINGS INDICATE THE EXTENT OF WORK INCLUDED IN BARRING INDUSTRIES' SCOPE OF WORK & DO NOT NECESSARILY INCLUDE WORK REQUIRED FOR THE FULL PERFORMANCE & COMPLETION OF THE PROJECT CONTRACT DOCUMENTS.
- UTILITY & CONNECTION REQUIREMENTS & BUILDING SPECIAL CONDITIONS FOR EQUIPMENT NOT PROVIDED BY BARRING INDUSTRIES ARE TO BE VERIFIED WITH THE PROVIDER BY THE APPLICABLE GENERAL ELECTRICAL, MECHANICAL, & PLUMBING CONTRACTORS.
- DIMENSIONS ARE FROM SURFACE OF FINISHED WALLS, FLOORS, CEILING & COLUMN CENTRELINES. DIMENSIONS ARE TO BE VERIFIED BY ALL CONTRACTORS PRIOR TO COMMENCING ANY WORK.
- DIMENSIONS ARE CLEAR FINISHED SURFACE TO FINISHED SURFACE UNLESS OTHERWISE NOTED.
- ALL WORK SHALL BE EXECUTED IN ACCORDANCE WITH APPLICABLE FEDERAL, STATE & LOCAL CODES & ANY GOVERNING OFFICIAL HAVING JURISDICTION.
- IN THE EVENT IT IS NECESSARY TO DEVIATE FROM BARRING'S DRAWINGS, THE CONTRACTOR SHALL NOTIFY BARRING INDUSTRIES IN WRITING PRIOR TO MAKING THE DEVIATION.
- ELECTRICAL & MECHANICAL UTILITY SERVICES & CONNECTIONS HAVE BEEN LOCATED TO SUIT THE REQUIREMENTS OF THE FOODSERVICE EQUIPMENT.
- CONNECTION REQUIREMENTS, CONNECTED LOAD & CONSUMPTION VALUES IN THE EQUIPMENT SCHEDULE ARE FOR (1) UNIT. TO DETERMINE THE TOTAL REQUIREMENTS, MULTIPLY BY THE QUANTITY IN THE EQUIPMENT SCHEDULE.
- ROUGH-IN SIZES & LOCATIONS SHOWN IN THESE DRAWINGS ARE BASED ON INFORMATION PROVIDED TO BARRING. ACTUAL SIZES & LOCATIONS MAY VARY DEPENDING ON PREVAILING CODES, STANDARDS & SITE CONDITIONS.
- QUARRY TILE FLOORS SHALL BE ACID WASHED & THOROUGHLY FLUSHED WITH CLEAN WATER PRIOR TO THE DELIVERY & SET-IN-PLACE OF ANY FOODSERVICE EQUIPMENT. DAMAGE CAUSED BY ACID BASED CLEANING/ETCHING AGENTS ARE NOT COVERED UNDER ANY WARRANTY.
- THE GENERAL CONTRACTOR SHALL PROVIDE PENETRATIONS & OPENINGS SIZED TO FIT EQUIPMENT SHOWN IN THESE DRAWINGS.
- PRIOR TO DELIVERY & SET-IN-PLACE OF ANY FOODSERVICE EQUIPMENT, THE GENERAL CONTRACTOR SHALL PROVIDE THE FOLLOWING MINIMUM BUILDING READINESS ITEMS:
 - CEILING GRID INSTALLED.
 - LIGHTING FIXTURES INSTALLED & WIRED.
 - HVAC DIFFUSERS & DUCT WORK INSTALLED.
 - FLOOR ACID WASHED & BROOM SWEPT.
 - WALL FINISHES INSTALLED ON EXPOSED WALL SURFACES.
 - ELECTRICAL WIRING PULLED TO ROUGH-IN LOCATIONS SHOWN IN THESE DRAWINGS.
 - PLUMBING PIPING INSTALLED TO ROUGH-IN LOCATIONS SHOWN IN THESE DRAWINGS.
 - GAS, STEAM & WATER PIPING PRESSURE TESTED & FLUSHED FREE OF FOREIGN MATTER.

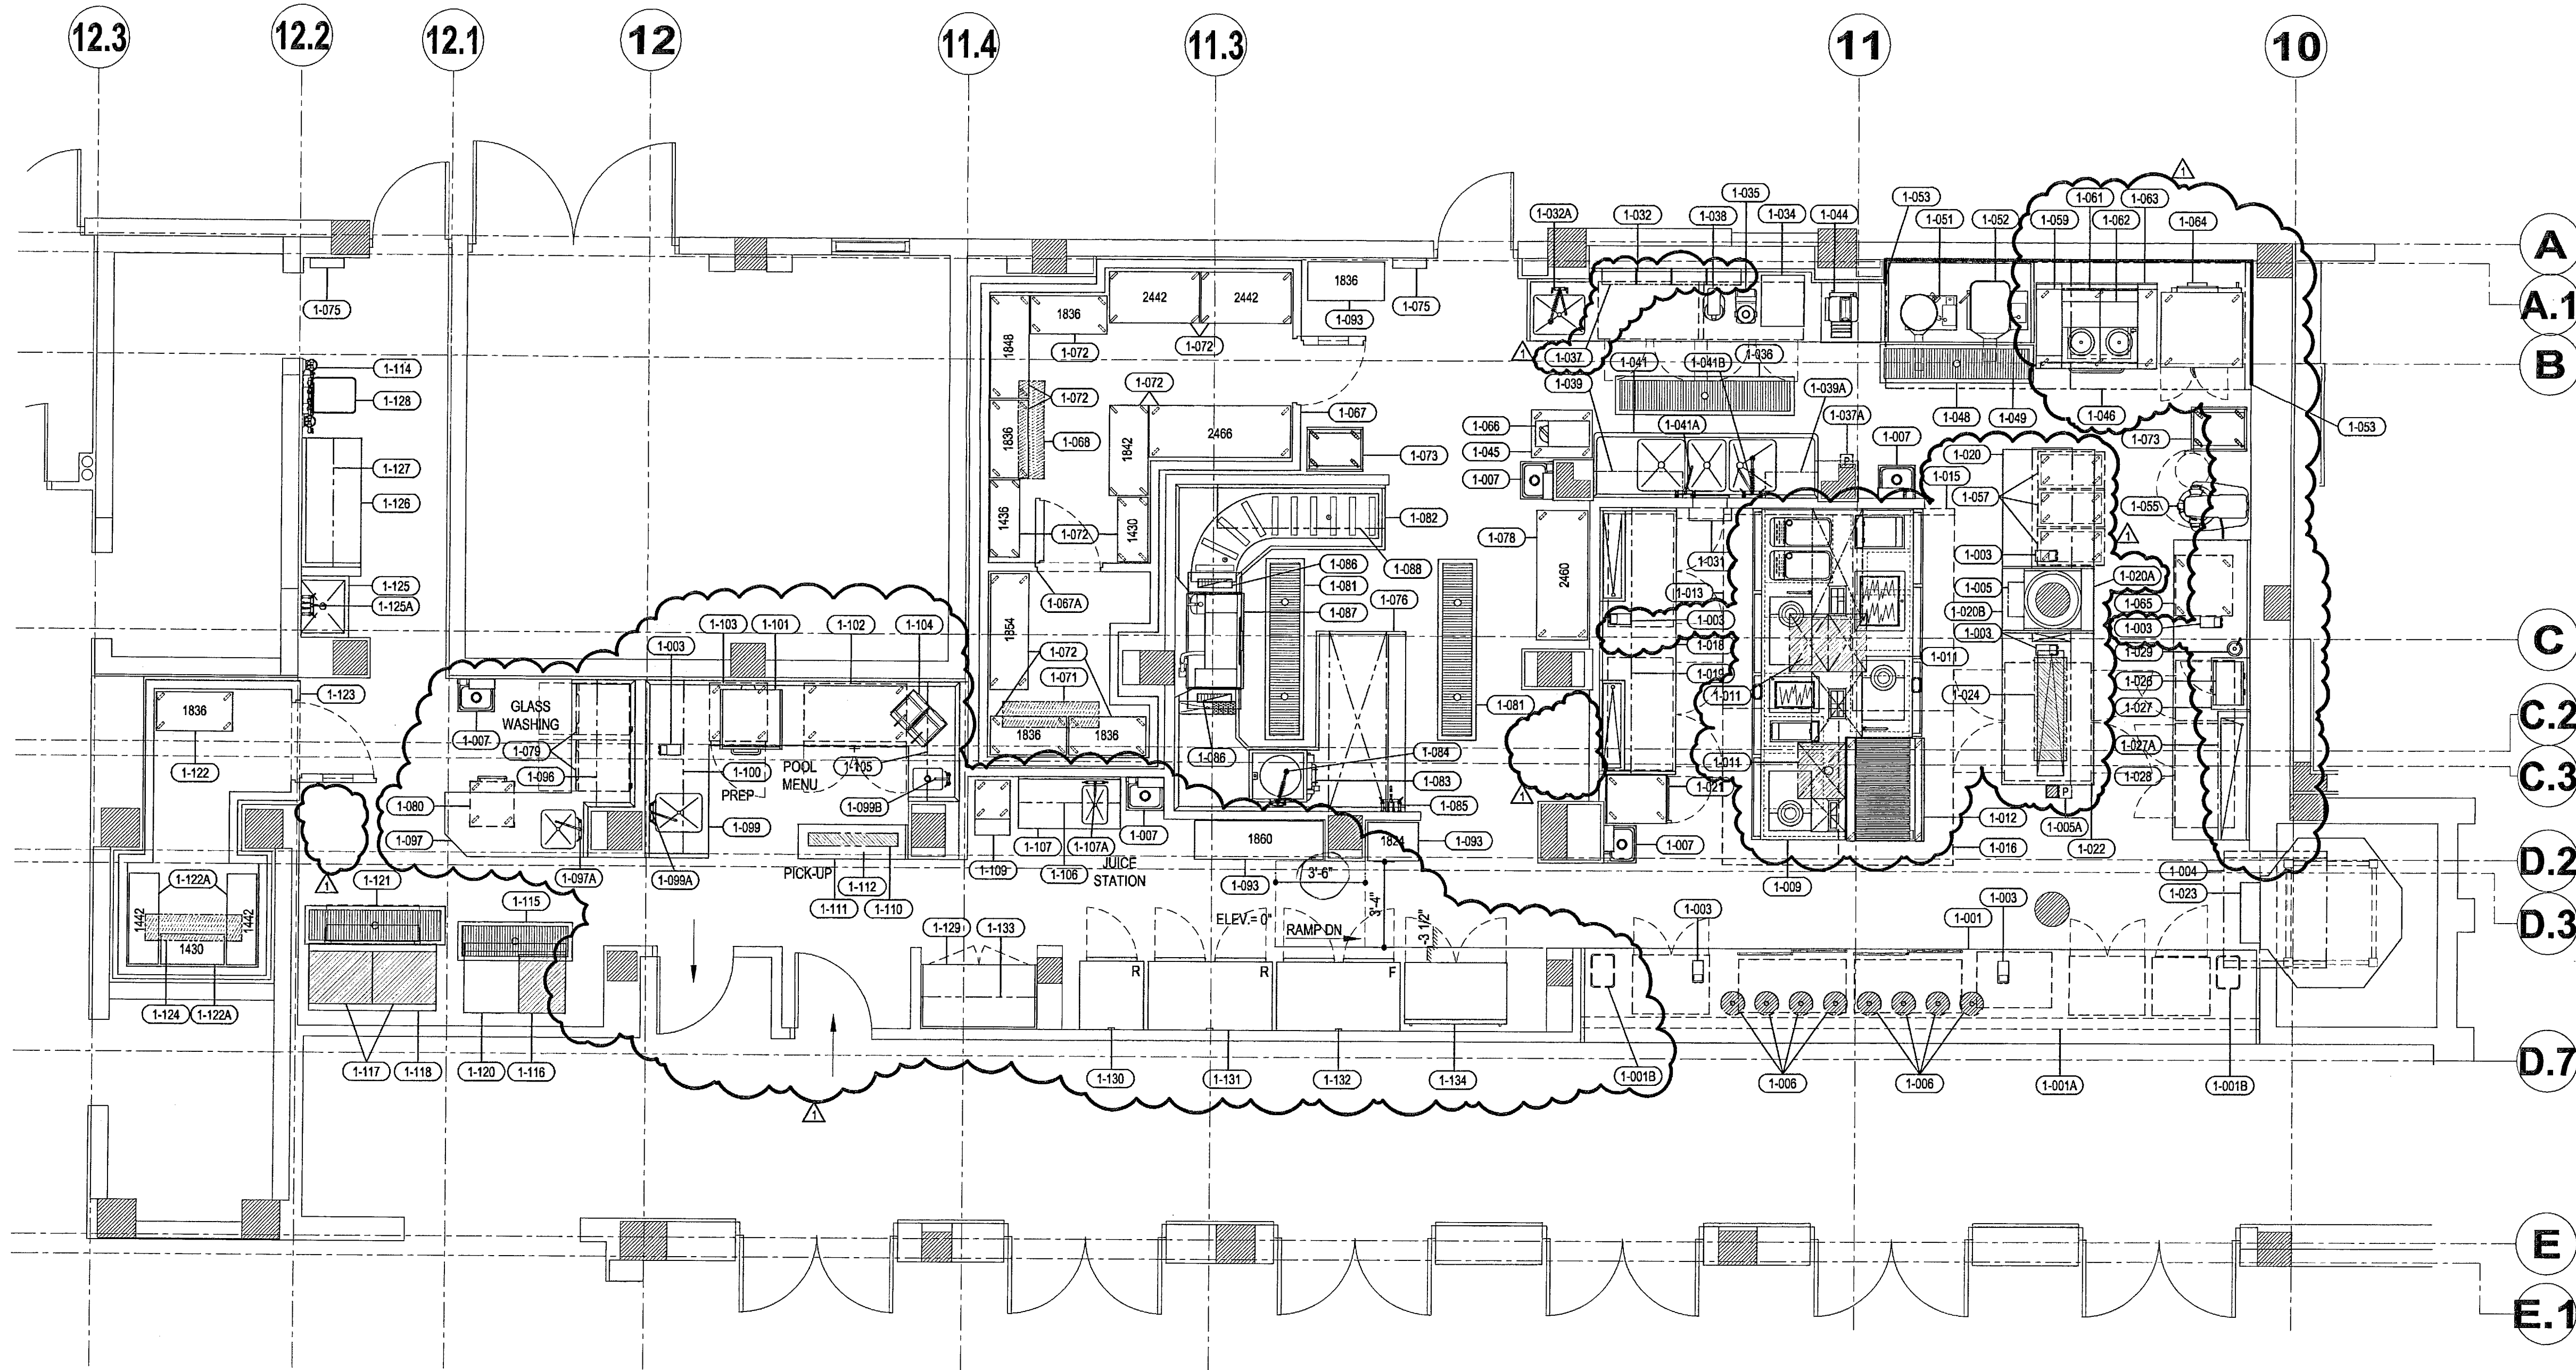

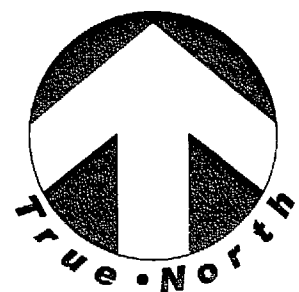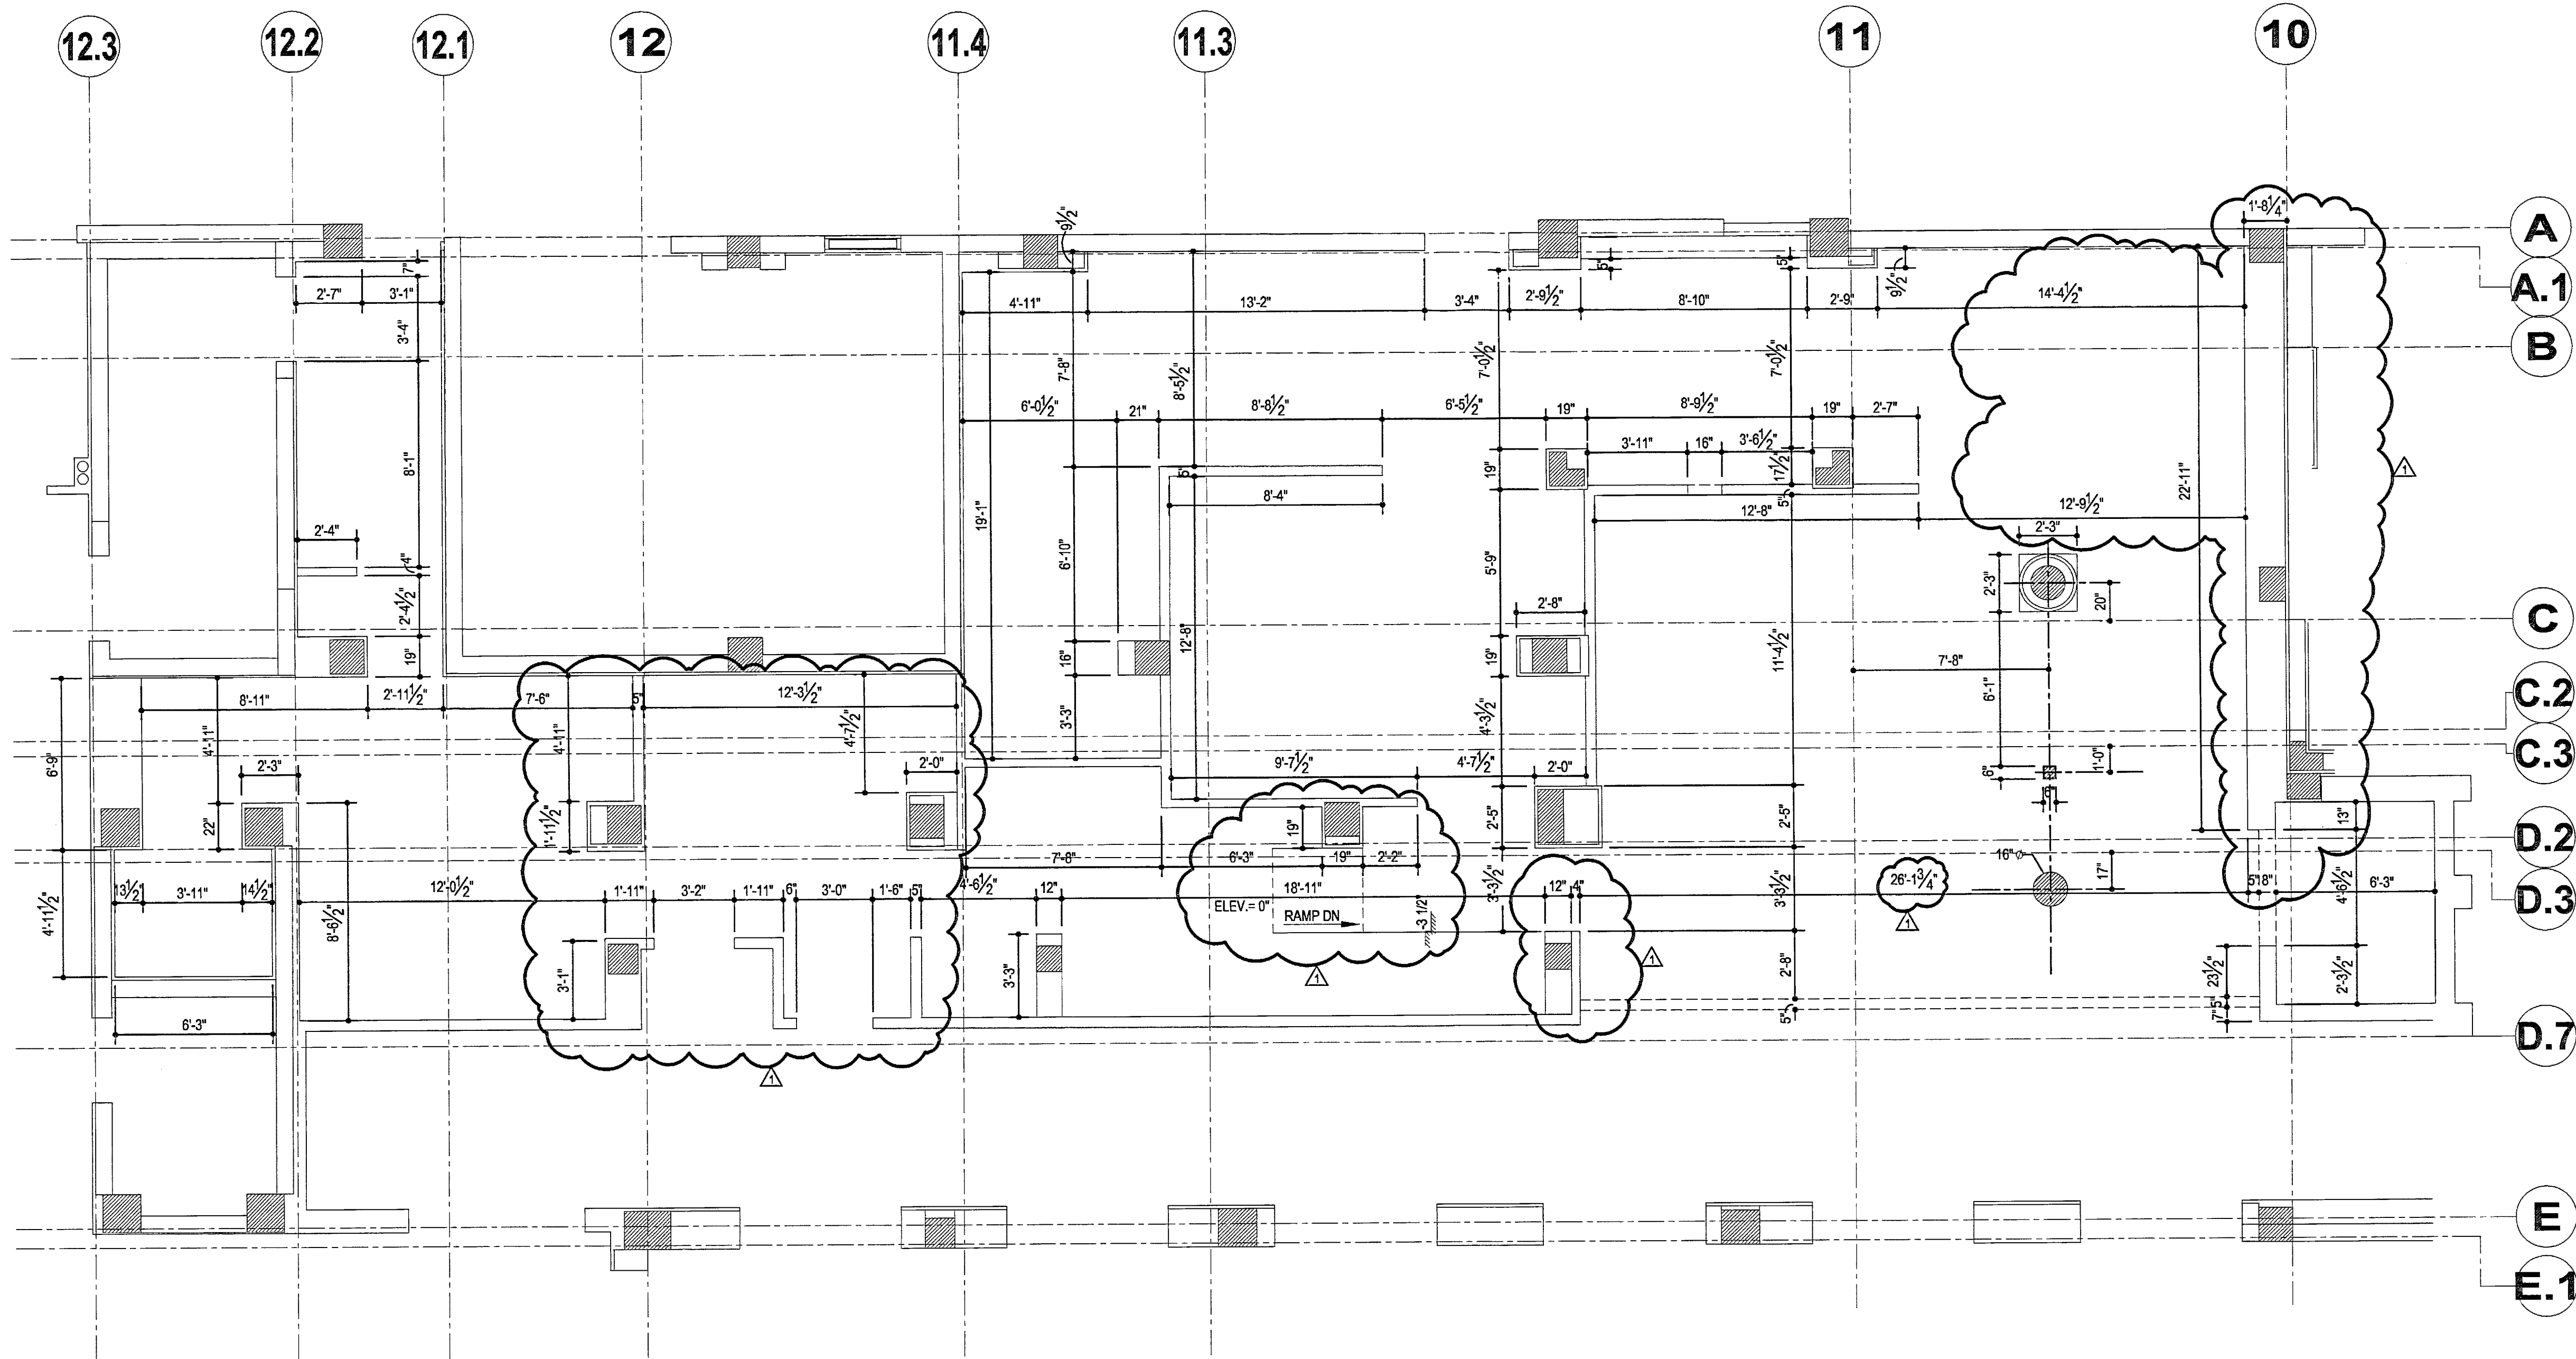

SOHO HOUSE

MIAMI BEACH, FLORIDA

FIRST FLOOR KITCHEN

ARCHITECTURAL PLAN

SHEET K1-4

PROJECT NUMBER 071152

BARING INDUSTRIES

A Division of Electrolux Professional, Inc.

http://www.baring.com • e-mail: sales@baring.com

Corporate Headquarters

Baring Industries
3340 S.W. 42ND STREET
Ft. Lauderdale, FL 33312 USA
TELEPHONE (954) 327-6700
FAX (954) 327-6781

Northeastern Regional Office

Baring Industries
3001 Lincoln Drive West, Suite J
Marlton, NJ 08053 USA
TELEPHONE (856) 988-9008
FAX (856) 988-0152

Midwestern Regional Office

Baring Industries
Suite 100
Nashville, TN 37203 USA
TELEPHONE (615) 252-8089
FAX (615) 252-8074

Midwestern Regional Office

Baring Industries
435 Eastman Lane South
Lombard, IL 60148 USA
TELEPHONE (630) 650-1110
FAX (630) 650-1120

Western Regional Office

Baring Industries
11411 Southern Highlands Parkway
Suite 220
Las Vegas, NV 89141 USA
TELEPHONE (702) 385-4415
FAX (702) 385-4417

PROJECT NAME

PROJECT LOCATION

AREA NAME


REVISION: BY: CK BY: DATE

1	ST	JM	08-26-2009
2			
3			
4			
5			

PROJ. MGR: FRANK MURPHY
COORDINATOR: PATRICIA TEPPER
TELEPHONE: 954-327-6720
DRAWN BY: ST
CHECKED BY: JM
DATE: 08-26-2009
SCALE: 1/4" = 1'-0"

SPECIAL CONDITIONS NOTES

- CONCRETE & MASONRY BASES & CURBS SHALL BE PROVIDED BY THE GENERAL CONTRACTOR & SHALL BE TROWEL SMOOTH & LEVEL +/- 1/8".
- WALL BACKING SUITABLE FOR SUPPORTING WALL-MOUNTED EQUIPMENT PROVIDED & INSTALLED BY THE GENERAL CONTRACTOR.
- SLEEVES PENETRATING ANY WALL, FLOOR OR ROOF SHALL BE PROVIDED & INSTALLED BY THE GENERAL CONTRACTOR IN ACCORDANCE WITH APPLICABLE CODES & GOVERNING OFFICIAL HAVING JURISDICTION.
- BEVERAGE CONDUIT RUNS SHOWN ARE SCHEMATIC, PROVIDER TO VERIFY ROUTING, MATERIAL, DIAMETER & PULL BOX REQUIREMENTS WITH BEVERAGE SYSTEM CONTRACTOR(S) PRIOR TO INSTALLING CONDUIT.
- DEPRESSIONS & FITS FOR WALK-IN BOXES SHALL BE TROWEL SMOOTH & LEVEL +/- 1/8".
- FINISHED FLOOR SURFACES UNDER ROLL-IN EQUIPMENT SHALL BE LEVEL +/- 1/8".
- WALL SURFACES AROUND RECESSED CONTROL PANELS SHALL BE LIST OPEN & UNFINISHED UNTIL THE CONTROL PANELS HAVE BEEN INSTALLED.
- UNLESS OTHERWISE NOTED IN THESE DRAWINGS, CURBS/RACKS/DRAINAGE FOR ROOF-MOUNTED EQUIPMENT SHALL BE PROVIDED & INSTALLED BY THE GENERAL CONTRACTOR IN ACCORDANCE WITH APPLICABLE CODES & ANY GOVERNING OFFICIAL HAVING JURISDICTION.
- UNLESS OTHERWISE NOTED IN THESE DRAWINGS BUILDING STRUCTURAL SUPPORT SUITABLE FOR SUPPORTING CEILING SUSPENDED EQUIPMENT SHALL BE PROVIDED & INSTALLED BY THE GENERAL CONTRACTOR IN ACCORDANCE WITH APPLICABLE CODES & ANY GOVERNING OFFICIAL HAVING JURISDICTION.

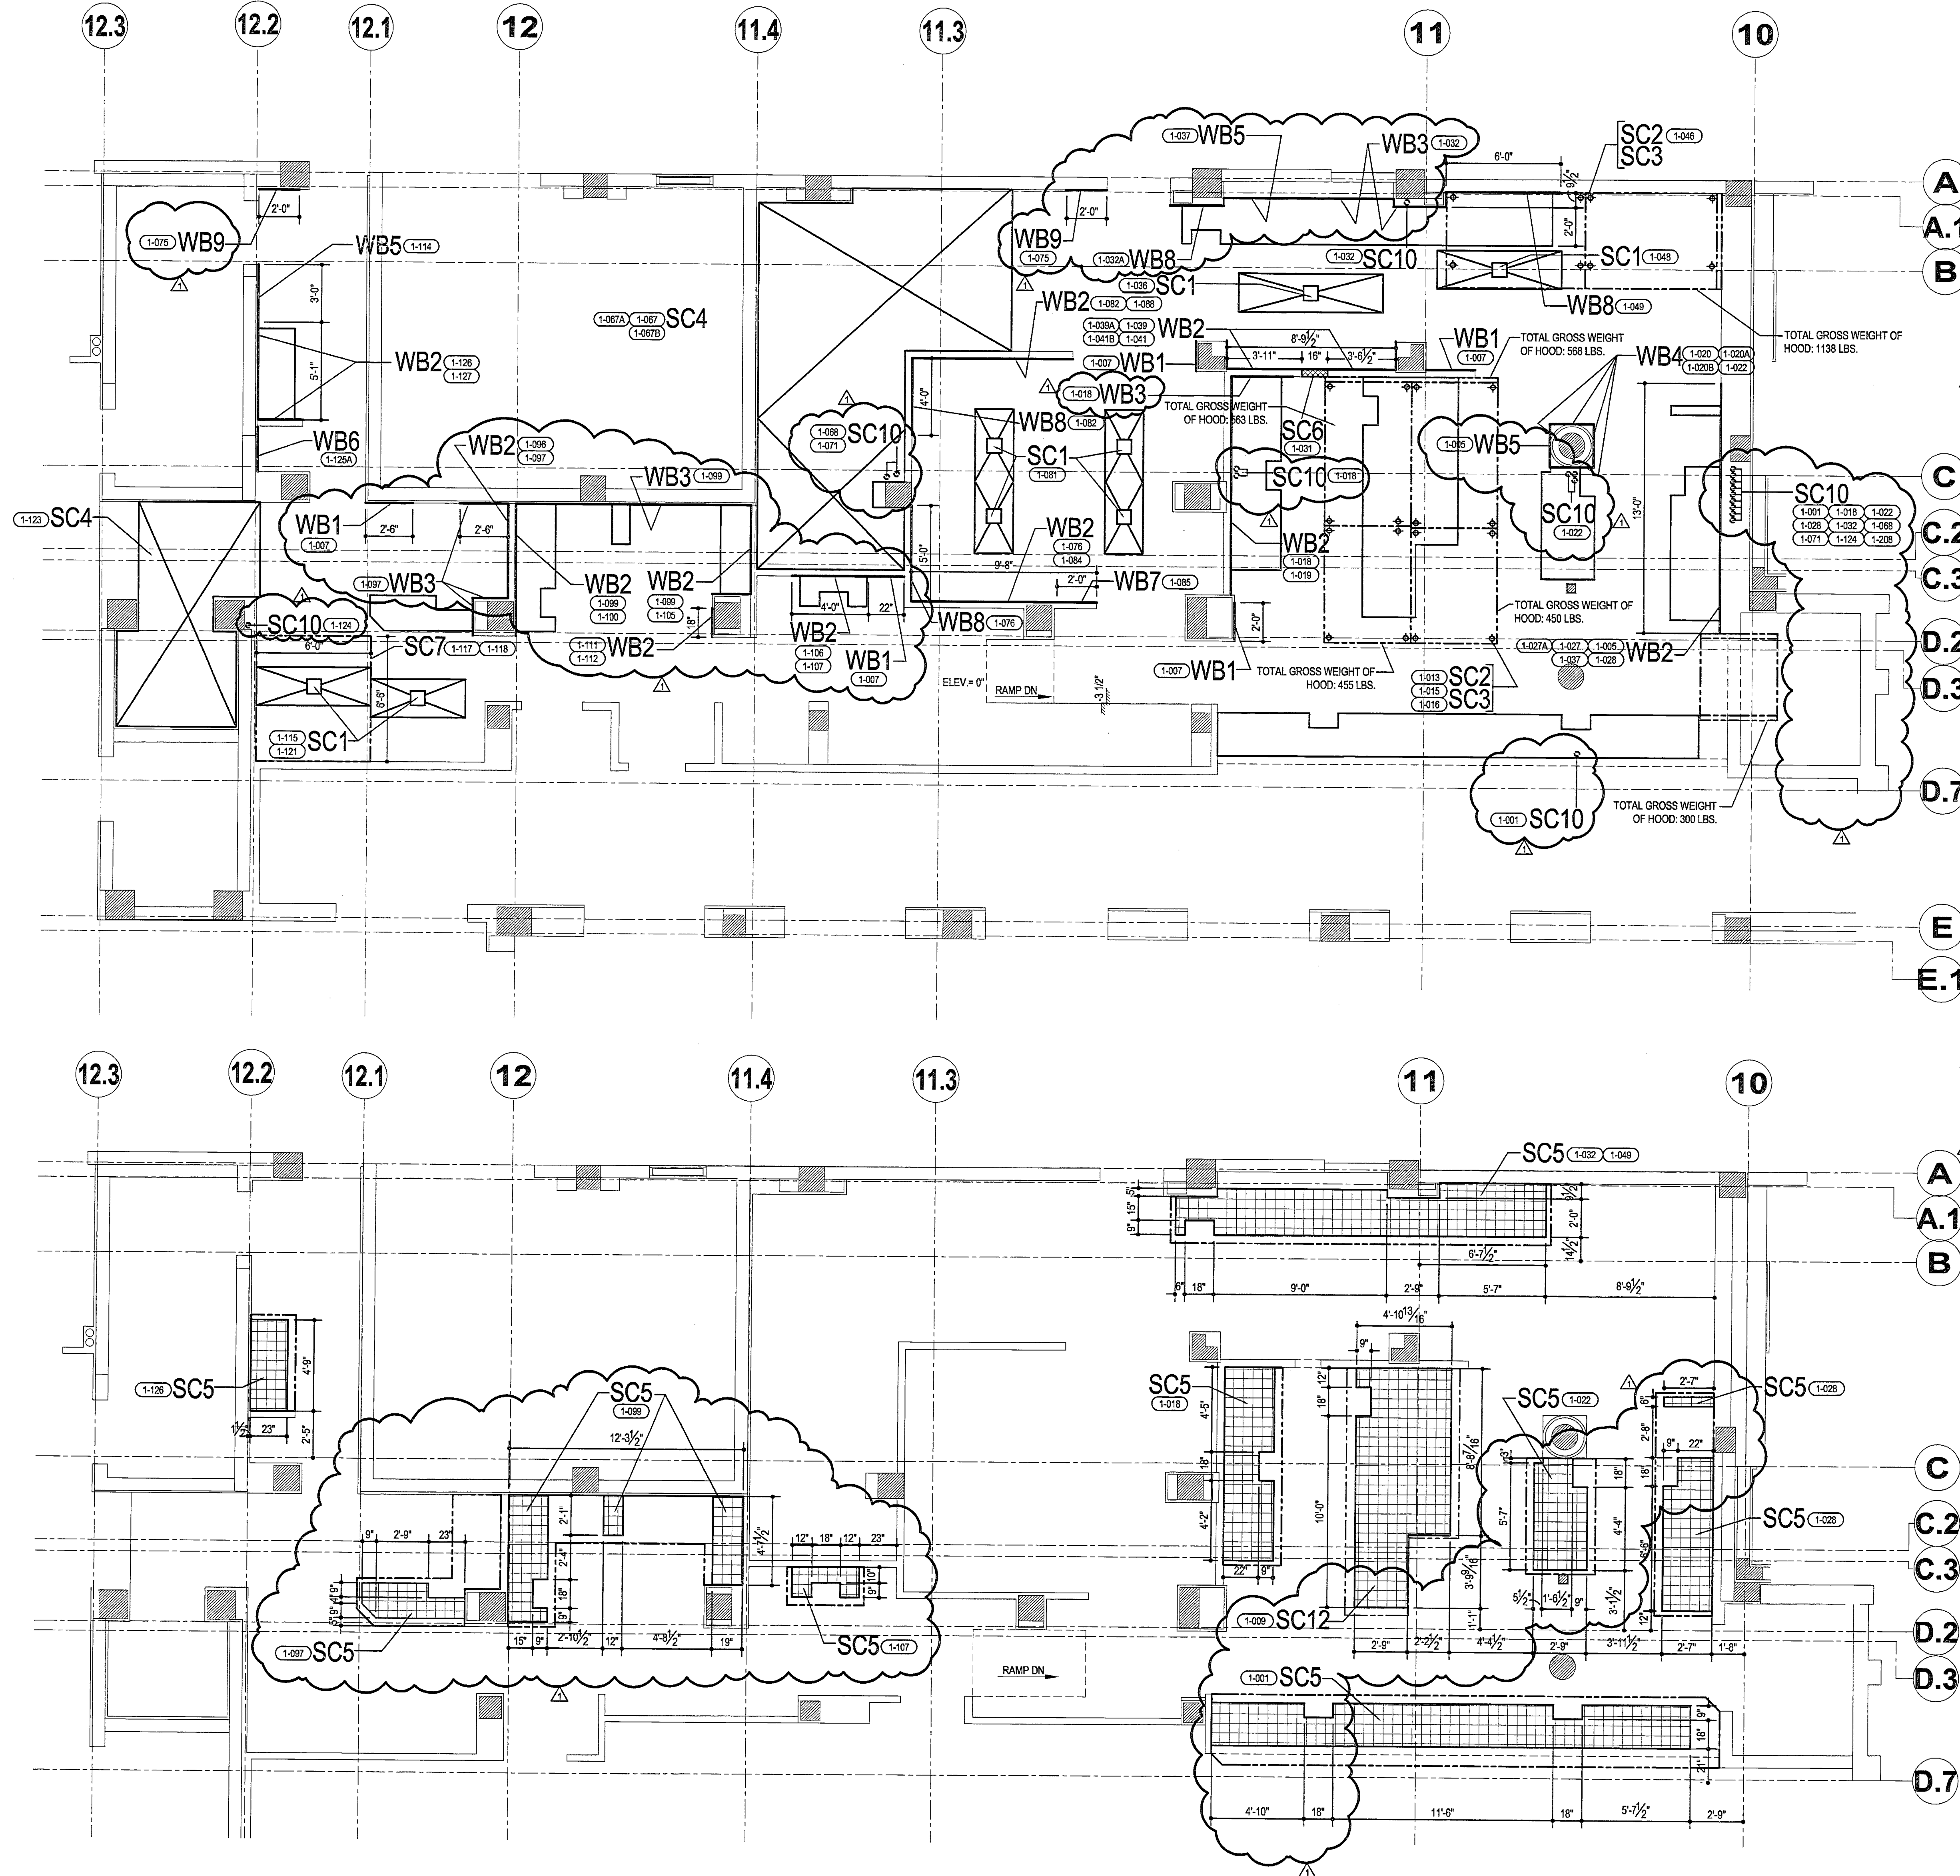

SPECIAL CONDITIONS NOTES

SC1	DEPRESSED PIT IN FLOOR/FLOOR TROUGH W/8\" X 8\" HOLE THROUGH SLAB FOR WASTE DRAIN - SEE DETAIL THIS SHEET & VERIFY FLOOR TROUGH SIZE W/FLOOR TROUGH SHOP DRAWING
SC2	APPROXIMATE HANGER ROD LOCATION & QUANTITY ABOVE EQUIPMENT. ARCHITECT/ENGINEER TO DESIGN & GC TO PROVIDE STRUCTURAL SUPPORT ABOVE ADEQUATE TO SUPPORT EQUIPMENT. ARCHITECT/ENGINEER/SC TO VERIFY QTY. & LOCATION OF HANGER RODS & WT TO BE SUPPORTED.
SC3	ALL CONTRACTORS TO VERIFY HANGER ROD LOCATIONS & MECHANICAL/ELECTRICAL CONNECTION POINTS BEFORE COMMENCING ANY WORK ABOVE CEILING SUSPENDED EQUIPMENT.
SC4	DEPRESSED PIT IN FLOOR/FWALK-IN BOX W/PIPE-FABRICATED FLOOR - SEE DEPRESSION DETAIL THIS SHEET
SC5	6\"(H) CONCRETE FILLED METAL CURB EQUIPMENT - TOP OF CURB TO BE TROWEL SMOOTH & LEVELED TO +/- 1/8\"
SC6	16\"(W) X 12\"(H) X 7\"(D) PASS-THRU IN BUILDING WALL WSILL @ 42\" AFF EQUIPMENT - VERIFY SIZE/LOCATION W/MANUFACTURER'S SHOP DRAWING
SC7	86\"(H) CEILING POCKET REQUIRED TO ACCOMMODATE EQUIPMENT
SC8	60\"(W) X 36\"(H) X 7\"(D) PASS-THRU IN BUILDING WALL WSILL @ 42\" AFF EQUIPMENT - VERIFY SIZE/LOCATION W/MANUFACTURER'S SHOP DRAWING
SC9	GENERAL CONTRACTOR TO PROVIDE STRUCTURAL SUPPORT ABOVE FOR CEILING HUNG EQUIPMENT - SEE EQUIPMENT SHOP DRAWING FOR MOUNTING INFORMATION
SC10	3\" DIA CONDUIT THROUGH FLOOR SLAB FOR REFRIGERATION LINES
SC11	NOT USED
SC12	4\"(H) CONCRETE CURB EQUIPMENT FORMED BY G.C. - TOP OF CURB TO BE TROWEL SMOOTH & LEVELED TO +/- 1/8\"

WALL BACKING NOTES

WB1	48\"(H) WALL BACKING W/BOTTOM @ 24\" AFF
WB2	48\"(H) WALL BACKING W/BOTTOM @ 36\" AFF
WB3	12\"(H) WALL BACKING W/BOTTOM @ 36\" AFF
WB4	66\"(H) WALL BACKING W/TOP @ 6\" AFF
WB5	36\"(H) WALL BACKING W/TOP @ FINISHED CEILING
WB6	24\"(H) WALL BACKING W/BOTTOM @ 18\" AFF
WB7	24\"(H) WALL BACKING W/BOTTOM @ 6\" AFF
WB8	24\"(H) WALL BACKING W/BOTTOM @ 36\" AFF
WB9	42\"(H) WALL BACKING W/BOTTOM @ 42\" AFF

SPECIAL CONDITION LEGEND

SLEEVE	
SLAB DEPRESSION	
RAISED CURB	
WALL RECESS	
LOW PARTITION WALL	
WALL BACKING	
OVERHEAD BEVERAGE CONDUIT	
BELOW FLOOR BEVERAGE CONDUIT	
BEVERAGE CONDUIT STUB	
HOOD HANGER ROD	
ABOVE FINISHED FLOOR	AFF
DROP FROM ABOVE	DFA
BELOW FINISHED FLOOR	BFF



BARING INDUSTRIES
A Division of Electrobus Professional, Inc.
http://www.baring.com • e-mail: sales@baring.com

Corporate Headquarters
Baring Industries
3901 Loch Drive West, Suite J
Morton, NJ 08053 USA
TELEPHONE (856) 327-6700
FAX (856) 327-6701

Northeastern Regional Office
Baring Industries
1200 PINE STREET
Suite 100
Nashville, TN 37203 USA
TELEPHONE (615) 252-6089
FAX (615) 252-6014

Midwestern Regional Office
Baring Industries
435 Eisenhower Lane South
Lombard, IL 60148 USA
TELEPHONE (815) 252-6089
FAX (815) 252-6014

Western Regional Office
Baring Industries
11411 Southern Highlands Parkway
Suite 200
Las Vegas, NV 89141 USA
TELEPHONE (702) 386-4416
FAX (702) 386-4417

SOHO HOUSE
MIAMI BEACH, FLORIDA
FIRST FLOOR
KITCHEN


**SPECIAL CONDITIONS PLAN
EQUIPMENT BASE PLAN**

REVISION: BY: CK BY: DATE:
ST JM 08-26-2009

PROJ. MGR: FRANK MURPHY
COORDINATOR: PATRICIA TEPPER
TELEPHONE: 954-327-6720
DRAWN BY: ST
CHECKED BY: JM
DATE: 08-26-2009
SCALE: 1/4\" = 1'-0\"

SHEET
K1-5
PROJECT NUMBER
071152


- PLUMBING NOTES**
- UTILITIES SHOWN ARE THE MINIMUM REQUIRED FOR THE FOODSERVICE EQUIPMENT. LOCATION, QUANTITY & SIZE OF ADDITIONAL UTILITIES, IF DESIRED/REQUIRED, ARE TO BE PROVIDED BY OTHERS.
 - FINAL CONNECTIONS TO EQUIPMENT, INTERCONNECTIONS BETWEEN COMPONENTS & INSTALLING DRAIN/PANTRY ARE INCLUDED IN THE PLUMBING CONTRACTOR'S SCOPE OF WORK.
 - UNLESS OTHERWISE NOTED IN THESE DRAWINGS, COMPONENTS SUCH AS (BUT NOT LIMITED TO) PIPES, TRAPS, VALVES, WATER HAMMER ARRESTORS, PRESSURE REDUCING VALVES, PRESSURE REGULATING VALVES & GAGES SHALL BE PROVIDED & INSTALLED BY THE PLUMBING CONTRACTOR.
 - UNLESS OTHERWISE NOTED IN THESE DRAWINGS OR AS RESTRICTED BY CODE, UTILITIES SHALL BE CONCEALED IN STUDIES OUT OF BUILDING WALLS.
 - COMPONENTS SUCH AS (BUT NOT LIMITED TO) TRAPS, VALVES, WATER HAMMER ARRESTORS, PRESSURE REDUCING VALVES, PRESSURE REGULATING VALVES & GAGES SHALL BE LOCATED SO THAT THEY DO NOT INTERFERE WITH THE OPERATION OF THE EQUIPMENT.
 - UNLESS OTHERWISE NOTED IN THESE DRAWINGS, WATER PRESSURE AT CONNECTION POINTS ON THE EQUIPMENT SHALL NOT EXCEED:
A. 25 PSI FOR DISHWASHERS & WATER BOOSTER HEATERS
B. 50 PSI FOR ALL OTHER EQUIPMENT
& SHALL COMPLY WITH THE MANUFACTURER'S WATER FLOW REQUIREMENTS.
 - UNLESS OTHERWISE NOTED IN THESE DRAWINGS, HOT WATER SUPPLY TO DISH & WASHING EQUIPMENT & WATER BOOSTER HEATERS SHALL BE 120 DEG F (+/- 5 DEG F) AT THE CONNECTION POINT ON THE EQUIPMENT.
 - THE PLUMBING CONTRACTOR SHALL PROVIDE A WATER HAMMER ARRESTOR AT ALL WATER HEATERS AND DISHWASHER/WATER BOOSTER HEATER LOCATIONS.
 - UNLESS OTHERWISE NOTED IN THESE DRAWINGS, THE PLUMBING CONTRACTOR SHALL PROVIDE A BACKFLOW PREVENTION DEVICE AS REQUIRED BY APPLICABLE CODES AND GOVERNING OFFICIALS HAVING JURISDICTION.
 - EXPOSED PORTIONS OF CHILLED/COLDING WATER & HOT WATER PIPING SHALL BE INSULATED BY THE PLUMBING CONTRACTOR.
 - GAS, STEAM & WATER PIPING SHALL BE BE PRESSURE TESTED, PULSED FREE OF FOREIGN WATER & LINE STANNERS CLEANED BY THE PLUMBING CONTRACTOR PRIOR TO CONNECTION TO THE EQUIPMENT.
 - GREASE TRAPS ARE TO BE LOCATED & INSTALLED SO THEY ARE ACCESSIBLE & COVERED) REMOVED WITHOUT INTERFERING IN THE OPERATION OF THE EQUIPMENT OR WITH ANY ELECTRICAL, MECHANICAL OR PLUMBING UTILITY.
 - CONDENSATE DRAIN PIPING SHALL BE TRAPPED OUTSIDE OF THE REFRIGERATED COMPARTMENT & EXTENDED TO AN INDIRECT BUILDING WASTE DRAIN.
 - CONDENSATE DRAIN PIPING FROM MAKEUP/EVAPORATOR COILS SHALL BE PROVIDED, INSTALLED & INSULATED BY THE PLUMBING CONTRACTOR.
 - UNLESS OTHERWISE NOTED IN THESE DRAWINGS, CONDENSATE DRAIN PIPING FROM REFRIGERATED EQUIPMENT NOT EQUIPPED WITH A CONDENSATE EVAPORATOR SHALL BE PROVIDED & INSTALLED BY THE PLUMBING CONTRACTOR.
 - DRAIN PIPING FROM WASTE DISPOSAL EQUIPMENT SUCH AS DISPOSERS/PULPERS SHALL BE PROVIDED WITH CLEAN-OUT FITTINGS.
 - PLUMBING CONTRACTOR TO PROVIDE & INSTALL A MAIN FUEL GAS SHUT-OFF VALVE IN ACCORDANCE WITH APPLICABLE CODES & ANY GOVERNING OFFICIAL HAVING JURISDICTION.
 - UNLESS OTHERWISE NOTED IN THESE DRAWINGS, FUEL GAS SOLENOID SHUT-OFF VALVE(S) FOR FOODSERVICE EQUIPMENT PROVIDED BY BARING ARE PROVIDED BY BARING & INSTALLED BY THE PLUMBING CONTRACTOR.
 - UNLESS PERMITTED BY APPLICABLE CODE(S) FUEL GAS PIPING TO PILOT BURNERS ON EQUIPMENT SHALL NOT BE PASS A FUEL GAS SOLENOID SHUT-OFF VALVE.
 - BARING INDUSTRIES RECOMMENDS THAT FUEL GAS SERVICE BE PROVIDED VIA A LOOPED DISTRIBUTION SYSTEM. THE SIZE OF THE LOOP SHALL BE DETERMINED BY THE PROJECT ARCHITECT/ENGINEER.
 - DRAIN PIPING FROM ANY EQUIPMENT USING/GENERATING STEAM SHALL BE OF MATERIALS & UTILIZING INSTALLATION METHODS TO ACCOMMODATE TEMPERATURES ABOVE 212 DEG F.
 - BARING INDUSTRIES RECOMMENDS THAT STEAM SUPPLY & CONDENSATE RETURN BE PROVIDED VIA LOOPED SYSTEMS. THE SIZE OF THE LOOPS SHALL BE DETERMINED BY THE PROJECT ARCHITECT/ENGINEER.
 - BARING INDUSTRIES RECOMMENDS THAT CHILLED/COLDING WATER SUPPLY & RETURN BE PROVIDED VIA LOOPED SYSTEMS. THE SIZE OF THE LOOPS SHALL BE DETERMINED BY THE PROJECT ARCHITECT/ENGINEER.

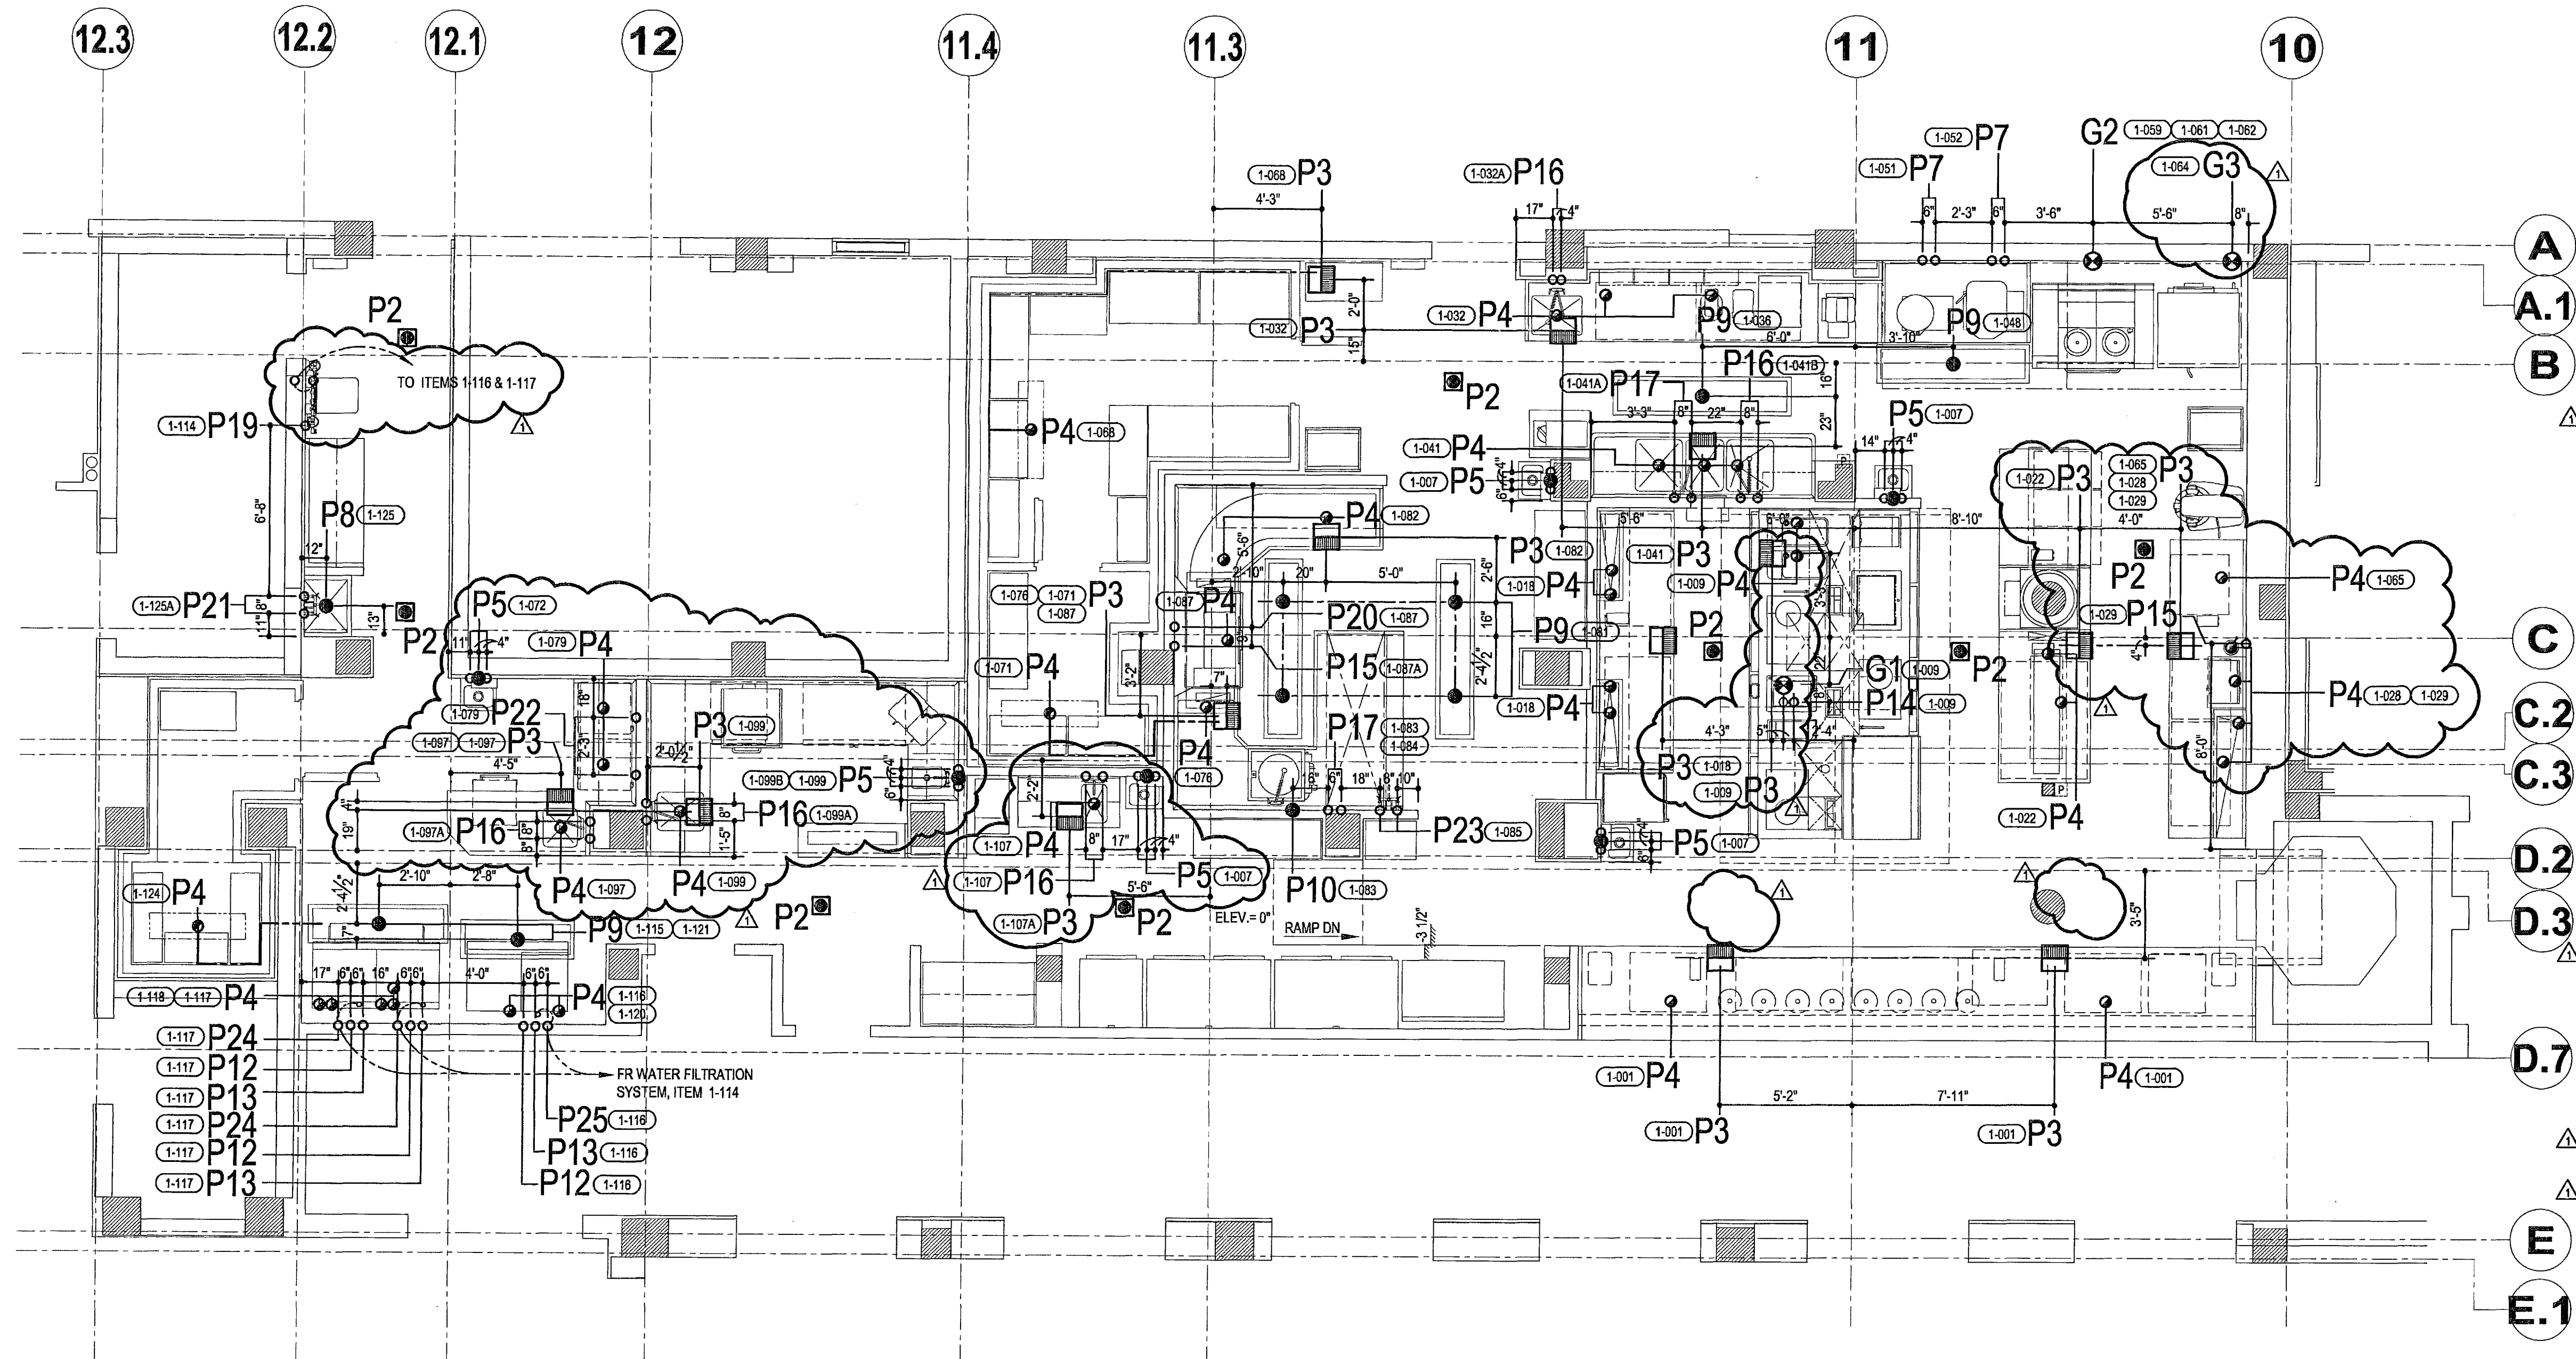

PLUMBING ROUGH-IN SCHEDULE	
P1	NOT USED
P2	FLOOR DRAIN W/REMOVABLE GRATE
P3	FLOOR SINK W/REMOVABLE GRATE
P4	DRAIN LOCATION ON EQUIPMENT - EXTEND TO BUILDING WASTE DRAIN
P5	1/2\" HOT & COLD WATER STUB @ +12\" AFF & OUT OF WALL AND 1-1/2\" DIRECT WASTE DRAIN STUB @ +18\" & OUT OF WALL - CONNECT TO HAND SINK & PROVIDE SHUT-OFF VALVES ON WATER LINES
P6	NOT USED
P7	1/2\" HOT & COLD WATER - STUB @ +48\" AFF & OUT OF WALL - CONNECT TO EQUIPMENT & PROVIDE SHUT-OFF VALVES
P8	3\" DIRECT WASTE DRAIN F/MOP SINK - STUB UP +6\" AFF - TRIM TO CORRECT ELEVATION & CONNECT TO MOP SINK DRAIN
P9	3\" DIRECT WASTE DRAIN F/FLOOR TROUGH - STUB UP +6\" AFF - TRIM TO CORRECT ELEVATION & CONNECT TO FLOOR TROUGH
P10	2\" DIRECT WASTE DRAIN - STUB UP +6\" AFF & OUT OF BUILDING WALL - CONNECT TO DRAIN OUTLET ON SCRAP COLLECTOR
P11	NOT USED
P12	1/2\" COOLING WATER SUPPLY FR/BUILDING COOLING SYSTEM LOOP - STUB @ +72\" AFF & OUT OF WALL - CONNECT TO EQUIPMENT & PROVIDE SHUT-OFF VALVE
P13	1/2\" COOLING WATER RETURN TO BUILDING COOLING SYSTEM LOOP - STUB @ +72\" AFF & OUT OF WALL - CONNECT TO EQUIPMENT & PROVIDE SHUT-OFF VALVE
P14	1/2\" COLD WATER - STUB @ +9\" AFF - CONNECT TO EQUIPMENT & PROVIDE SHUT-OFF VALVES
P15	1/2\" COLD WATER - STUB @ +12\" AFF & OUT OF WALL - CONNECT TO EQUIPMENT & PROVIDE SHUT-OFF VALVE
P16	1/2\" HOT & COLD WATER - STUB @ +12\" AFF & OUT OF WALL - CONNECT TO EQUIPMENT & PROVIDE SHUT-OFF VALVES
P17	3/4\" HOT & COLD WATER - STUB @ +12\" AFF & OUT OF WALL - CONNECT TO EQUIPMENT & PROVIDE SHUT-OFF VALVES
P18	NOT USED
P19	3/4\" COLD WATER - STUB @ +80\" AFF & OUT OF WALL - CONNECT TO WATER FILTER & EXTEND TO ITEMS 1-098, 1-101, 1-103, 1-116, & 1-117 - PROVIDE SHUT-OFF VALVE
P20	3/4\" 110\" F HOT WATER - STUB @ +60\" AFF & OUT OF WALL - CONNECT TO DISHWASHER & PROVIDE SHUT-OFF VALVE
P21	1/2\" HOT & COLD WATER - STUB @ +38\" AFF & OUT OF WALL - CONNECT TO EQUIPMENT & PROVIDE SHUT-OFF VALVES
P22	3/4\" 110\" F HOT WATER - STUB @ +12\" AFF & OUT OF WALL - CONNECT TO EQUIPMENT & PROVIDE SHUT-OFF VALVE
P23	1/2\" HOT & COLD WATER - STUB @ +24\" AFF & OUT OF WALL - CONNECT TO EQUIPMENT & PROVIDE SHUT-OFF VALVES
P24	3/8\" FILTERED COLD WATER - FR/1-114 - STUB @ +60\" AFF & OUT OF WALL - CONNECT TO EQUIPMENT & PROVIDE SHUT-OFF VALVES
P25	1/2\" FILTERED COLD WATER - FR/1-114 - STUB @ +72\" AFF & OUT OF WALL - CONNECT TO EQUIPMENT & PROVIDE SHUT-OFF VALVES

GAS ROUGH-IN SCHEDULE	
G1	1 1/4\" NATURAL GAS - STUB @ +12\" AFF - CONNECT TO EQUIPMENT THROUGH PRESSURE REGULATOR & PROVIDE SHUT-OFF
G2	1\" NATURAL GAS - STUB @ +24\" AFF & OUT OF BUILDING WALL - CONNECT TO EQUIPMENT THROUGH PRESSURE REGULATOR & FLEXIBLE GAS LINE W/QUICK DISCONNECT - PROVIDE SHUT-OFF
G3	1/2\" NATURAL GAS - STUB @ +24\" AFF & OUT OF BUILDING WALL - CONNECT TO EQUIPMENT THROUGH PRESSURE REGULATOR & FLEXIBLE GAS LINE W/QUICK DISCONNECT & PROVIDE SHUT-OFF

PLUMBING LEGEND	
COLD WATER	CW
HOT WATER	HW
COOLING WATER SUPPLY	CWS
COOLING WATER RETURN	CWR
BUILDING DIRECT WASTE DRAIN	DW
INDIRECT WASTE DRAIN LOCATION ON EQUIPMENT	IW
HUB DRAIN/AIR GAP DRAIN	HDA/G
FLOOR DRAIN	FD
FUNNEL-TYPE FLOOR DRAIN	F7D
FLOOR SINK	FS
STEAM SUPPLY	SS
CONDENSATE RETURN	CR
GAS	G
COMPRESSED AIR	CA
ABOVE FINISH FLOOR	AF
DROP FROM ABOVE	DFA
BELOW FINISH FLOOR	BFF
CONDENSATE/COOLING WATER/WASTE PIPING	

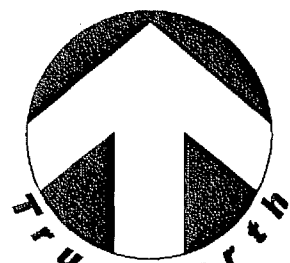

BARING INDUSTRIES
A Division of Electrosan Professionals, Inc.
http://www.baring.com • e-mail: sales@baring.com

Corporate Headquarters
Baring Industries
2049 S.W. 42ND STREET
Ft. Lauderdale, FL 33312 USA
TELEPHONE (954) 327-6720
FAX (954) 327-6781

Northeastern Regional Office
Baring Industries
3001 Lincoln Drive West, Suite J
Morristown, NJ 08953 USA
TELEPHONE (954) 369-9928
FAX (954) 369-0152

Midwestern Regional Office
Baring Industries
1009 PINES STREET
Suite 100
Nashville, TN 37203 USA
TELEPHONE (615) 252-8089
FAX (615) 252-8074

Midwestern Regional Office
Baring Industries
435 Eisenhower Lane South
Lombard, IL 60148 USA
TELEPHONE (630) 920-1110
FAX (630) 920-1110

Western Regional Office
Baring Industries
14111 Southern Highlands Parkway
Suite 220
Las Vegas, NV 89131 USA
TELEPHONE (702) 385-4416
FAX (702) 385-4417

SOHO HOUSE

MIAMI BEACH, FLORIDA

FIRST FLOOR

KITCHEN

PROJECT NAME

PROJECT LOCATION

ARCH NAME

PLUMBING ROUGH-IN PLAN

REVISION: BY: CK BY: DATE:

ST	JM	08-28-2009
----	----	------------

PROJ. MGR: FRANK MURPHY
COORDINATOR: PATRICIA TEPPER
TELEPHONE: 954-327-6720
DRAWN BY: ST
CHECKED BY: JM
DATE: - 08-28-2009
SCALE: 1/4\"=1'-0\"

SHEET

K1-6

PROJECT NUMBER

071152

THIS DRAWING AND ITS CONTENTS ARE THE PROPERTY OF BARING INDUSTRIES, INC. REPRODUCTION, DISTRIBUTION, MODIFICATION IN ANY FORM OR ANY OTHER UNAUTHORIZED USE OF THIS DRAWING WITHOUT THE EXPRESSED WRITTEN CONSENT OF BARING INDUSTRIES, INC. IS PROHIBITED. COPYRIGHT © 2009 BARING INDUSTRIES, INC. ALL RIGHTS RESERVED.

DATE: 08-28-2009

FILE: P:\PROJECTS\SOHO HOUSE\SOHO HOUSE\PLUMBING\ROUGH-IN PLAN\SOHO HOUSE\PLUMBING\ROUGH-IN PLAN.dwg

SCALE: 1/4\"=1'-0\"


SHEET

PROJECT NUMBER

071152

REFRIGERATION & VENTILATION NOTES

1. SLEEVES PENETRATING ANY WALL, FLOOR OR ROOF SHALL BE PROVIDED & INSTALLED BY THE GENERAL CONTRACTOR IN ACCORDANCE WITH APPLICABLE CODE(S) & ANY GOVERNING OFFICIAL HAVING JURISDICTION.
2. REFRIGERATION LINE RUNS SHOWN ARE SCHEMATIC. ACTUAL ROUTING TO BE DETERMINED BY AIB SITE CONDITIONS. REFRIGERATION SYSTEM INSTALLER & THE GENERAL CONTRACTOR.
3. UNLESS OTHERWISE NOTED IN THESE DRAWINGS, CURBS/RACKS/UNDERLAGE FOR ROOF-MOUNTED EQUIPMENT SHALL BE PROVIDED & INSTALLED BY THE GENERAL CONTRACTOR IN ACCORDANCE WITH APPLICABLE CODE(S) & ANY GOVERNING OFFICIAL HAVING JURISDICTION.
4. UNLESS OTHERWISE NOTED IN THESE DRAWINGS, EXHAUST VENTILATORS SHALL BE HUNG WITH THE BOTTOM OF THE VENTILATOR @ 8' AFF.
5. HVAC CONTRACTOR SHALL MAKE CONNECTIONS BETWEEN EXHAUST VENTILATORS & DUCT WORK FULLY WELDED & LIQUID TIGHT.
6. HVAC CONTRACTOR SHALL PROVIDE & INSTALL DUCTWORK, FANS & CURBS REQUIRED FOR A COMPLETE & FUNCTIONING SYSTEM.
7. SYSTEM START-UP & AIR BALANCE IS INCLUDED IN THE HVAC CONTRACTOR'S SCOPE OF WORK.

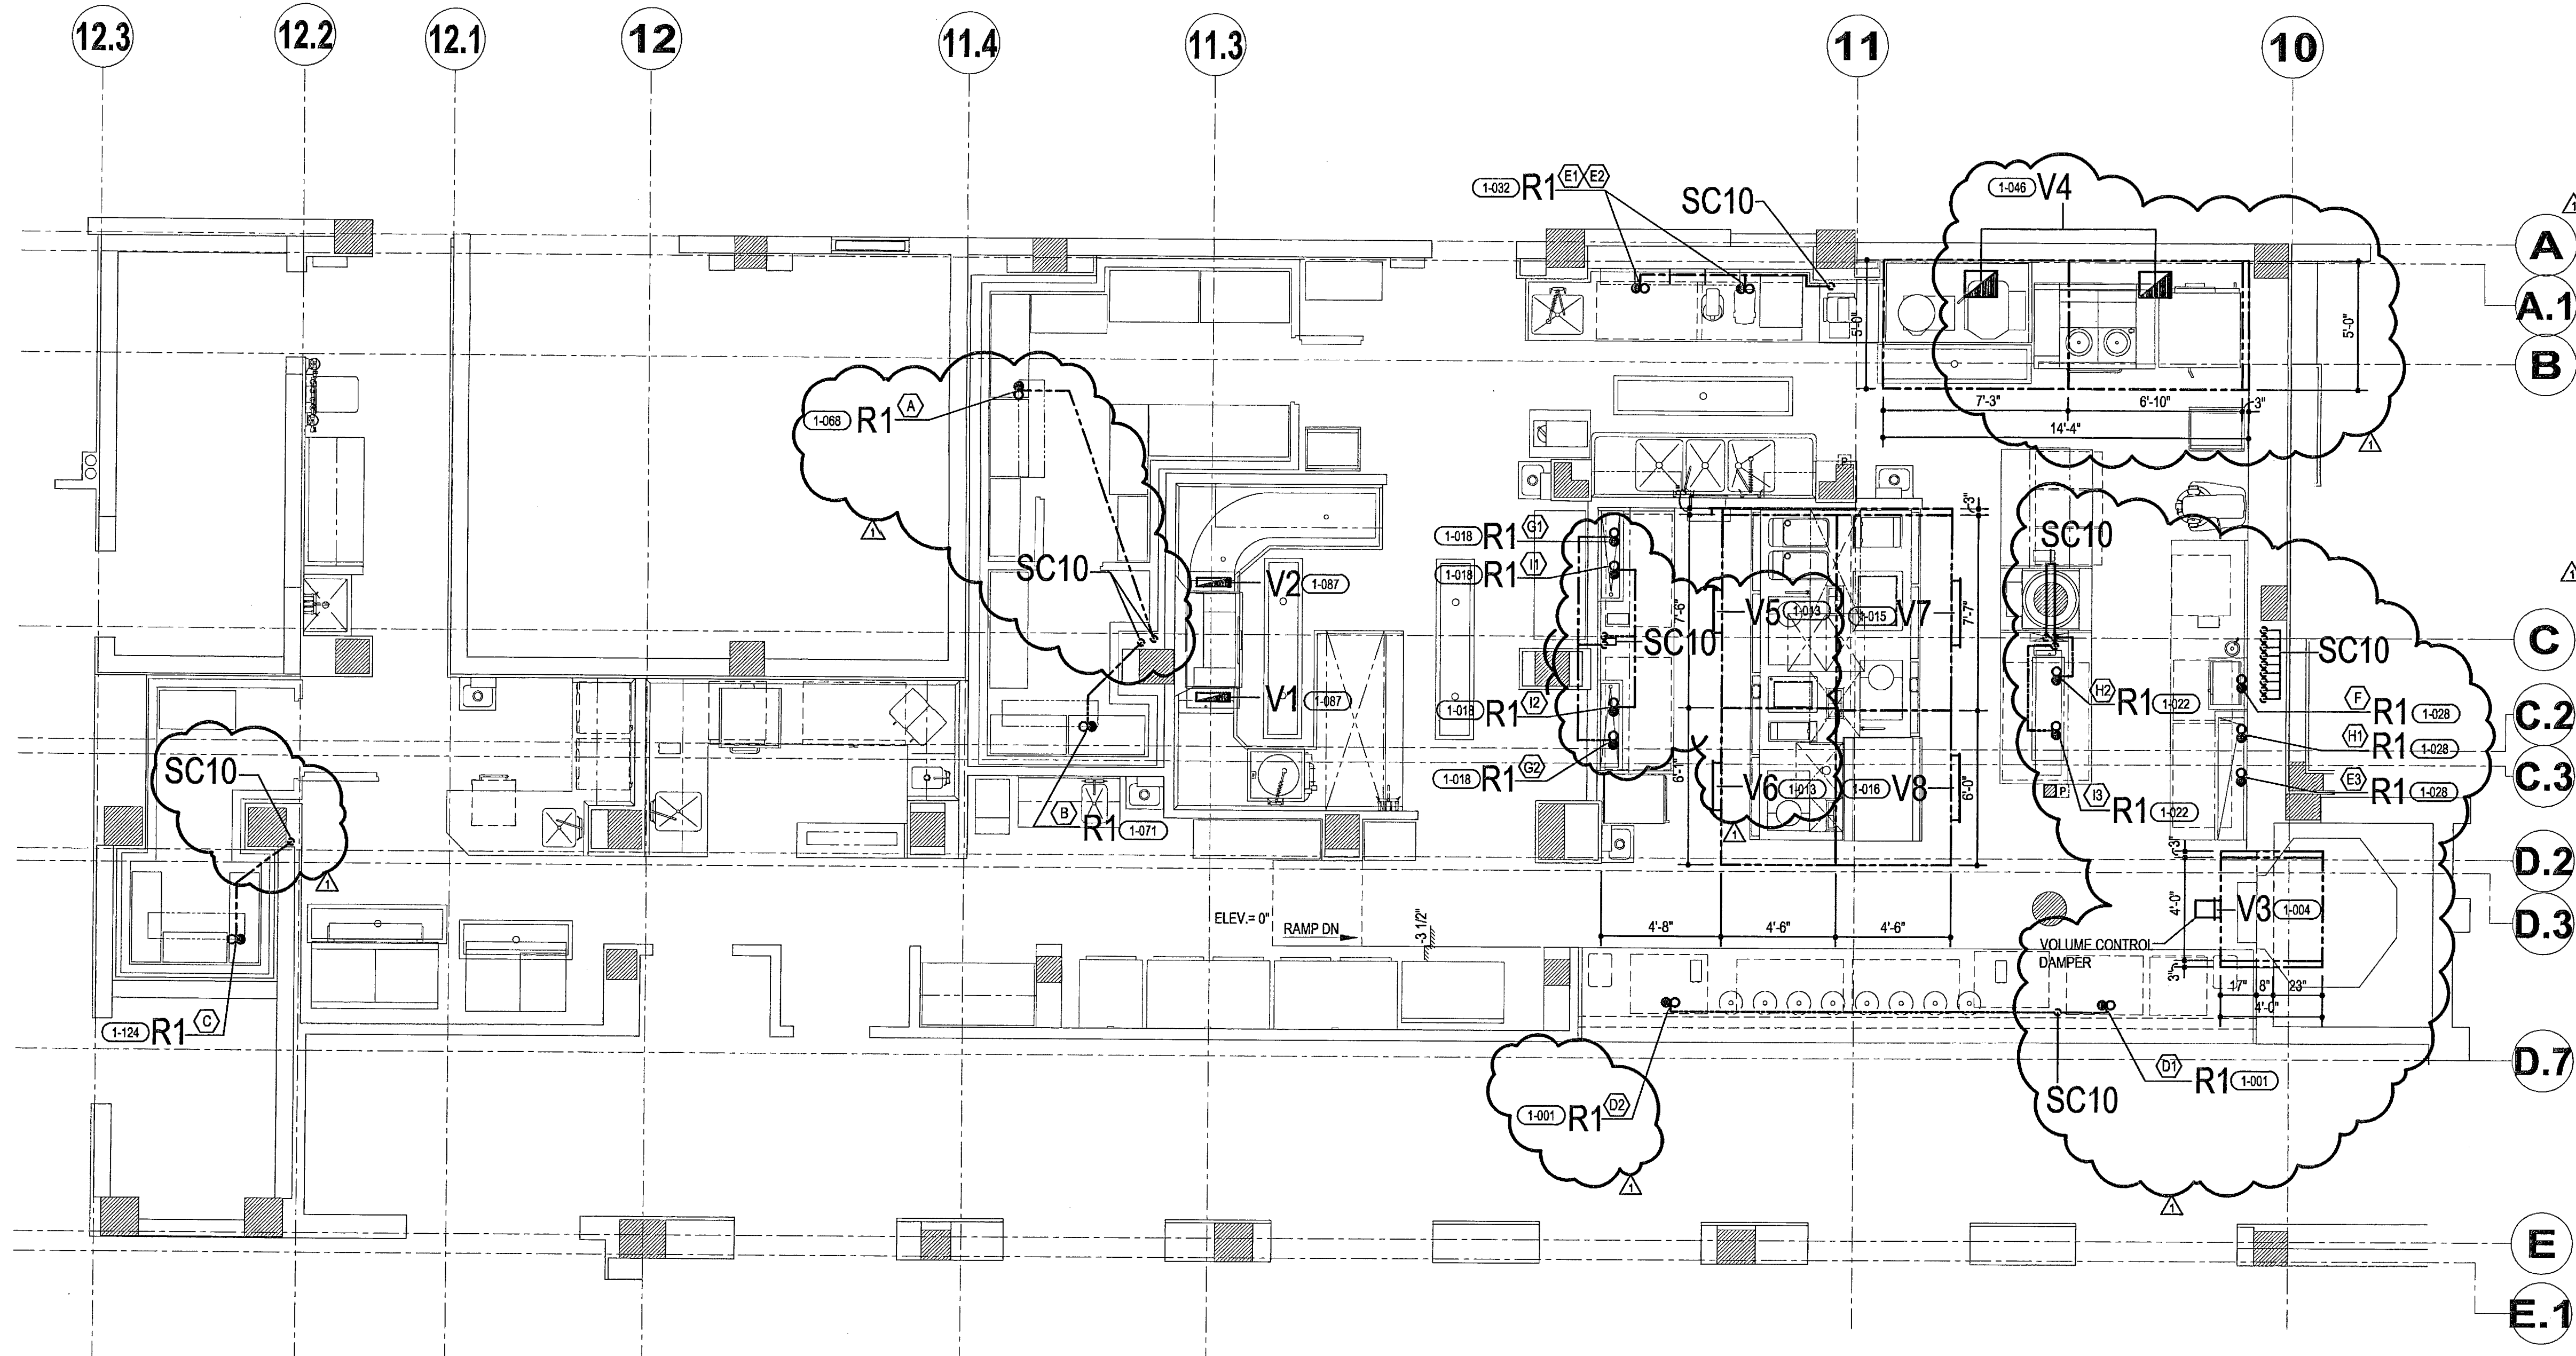

VENTILATION ROUGH-IN SCHEDULE

V1	4" X 16" EXHAUST DUCT - 200 CFM @ 0.25" SP
V2	4" X 16" EXHAUST DUCT - 400 CFM @ 0.25" SP
V3	8" X 12" EXHAUST DUCT IN FRONT FACE OF EXHAUST HOOD - 1200 CFM @ 1.13" SP
V4	12" X 15" EXHAUST DUCT - 2145 CFM @ .75" SP
V5	8" X 22" EXHAUST DUCT IN FRONT FACE OF EXHAUST HOOD- 2235 CFM @ .83" SP
V6	8" X 20" EXHAUST DUCT IN FRONT FACE OF EXHAUST HOOD- 1813 CFM @ 1.03" SP
V7	8" X 30" EXHAUST DUCT IN FRONT FACE OF EXHAUST HOOD- 2821 CFM @ 1.34" SP
V8	8" X 30" EXHAUST DUCT IN FRONT FACE OF EXHAUST HOOD- 2844 CFM @ 2.23" SP

REFRIGERATION ROUGH-IN SCHEDULE

R1	LIQUID & SUCTION REFRIGERATION LINES BETWEEN THE EQUIPMENT & REMOTE REFRIGERATION RACK
SC10	3" DIA SLEEVE THROUGH FLOOR SLAB REFRIGERATION LINES
SC11	NOT USED

REFRIGERATION LEGEND


LIQUID & SUCTION LINES
OVERHEAD REFRIGERATION LINES
BELOW FLOOR REFRIGERATION LINES
INSIDE EQUIPMENT REFRIGERATION LINES
ABOVE FINISHED FLOOR
DROP FROM ABOVE
BELOW FINISHED FLOOR

AFF
DFA
BFF

VENTILATION LEGEND

EXHAUST DUCT
SUPPLY DUCT
STATIC PRESSURE, WATER GAUGE
CUBIC FEET/MINUTE
ABOVE FINISHED FLOOR

SPWG
CFM
AFF

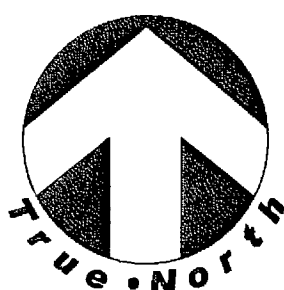

SOHO HOUSE

MIAMI BEACH, FLORIDA

FIRST FLOOR
KITCHEN

REFRIGERATION &
VENTILATION ROUGH-IN
PLAN

REVISION: BY: OK BY: DATE:


PROJ. MGR: FRANK MURPHY
COORDINATOR: PATRICIA TEPPER
TELEPHONE: 954-327-6720
DRAWN BY: ST
CHECKED BY: JM
DATE: 06-26-2009
SCALE: 1/4" = 1'-0"

K1-7

0711152

ELECTRICAL NOTES

- UTILITIES SHOWN ARE THE MINIMUM REQUIRED FOR THE FOODSERVICE EQUIPMENT. LOCATION, QUANTITY & SIZE OF ADDITIONAL UTILITIES, IF DESIRED/REQUIRED, ARE TO BE PROVIDED BY OTHERS.
- FINAL CONNECTIONS TO EQUIPMENT & INTER-CONNECTIONS BETWEEN COMPONENTS ARE INCLUDED IN THE ELECTRICAL CONTRACTOR'S SCOPE OF WORK.
- UNLESS OTHERWISE NOTED IN THESE DRAWINGS, COMPONENTS SUCH AS (BUT NOT LIMITED TO) WIRE, CONDUIT, SWITCHES, SAFETY DEVICES, OVER CURRENT & GROUND FAULT PROTECTION DEVICES & DISCONNECT SWITCHES SHALL BE PROVIDED & INSTALLED BY THE ELECTRICAL CONTRACTOR.
- UNLESS OTHERWISE NOTED IN THESE DRAWINGS OR AS RESTRICTED BY CODE, UTILITIES SHALL BE CONCEALED IN A STUBBED OUT OF BUILDING WALLS.
- COMPONENTS SUCH AS (BUT NOT LIMITED TO) SWITCHES, SAFETY DEVICES, OVER CURRENT & GROUND FAULT PROTECTION DEVICES & DISCONNECT SWITCHES SHALL BE LOCATED SO THAT THEY DO NOT INTERFERE WITH THE OPERATION OF THE EQUIPMENT.
- NEMA CONFIGURATION DESIGNATIONS ARE PROVIDED TO ENSURE THAT RECEPTACLES PROVIDED ARE INSTALLED BY THE ELECTRICAL CONTRACTOR MATCH THE FLU'S CONFIGURATION PROVIDED WITH THE EQUIPMENT.
- ELECTRICAL CONTRACTOR SHALL PROVIDE & INSTALL DISCONNECT SWITCHES AS REQUIRED BY APPLICABLE CODE(S) & ANY GOVERNING OFFICIAL, HAVING JURISDICTION.
- LINE VOLTAGE CONTROL CIRCUIT & INTER-WIRING BETWEEN WALK-IN BOX COMPONENTS SUCH AS (BUT NOT LIMITED TO) CONDENSING UNITS, REFRIGERATION RACKS, EVAPORATOR COILS, TIME CLOCKS & TEMPERATURE CONTROLS ARE INCLUDED IN THE ELECTRICAL CONTRACTOR'S SCOPE OF WORK.
- UNLESS OTHERWISE NOTED IN THESE DRAWINGS HEATER CABLE SHALL PROVIDED BY BARING & SHALL BE FLEXIBLE, SELF-REGULATING TYPE RATED @ 3 WATTS PER FOOT.
- CONDENSATE DRAIN PIPE FROM WALK-IN REFRIGERATOR COMPARTMENTS SHALL BE WRAPPED WITH HEATER CABLE BY THE ELECTRICAL CONTRACTOR.
- WALK-IN BOX LIGHT FIXTURES SHIPPED LOOSE SHALL BE MOUNTED AND INTER-WIRED BY THE ELECTRICAL CONTRACTOR.
- VENTILATION COMPONENTS SUCH AS (BUT NOT LIMITED TO) LIGHT FIXTURES, CONTROL PANELS, FANS, MAGNETIC CONTACTORS, MOTORIZED DAMPERS & THE BUILDING ALARM SYSTEM ARE INCLUDED IN THE ELECTRICAL CONTRACTOR'S SCOPE OF WORK.
- LINE VOLTAGE CONTROL CIRCUIT & INTER-WIRING BETWEEN FIRE SUPPRESSION SYSTEM COMPONENTS SUCH AS (BUT NOT LIMITED TO) CONTROL PANELS, AGENT CANNISTERS, REMOTE PULL STATIONS & THE BUILDING ALARM SYSTEM ARE INCLUDED IN THE ELECTRICAL CONTRACTOR'S SCOPE OF WORK.
- FIRE SUPPRESSION SYSTEM REMOTE PULL STATION REQUIRES 4" x 4" OCTAGON J-BOX W/SCREW HOLES @ 2 & 8 O'CLOCK POSITIONS. ELECTRICAL CONTRACTOR SHALL RECESS THE J-BOX IN THE BUILDING WALL & PROVIDE EMPTY CONDUIT FROM THE TOP OF THE J-BOX STUBBED OUT THE BLDG WALL 6" ABOVE THE FINISHED C.L.G.
- ELECTRICAL CONTRACTOR SHALL VERIFY FIRE SUPPRESSION SYSTEM REMOTE PULL STATION CONDITIONS WITH THE GOVERNING OFFICIAL, HAVING JURISDICTION PRIOR TO ROUGH-IN.
- ELECTRICAL CONTRACTOR SHALL VERIFY TO WHICH BLDG SYSTEMS THE FIRE SUPPRESSION SYSTEM SHALL BE INTER-CONNECTED.
- LINE VOLTAGE CONTROL CIRCUIT & INTER-WIRING BETWEEN WASTE SYSTEM COMPONENTS SUCH AS (BUT NOT LIMITED TO) CONTROL PANELS, START STOP SWITCHES, DISPOSERS, PUMPS & TROUGH COLLECTORS ARE INCLUDED IN THE ELECTRICAL CONTRACTOR'S SCOPE OF WORK.
- LINE VOLTAGE CONTROL CIRCUIT & INTER-WIRING BETWEEN WAREWASHING EQUIPMENT COMPONENTS SUCH AS (BUT NOT LIMITED TO) CONTROL PANELS, VENT FAN CONTROL, DETERGENT & SANITIZER DISPENSERS, TABLE MOUNT SWITCHES & WATER BOOSTER HEATERS ARE INCLUDED IN THE ELECTRICAL CONTRACTOR'S SCOPE OF WORK.
- UNLESS OTHERWISE STIPULATED BY APPLICABLE CODE, ALL 120-VOLT RECEPTACLES SHALL BE GFCI TYPE.
- POWER SERVICE TO COMPUTER AND POINT-OF-SALE EQUIPMENT SHALL BE ON A DEDICATED CIRCUIT WITH ISOLATED GROUND.
- POINT-OF-SALE EQUIPMENT REQUIRES AN EMPTY J-BOX AND CONDUIT SUITABLE FOR CATEGORY-5 DATA INTERFACE CABLE. ELECTRICAL CONTRACTOR TO VERIFY ROUTING WITH THE SYSTEM PROVIDER.
- COMPUTER EQUIPMENT REQUIRES A J-BOX AND CONDUIT WITH DATA INTERFACE CABLE & RJ45 ETHERNET CONNECTOR. ELECTRICAL CONTRACTOR TO VERIFY ROUTING WITH THE SYSTEM PROVIDER.

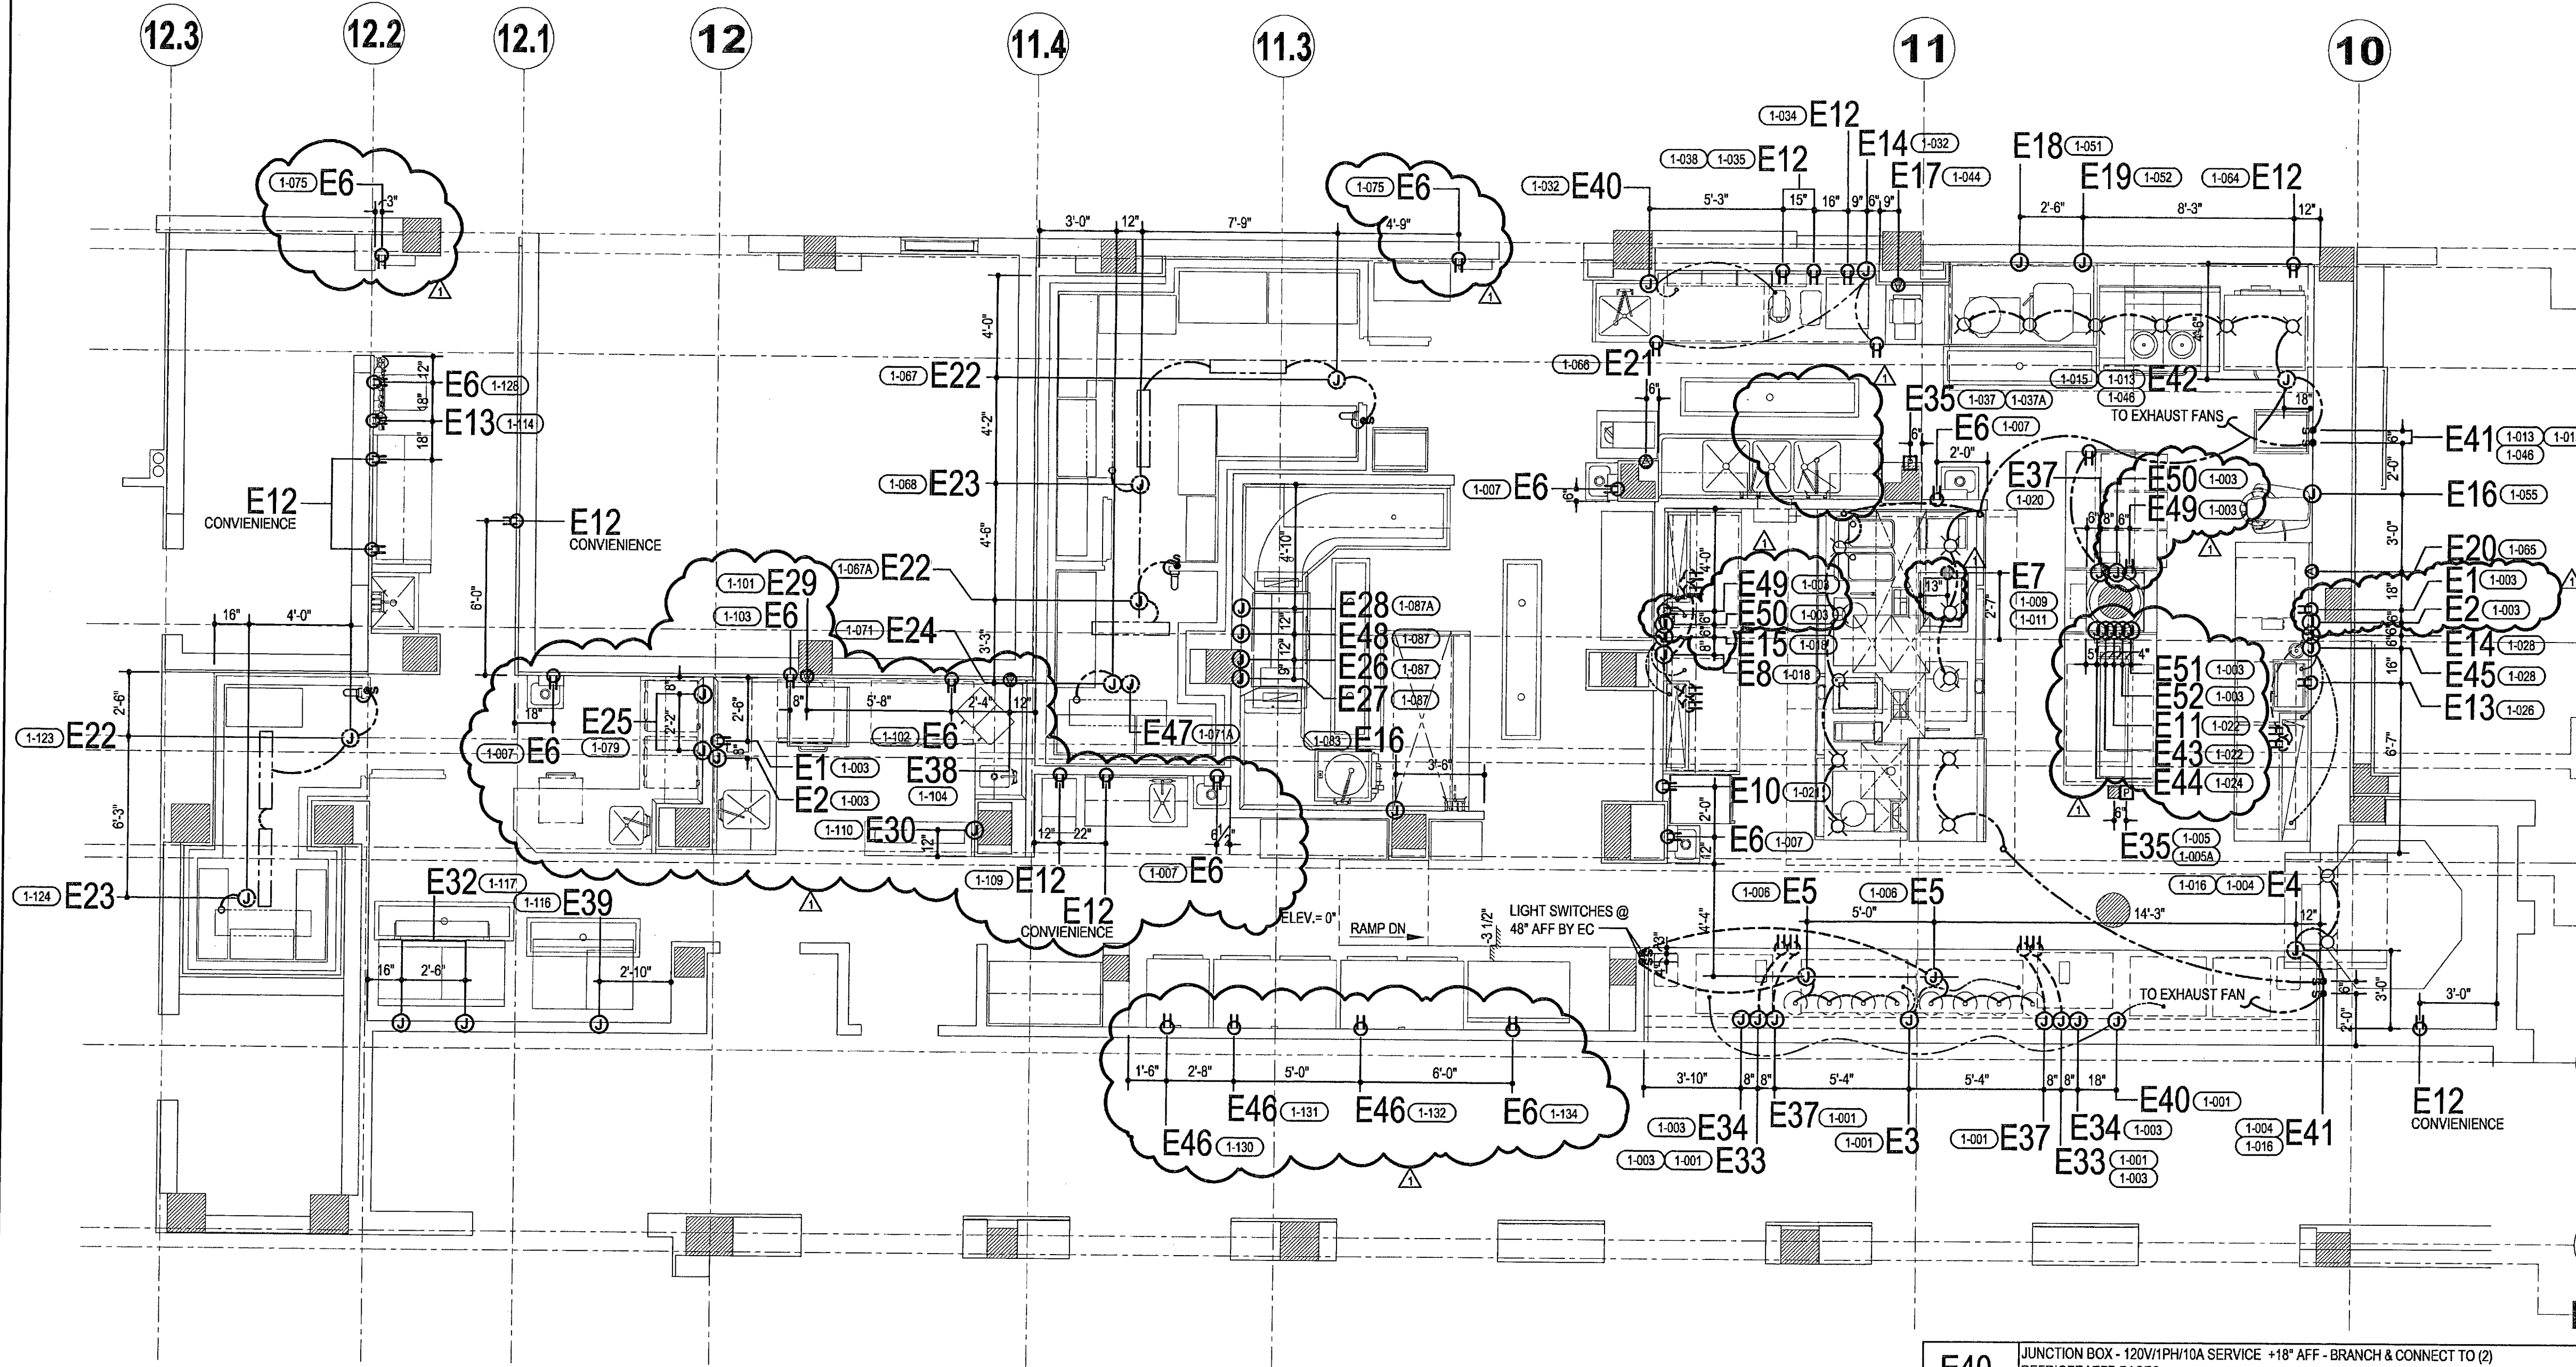



E40	JUNCTION BOX - 120V/1PH/10A SERVICE - +18" AFF - BRANCH & CONNECT TO (2) REFRIGERATED BASES
E41	LIGHT & FAN SWITCHES F/EXHAUST HOOD @ 48" AFF - INTERWIRE TO EXHAUST HOOD(S) & FAN(S) AS REQUIRED
E42	JUNCTION BOX - 120V/1PH/20A SERVICE - DOWN FROM ABOVE TO TOP OF EXHAUST HOOD - CONNECT & INTERWIRE TO LIGHT FIXTURES & CAPTURE JET FANS AS REQUIRED
E43	JUNCTION BOX - 120V/1PH/10A SERVICE - ABOVE FINISHED CEILING - WIRE DOWN UTILITY CHASE - BRANCH & CONNECT TO REFRIGERATED BASE & REFRIGERATED INGREDIENT RAIL AS REQUIRED
E44	JUNCTION BOX - 120V/1PH/20A SERVICE - ABOVE FINISHED CEILING - WIRE DOWN UTILITY CHASE & CONNECT TO EQUIPMENT
E45	JUNCTION BOX - 120V/1PH/15A SERVICE - +18" AFF - BRANCH & CONNECT TO REFRIGERATED BASE, FREEZER BASE & REFRIGERATED INGREDIENT RAIL AS REQUIRED
E46	DUPLEX RECEPTACLE - 120V/1PH/20A SERVICE - NEMA 5-20R GFCI +90" AFF
E47	JUNCTION BOX, CONDUIT & POWER FEED WIRING BETWEEN DRAIN LINE HEATER & REMOTE REFRIGERATION RACK - STUB @ TOP OF WALK-IN BOX & @ REMOTE REFRIGERATION RACK - CONNECT TO EQUIPMENT AS REQUIRED
E48	JUNCTION BOXES @ DISHWASHER CONTROL PANEL (@+80" AFF) & EXHAUST FAN W/CONDUIT & WIRING F/VENT FAN CONTROL - EC TO CONNECT TO EQUIPMENT & INTERWIRE AS REQUIRED
E49	DUPLEX RECEPTACLE ON DEDICATED CIRCUIT W/ISOLATED GROUND - 120V/1PH/20A SERVICE - NEMA 5-20R +68" AFF
E50	EMPTY JUNCTION BOX & CONDUIT F/ICAT5e COMMUNICATION/DATA CABLE - +68" AFF - VERIFY REQUIREMENTS WITH SUPPLIER
E51	JUNCTION BOX ON DEDICATED CIRCUIT W/ISOLATED GROUND - 120V/1PH/20A SERVICE - ABOVE FINISHED CEILING - WIRE DOWN UTILITY CHASE & CONNECT TO RECEPTACLE MOUNTED IN EQUIPMENT
E52	EMPTY JUNCTION BOX & CONDUIT F/ICAT5e COMMUNICATION/DATA CABLE - ABOVE FINISHED CEILING - WIRE DOWN UTILITY CHASE - VERIFY REQUIREMENTS WITH SUPPLIER

ELECTRICAL ROUGH-IN SCHEDULE

E1	DUPLEX RECEPTACLE ON DEDICATED CIRCUIT W/ISOLATED GROUND - 120V/1PH/20A SERVICE - NEMA 5-20R +50" AFF
E2	EMPTY JUNCTION BOX & CONDUIT F/ICAT5e COMMUNICATION/DATA CABLE - +50" AFF - VERIFY REQUIREMENTS WITH SUPPLIER
E3	JUNCTION BOX - 120V/1PH/15A SERVICE +18" AFF - BRANCH & CONNECT TO (2) HEATED PLATE CABINETS
E4	JUNCTION BOX - 120V/1PH/10A SERVICE DOWN FROM ABOVE TO TOP OF EXHAUST HOOD - CONNECT & INTER-WIRE TO LIGHT FIXTURES & CAPTURE JET FANS AS REQUIRED
E5	JUNCTION BOX - 120V/1PH/15A SERVICE ABOVE FINISHED CEILING - PROVIDE WALL SWITCH @ +48" AFF - INTERWIRE & CONNECT TO EQUIPMENT & WALL SWITCH AS REQUIRED
E6	DUPLEX RECEPTACLE - 120V/1PH/20A SERVICE - NEMA 5-20R GFCI +18" AFF
E7	CONDUIT STUB - 120-208V/3PH/200A SERVICE - STUB @ +9" AFF - CONNECT TO CIRCUIT BREAKER PANEL ON EQUIPMENT - SEE SHOP DRAWING FOR PANEL SCHEDULE
E8	MULTI-CIRCUIT JUNCTION BOX - (4) 120V/1PH/20A SERVICES +18" AFF - CONNECT TO CONVENIENCE DUPLEX RECEPTACLES - NEMA 5-20R GFCI - IN EQUIPMENT
E9	NOT USED
E10	(2) DUPLEX RECEPTACLES - 120V/1PH/20A SERVICE - NEMA 5-20R GFCI (1) @ +38" & (1) @ +72" AFF
E11	MULTI-CIRCUIT JUNCTION BOX - (2) 120V/1PH/20A SERVICES ABOVE FINISHED CEILING - WIRE DOWN UTILITY SERVICE CHASE - CONNECT TO CONVENIENCE DUPLEX RECEPTACLES - NEMA 5-20R GFCI MOUNTED IN EQUIPMENT
E12	DUPLEX RECEPTACLE - 120V/1PH/20A SERVICE - NEMA 5-20R GFCI +50" AFF
E13	DUPLEX RECEPTACLE - 120V/1PH/20A SERVICE - NEMA 5-20R GFCI +68" AFF
E14	MULTI-CIRCUIT JUNCTION BOX - (2) 120V/1PH/20A SERVICES +18" AFF - CONNECT TO CONVENIENCE DUPLEX RECEPTACLES - NEMA 5-20R GFCI - IN EQUIPMENT
E15	JUNCTION BOX - 120V/1PH/15A SERVICES +18" AFF - BRANCH & CONNECT TO (2) REFRIGERATED BASES & (2) REFRIGERATED INGREDIENT RAILS AS REQUIRED
E16	JUNCTION BOX - 208V/3PH/10A SERVICE +18" AFF - CONNECT TO EQUIPMENT
E17	SINGLE RECEPTACLE - 208V/3PH/15A SERVICE - NEMA 15-15R +50" AFF
E18	JUNCTION BOX - 208V/3PH/40A SERVICE +50" AFF - CONNECT TO EQUIPMENT
E19	JUNCTION BOX - 208V/3PH/20A SERVICE +50" AFF - CONNECT TO EQUIPMENT
E20	SINGLE RECEPTACLE - 208V/1PH/20A SERVICE - NEMA L8-20R +18" AFF
E21	SINGLE RECEPTACLE - 208V/1PH/20A SERVICE - NEMA 6-20R +50" AFF
E22	JUNCTION BOX - 120V/1PH/10A SERVICE - DOWN FROM ABOVE TO TOP OF WALK-IN COOLER BOX - CONNECT TO JUNCTION BOX AND INTER-WIRE TO LIGHT FIXTURES, DOOR HEATER, & TEMPERATURE ALARM AS REQUIRED
E23	JUNCTION BOX - 120V/1PH/10A SERVICE - DOWN FROM ABOVE TO TOP OF WALK-IN BOX - CONNECT TO EVAPORATOR INSIDE WALK-IN BOX
E24	JUNCTION BOX, CONDUIT & WIRING BETWEEN EVAPORATOR & REMOTE REFRIGERATION RACK UNIT - F/POWER FEED & CONTROL WIRING - STUB @ TOP OF WALK-IN BOX & @ REMOTE REFRIGERATION RACK - CONNECT TO EQUIPMENT AS REQUIRED
E25	JUNCTION BOX - 120-208V/1PH/50A SERVICE +18" AFF - CONNECT TO EQUIPMENT
E26	JUNCTION BOX - 480V/3PH/40A SERVICE +60" AFF - CONNECT TO EQUIPMENT
E27	JUNCTION BOX - 480V/3PH/50A SERVICE +60" AFF - CONNECT TO BOOSTER HEATER ON TOP OF EQUIPMENT
E28	JUNCTION BOX - 208V/1PH/10A SERVICE +18" AFF - CONNECT TO EQUIPMENT
E29	SINGLE RECEPTACLE - 208V/1PH/50A SERVICE - NEMA 6-50R +50" AFF
E30	JUNCTION BOX - 120V/1PH/20A SERVICE +72" AFF - CONNECT TO EQUIPMENT
E31	NOT USED
E32	JUNCTION BOX - 208V/1PH/30A SERVICE +78" AFF - CONNECT TO EQUIPMENT
E33	JUNCTION BOX - 120V/1PH/20A DEDICATED CIRCUIT W/ISOLATED GROUND +18" AFF - CONNECT TO DUPLEX RECEPTACLE MOUNTED IN EQUIPMENT
E34	EMPTY JUNCTION BOX & CONDUIT F/ICAT5e COMMUNICATION/DATA CABLE - +18" AFF - VERIFY REQUIREMENTS WITH SUPPLIER
E35	EMPTY OCTAGON JUNCTION BOX F/FIRE PROTECTION SYSTEM REMOTE PULL STATION - +48" AFF W/SCREW HOLES @ 2 & 8 O'CLOCK POSITIONS - EXTEND 1/2" EMT CONDUIT FROM BOX TO 6" ABOVE FINISHED CEILING - W/NO BENDS
E36	NOT USED
E37	JUNCTION BOX - 120V/1PH/20A SERVICE +18" AFF - CONNECT TO CONVENIENCE DUPLEX RECEPTACLE - NEMA 5-20R GFCI - MOUNTED IN EQUIPMENT
E38	SINGLE RECEPTACLE - 208V/1PH/30A SERVICE - NEMA L8-30R +50" AFF
E39	JUNCTION BOX - 120V/1PH/20A SERVICE +78" AFF - CONNECT TO EQUIPMENT

ELECTRICAL LEGEND

SINGLE RECEPTACLE, NEMA 5-20R	SR	○
DUPLEX RECEPTACLE, NEMA 5-20R	DR	○
QUADRUPLEX RECEPTACLE, NEMA 5-20R	QR	○
SPECIAL RECEPTACLE, 208 OR 480	SFR	○
FLOOR RECEPTACLE	FR	○
JUNCTION BOX	JB	○
DROP CORD OR CONDUIT	DC	○
CONDUIT STUB	C	○
WALL SWITCH	S	○
RECEPTACLE ON EQUIPMENT		○
FIRE PROTECTION SYSTEM REMOTE PULL STATION		○
INCANDESCENT LIGHT FIXTURE		○
FLUORESCENT LIGHT FIXTURE		○
LOAD CENTER IN EQUIPMENT		○
BUILDING LOAD CENTER PANEL		○
POINT OF CONNECTION ON EQUIPMENT		○
ABOVE FINISHED FLOOR	AFF	○
DROP FROM ABOVE	DFA	○
BRANCH TO CONNECTIONS	BTG	○
ELECTRICAL INTERCONNECTIONS		○

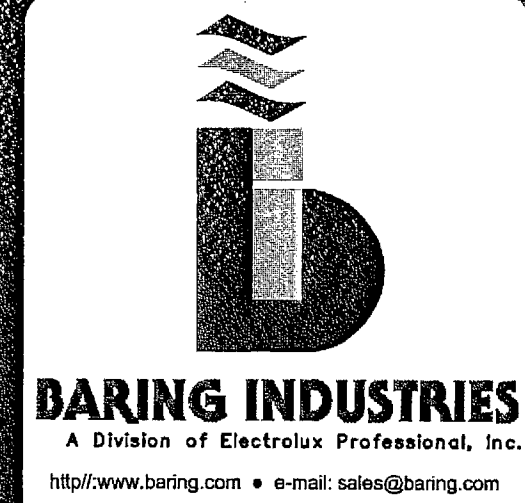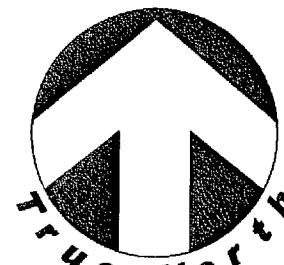

BARING INDUSTRIES
A Division of Electroflux Professional, Inc.

http://www.baring.com • e-mail: sales@baring.com

Corporate Headquarters
Baring Industries
3249 S.W. 42ND STREET
PL. Lauderdale, FL 33312 USA
TELEPHONE (954) 327-6700
FAX: (954) 327-6761

Northeastern Regional Office
Baring Industries
3001 Lincoln Drive West, Suite J
Madison, NJ 08053 USA
TELEPHONE (609) 949-9928
FAX: (609) 949-9102

Midwestern Regional Office
Baring Industries
1208 PINES STREET
Suite 110
Nashville, TN 37203 USA
TELEPHONE (615) 252-2699
FAX: (615) 252-8074

Midwestern Regional Office
Baring Industries
435 Eisenhower Lane South
Lombard, IL 60148 USA
TELEPHONE (815) 920-1110
FAX: (815) 920-1120

Western Regional Office
Baring Industries
11411 Southern Highlands Parkway
Suite 200
Las Vegas, NV 89141 USA
TELEPHONE (702) 385-4418
FAX: (702) 385-4417

SOHO HOUSE

MIAMI BEACH, FLORIDA

FIRST FLOOR
KITCHEN

PROJECT NAME

PROJECT LOCATION

AREA NAME

**ELECTRICAL
ROUGH-IN PLAN**

SHEET TITLE

REVISION: BY: CK BY: DATE:

1	ST	JM	08-28-2009
2			
3			
4			
5			

PROJ. MGR: FRANK MURPHY
COORDINATOR: PATRICIA TEPPER
TELEPHONE: 954-327-6720

DRAWN BY: ST
CHECKED BY: JM
DATE: 08-28-2009
SCALE: 1/4" = 1'-0"


K1-8

PROJECT NUMBER
071152

THIS DRAWING AND ITS CONTENTS ARE THE PROPERTY OF BARING INDUSTRIES, INC. REPRODUCTION, DISTRIBUTION, MODIFICATION IN ANY FORM OR ANY OTHER UNAUTHORIZED USE OF THIS DRAWING WITHOUT THE EXPRESSED WRITTEN CONSENT OF BARING INDUSTRIES, INC. IS PROHIBITED. COPYRIGHT © 2008 BARING INDUSTRIES, INC. ALL RIGHTS RESERVED.

GENERAL NOTES

1. REFER TO THE PROJECT ARCHITECTURAL, ELECTRICAL, INTERIOR DESIGN, MECHANICAL & PLUMBING DRAWINGS FOR ACTUAL CONSTRUCTION CONDITIONS & DETAILS.
2. MANUFACTURER'S SHOP DRAWINGS & SPECIFICATION SHEETS ARE PROVIDED BY BARING INDUSTRIES & ARE TO BE CONSIDERED A PART OF THESE DRAWINGS.
3. BUILDING WALLS & DIMENSIONS MATCH THE ARCHITECTURAL DRAWINGS PROVIDED TO BARS UNLESS OTHERWISE NOTED.
4. THESE DRAWINGS INDICATE THE EXTENT OF WORK INCLUDED IN BARING INDUSTRIES' SCOPE OF WORK & DO NOT NECESSARILY INCLUDE WORK REQUIRED FOR THE FULL PERFORMANCE & COMPLETION OF THE PROJECT CONTRACT DOCUMENTS.
5. UTILITY & CONNECTION REQUIREMENTS & BUILDING SPECIAL CONDITIONS FOR EQUIPMENT NOT PROVIDED BY BARING INDUSTRIES ARE TO BE VERIFIED WITH THE PROVIDER BY THE APPLICABLE GENERAL, ELECTRICAL, MECHANICAL & PLUMBING CONTRACTORS.
6. DIMENSIONS ARE FROM SURFACE OF FINISHED WALLS, FLOORS, CEILINGS & COLUMN CENTERS UNLESS DIMENSIONS ARE TO BE VERIFIED BY ALL CONTRACTORS PRIOR TO COMMENCING ANY WORK.
7. DIMENSIONS ARE CLEAR FINISHED SURFACE TO FINISHED SURFACE UNLESS OTHERWISE NOTED.
8. ALL WORK SHALL BE EXECUTED IN ACCORDANCE WITH APPLICABLE FEDERAL, STATE & LOCAL CODES & ANY GOVERNING OFFICIAL HAVING JURISDICTION.
9. IN THE EVENT IT IS NECESSARY TO DEVIATE FROM BARING INDUSTRIES' DRAWINGS, THE CONTRACTOR SHALL NOTIFY BARING INDUSTRIES IN WRITING PRIOR TO MAKING THE DEVIATION.
10. ELECTRICAL & MECHANICAL UTILITY SERVICES & CONNECTIONS HAVE BEEN LOCATED TO SUIT THE REQUIREMENTS OF THE FOODSERVICE EQUIPMENT.
11. CONNECTION REQUIREMENTS, CONNECTED LOAD & CONSUMPTION VALUES IN THE EQUIPMENT SCHEDULE ARE FOR (1) UNIT. TO DETERMINE THE TOTAL REQUIREMENTS, MULTIPLY BY THE QUANTITY IN THE EQUIPMENT SCHEDULE.
12. ROUGH-IN SIZES & LOCATIONS SHOWN IN THESE DRAWINGS ARE BASED ON INFORMATION PROVIDED TO BARING ACTUAL SIZES & LOCATIONS MAY VARY DEPENDING ON PREVAILING CODES, STANDARDS & SITE CONDITIONS.
13. QUANTITY TILES FLOORS SHALL BE ACID WASHED & THOROUGHLY FLUSHED WITH CLEAN WATER PRIOR TO THE DELIVERY & SET-IN PLACE OF ANY FOODSERVICE EQUIPMENT. DAMAGE CAUSED BY ACID BASED CLEANING/ETCHING AGENTS ARE NOT COVERED UNDER ANY WARRANTY.
14. THE GENERAL CONTRACTOR SHALL PROVIDE PENETRATIONS & OPENINGS SIZED TO FIT EQUIPMENT SHOWN IN THESE DRAWINGS.
15. PRIOR TO DELIVERY & SET-IN PLACE OF ANY FOODSERVICE EQUIPMENT, THE GENERAL CONTRACTOR SHALL PROVIDE THE FOLLOWING MINIMUM BUILDING READINESS ITEMS:
 - A. CEILING GRID INSTALLED.
 - B. LIGHTING FIXTURES INSTALLED & WIRED.
 - C. HVAC DIFFUSERS & DUCTWORK INSTALLED.
 - D. FLOOR ACID WASHED & BROOM WASHED.
 - E. WALL FINISHES INSTALLED ON EXPOSED WALL SURFACES.
 - F. ELECTRICAL WIRING PULLED TO ROUGH-IN LOCATIONS SHOWN IN THESE DRAWINGS.
 - G. PLUMBING PIPING INSTALLED TO ROUGH-IN LOCATIONS SHOWN IN THESE DRAWINGS.
 - H. GAS, STEAM & WATER PIPING PRESSURE TESTED & FLUSHED FREE OF FOREIGN MATTER.

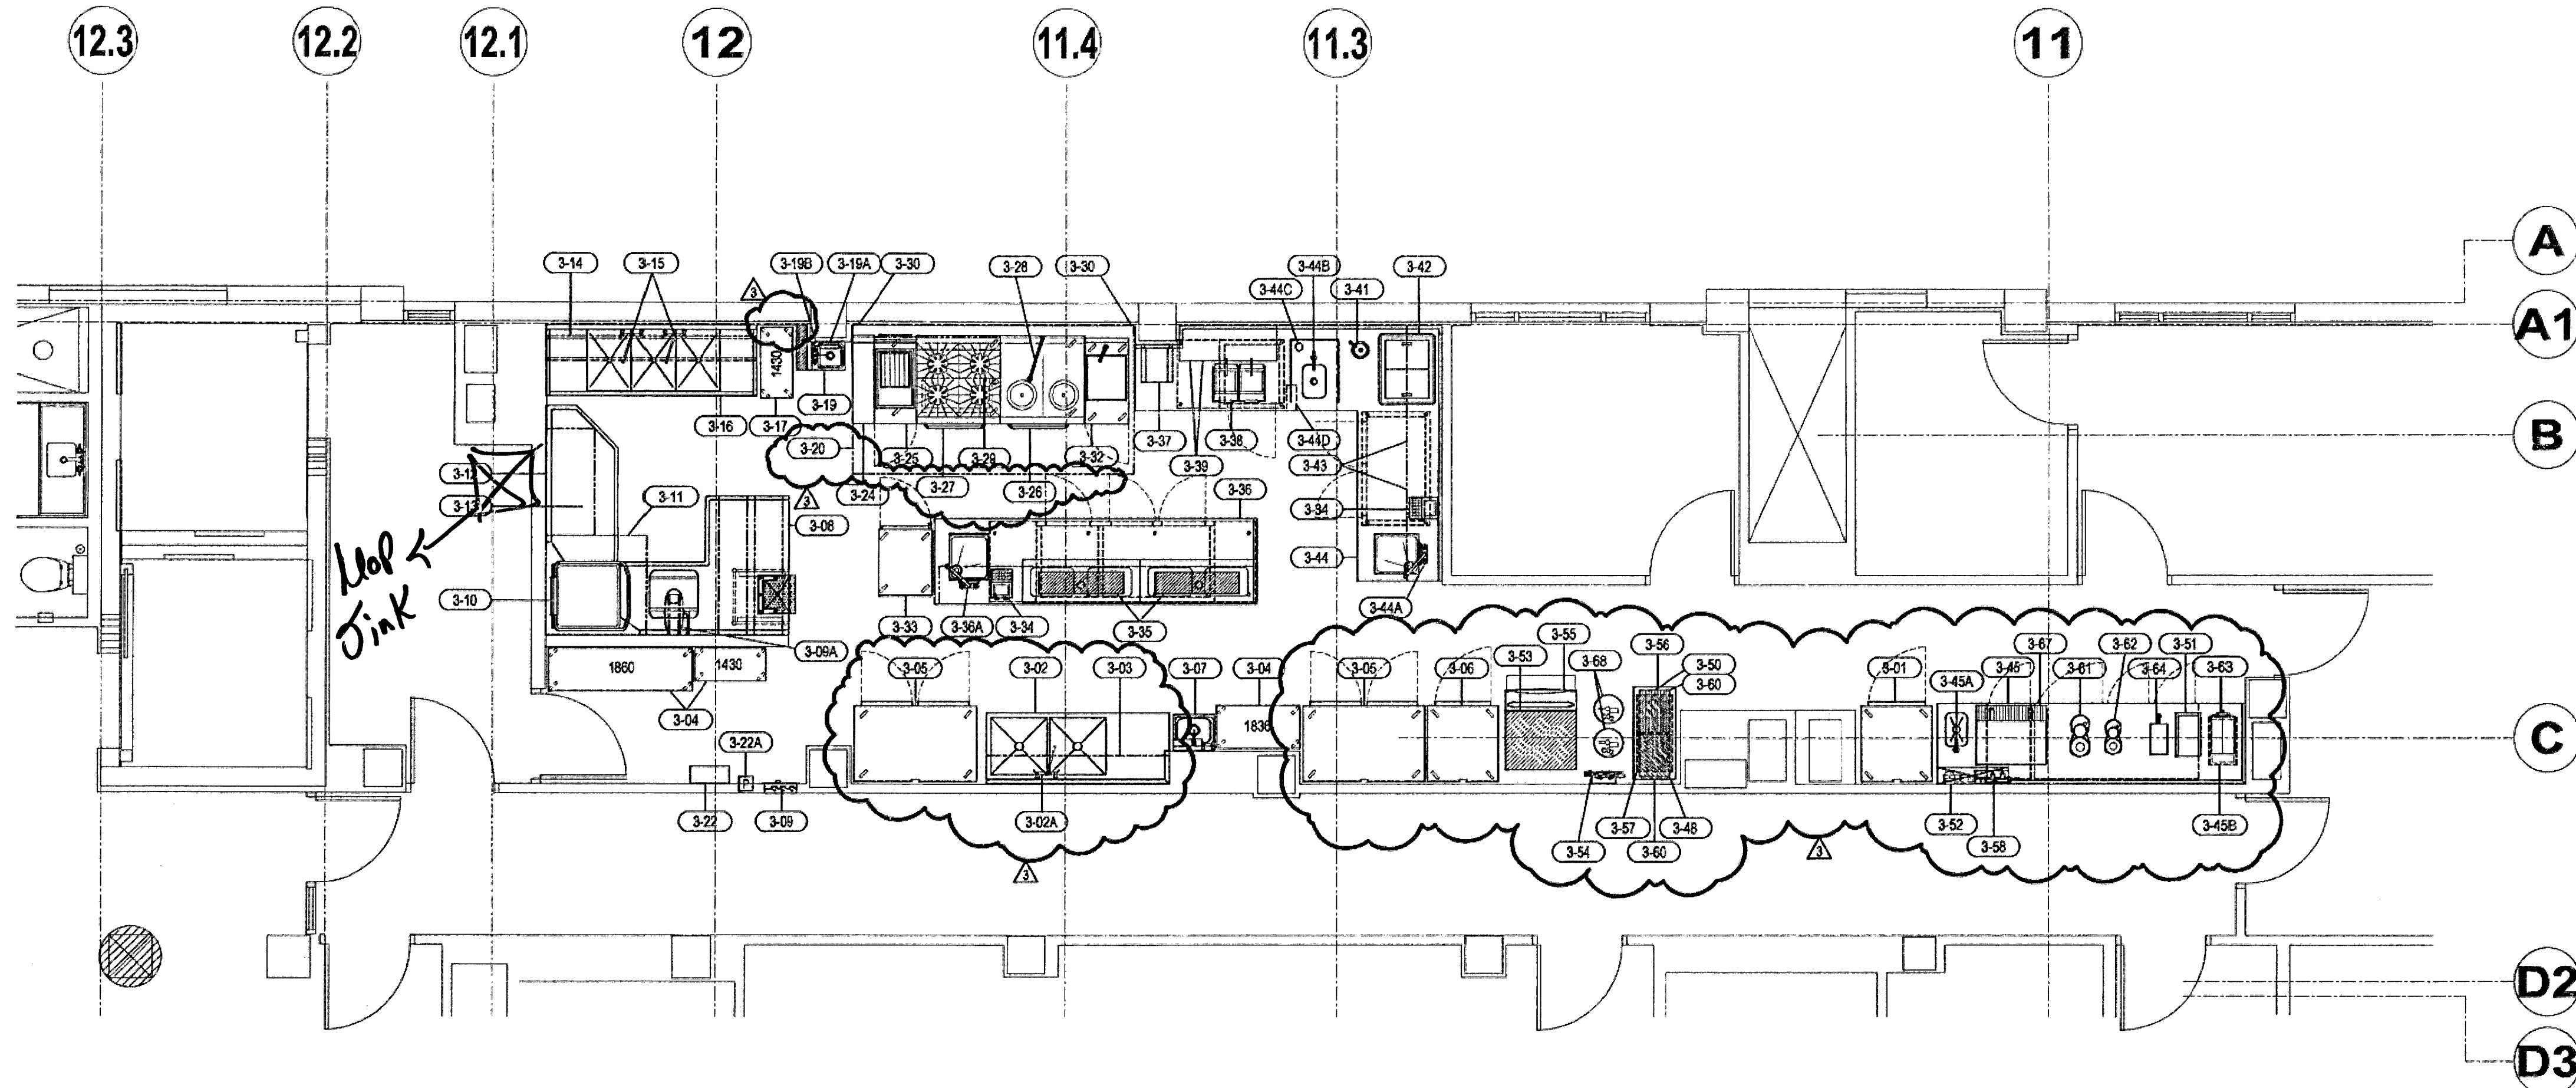

FOOD SERVICE PLAN APPROVED
 10/12/2009
 10/12/2009

FOOD SERVICE PLAN APPROVED
 10/12/2009
 10/12/2009



BARING INDUSTRIES
 A Division of Electrolux Professional, Inc.
 http://www.baring.com • e-mail: sales@baring.com

Corporate Headquarters
 Baring Industries
 3945 S.W. 42ND STREET
 Ft. Lauderdale, FL 33312 USA
 TELEPHONE: (954) 327-6700
 FAX: (954) 327-6761

Northeastern Regional Office
 Baring Industries
 3001 Lincoln Drive West, Suite J
 Murton, NJ 08053 USA
 TELEPHONE: (609) 968-6926
 FAX: (609) 968-0152

Mideastern Regional Office
 Baring Industries
 1205 PINES STREET
 Suite 100
 Nashville, TN 37203 USA
 TELEPHONE: (615) 262-8089
 FAX: (615) 262-8074

Midwestern Regional Office
 Baring Industries
 435 Eisenhower Ave. South
 Lombard, IL 60148 USA
 TELEPHONE: (630) 620-1110
 FAX: (630) 620-1100

Western Regional Office
 Baring Industries
 11411 Southern Highlands Parkway
 Suite 220
 Las Vegas, NV 89141 USA
 TELEPHONE: (702) 385-4416
 FAX: (702) 385-4417

SOHO HOUSE
 MIAMI BEACH, FLORIDA
 SEVENTH FLOOR
 KITCHEN

PROJECT NAME
 PROJECT LOCATION
 AREA NAME

EQUIPMENT PLAN

SHEET TITLE

REVISION	BY	CK BY	DATE
1	ST	JM	02-23-2009
2	JRL	JM	04-23-2009
3	ST	MGP	07-09-2009
4			
5			


PROJ. MGR: FRANK MURPHY
 COORDINATOR: PATRICIA TEPPER
 TELEPHONE: 954-327-6720
 DRAWN BY: ST
 CHECKED BY: JM
 DATE: 02-27-2009
 SCALE: 1/4" = 1'-0"

SHEET
K3-2
 PROJECT NUMBER
071152

GENERAL NOTES

- REFER TO THE PROJECT ARCHITECTURAL, ELECTRICAL, INTERIOR DESIGN, MECHANICAL, & PLUMBING DRAWINGS FOR ACTUAL CONSTRUCTION CONDITIONS & DETAILS.
- MANUFACTURER'S SHOP DRAWINGS & SPECIFICATION SHEETS ARE PROVIDED BY BARING INDUSTRIES & ARE TO BE CONSIDERED A PART OF THESE DRAWINGS.
- BUILDING WALLS & DIMENSIONS MATCH THE ARCHITECTURAL DRAWINGS PROVIDED TO BARING UNLESS OTHERWISE NOTED.
- THESE DRAWINGS INDICATE THE EXTENT OF WORK INCLUDED IN BARING INDUSTRIES' SCOPE OF WORK & DO NOT NECESSARILY INCLUDE WORK REQUIRED FOR THE FULL PERFORMANCE & COMPLETION OF THE PROJECT CONTRACT DOCUMENTS.
- UTILITY & CONNECTION REQUIREMENTS & BUILDING SPECIAL CONDITIONS FOR EQUIPMENT NOT PROVIDED BY BARING INDUSTRIES ARE TO BE VERIFIED WITH THE PROVIDER BY THE APPLICABLE GENERAL, ELECTRICAL, MECHANICAL, & PLUMBING CONTRACTORS.
- DIMENSIONS ARE FROM SURFACE OF FINISHED WALLS, FLOORS, CEILINGS & COLUMN CENTERLINES. DIMENSIONS ARE TO BE VERIFIED BY ALL CONTRACTORS PRIOR TO COMMENCING ANY WORK.
- DIMENSIONS ARE CLEAR FINISHED SURFACE TO FINISHED SURFACE UNLESS OTHERWISE NOTED.
- ALL WORK SHALL BE EXECUTED IN ACCORDANCE WITH APPLICABLE FEDERAL, STATE & LOCAL CODES & ANY GOVERNING OFFICIAL HAVING JURISDICTION.
- IN THE EVENT IT IS NECESSARY TO DEVIATE FROM BARING'S DRAWINGS, THE CONTRACTOR SHALL NOTIFY BARING INDUSTRIES IN WRITING PRIOR TO MAKING THE DEVIATION.
- ELECTRICAL & MECHANICAL UTILITY SERVICES & CONNECTIONS HAVE BEEN LOCATED TO SUIT THE REQUIREMENTS OF THE FOODSERVICE EQUIPMENT.
- CONNECTION REQUIREMENTS, CONNECTED LOAD & CONSUMPTION VALUES IN THE EQUIPMENT SCHEDULE ARE FOR (1) UNIT. TO DETERMINE THE TOTAL REQUIREMENTS, MULTIPLY BY THE QUANTITY IN THE EQUIPMENT SCHEDULE.
- ROUGH-IN SIZES & LOCATIONS SHOWN IN THESE DRAWINGS ARE BASED ON INFORMATION PROVIDED TO BARING. ACTUAL SIZES & LOCATIONS MAY VARY DEPENDING ON PREVAILING CODES, STANDARDS & SITE CONDITIONS.
- QUARRY TILE FLOORS SHALL BE ACID WASHED & THOROUGHLY FLUSHED WITH CLEAN WATER PRIOR TO THE DELIVERY & SET-IN-PLACE OF ANY FOODSERVICE EQUIPMENT. DAMAGE CAUSED BY ACID BASED CLEANING/ETCHING AGENTS ARE NOT COVERED UNDER ANY WARRANTY.
- THE GENERAL CONTRACTOR SHALL PROVIDE PENETRATIONS & OPENINGS SIZED TO FIT EQUIPMENT SHOWN IN THESE DRAWINGS.
- PRIOR TO DELIVERY & SET-IN-PLACE OF ANY FOODSERVICE EQUIPMENT, THE GENERAL CONTRACTOR SHALL PROVIDE THE FOLLOWING MINIMUM BUILDING READINESS ITEMS:

- CEILING GRIDS INSTALLED.
- LIGHTING FIXTURES INSTALLED & WIRED.
- HVAC DIFFUSERS & DUCTWORK INSTALLED.
- FLOOR ACID WASHED & BROOM SWEEP.
- WALL FINISHES INSTALLED ON EXPOSED WALL SURFACES.
- ELECTRICAL WIRING PULLED TO ROUGH-IN LOCATIONS SHOWN IN THESE DRAWINGS.
- PLUMBING PIPING INSTALLED TO ROUGH-IN LOCATIONS SHOWN IN THESE DRAWINGS.
- GAS, STEAM & WATER PIPING PRESSURE TESTED & FLUSHED FREE OF FOREIGN MATTER.

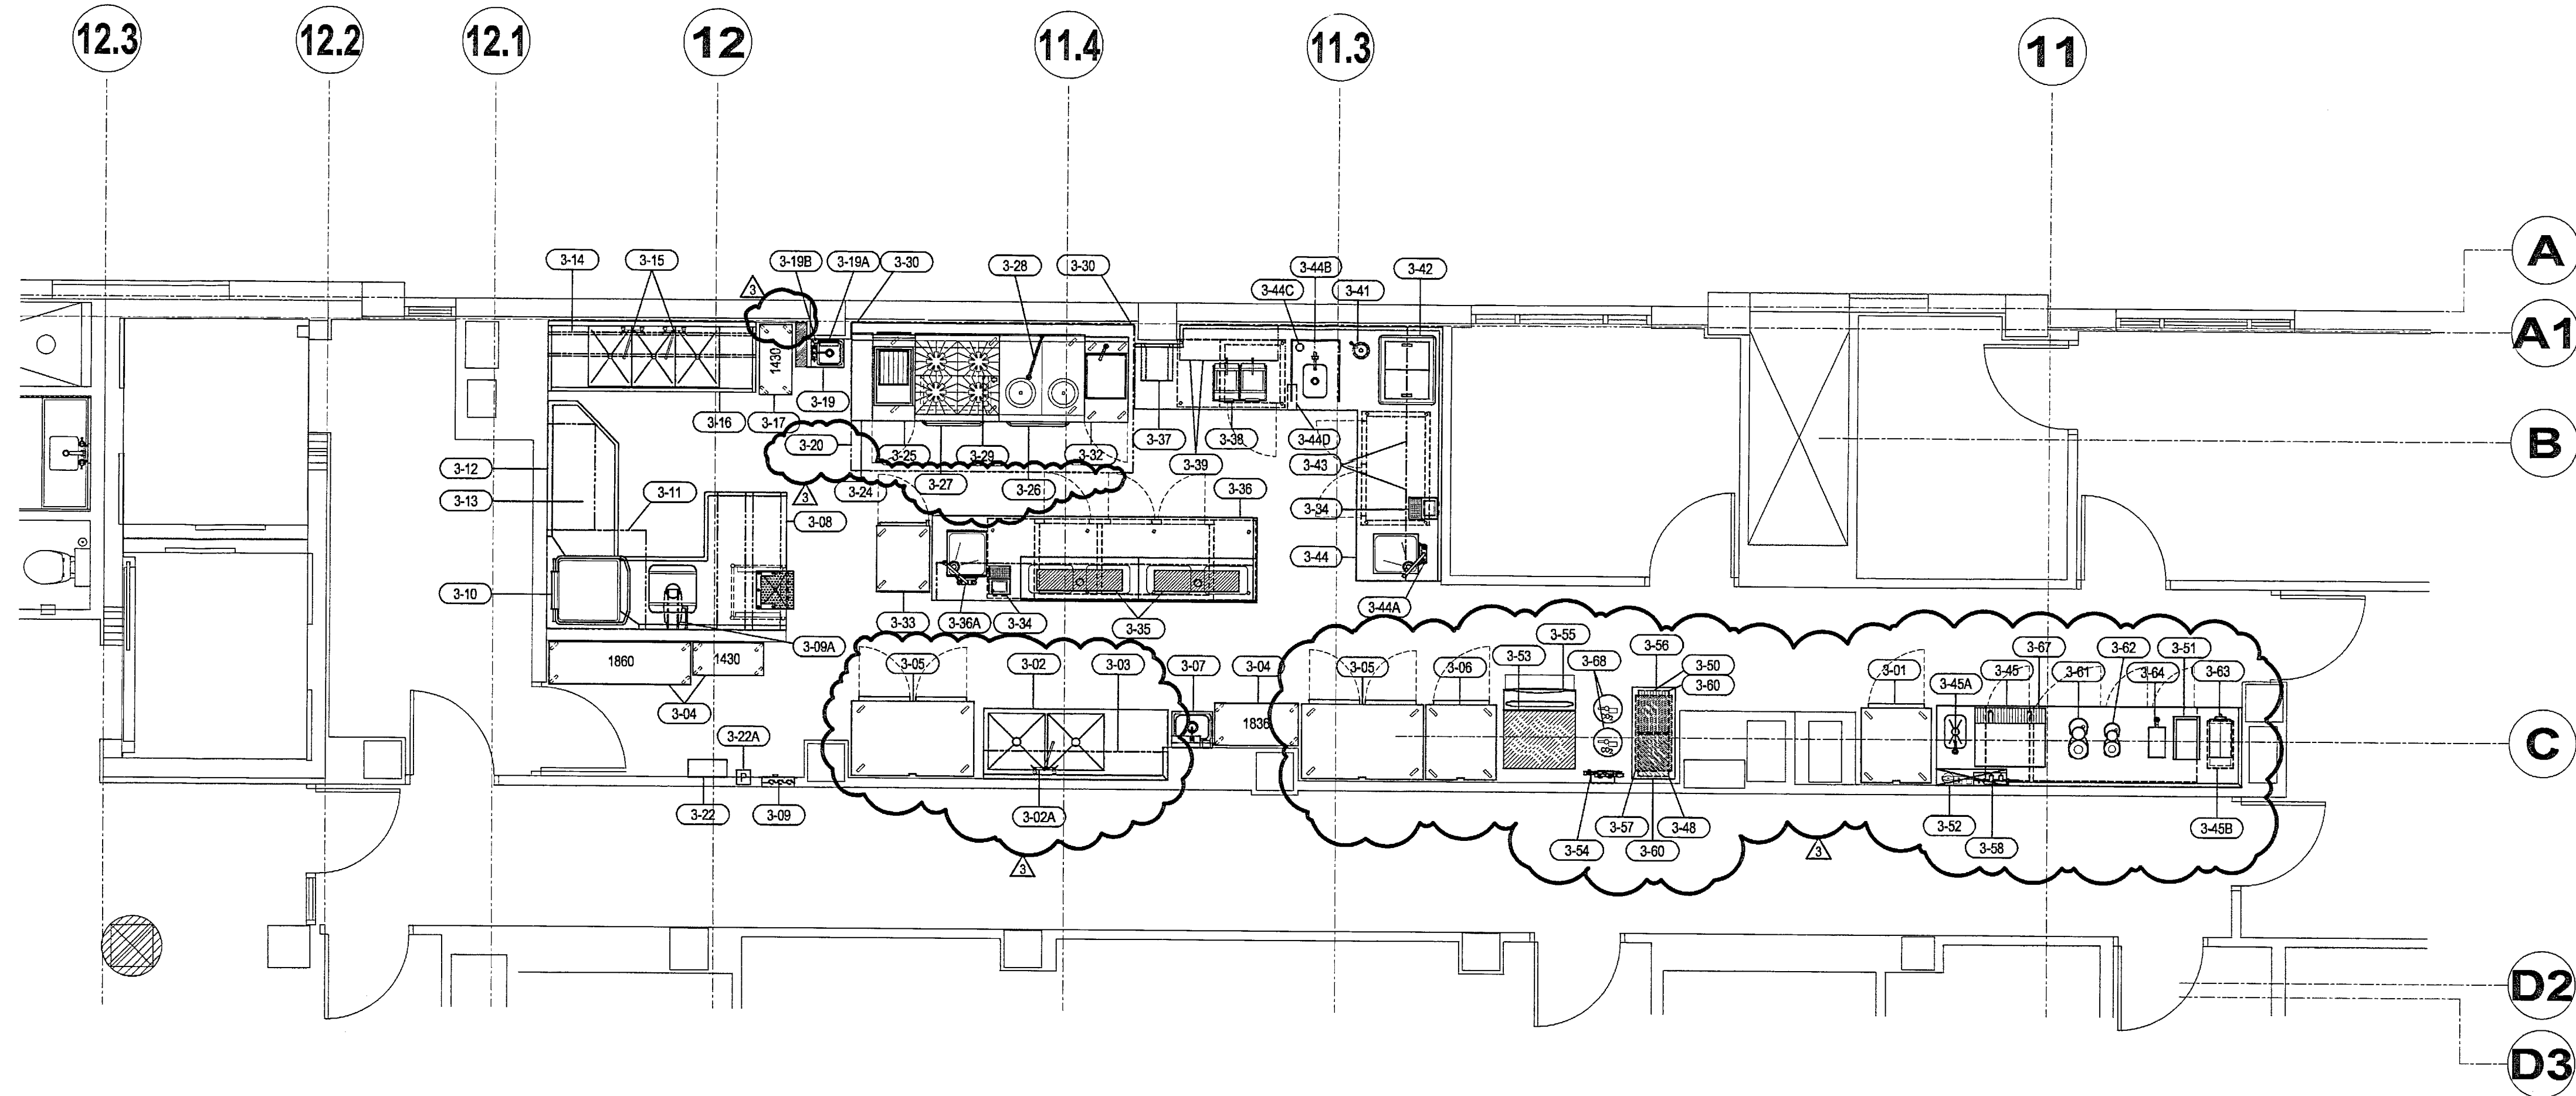

BARING INDUSTRIES
A Division of Electrolux Professional, Inc.
http://www.baring.com • e-mail: sales@baring.com

Corporate Headquarters
Baring Industries
3249 S.W. 42ND STREET
FL. LAUDERDALE, FL 33312 USA
TELEPHONE: (954) 327-6700
FAX: (954) 327-6781

Northeastern Regional Office
Baring Industries
3501 Lincoln Drive West, Suite J
Metairie, LA 70005 USA
TELEPHONE: (850) 888-8926
FAX: (850) 888-8927

Midwestern Regional Office
Baring Industries
1209 PINES STREET
Suite 100
Nashville, TN 37203 USA
TELEPHONE: (615) 252-8089
FAX: (615) 252-8074

Midwestern Regional Office
Baring Industries
435 Eisenhower Lane South
Lombard, IL 60148 USA
TELEPHONE: (815) 850-1110
FAX: (815) 850-1120

Western Regional Office
Baring Industries
11411 Southern Highlands Parkway
Suite 220
Las Vegas, NV 89141 USA
TELEPHONE: (702) 386-4416
FAX: (702) 386-4417

SOHO HOUSE

MIAMI BEACH, FLORIDA

**SEVENTH FLOOR
KITCHEN**

PROJECT NAME

PROJECT LOCATION

AREA NAME

EQUIPMENT PLAN

SHEET TITLE

REVISION	BY:	CK BY:	DATE:
1	ST	JM	03-23-2003
2	JRL	JM	04-23-2009
3	ST	MGP	07-08-2009
4			
5			


PROJ. MGR: FRANK MURPHY
COORDINATOR: PATRICIA TEPPER
TELEPHONE: 954-327-6720
DRAWN BY: ST
CHECKED BY: JM
DATE: 02-27-2009
SCALE: 1/4" = 1'-0"

SHEET


K3-2

PROJECT NUMBER


071152

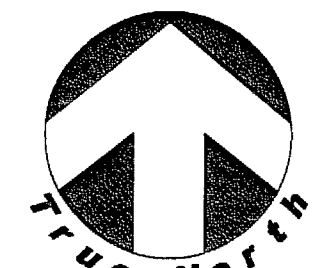

THIS DRAWING AND ITS CONTENTS ARE THE PROPERTY OF BARING INDUSTRIES, INC. REPRODUCTION, DISTRIBUTION, MODIFICATION IN ANY FORM OR ANY OTHER UNAUTHORIZED USE OF THIS DRAWING WITHOUT THE EXPRESSED WRITTEN CONSENT OF BARING INDUSTRIES, INC. IS PROHIBITED. COPYRIGHT © 2008 BARING INDUSTRIES, INC. ALL RIGHTS RESERVED.

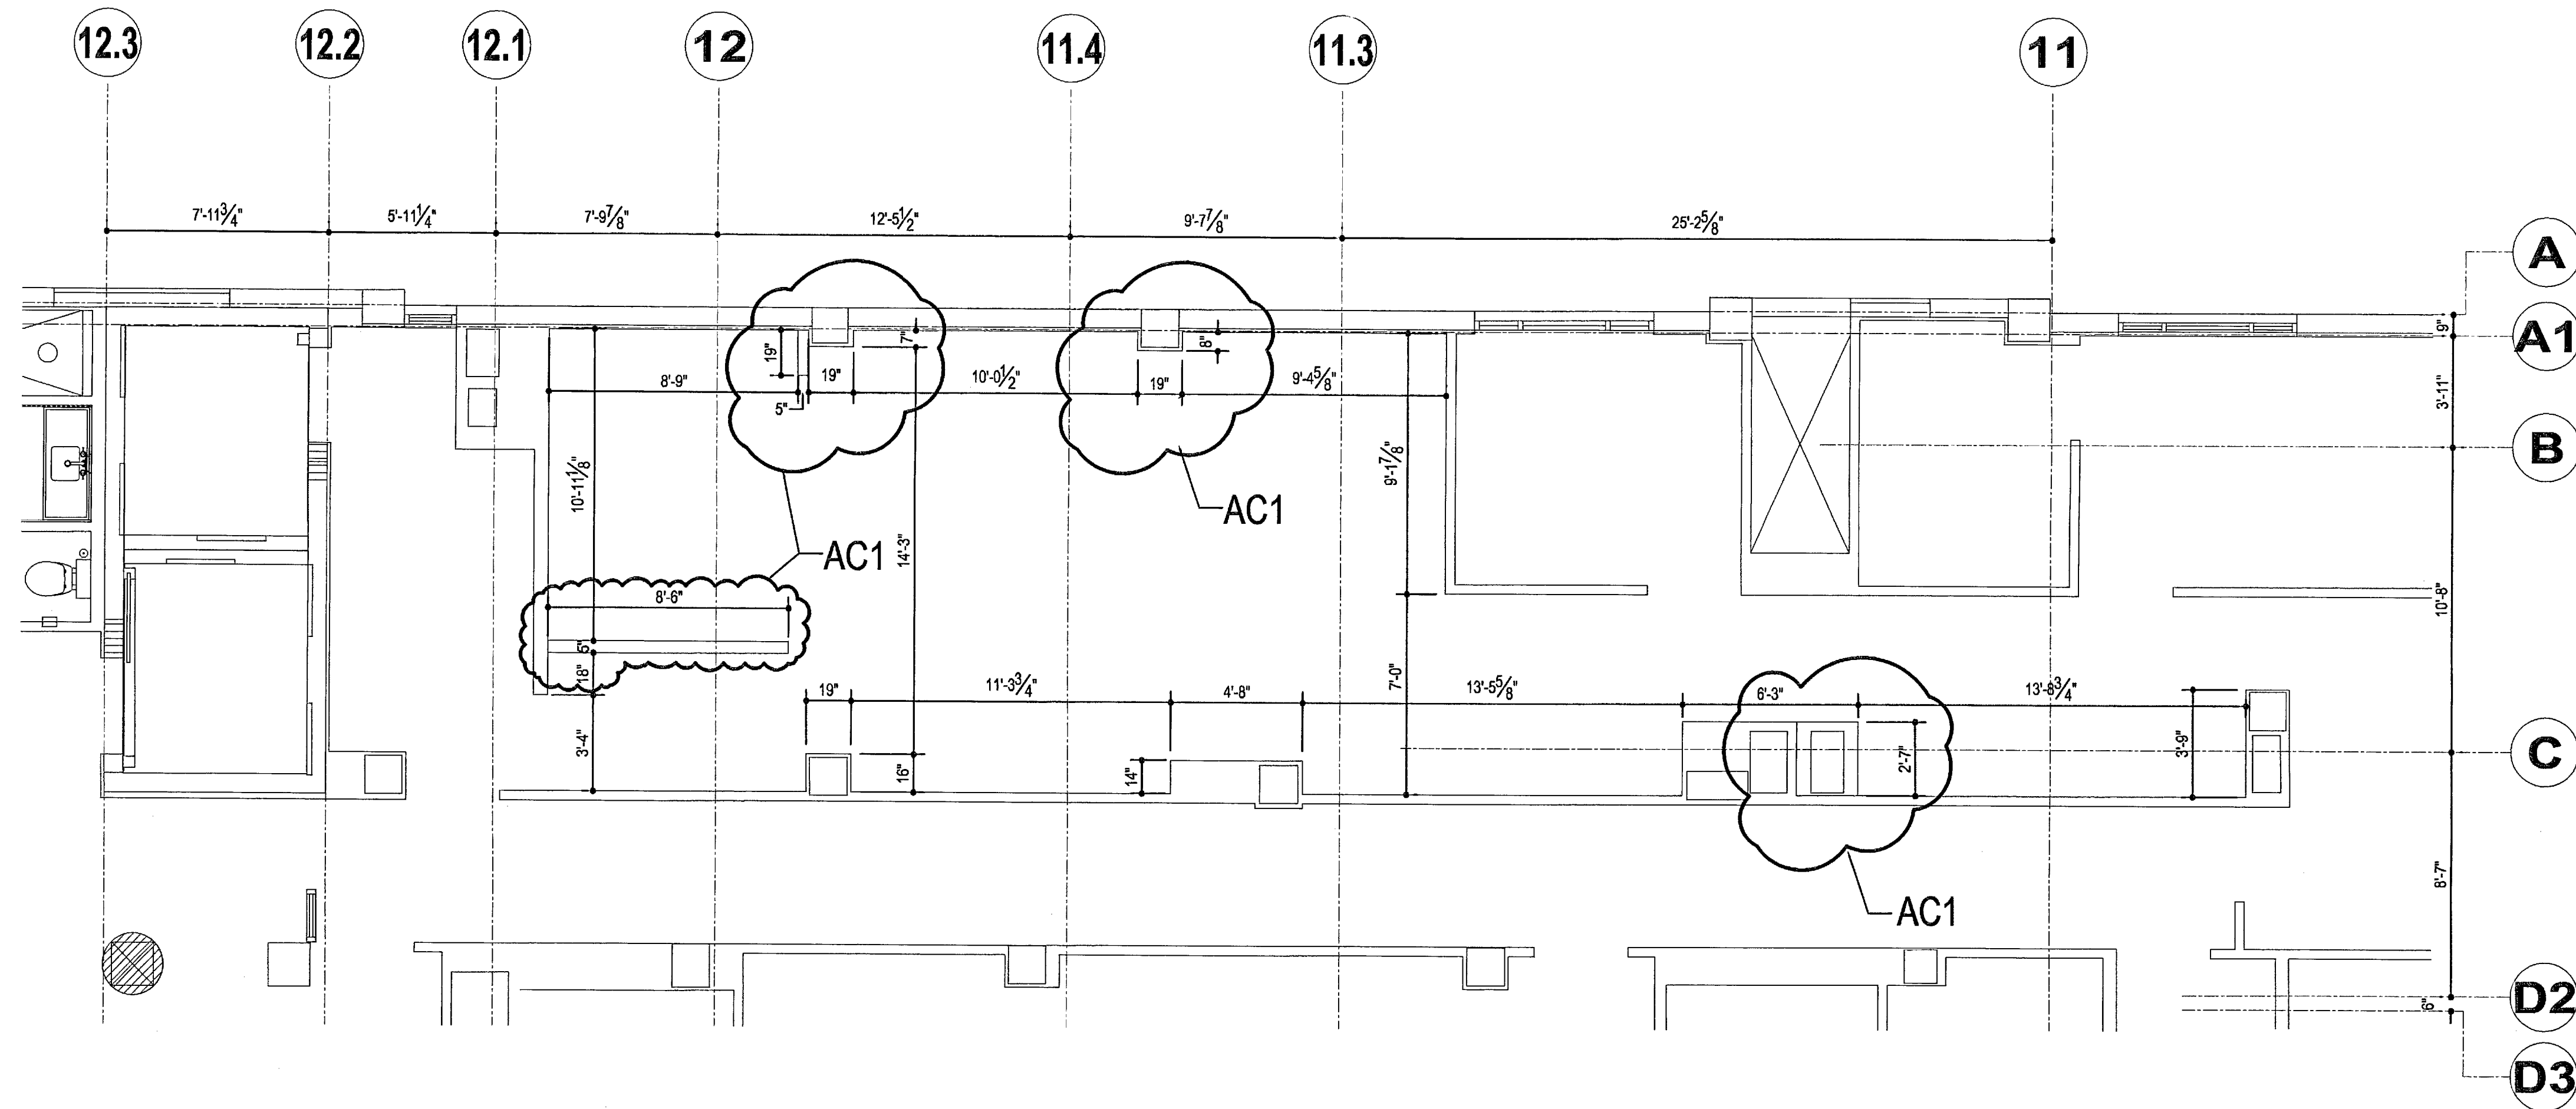

ARCHITECTURAL NOTES	
AC1	BUILDING WALLS IN THIS AREA VARY FROM THE ARCHITECTURAL DRAWINGS TO ACCOMMODATE THE FOODSERVICE EQUIPMENT

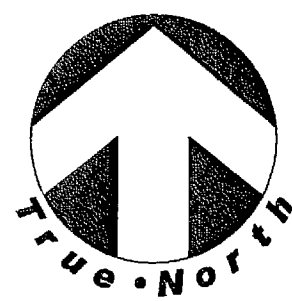

BARING INDUSTRIES
A Division of Electrolux Professional, Inc.
http://www.baring.com • e-mail: sales@baring.com

• **Corporate Headquarters**
Baring Industries
3245 S.W. 42ND STREET
FL Lauderdale, FL 33312 USA
TELEPHONE (954) 327-6700
FAX (954) 327-6761

Northeastern Regional Office
Baring Industries
3001 Lincoln Drive West, Suite J
Marion, NJ 08033 USA
TELEPHONE (856) 988-8928
FAX (856) 988-0152

Midwestern Regional Office
Baring Industries
1208 PINES STREET
Suite 100
Nashville, TN 37203 USA
TELEPHONE (615) 252-8099
FAX (615) 252-8076

Midwestern Regional Office
Baring Industries
435 Eisenhower Lane South
Lombard, IL 60148 USA
TELEPHONE (830) 820-1110
FAX (830) 820-1120

Western Regional Office
Baring Industries
11411 Southern Highlands Parkway
Suite 220
Las Vegas, NV 89141 USA
TELEPHONE (702) 385-4416
FAX (702) 385-4417

SOHO HOUSE

MIAMI BEACH, FLORIDA

SEVENTH FLOOR KITCHEN

ARCHITECTURAL PLAN

REVISION: BY: CK BY: DATE:

1	ST	JM	03-23-2009
2	JRL	JM	04-23-2009
3	ST	MGP	07-08-2009
4			
5			


PROJ. MGR: FRANK MURPHY
COORDINATOR: PATRICIA TEPPER
TELEPHONE: 954-327-6720
DRAWN BY: ST
CHECKED BY: JM
DATE: 02-27-2009
SCALE: 1/4" = 1'-0"

SHEET
K3-3
PROJECT NUMBER
071152

THIS DRAWING AND ITS CONTENTS ARE THE PROPERTY OF BARING INDUSTRIES, INC. REPRODUCTION, DISTRIBUTION, MODIFICATION IN ANY FORM OR ANY OTHER, UNAUTHORIZED USE OF THIS DRAWING WITHOUT THE EXPRESSED WRITTEN CONSENT OF BARING INDUSTRIES, INC. IS PROHIBITED. COPYRIGHT © 2008 BARING INDUSTRIES, INC. ALL RIGHTS RESERVED.

SPECIAL CONDITIONS NOTES

1. CONCRETE & MASONRY BASES & CURBS SHALL BE PROVIDED BY THE GENERAL CONTRACTOR & SHALL BE TROWEL SMOOTH & LEVEL +/- 1/8".
2. WALL BACKING SUITABLE FOR SUPPORTING WALL-MOUNTED EQUIPMENT PROVIDED & INSTALLED BY THE GENERAL CONTRACTOR.
3. SLEEVES PENETRATING ANY WALL, FLOOR OR ROOF SHALL BE PROVIDED & INSTALLED BY THE GENERAL CONTRACTOR IN ACCORDANCE WITH APPLICABLE CODE(S) & ANY GOVERNING OFFICIAL HAVING JURISDICTION.
4. BEVERAGE CONDUIT RUNS SHOWN ARE SCHEMATIC. PROVIDER TO VERIFY ROUTING, MATERIAL, DIAMETERS & PULL BOX REQUIREMENTS WITH BEVERAGE SYSTEM CONTRACTOR(S) PRIOR TO INSTALLING CONDUIT.
5. DEPRESSIONS & PITS FOR WALK-IN BOXES SHALL BE TROWEL SMOOTH & LEVEL +/- 1/8".
6. FINISHED FLOOR SURFACES UNDER ROLL-IN EQUIPMENT SHALL BE LEVEL +/- 1/8".
7. WALL SURFACES AROUND RECESSED CONTROL PANELS SHALL BE LEFT OPEN & UNFINISHED UNTIL THE CONTROL PANELS HAVE BEEN INSTALLED.
8. UNLESS OTHERWISE NOTED IN THESE DRAWINGS, CURBS/RAISERS/DUNNAGE FOR ROOF-MOUNTED EQUIPMENT SHALL BE PROVIDED & INSTALLED BY THE GENERAL CONTRACTOR IN ACCORDANCE WITH APPLICABLE CODE(S) & ANY GOVERNING OFFICIAL HAVING JURISDICTION.
9. UNLESS OTHERWISE NOTED IN THESE DRAWINGS BUILDING STRUCTURAL SUPPORT SUITABLE FOR SUPPORTING CEILING SUSPENDED EQUIPMENT SHALL BE PROVIDED & INSTALLED BY THE GENERAL CONTRACTOR IN ACCORDANCE WITH APPLICABLE CODE(S) & ANY GOVERNING OFFICIAL HAVING JURISDICTION.

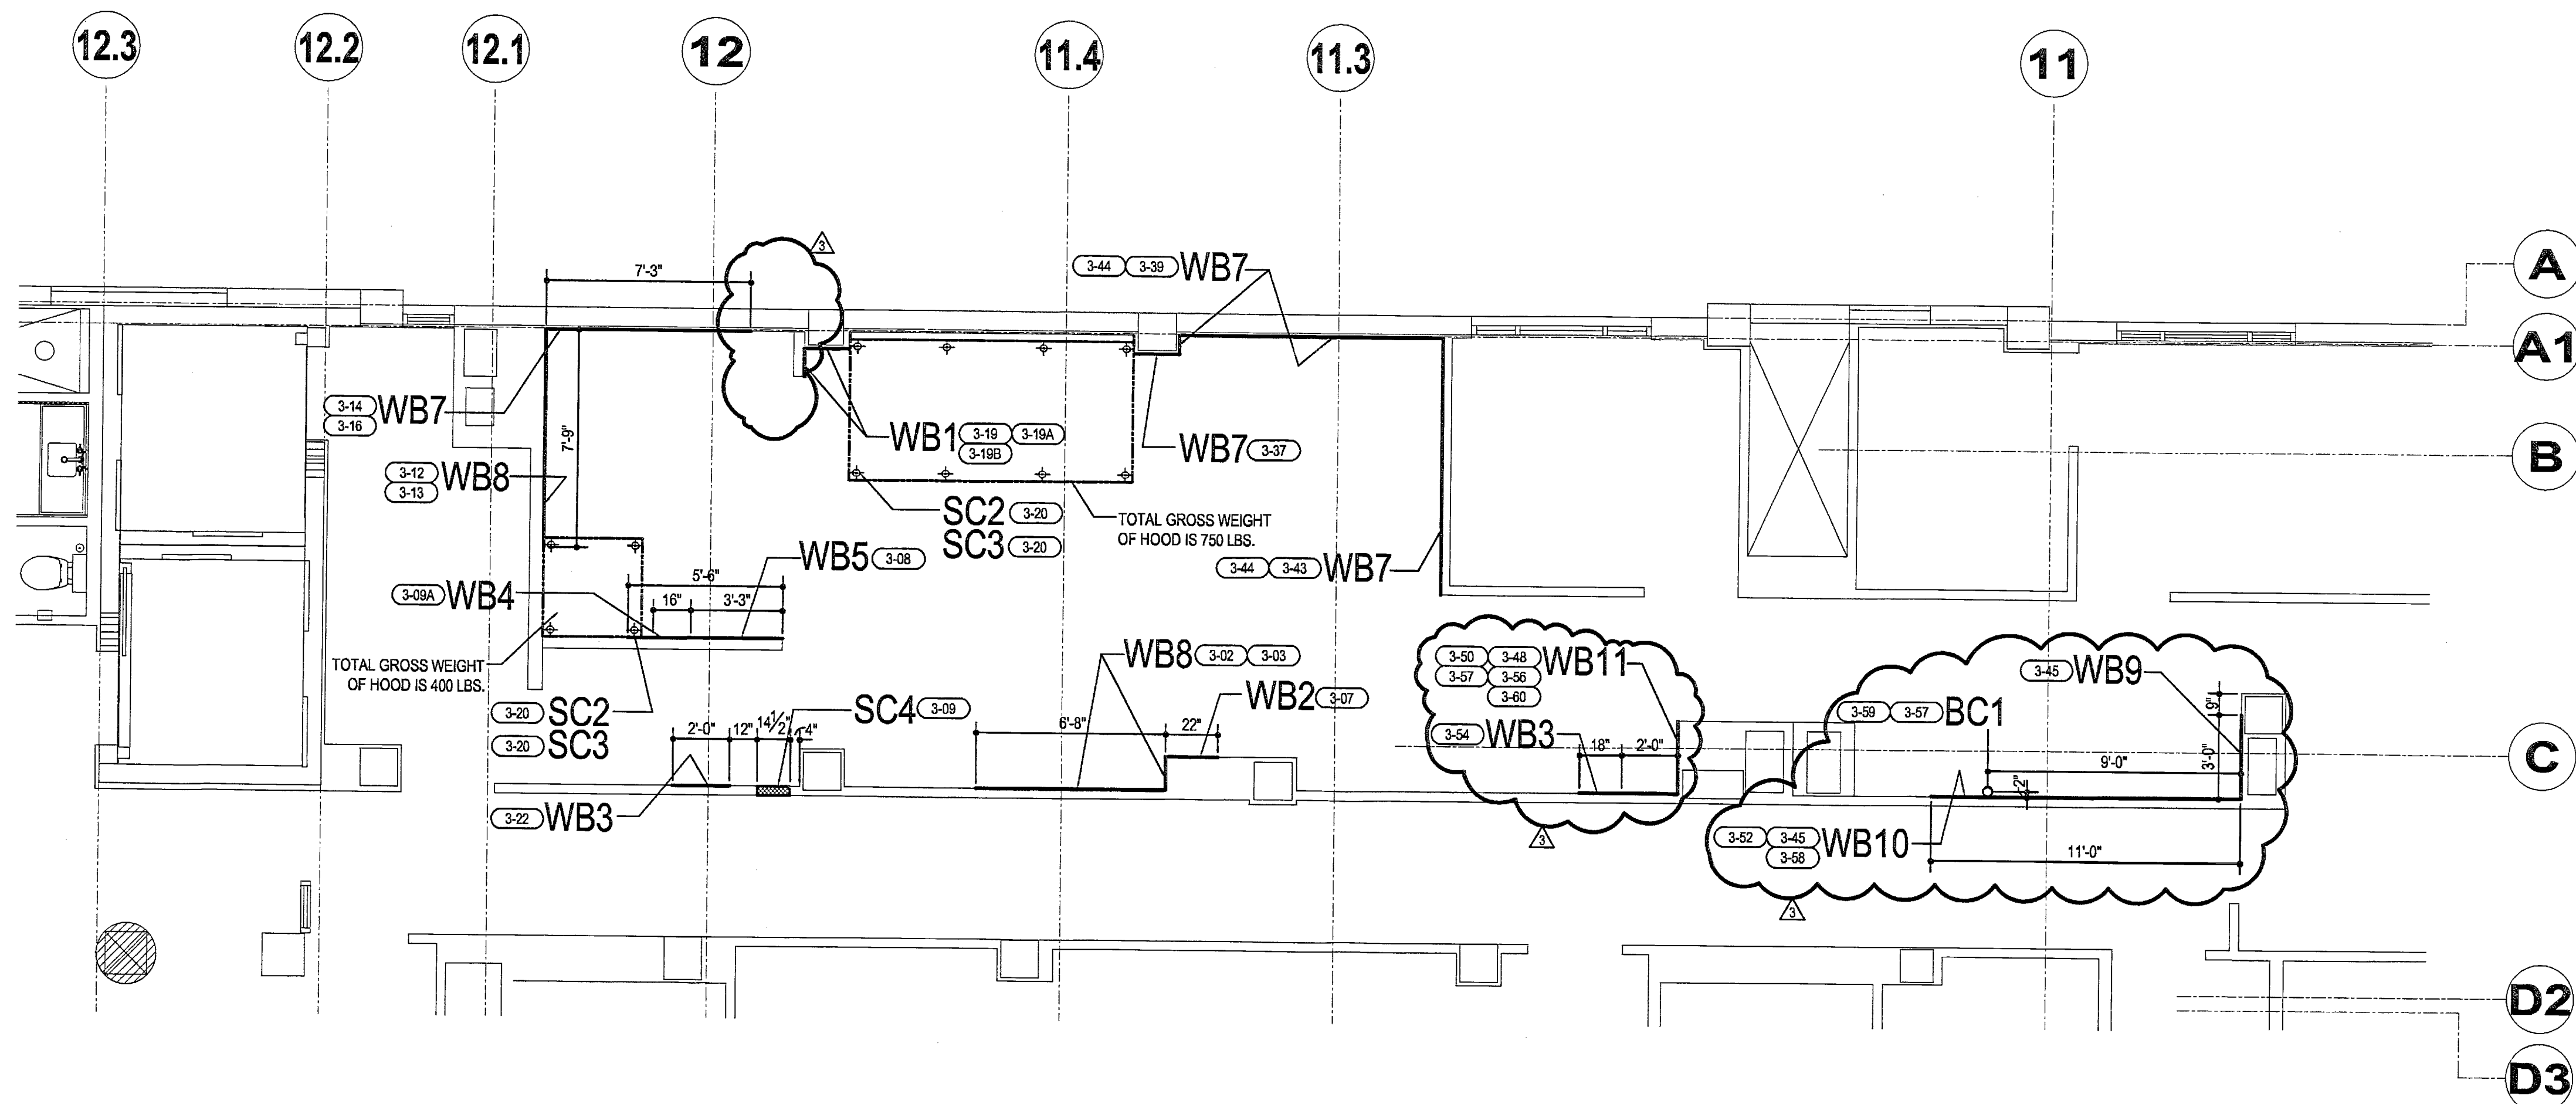

BEVERAGE CONDUIT ROUGH-IN SCHEDULE

BC1	ALUMINUM BEVERAGE CONDUIT ABOVE CEILING - STUB DOWN 6" BELOW FINISHED CEILING - FLOOR SLAB AND WALL PENETRATIONS SHALL BE SEALED WITH A UL LISTED FIRESTOP ASSEMBLY.
-----	--

SPECIAL CONDITIONS NOTES


SC1	NOT USED
SC2	APPROXIMATE HANGER ROD LOCATION & QUANTITY ABOVE EQUIPMENT. ARCHITECT/ENGINEER TO DESIGN & GC TO PROVIDE STRUCTURAL SUPPORT ABOVE ADEQUATE TO SUPPORT EQUIPMENT. ARCHITECT/ENGINEER TO VERIFY QTY. & LOCATION OF HANGER RODS & WT TO BE SUPPORTED.
SC3	ALL CONTRACTORS TO VERIFY HANGER ROD LOCATIONS & MECHANICAL/ELECTRICAL CONNECTION POINTS BEFORE COMMENCING ANY WORK ABOVE CEILING SUSPENDED EQUIPMENT.
SC4	14 1/2" (W) X 20" (H) X 4" (D) RECESS IN BUILDING WALL WILL @ 48" AFF /EQUIPMENT - DO NOT CLOSE OR FINISH BUILDING WALL UNTIL EQUIPMENT INSTALLATION IS COMPLETE

WALL BACKING NOTES

WB1	48"(H) WALL BACKING W/BOTTOM @ 24" AFF
WB2	36"(H) WALL BACKING W/BOTTOM @ 24" AFF
WB3	24"(H) WALL BACKING W/TOP @ FINISHED CEILING
WB4	24"(H) WALL BACKING W/BOTTOM @ 70" AFF
WB5	9"(H) WALL BACKING W/BOTTOM @ 36" AFF & 36"(H) WALL BACKING W/BOTTOM @ 48" AFF
WB6	NOT USED
WB7	9"(H) WALL BACKING W/BOTTOM @ 36" AFF & 36"(H) WALL BACKING W/BOTTOM @ 54" AFF
WB8	9"(H) WALL BACKING W/BOTTOM @ 36" AFF & 24"(H) WALL BACKING W/BOTTOM @ 54" AFF
WB9	18"(H) WALL BACKING W/BOTTOM @ 30" AFF
WB10	56"(H) WALL BACKING W/TOP @ FINISHED CEILING
WB11	WALL BACKING W/BOTTOM @ 6" AFF & TOP @ 6" ABOVE FINISHED CEILING

SPECIAL CONDITION LEGEND

SLEEVE	
SLAB DEPRESSION	
RAISED CURB	
WALL RECESS	
LOW PARTITION WALL	
WALL BACKING	
OVERHEAD BEVERAGE CONDUIT	
BELOW FLOOR BEVERAGE CONDUIT	
BEVERAGE CONDUIT STUB	
HOOD HANGER ROD	
ABOVE FINISHED FLOOR	
DROP FROM ABOVE	
BELOW FINISHED FLOOR	

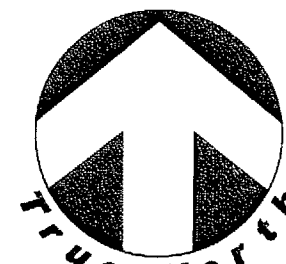

SOHO HOUSE

MIAMI BEACH, FLORIDA

SEVENTH FLOOR
KITCHEN


SPECIAL CONDITIONS PLAN

REVISION:	BY:	CK BY:	DATE:
1	ST	JM	03-23-2009
2	JRL	JM	04-23-2009
3	ST	MGP	07-09-2009
4			
5			
6			
7			
8			
9			
10			

PROJ. MGR:	FRANK MURPHY
COORDINATOR:	PATRICIA TEPPER
TELEPHONE:	854-327-6720
DRAWN BY:	ST
CHECKED BY:	JM
DATE:	02-27-2009
SCALE:	1/4" = 1'-0"

K3-4

071152

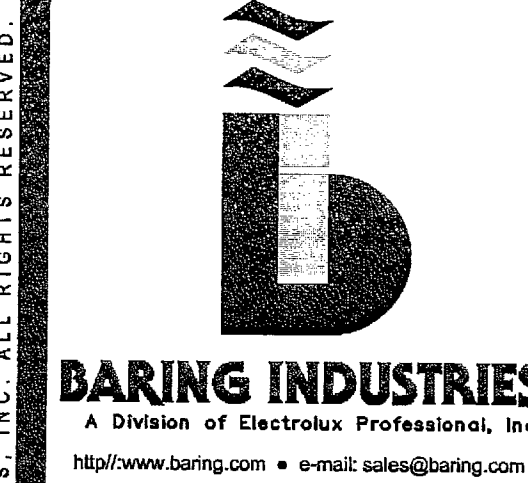

Barling Industries
A Division of Electronic Professionals, Inc.
http://www.baring.com • e-mail: sales@barling.com

Corporate Headquarters
Barling Industries
3249 S.W. 42ND STREET
Ft. Lauderdale, FL 33317 USA
TELEPHONE (954) 327-6700
FAX (954) 327-6701

Northeastern Regional Office
Barling Industries
3201 Lincoln Drive West, Suite J
Morton, NJ 08053 USA
TELEPHONE (609) 688-9925
FAX (609) 688-9152


Midwestern Regional Office
Barling Industries
1200 Pines Street
Suite 100
Nashville, TN 37203 USA
TELEPHONE (615) 262-6888
FAX (615) 252-6074

Midwestern Regional Office
Barling Industries
435 Eisenhower Lane South
Lombard, IL 60148 USA
TELEPHONE (630) 630-1110
FAX (630) 630-1120

Western Regional Office
Barling Industries
11411 Southern Highlands Parkway
Suite 220
Las Vegas, NV 89141 USA
TELEPHONE (702) 385-4416
FAX (702) 385-4417

PLUMBING NOTES

- UTILITIES SHOWN ARE THE MINIMUM REQUIRED FOR THE FOODSERVICE EQUIPMENT. LOCATION, QUANTITY & SIZE OF ADDITIONAL UTILITIES, IF DESIRED, ARE TO BE PROVIDED BY OTHERS.
- FINAL CONNECTIONS TO EQUIPMENT, INTER-CONNECTIONS BETWEEN COMPONENTS & INSTALLING DRAIN/FACETS ARE INCLUDED IN THE PLUMBING CONTRACTOR'S SCOPE OF WORK.
- UNLESS OTHERWISE NOTED IN THESE DRAWINGS, COMPONENTS SUCH AS (BUT NOT LIMITED TO) TRAPS, VALVES, WATER HAMMER ARRESTORS, PRESSURE REDUCING VALVES, PRESSURE REGULATING VALVES & GAUGES SHALL BE PROVIDED & INSTALLED BY THE PLUMBING CONTRACTOR.
- UNLESS OTHERWISE NOTED IN THESE DRAWINGS OR AS RESTRICTED BY CODE, UTILITIES SHALL BE CONCEALED IN & STUBBED OUT OF BUILDING WALLS.
- COMPONENTS SUCH AS (BUT NOT LIMITED TO) TRAPS, VALVES, WATER HAMMER ARRESTORS, PRESSURE REDUCING VALVES, PRESSURE REGULATING VALVES & GAUGES SHALL BE LOCATED SO THAT THEY DO NOT INTERFERE WITH THE OPERATION OF THE EQUIPMENT.
- UNLESS OTHERWISE NOTED IN THESE DRAWINGS, WATER PRESSURE AT CONNECTION POINTS ON THE EQUIPMENT SHALL NOT EXCEED:
A. 25 PSI FOR DISHWASHERS & WATER BOOSTER HEATERS
B. 50 PSI FOR ALL OTHER EQUIPMENT
& SHALL COMPLY WITH THE MANUFACTURER'S WATER FLOW REQUIREMENTS.
- UNLESS OTHERWISE NOTED IN THESE DRAWINGS, HOT WATER SUPPLY TO DISH & WASHING EQUIPMENT & WATER BOOSTER HEATERS SHALL BE 120 DEG F (+/- 5 DEG F) AT THE CONNECTION POINT ON THE EQUIPMENT.
- THE PLUMBING CONTRACTOR SHALL PROVIDE A WATER HAMMER ARRESTOR AT ALL WATER HEATERS AND DISHWASHER WATER BOOSTER HEATER LOCATIONS.
- UNLESS OTHERWISE NOTED IN THESE DRAWINGS, THE PLUMBING CONTRACTOR SHALL PROVIDE & INSTALL BACKFLOW PREVENTION DEVICES AS REQUIRED BY APPLICABLE CODES AND GOVERNING OFFICIALS HAVING JURISDICTION.
- EXPOSED PORTIONS OF CHILLED/COLDING WATER & HOT WATER PIPING SHALL BE INSULATED BY THE PLUMBING CONTRACTOR.
- GAS, STEAM & WATER PIPING SHALL BE BE PRESSURE TESTED, FLUSHED FREE OF FOREIGN MATTER & LINE STRAINERS CLEANED BY THE PLUMBING CONTRACTOR PRIOR TO CONNECTION TO THE EQUIPMENT.
- GREASE TRAPS ARE TO BE LOCATED & INSTALLED SO THEY ARE ACCESSIBLE & COVERED REMOVED WITHOUT INTERFERING IN THE OPERATION OF THE EQUIPMENT OR WITH ANY ELECTRICAL, MECHANICAL OR PLUMBING UTILITY.
- CONDENSATE DRAIN PIPING SHALL BE TRAPPED OUTSIDE OF THE REFRIGERATED COMPARTMENT & EXTENDED TO AN INDIRECT BUILDING WASTE DRAIN.
- CONDENSATE DRAIN PIPING FROM WALK-IN EVAPORATOR COILS SHALL BE PROVIDED, INSTALLED & INSULATED BY THE PLUMBING CONTRACTOR.
- UNLESS OTHERWISE NOTED IN THESE DRAWINGS, CONDENSATE DRAIN PIPING FROM REFRIGERATED EQUIPMENT NOT EQUIPPED WITH A CONDENSATE EVAPORATOR SHALL BE PROVIDED & INSTALLED BY THE PLUMBING CONTRACTOR.
- DRAIN PIPING FROM WASTE DISPOSAL EQUIPMENT SUCH AS DISPOSERS/SINKERS SHALL BE PROVIDED WITH CLEAN-OUT FITTINGS.
- PLUMBING CONTRACTOR TO PROVIDE & INSTALL A MAIN FUEL GAS SHUT-OFF VALVE IN ACCORDANCE WITH APPLICABLE CODES & ANY GOVERNING OFFICIAL HAVING JURISDICTION.
- UNLESS OTHERWISE NOTED IN THESE DRAWINGS, FUEL GAS SOLIDING SHUT-OFF VALVES FOR FOODSERVICE EQUIPMENT PROVIDED BY BARING ARE PROVIDED BY BARING & INSTALLED BY THE PLUMBING CONTRACTOR.
- UNLESS PERMITTED BY APPLICABLE CODES, FUEL GAS PIPING TO PILOT BURNERS ON EQUIPMENT SHALL NOT BY-PASS A FUEL GAS SOLENOID SHUT-OFF VALVE.
- BARING INDUSTRIES RECOMMENDS THAT FUEL GAS SERVICE BE PROVIDED VIA A LOOPED DISTRIBUTION SYSTEM. THE SIZE OF THE LOOP SHALL BE DETERMINED BY THE PROJECT ARCHITECT/ENGINEER.
- DRAIN PIPING FROM ANY EQUIPMENT USING GENERATING STEAM SHALL BE OF MATERIALS & UTILIZED INSTALLATION METHODS TO ACCOMMODATE TEMPERATURES ABOVE 212 DEG F.
- BARING INDUSTRIES RECOMMENDS THAT STEAM SUPPLY & CONDENSATE RETURN BE PROVIDED VIA LOOPED SYSTEMS. THE SIZE OF THE LOOPS SHALL BE DETERMINED BY THE PROJECT ARCHITECT/ENGINEER.
- BARING INDUSTRIES RECOMMENDS THAT CHILLED/COLDING WATER SUPPLY & RETURNS BE PROVIDED VIA LOOPED SYSTEMS. THE SIZE OF THE LOOPS SHALL BE DETERMINED BY THE PROJECT ARCHITECT/ENGINEER.

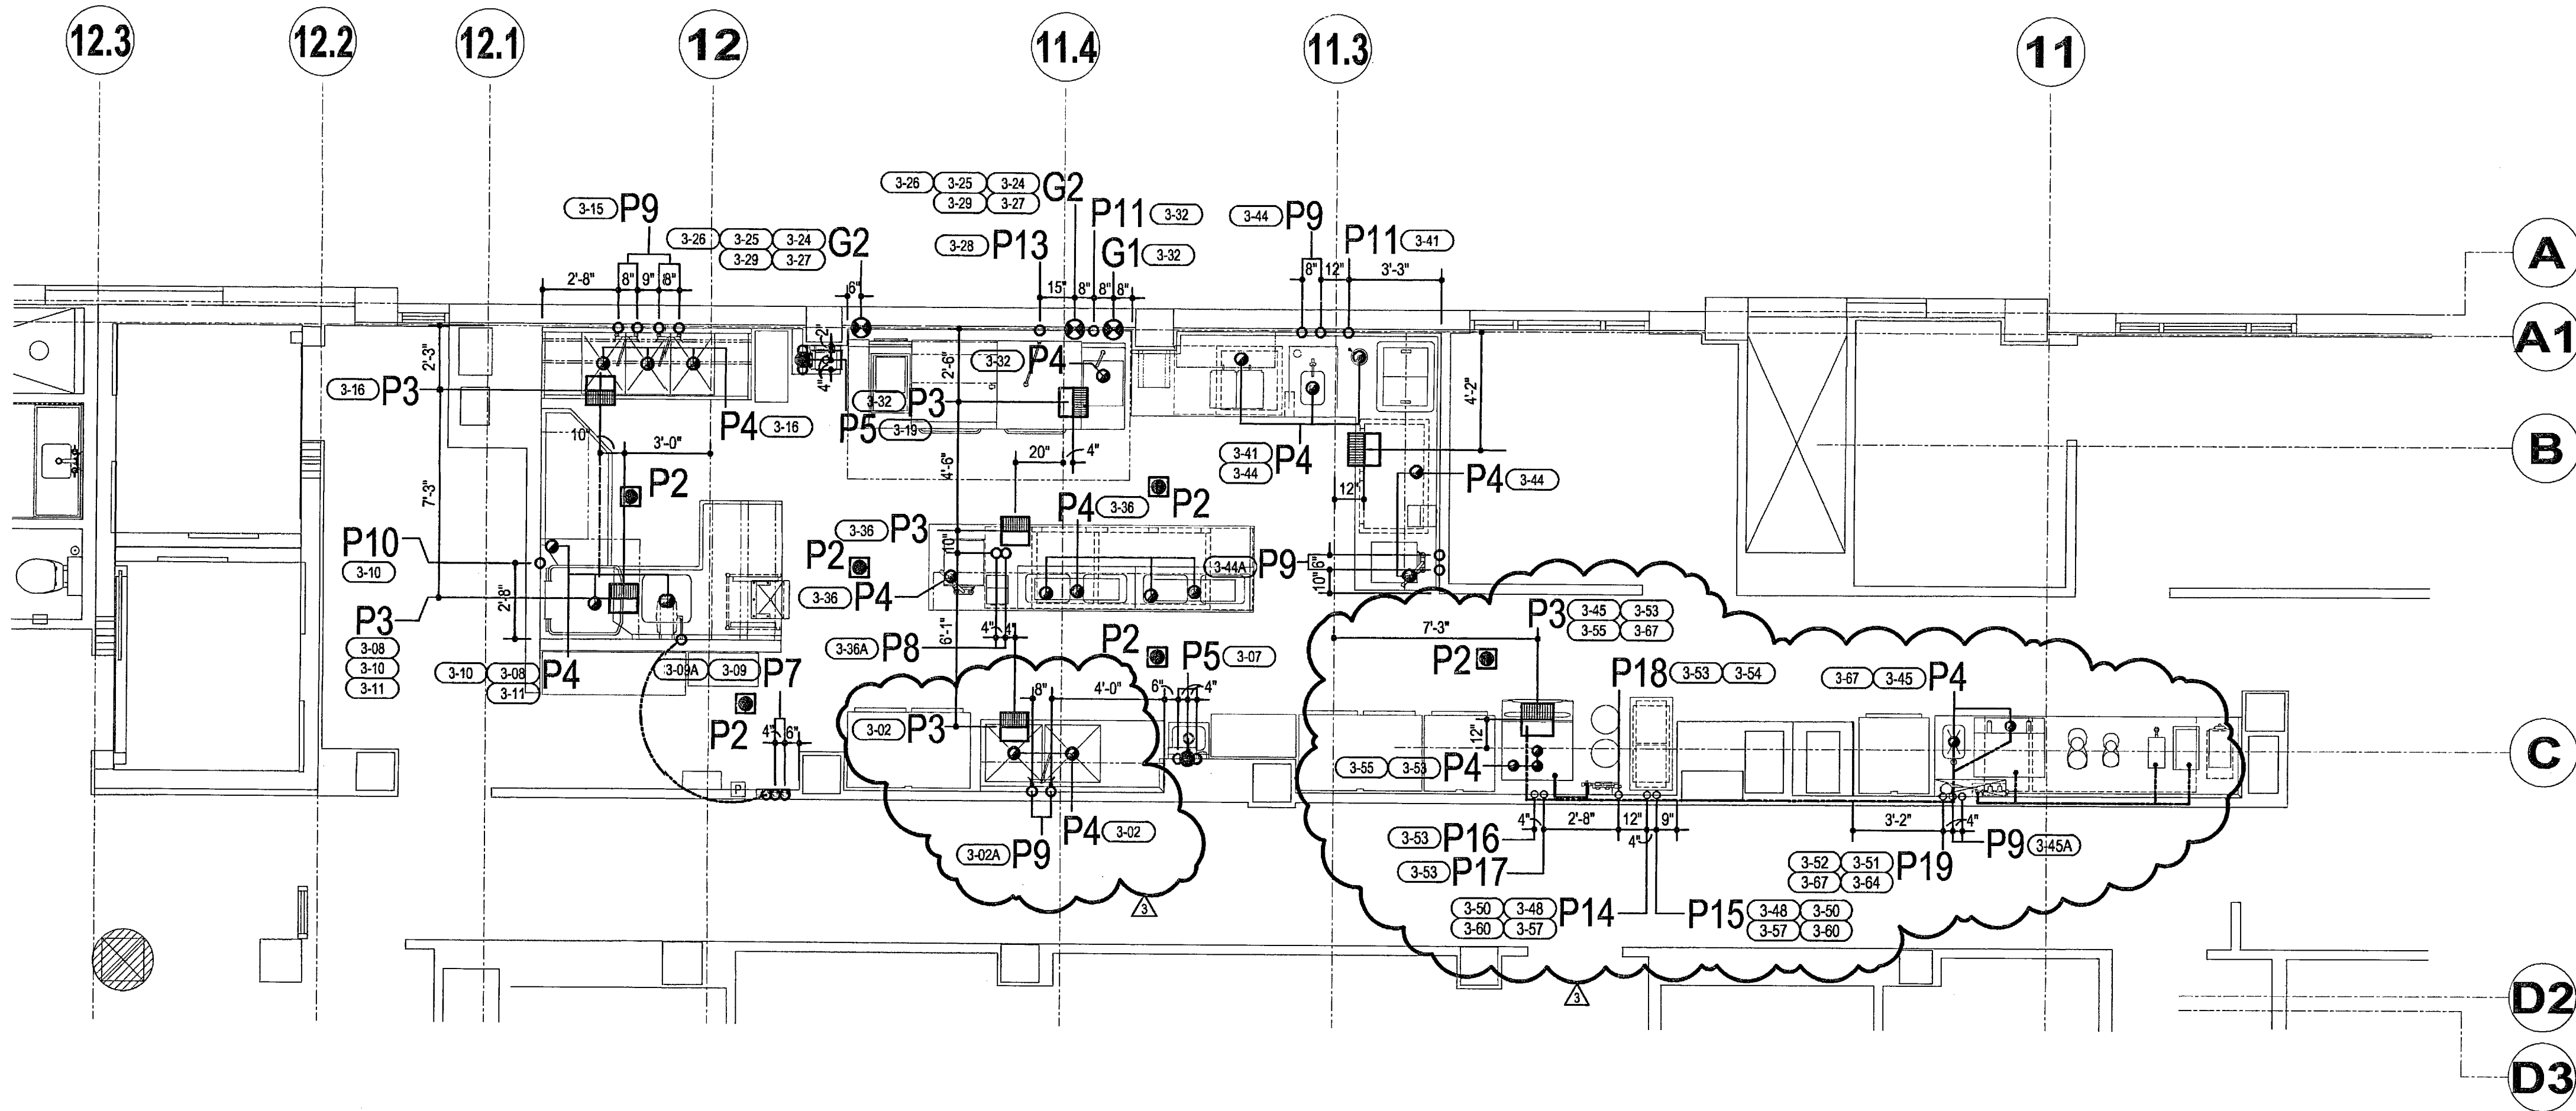

GAS ROUGH-IN SCHEDULE


G1	1/2" NATURAL GAS - STUB @ +24" AFF & OUT OF BUILDING WALL - CONNECT TO EQUIPMENT THROUGH PRESSURE REGULATOR & FLEXIBLE GAS LINE W/QUICK DISCONNECT & PROVIDE SHUT-OFF
G2	1-1/4" NATURAL GAS FR GAS SUPPLY LOOP - STUB @ +24" AFF & OUT OF BUILDING WALL - CONNECT TO EQUIPMENT THROUGH PRESSURE REGULATOR & FLEXIBLE GAS LINE W/QUICK DISCONNECT - PROVIDE SHUT-OFF @ EACH END OF LOOP

PLUMBING ROUGH-IN SCHEDULE

P1	NOT USED
P2	FLOOR DRAIN WIREMOVABLE GRATE
P3	FLOOR SINK WIREMOVABLE GRATE
P4	DRAIN LOCATION ON EQUIPMENT - EXTEND TO BUILDING WASTE DRAIN
P5	1/2" HOT & COLD WATER STUB @ +12" AFF & OUT OF WALL AND 1-1/2" DIRECT WASTE DRAIN STUB @ +18" & OUT OF WALL - CONNECT TO HAND SINK & PROVIDE SHUT-OFF VALVES ON WATER LINES
P6	3" DIRECT WASTE DRAIN FLOOR TROUGH - STUB UP +8" AFF - TRIM TO CORRECT ELEVATION & CONNECT TO FLOOR TROUGH
P7	1/2" HOT & COLD WATER - STUB @ +80" AFF TO TOP OF CONTROL CABINET, CONNECT TO MIXING VALVE IN HOSE REEL CONTROL CABINET & EXTEND TO HOSE REEL INSIDE BUILDING WALL
P8	1/2" HOT & COLD WATER - STUB @ +8" AFF - CONNECT TO EQUIPMENT & PROVIDE SHUT-OFF VALVES
P9	1/2" HOT & COLD WATER - STUB @ +12" AFF & OUT OF WALL - CONNECT TO EQUIPMENT & PROVIDE SHUT-OFF VALVES
P10	3/4" MINIMUM 110° F HOT WATER - STUB @ +12" AFF & OUT OF WALL - CONNECT TO EQUIPMENT & PROVIDE SHUT-OFF VALVE
P11	1/2" COLD WATER - STUB @ +12" AFF & OUT OF WALL - CONNECT TO EQUIPMENT & PROVIDE SHUT-OFF VALVE
P12	NOT USED
P13	1/2" COLD WATER - STUB @ +40" AFF & OUT OF WALL - CONNECT TO EQUIPMENT & PROVIDE SHUT-OFF VALVE
P14	1 1/4" COOLING WATER SUPPLY FR BUILDING COOLING SYSTEM LOOP - STUB @ +24" AFF & OUT OF WALL - MANIFOLD & CONNECT TO INLETS ON MULTIPLE EQUIPMENT - PROVIDE SHUT-OFF AT EACH INLET - INSULATE ALL EXPOSED PIPING
P15	1 1/4" COOLING WATER RETURN TO BUILDING COOLING SYSTEM LOOP - MANIFOLD - STUB @ +24" AFF & CONNECT TO OUTLETS ON MULTIPLE EQUIPMENT - PROVIDE SHUT-OFF AT EACH OUTLET - INSULATE ALL EXPOSED PIPING
P16	1/2" COOLING WATER SUPPLY FR BUILDING COOLING SYSTEM LOOP - STUB @ +54" AFF & OUT OF WALL - CONNECT TO EQUIPMENT & PROVIDE SHUT-OFF VALVE
P17	1/2" COOLING WATER RETURN TO BUILDING COOLING SYSTEM LOOP - STUB @ +54" AFF & OUT OF WALL - CONNECT TO EQUIPMENT & PROVIDE SHUT-OFF VALVE
P18	3/4" COLD WATER - STUB @ +84" AFF & OUT OF WALL - CONNECT TO WATER FILTER & EXTEND FR FILTER THROUGH BUILDING WALL TO ICE MACHINE - PROVIDE SHUT-OFF VALVE
P19	3/4" COLD WATER - STUB @ +84" AFF & OUT OF WALL - CONNECT TO WATER FILTER & EXTEND FR FILTER TO BEVERAGE EQUIPMENT - PROVIDE SHUT-OFF VALVE

PLUMBING LEGEND

COLD WATER	CW	○
HOT WATER	HW	○
COOLING WATER SUPPLY	CWS	○
COOLING WATER RETURN	CWR	○
BUILDING DIRECT WASTE DRAIN	DW	●
INDIRECT WASTE DRAIN LOCATION ON EQUIPMENT	INW	●
HUB DRAIN/INLET GAP DRAIN	HD/IGD	○
FLOOR DRAIN	FD	○
FLOOR SINK	FS	○
STEAM SUPPLY	SS	○
CONDENSATE RETURN	CR	○
GAS	GR	○
COMPRESSED AIR	CA	○
ABOVE FINISH FLOOR	AF	○
DROP FROM ABOVE	DFA	○
BELOW FINISH FLOOR	BFF	○
INTER-CONNECTING WATER PIPING		○

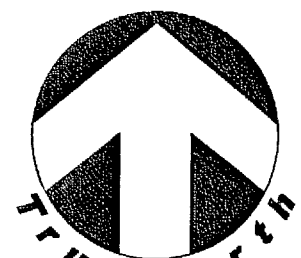

BARING INDUSTRIES

A Division of Electrolux Professional, Inc.

http://www.baring.com • e-mail: sales@baring.com

Corporate Headquarters
Baring Industries
3249 S.W. 42ND STREET
Ft. Lauderdale, FL 33312 USA
TELEPHONE: (954) 327-6700
FAX: (954) 327-6781

Northeastern Regional Office
Baring Industries
3001 Lincoln Drive West, Suite J
Marlton, NJ 08053 USA
TELEPHONE: (856) 988-9926
FAX: (856) 988-9152

Midwestern Regional Office
Baring Industries
1229 PINE STREET
Suite 100
Nashville, TN 37203 USA
TELEPHONE: (615) 252-8099
FAX: (615) 252-8074

Midwestern Regional Office
Baring Industries
435 Eisenhower Lane South
Lombard, IL 60148 USA
TELEPHONE: (630) 620-1110
FAX: (630) 620-1120

Western Regional Office
Baring Industries
11411 Southern Highlands Parkway
Suite 220
Las Vegas, NV 89141 USA
TELEPHONE: (702) 385-4419
FAX: (702) 385-4417

SOHO HOUSE

MIAMI BEACH, FLORIDA

SEVENTH FLOOR
KITCHEN

PLUMBING
ROUGH-IN PLAN

SHEET

REVISION: BY: CK BY: DATE:

ST JM 03-23-2003

JRL JM 04-23-2004

ST MCP 07-08-2009

PROJ. MGR: FRANK MURPHY

COORDINATOR: PATRICIA TEPPER

TELEPHONE: 954-327-6720

DRAWN BY: ST

CHECKED BY: JM

DATE: 02-27-2009

SCALE: 1/4" = 1'-0"

SHEET


K3-5

PROJECT NUMBER

071152

REFRIGERATION & VENTILATION NOTES

1. SLEEVES PENETRATING ANY WALL, FLOOR OR ROOF SHALL BE PROVIDED & INSTALLED BY THE GENERAL CONTRACTOR IN ACCORDANCE WITH APPLICABLE CODE(S) & ANY GOVERNING OFFICIAL HAVING JURISDICTION.
2. REFRIGERATION LINE RUNS SHOWN ARE SCHEMATIC. ACTUAL ROUTING TO BE DETERMINED BY JOB SITE CONDITIONS, REFRIGERATION SYSTEM INSTALLER & THE GENERAL CONTRACTOR.
3. UNLESS OTHERWISE NOTED IN THESE DRAWINGS, CURBS/BACKS/DRAINAGE FOR ROOF MOUNTED EQUIPMENT SHALL BE PROVIDED & INSTALLED BY THE GENERAL CONTRACTOR IN ACCORDANCE WITH APPLICABLE CODE(S) & ANY GOVERNING OFFICIAL HAVING JURISDICTION.
4. UNLESS OTHERWISE NOTED IN THESE DRAWINGS, EXHAUST VENTILATORS SHALL BE RUN WITH THE BOTTOM OF THE VENTILATOR @ 8' AFF.
5. HVAC CONTRACTOR SHALL MAKE CONNECTIONS BETWEEN EXHAUST VENTILATORS & DUCT WORK FULLY WELDED & LIQUID TIGHT.
6. HVAC CONTRACTOR SHALL PROVIDE & INSTALL DUCTWORK, FANS & CURBS REQUIRED FOR A COMPLETE & FUNCTIONING SYSTEM.
7. SYSTEM START-UP & AIR BALANCE IS INCLUDED IN THE HVAC CONTRACTOR'S SCOPE OF WORK.

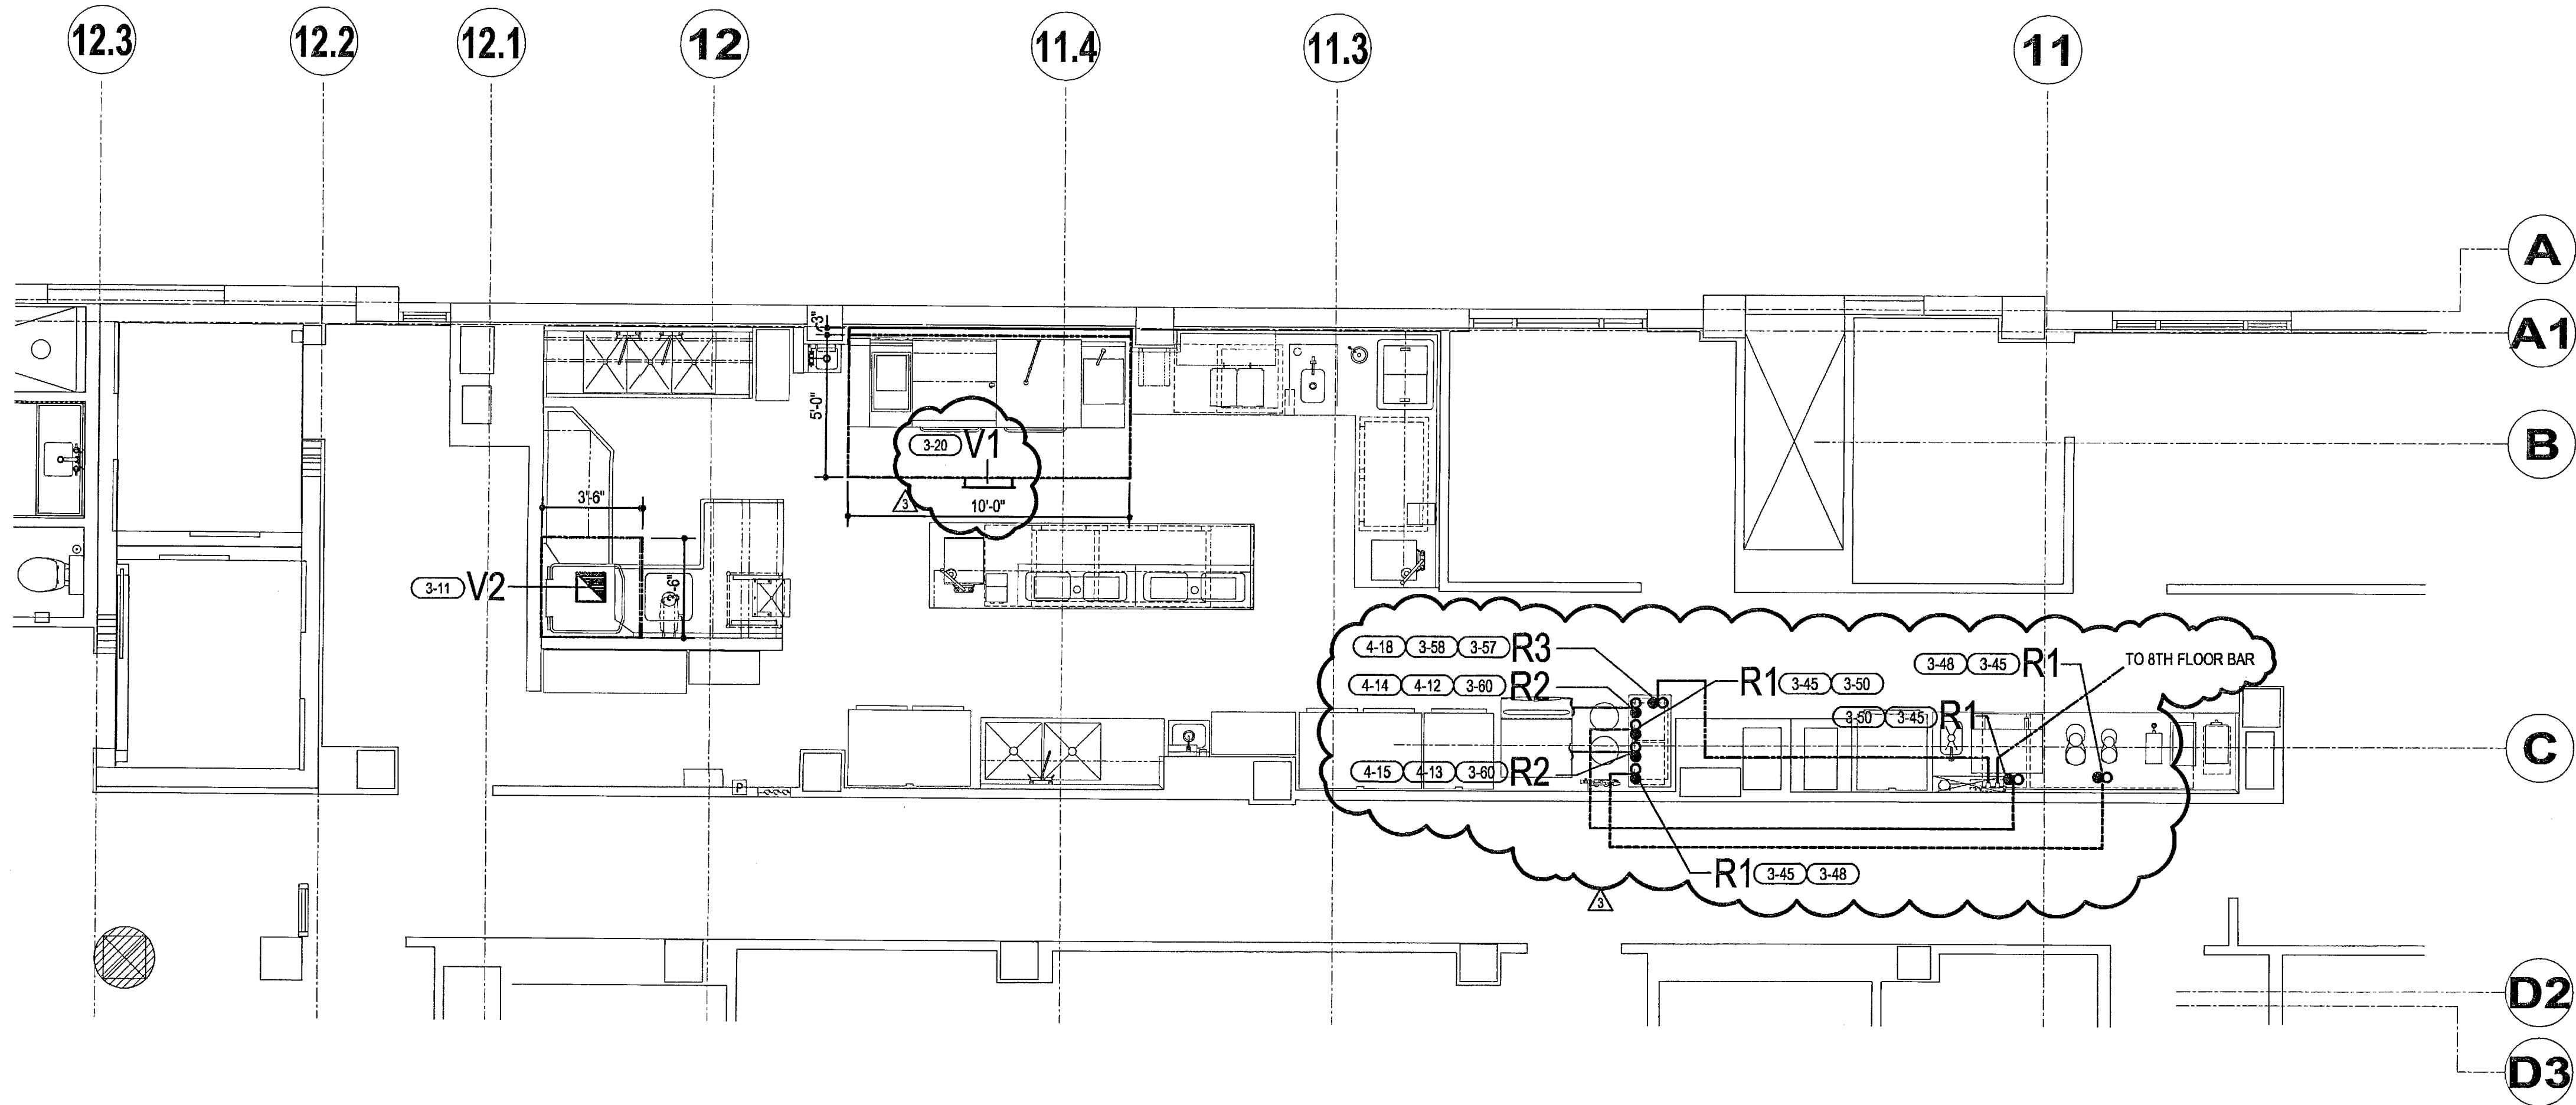

VENTILATION ROUGH-IN SCHEDULE

V1	10" X 20" EXHAUST DUCT IN FRONT FACE OF EXHAUST HOOD - 2927 CFM @ .80" SP
V2	10" X 10" VAPOR HOOD EXHAUST - 500 CFM

REFRIGERATION ROUGH-IN SCHEDULE

R1	LIQUID & SUCTION REFRIGERATION LINES BETWEEN THE EQUIPMENT & REMOTE CONDENSING UNIT
R2	LIQUID & SUCTION REFRIGERATION LINES BETWEEN 8TH FLOOR REFRIGERATED EQUIPMENT & REMOTE CONDENSING UNIT
R3	REFRIGERATED GLYCOL CIRCULATION LINES TO REMOTE BEER PUMP PANEL STATION & BEER TOWERS ON 8TH FLOOR VIA PRODUCT CONDUIT PYTHON

REFRIGERATION LEGEND

LIQUID & SUCTION LINES
OVERHEAD REFRIGERATION LINES
BELOW FLOOR REFRIGERATION LINES


ABOVE FINISHED FLOOR
DROP FROM ABOVE
BELOW FINISHED FLOOR

AFF
DFA
BFF

VENTILATION LEGEND

EXHAUST DUCT
SUPPLY DUCT
STATIC PRESSURE, WATER GAUGE
CUBIC FEET/MINUTE
ABOVE FINISHED FLOOR

SPWG
CFM
AFF

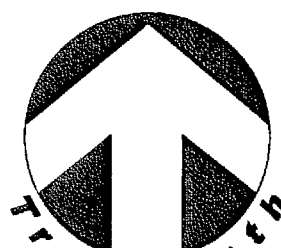

BARING INDUSTRIES
A Division of Electroflux Professional, Inc.
http://www.baring.com • e-mail: sales@baring.com

• **Corporate Headquarters**
Baring Industries
3208 S.W. 42ND STREET
FL LAUDERDALE, FL 33312 USA
TELEPHONE (954) 327-6700
FAX: (954) 327-6781

Northeastern Regional Office
Baring Industries
3001 Lincoln Drive West, Suite J
Marlton, NJ 08053 USA
TELEPHONE (856) 988-9026
FAX (856) 988-0102

Midwestern Regional Office
Baring Industries
1208 PINES STREET
Suite 100
Nashville, TN 37203 USA
TELEPHONE (615) 252-8089
FAX (615) 252-8074

Midwestern Regional Office
Baring Industries
435 Elmhorow Lane South
Lombard, IL 60148 USA
TELEPHONE (830) 650-1110
FAX (830) 650-1120

Western Regional Office
Baring Industries
11411 Southern Highlands Parkway
Suite 220
Las Vegas, NV 89141 USA
TELEPHONE (702) 385-4416
FAX (702) 385-4417

SOHO HOUSE

MIAMI BEACH, FLORIDA

SEVENTH FLOOR
KITCHEN

REFRIGERATION &
VENTILATION ROUGH-IN
PLAN

SHEET TITLE

REVISION:	BY:	OK BY:	DATE:
1	ST	JM	03-23-2007
2	JRL	JM	04-23-2007
3	ST	MGP	07-05-2009

PROJ. MGR: FRANK MURPHY
COORDINATOR: PATRICIA TEPPER
TELEPHONE: 954-327-6720
DRAWN BY: ST
CHECKED BY: JM
DATE: 02-27-2009
SCALE: 1/4" = 1'-0"

SHEET


K3-6

PROJECT NUMBER

071152

ELECTRICAL NOTES

- UTILITIES SHOWN ARE THE MINIMUM REQUIRED FOR THE FOODSERVICE EQUIPMENT. LOCATION, QUANTITY & SIZE OF ADDITIONAL UTILITIES, IF DESIRED/REQUIRED, ARE TO BE PROVIDED BY OTHERS.
- FINAL CONNECTIONS TO EQUIPMENT & INTER-CONNECTIONS BETWEEN COMPONENTS ARE INCLUDED IN THE ELECTRICAL CONTRACTORS SCOPE OF WORK.
- UNLESS OTHERWISE NOTED IN THESE DRAWINGS, COMPONENTS SUCH AS (BUT NOT LIMITED TO) WIRE, CONDUIT, SWITCHES, SAFETY DEVICES, OVER CURRENT & GROUND FAULT PROTECTION DEVICES & DISCONNECT SWITCHES SHALL BE PROVIDED & INSTALLED BY THE ELECTRICAL CONTRACTOR.
- UNLESS OTHERWISE NOTED IN THESE DRAWINGS OR AS RESTRICTED BY CODE, UTILITIES SHALL BE CONCEALED IN A STUBBED OUT OF BUILDING WALLS.
- COMPONENTS SUCH AS (BUT NOT LIMITED TO) SWITCHES, SAFETY DEVICES, OVER CURRENT & GROUND FAULT PROTECTION DEVICES & DISCONNECT SWITCHES SHALL BE LOCATED SO THAT THEY DO NOT INTERFERE WITH THE OPERATION OF THE EQUIPMENT.
- NEAT CONFIGURATION DESIGNATIONS ARE PROVIDED TO ENSURE THAT RECEPTACLES PROVIDED & INSTALLED BY THE ELECTRICAL CONTRACTOR MATCH THE PLUG CONFIGURATION PROVIDED WITH THE EQUIPMENT.
- ELECTRICAL CONTRACTOR SHALL PROVIDE & INSTALL DISCONNECT SWITCHES AS REQUIRED BY APPLICABLE CODES & ANY GOVERNING OFFICIAL HAVING JURISDICTION.
- LINE VOLTAGE CONTROL CIRCUIT & INTER-WIRING BETWEEN WALK-IN BOX COMPONENTS SUCH AS (BUT NOT LIMITED TO) CONDENSING UNITS, REFRIGERATION RACKS, EVAPORATOR COILS, TIME CLOCKS & TEMPERATURE CONTROLS ARE INCLUDED IN THE ELECTRICAL CONTRACTORS SCOPE OF WORK.
- UNLESS OTHERWISE NOTED IN THESE DRAWINGS HEATER CABLE SHALL PROVIDED BY BARRING & SHALL BE FLEXIBLE, SELF-REGULATING TYPE RATED @ 3 WATTS PER FOOT.
- CONDENSATE DRAIN PIPE FROM WALK-IN FREEZER COMPARTMENTS SHALL BE WRAPPED WITH HEATER CABLE BY THE ELECTRICAL CONTRACTOR.
- WALK-IN BOX LIGHT FIXTURES SHIPPED LOOSE SHALL BE MOUNTED AND INTER-WIRED BY THE ELECTRICAL CONTRACTOR.
- LINE VOLTAGE CONTROL CIRCUIT & INTER-WIRING BETWEEN EXHAUST VENTILATOR COMPONENTS SUCH AS (BUT NOT LIMITED TO) LIGHT FIXTURES, CONTROL PANELS, FANS, MAGNETIC CONTROLLERS, MOTORIZED DAMPERS & THE BUILDING ALARM SYSTEM ARE INCLUDED IN THE ELECTRICAL CONTRACTORS SCOPE OF WORK.
- LINE VOLTAGE CONTROL CIRCUIT & INTER-WIRING BETWEEN FIRE SUPPRESSION SYSTEM COMPONENTS SUCH AS (BUT NOT LIMITED TO) CONTROL PANELS, AGENT CABINETS, REMOTE PULL STATIONS & THE BUILDING ALARM SYSTEM ARE INCLUDED IN THE ELECTRICAL CONTRACTORS SCOPE OF WORK.
- FIRE SUPPRESSION SYSTEM REMOTE PULL STATION REQUIRES A 4" x 4" OCTAGON J-BOX W/SCREW HOLES @ 2 & 8 O'CLOCK POSITIONS. ELECTRICAL CONTRACTOR SHALL RECESS THE J-BOX IN THE BUILDING WALL & PROVIDE EMPTY CONDUIT FROM THE TOP OF THE J-BOX STUBBED OUT THE BLDG WALL 6" ABOVE THE FINISHED C.O.G.
- ELECTRICAL CONTRACTOR SHALL VERIFY FIRE SUPPRESSION SYSTEM REMOTE PULL STATION LOCATIONS WITH THE GOVERNING OFFICIAL HAVING JURISDICTION PRIOR TO RECESSING.
- ELECTRICAL CONTRACTOR SHALL VERIFY TO WHICH BLDG SYSTEMS THE FIRE SUPPRESSION SYSTEM SHALL BE INTER-CONNECTED.
- LINE VOLTAGE CONTROL CIRCUIT & INTER-WIRING BETWEEN WASTE SYSTEM COMPONENTS SUCH AS (BUT NOT LIMITED TO) CONTROL PANELS, START STOP SWITCHES, DISPOSERS, PUMPS & TROUGH COLLECTORS ARE INCLUDED IN THE ELECTRICAL CONTRACTORS SCOPE OF WORK.
- LINE VOLTAGE CONTROL CIRCUIT & INTER-WIRING BETWEEN WAREWASHING EQUIPMENT COMPONENTS SUCH AS (BUT NOT LIMITED TO) CONTROL PANELS, VENT FAN CONTROL, DETERGENT & SANITIZER DISPENSERS, TABLE LIMIT SWITCHES & WATER BOOSTER/HEATERS ARE INCLUDED IN THE ELECTRICAL CONTRACTORS SCOPE OF WORK.
- UNLESS OTHERWISE STIPULATED BY APPLICABLE CODE, ALL 120-VOLT RECEPTACLES SHALL BE GFCI TYPE.
- POWER SERVICE TO COMPUTER AND POINT-OF-SALE EQUIPMENT SHALL BE ON A DEDICATED CIRCUIT WITH ISOLATED GROUND.
- POINT-OF-SALE EQUIPMENT REQUIRES AN EMPTY J-BOX AND CONDUIT SUITABLE FOR CATEGORY 5 DATA INTERFACE CABLE. ELECTRICAL CONTRACTOR TO VERIFY ROUTING WITH THE SYSTEM PROVIDER.
- COMPUTER EQUIPMENT REQUIRES A J-BOX AND CONDUIT WITH DATA INTERFACE CABLE & RJ45 ETHERNET CONNECTOR. ELECTRICAL CONTRACTOR TO VERIFY ROUTING WITH THE SYSTEM PROVIDER.


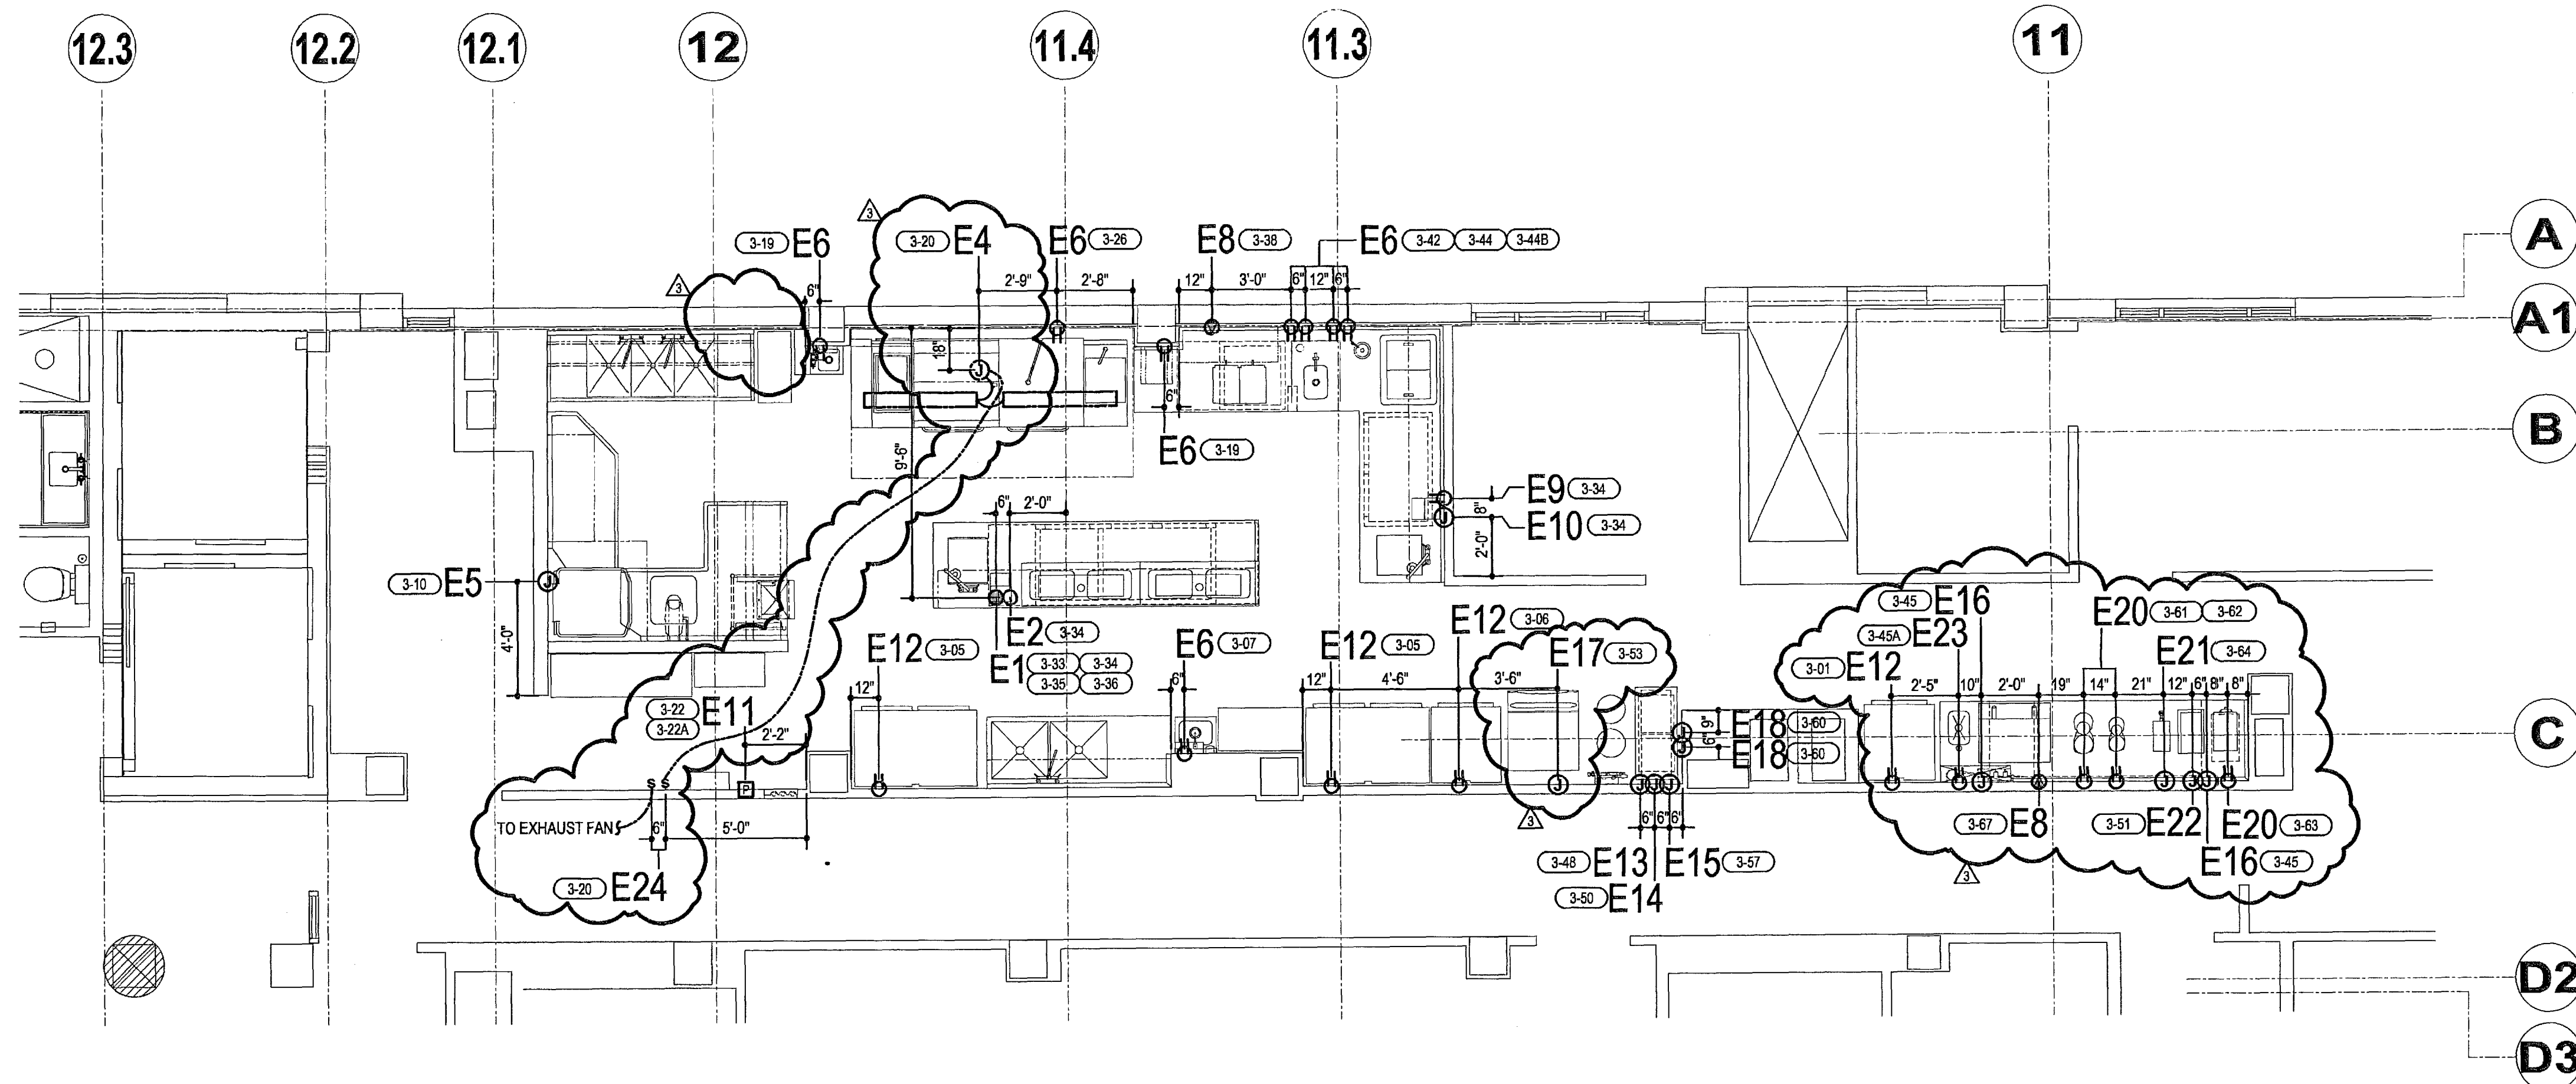


ELECTRICAL ROUGH-IN SCHEDULE

E1	CONDUIT STUB - 120V/1PH/10A SERVICE - STUB @ 48" AFF - CONNECT TO CIRCUIT BREAKER PANEL ON EQUIPMENT - SEE SHOP DRAWING FOR PANEL SCHEDULE
E2	EMPTY JUNCTION BOX & CONDUIT FOR CAT5e COMMUNICATION DATA CABLE - 48" AFF - VERIFY REQUIREMENTS WITH SUPPLIER
E3	NOT USED
E4	JUNCTION BOX - 120V/1PH/10A SERVICE DOWN FROM ABOVE TO TOP OF EXHAUST HOOD - CONNECT & INTER-WIRE TO LIGHT FIXTURES & CAPTURE JET FANS) AS REQUIRED
E5	JUNCTION BOX - 480V/3PH/3A SERVICE - 18" AFF - CONNECT TO EQUIPMENT & INTERWIRE VENT FAN CONTROL TO EXHAUST FAN
E6	DUPLEX RECEPTACLE - 120V/1PH/20A SERVICE - NEMA 5-20R GFCI 18" AFF
E7	NOT USED
E8	SINGLE RECEPTACLE - 208V/1PH/30A SERVICE - NEMA L6-30R 45" AFF
E9	DUPLEX RECEPTACLE ON DEDICATED CIRCUIT W/ISOLATED GROUND - 120V/1PH/20A SERVICE - NEMA 5-20R 45" AFF
E10	EMPTY JUNCTION BOX & CONDUIT FOR CAT5e COMMUNICATION DATA CABLE - 45" AFF - VERIFY REQUIREMENTS WITH SUPPLIER
E11	EMPTY OCTAGON JUNCTION BOX FOR FIRE PROTECTION SYSTEM REMOTE PULL STATION - 48" AFF W/SCREW HOLES @ 2 & 8 O'CLOCK POSITIONS - EXTEND 12" EMT CONDUIT FROM BOX TO 6" ABOVE FINISHED CEILING W/NO BENDS
E12	DUPLEX RECEPTACLE - 120V/1PH/20A SERVICE - NEMA 5-20R GFCI 48" AFF
E13	JUNCTION BOX - 120V/1PH/15A SERVICE - 24" AFF - CONNECT TO EQUIPMENT
E14	JUNCTION BOX - 120V/1PH/10A SERVICE - 24" AFF - CONNECT TO EQUIPMENT
E15	JUNCTION BOX - 208V/1PH/15A SERVICE - 48" AFF - CONNECT TO EQUIPMENT
E16	JUNCTION BOX - 120V/1PH/10A SERVICE - 24" AFF - CONNECT TO EQUIPMENT
E17	JUNCTION BOX - 208V/1PH/20A SERVICE - 48" AFF - CONNECT TO EQUIPMENT
E18	JUNCTION BOX - 120V/1PH/15A SERVICE - 78" AFF - CONNECT TO EQUIPMENT
E19	NOT USED
E20	DUPLEX RECEPTACLE - 120V/1PH/20A SERVICE - NEMA 5-20R GFCI 48" AFF
E21	JUNCTION BOX - 120V/1PH/20A SERVICE - 45" AFF - CONNECT TO EQUIPMENT
E22	JUNCTION BOX - 120-208V/1PH/20A SERVICE - 45" AFF - CONNECT TO EQUIPMENT
E23	DUPLEX RECEPTACLE - 120V/1PH/15A SERVICE - NEMA 5-15R GFCI 18" AFF
E24	LIGHT & FAN SWITCHES FOR EXHAUST HOOD @ 48" AFF - INTERWIRE TO EXHAUST HOOD & FAN AS REQUIRED

ELECTRICAL LEGEND

SINGLE RECEPTACLE, NEMA 5-20R	SR
DUPLEX RECEPTACLE, NEMA 5-20R	DR
QUADRAPLEX RECEPTACLE, NEMA 5-20R	QR
SPECIAL RECEPTACLE, 208 OR 480	SPR
FLOOR RECEPTACLE	FR
JUNCTION BOX	JB
DROP CORD OR CONDUIT	DC
CONDUIT STUB	C
WALL SWITCH	S
RECEPTACLE ON EQUIPMENT	RE
FIRE PROTECTION SYSTEM REMOTE PULL STATION	FP
INCANDESCENT LIGHT FIXTURE	IL
FLUORESCENT LIGHT FIXTURE	FL
LOAD CENTER IN EQUIPMENT	LC
BUILDING LOAD CENTER PANEL	BL
POINT OF CONNECTION ON EQUIPMENT	PO
ABOVE FINISHED FLOOR	AFF
DROP FROM ABOVE	DFA
BRANCH TO CONNECTIONS	BT
ELECTRICAL INTERCONNECTIONS	IC

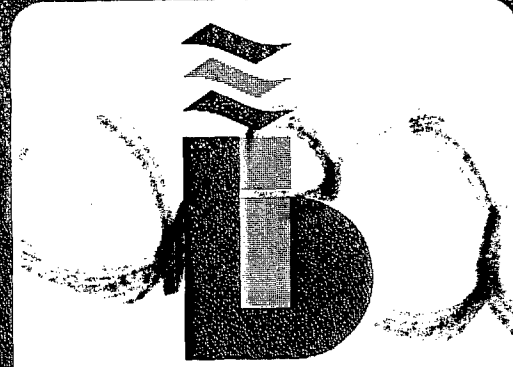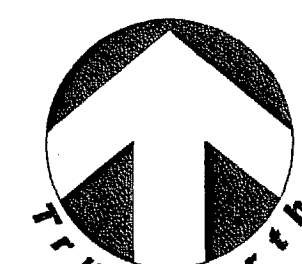

Baring Industries

A Division of Electroflux Professional, Inc.
http://www.baring.com • e-mail: sales@baring.com

Corporate Headquarters
Baring Industries
3049 S.W. 42ND STREET
Ft. Lauderdale, FL 33307 USA
TELEPHONE (954) 327-1700
FAX (954) 327-4191

Northeastern Regional Office
Baring Industries
3501 Lincoln Drive West, Suite J
Morton, NJ 08053 USA
TELEPHONE (800) 848-8626
FAX (800) 848-8152

Midwestern Regional Office
Baring Industries
4200 W. 12TH STREET
Suite 100
Naperville, IL 60563 USA
TELEPHONE (630) 422-0099
FAX (630) 422-1120

Midwestern Regional Office
Baring Industries
435 Eisenhower Lane South
Lombard, IL 60148 USA
TELEPHONE (630) 620-1110
FAX (630) 620-1120

Western Regional Office
Baring Industries
11411 Southern Highlands Parkway
Suite 220
Las Vegas, NV 89114 USA
TELEPHONE (702) 385-4416
FAX (702) 385-4417

SOHO HOUSE

MIAMI BEACH, FLORIDA

SEVENTH FLOOR
KITCHEN

PROJECT NAME

PROJECT LOCATION

ASSET NAME

ELECTRICAL
ROUGH-IN PLAN

SHEET TITLE

REVISION	BY	CK BY	DATE
1	ST	JM	03-23-2009
2	JRL	JM	04-23-2009
3	ST	MGP	07-08-2009

PROJ. MGR: FRANK MURPHY
COORDINATOR: PATRICIA TEPPER
TELEPHONE: 954-327-6720

DRAWN BY: ST
CHECKED BY: JM
DATE: 02-27-2009

SCALE: 1/4" = 1'-0"

SHEET
K3-7PROJECT NUMBER
071152

BO-04736
4385 Collins Ave
Office Copy

DERM

PLAN REVIEW

FINAL

APPROVAL

DEPARTMENT OF ENVIRONMENTAL
RESOURCES MANAGEMENT

Miguel de Armas

CUO DATE *12/9/09*

OFFICE COPY

CITY OF MIAMI BEACH

APPROVED FOR PERMIT BY

THE FOLLOWING:

BUILDING	<i>12/9/09</i>
ZONING	<i>12/9/09</i>
DRAINAGE	<i>12/9/09</i>
CONCRETE	<i>12/9/09</i>
ELECTRICAL	<i>12/9/09</i>
MECHANICAL	<i>12/9/09</i>
FIRE PROTECTION	<i>12/9/09</i>
ENGINEERING	<i>12/9/09</i>
PUBLIC WORKS	<i>12/9/09</i>
STRUCTURES	<i>12/9/09</i>
REVIEWER	<i>12/9/09</i>



Derm Number: 2009-1204-1153-1078
Contact Name: CELIA FOLINI
Contact Phone: (786) 957-5342
Folio: 02-5225-001-2140
Project Name: 5010 BENCH HOUSE
Date Received: 12/04/2009
Reviewer Name:



CITY OF MIAMI BEACH
BUILDING DEPARTMENT
1700 CONVENTION CENTER DRIVE
2ND FLOOR - CITY HALL
MIAMI BEACH, FL 33139

**NOTICE TO THE CITY OF MIAMI BEACH BUILDING
DEPARTMENT OF EMPLOYMENT AS SPECIAL INSPECTOR
UNDER THE FLORIDA BUILDING CODE**

I, (we) have been retained by: Claro Development to perform special inspector services under the Florida Building Code at the 4385 Collins Avenue project on the below listed structures as of 10/15/10 (date). I am a professional engineer licensed in the State of Florida.

Process Number:

B1100002

Master Permit (IF APPLICABLE):

- ☐ Special Inspector for Pillings, FBC 1822.1.20
☐ Special Inspector for Soil Compaction, FBC 1820.3.1
☐ Special Inspector for Precast Attachments, FBC 1927.12.2 (By P.E. or R.A.)
☐ Special Inspector for Reinforced Masonry, FBC 2122.4
☒ Special inspection for Steel Bolted & Welded Connections, FBC 2218.2 (By P.E. or R.A.)
☐ Special Inspector for Trusses over 35 feet long or 6 feet high, FBC 2319.17.4.2 (By P.E. or R.A.)
☐ Special Inspector for

NOTE: Only the marked boxes apply.

The following individual(s) employed by this firm or me are authorized representatives to perform inspections*

1. Jose Fernandez, PE 2. Peter Koerber
3. Federico Garcia 4. _____

*NOTE: FBC 2001 HVZ sections 1927.12.2, 2218.2, 2319.17.4.2 requires either a Registered professional Engineer or Registered Architect to perform the actual inspections.

I, (we) will notify the City of Miami Beach Building Department of any changes regarding authorized personnel performing inspection services.

I, (we) understand that a Special Inspection Log for each building must be displayed in a convenient location on the site for reference by the City of Miami Beach Building Department Inspector. All mandatory inspections, as required of the Florida Building Code, inspection performed by the Special Inspector hired by the Owner are in addition to the mandatory inspections performed by the Building Department. Further, upon completion of the work under each building permit, I will submit to the Building Inspector at the time of final inspection the completed Inspection Log form and sealed statement that, to the best of my knowledge, belief and professional judgment those portions outlined above meet the intent of the Florida Building Code and are in subsequent accordance with the approved plans.

Architect/Engineer Signature:

Architect/Engineer
Name Printed:

Address:

Phone Number:

Owner/Agent Signature:

Owner/Agent Name Printed:

Building Department
Accepted By:

Mustafa Cankat, PE

1900 SW 57 AVE? #1, Miami, FL 33155

(305) 266-9777

Geeta Polish - Agent

Uferer 12/6/11

Signed and Sealed

#18632

License Number

Date: 10/15/10

CANKAT-ESSMAN, INC.

1900 SW 57 Avenue, #1
Miami, FL 33155
Tel: (305) 266-9777
Fax: (305) 266-0584
mus@cankatessman.com
www.cankatessman.com

October 20, 2010

City of Miami Beach
Building Department
1700 Convention Center Drive
2nd Floor City Hall
Miami Beach, FL

Attention: Mr. R. L. Valdes, PE
Structural Plan Reviewer

Re: 4385 Collins Ave., Miami Beach, FL
Soho Beach House / Court Yard Pergola
Structural B 1100002
Our Job No. 10017

Dear Sir:

The following are our responses to your Structural Review Comments, dated 10/7/10.

ITEM #1:

Comment: PROVIDE FOUNDATION FOR TRELLIS COLUMNS. NOTE THAT DESIGN CRITERIA REFERS TO SOIL BEARING PRESSURE BUT THE MASTER PERMIT USED PILE FOUNDATION. IF TRELLIS IS SUPPORTED BY A CONCRETE STRUCTURE BY OTHERS (SLAB ON GRADE, STRUCTURAL SLAB OR CONTINUOUS OR INDIVIDUAL FOOTINGS), PROVIDE EVIDENCE OF SUCH.

RESPONSE: Trellis columns are supported on existing 8" reinforced concrete slab over pile foundation. Calculation page foundation information is corrected. See attached partial foundation plan of the area where the trellis columns are installed. See calculation page 11 maximum downward reaction (gravity + wind) is 2.05 kips. Punching shear at column base is less than 10 psi and distributed load is within the capacity of structural slab.


ITEM #2:

Comment: SPECIAL INSPECTIONS ARE REQUIRED FOR STRUCTURAL STEEL BOLTED AND WELDED CONNECTIONS. PROVIDE THREE FULLY EXECUTED COPIES OF SPECIAL INSPECTOR FORM.

RESPONSE: Special Inspector forms are provided. Please see attached.

ITEM #3:

Comment: SECTION 1/S-2. PROVIDE SIZE AND CONNECTIONS FOR HANGERS SUPPORTING TRELLIS FROM "EXISTING BEAMS BY OTHERS".

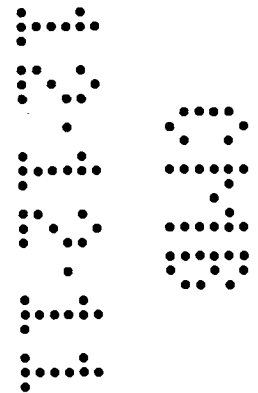


RESPONSE: Please see Section 6/S-2 for tubular hanger section size and weld size connecting them at top and bottom.

ITEM #4:


Comment: CALCULATIONS INDICATE A MOMENT CONNECTION BETWEEN BEAM AND POST AS AN ALL-AROUND 3/16" FILLET WELD. PROVIDE DETAIL FOR CONNECTION 2.

RESPONSE: Stability of the hanging pergola below the long bar structure has been originally provided in transverse direction (N-S) by connecting the new HSS 6x4x3/16 beams to concrete columns of the bar structure at each end in longitudinal direction (E-W) hangers were welded only. We revised Section 2/S-2 by adding cross bracing members to provide stability without relying on moment connection.

Yours truly,



Mustafa Cankat, PE

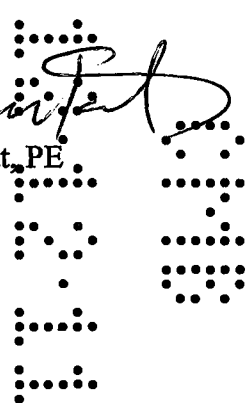

Atts.

CANKAT-ESSMAN, INC.

CONSULTING ENGINEERS

1900 SW 57 Ave., Suite 1


MIAMI, FL 33156

T:305.266.9777 F:305.266.0584

STRUCTURAL CALCULATIONS

GENERAL INFORMATION

Project : **SOHO BEACH HOUSE Courtyard Pergola**
Project Address: 4385 Collins Ave
Miami Beach FL 33140
Date 9/21/2010
Our Job No. 10017
Client: SOHO BEACH HOUSE

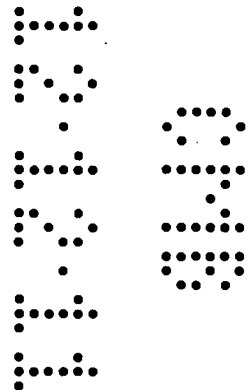

INDEX

<u>CONTENTS</u>	<u>PAGE</u>
DESIGN CRITERIA	2
WIND ANALYSIS	3 & 4
STEEL FRAMING BEAMS & POSTS	5 thru 11
WOOD RAFTERS	12
CONNECTIONS	13 thru 16
APPENDIX	17 thru 21

TOTAL (21) PAGES

Mustafa Cankat, PE
Florida License #: 18632
C.A #: 404419

10/27/2010

STRUCTURAL CALCULATIONS

Applicable Codes:

- * Florida Building Code 2007
- * ACI 318-99 Reinforced Concrete
- * ACI 530-98 Reinforced Masonry
- * ASTM C-90 Hollow unit masonry
- * ASTM C-476 Grout
- * AISC
- * ASCE 7-05

Wind Criteria (as per ASCE 7-05)

Basic Wind speed 146 (3 second gust) High Velocity Wind Zone
Height <60 Ft.
Exposure C
Importance factor I=1
Kd=1
kdt=0.85

Design Loads:

	Dead Load	S.I. DL	Live Load
Roof	10 psf		30 psf
Floor			
Terrace, Balcony /Stair	25 psf		100 psf

Pitch of roof 1/12
Eave height(z) Ft
Building width (L) Ft
Mean roof height(H) Ft

Pergola columns are supported on existing 8" concrete structural slab over Pile Foundations.
Assumed minimum concrete properties.


Concrete:	Foundation	Superstructure	Reinforcing Steel
fc'=	3000 psi	4000 psi	fy= 60000 psi
E=	3321 ksi		

Structural Wood

All structural lumber shall be No.2 common grade Southern Pine or better grade

Structural Steel

Tubular sections: ASTM A-500 Gr B
All Others: ASTM A-36

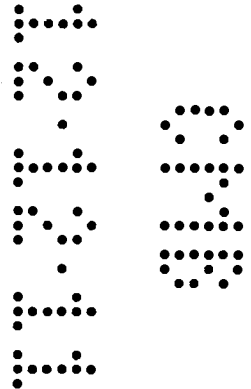

MIAMI, FL 33155
T:305.266.9777 F:305.266.0584

PROJECT: SOHO BEACH HOUSE Courtyard Pergola

JOB NO:

Page: 3


Calc'd: FO

Checked: FO

Date: 9/2/10

CLIENT:

ARCHITECT:

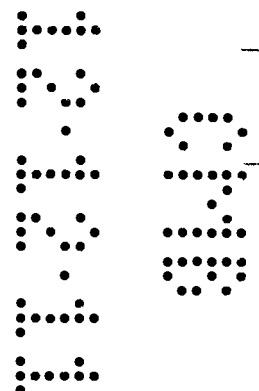

WIND ANALYSIS

ASCE 7-05, MONOSLOPE FREE ROOFS, C&C $\Theta \leq 7.5^\circ$ SOHO Beach

h(feet)	9.25	mean roof height
Exposure	2	1 for B, 2 for C, 1 for D
K_{zt}	1.00	6.5.7
K_d	0.85	Table 6-4
V	146	mph
I	1.00	Table 6-1
G	0.85	6.5.8
p(in/ft)	0.00	roof pitch
L(feet)	18.83	least horizontal dim.
Flow	1	Enter 1 for clear flow

Θ°	0.00	OK < 7.5
a(feet)	3.00	
Exposure	C	
α	9.5	Table 6-2
z_g	900	Table 6-2
$K_{h(CASE 1)}$	0.85	Table 6-3
q_h	39.37	$.00256 K_z K_{zt} K_d V^2 I$
$q_h G$	33.47	psf
h/L	0.49	OK

roof angle	sqft.	A_f	C_N					
			Zone 3		Zone 2		Zone 1	
0°	9	$\leq a^2$	2.4	-3.3	1.8	-1.7	1.2	-1.1
	36	$> a^2 \leq 4a^2$	1.8	-1.7	1.8	-1.7	1.2	-1.1
	36	$> 4a^2$	1.2	-1.1	1.2	-1.1	1.2	-1.1

roof angle	sqft	A_f	C_N					
			Zone 3		Zone 2		Zone 1	
Θ°	9	$\leq a^2$	2.4	-3.3	1.8	-1.7	1.2	-1.1
	36	$> a^2 \leq 4a^2$	1.8	-1.7	1.8	-1.7	1.2	-1.1
	36	$> 4a^2$	1.2	-1.1	1.2	-1.1	1.2	-1.1

roof angle	sqft	A_f	C_N					
			Zone 3		Zone 2		Zone 1	
7.5°	9	$\leq a^2$	3.2	-4.2	2.4	-2.1	1.6	-1.4
	36	$> a^2 \leq 4a^2$	2.4	-2.1	2.4	-2.1	1.6	-1.4
	36	$> 4a^2$	1.6	-1.4	1.6	-1.4	1.6	-1.4

roof angle	sqft	A_f	$q_h G C_N$ (psf)				Clear Flow	
			Zone 3		Zone 2		Zone 1	
Θ°	9	$\leq a^2$	80.32	-110.44	60.24	-56.90	40.16	-36.81
	36	$> a^2 \leq 4a^2$	60.24	-56.90	60.24	-56.90	40.16	-46.86
	36	$> 4a^2$	40.16	-36.81	40.16	-36.81	40.16	-36.81


4x4 WD
STL
FRAME

MIAMI, FL 33155
T:305.266.9777 F:305.266.0584

PROJECT: SOHO BEACH HOUSE Courtyard Pergola
CLIENT:
ARCHITECT: ALLAN T. SHULMAN ARCHITECTS, P.A.

JOB NO:

Page: 5
Calc'd: FO
Checked FO
Date: 9/2/10

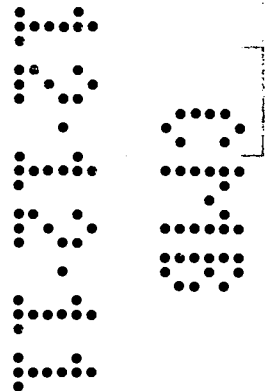

FRAMING
STEEL BEAM/POST

CANKAT ESMAN 1906 SW 57th Ave. No.1 MIAMI, FL 33155 (305)266-9777	STEEL BEAM DESIGN	Page <u>7</u> of <u> </u>
	SOHO BEACH HOUSE 9' LONG TUBULAR BEAM	Project No: <u> </u> 11/1/04
		Design: <u>MC</u> Date: 09/02/10
		Checked: <u>F.O</u> Date: <u> </u>

\\Secondchance\SharedDocs\Soho Beach\steelbeam.xls\SECTION


Programmed by: Fuat Omarli, P.E.

Beam Data: Material 46 Ksi
 Span length: 9.00 Ft
 Section Compact Distances from left
 Uniform Load: 0.144 Klf 9.0 Ft
 Partial uniform Load
 Partial uniform Load
 Partial uniform Load 9.0 Ft

BEAM HSS 6X4X3/16

Total Appl. Point Moment

Point Load	P(K)	x(Ft) from left	Dist to mid span	Dist to point of inflection
P1				
P2				
P3				
P4				
P5				
P6				
P7				
P8				
P9				
P10				

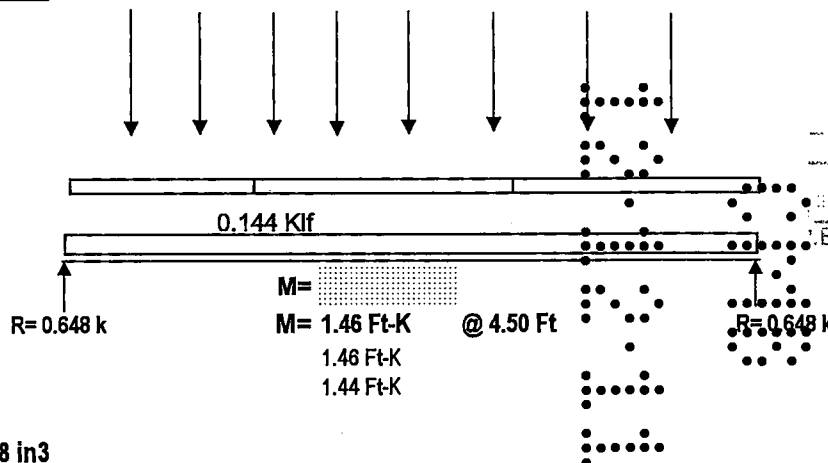

RESULT

M= 1.46 Ft-K x 12.00 = 17.5 in-K
 $S_{req'd} = M_{max} / F_b = 17.5 / 30.36 = 0.58 \text{ in}^3$

Section Properties of Laterally Supported Beam

TYPE: HSS
 SIZE: HSS6X4X3/16
 WEIGHT 12.0 Lbs/ft
 AREA 3.28 in²
 DEPTH 6.00 in
 WIDTH 4.000 in
 t web
 t flange
 t 0.188 in
 Ix 16.40 in⁴
 Sx 5.46 in³ > 0.58 in³ OK
 rx 2.23 in
 ly 8.76 in⁴
 Sy 4.38 in³
 ry 1.63 in

Deflection Check: As per FBC '02 L/360
 $\Delta = 5 / 48 * M * L^2 / E * I = 0.04 \text{ in} < 0.30 \text{ in}$ OK

Vibration Check:
 $f = 3.5 \sqrt{1 / \Delta} = 3.5 \sqrt{22.37} = 16.56 \text{ OK} > 5$

Lateral Force, P: 1.2 K
Wall length, L: 8.25 Ft ✓
Wall height, h: 9.5 Ft
Flexural mod. of Elasticity, E: 29000 Ksi
 I_2 horiz.: 12 in⁴ $k = I_2 h / I_1 L$
 I_1 Vert.: 2 in⁴ $k = 6.909$

PIN SUPPORTS



$H_A = 0.6$ K ✓
 $H_B = 0.6$ K ✓
 $M_C = -5.7$ K-Ft ✓
 $M_D = -5.7$ K-Ft
 $\Delta = M_C * L^2 / 6EI = 2.554$ in

FIXED SUPPORTS

$H_A = 0.6$ K
 $H_B = 0.6$ K ✓
 $R_A = -R_B = -3PH/L * k/(6k+1) = -0.67$ K ✓
 $M_A = -M_B = PH/2 * [(3K+1)/(6K+1)] = 2.92$ K-Ft
 $M_C = H * h - M_A = 2.78$ K-Ft
 $M_D = -H * h + M_B = -2.78$ K-Ft
 $\Delta = M_C * L^2 / 6EI = 1.247$ in

FIXED SUPPORTS AND PINNED AT TOP

$H_A = 0.6$ K
 $H_B = 0.6$ K
 $R_A = -R_B = PH/L = 0.0$ K
 $M_A = H * h = 5.70$ K-Ft
 $M_B = H * h = 5.70$ K-Ft
 $\Delta = P * L^3 / EI = 15.326$ in

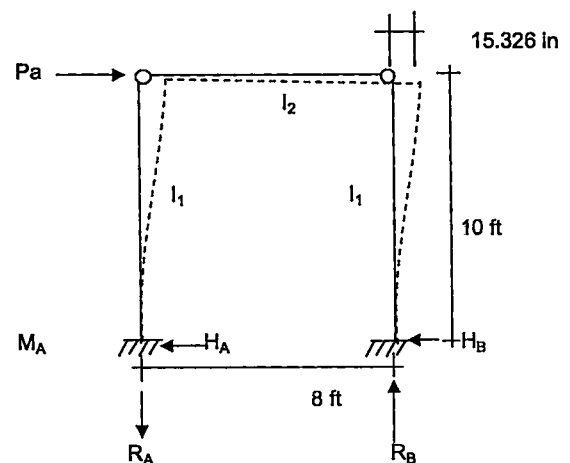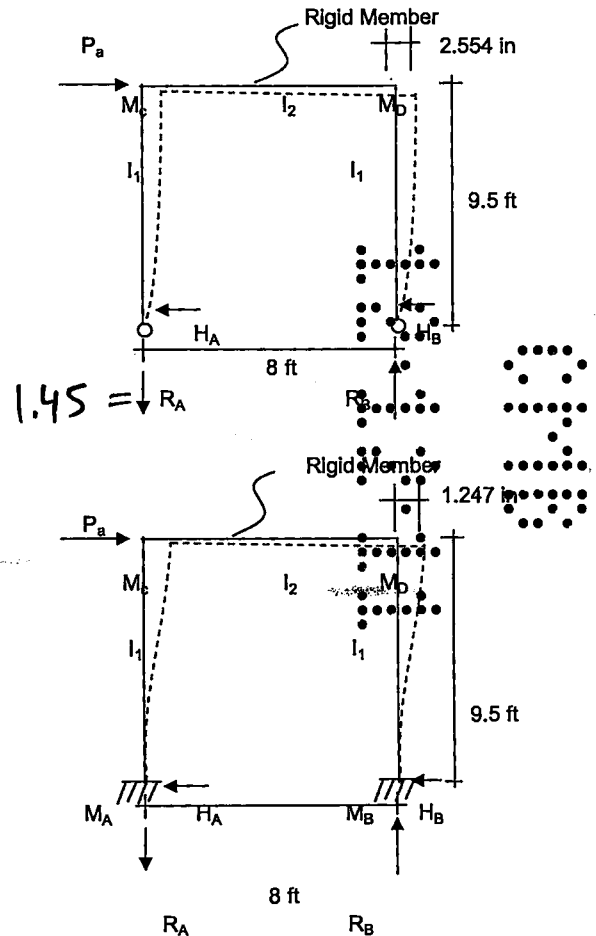

CANKAT ESSMAN 1900 SW 57th Ave, No: 1 Miami, FL 33155 (305) 266-9777	STEEL BEAM DESIGN	Page <u>9</u> of <u> </u>
	SOHO BEACH HOUSE	Project No: <u> </u> 11/1/04
	18" LONG TUBULAR BEAM	Design: <u>F.O.</u> Date: 09/02/10 Checked: <u>MC</u> Date: <u> </u>

\\Secondchance\SharedDocs\Soho Beach\steelbeam.xls\SECTION

Beam Data: Material 46 Ksi

Span length: 18.00 Ft

Section Compact

Distances from left

Start End

Uniform Load: 0.072 Klf 18.0 Ft

Partial uniform Load

Partial uniform Load

Partial uniform Load 18.0 Ft


HSS 6x4 x3/16

SINGLE SPAN
w/ LONG SPAN
CONDITION

Total Appl. Point Moment

Point Load P(K) x(Ft) from left Dist to mid span Dist to point of inflection

P1
P2
P3
P4
P5
P6
P7
P8
P9
P10

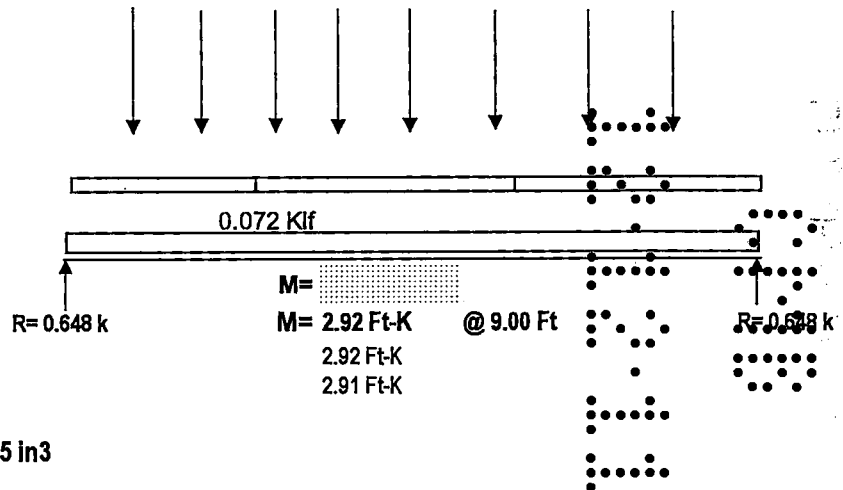

RESULT

M= 2.92 Ft-K x 12.00 = 35.0 in-K

$S_{req'd} = M_{max}/F_b = 35.0 / 30.36 = 1.15 \text{ in}^3$

Section Properties of Laterally Supported Beam

TYPE: HSS

SIZE: HSS6x4x3/16

WEIGHT 12.0 Lbs/ft

AREA 3.28 in²

DEPTH 6.00 in

WIDTH 4.000 in

t web

t flange

t 0.188 in

Ix 16.40 in⁴

Sx 5.46 in³ > 1.15 in³ OK

r x 2.23 in

Iy 8.76 in⁴

Sy 4.38 in³

ry 1.63 in

Deflection Check: As per FBC '02 $L/360$
 $\Delta = 5/48 * M * L^2 / E * I = 0.36 \text{ in} < 0.60 \text{ in}$ OK

Vibration Check:
 $f = 3.5 \sqrt{1/\Delta} = 3.5 \sqrt{2.80} = 5.85$ OK > 5

Lateral Force, P: 1.2 K
Wall length, L: 18 Ft ✓
Wall height, h: 9.5 Ft
Flexural mod. of Elasticity, E: 29000 Ksi
 I_2 horiz. 12 in⁴ $k = I_2 h / I_1 L$
 I_1 Vert. 2 in⁴ $k = 3.167$

PIN SUPPORTS



$H_A = 0.6$ K ✓
 $H_B = 0.6$ K
 $M_C = -5.7$ K-Ft ✓
 $M_D = -5.7$ K-Ft
 $\Delta = M_C \cdot L^2 / 6EI = 2.554$ in

FIXED SUPPORTS

$H_A = 0.6$ K
 $H_B = 0.6$ K
 $R_A = -R_B = -3PH/L \cdot k/(6k+1) = -0.30$ K ✓
 $M_A = -M_B = -PH/2 \cdot [(3K+1)/(6K+1)] = 2.99$ K-Ft
 $M_C = H \cdot h - M_A = 2.71$ K-Ft
 $M_D = -H \cdot h + M_B = -2.71$ K-Ft
 $\Delta = M_C \cdot L^2 / 6EI = 1.213$ in

FIXED SUPPORTS AND PINNED AT TOP

$H_A = 0.6$ K
 $H_B = 0.6$ K
 $R_A = -R_B = PH/L = 0.0$ K
 $M_A = H \cdot h = 5.70$ K-Ft
 $M_B = H \cdot h = 5.70$ K-Ft
 $\Delta = P \cdot L^3 / EI = 15.326$ in

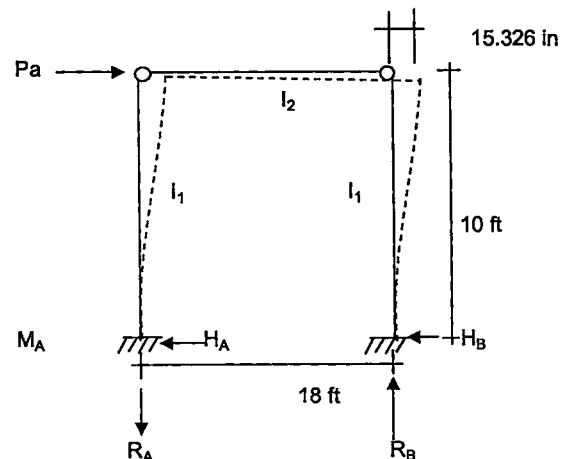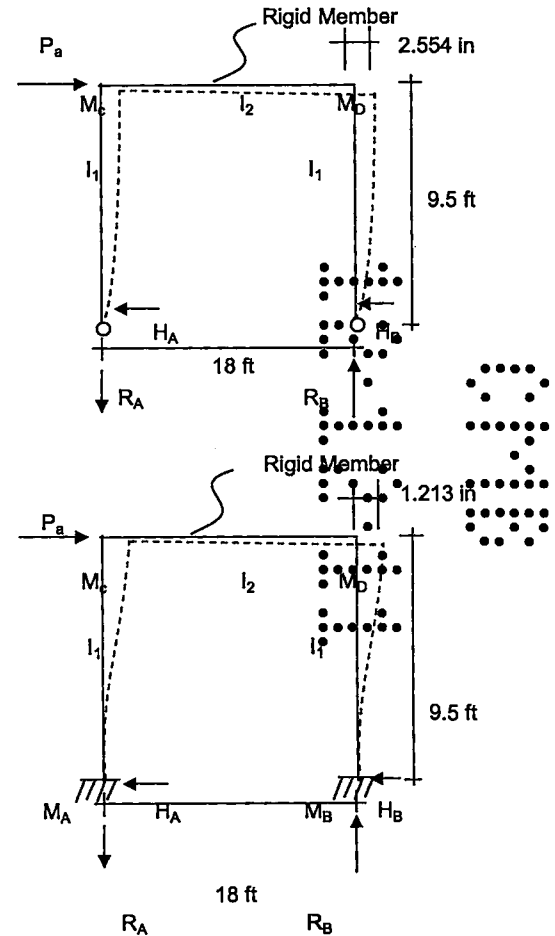

cankat - essman inc.

PROJECT Solo BEACH HOUSE COURTYARD PERGOLA
 LOCATION MIAMI BEACH, FL
 SUBJECT FRAMING

PAGE 11 OF 17
 JOB NO 10017
 DATE 9/21/2010
 BY MC

$q_{wind} = 60 \text{ psf (for rafter)}$, $40 \text{ psf (for frame)}$



$q_{rafter} = 60 \times 0.25 = 15 \text{ plf}$ $q_{frame} = 40 \times 0.5 = 20 \text{ plf}$

Trib. width = 8'

$F = 0.015 \times 8 \times 10 \text{ ps} = 1.2$

Trib width = 4'

$F = 0.015 \times 4 \times 20 \text{ ps} = 1.2$

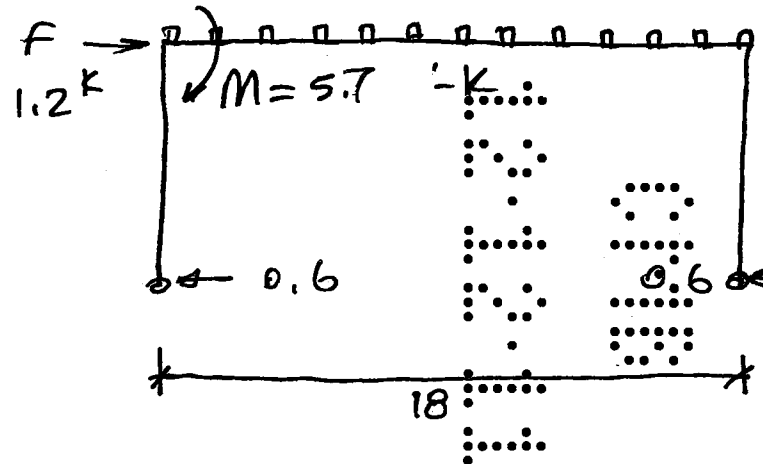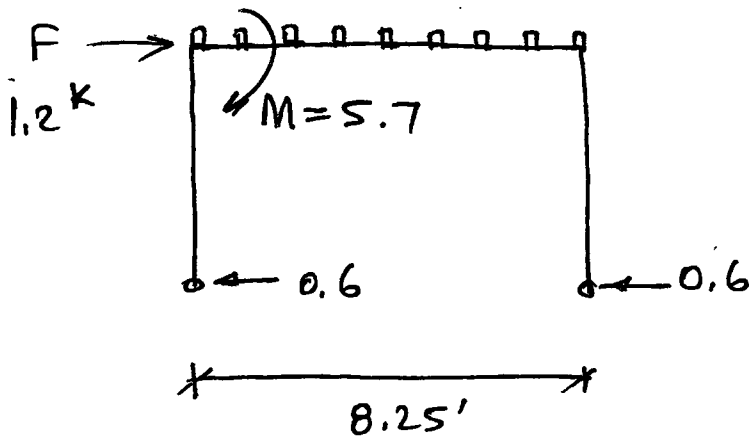

0.65 ↓
 1.45 ↑

FRAME-1

0.65 ↓
 1.45 ↓

0.65 ↓
 0.56 ↑

FRAME-2

0.65 ↓
 0.56 ↓

Total ↑ 0.8
 (Up)

↓ 2.05
 (down)

0.09 ↓
 (down)

1.21 ↓
 (down)

USE FOR
 EXP. BOLT
 DESIGN

cankat - essman inc.

PROJECT SOFT BEACH HOUSE COURTYARD PERGOLA
 LOCATION MIAMI BEACH, FL.
 SUBJECT WOOD RAFTERS

PAGE 12 OF
 JOB NO 10017
 DATE 9/21/2010
 BY MC

4" x 4" PT. WOOD RAFTERS @ 12" o/c

SOUTHERN PINE #2 OR BETTER

$$L_{max} = 11'-3"$$

$$A = 12.25 \text{ sq in}$$

$$S_{x-x} = 7.146 \text{ in}^3$$

$$I_{x-x} = 12.51 \text{ in}^4$$

* $F_b = 1,500 \text{ psi}$ *OR FOR 4" WIDE
 $F_t = 825 \text{ psi}$ CONSTRUCTION
 $F_v = 175 \text{ psi}$ GRADE
 $F_c = 565 \text{ psi}$ $F_b = 1,100 \text{ psi}$
 $E = 1.6 \times 10^6 \text{ psi}$

$$W_w = 60 \text{ psf (CONSERVATIVE)}$$

$$\text{@ EA. RAFTER } W_w = 60 \times 3.5/12 = 17.5 \text{ plf.}$$

$$M_w = 17.5 \times 11.25^2/8$$

$$M_w = 277 \text{ ft-lb.}$$

$$f_{bx} = \frac{277 \times 12}{7.14} = 465 \text{ psi} < 1,100 \text{ psi} \quad \text{OK}$$

$$V = 17.5 \times 11.25/2$$

$$V = 66 \text{ lbs.} \uparrow$$

$$v = \frac{4}{3} \frac{66}{3.5 \times 3.5} = 7 \text{ psi} \ll 175 \text{ psi}$$

MAX. CANTILEVER END $L = 2'-7"$

CHECK

$$M_{cant} = 17.5 \times 2.58^2/2$$

$$M_{cant} = 58 \text{ ft-lb} < 277 \text{ ft-lb} \quad \text{DO NOT GOVERN}$$


NOTE : NO ADJUSTMENT FACTORS ARE USED
 SINCE STRESSES ARE VERY LOW ... OK ✓

MIAMI, FL 33155
T:305.266.9777 F:305.266.0584

PROJECT: SOHO BEACH HOUSE Courtyard Pergola
CLIENT:
ARCHITECT: ALLAN T. SHULMAN ARCHITECTS, P.A.


JOB NO:

Page: 13
Calc'd: FO
Checked FO
Date: 9/2/10

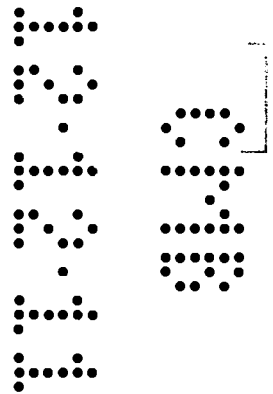

CONNECTIONS

MOMENT CONNECTION @ TOP OF POST W/ BEAM.

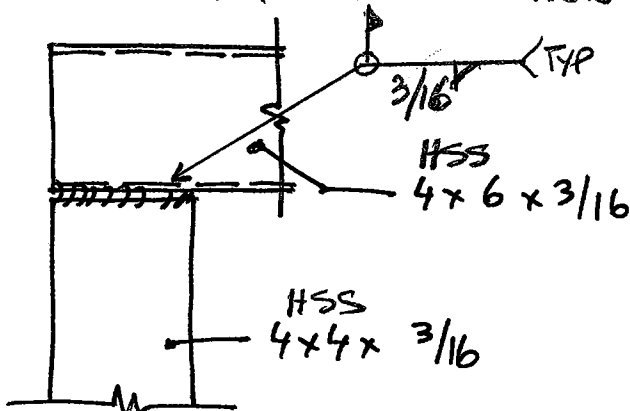


$$M = 5.7 \text{ 'K}$$

$$S = 4.209 \text{ in}^3 (*)$$

$$f_w = \frac{5.7 \times 12}{4.209} = 16.25$$


$$F_{w \text{ allow}} = 21 \text{ ksi} > f_w$$

$$F_{w \text{ allow}} = 0.3 \times 70 \text{ ksi} = 21 \text{ ksi}$$

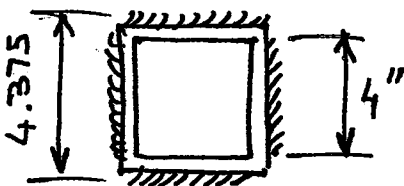

BASE CONNECTION W/ EXPANSION BOLTS

FROM PAGE 11 MAXIMUM REACTIONS @ BASE

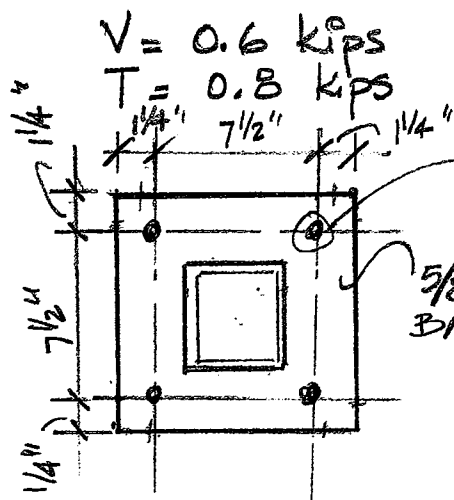

TOTAL (4) $5/8"$ HILTI-KWIK BOLT 3
 W/ $4"$ EMBEDMENT

$5/8 \times 10 \times 10"$
 BASE PL.

4 BOLTED COLUMN BASE

$$V' = 0.6/4 = 0.15 \text{ kips/BOLT}$$

$$T = 0.8/4 = 0.20 \text{ kips/BOLT}$$

CONT'D ON PAGE 16

*) See NEXT PAGE FOR WELD SECTION MODULUS,
 (PAGE -15)

CANKAT ESSMAN 1900 SW 57th Ave. Miami, FL 33155 Tel: (305) 266-9777	Project: SOHO BEACH HOUSE	Engineer: FO	Page:
		Date: 2-Sep	15
	Subject: 4X4 POST WELD	Checker: MC	Project #
		Date: 2-Sep	



PROPERTIES OF SECTION DESCRIBED BY NODES COORDINATES

Units: in

Nodes Coordinates		
	X	Y
1		
2		4.375
3	4.375	4.375
4	4.375	
5		
6	0.188	0.188
7	4.188	0.188
8	4.188	4.188
9	0.188	4.188
10	0.188	0.188
11		
12		
Section Properties About Centroidal Axis Parallel to Original Axis			
ϕ =	45.00000 deg	X-dim =	4.3750 in
A =	3.14063 in ²	Y-dim =	4.3750 in
Xcg =	2.18495 in	Sx(top) =	4.1994 in ³
Ycg =	2.18495 in	Sx(bot) =	4.2092 in ³
Ixo =	9.19694 in ⁴	Sy(left) =	4.2092 in ³
Iyo =	9.19694 in ⁴	Sy(right) =	4.1994 in ³
Ixyo =	-0.00002 in ⁴		

Section Properties About Principal Axis			
ϕ =	45.00000 deg	Sxp(top) =	2.9729 in ³
Ixp =	9.19696 in ⁴	Sxp(bot) =	2.9729 in ³
Iyp =	9.19691 in ⁴	Syp(left) =	2.9764 in ³
Ixyp =	0.00000 in ⁴	Syp(right) =	2.9694 in ³
J =	18.39387 in ⁴		

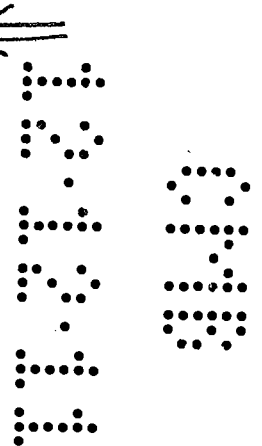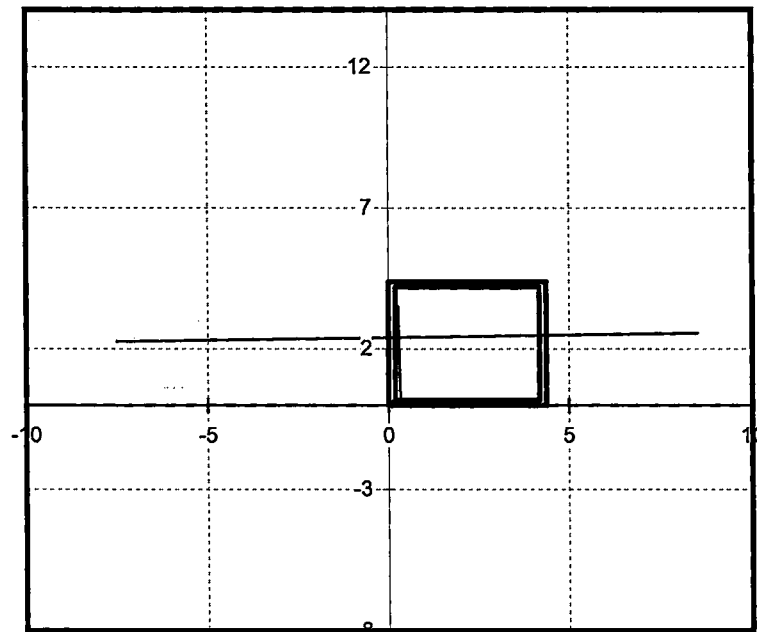

PROJECT SOHO BEACH HOUSE COURTYARD PERGOLA
 LOCATION MIAMI BEACH, FL.
 SUBJECT CONNECTIONS

PAGE 16 OF
 JOB NO 10017
 DATE 9/21/2010
 BY MC

MIN. EDGE DIST { FOR TENSION $\Rightarrow 1.75 \times 4 = 7"$
 FOR SHEAR $\Rightarrow 3 \times 4 = 12"$
 BOLT SPACING (T & V) $\Rightarrow 3 \times 4 = 12"$

ALL COLUMNS

WITH THE EXCEPTION OF COLUMNS NEXT TO TRENCH
 HAVE MORE THAN 12" EDGE DISTANCE.

CHECK COLUMN BASE NEXT TO TRENCH.

EDGE DISTANCE = 5" (WORST CONDITION)

& $h_{nominal} = 4"$ (EMBEDMENT)

ADJUSTMENT FACTORS

TENSION / SHEAR (Spacing) $7\frac{1}{2} \Rightarrow f = \frac{2.87}{2.87}$

TENSION (Edge Distance) = 5" $\Rightarrow f_{RN} = 0.9$

SHEAR (Edge Distance) = 5" $\Rightarrow f_{RV} = 0.6$

TENSION CAP / PER BOLT (CONCRETE $f'_c = 3000$ psi)

$$T = 2.87 \times 0.96 \times 0.9$$

$$T = 2.47 > 0.2 \text{ kips. OK.}$$

SHEAR CAP / PER BOLT

$$V = 4.89 \times 0.80 \times 0.96 \times 0.6$$

20% REDUCTION

$$V = 2.29 \text{ kips} > 0.15 \text{ kips OK.}$$

COMBINED TENSION & SHEAR

$$\left(\frac{0.2}{2.47} \right) + \left(\frac{0.15}{2.29} \right) = 0.14 \ll 1.0 \text{ OK.}$$

WOOD RAFTER TO STEEL TUBE CONNECTION

PULL OUT @ END CONNECTION (FROM PAGE 12) $66 \text{ lbs} \ll (0.25 \times 4297)$ *

* SEE APPENDIX ITW BUILDEX $\frac{1}{4}$ -20 x 3 SELF DRILLING SCREWS = 1074 lbs

ALL OTHER CONNECTION, REACTIONS ARE LOW & BY INSPECTION. OK.

MIAMI, FL 33155
T:305.266.9777 F:305.266.0584

PROJECT: SOHO BEACH HOUSE Courtyard Pergola

JOB NO:

CLIENT:
ARCHITECT: ALLAN T. SHULMAN ARCHITECTS, P.A.

Page:
Calc'd: FO
Checked FO
Date: 9/2/10

APPENDIX



BUILDING CODE COMPLIANCE OFFICE (BCCO)
PRODUCT CONTROL DIVISION

B100002

PAGE - 18

MIAMI-DADE COUNTY, FLORIDA
METRO-DADE FLAGLER BUILDING
140 WEST FLAGLER STREET, SUITE 1603
MIAMI, FLORIDA 33130-1563
(305) 375-2901 FAX (305) 375-2908

NOTICE OF ACCEPTANCE (NOA)

Hilti, Inc.
5400 S. 122nd East Avenue
Tulsa OK 74146

SCOPE:

This NOA is being issued under the applicable rules and regulations governing the use of construction materials. The documentation submitted has been reviewed by Miami-Dade County Product Control Division and accepted by the Board of Rules and Appeals (BORA) to be used in Miami Dade County and other areas where allowed by the Authority Having Jurisdiction (AHJ).

NOTICE: In addition to the above, The Miami-Dade County Product Control Division (In Miami Dade County) and the BCCO (In areas outside of Miami-Dade County) reserve the right to have this product or material tested for quality assurance purposes. If the product or material fails to perform in the accepted manner, the manufacturer will incur the expense of such testing and water. Miami-Dade County, state agencies, or federal agencies. The City of Miami Beach assumes no responsibility for accuracy of or material fails to meet the requirements of the applicable building code, Rules, and Regulations.

This product is approved as described herein, and has been designed to comply with the Florida Building Code, including the High Velocity Hurricane Zone.

DESCRIPTION: Kwik Bolt 3 Concrete Expansion Anchor.

APPROVAL DOCUMENT: Drawing No. 543-003-C, Sheets 1 of 1, titled "Hilti Kwik Bolt 3 Mechanical Expansion Anchor for Concrete and Masonry Elements" dated 11/12/98 with last revision on 10/31/06, prepared by T. E. Lunn PE Engineering, signed and sealed by T. E. Lunn PE, bearing the Miami-Dade County Product Control Approval stamp with the Notice of Acceptance (NOA) number and approval date by the Miami-Dade County Product Control Division.

MISSILE IMPACT RATING: None

LABELING: Each unit or box shall bear a permanent label with the manufacturer's name or logo, city, state and following statement: "Miami-Dade County Product Control Approved or MDCPCA", unless otherwise noted herein.

RENEWAL of this NOA shall be considered after a renewal application has been filed and there has been no change in the applicable building code negatively affecting the performance of this product.

TERMINATION of this NOA will occur after the expiration date or if there has been a revision or change in the materials, use, and/or manufacture of the product or process. Misuse of this NOA as an endorsement of any product, for sales, advertising or any other purposes shall automatically terminate this NOA. Failure to comply with any section of this NOA shall be cause for termination and removal of NOA.

ADVERTISEMENT: The NOA number preceded by the words Miami-Dade County, Florida, and followed by the expiration date may be displayed in advertising literature. If any portion of the NOA is displayed, then it shall be done in its entirety.

INSPECTION: A copy of this entire NOA shall be provided to the user by the manufacturer or its distributors and shall be available for inspection at the job site at the request of the Building Official.

This NOA consist of this page 1, evidence page as well as approval document mentioned above.

The submitted documentation was reviewed by Candido F. Font, P.E.



12/28/06

NOA No 06-0810.13
Expiration Date: December 28, 2011
Approval Date: December 28, 2006

Page 1

NOTICE OF ACCEPTANCE: EVIDENCE PAGE

A DRAWINGS:

1. Drawings prepared by T.E. Lunn PE Engineering, titled "Hilti Kwik Bolt 3 Mechanical Expansion Anchor for Concrete and Masonry Elements"; Drawing No. 543-003-C, dated 11/12/98 with last revision on 10/31/06, sheet 1 of 1, signed and sealed by T.E. Lunn PE.

B TEST:

	Laboratory No.	Test Report.	Date.	Signature
1.	CEL 51792C	ASTM E488	05/22/06	L.W. Mattis PE.
2.	STTS 99-0513.01	ASTM G85 Annex 5	08/25/05	M. Mosbat PE.

C CALCULATIONS:

N/A

D QUALITY ASSURANCE.


1. Building Code Compliance Office.


E MATERIAL CERTIFICATIONS:

N/A

F STATEMENTS:


1. No interest letter issued by T.E. Lunn on 07/20/06, signed and sealed by T.E. Lunn, PE.
2. Code compliance letter issued by T.E. Lunn on 07/20/06 signed and sealed by T. E. Lunn, PE.


12/28/06
Candido F. Font, P.E.
Senior Product Control Examiner
NOA No 06-0810.13
Expiration Date: December 28, 2011
Approval Date: December 28, 2006

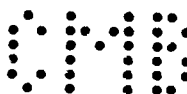

DESCRIPTION:

HILTI Kwik Bolt 3 is a stud type expansion anchor with a single piece wedge which expands in concrete and CMU when torque is applied. They are supplied with a nut and washer.

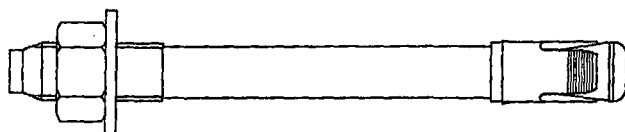

Anchor Diameter (in.)	Fracture Load (lb)
1/4	2,900
3/8	7,200
1/2	12,400
5/8	19,600
3/4	28,700

MATERIAL CHARACTERISTICS:


1" carbon steel studs, conform to AISI 11L41.
Nuts are carbon steel conforming to ASTM A563 Grade A and meet dimensional requirements of ANSI B18.2.2.
Washers are made from carbon steel conforming to ASTM F844 and meet dimensional requirements of ANSI 18.22.1 Type A plain.
All 3/8", 1/2", 5/8", and 3/4" wedges are made from carbon steel.
All 1/4" and 1" wedges are made from stainless steel.

GENERAL NOTES:

- Design values in pounds are equal to ultimate load divided by 4.
- Edge distance shall be 1.75 times the minimum embedment for tension and 3 times the minimum embedment for shear. Anchor center to center distance shall be 3 times the minimum embedment.
- Anchor installation shall be made in accordance with Hilti's published installation instructions in the Product Technical Guide. Limit one anchor per cell.
- Anchor installation in grouted concrete masonry units require a minimum 12" distance and 8" spacing. Limit one anchor per cell.
Avoid installation within 1-3/8" of any vertical mortar joint.
- Values shown are for shear plane through the anchor body.
- When the shear plane is acting through the anchor threads, reduce the shear by 10%.
- When the shear plane is acting through the anchor threads, reduce the shear by 6%.
- When the shear plane is acting through the anchor threads, reduce the shear by 20%.

DESIGN VALUES:

Dia. (in.)	Min. Embed. (in.)	3000 psi		CMU Grouted	
		Tension	Shear	Tension	Shear
1/4	2	623	458	-	-
3/8	2-1/2	1355	1460 ^a	780	1155
1/2	3-1/2	2185	2343 ^a	905	1723
5/8	4	2870	4885 ^a	1295	1723
3/4	4-3/4	3635	6173 ^a	-	-
1	6	4808	9200	-	-

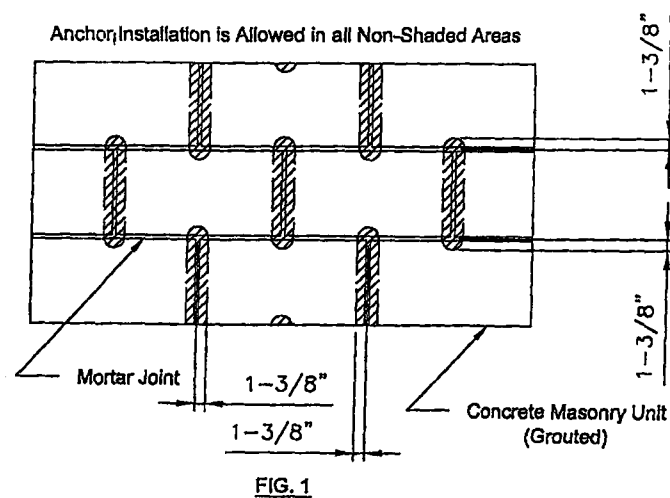

ENGINEERING

23 THURSTON DR.
PALM BEACH GARDENS, FL 33418
OFF: (561) 625-6655
FAX: (561) 625-6653
EMAIL: info@hilti.com
FLORIDA REG. # 26119

[Signature]
11.6.06

HILTI, INC.
5400 S 122nd E Ave
Tulsa, OK 74146


HILTI KWIK BOLT 3
MECHANICAL
EXPANSION ANCHOR
FOR CONCRETE
AND MANSONRY
ELEMENTS

REVISION DATE: 31-10-06
DATE: 11-12-98
DRAWING: 543-003-C
SCALE: 1" = 1"
SHEET NO. 1 OF 1

FOR OFFICE USE

Approved as complying with the
Florida Building Code
Date: 12/28/06
By: *[Signature]*
Miami Code Project Control
Division

Selector Guide

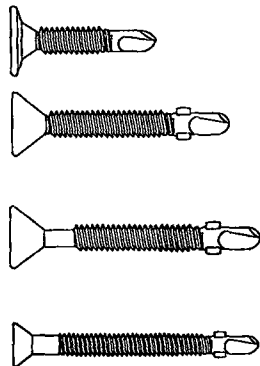

Part Number	Description	Head Style	Drill Point	Drill & Tap Capacity	Wood Attachment Range	Applications
1077000	10-24 x 3/4"	Wafer	#3	.036-.175	1/4"-3/8"	• Plywood, mansard, fascia roofing, flooring to steel framing.
1079000	10-24 x 1"	Wafer	#3	.036-.175	1/4"-1/2"	
1082000	10-24 x 1-7/16"	PFH ww*	#3	.060-.175	1/4"-3/4"	
1087000	10-16 x 1-13/16"	PFH	#3	.036-.175	1/4"-3/4"	
1092000	12-24 x 2-1/4"	PFH ww*	#4	.125-.250	3/4"-1-3/8"	• Plywood, 2 X 4's header to steel framing.
1094000	12-24 x 2-3/4"	PFH ww*	#4	.125-.250	3/4"-1-5/8"	
1096000	1/4-20 x 3"	PFH ww* *ww with wings	#4	.125-.250	3/4"-2"	• 2 X 4's to steel framing.

Performance Data

PULLOUT VALUES (average lbs. ultimate)											
Fastener		Steel Gauge									
Dia.	Pt.	26	24	22	20	18	16	14	12	3/16	1/4
#10	3				299	499	708	967	1474		
#12	4.5						683	923	1508	3865	4101
1/4	4						788	1116	1803	4297	

FASTENER VALUES			
Fastener (dia-pt)	Tensile (lbs. min.)	Shear (avg. lbs. ult.)	Torque (min. in. lbs.)
10-16 T/3	1936	1400	61
10-24 T/3	2702	1500	65
12-24 T/4	3165	2200	150
1/4-20	3860	2700	168

SHEET STEEL GAUGES								
Gauge No.	12	14	16	18	20	22	24	2
Decimal Equivalent	.105"	.075"	.060"	.048"	.036"	.030"	.024"	.015"

SHEAR VALUES (average lbs. ultimate)									
Fastener		Steel Gauge (lapped)							
Dia.	Pt.	20	18	16	14	12	10	8	1/4
#10	3	728	1266	1540	1722				
#12	4.5					2641	2887	2897	
1/4	4					2650	2820		

The values listed are ultimate averages achieved under laboratory conditions and apply to Buildex manufactured fasteners only. Appropriate safety factors should be applied to these values for design purposes.

Installation Guidelines

- A standard screwgun with a depth sensitive nosepiece should be used to install Tek's. For optimal fastener performance, the screwgun should be a minimum of 4 amps and have a RPM range of 0-2000.
- Adjust the screwgun nosepiece to properly seat the fastener.
- Worn or damaged bit tip should be replaced.
- The fastener is fully seated when the head is flush with the work surface.

- Overdriving may result in torsional failure of the fastener or stripout of the substrate.
- The fastener must penetrate beyond the metal structure a minimum of 3 pitches of thread.
- All #10 diameter "Winged" parts must be driven into a minimum of 16 GA steel thickness; all 1/4 and #12 diameter "Winged" parts must be driven into a minimum of 1/8" steel in order to break the wings consistently.

ITW Buildex

Teks®, Climaseal™ and Building Ideas that Work™ are trademarks of ITW Buildex and Illinois Tool Works Inc.

BUILDING IDEAS THAT WORK™
1349 West Bryn Mawr Avenue
Itasca, Illinois 60143
630/595-3500 FAX: 630/595-3549
©1997 Illinois Tool Works, Inc.









REVISIONS	BY
1. CROSS BRACING ADDED	J.M.F.
2. BLUES PER CHANGES	J.M.F.

COURT YARD & LONG BAR PERGOLA
SOHO BEACH HOUSE
 4385 COLLINS AVENUE, MIAMI BEACH, FL, 33140


SECTIONS

cankat-essman, inc.
 consulting engineers
 STATE OF FLORIDA CA No. 00004419
 1900 S.W. 57th AVE. SUITE 1, MIAMI, FL 33155
 PHONE (305) 266-9777 FAX (305) 266-0584
 LAWRENCE J. ESSMAN, P.E. FL REG. NO. 6878
 MUSTAFA CANKAT, P.E. FL REG. NO. 18632


Date: SEPT 21, 2010
 Scale: AS NOTED
 Drawn: J.M.F.
 Job: 10017
 Dwg #: **S-2**
 Sheet 2 of 2

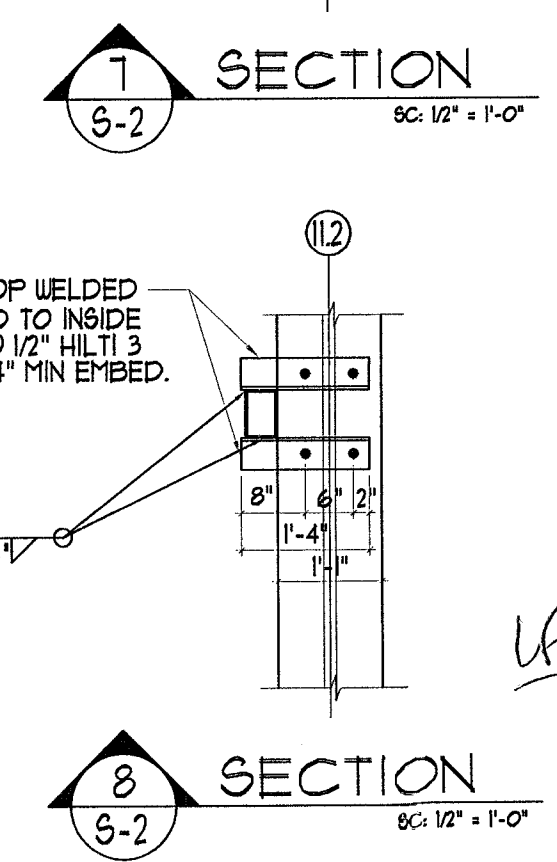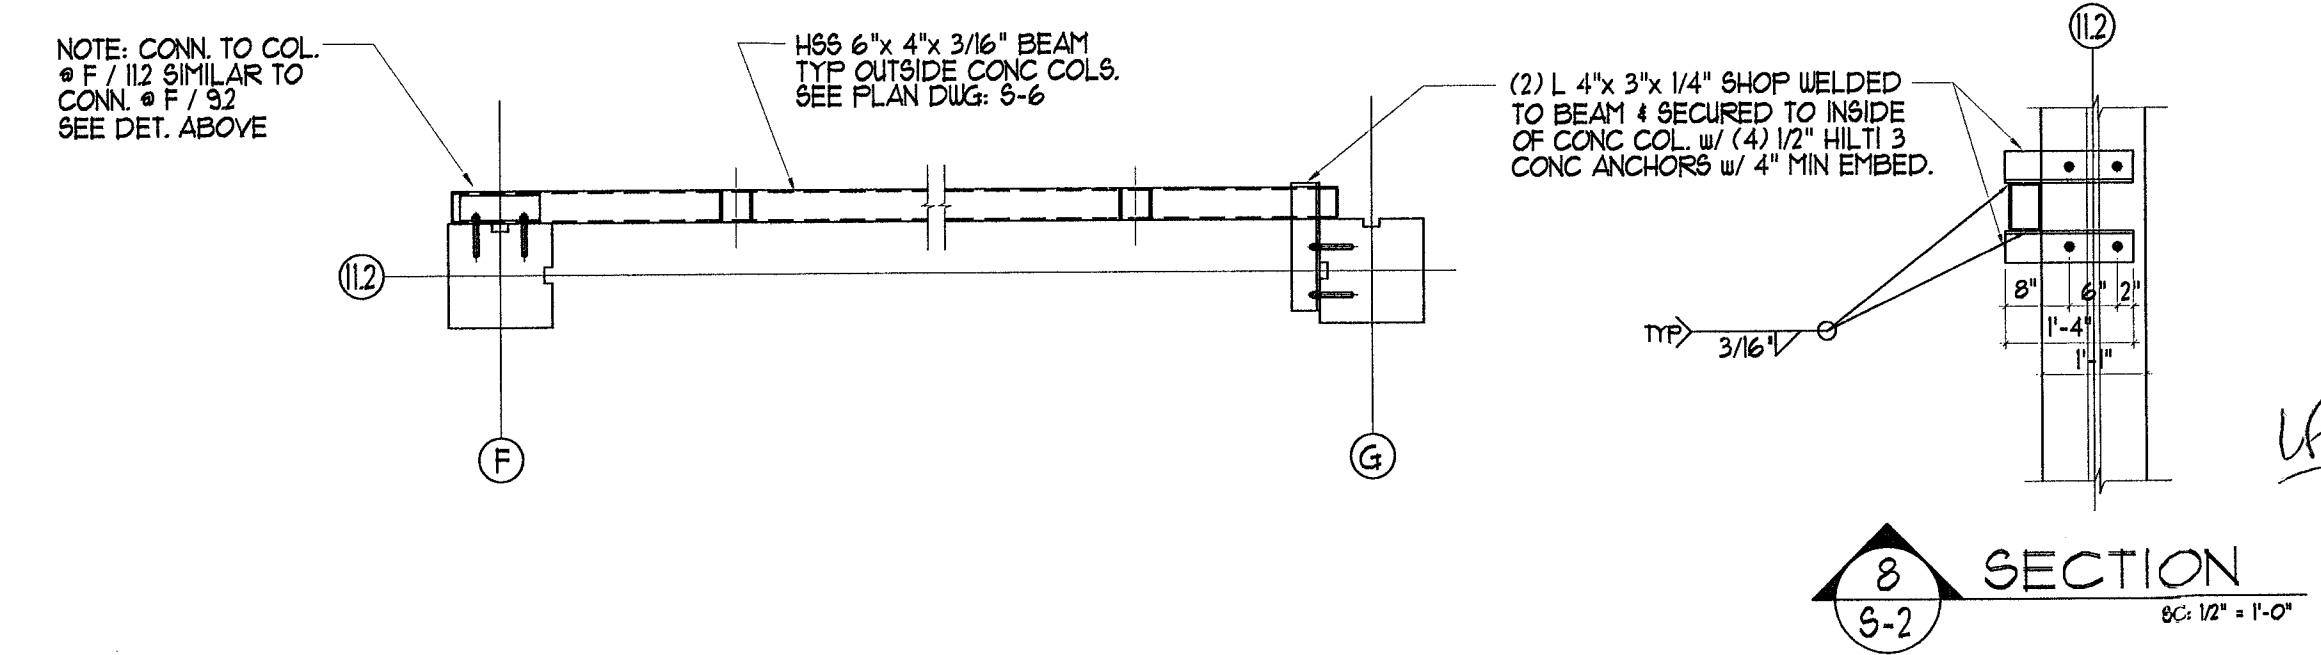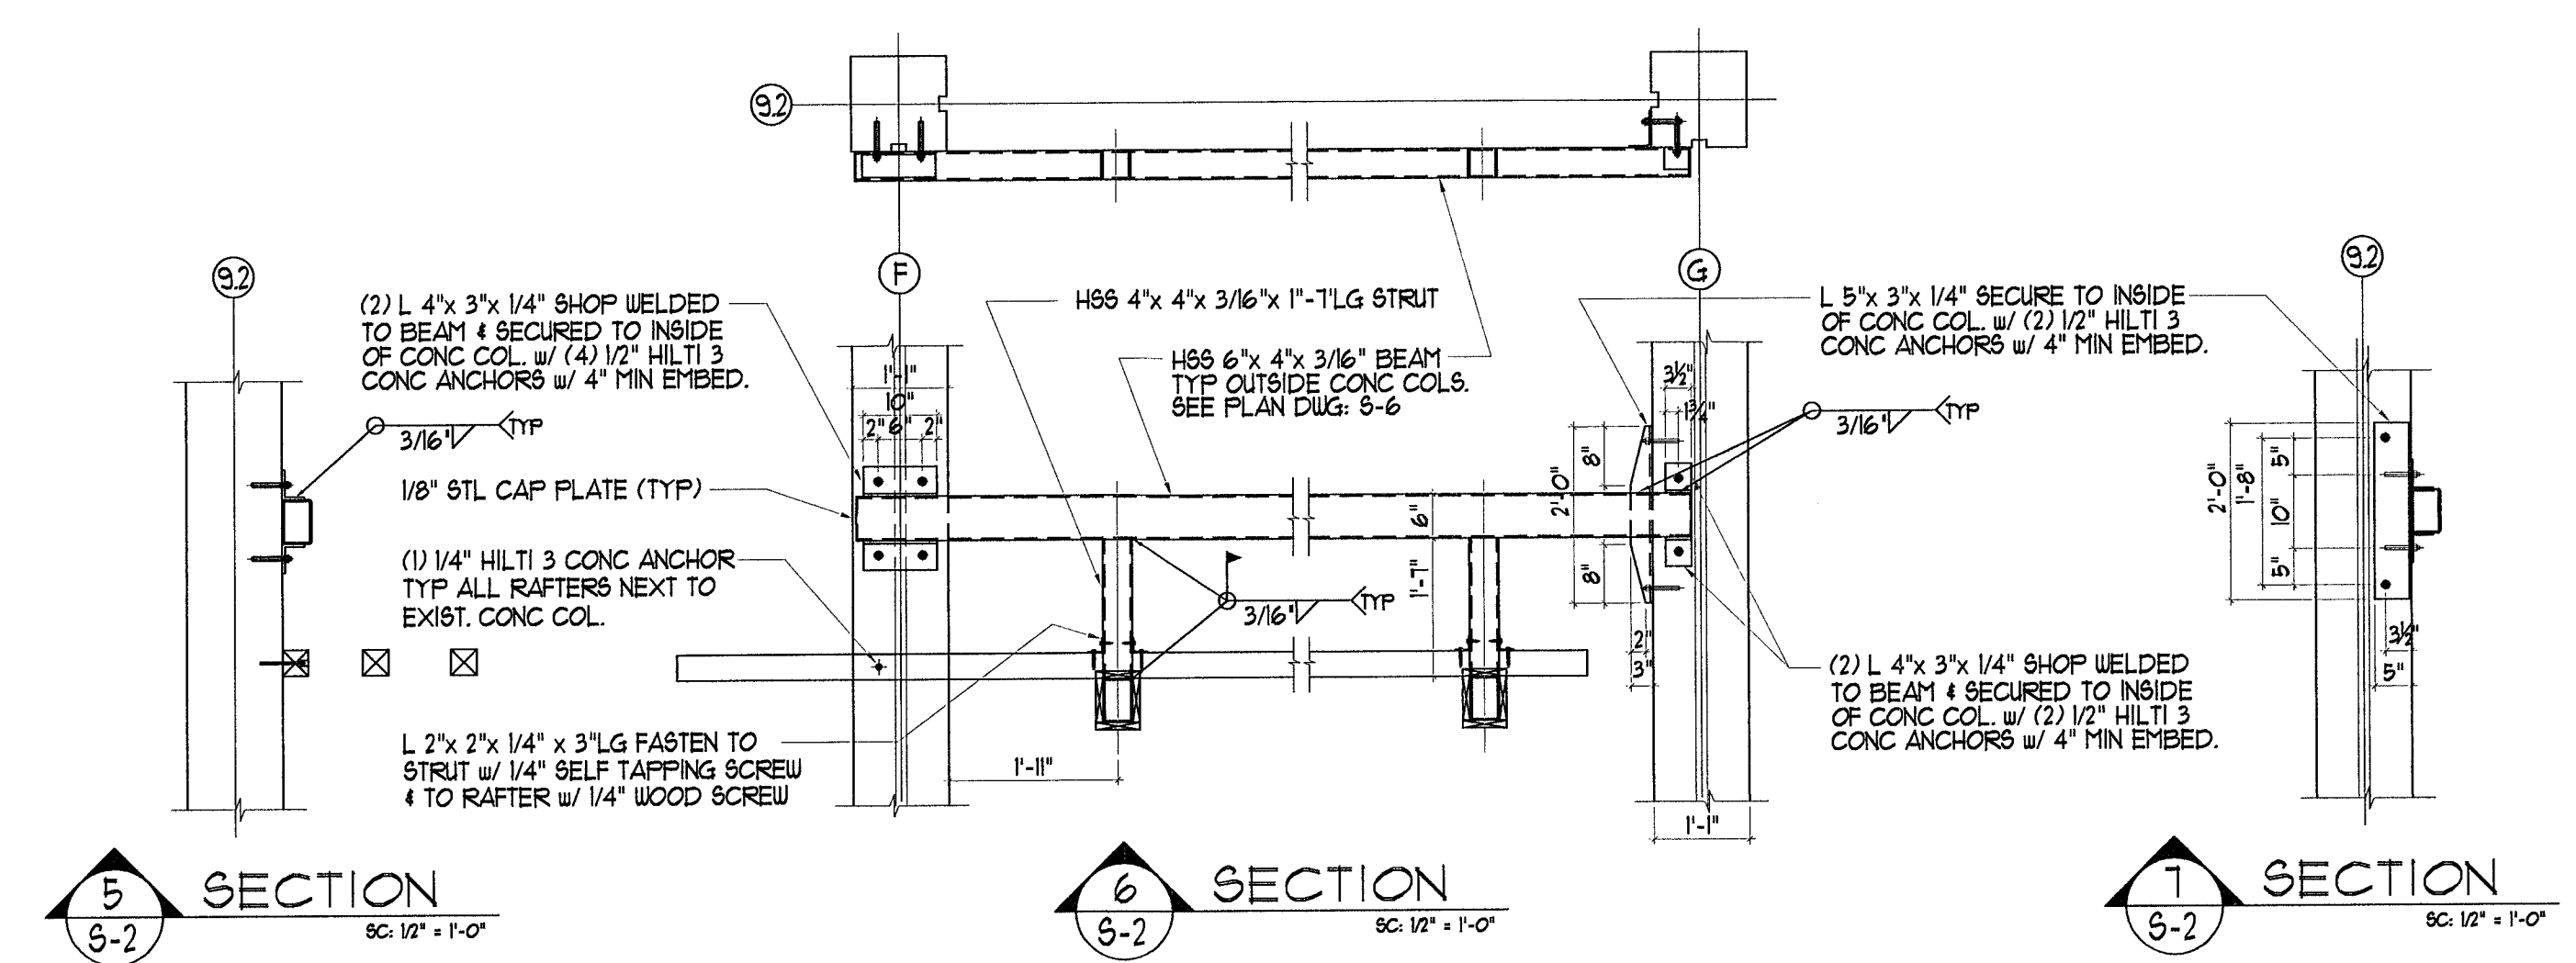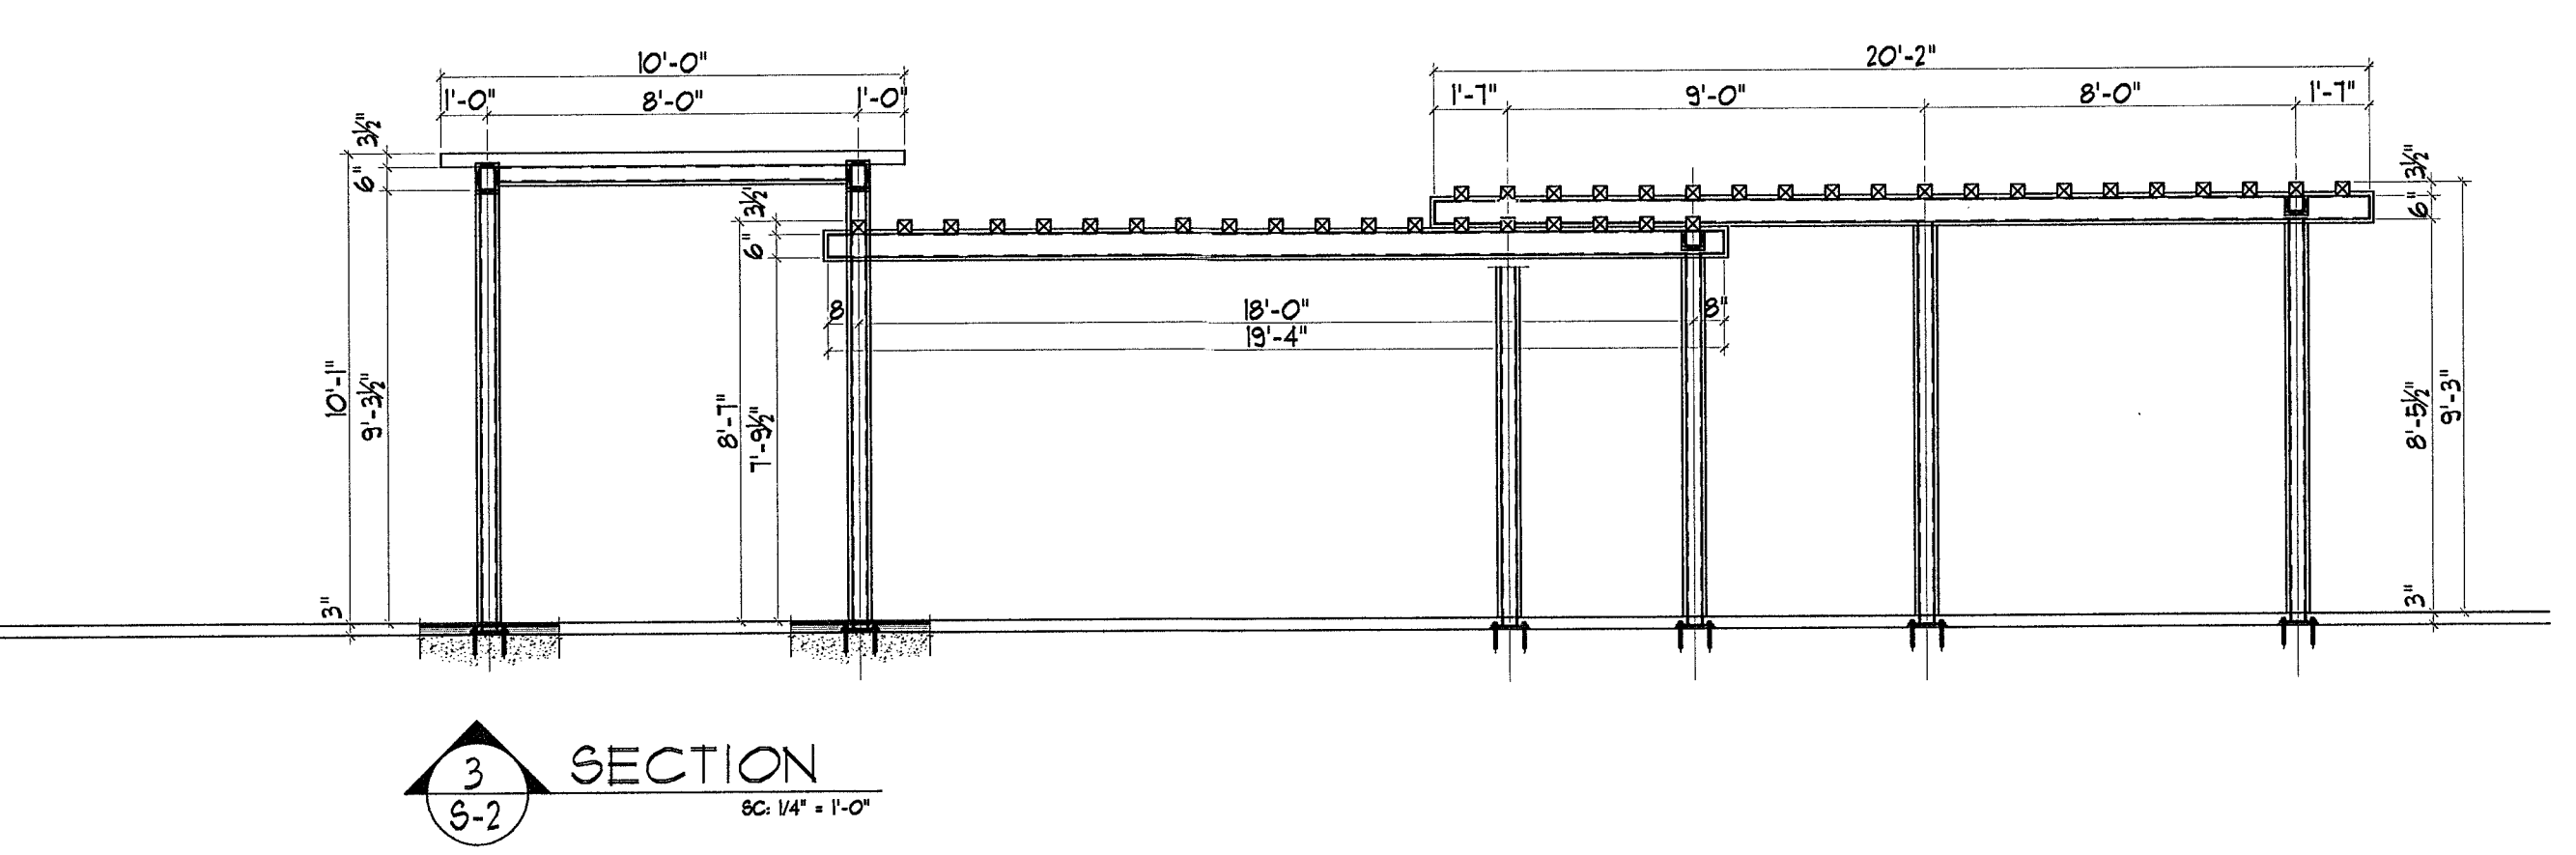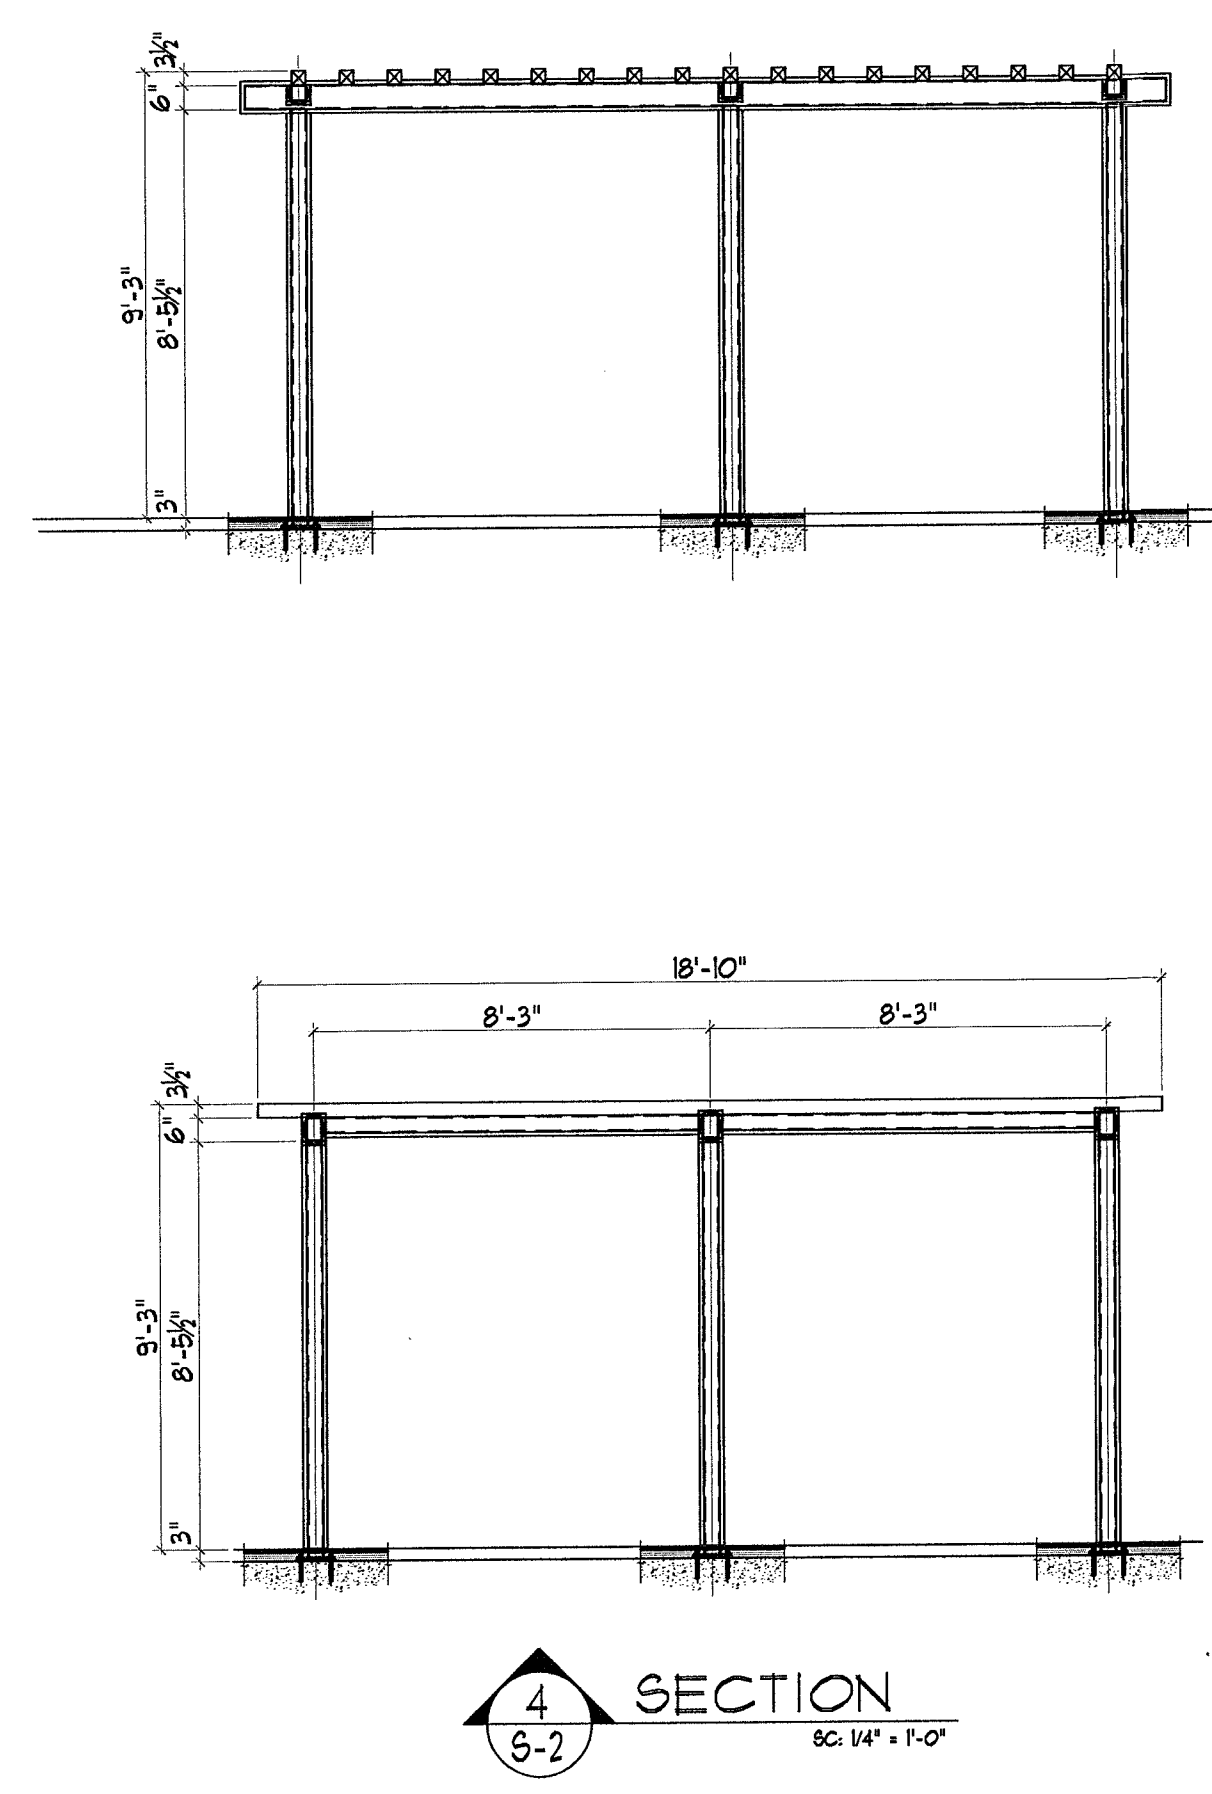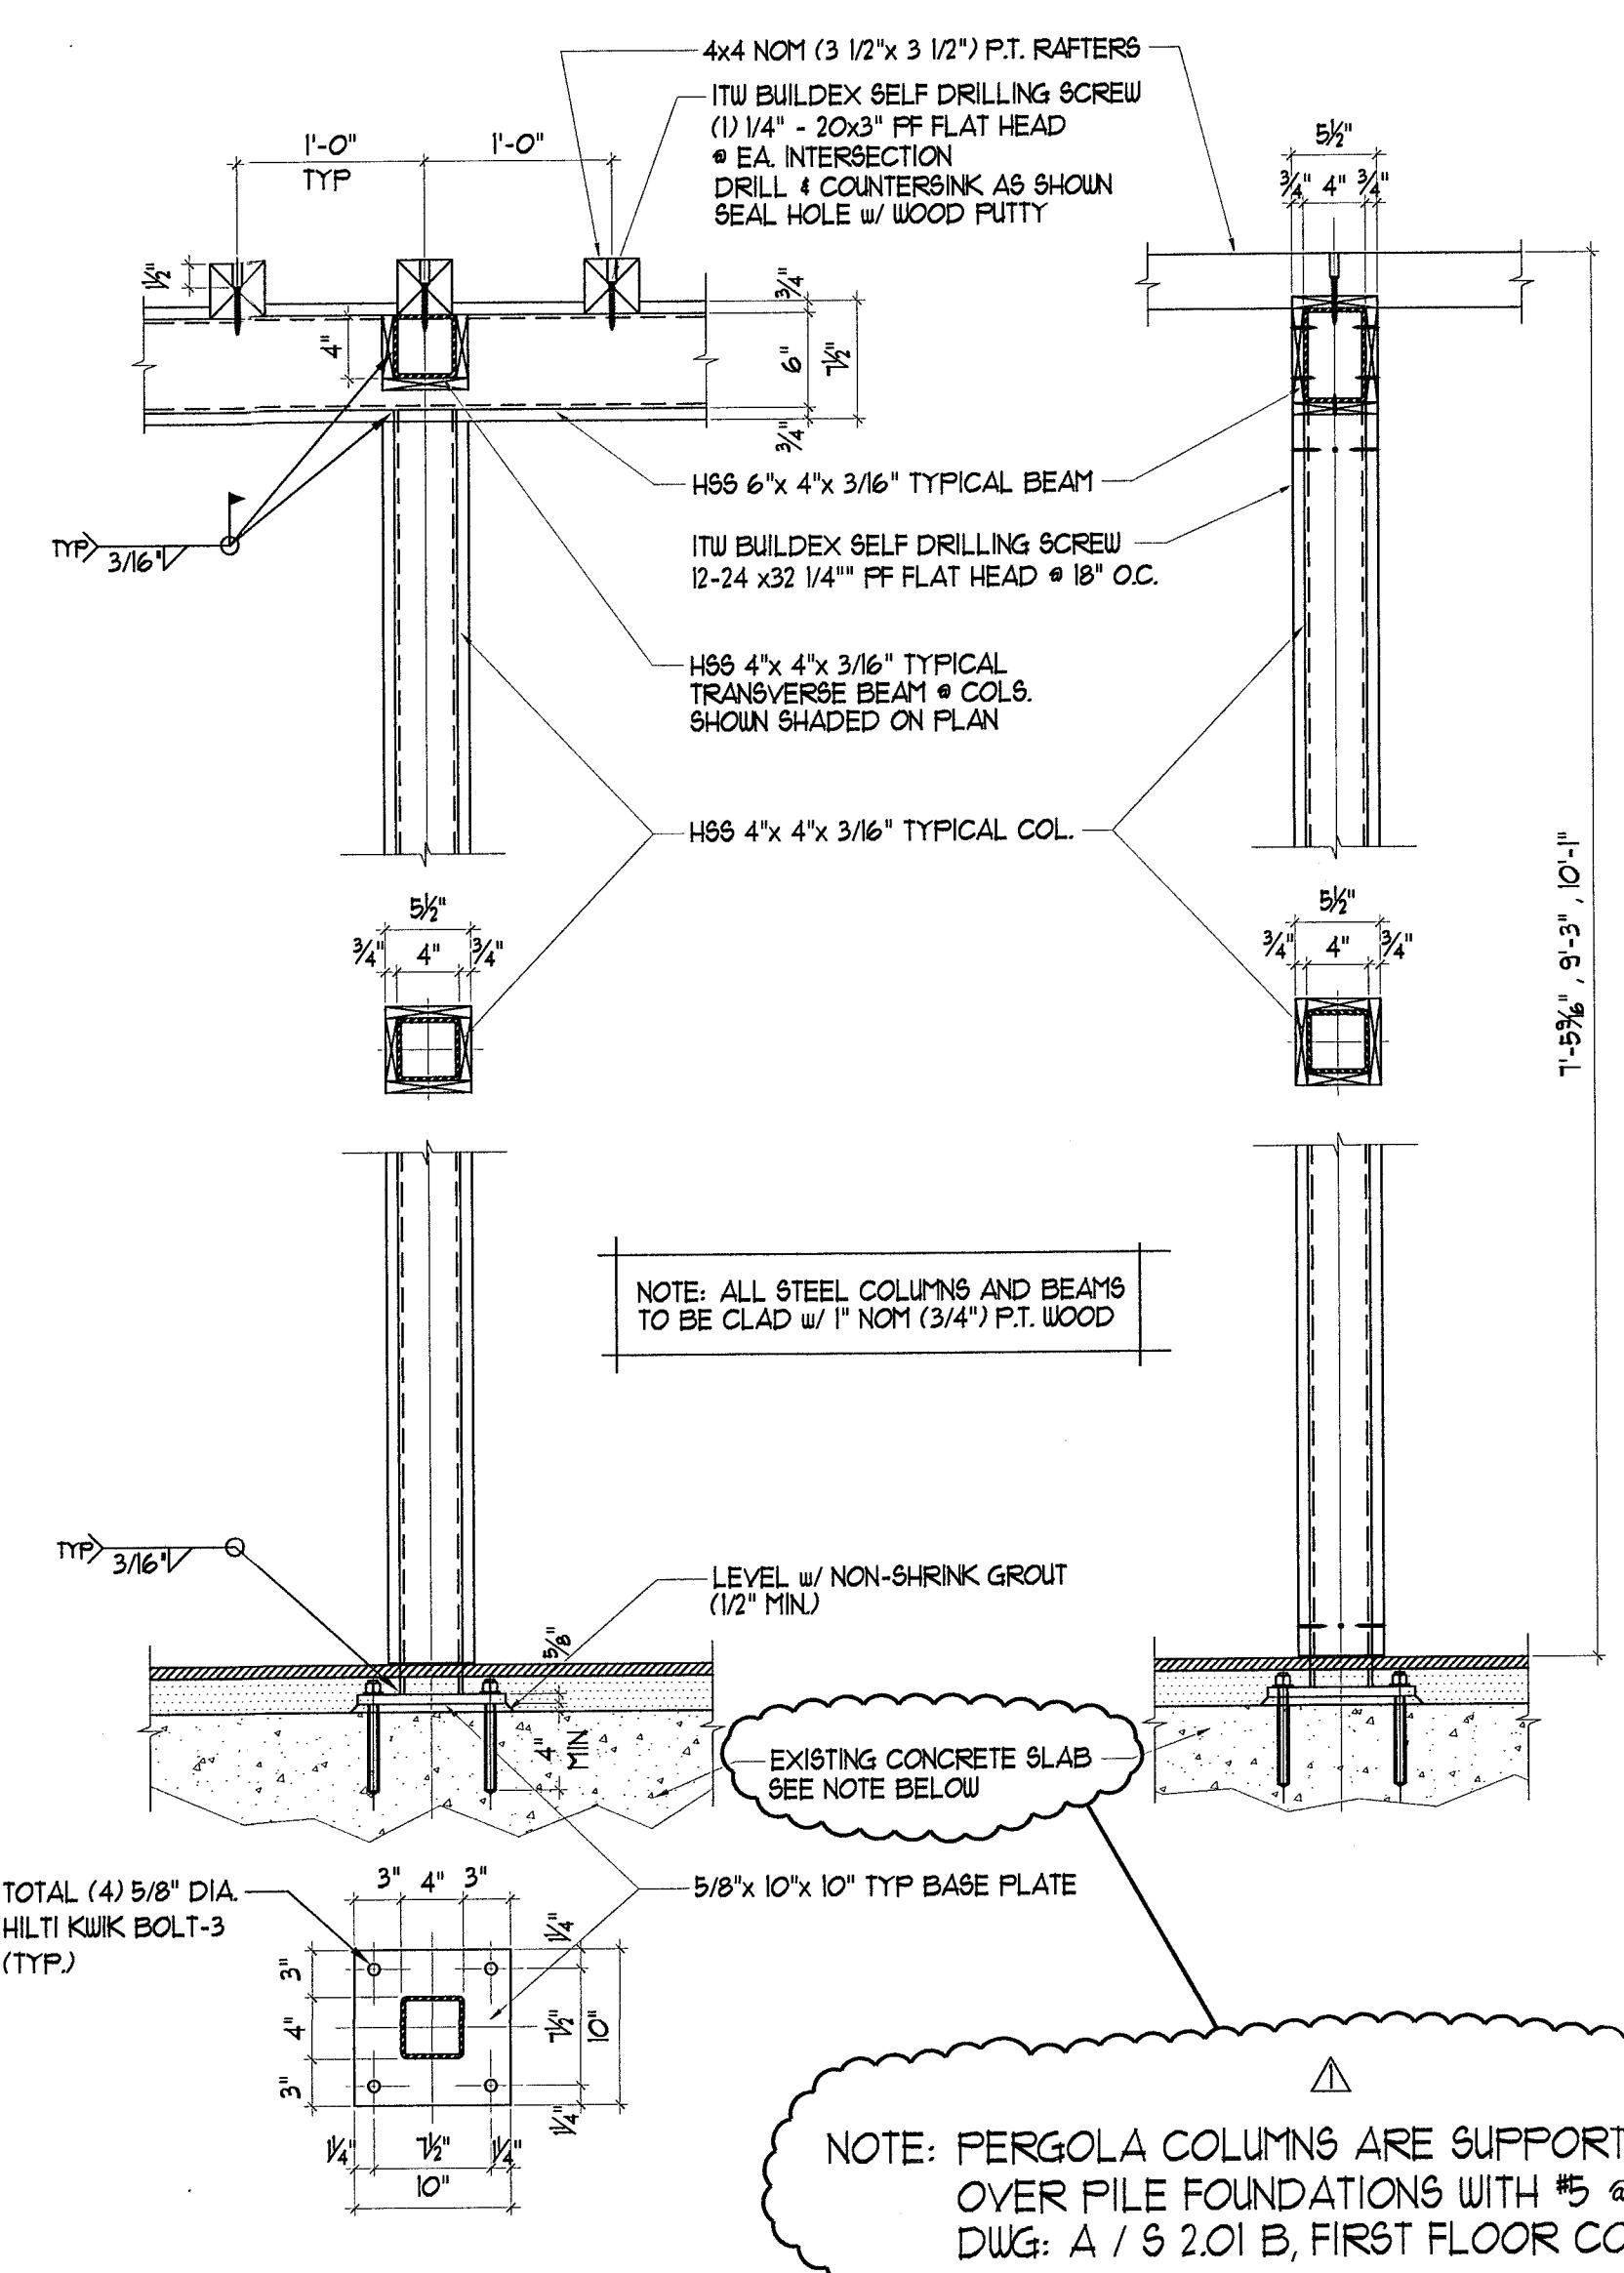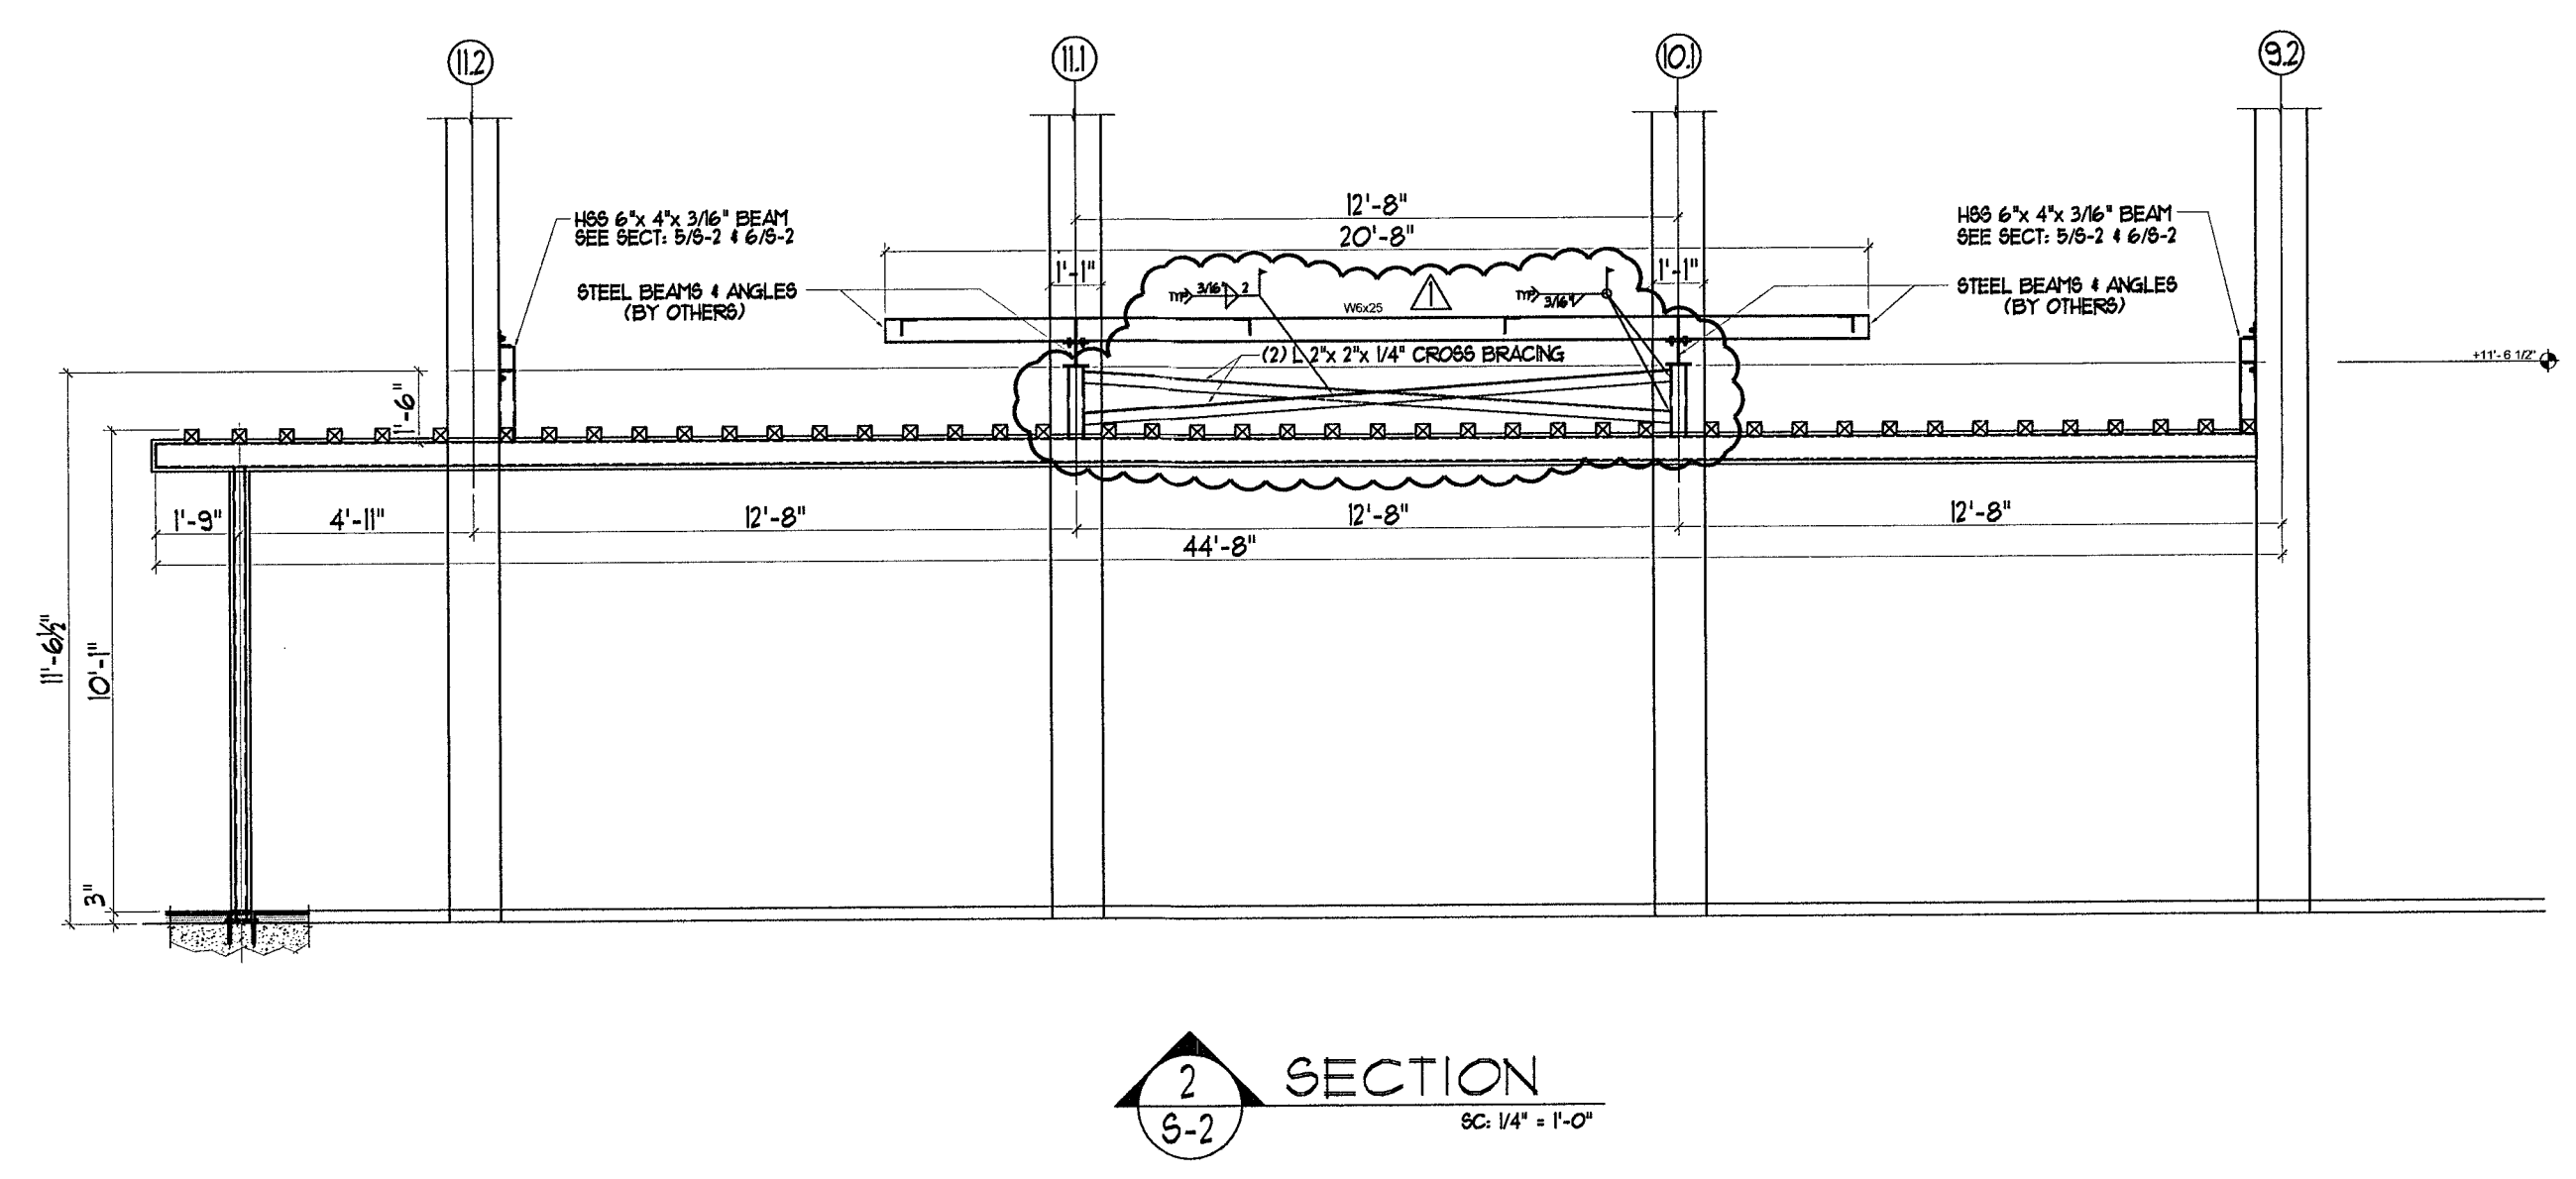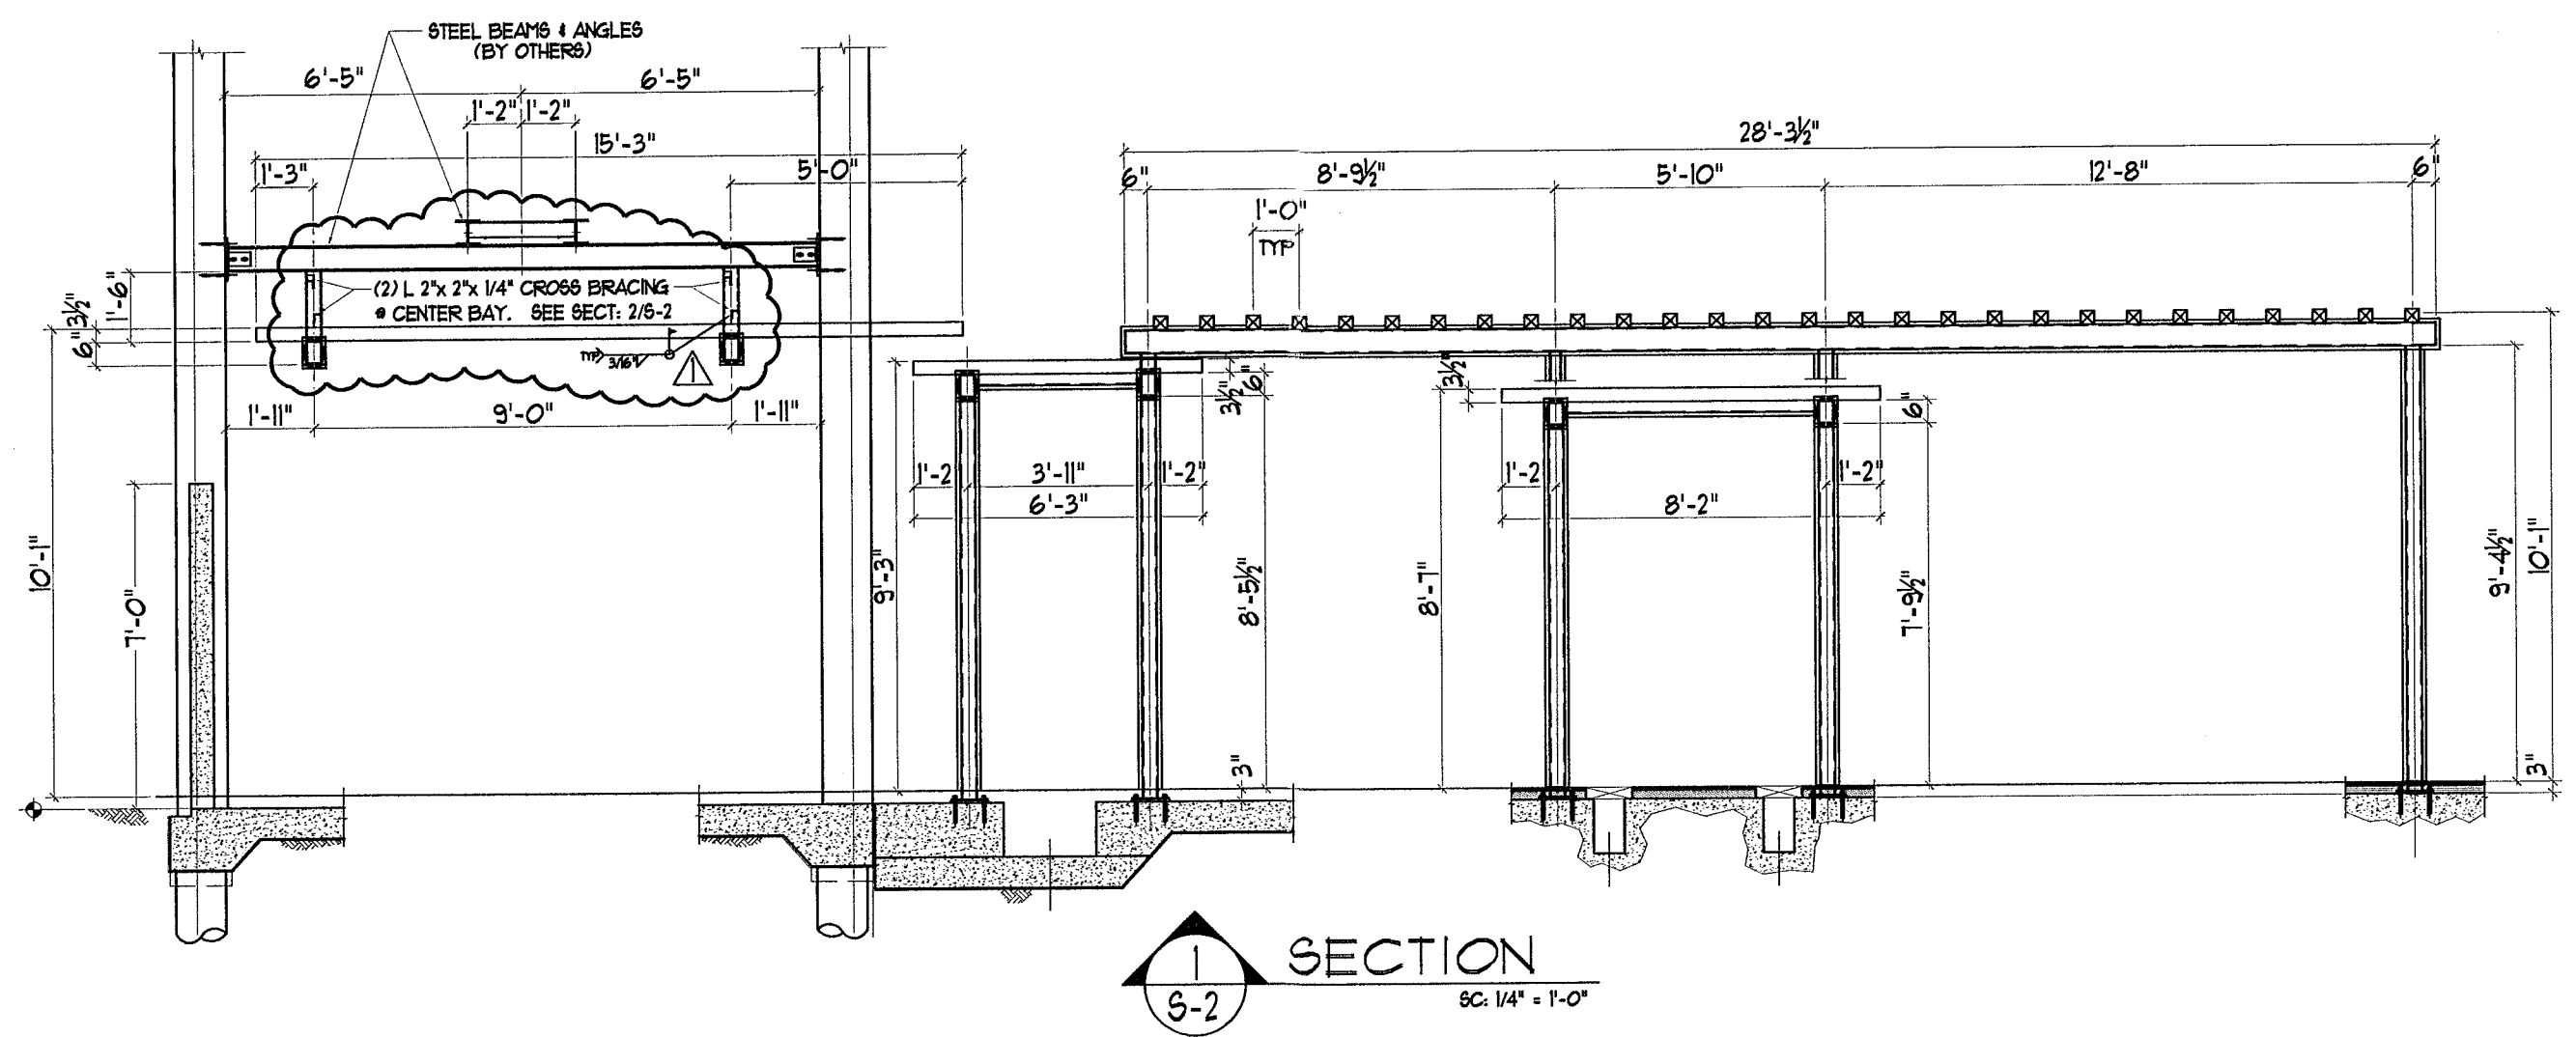

NOTE: PERGOLA COLUMNS ARE SUPPORTED ON EXISTING 8" CONCRETE STRUCTURAL SLAB OVER PILE FOUNDATIONS WITH #5 @ 12 CONT. EA. WAY BOT. & #5 @ 12 TOP AS SHOWN ON DWG: A / S 2.01 B, FIRST FLOOR COURTYARD FRAMING PLAN (ORIGINAL BLDG. PLANS)

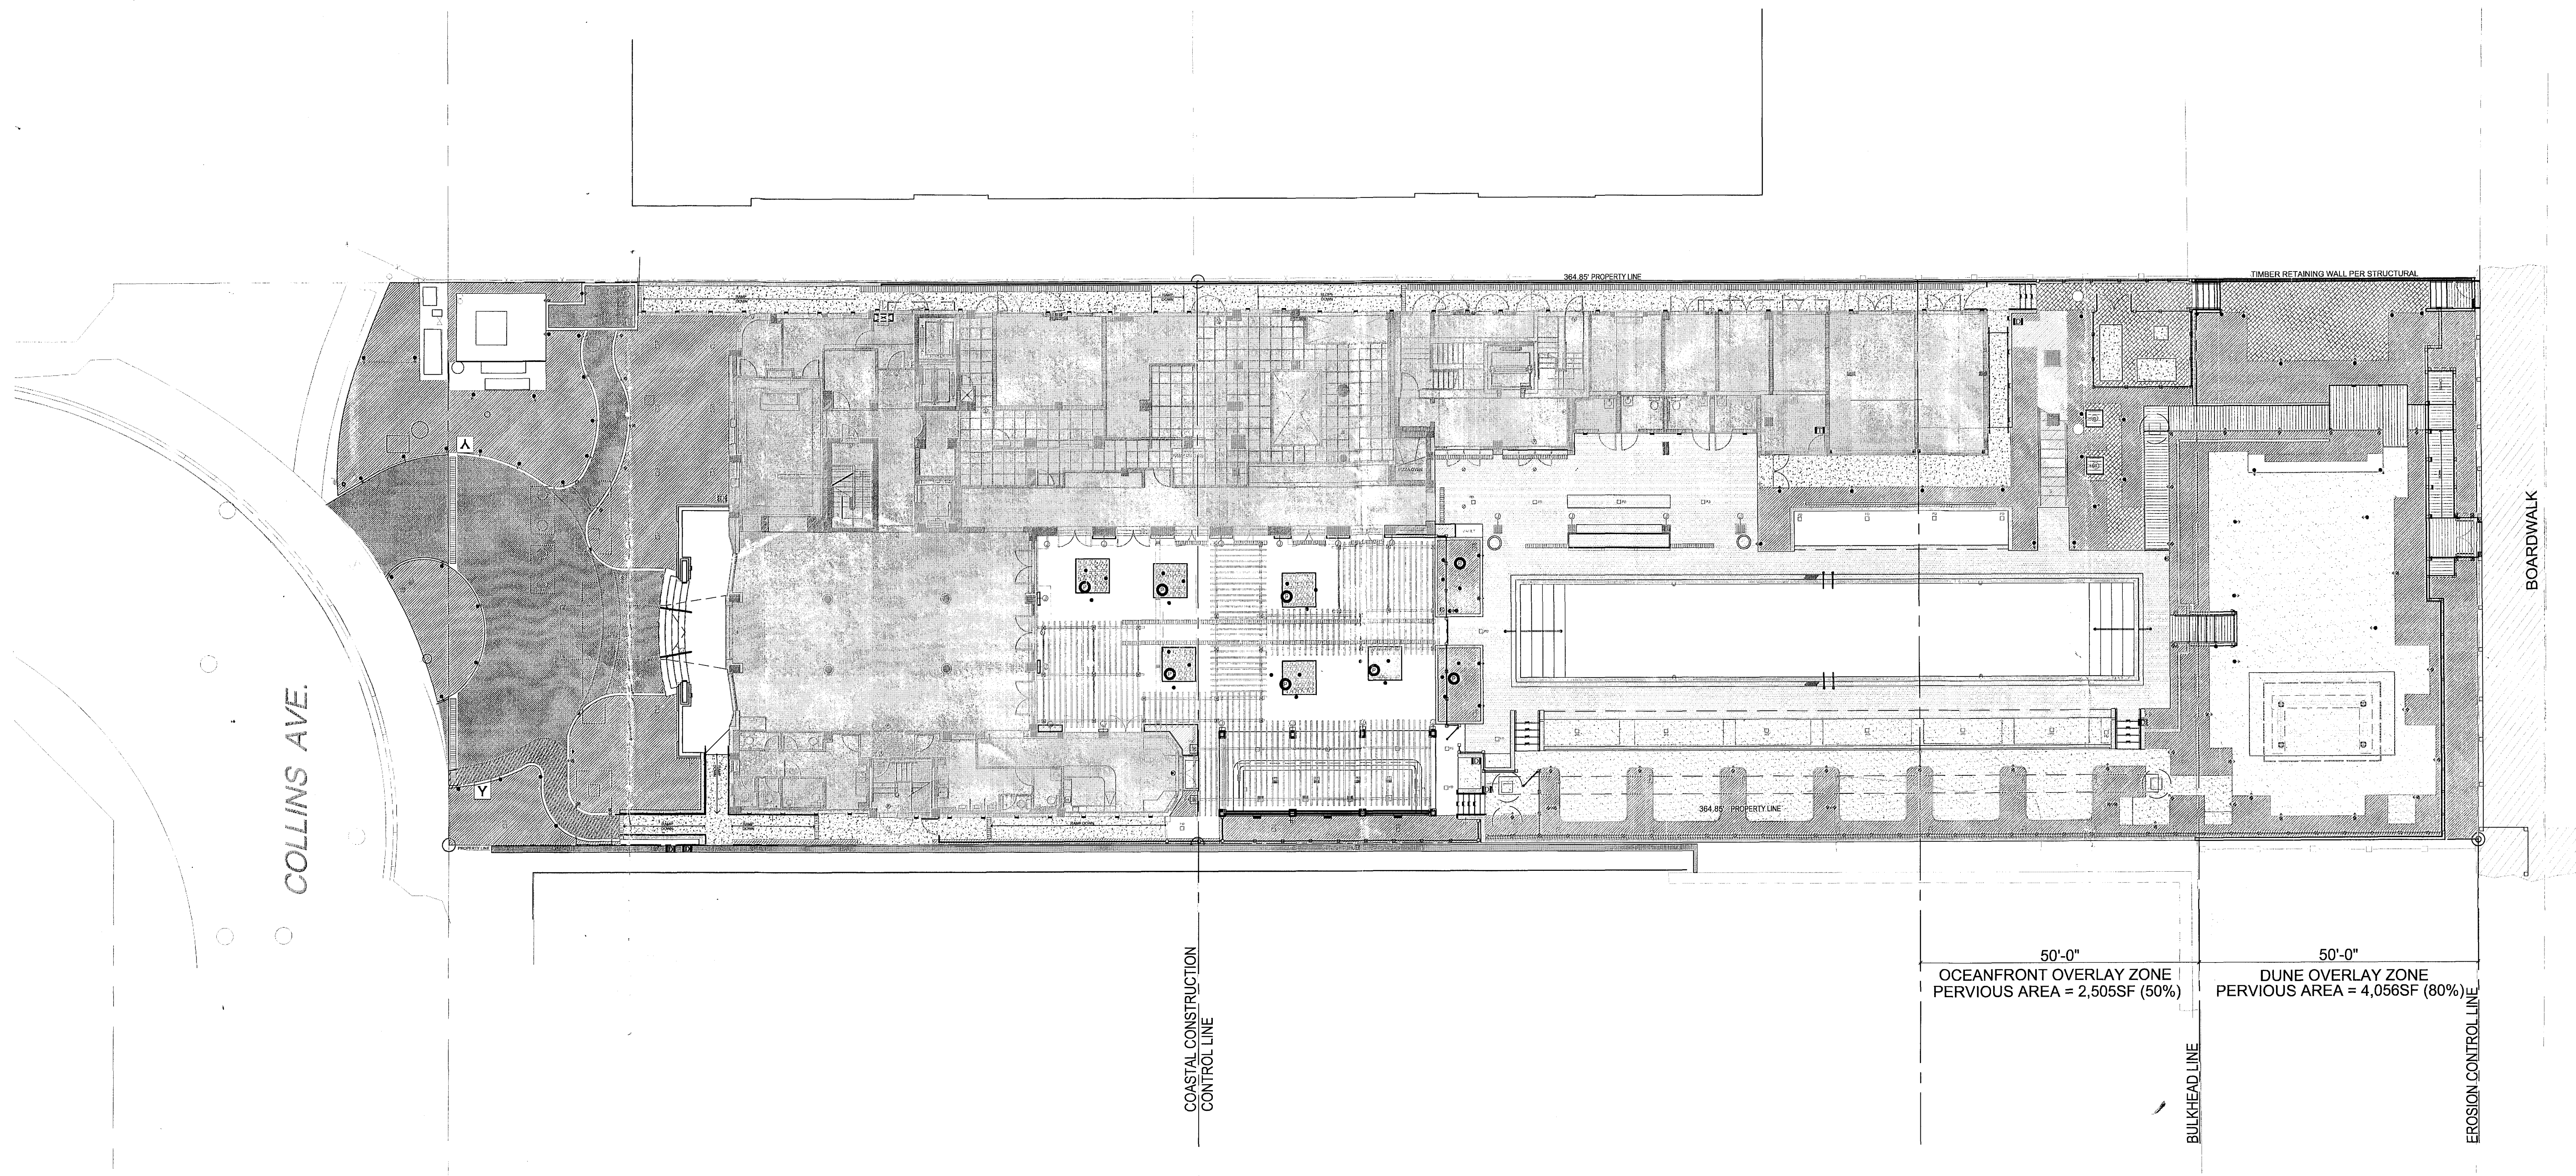

PROPOSED SITE PLAN
NOT TO SCALE

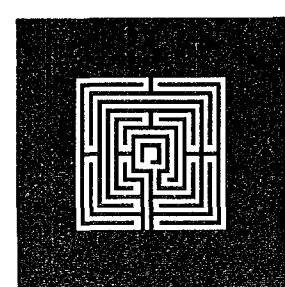


ALLANT. SHULMAN ARCHITECT, P.A.
(AR 0012763)
100 NE 38TH STREET, SPACE #2 MIAMI, FL 33137
TEL: 305.438.0609 FAX: 305.438.0170

JUNGLES
LANDSCAPE
ARCHITECT
RAYMOND JUNGLES INCORPORATED
Landscape Architect ASLA
242 SW 5th Street, Miami, FL 33130
PH (305)858.8777 FAX (305)858.0742
www.raymondjungles.com

REVISIONS

REVISIONS


[Signature]
10.19.10

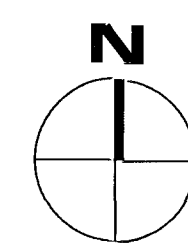


SOHO BEACH HOUSE
4385 COLLINS AVENUE, MIAMI BEACH, FL, 33140
JOB NO. 06023
RENOVATION AND ADDITION

L-1.00
10.19.10

SEE SHEET L1.01
SEE SHEET L1.02

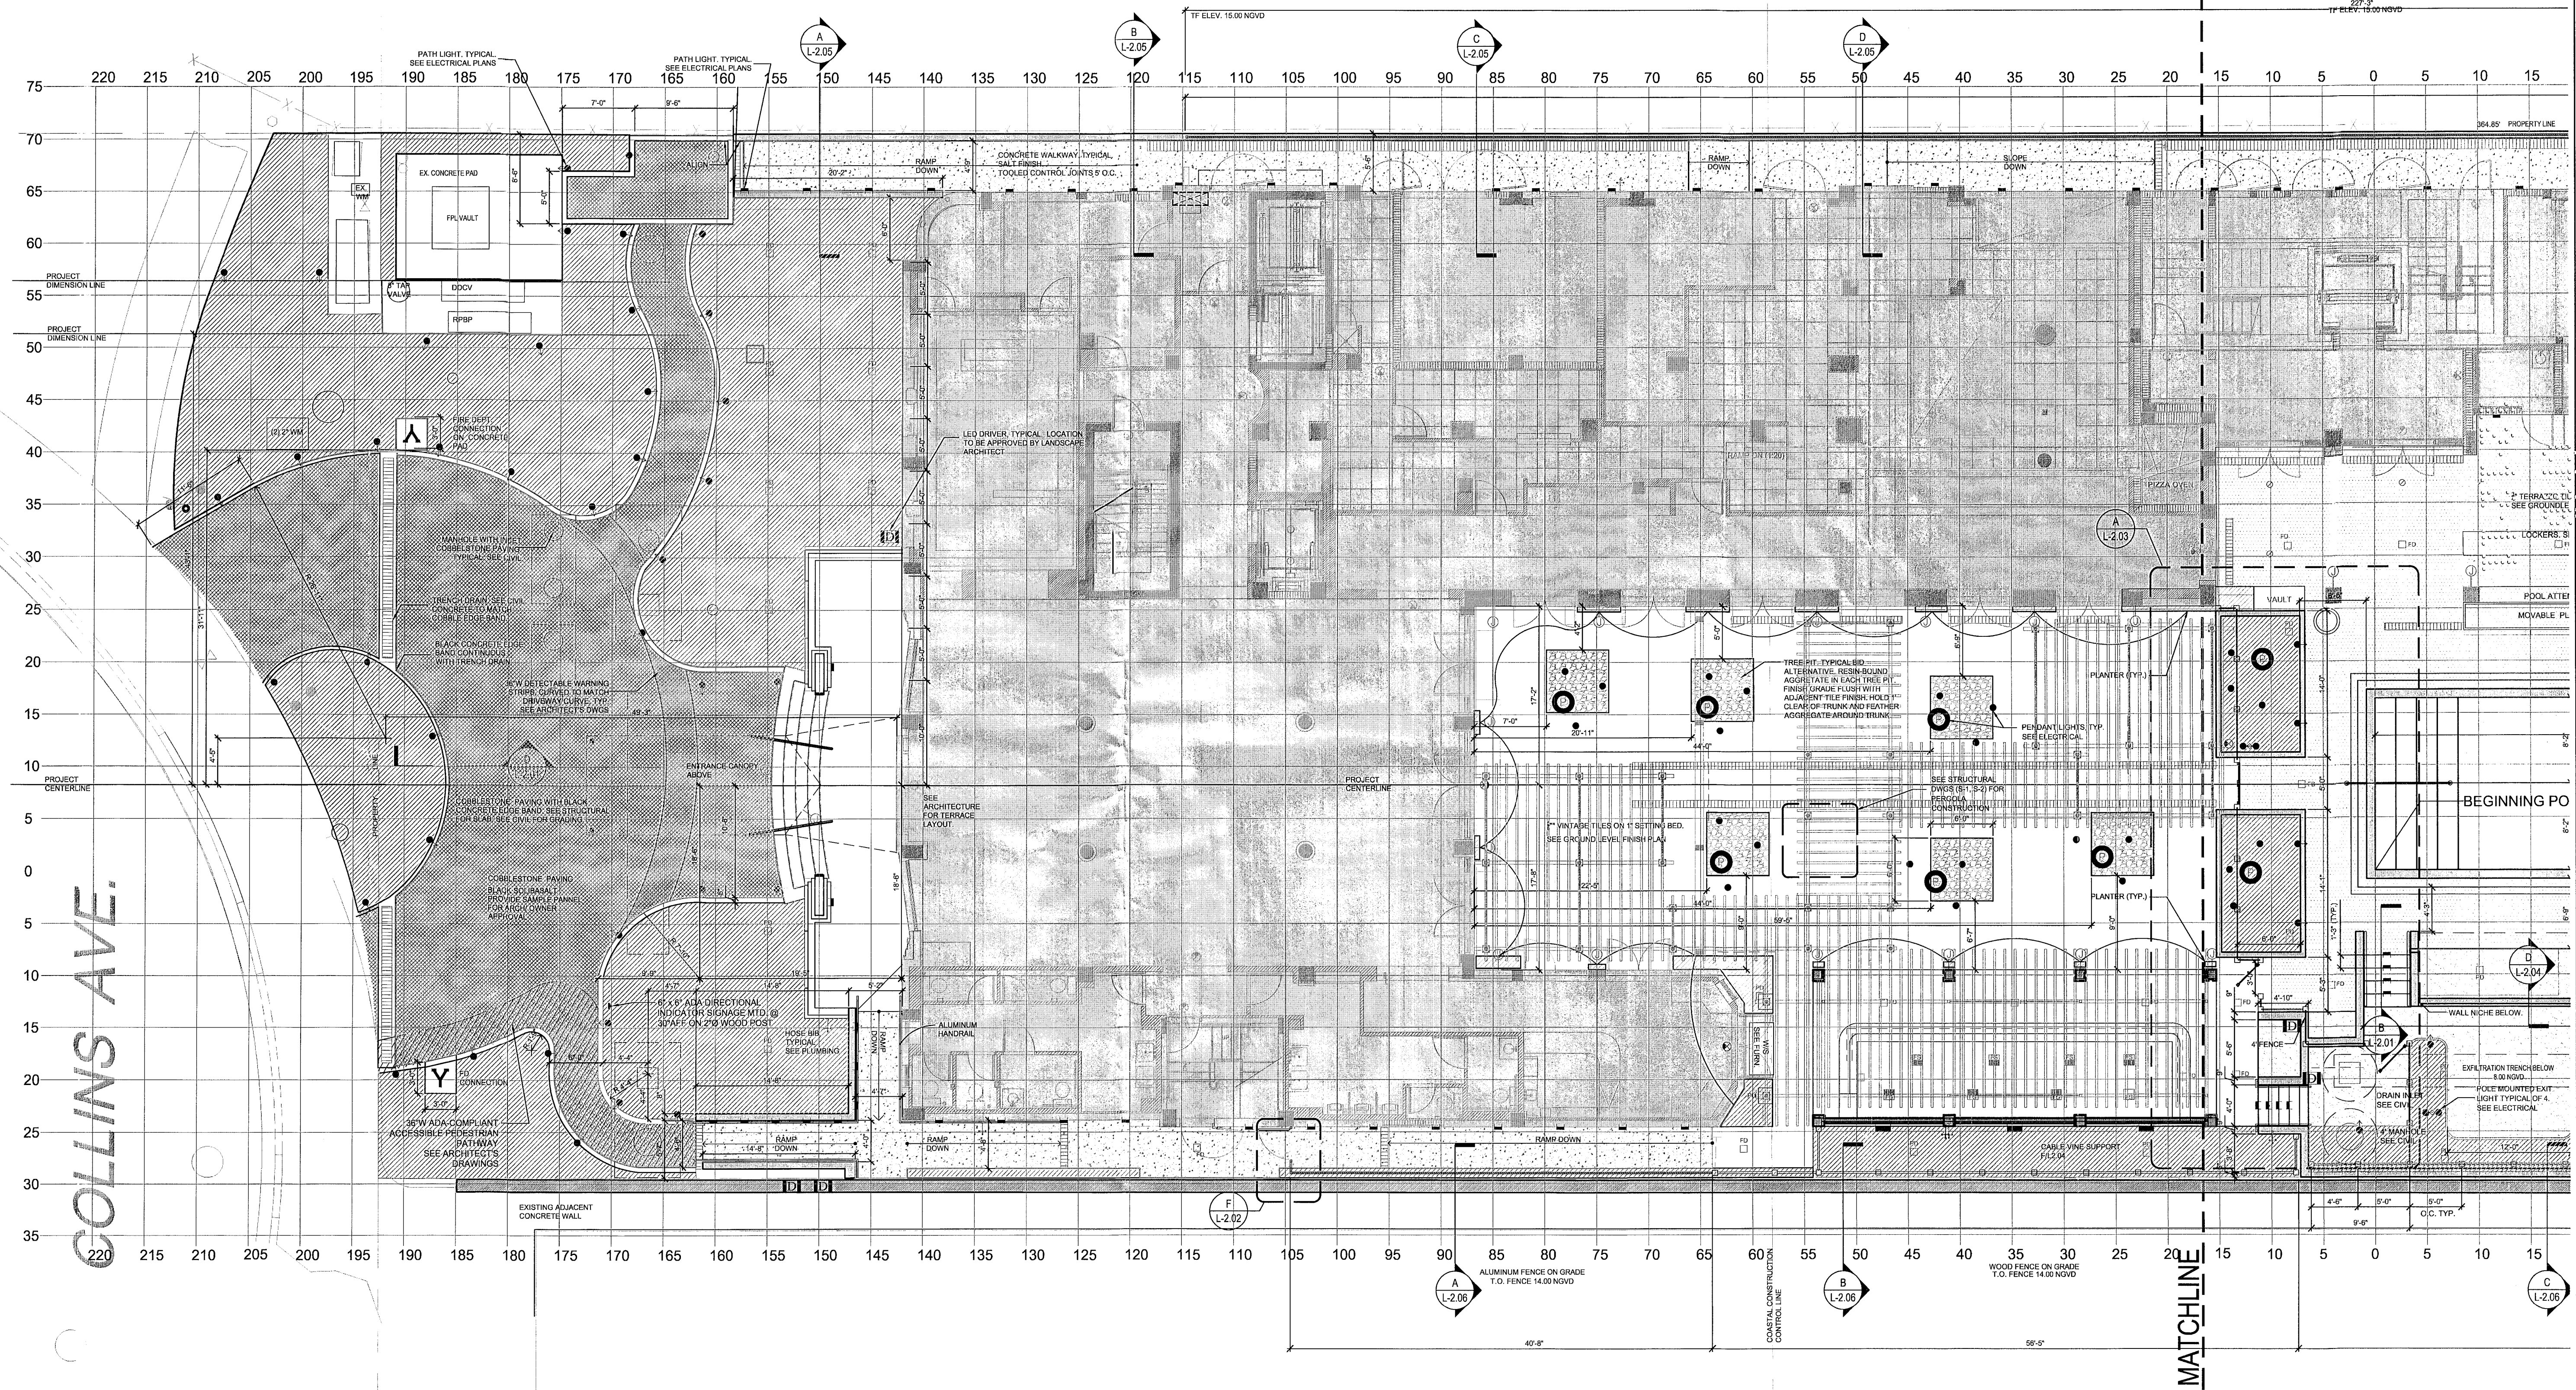

PARTIAL HARDSCAPE PLAN
SCALE: 1/8"=1'-0"

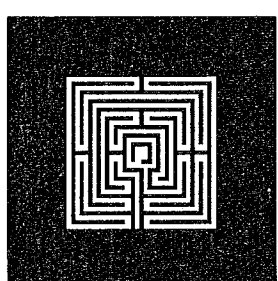


ALLANT. SHULMAN ARCHITECT, P.A.
(AR 0012763)
100 NE 38TH STREET, SPACE #2 MIAMI, FL 33137
TEL: 305.438.0609 FAX: 305.438.0170

JUNGLES
LANDSCAPE
ARCHITECT
RAYMOND JUNGLES INCORPORATED
Landscaping Architect ASLA
2402 SW 5TH STREET, MIAMI, FL 33135
PH (305) 858.6777 FAX (305) 856.0742
www.raymondjungles.com

REVISIONS

REVISIONS

[Signature]
10.19.10

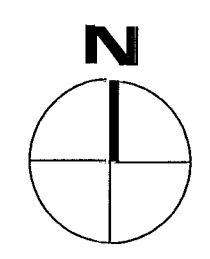

SOHO BEACH HOUSE
4385 COLLINS AVENUE, MIAMI BEACH, FL 33140
JOB NO. 06023
RENOVATION AND ADDITION

L-1.01
10.19.10