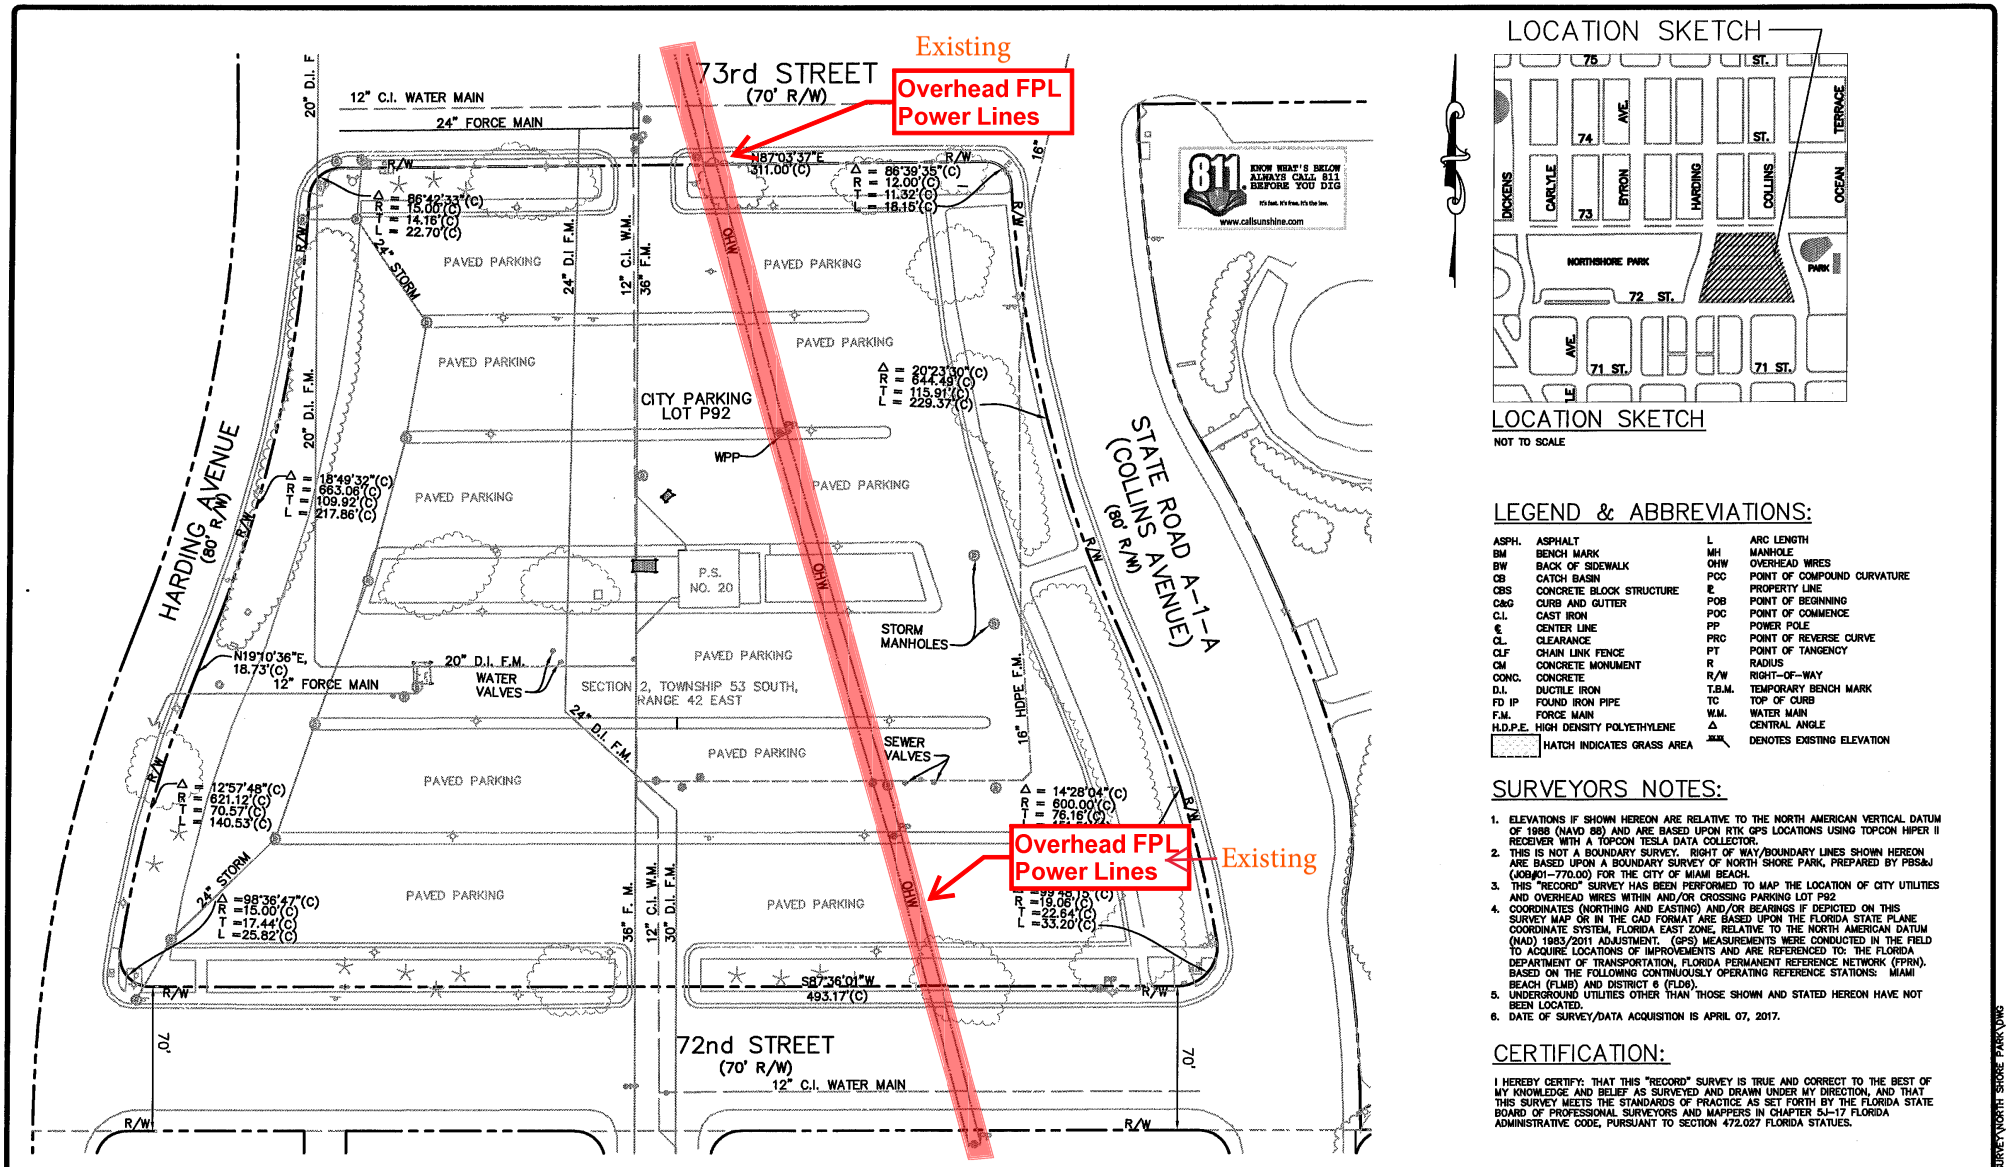


"RECORD SURVEY"
SCALE: 1"=60' (11X17)

LOCATION SKETCH

LOCATION SKETCH
NOT TO SCALE

LEGEND & ABBREVIATIONS:

ASPH.	ASPHALT	L	ARC LENGTH
BM	BENCH MARK	MH	MANHOLE
BW	BACK OF SIDEWALK	OHW	OVERHEAD WIRES
CB	CATCH BASIN	PCC	POINT OF COMPOUND CURVATURE
CBS	CONCRETE BLOCK STRUCTURE	℄	PROPERTY LINE
C&G	CURB AND GUTTER	POB	POINT OF BEGINNING
C.I.	CAST IRON	POC	POINT OF COMMENCE
℄	CENTER LINE	PP	POWER POLE
CL.	CLEARANCE	PRC	POINT OF REVERSE CURVE
CLF	CHAIN LINK FENCE	PT	POINT OF TANGENCY
CM	CONCRETE MONUMENT	R	RADIUS
CONC.	CONCRETE	R/W	RIGHT-OF-WAY
D.I.	DUCTILE IRON	T.B.M.	TEMPORARY BENCH MARK
FD IP	FOUND IRON PIPE	TC	TOP OF CURB
F.M.	FORCE MAIN	W.M.	WATER MAIN
H.D.P.E.	HIGH DENSITY POLYETHYLENE	Δ	CENTRAL ANGLE
	HATCH INDICATES GRASS AREA	XX.XX	DENOTES EXISTING ELEVATION

SURVEYORS NOTES:

1. ELEVATIONS IF SHOWN HEREON ARE RELATIVE TO THE NORTH AMERICAN VERTICAL DATUM OF 1988 (NAVD 88) AND ARE BASED UPON RTK GPS LOCATIONS USING TOPCON HIPER II RECEIVER WITH A TOPCON TESLA DATA COLLECTOR.
2. THIS IS NOT A BOUNDARY SURVEY. RIGHT OF WAY/BOUNDARY LINES SHOWN HEREON ARE BASED UPON A BOUNDARY SURVEY OF NORTH SHORE PARK, PREPARED BY PBS&J (JOB#01-770.00) FOR THE CITY OF MIAMI BEACH.
3. THIS "RECORD" SURVEY HAS BEEN PERFORMED TO MAP THE LOCATION OF CITY UTILITIES AND OVERHEAD WIRES WITHIN AND/OR CROSSING PARKING LOT P92
4. COORDINATES (NORTHING AND EASTING) AND/OR BEARINGS IF DEPICTED ON THIS SURVEY MAP OR IN THE CAD FORMAT ARE BASED UPON THE FLORIDA STATE PLANE COORDINATE SYSTEM, FLORIDA EAST ZONE, RELATIVE TO THE NORTH AMERICAN DATUM (NAD) 1983/2011 ADJUSTMENT. (GPS) MEASUREMENTS WERE CONDUCTED IN THE FIELD TO ACQUIRE LOCATIONS OF IMPROVEMENTS AND ARE REFERENCED TO: THE FLORIDA DEPARTMENT OF TRANSPORTATION, FLORIDA PERMANENT REFERENCE NETWORK (FPRN). BASED ON THE FOLLOWING CONTINUOUSLY OPERATING REFERENCE STATIONS: MIAMI BEACH (FLMB) AND DISTRICT 6 (FLD6).
5. UNDERGROUND UTILITIES OTHER THAN THOSE SHOWN AND STATED HEREON HAVE NOT BEEN LOCATED.
6. DATE OF SURVEY/DATA ACQUISITION IS APRIL 07, 2017.

CERTIFICATION:

I HEREBY CERTIFY: THAT THIS "RECORD" SURVEY IS TRUE AND CORRECT TO THE BEST OF MY KNOWLEDGE AND BELIEF AS SURVEYED AND DRAWN UNDER MY DIRECTION, AND THAT THIS SURVEY MEETS THE STANDARDS OF PRACTICE AS SET FORTH BY THE FLORIDA STATE BOARD OF PROFESSIONAL SURVEYORS AND MAPPERS IN CHAPTER 5J-17 FLORIDA ADMINISTRATIVE CODE, PURSUANT TO SECTION 472.027 FLORIDA STATUES.

04-11-17
DATE OF SIGNATURE

BRIAN T. BELLINO, P.S.M.
CITY SURVEYOR MANAGER
FLORIDA LICENSE NO.4973

MIAMIBEACH
PUBLIC WORKS DEPARTMENT
1700 CONVENTION CENTER DRIVE, MIAMI BEACH, FL 33139

NEIGHBORHOOD: NO. 4 - NORTH SHORE
TITLE: "RECORD SURVEY" FOR PARKING LOT P92

CITY MANAGER: JIMMY L. MORALES
DIRECTOR: ERIC T. CARPENTER, P.E.
CITY ENGINEER: BRUCE A. MOWRY, Ph.D., P.E.

ENGINEER OF RECORD:
DESIGN ENGINEER:
DRAWN BY: T.F.
CHECKER: B.T.B.
SCALE: AS SHOWN

ACCEPTED BY:
BRIAN T. BELLINO, P.S.M.
CITY SURVEYOR MANAGER

NO.	DATE	REVISION	APP'D. BY
6			
5			
4			
3			
2			
1			

File Name: CMB PARKING LOT 9B btb.dwg
Survey Reference:
Field Book: N/A Page: N/A Work Order: N/A
Date: 04/04/17 Sheet: 1 of 1 Drawing: ANSI D-survey
File Path: P:\WORK\ALL SURVEY\NORTH SHORE PARK\DWG

Attachment A